

NOTES:

- 4. NEW 10" PUBLIC WATER LINE EASEMENT
- 5. NOT USED
- 6. ALL WATER SERVICES ARE TO BE 1-1/2" UNLESS OTHERWISE SPECIFIED
- 7. ALL SANITARY SEWER SERVICES ARE TO BE 6" UNLESS OTHERWISE NOTED.

**LEGEND**

EXISTING RIM & INV ELEVATION	EXISTING WATER VALVE
EXISTING TRAFFIC SIGNAL BOX	EXISTING METER RISER
EXISTING TRAFFIC SIGNAL	EXISTING BILLBOARD
EXISTING LIGHT POLE	EXISTING FIRE HYDRANT
EXISTING POWER POLE	EXISTING DROP INLET
EXISTING OVERHEAD UTILITY LINE	EXISTING FENCE
EXISTING GAS LINE	EXISTING PROPERTY LINE
EXISTING SEWER LINE	EXISTING LOT LINES
EXISTING WATER LINE	EXISTING CURB & GUTTER
EXISTING ANCHOR	EXISTING SIDEWALK
EXISTING SEWER MANHOLE	NEW BUILDING
EXISTING STORM MANHOLE	NEW CURB & GUTTER
EXISTING STORM LINE	NEW PARKING STRIPES
	NEW STORM DRAIN
	NEW FINISH FLOOR
	NEW SAS LINE
	NEW WATERLINE
	NEW SAS SERVICE
	FUTURE BUILDING
	NEW WATERLINE SERVICE
	FUTURE WATERLINE SERVICE
	SAWCUT & REPLACE EXISTING ASPHALT PER 2465-ARTERIAL

RECORD DRAWING  
 CERTIFICATE OF SUBSTANTIAL COMPLIANCE ON PLANS

I, Gregory J. Krenik, NMPE 11929, of the firm Mark Goodwin & Associates, P.A., a Registered Professional Engineer in the State of New Mexico, do hereby certify, to the best of my knowledge and belief, that the infrastructure installed as part of this project has been inspected by me or by a qualified person under my direct supervision, and has been constructed in accordance with the plans and specifications approved by the City Engineer and that the original design intent of the approved plans has been met, except as noted by me on the as-built construction drawings. This certification is based on site inspections by me or personnel under my direct supervision and information provided by David R. Vigil.

Gregory J. Krenik  
 11929  
 NMPE 11929

I, Gregory J. Krenik, certify that the electronic version is identical to the original reproducible APPROVED FOR CONSTRUCTION drawings signed by me on 1/18/08.


**EQA #08-01-04176**

**dmg** MARK GOODWIN & ASSOCIATES, P.A.  
 CONSULTING ENGINEERS  
 P.O. BOX 90606  
 ALBUQUERQUE, NEW MEXICO 87199  
 (505) 828-2200, FAX (505) 797-9539

**CITY OF ALBUQUERQUE**  
**PUBLIC WORKS DEPARTMENT**

TITLE: **I.P.F.D.C. MASTER UTILITY PLAN**

DESIGN REVIEW COMMITTEE	CITY ENGINEER APPROVAL	MO./DAY/YR.	MO./DAY/YR.
APPROVE FEB 26 2008 DESIGN REVIEW COMMITTEE	APPROVE NOV 21 2008 CITY ENGINEER		

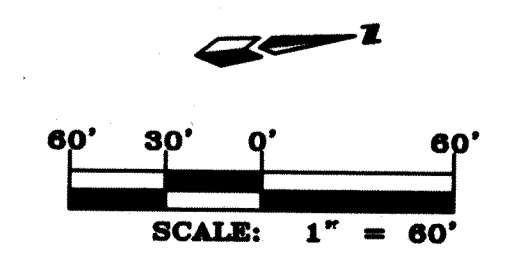

AS BUILT INFORMATION		BENCH MARKS		SURVEY INFORMATION		ENGINEER'S SEAL		REVISIONS	
CONTRACTOR	TLC	BENCHMARK IS AN ACS 1 3/4" ALUMINUM DISK.	DATE	NO.	BY		NO. DATE	REMARKS	BY
WORK SUBMITTED	GeoSurvCo	STAMPED, "ACS BM, 11-H13", EXPOSED TO THE TOP OF A CONCRETE CURB, AT THE N.W. CURB RETURN.	DATE	NO.	DATE		DESIGN	DATE	DATE
ACCEPTANCE BY	MLGA	ELEVATION = 4961.641 (SLD 1929)	DATE	NO.	DATE		CAR	DATE	DATE
REVISIONS	GeoSurvCo						DMG		
DATE	DATE								
DATE	DATE								
