
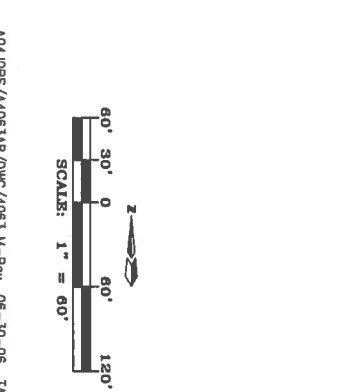
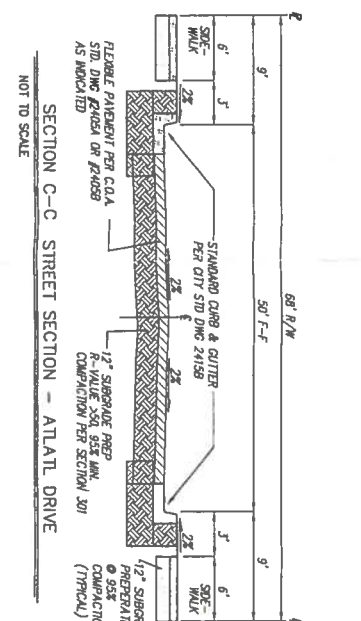


- NOTES**
1. ALL 4' VALLEY GUTTERS PER CITY OF ALBUQUERQUE STANDARD DRAWING 2421 AT INTERSECTIONS AND 6' VALLEY GUTTERS PER COA STD DNG 2420 AT ALL INTERSECTIONS AND ALL 10' & 12' SPECIAL VALLEY GUTTERS PER COA STD DNG 2422.
 2. ALL 4' INTERIOR SIDEWALKS ARE DETACHED, UNLESS OTHERWISE NOTED.
 3. ALL HANGOFF RAMP TO BE PER CITY STD DNG 2441 CASE 4, W/TERMINATED DOWNS.
 4. TRANSITION FROM MOUNTABLE CURB TO STANDARD CURB SHALL BE 10' PER COA STD DNG 2418 AND AT HANGOFF RAMP, IF NECESSARY.
 5. TRANSITION SECTION FROM FULL CROWN TO NO CROWN TO BE A MINIMUM OF 50' PER COA STD DNG 2401.
 6. ALL SIDEWALKS PER COA STD DNG 2420.
 7. UNIDIRECTIONAL CURB ACCESS RAMP PER COA STD DNG 2426 W/TERMINATED DOWNS.
 8. CURB RETURNS WITH 6' VALLEY GUTTER, PROVIDE TYPE III BARRICADE, IF NECESSARY.
 9. CONTRACTOR RESPONSIBLE FOR INSTALLATION & MAINTENANCE OF ALL SIGNING & STRIPING UNIT, ACCEPTED BY CITY OF ALBUQUERQUE.
 10. STREET GRADES SHALL NOT EXCEED 2.00% FOR THE FIRST 6' FROM THE FLOWLINE OF INTERSECTING STREETS TO ENSURE THAT CROSS-WALK CROSS-SLOPES ARE ADA COMPLIANT. SEE SHEET 7, MASTER PAVING PLAN.

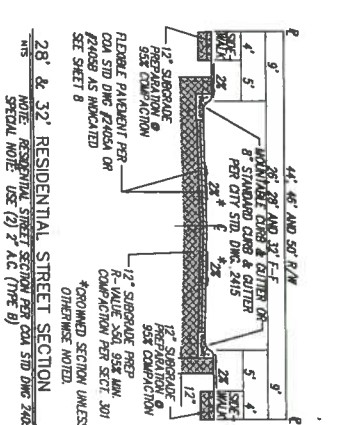


MARK GOODMAN & ASSOCIATES, P.A.
CONSULTING ENGINEERS
P.O. BOX 90606
ALBUQUERQUE, NEW MEXICO 87199
PHONE (505) 263-2000 FAX (505) 263-2559

CITY OF ALBUQUERQUE
PUBLIC WORKS DEPARTMENT
ANASAZI RIDGE SUBDIVISION
MASTER PAVING PLAN

DESIGN REVIEW COMMITTEE
DESIGN REVIEW DATE: JUL 14 2006
CITY ENGINEER: [Signature]
LAST DESIGN UPDATE: [Signature]

DESIGNED BY: JSD DATE: 01/06
DRAWN BY: TAS DATE: 01/06
CHECKED BY: DMG DATE: 01/06

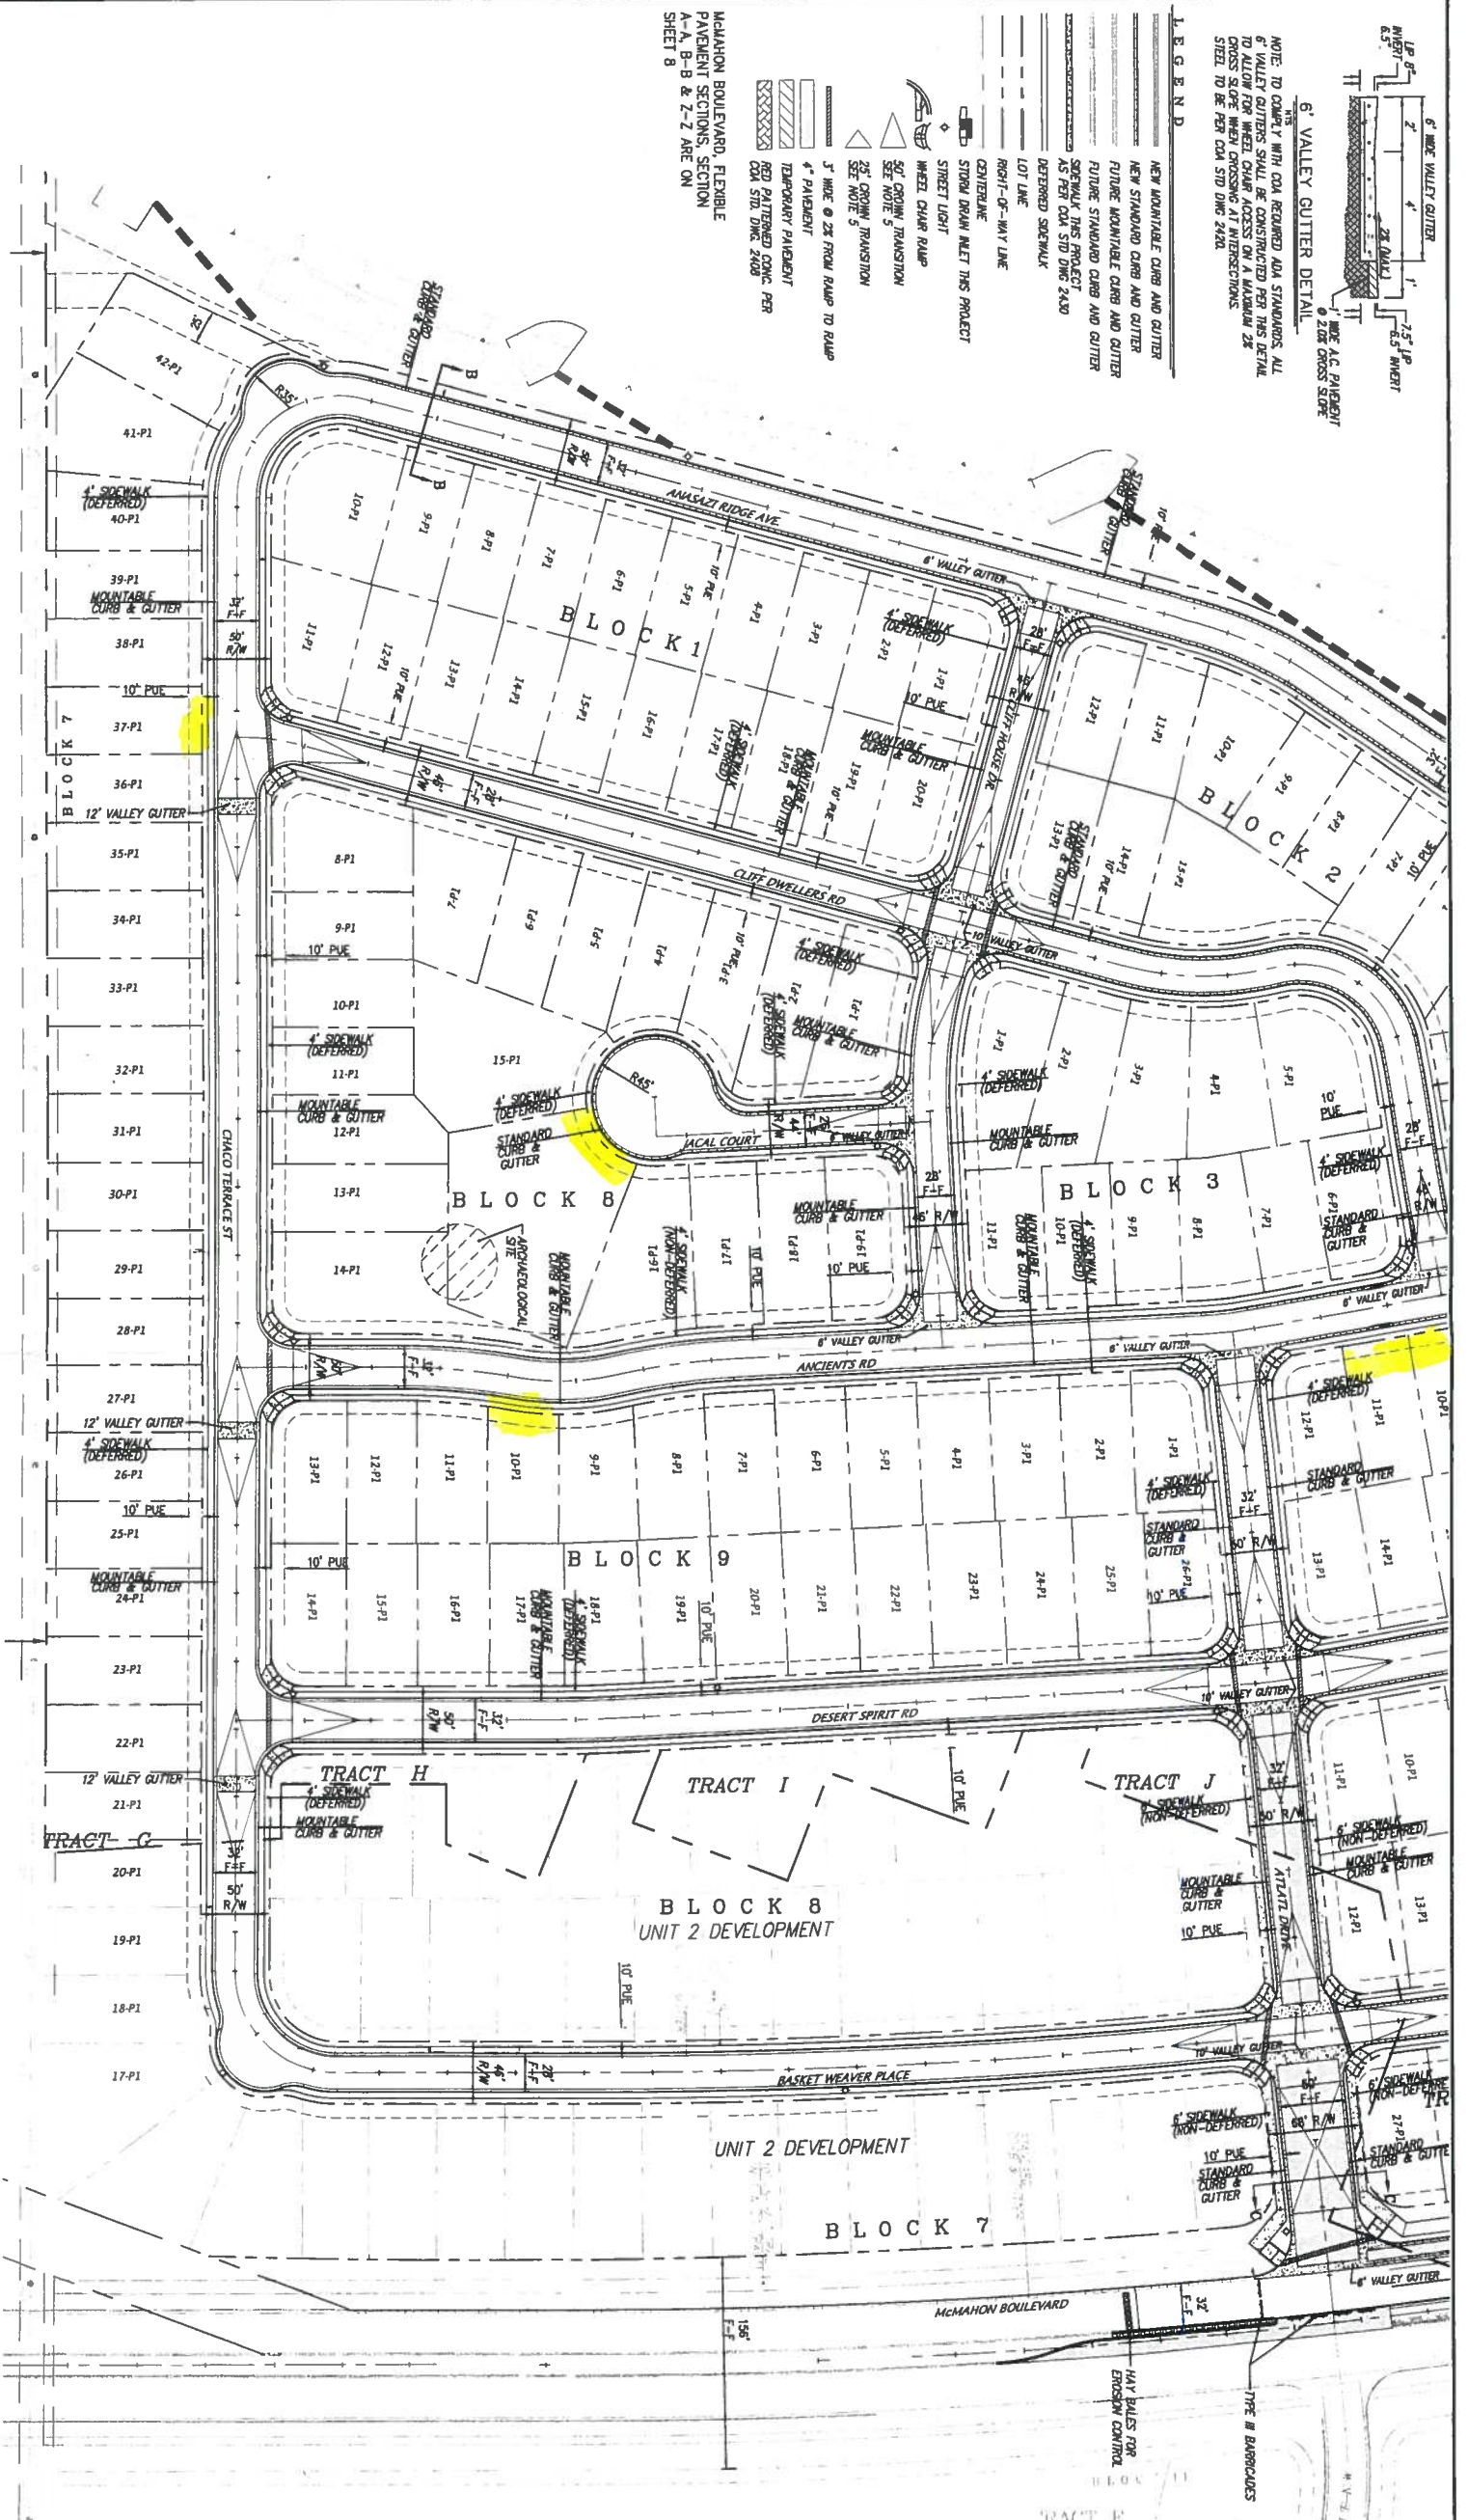

SURVEY INFORMATION			BENCH MARKS		AS BUILT INFORMATION	
FIELD NOTES						
NO.	BY	DATE			CONTRACTOR	DATE
					Hydro Systems	
					WORK STAKED BY	DATE
					INSPECTOR'S ACCEPTANCE BY	DATE
					FIELD VERIFICATION BY	DATE
					DRAWINGS CORRECTED BY	DATE
					MICRO-FILM INFORMATION	
					RECORDED BY	DATE
					NO	

NOTE: HGS STATION "SANDBERN" IS LOCATED TO THE NW OF DOWNTOWN ALBUQUERQUE. TO REACH STATION FROM INTERSECTION OF CENTRAL AVE. & COORS RD., GO N. ON COORS 7.6 MI. TO THE INTERSECTION WITH PARADISE BLVD., THEN NW ON PARADISE 1.1 MI. TO GOLF COURSE RD., THEN NE ON GOLF COURSE 1.3 MI. TO JUNCTION WITH MCMAHON BLVD., THEN NW ON MCMAHON 2.25 MI. STATION IS LOCATED 600 FT SOUTH OF THIS POINT. STATION IS STD. USGS BRASS TABLET STAMPED "SANDBERN 1989" SET IN CONC. POST
X = 361,854.28, Y = 1,534,208.29 (NAD 27) ELEV = 5456.82 (NGVD 29)

