

VILLE CT

HOLLY AVENUE
(60' ROW)

GENERAL NOTES:

1. ALL WORK SHALL COMPLY WITH THE REGULATION AND ORDINANCES OF THE CITY OF ALBUQUERQUE, NM AND ANY OTHER APPLICABLE CODES.
2. THE GENERAL CONTRACT SHALL NOTIFY THE OWNER/ARCHITECT OF ANY INTERRUPTIONS IN UTILITY SERVICES.
3. THE GENERAL CONTRACTOR SHALL CONTACT LOCAL UTILITIES TO VERIFY ALL SIZES, LOCATIONS, AND CONNECTION POINTS FOR ALL UTILITIES AFFECTED.
4. ANY CONNECTIONS, DISCONNECTIONS, AND INSTALLATIONS TO LOCAL UTILITIES SHALL BE MADE IN ACCORDANCE WITH APPLICABLE CODES.
5. EXTERIOR BUILDING SIGN FURNISHED & INSTALLED BY OWNER VENDOR. GC TO PROVIDE POWER.
6. GENERAL CONTRACTOR TO VERIFY EXISTING SITE CONDITIONS PRIOR TO BID. ALSO PROVIDE CONTINUOUS CURB CUTS AND SMOOTH PAVEMENT & CURB TRANSITIONS BETWEEN NEW AND EXISTING CONDITIONS AS REQUIRED FOR SITEWORK AS INDICATED.
7. GENERAL CONTRACTOR SHALL PROVIDE AND INSTALL ELECTRICAL CONDUIT AND STRUCTURAL FOOTINGS FOR ALL NEW SITE DRIVE-THRU SIGNAGE (TYPICAL).



KEYED NOTES:

INDICATED BY SYMBOL

- 1.1 PROPOSED PANERA SPACE
- 1.2 EXISTING CMU TRASH ENCLOSURE.
- 1.3 EXISTING STEEL PIPE HANDRAIL TO REMAIN.
- 1.4 EXISTING TRANSFORMER
- 1.5 PROPOSED FIRE SPRINKLER ROOM.
- 1.6 EXISTING SITE LIGHTING
- 1.7 EXISTING GAS METER
- 1.8 EXISTING STORM SEWER
- 1.9 EXISTING ELECTRICAL SWITCHGEAR
- 2.0 EXISTING FIRE HYDRANT (6" LINE)
- 2.1 ADJACENT TENANT SPACE.
- 2.2 EXISTING MAIN ENTRY DOORS.
- 2.3 EXISTING SERVICE DOOR TO REMAIN.
- 2.4 EXISTING LANDSCAPE AREA TO REMAIN.
- 2.5 EXISTING SIDEWALK TO REMAIN.
- 2.6 PROPOSED BRICK (PAVER) PATIO.
- 2.7 EXISTING DRIVE AISLE TO REMAIN.
- 2.8 EXISTING HANDICAP STALL WITH WHEEL STOP AND SIGNAGE.
- 2.9 EXISTING CULVERT DRAIN WITH STEEL COVER PLATE.
- 3.0 NEW CURB RAMPS. RUNNING SLOPE N.T.E. 8.33% AND CROSS SLOPE N.T.E. 2%.
- 3.1 NEW WHEELSTOP, SEE DETAIL X/XX.
- 3.2 EXISTING BIKE RACK TO REMAIN.
- 3.3 NEW BOLLARD W/ DECORATIVE COVER, SEE DETAIL X/XX.

*red brick ground
No to rock ground*

21 CURB RAMP DETAIL
SCALE: 1/4"=1'-0"

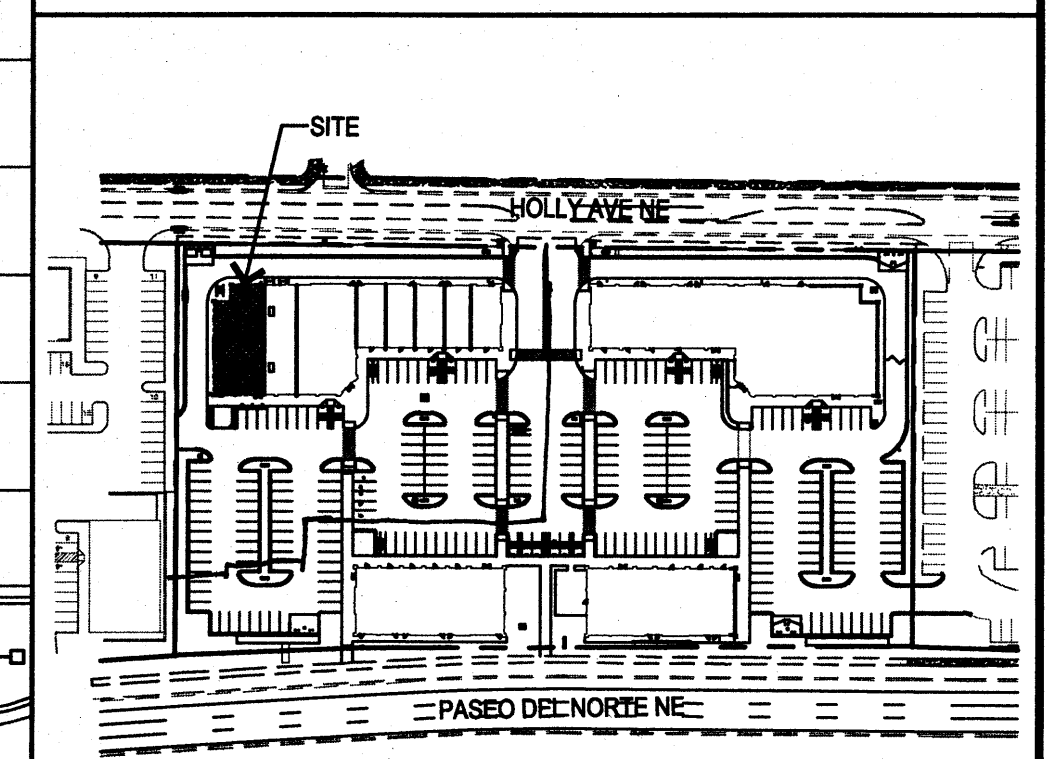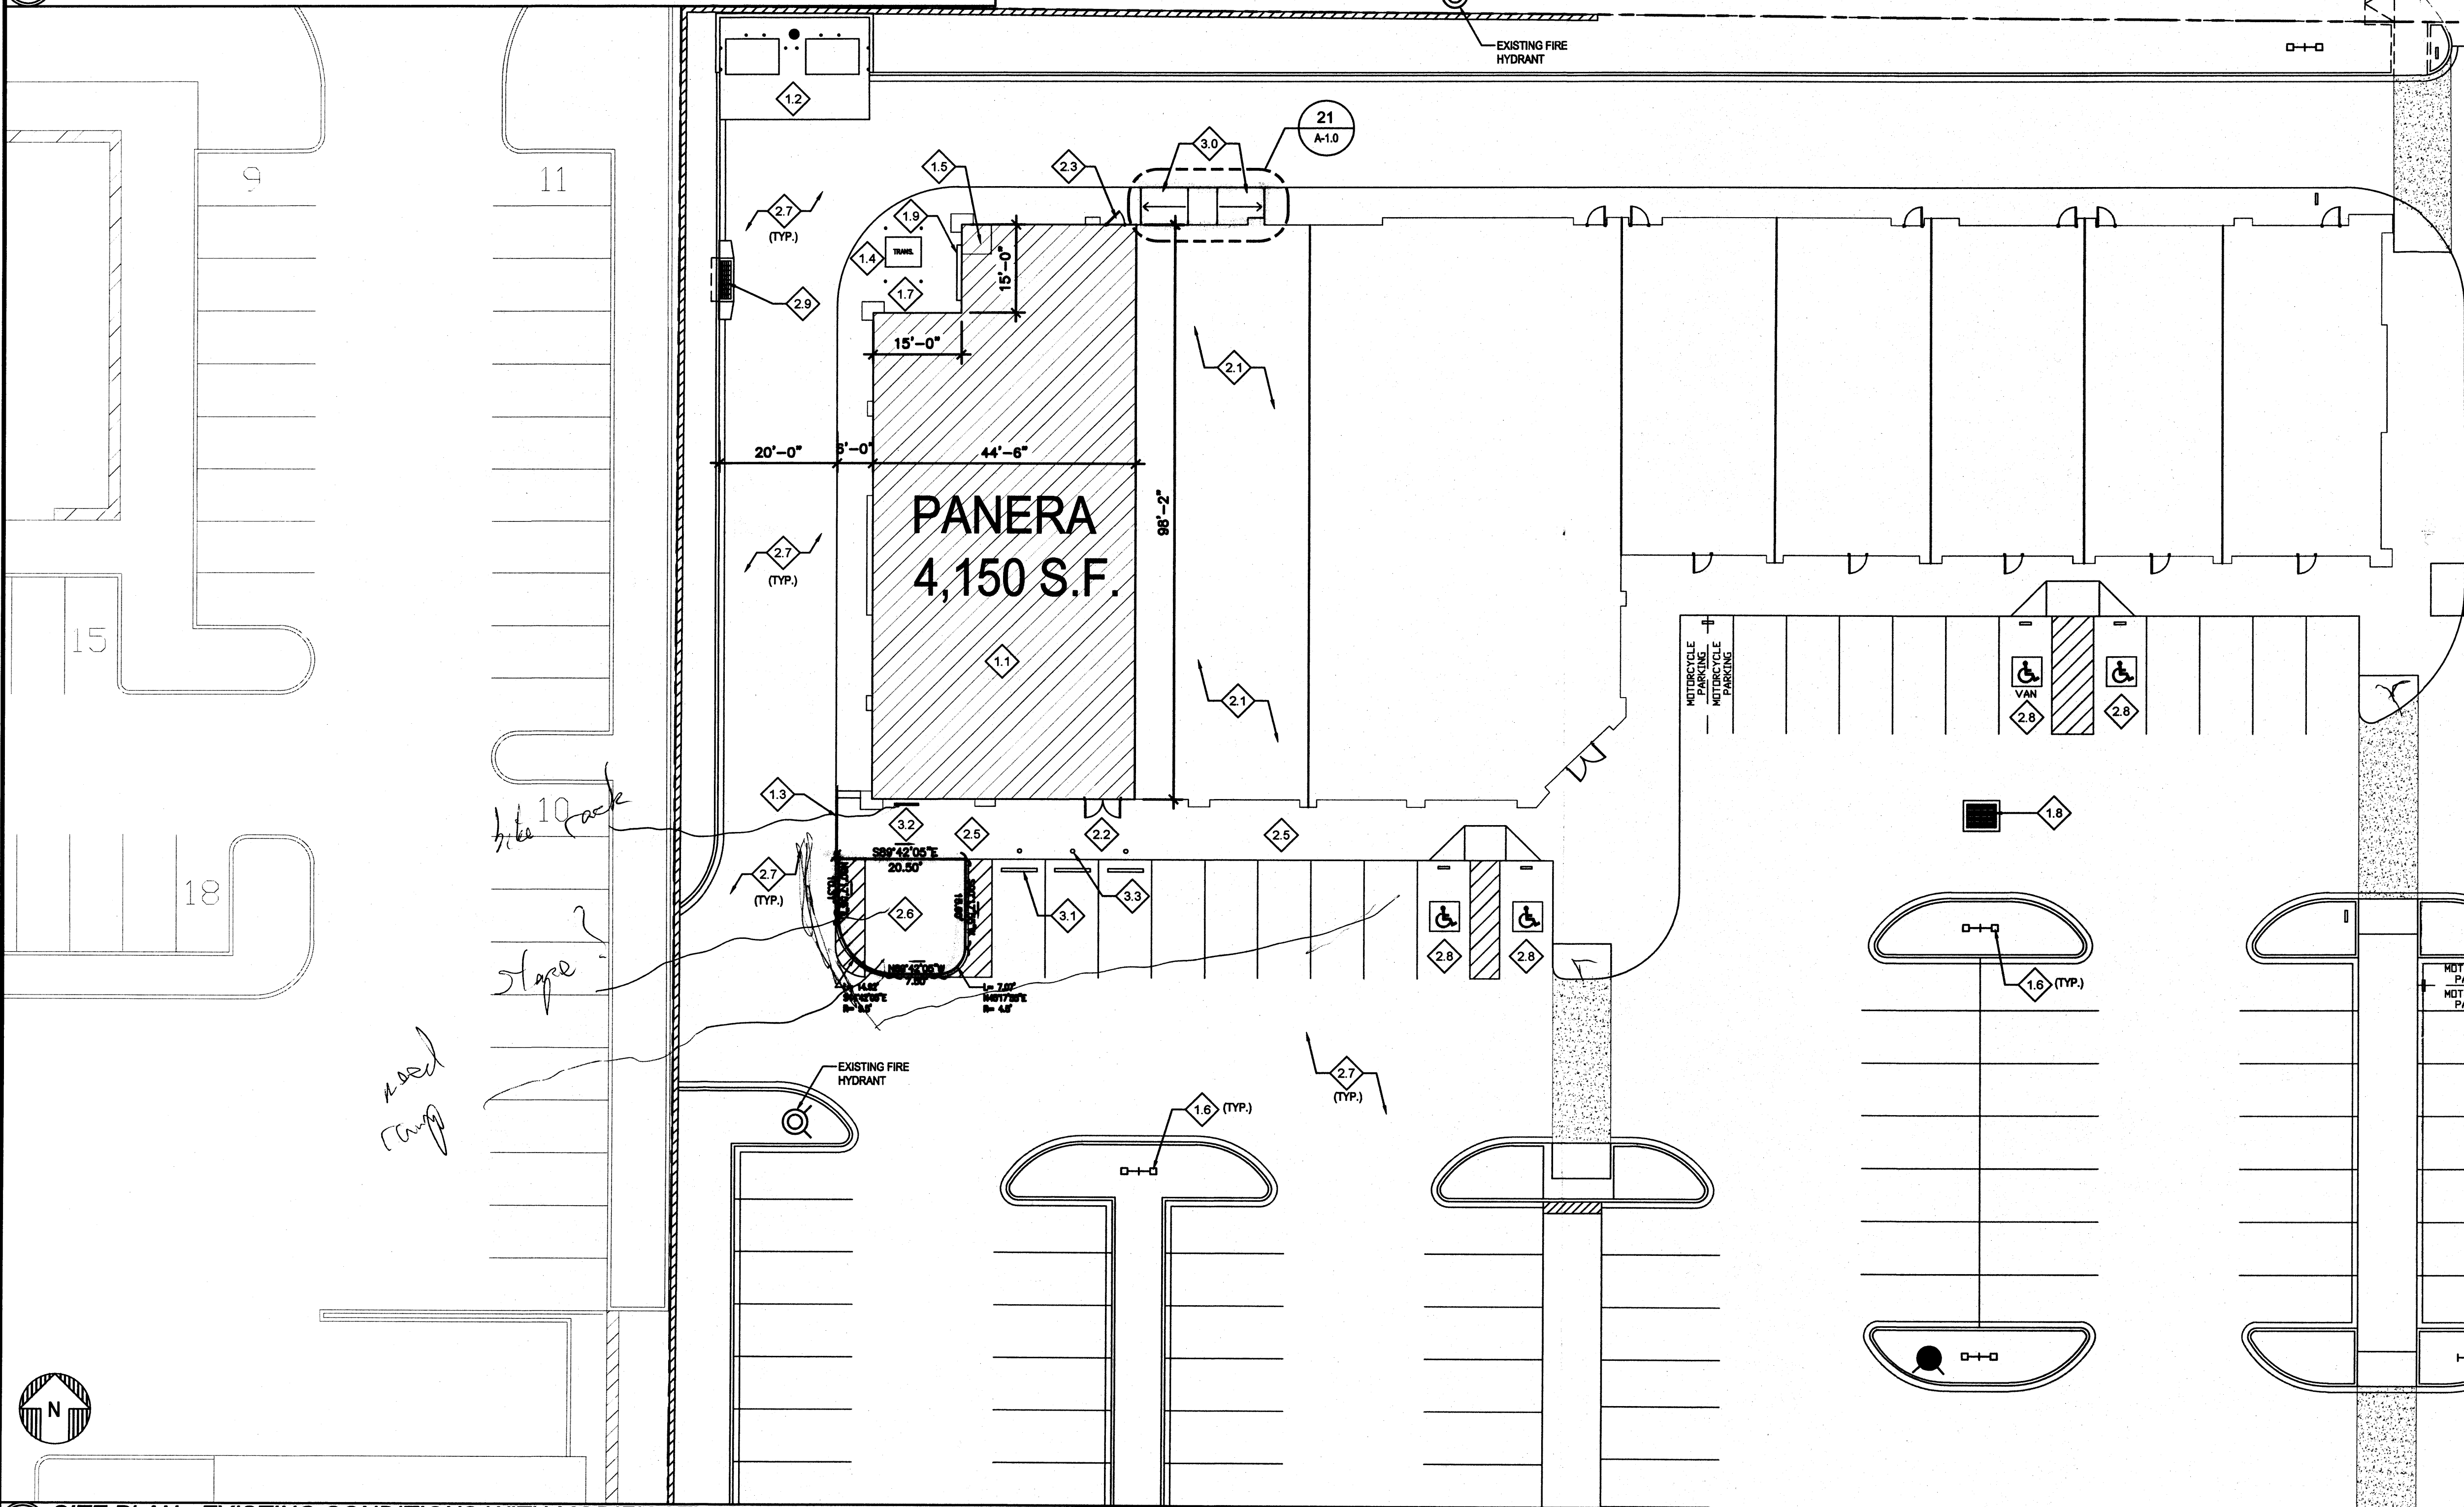


4 KEY PLAN
SCALE: NTS

24 SITE PLAN - EXISTING CONDITIONS WITH MODIFICATIONS
SCALE: 1/16"=1'-0"

BAKERY CAFE:
#610048

SYSTEM: SS (CALM)
PROTOTYPE UPDATE: 2011-01

DESIGN CONSULTANT:
ARCUSION
INCORPORATED
10000 10TH AVENUE NE
SUITE 1000
ALBUQUERQUE, NM 87113
TEL: (505) 415-3400 FAX: (505) 415-3200

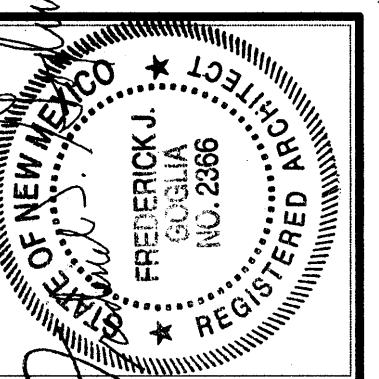

PARADISE BAKERY & CAFE #610048
HOLLY PLAZA - 6650 HOLLY AVE. NE
ALBUQUERQUE, NM 87113

PERMIT / BID SET
ISSUED 07.13.11

REVISION	BUILDING & OWNER COMMENTS	DATE
		08/07/11

ISSUE DATE: 07.13.11
PROJECT NUMBER: 110396
DRAWN BY: BTM
DPM: Michael Rolvas
DM: Caryl Scobbie
CPM: Keith Kolchey

SHEET NO:
A-1.0
SITE PLAN
NEW CONSTRUCTION
FILE: 010048-A-1.0.dwg

3 numbers