


ADMINISTRATIVE AMENDMENT

FILE # _____ **PROJECT #** _____

APPROVED BY

DATE

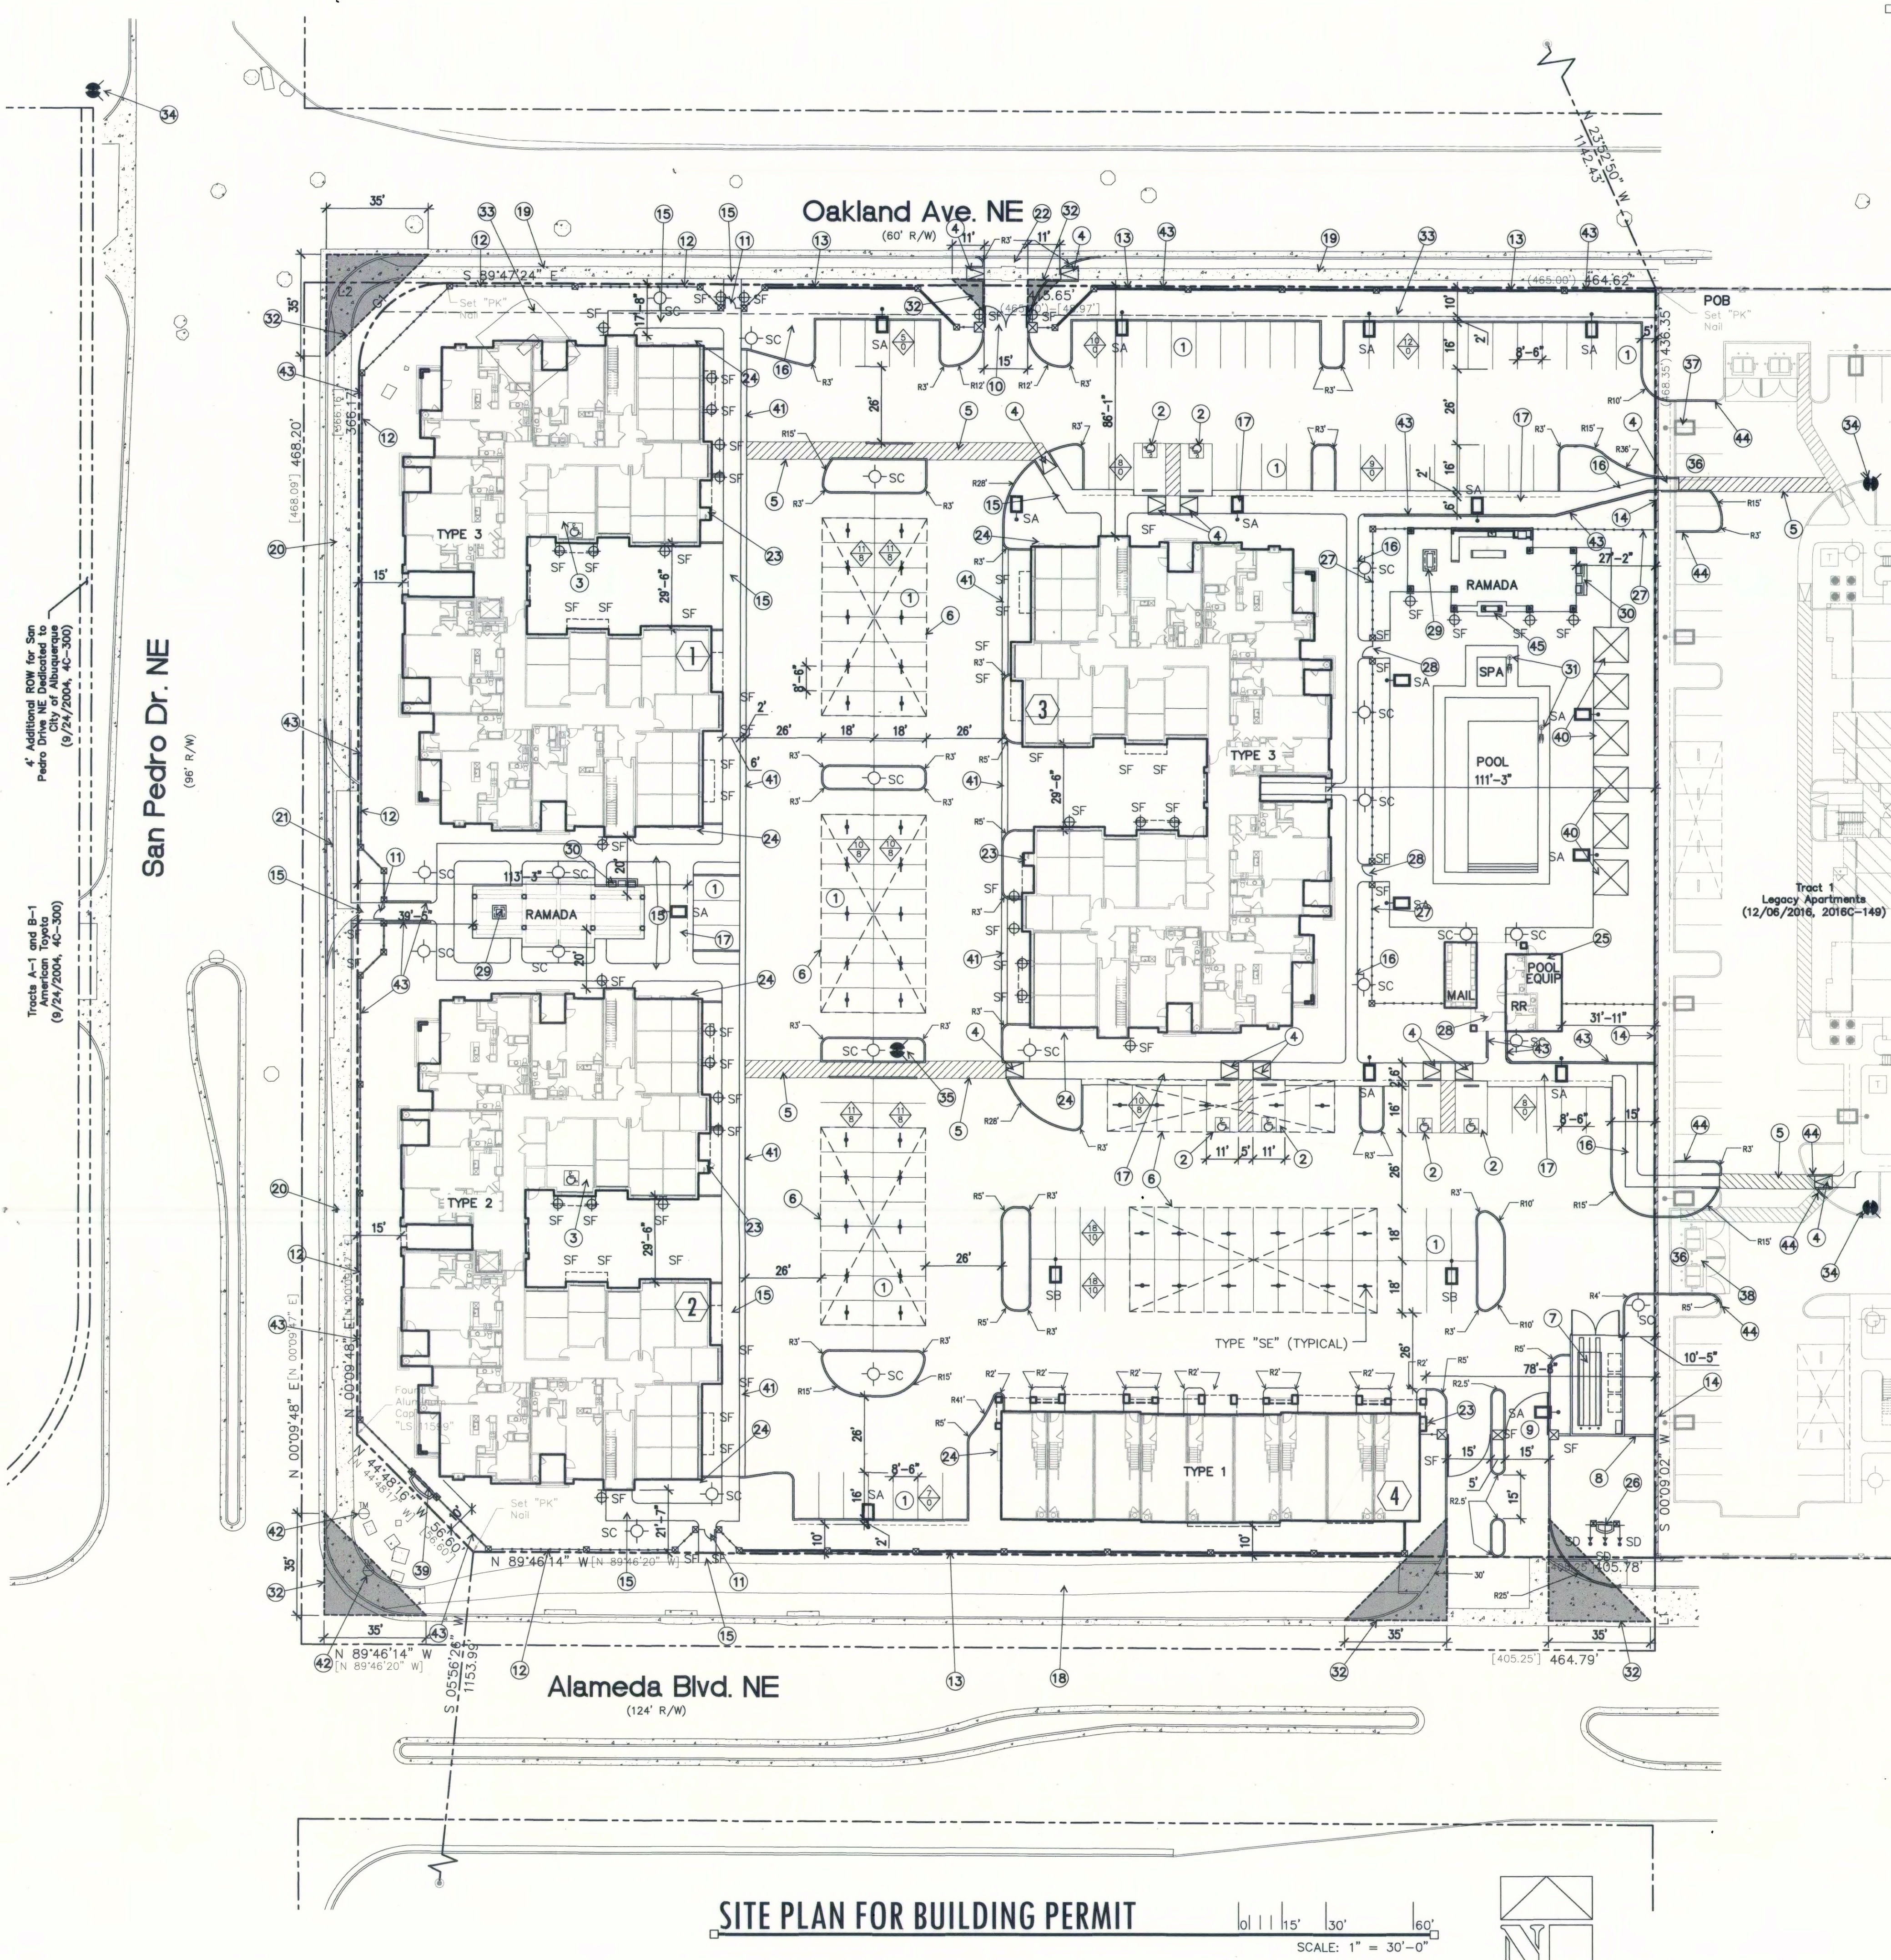

KEYNOTES ①

- 8.5'x18' PARKING SPACE WITH 2' OVERHANG, TYPICAL, SEE DETAIL 01/A1.20.
- 11'x18' ACCESSIBLE PARKING SPACE WITH 2' OVERHANG, SEE DETAIL 05/A1.20.
- ACCESSIBLE GARAGE SPACE.
- ACCESSIBLE CURB RAMP, SEE DETAIL 08/A1.20.
- ACCESSIBLE DRIVEWAY CROSSING WITH SCORED CONCRETE.
- INDICATES LOCATION OF CARPORT PARKING STRUCTURE, SEE DETAIL 06/A1.20.
- 39' O.U. YDS. TRASH COMPACTOR ENCLOSURE SURROUNDED BY 8' CMU WALL PAINTED TO MATCH BUILDINGS, SEE DETAIL 13/A1.20.
- 8' H. CMU WALL PAINTED TO MATCH BUILDINGS, SEE DETAIL 07/A1.20.
- RESIDENT ONLY REMOTE CONTROL ENTRY VEHICULAR GATE, SEE DETAIL 28/A1.21.
- EXIT ONLY VEHICULAR GATE, SEE DETAIL 44/A1.22.
- PEDESTRIAN ENTRY GATE, SEE DETAIL 23/A1.21.
- WROUGHT IRON PERIMETER VIEW FENCE, SEE DETAIL 17/A1.21.
- CMU/WROUGHT IRON COMBO PERIMETER FENCE, SEE DETAIL 17/A1.21.
- EXISTING CMU RETAINING WALL WITH WROUGHT IRON FENCE ON TOP. REMOVE AT NEW DRIVEWAYS AND SIDEWALK CONNECTIONS TO PHASE 1.
- 6' SIDEWALK CONNECTING TO PUBLIC WAYS AND CONNECTING BUILDINGS.
- 4' SIDEWALK, TYPICAL ON SITE.
- 8' SIDEWALK, TYPICAL AT PARKING, SEE DETAIL 09/A1.20.
- EXISTING 10' MULTI-USE ASPHALT TRAIL, 4' FROM STREET CURB AT ALAMEDA BLVD.
- EXISTING 6' SIDEWALK DETACH 6' FROM STREET CURB AT OAKLAND AVE.
- EXISTING 6' SIDEWALK DETACH 3' FROM STREET CURB AT SAN PEDRO DR.
- REMOVE EXISTING DRIVEWAY AND REPLACE WITH NEW CURB AND SIDEWALK TO MATCH EXISTING.
- NEW CURB CUT DRIVEWAY.
- FIRE RISER LOCATION, SEE BUILDING PLANS, ALL BUILDINGS SHALL HAVE PIV.
- ELECTRIC SERVICE LOCATION.
- POOL EQUIPMENT ROOM.
- MONUMENT SIGN NEXT TO ALAMEDA ENTRY DRIVE, SEE DETAIL 29/A1.21.
- WROUGHT IRON POOL FENCE, SEE DETAIL 18 & 19/A1.21.
- POOL ENTRY GATE, SEE DETAIL 24/A1.21.
- FIRE PIT, SEE DETAIL 32/A1.22.
- GAS GRILLS, SEE DETAIL 38/A1.22.
- POOL LIFT, SEE DETAIL 43/A1.22.
- SIGHT VISIBILITY, LANDSCAPING, FENCING AND SIGNING WILL NOT INTERFERE WITH CLEAR SIGHT REQUIREMENTS, THEREFORE, SIGNS, WALLS, TREES, AND SHRUBBERY BETWEEN 3 AND 8 FEET TALL (AS MEASURED FROM THE GUTTER PAN) WILL NOT BE ACCEPTABLE IN THE CLEAR SIGHT TRIANGLE.
- EXISTING 10' PNM EASEMENT (1/13/2017, DOC. NO. 2007003527).
- EXISTING FIRE HYDRANT.
- NEW FIRE HYDRANT.
- DRIVEWAY CONNECTION TO EXISTING PHASE 1 PROJECT. REMOVE EXISTING CMU WALL AS NEEDED.
- RELOCATE EXISTING LIGHT POLE.
- REMOVE EXISTING TRASH ENCLOSURE.
- MONUMENT SIGN AT SWC, SEE DETAIL 30/A1.21.
- POOL CABANA, SEE DETAIL 35/A1.22.
- MOUNTABLE CURB "ESTATE TYPE" PER CITY DETAIL 2415A, SEE DETAIL 42/A1.22.
- EXISTING TRAFFIC MAST.
- NEW RETAINING WALL PER GRADING PLANS.
- CONNECT TO EXISTING CURB ON PHASE 1.
- VENT-LESS 2-SIDED GAS FIREPLACE.

UNIT MIX

	UNIT TYPE												UNITS/BLDG	NO. BLDGS	TOTAL UNITS
	S1	A1	A2	A3	B2	B2m	B2H	B4	B5	TB1	TB1m1	TB1m2			
LIVABLE	587	728	768	768	768	1,194	1,216	1,216	1,242	1,286	1,330	1,330			
STOR/GAR	23	13	26	26	26	22	22	22	15	501	517	533			
PAT/BAL	60	59	67	67	67	57	57	57	57	56	56	68			
BLDG TYPE 1	6	6	4							5	2	2	8	1	8
BLDG TYPE 2	6	6	4		4	3	4	1	8	6			42	1	42
BLDG TYPE 3	6	6	3	1	4	4	4		6	6			42	2	84
TOTAL	18	18	10	2	12	11	12	1	24	18	5	2	4	135	

NOTES:

- ALL UNITS IN BLDGS TYPE 2 & 3 ARE TO MEET ANSI TYPE 'B' UNIT REQUIREMENTS.
- 26% TOTAL UNITS ARE REQUIRED TO MEET ANSI TYPE 'A' (135x.02=2.7 PROVIDED: 3)
- UNIT IN BLDG TYPE 1 ARE MULTISTORY UNITS AND ARE EXEMPT FROM ANSI REQUIREMENTS.

LEGEND

- PROPERTY LINE
- BUILDING NUMBER
- TYPE 2 BUILDING TYPE
- No. OF PARKING SPACES
- No. OF COVERED SPACES
- ACCESSIBLE PARKING AND ANSI TYPE 'A' DWELLING UNIT
- FIRE HYDRANT
- LIGHTING LEGEND
- TYPE 'SA'. 18' TALL POLE LIGHT. TYPE III DISTRIBUTION. FULLY CUT-OFF
- TYPE 'SB'. 18' TALL POLE LIGHT. TYPE V DISTRIBUTION. FULLY CUT-OFF
- TYPE 'SC'. 7' TALL POLE LIGHT.
- TYPE 'SD'. WALL MOUNTED SIGN LED LIGHT WITH GLARE SHIELD AND 36" LONG STEM.
- TYPE 'SE'. CARPORT LIGHT. 4 FT. FLUORESCENT STRIP.
- TYPE 'SF'. WALL SCONCE AT 6'-6" B.O.F. ADA COMPLIANT.
- TYPE 'SG'. 18' TALL POLE LIGHT. TYPE III DISTRIBUTION. FULLY CUT-OFF.
- B.O.F. - HEIGHT IS MEASURED FROM BOTTOM OF FIXTURE OR FIXTURE LENS TO ABOVE FINISHED FLOOR.
- T.O.F. - HEIGHT MEASURED FROM TOP OF FIXTURE TO ABOVE FINISHED FLOOR.

PROJECT NUMBER:
Application Number:
This Plan is consistent with the specific Site Development Plan approved by the Environmental Planning Commission (EPC), dated _____ and the Findings and Conditions in the Official Notification of Decision are satisfied.
Is an Infrastructure List required? () Yes () No If yes, then a set of approved DRC plans with a work order is required for any construction within Public Right-of-Way or for construction of public improvements.

DRB SITE DEVELOPMENT PLAN SIGNOFF APPROVAL:
Traffic Engineering, Transportation Division
ABCWUA
Parks and Recreation Department
City Engineer
Solid Waste Management
Code Enforcement
DRB Chairperson, Planning Department

DEVELOPMENT DATA
SITE AREA: 4.4876 ACRES (195,479 S.F.)
ZONING: R-MH
BUILDING HEIGHT: 48 FT
DENSITY: 50.00 DU/ACRE
SETBACKS PROVIDED: SIDE (N) FRONT (W) SIDE (S) REAR (E)
BUILDINGS 17'-8" 15'-0" 10'-0" 31'-11"
PARKING 10'-0" 11'-3" 10'-0" 5'-0"


	MINIMUM ON-LOT USABLE OPEN SPACE REQUIRED AND PROVIDED			
	SF REQ.	# OF PER DU'S	TOTAL SF PROVIDED	TOTAL SF PROVIDED
1 BEDROOM	200	60	12,000	
2 BEDROOM	250	75	18,750	
PROVIDED SITE OPEN SPACE				67,433
PROVIDED BALCONY PRIVATE OPEN SPACE				9,000
TOTAL (excess of 45,683 SF)	135	30,750	76,433	

GENERAL NOTES:

- ALL IMPROVEMENTS LOCATED IN THE RIGHT OF WAY SHALL BE INCLUDED ON A PUBLIC WORK ORDER.
- ALL SIDEWALKS, RAMPS (INCLUDING REQUIRED TRUNCATED DOMES) CURB CUTS, AND CURB AND GUTTER IN THE PUBLIC RIGHT-OF-WAY SHALL BE BUILT PER C.O.A. STANDARD DRAWINGS; SIDEWALK (2430), RAMPS (2440), CURB CUTS (2426), CURB AND GUTTER (2417A).
- GROUND MOUNTED MECHANICAL AND ELECTRICAL EQUIPMENT, INCLUDING TRANSFORMERS, ADJACENT TO A MAJOR FACADE SHALL BE SCREENED THROUGH THE USE OF WALLS, EARTH BERMS, DENSE EVERGREEN FOLIAGE OR OTHER ACCEPTABLE SCREENING DEVICE.

PARKING SPACE REQUIREMENTS		
	PARKING RATIO REQUIRED	PARKING SPACES
1.5 PARKING SPACES PER DWELLING UNIT	1.5	203
PHASE 1 PARKING LOST		6
Total Parking Spaces Required		209
OPEN PARKING PROVIDED		2
CARPORT PARKING PROVIDED		4
GARAGE PARKING PROVIDED		2
Total Parking Provided		8
Accessible Parking Required		8
OPEN ACCESSIBLE PARKING PROVIDED		4
CARPORT ACCESSIBLE PARKING PROVIDED		2
GARAGE ACCESSIBLE PARKING PROVIDED		2
Total Accessible Parking Provided		8
Bicycle Parking Required (10% OF REQUIRED OFF-STREET PARKING SPACES)		21
GARAGE		60
Total Bicycle Parking Provided		60


ADMINISTRATIVE AMENDMENT
FILE # 00834 PROJECT # 001280
Pricing calculation adjustments as shown.
See also SI-2020-00829.
RBrito 16 Sept 2020
APPROVED BY DATE

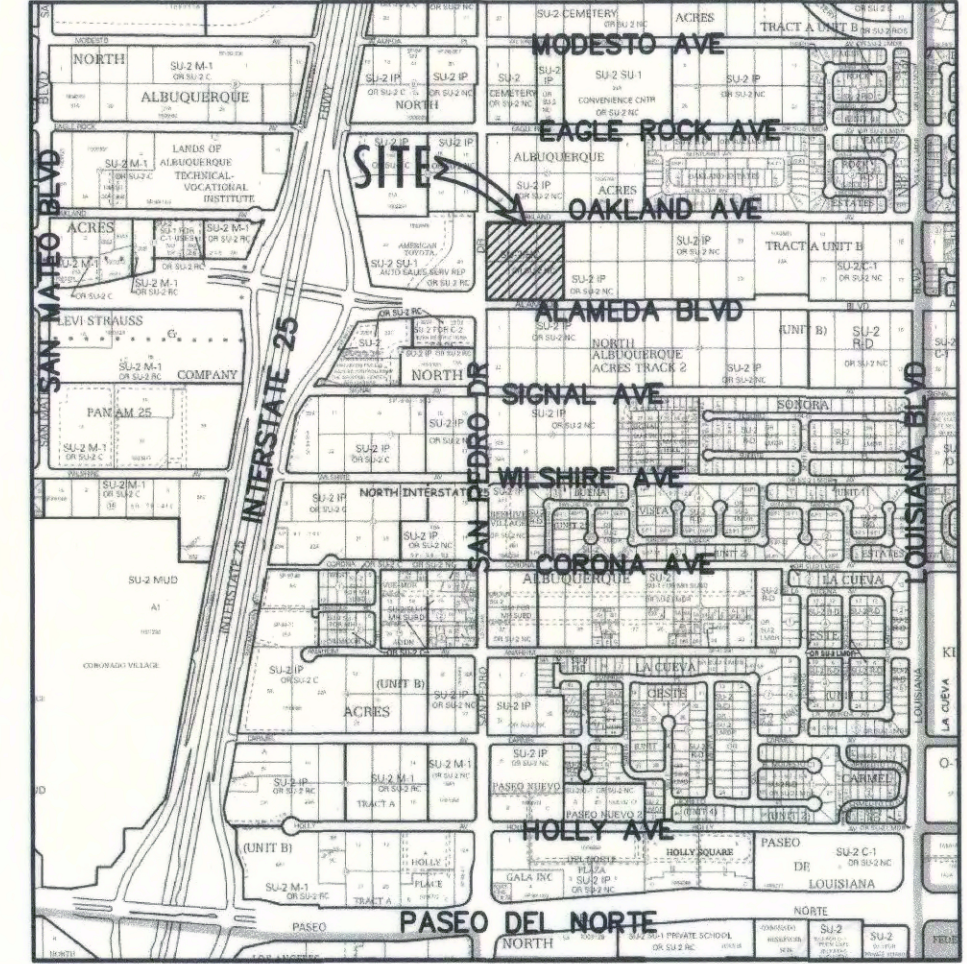

VICINITY MAP
NOT TO SCALE

MARKANA APARTMENTS - II
SAN PEDRO AND ALAMEDA
Albuquerque, New Mexico

Office of Rich Barber
ORB
Architecture, Inc.
WorldHQ@ORBArch.com

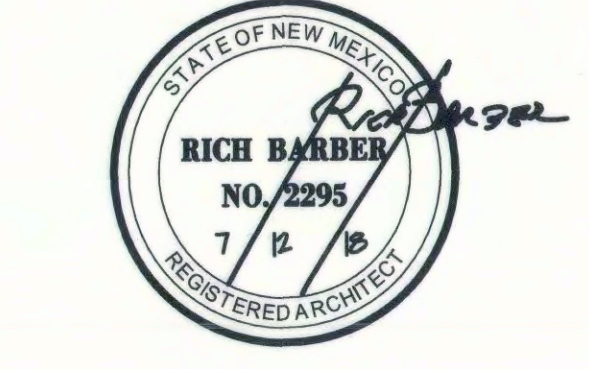



LEGACY HOSPITALITY

Amendment 04/22/2021:
Increased building height;
consistent with the RM-H Zone
As Built - Parking Count Revised
August 19/2020

DATE: JULY 12, 2018 ORB # 17-219

A1.10
SITE PLAN
FOR BUILDING PERMIT

FILE: F:\06\ORB Job Files\17-219_LH Legacy NAA Phase 2\CAD Files\Construction Documents\17219_A326_Bldg2_Elevs.dwg USER: jca DATE: Jun, 21 2018 TIME: 11:12 am

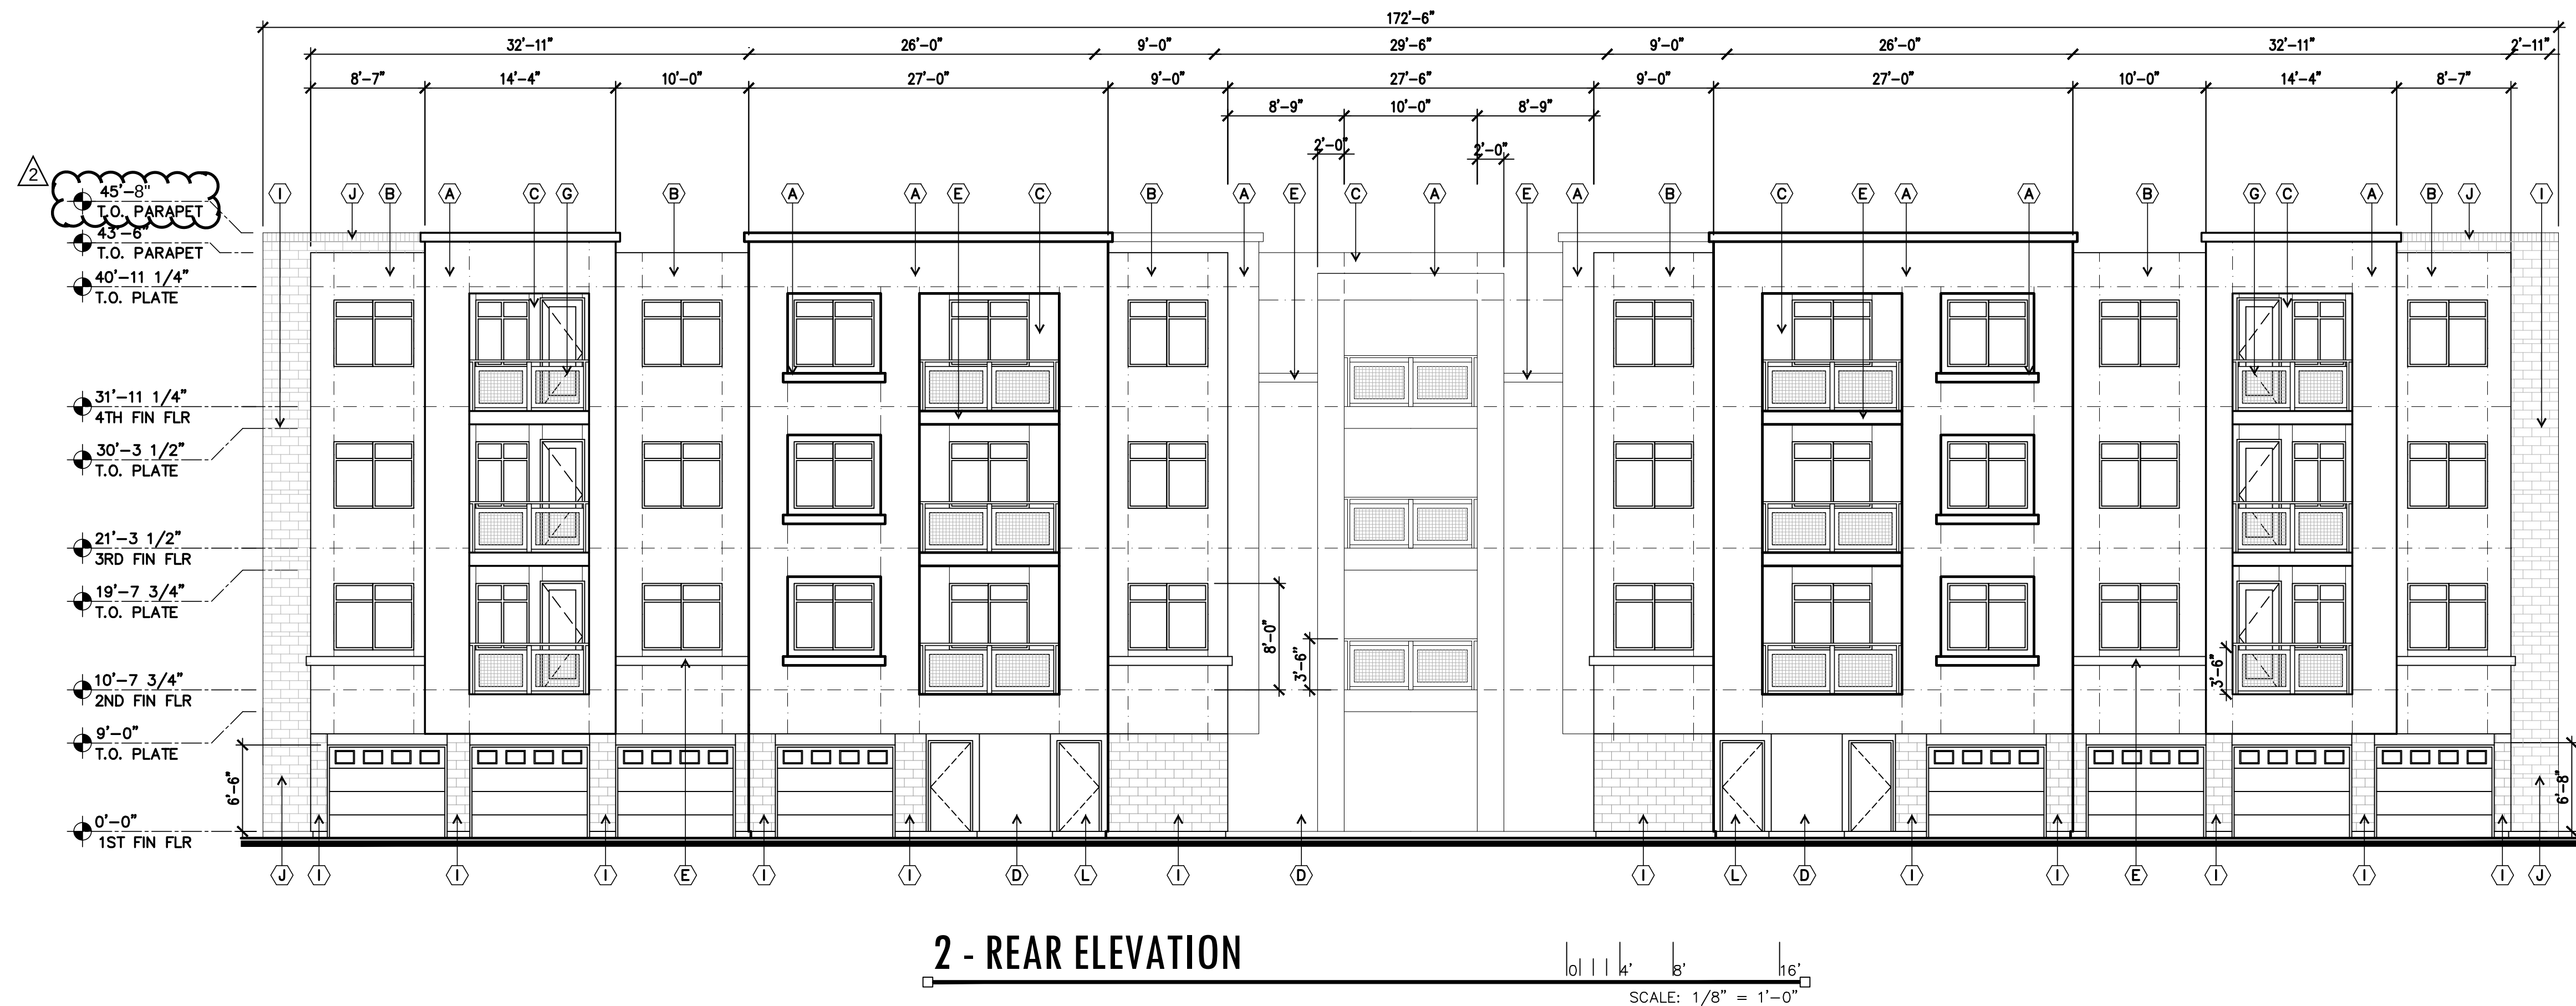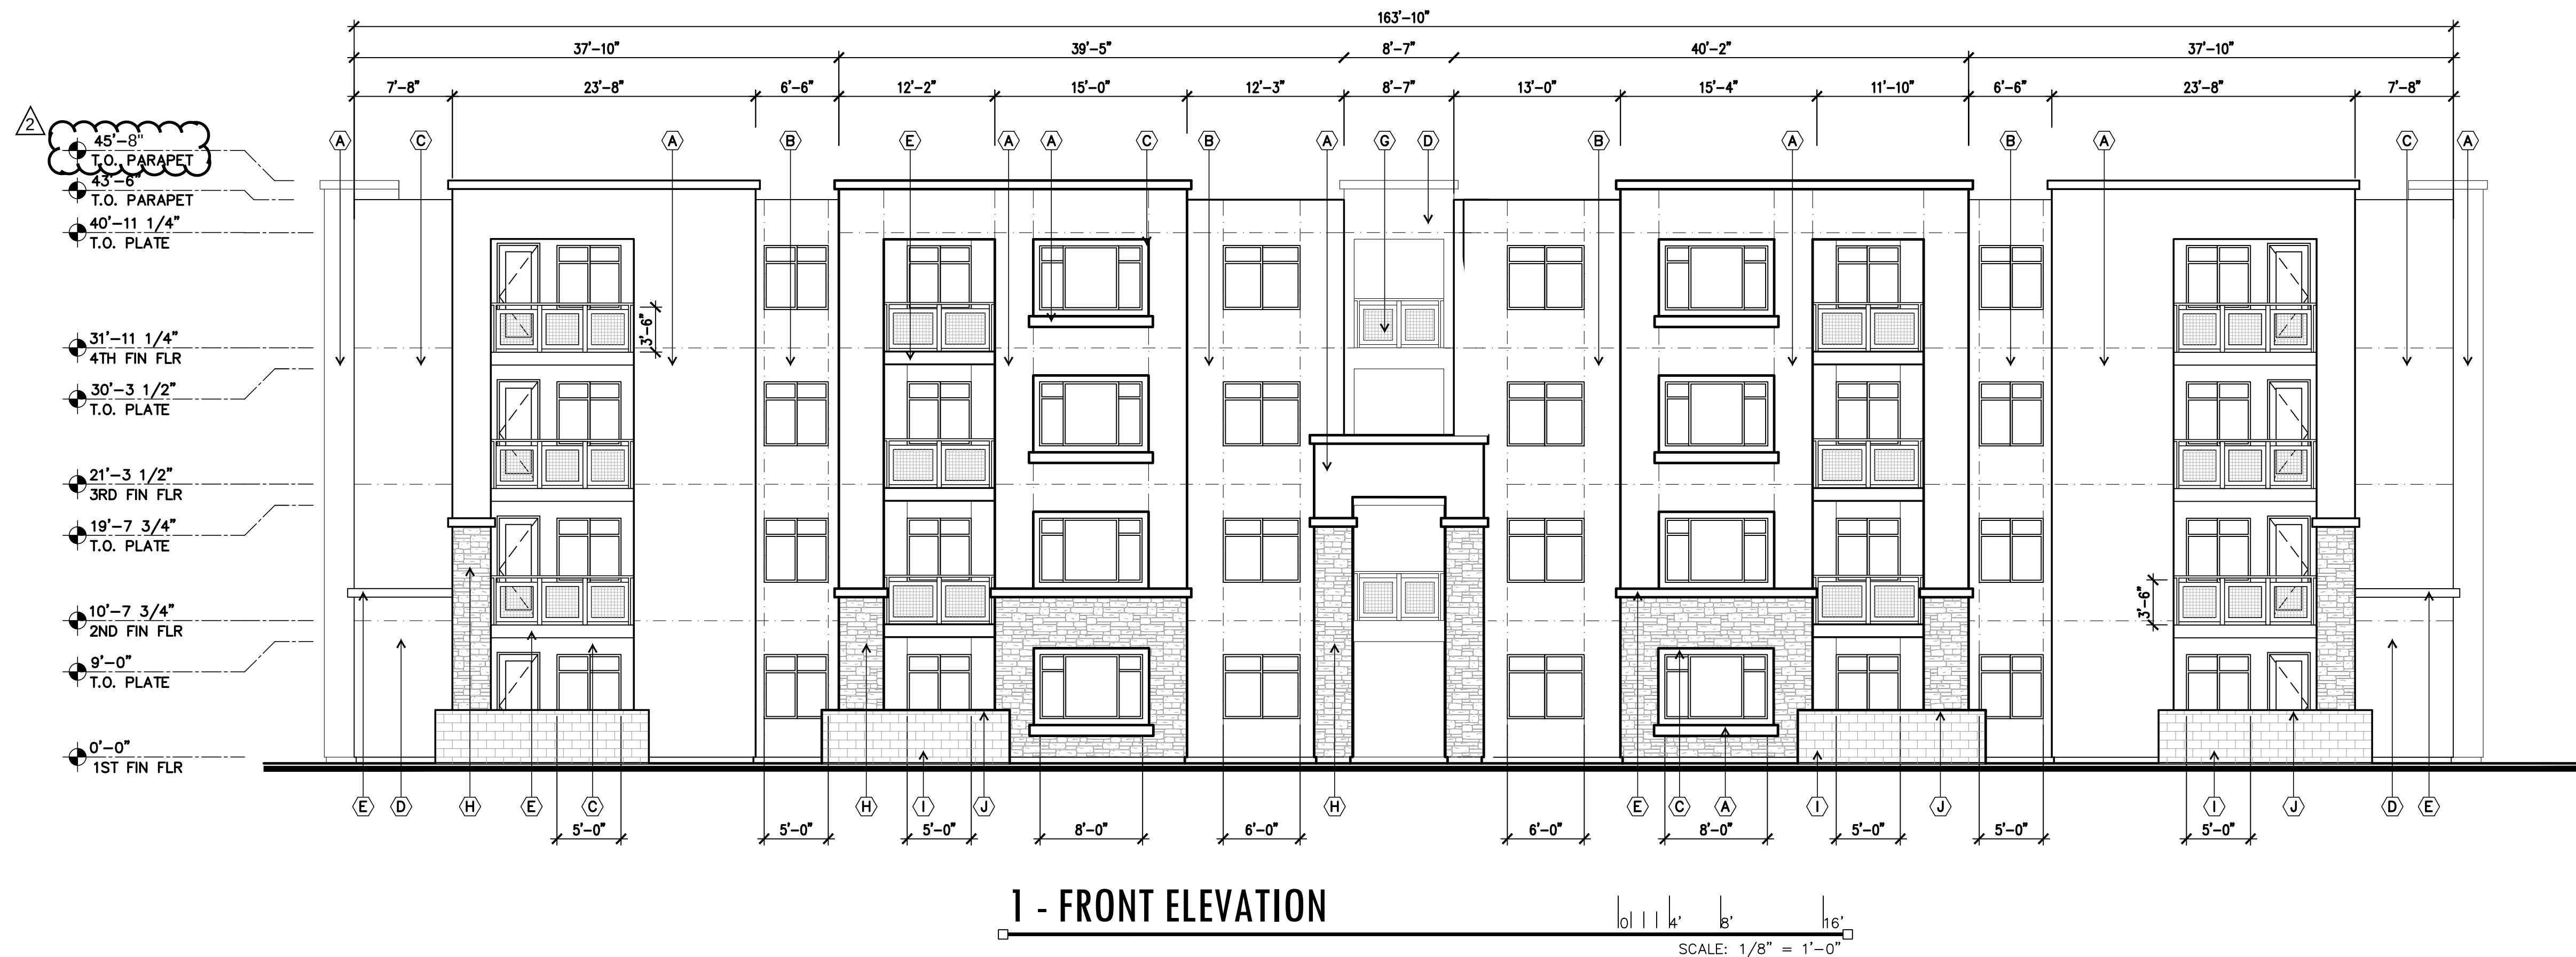


MATERIAL KEY NOTES:

- (A) STUCCO FINISH LIGHT BEIGE
(B) STUCCO FINISH DARK BEIGE
(C) STUCCO FINISH LIGHT GRAY
(D) STUCCO FINISH MEDIUM GRAY
(E) STUCCO FINISH DARK GRAY
(F) TILE ROOF
(G) RAILINGS DARK GRAY
(H) STONE VENEER
(I) EXPOSED LIGHT CMU
(J) EXPOSED DARK CMU
(K) WALL OPENING
(L) SERVICE DOOR, COLOR TO MATCH ADJACENT WALL

GENERAL NOTES:

1. ROOF MOUNTED EQUIPMENT SHALL BE SCREENED FROM THE ADJACENT PUBLIC RIGHT-OF-WAY BY PARAPET WALLS OR STRUCTURAL FEATURES THAT SHALL NOT EXCEED THE HEIGHT OF THE ROOF MOUNTED EQUIPMENT, IN ORDER TO ACHIEVE VERTICAL ARTICULATION. ARCHITECTURAL/STRUCTURAL FEATURES MAY EXCEED THE HEIGHT OF THE ROOF MOUNTED EQUIPMENT, BUT SHALL NOT, AT ANY POINT, EXCEED ONE-HALF (1/2) OF THE HEIGHT OF THE SUPPORTING WALL.
2. SKYLIGHTS AND ROOF VENTS ARE PERMITTED ONLY ON THE ROOF PLANE OPPOSITE THE PRIMARY STREET OR RIGHT-OF-WAY OR WHEN SHIELDED FROM PUBLIC RIGHT-OF-WAY VIEW BY THE BUILDING'S PARAPET.
3. GROUND MOUNTED MECHANICAL AND ELECTRICAL EQUIPMENT, INCLUDING TRANSFORMERS, ADJACENT TO A MAJOR FACADE SHALL BE SCREENED THROUGH THE USE OF WALLS, EARTH BERMS, DENSE EVERGREEN FOLIAGE OR OTHER ACCEPTABLE SCREENING DEVICE.

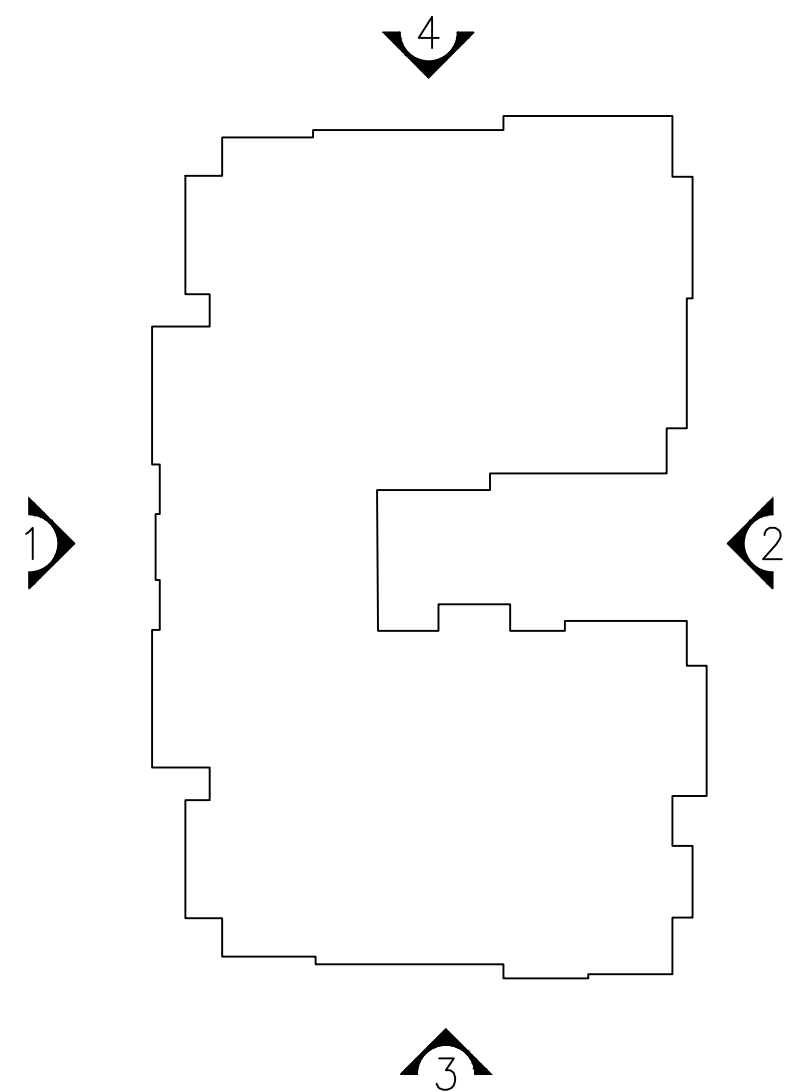


KEYMAP

MARKANA
APARTMENTS - II

SAN PEDRO AND ALAMEDA
Albuquerque, New Mexico

Office of Rich Barber
ORB
Architecture, LLC

WorldHQ@ORBArch.com

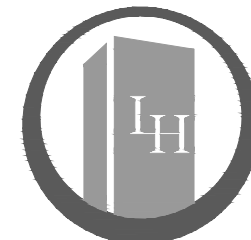

LEGACY HOSPITALITY

Amendment 04/22/2021:
Increased building height;
consistent with the RM-H Zone


DATE: JUNE 21, 2018

ORB # 17-219

A3.26

BUILDING TYPE 2 AND 3
ELEVATIONS

FILE: F:\06\ORB Job Files\17-219_LH_Legacy NAA Phase 2\CAD Files\Construction Documents\17219 A326 Blag2 Elev.dwg USER: jca DATE: Jun, 21 2018 TIME: 11:13 am


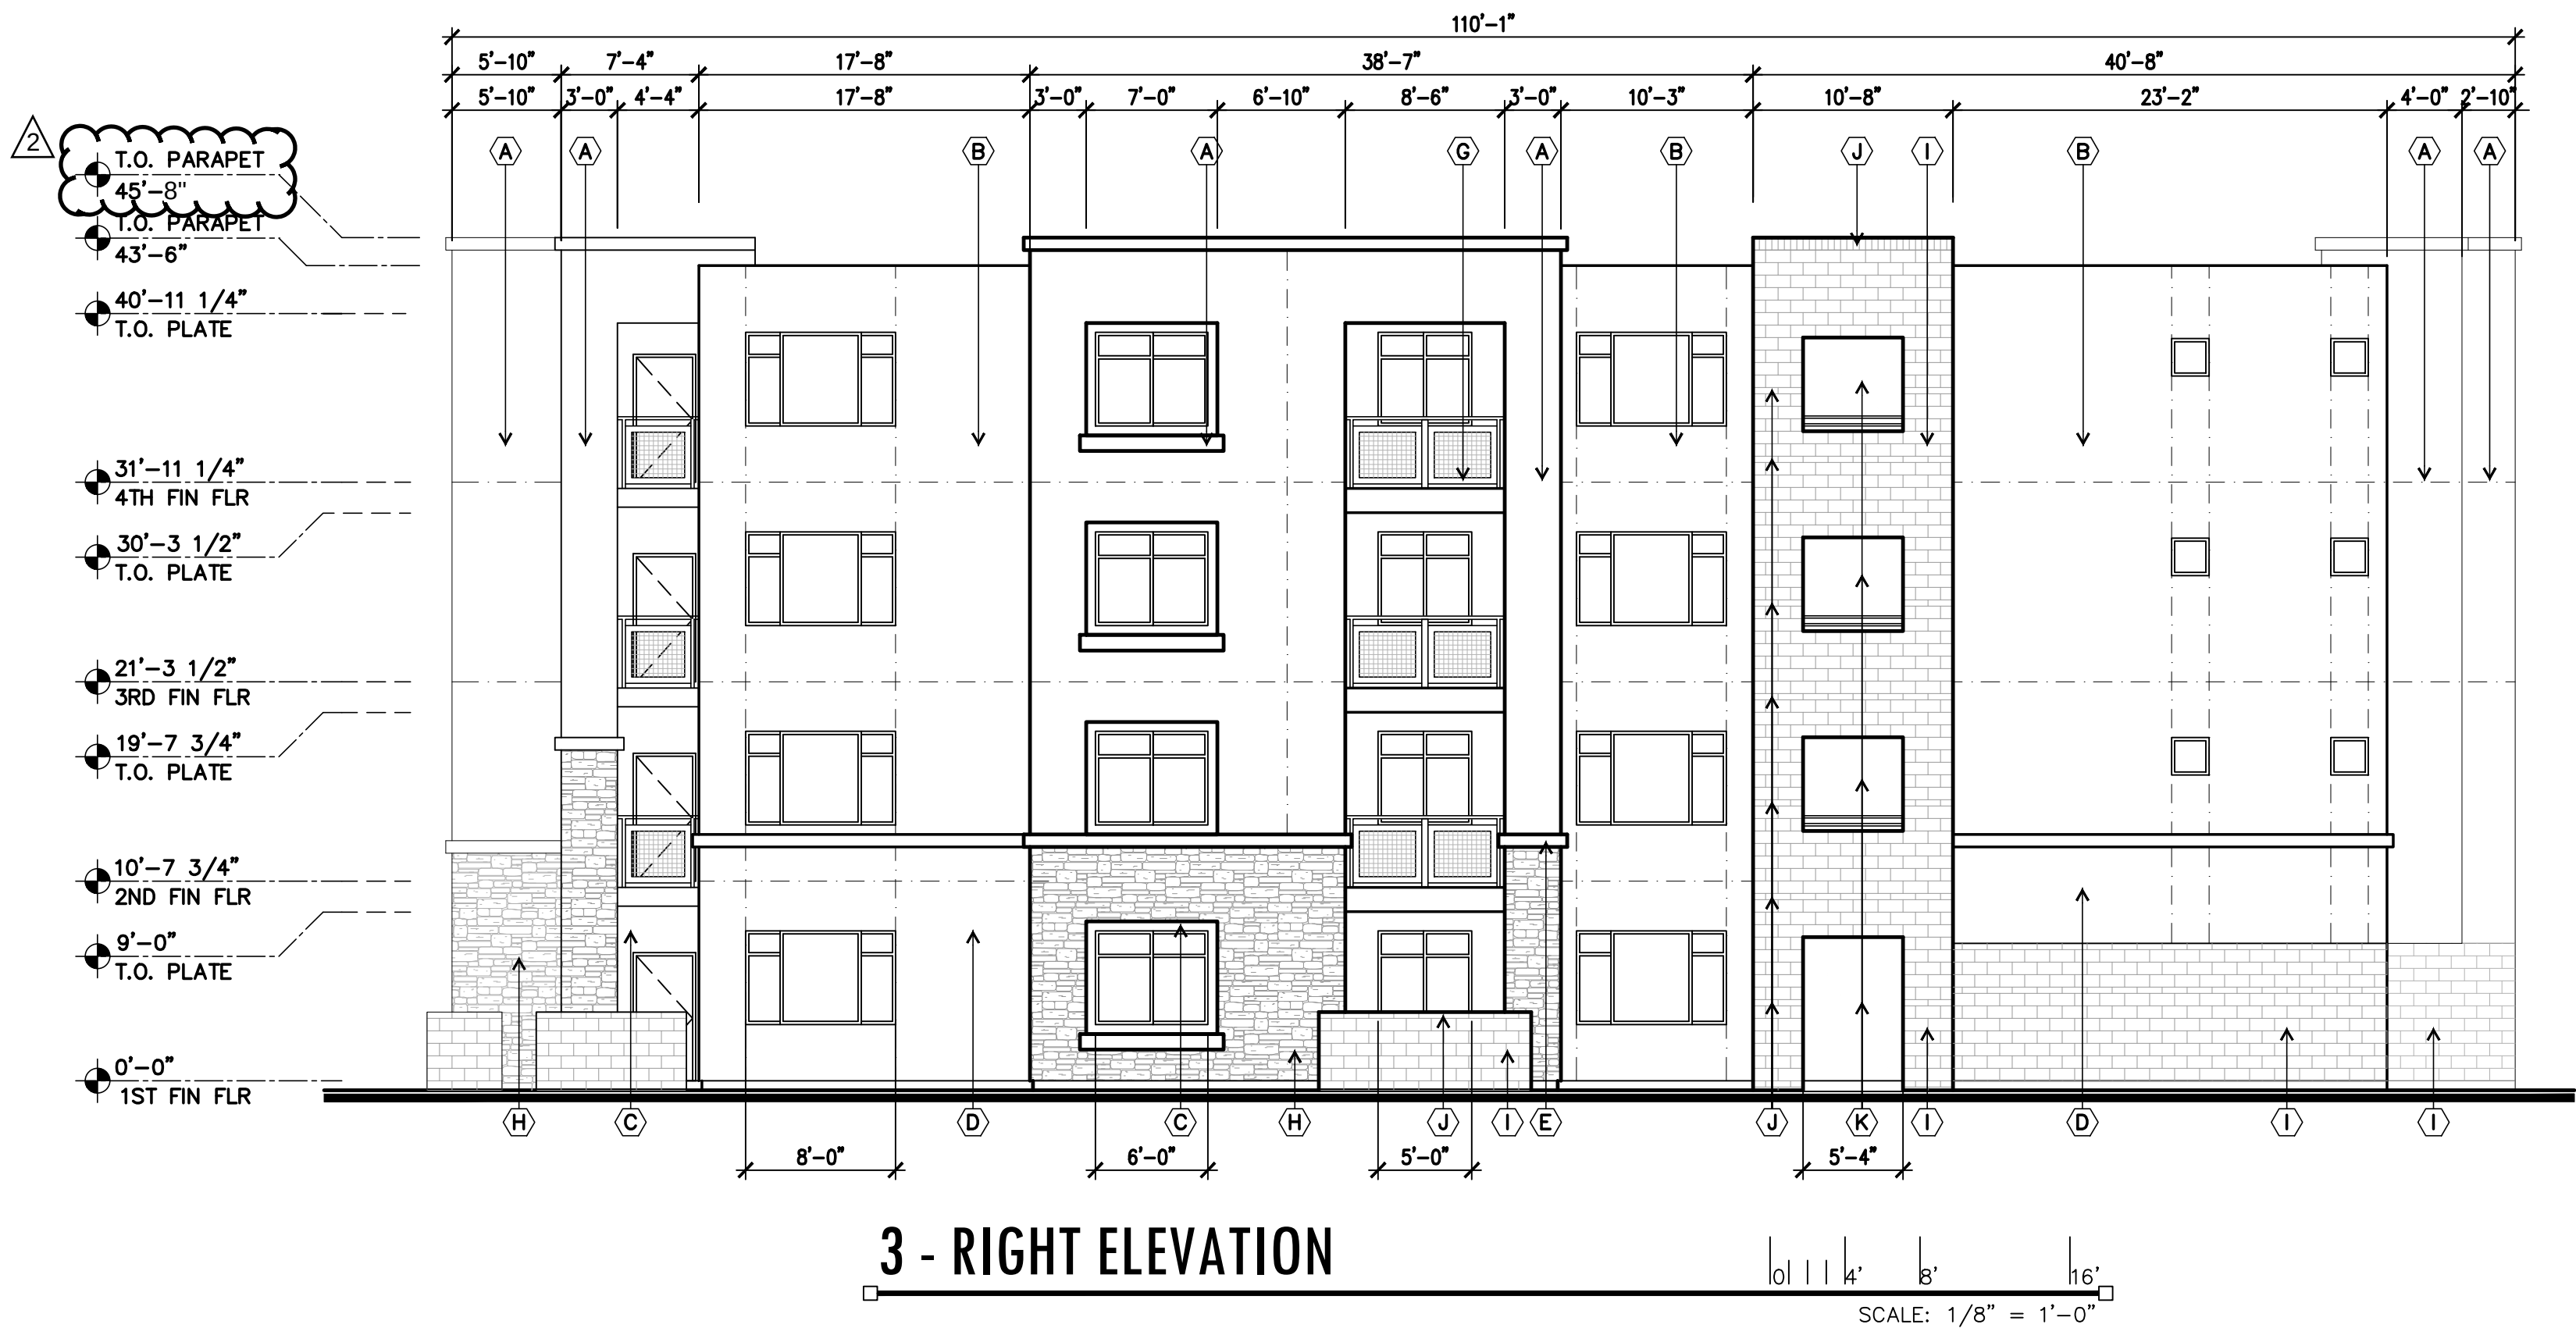


MATERIAL KEY NOTES:

- (A) STUCCO FINISH LIGHT BEIGE
- (B) STUCCO FINISH DARK BEIGE
- (C) STUCCO FINISH LIGHT GRAY
- (D) STUCCO FINISH MEDIUM GRAY
- (E) STUCCO FINISH DARK GRAY
- (F) TILE ROOF
- (G) RAILINGS DARK GRAY
- (H) STONE VENEER
- (I) EXPOSED LIGHT CMU
- (J) EXPOSED DARK CMU
- (K) WALL OPENING
- (L) SERVICE DOOR COLOR TO MATCH ADJACENT WALL

GENERAL NOTES:



- ROOF MOUNTED EQUIPMENT SHALL BE SCREENED FROM THE ADJACENT PUBLIC RIGHT-OF-WAY BY PARAPET WALLS OR STRUCTURAL FEATURES THAT SHALL NOT EXCEED THE HEIGHT OF THE ROOF MOUNTED EQUIPMENT. IN ORDER TO ACHIEVE VERTICAL ARTICULATION, ARCHITECTURAL/STRUCTURAL FEATURES MAY EXCEED THE HEIGHT OF THE ROOF MOUNTED EQUIPMENT BUT SHALL NOT, AT ANY POINT, EXCEED ONE-HALF (1/2) OF THE HEIGHT OF THE SUPPORTING WALL. SKYLIGHTS AND ROOF VENTS ARE PERMITTED ONLY ON THE ROOF PLANE OPPOSITE THE PRIMARY STREET OR RIGHT-OF-WAY OR WHEN SHIELDED FROM PUBLIC RIGHT-OF-WAY VIEW BY THE BUILDING'S PARAPET.
- GROUND MOUNTED MECHANICAL AND ELECTRICAL EQUIPMENT, INCLUDING TRANSFORMERS, ADJACENT TO A MAJOR FACADE SHALL BE SCREENED THROUGH THE USE OF WALLS, EARTH BERMS, DENSE EVERGREEN FOLIAGE OR OTHER ACCEPTABLE SCREENING DEVICE.

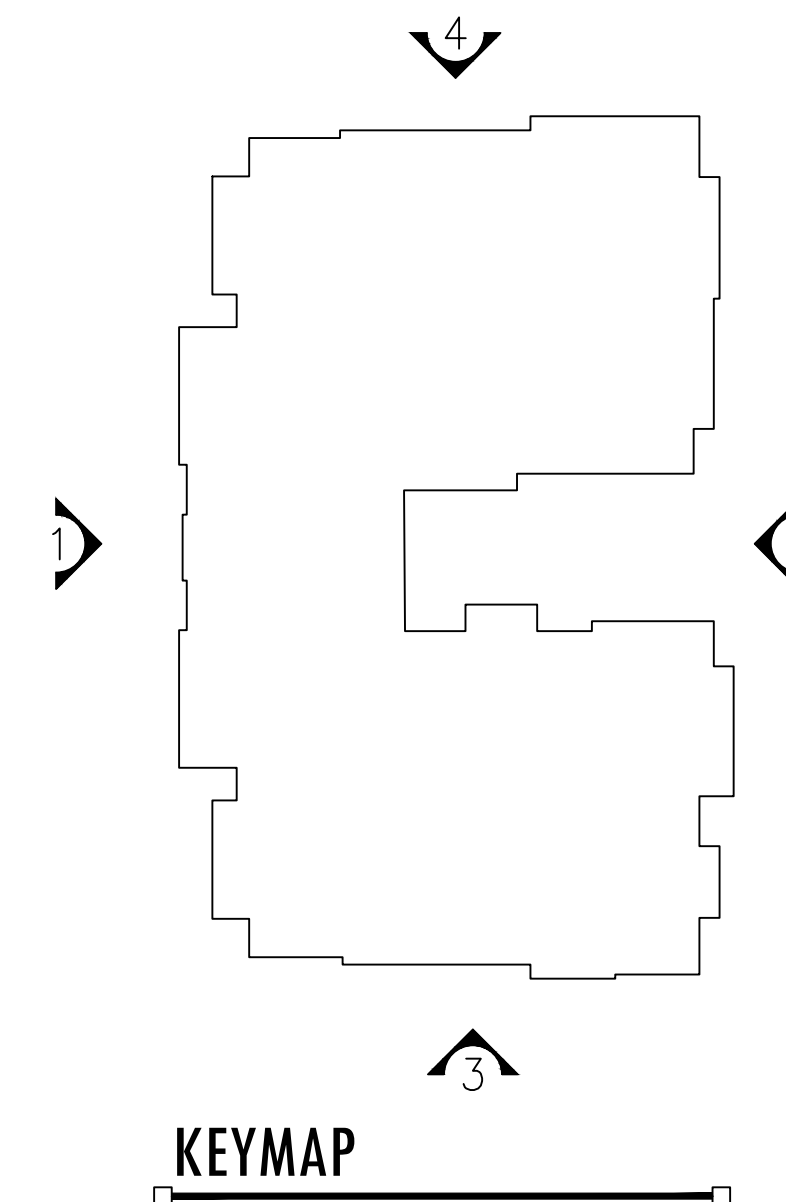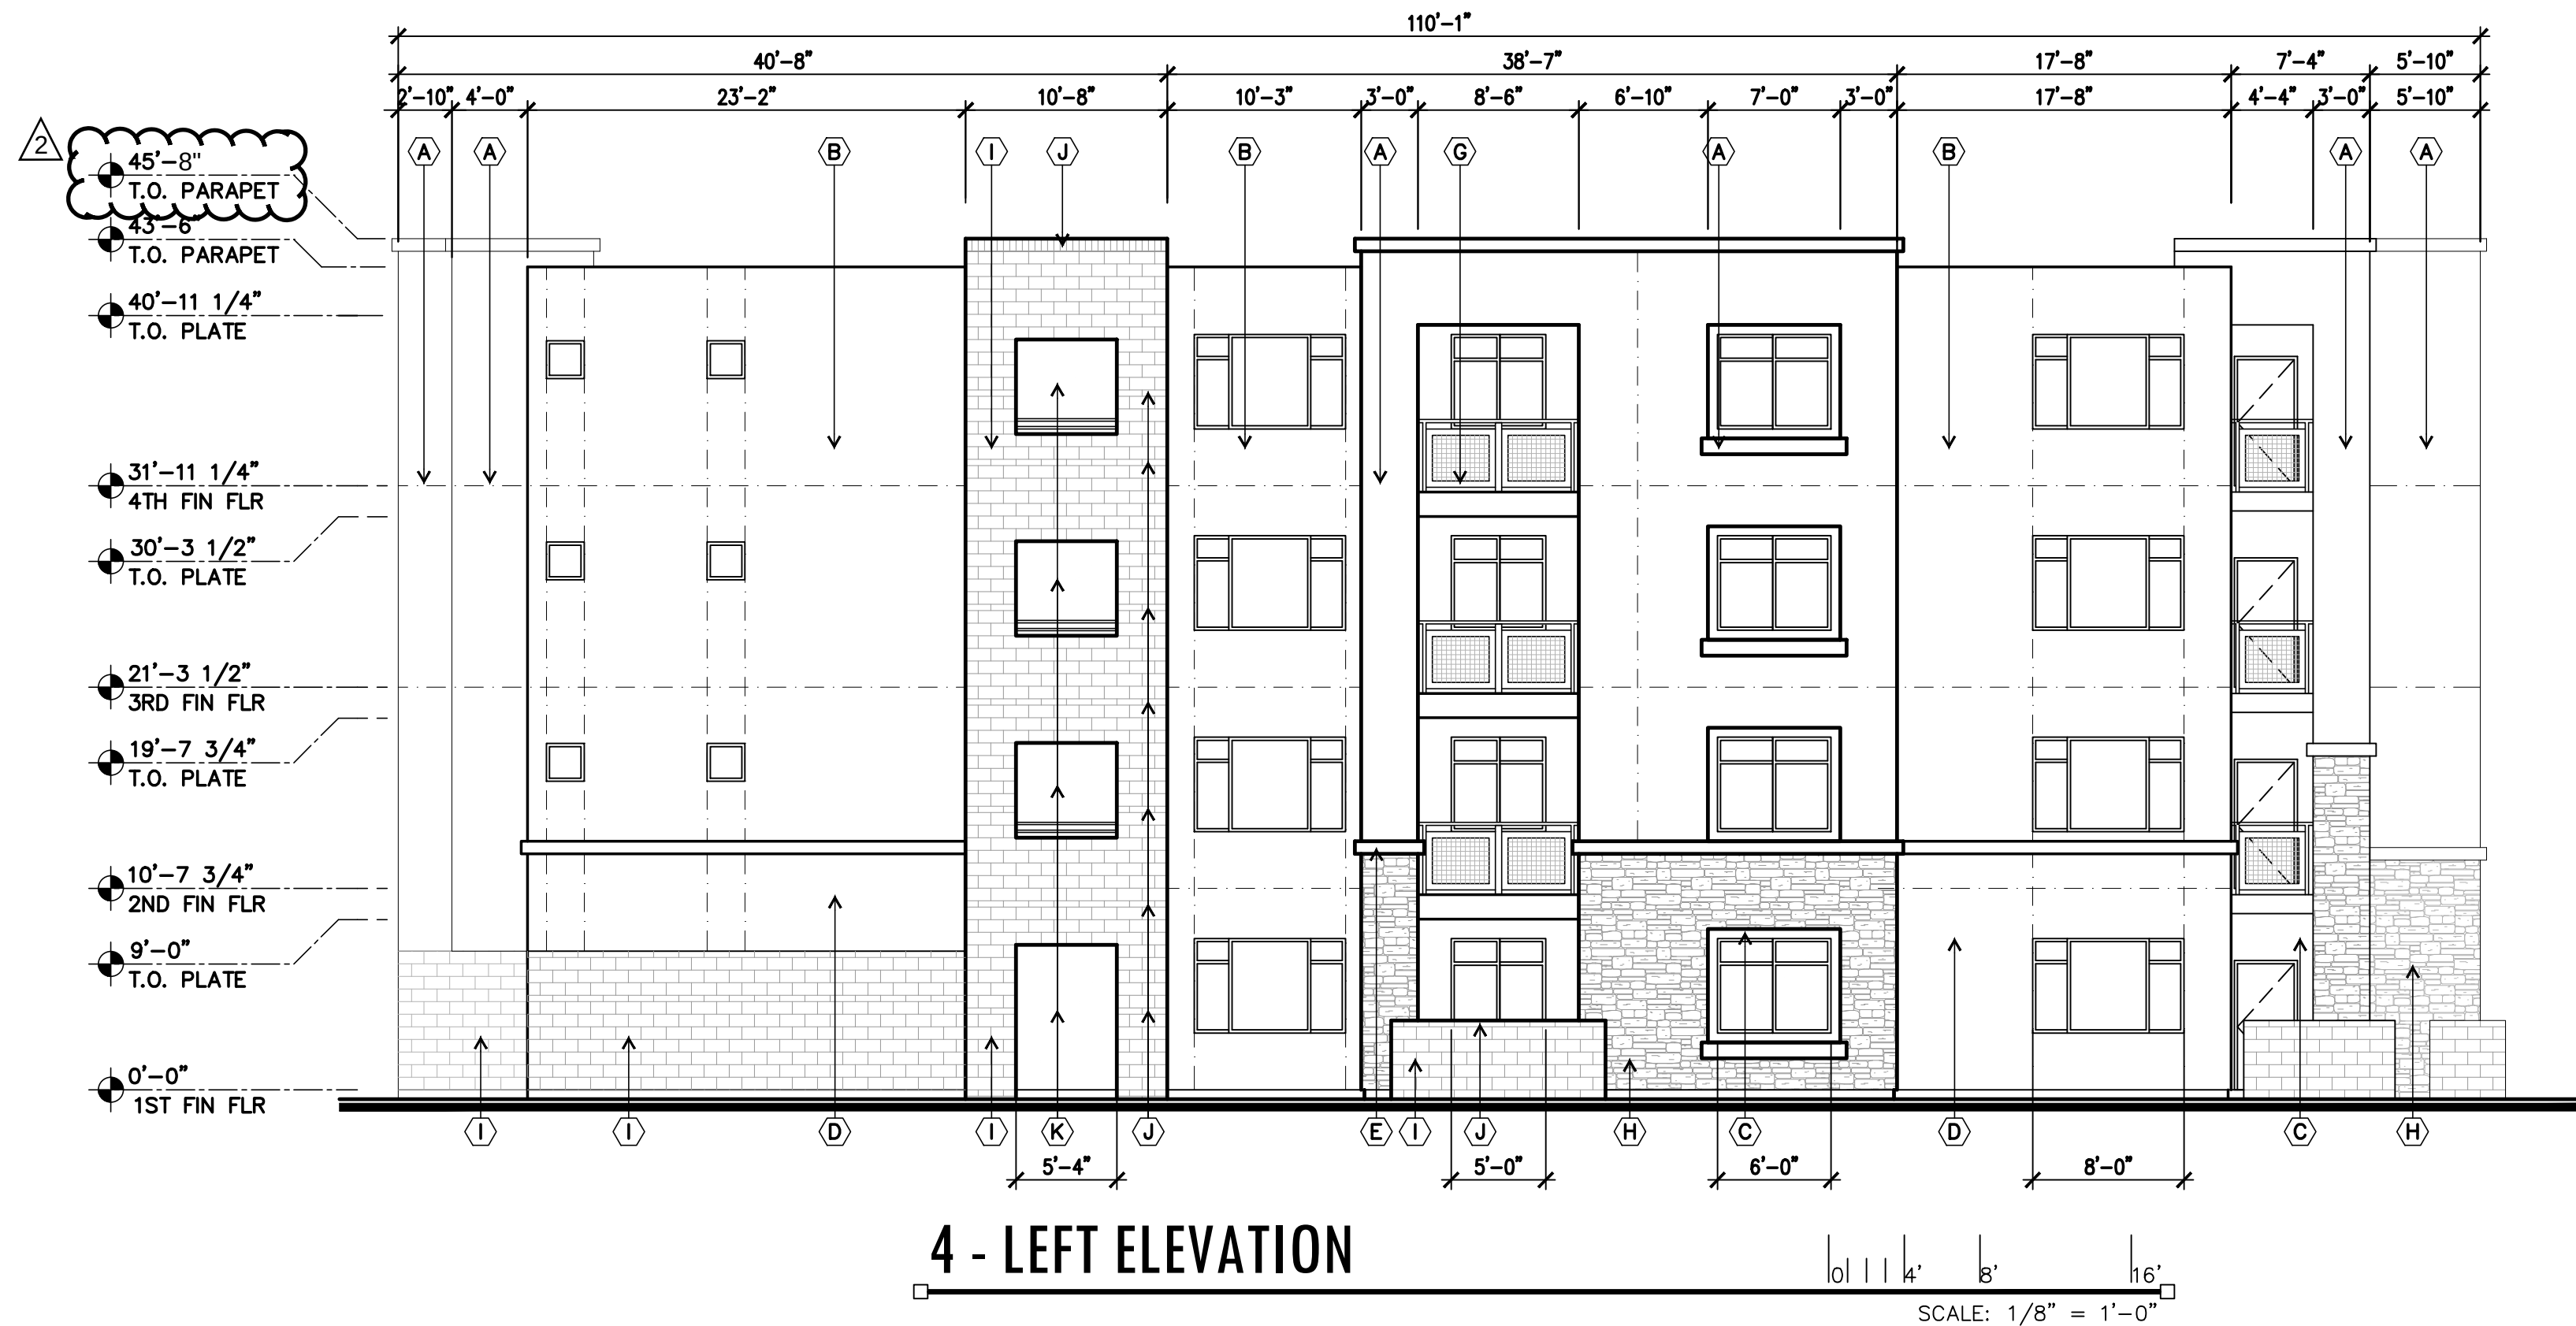

MARKANA
APARTMENTS - II

SAN PEDRO AND ALAMEDA
Albuquerque, New Mexico

Office of Rich Barber
Architecture, LLC
ORB
WorldHQ@ORBArch.com

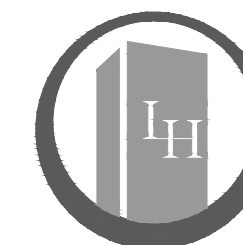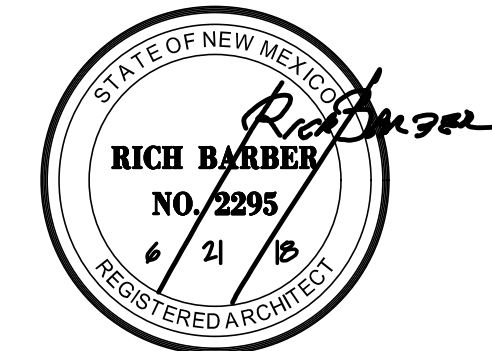

LEGACY HOSPITALITY

Amendment 04/22/2021:
Increased building height;
consistent with the RM-H Zone

DATE: JUNE 21, 2018 ORB # 17-219

A3.27

BUILDING TYPE 2 AND 3
ELEVATIONS