


ADMINISTRATIVE AMENDMENT

FILE # _____ PROJECT # _____


APPROVED BY

DATE

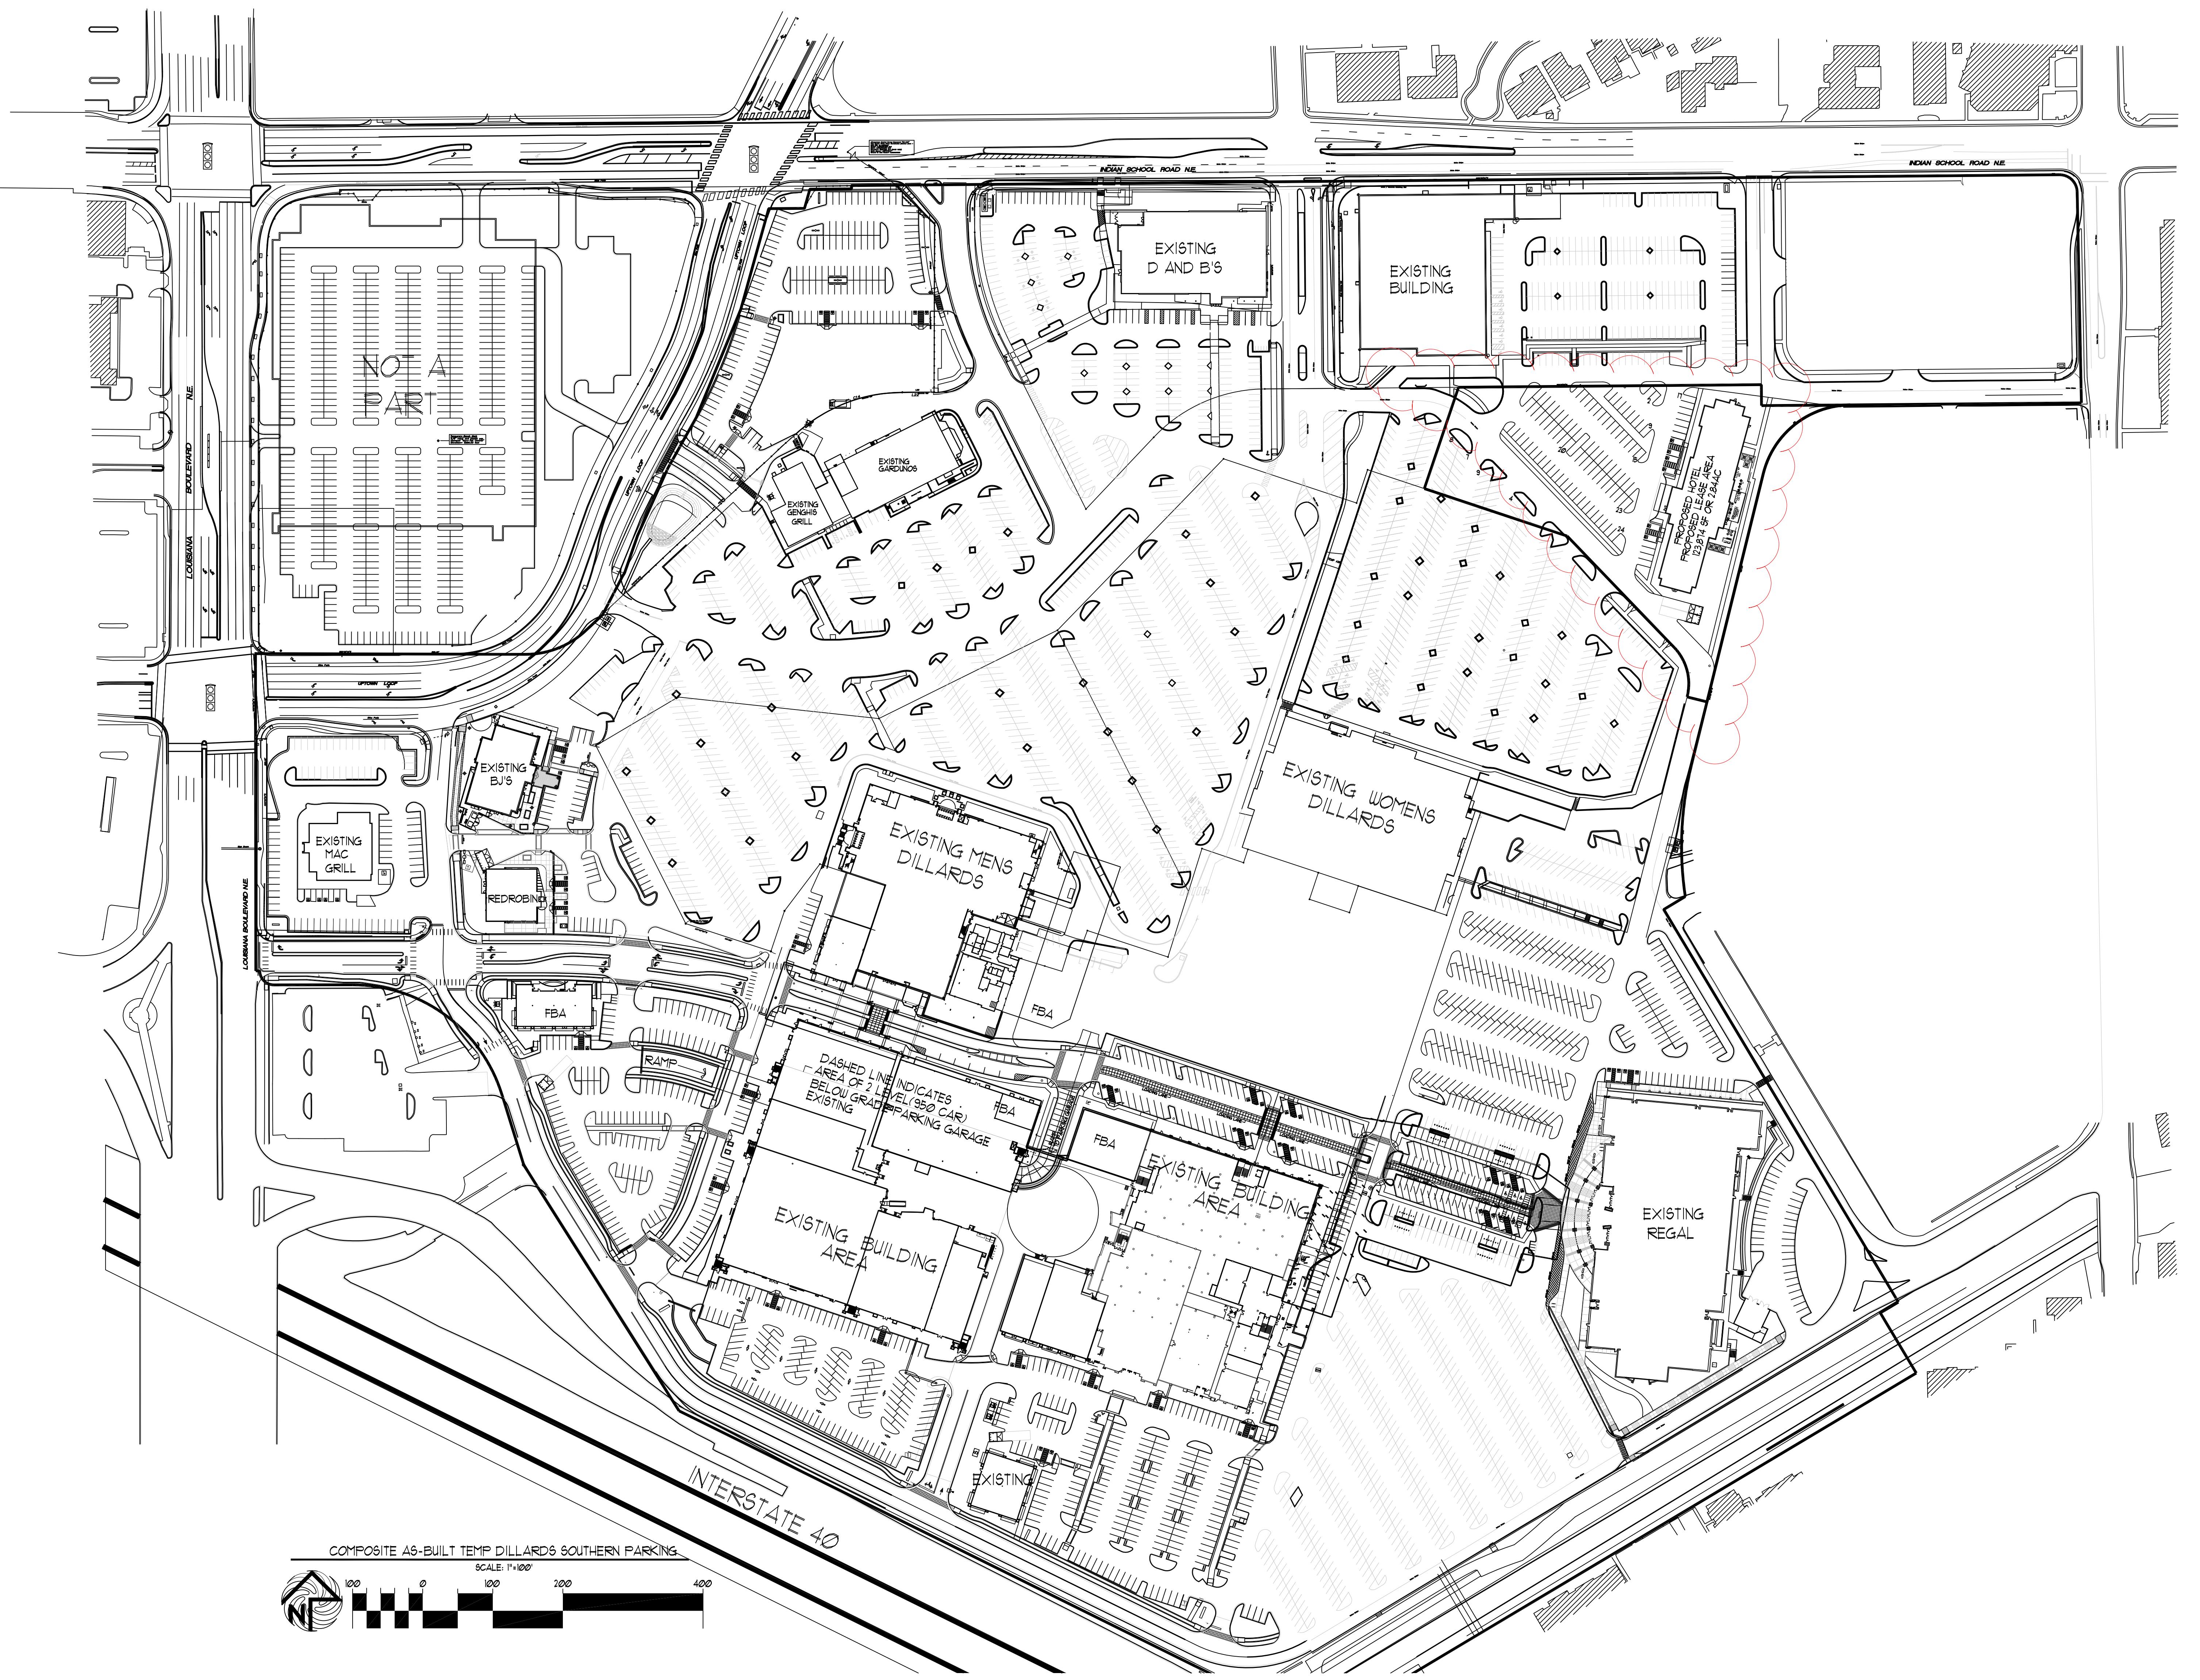


COMPOSITE AS-BUILT TEMP DILLARDS SOUTHERN PARKING

SCALE: 1"=100'

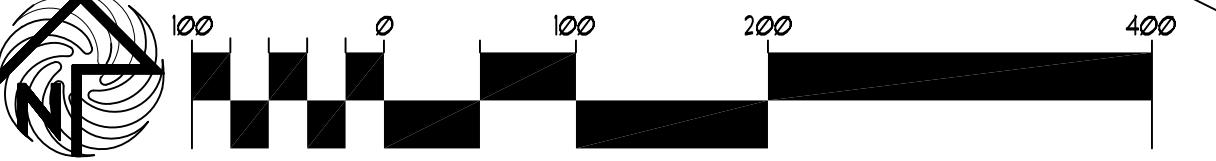


EXISTING BUILDING

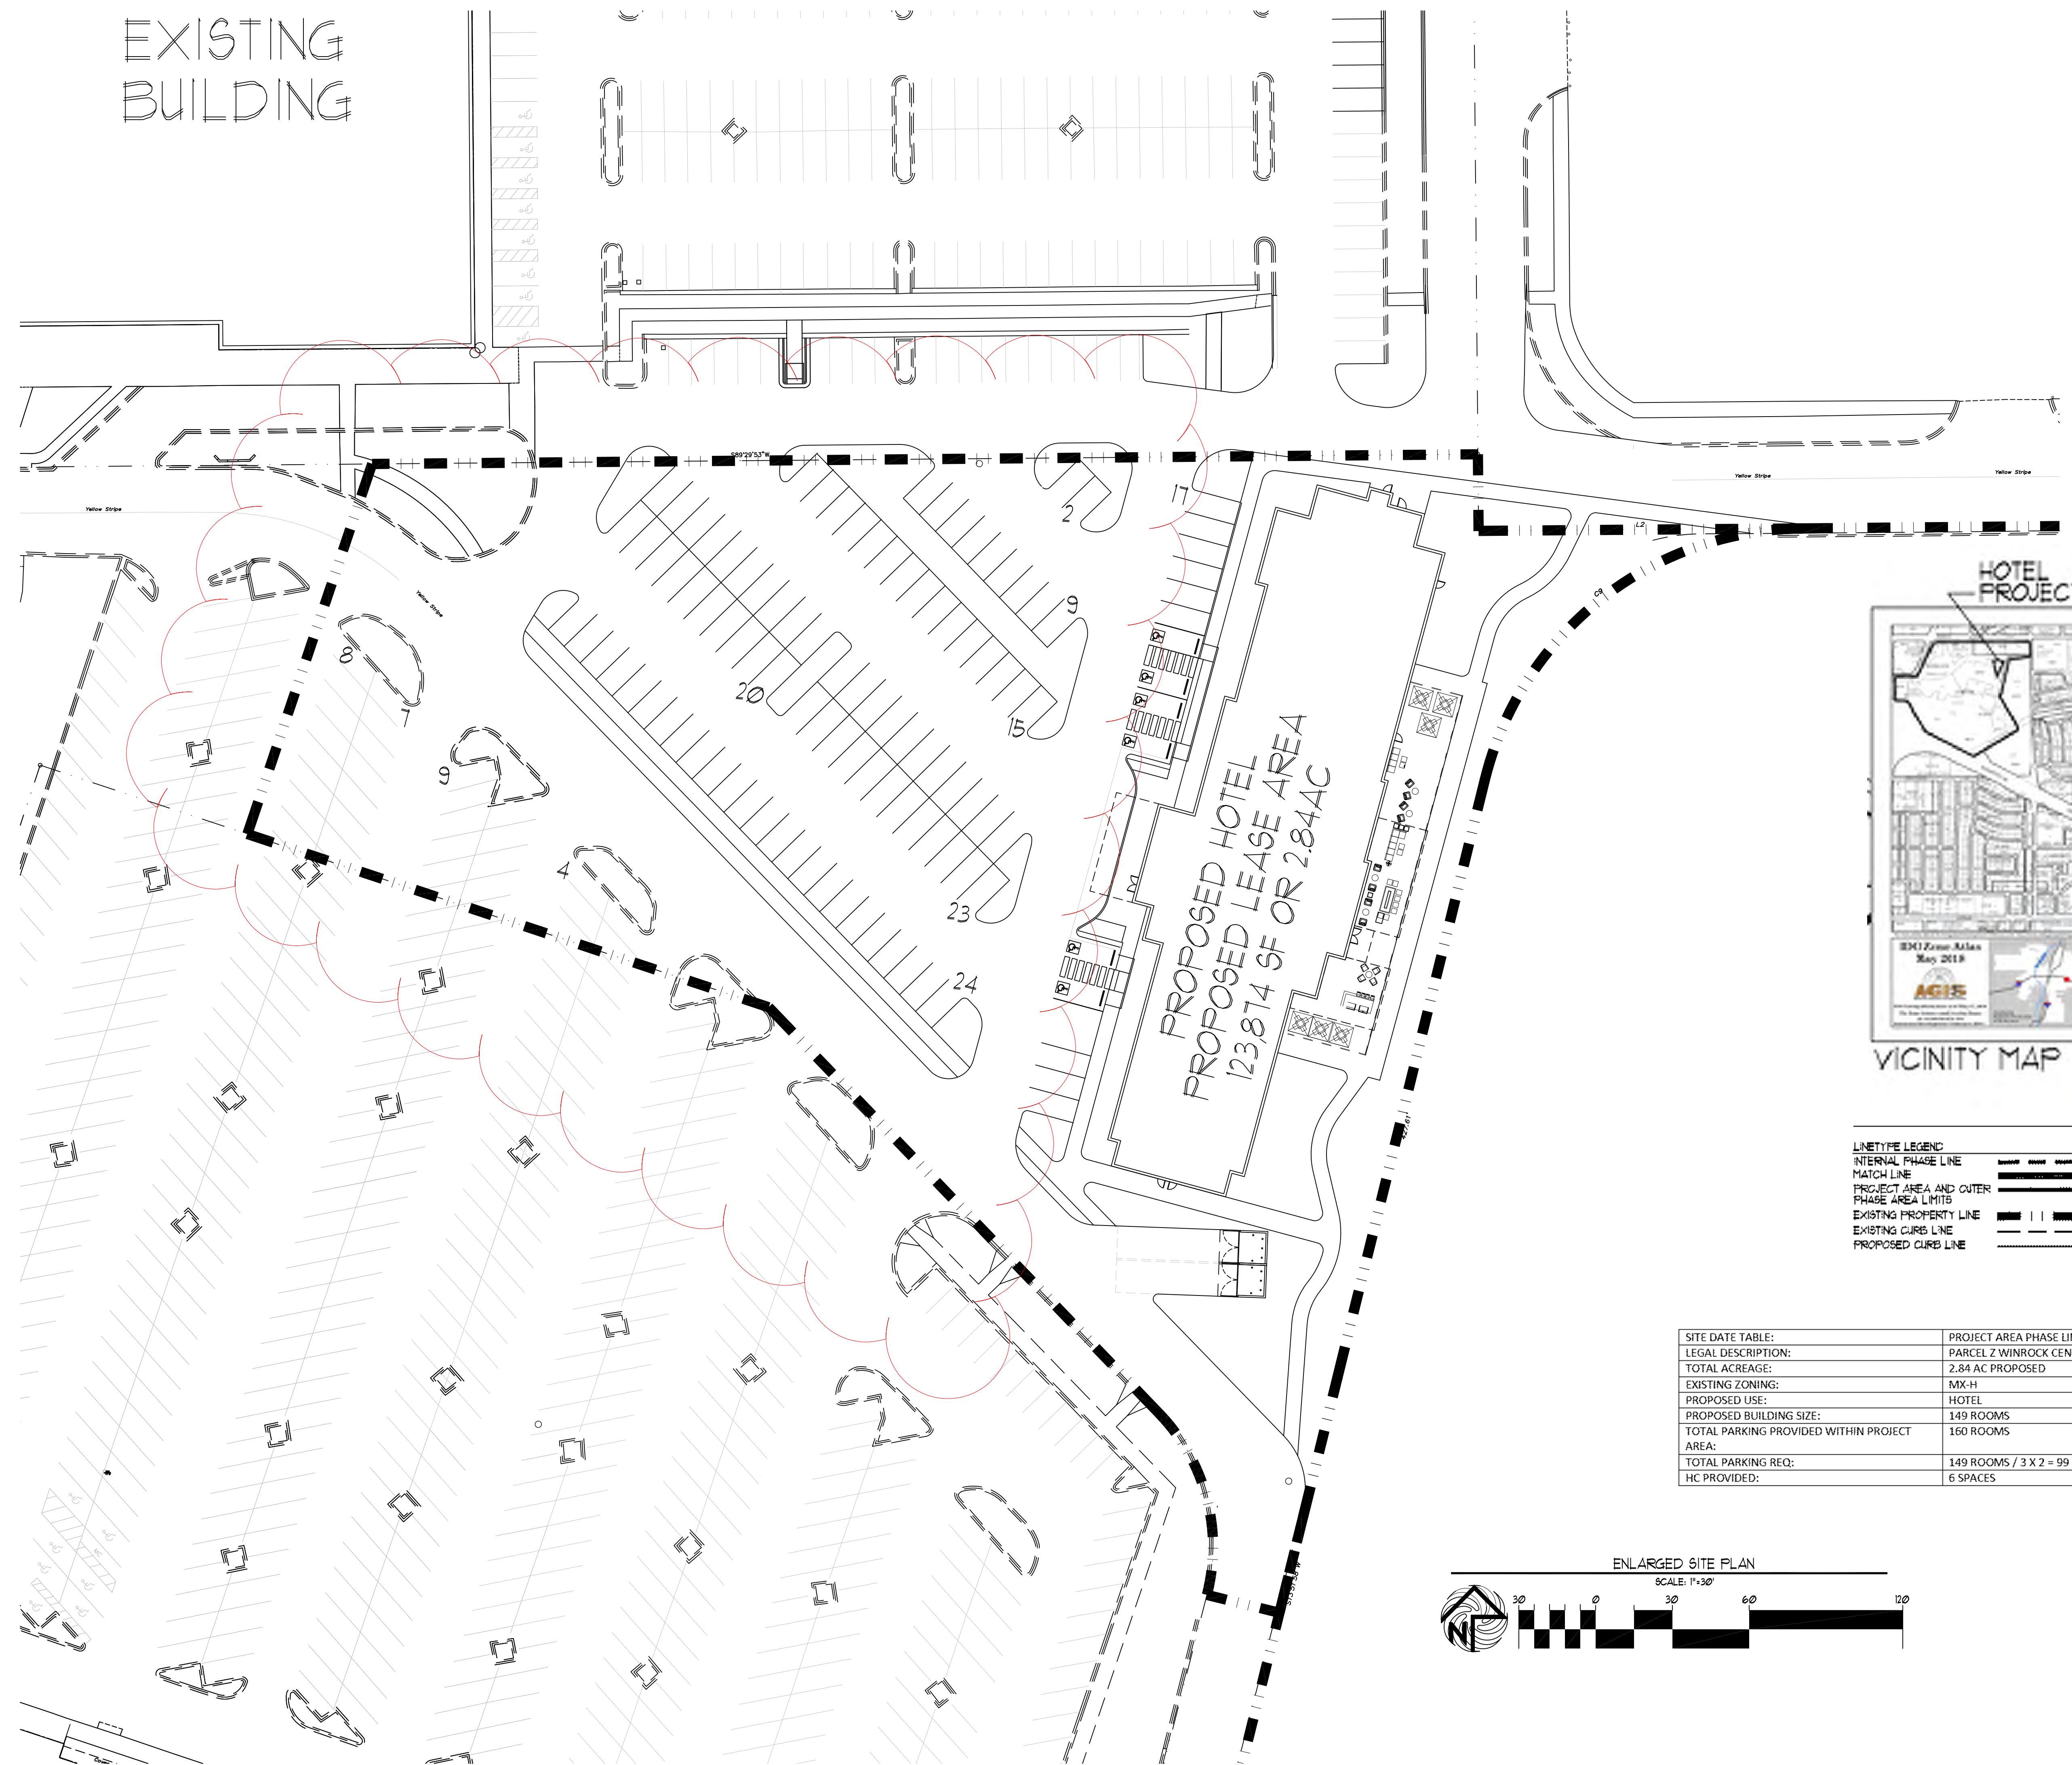

LINETYPE LEGEND

INTERNAL PHASE LINE	— — — — —
MATCH LINE	— — — — —
PROJECT AREA AND OUTER PHASE AREA LIMITS	— — — — —
EXISTING PROPERTY LINE	: :
EXISTING CURB LINE	— - - - -
PROPOSED CURB LINE	/ / / / /

SITE DATE TABLE:	PROJECT AREA PHASE LIMITS (LO
LEGAL DESCRIPTION:	PARCEL Z WINROCK CENTER ADDITION
TOTAL ACREAGE:	2.84 AC PROPOSED
EXISTING ZONING:	MX-H
PROPOSED USE:	HOTEL
PROPOSED BUILDING SIZE:	149 ROOMS
TOTAL PARKING PROVIDED WITHIN PROJECT AREA:	160 ROOMS
TOTAL PARKING REQ:	149 ROOMS / 3 X 2 = 99 REQUIRED PARKS
HC PROVIDED:	6 SPACES

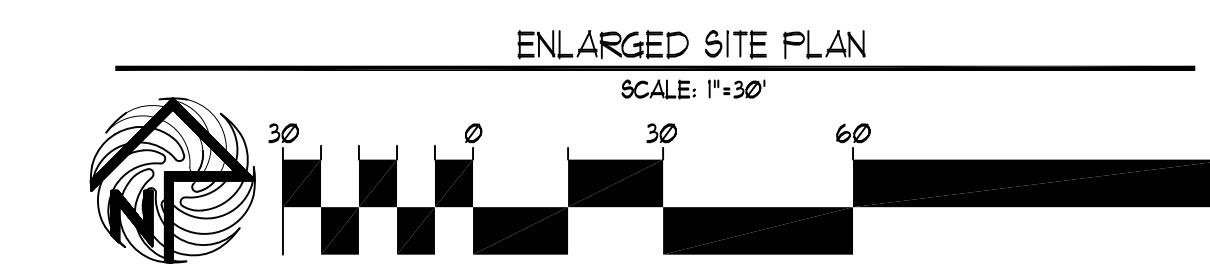


PROJECT TITLE	WINROCK TOWN CENTER
LOCATION	2100 LOUISIANA BLVD NE
PROJECT MANAGER	STEPHEN DUNBAR, AIA
JOB NO.	WIN-HOTEL
DRAWN BY	XXX
DATE	7/1/21
SCALE	1"=30'
RE: SCALE	SP-1A2
sheet	SP-1A2
of	1

MODULUS ARCHITECTS

100 SUN AVE. N.W. SUITE 305
ALBUQUERQUE, NEW MEXICO 87102
PHONE (505) 338-1499 FAX (505) 338-1498




EXISTING BUILDING

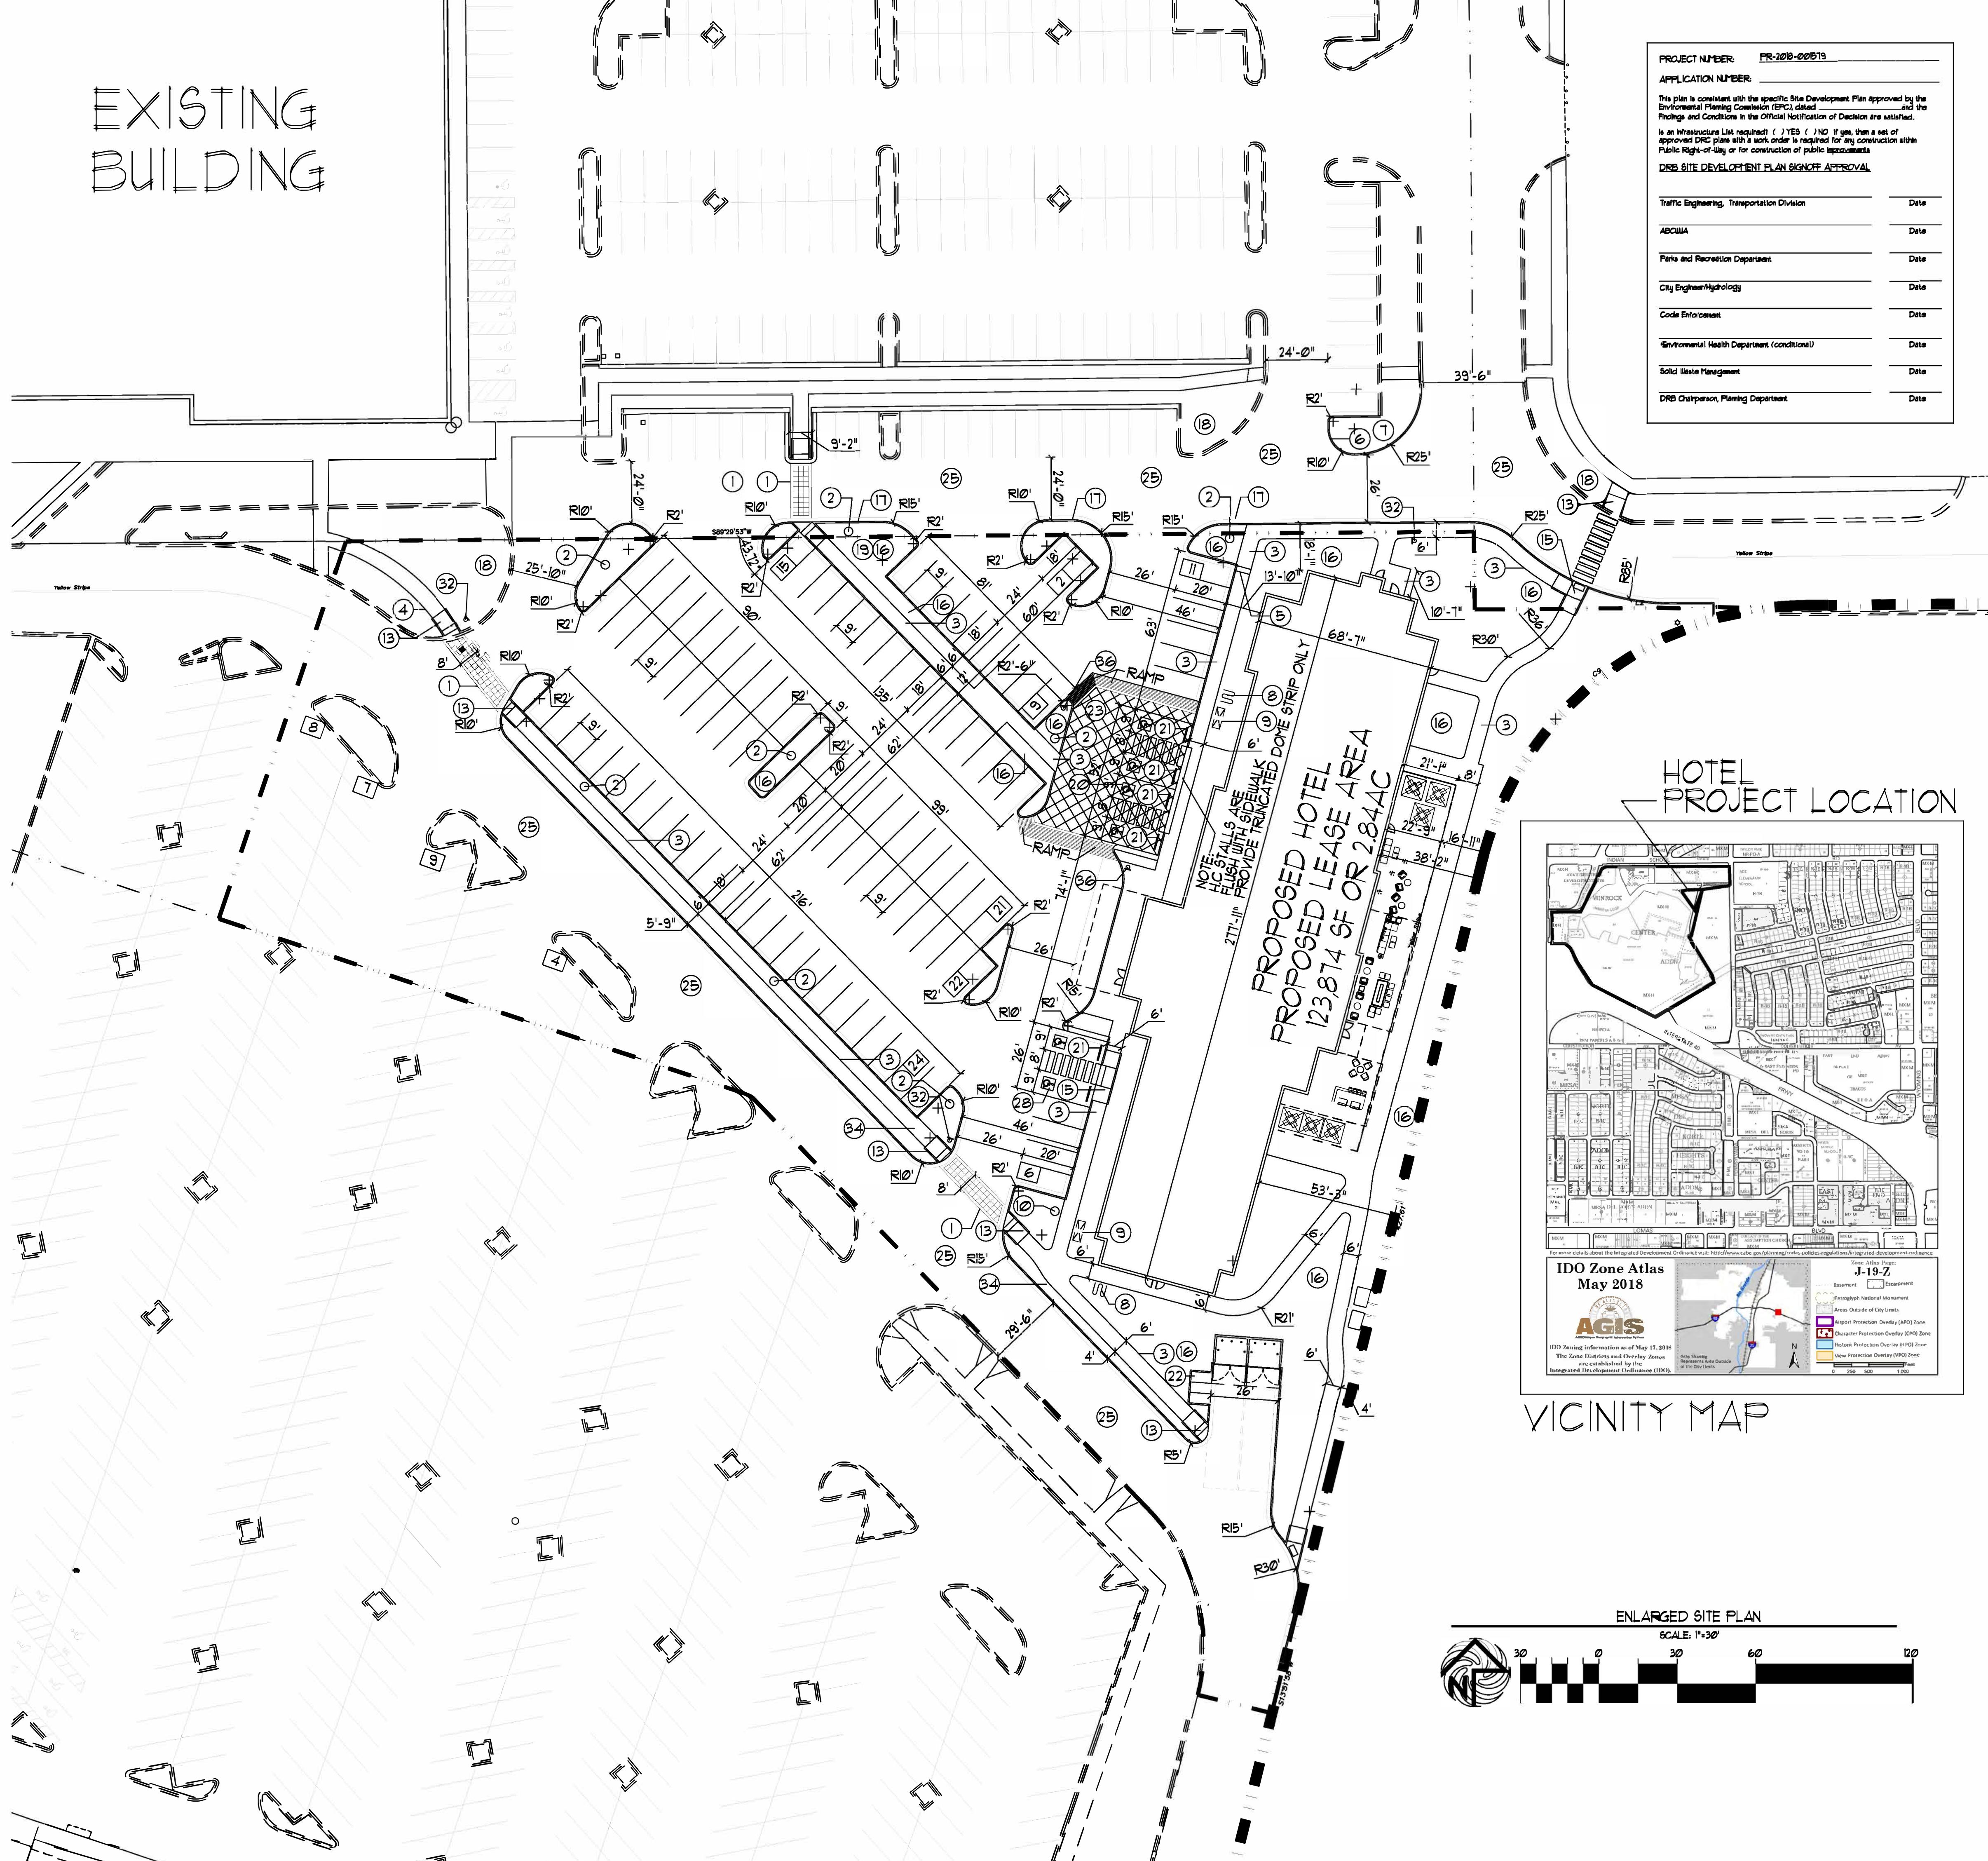


MODULUS ARCHITECTS

100 SUN AVE. N.W. SUITE 600
ALBUQUERQUE, NEW MEXICO 87102
PHONE (505) 338-1499 FAX (505) 338-1498

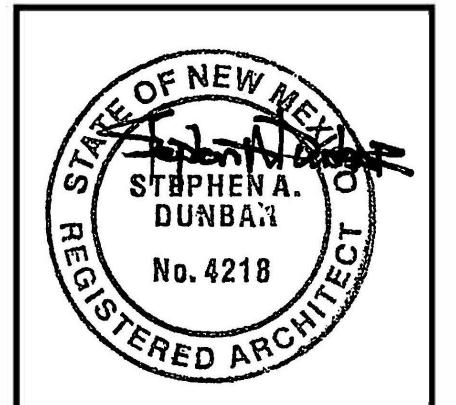

PROJECT TITLE:	WINROCK TOWN CENTER
PROJECT NUMBER:	2120 LOUISIANA BLVD NE ALBUQUERQUE, NEW MEXICO
PROJECT MANAGER:	STEPHEN DUNBAR, AIA
JOB NO.:	WIN-HOTEL
DRAWN BY:	5
DATE:	2/16/2021
SCALE:	1" = 30'
RE-SCALE:	1" = 10'
sheet:	5
of:	11
PROPOSED HOTEL SITE PLAN	

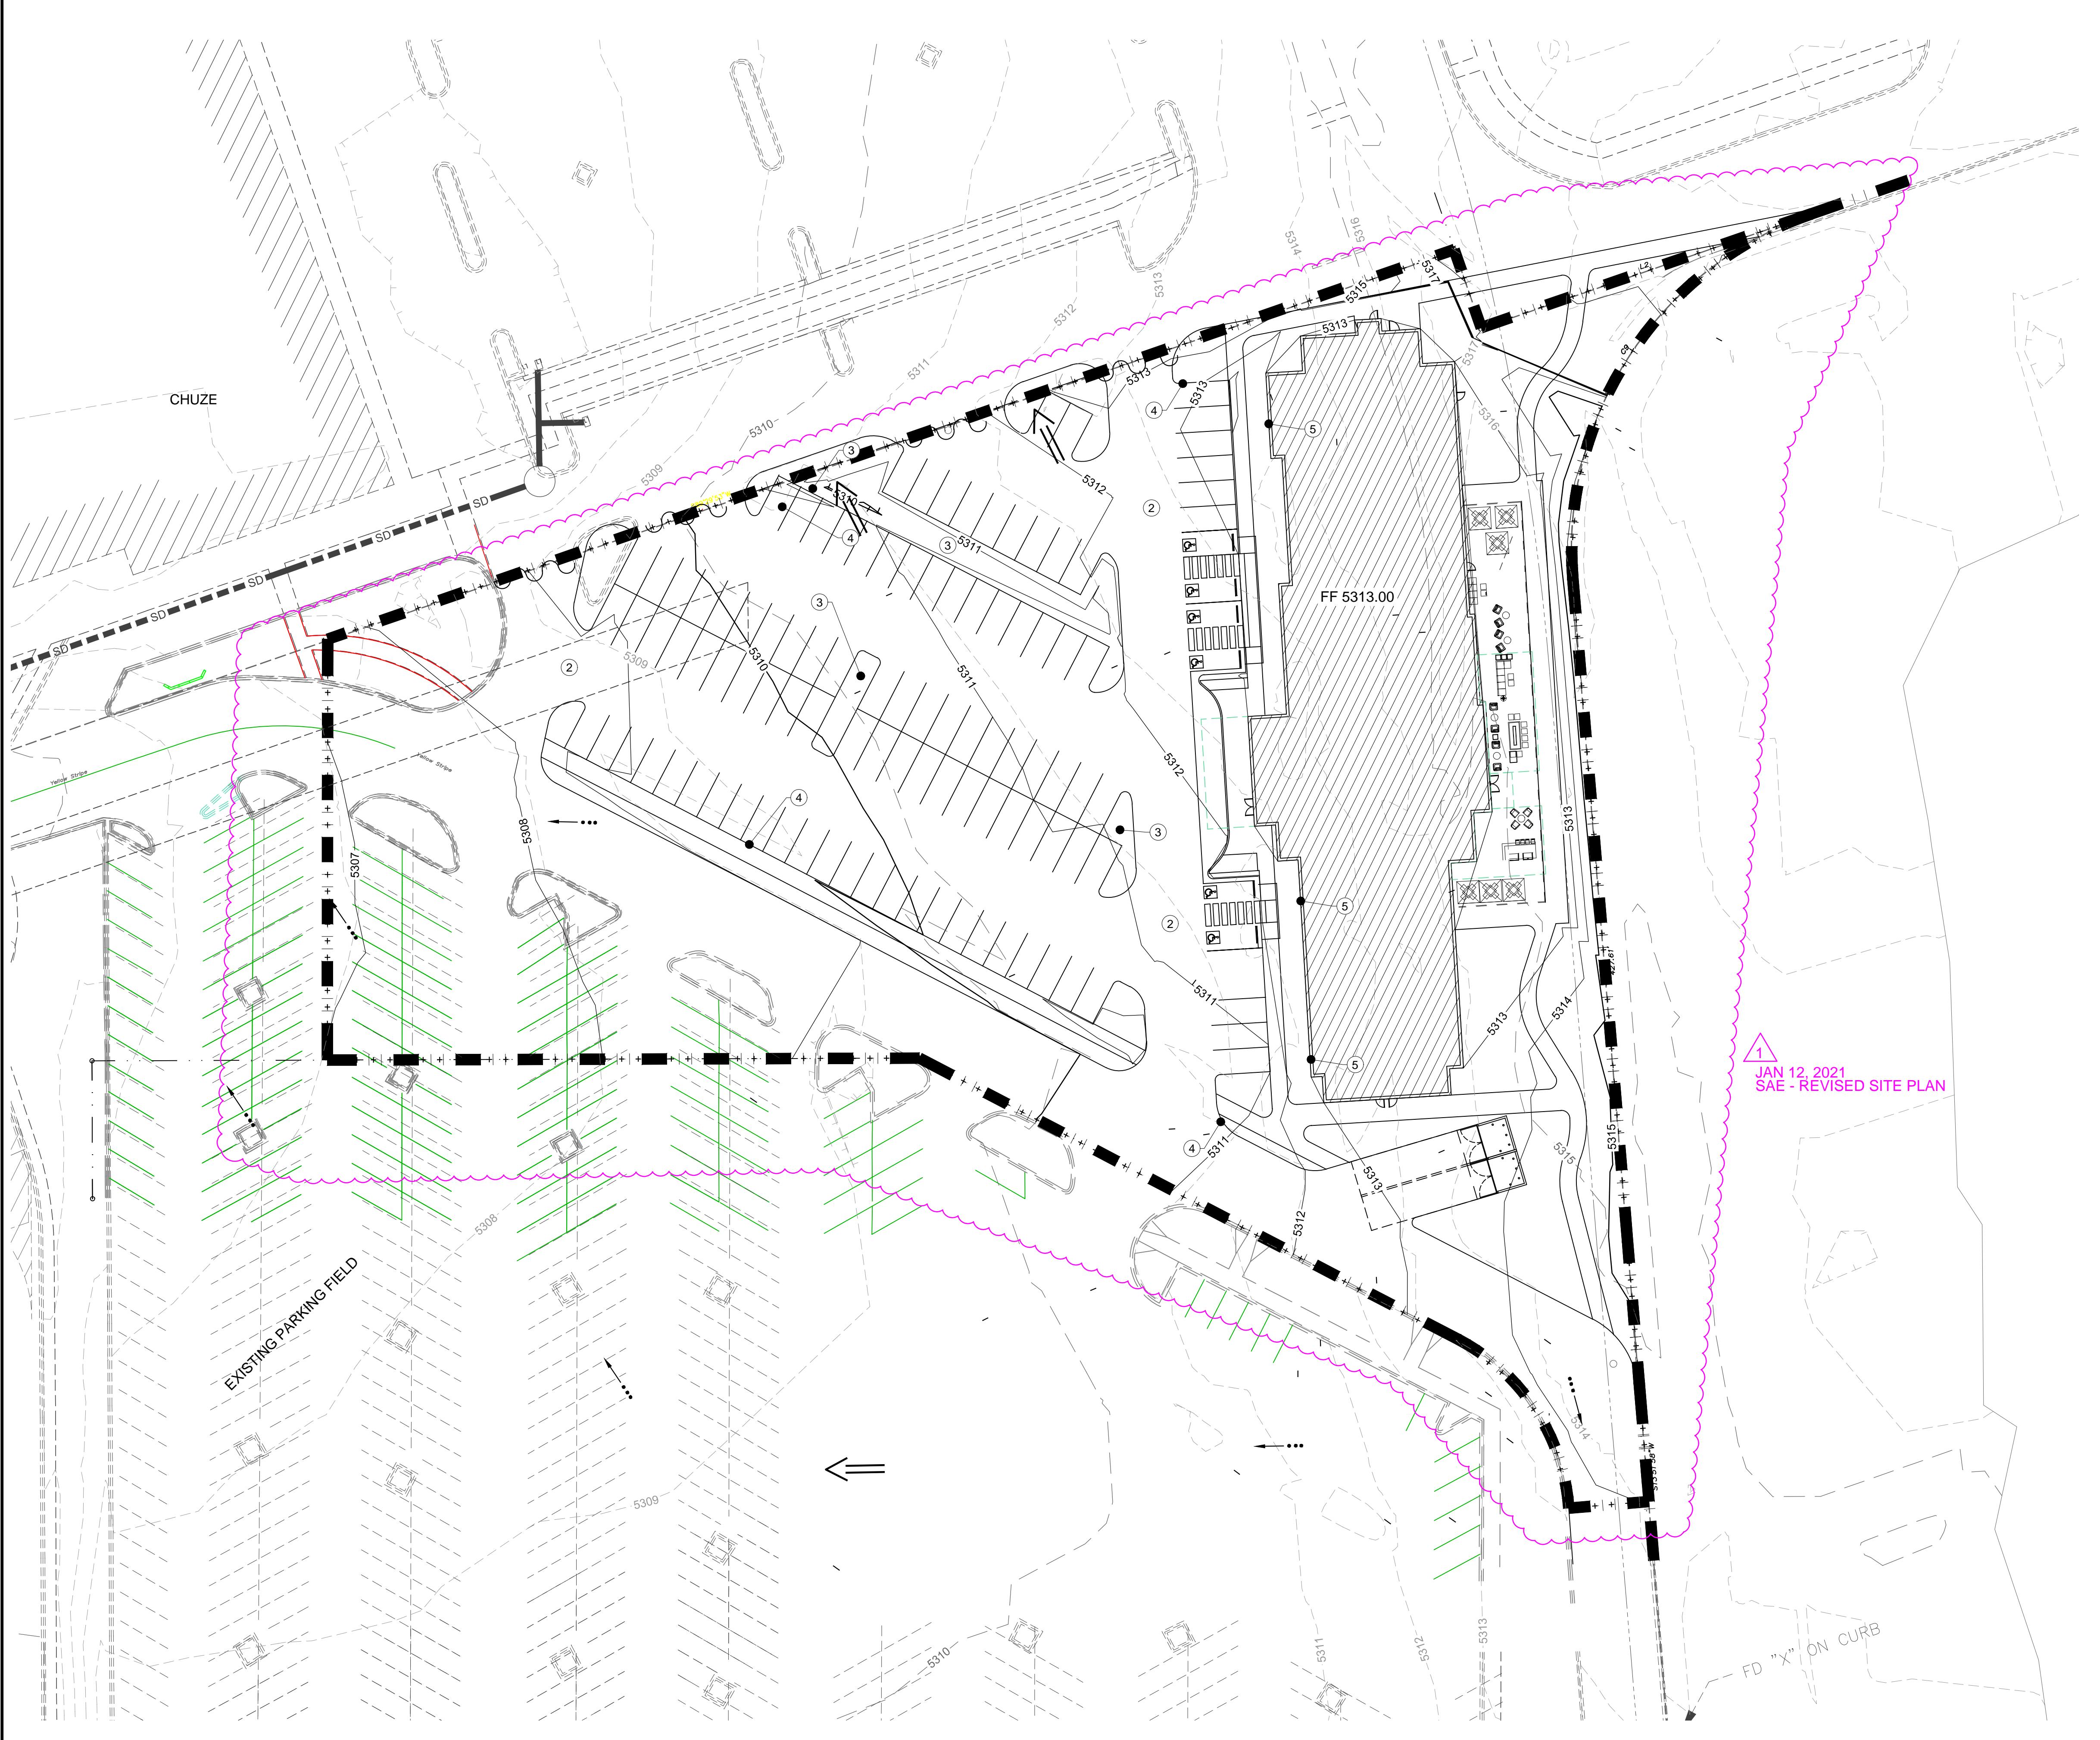

GRADING PLAN

CONSTRUCTION NOTES

- ① CONSTRUCT 6" ASPHALT CURB PER COA S DWG. 2415
 - ② CONSTRUCT 3" SP-C ASPHALT PARKING LO
 - ③ STORM WATER QUALITY POND
 - ④ CURB CUT
 - ⑤ ROOF DRAIN




JAN 12, 2021
SAF - REVISED SITE PL A

**HOTEL @
UNROCK TOWN CENTER
ALBUQUERQUE, NM**



GRADING PLAN FOR DRB SITE PLAN

MODULUS ARCHITECTS


100 SUN AVE. N.W. SUITE 600
ALBUQUERQUE, NEW MEXICO 87109
PHONE (505) 338-1499 FAX (505) 338-1498

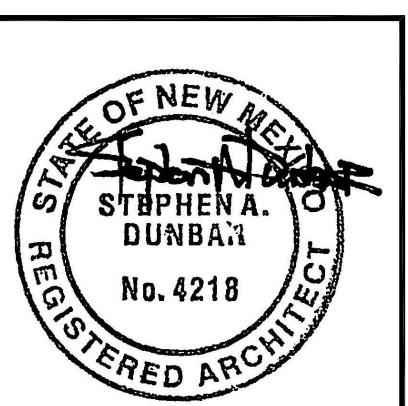


PROJECT TITLE	HOTEL SITE PLAN	JOB NO.	DRAWN BY
PROJECT MANAGER	2100 LOUISIANA	STEPHEN DUNBAR, AIA	SHEET NUMBER
DATE	2/16/21	SCALE	sheet
Re: PLAN		of	All

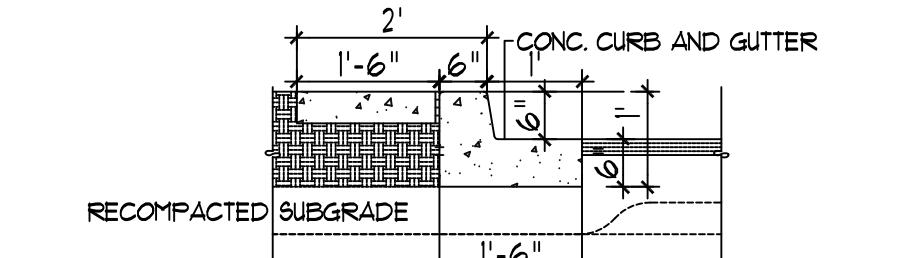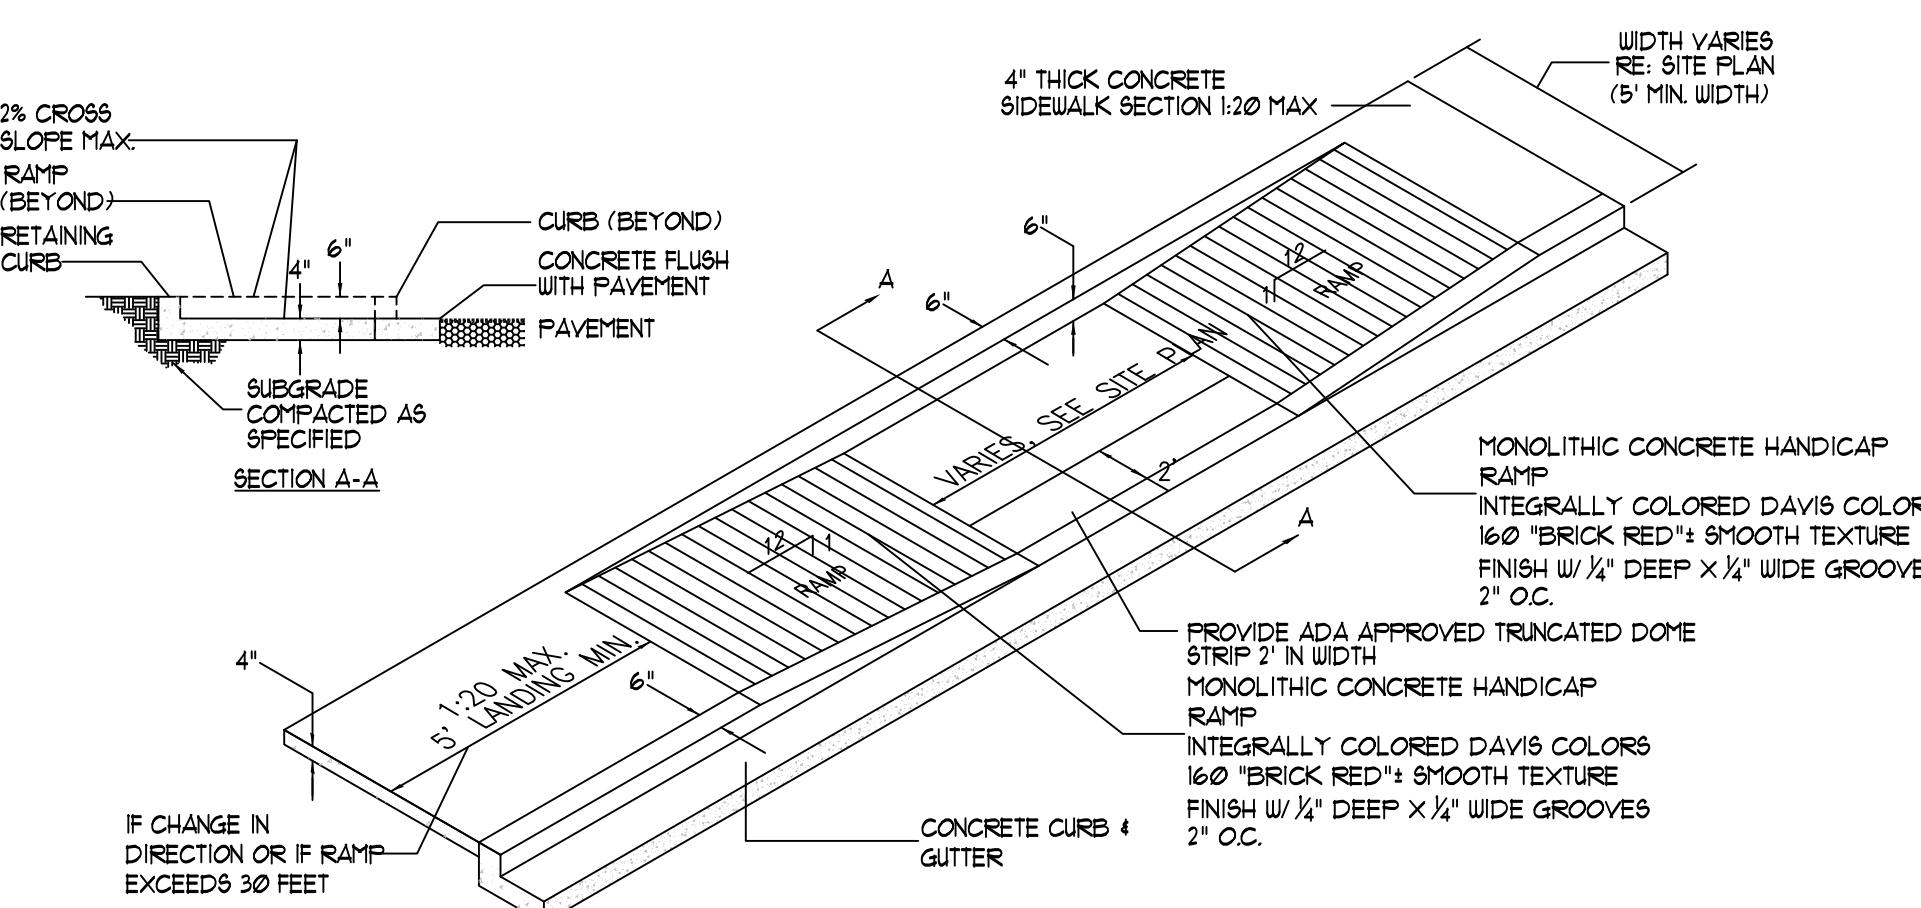


ISLAND CURB DETAIL
N.T.S.

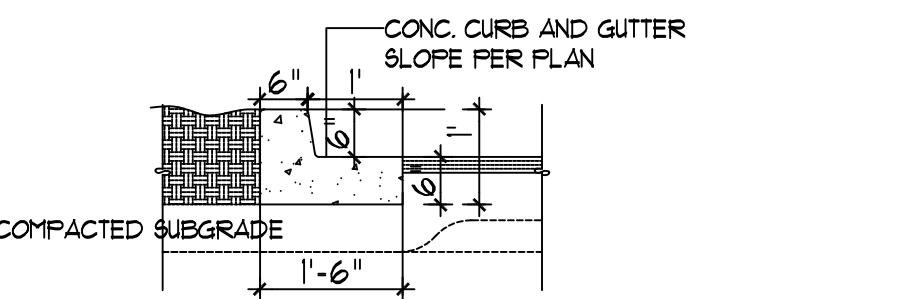




TYPICAL CURB DETAIL
N.T.S.

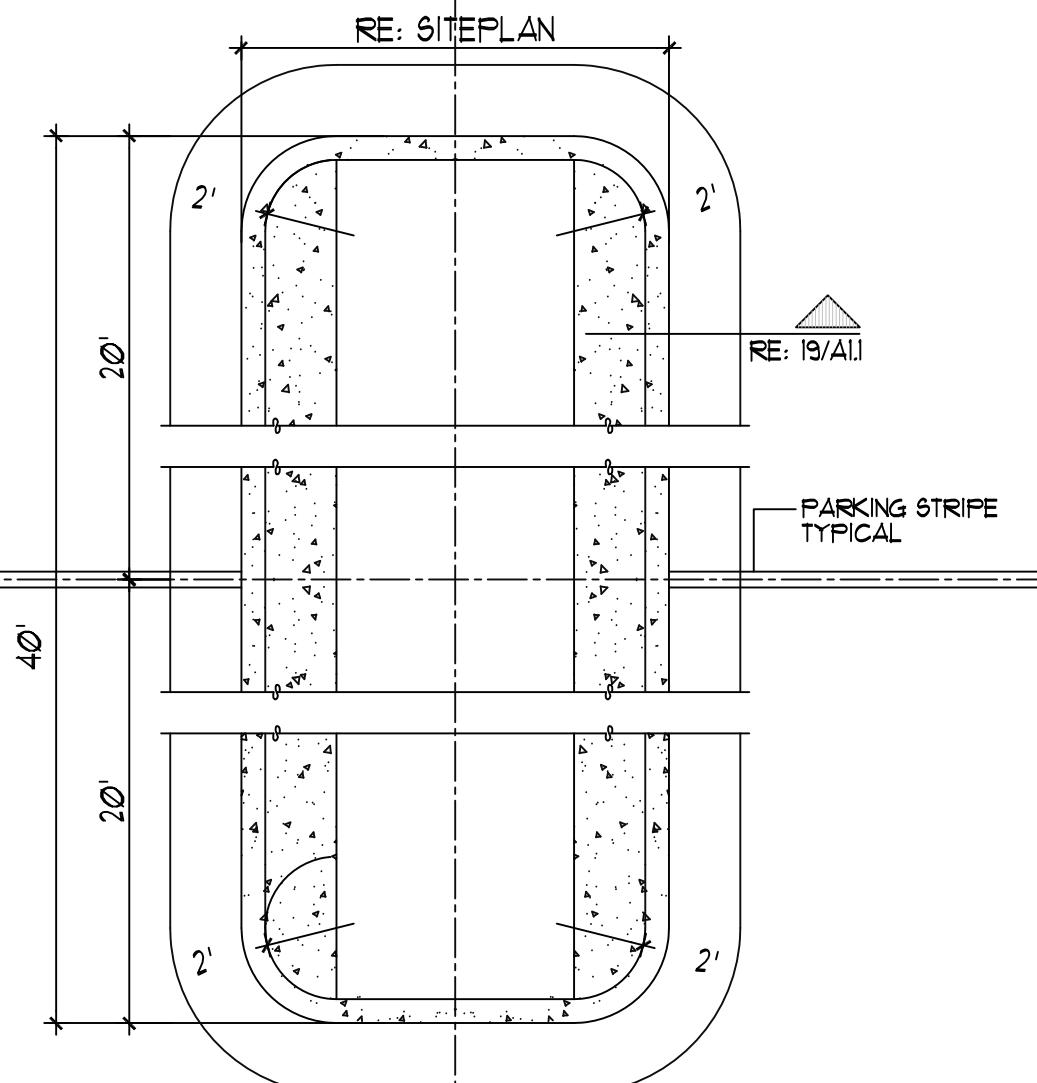



ISLAND DETAIL
N.T.S.

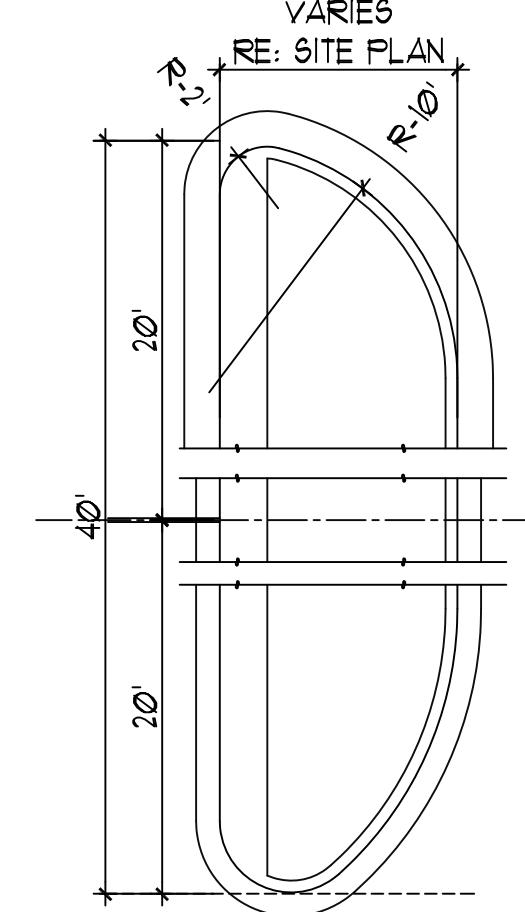


END ISLAND DETAIL
N.T.S.

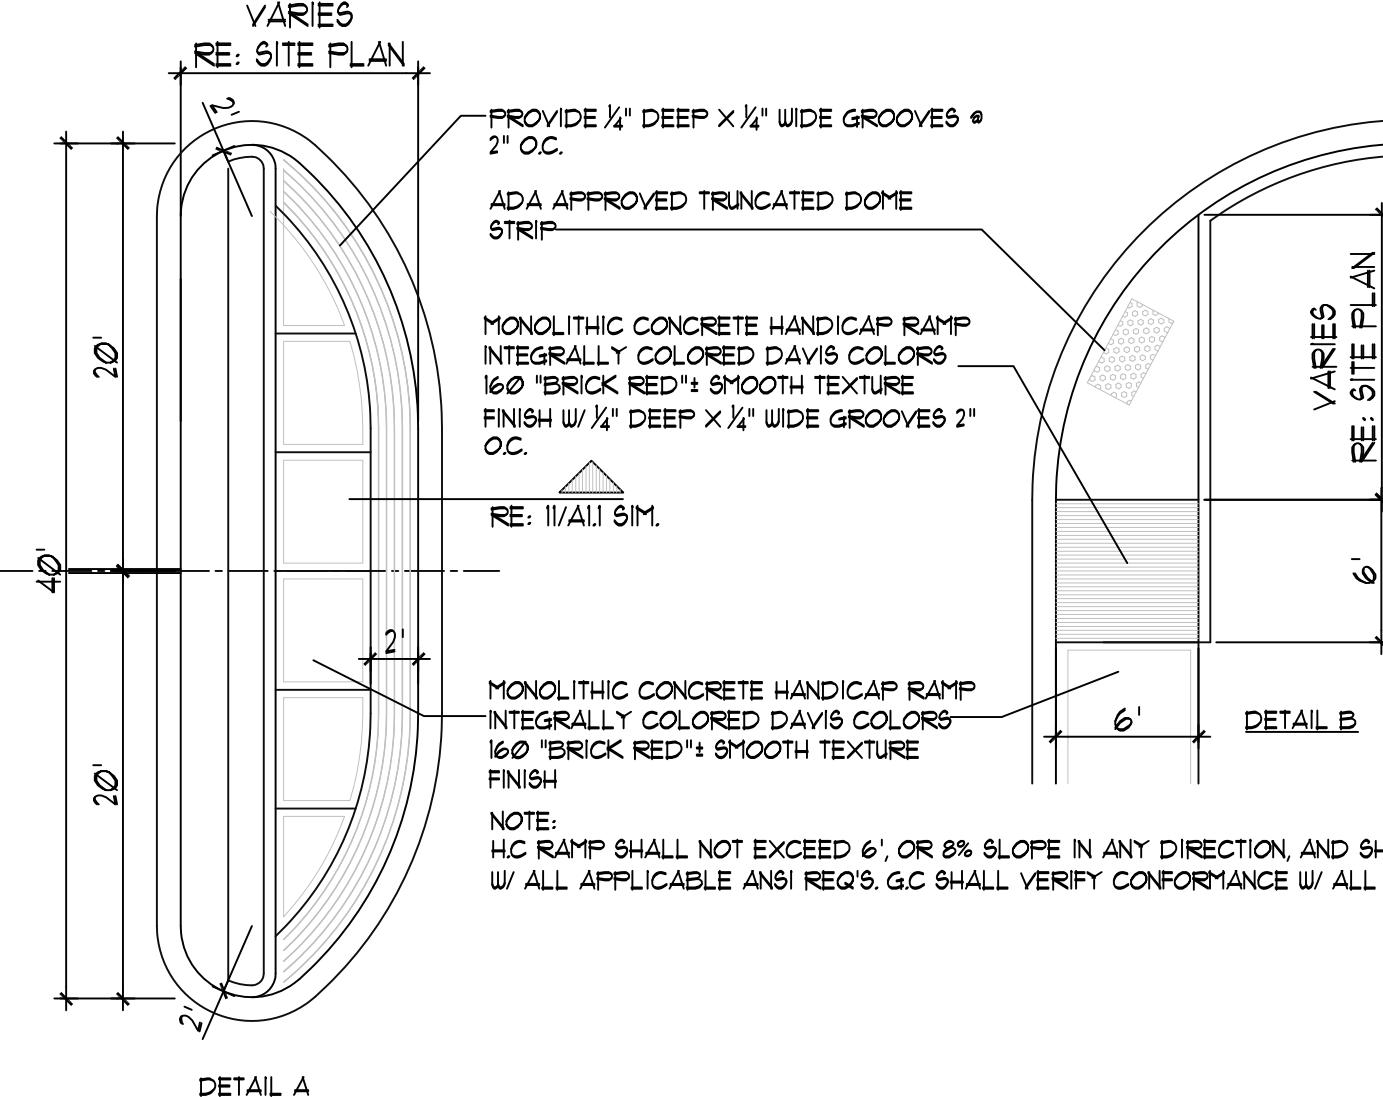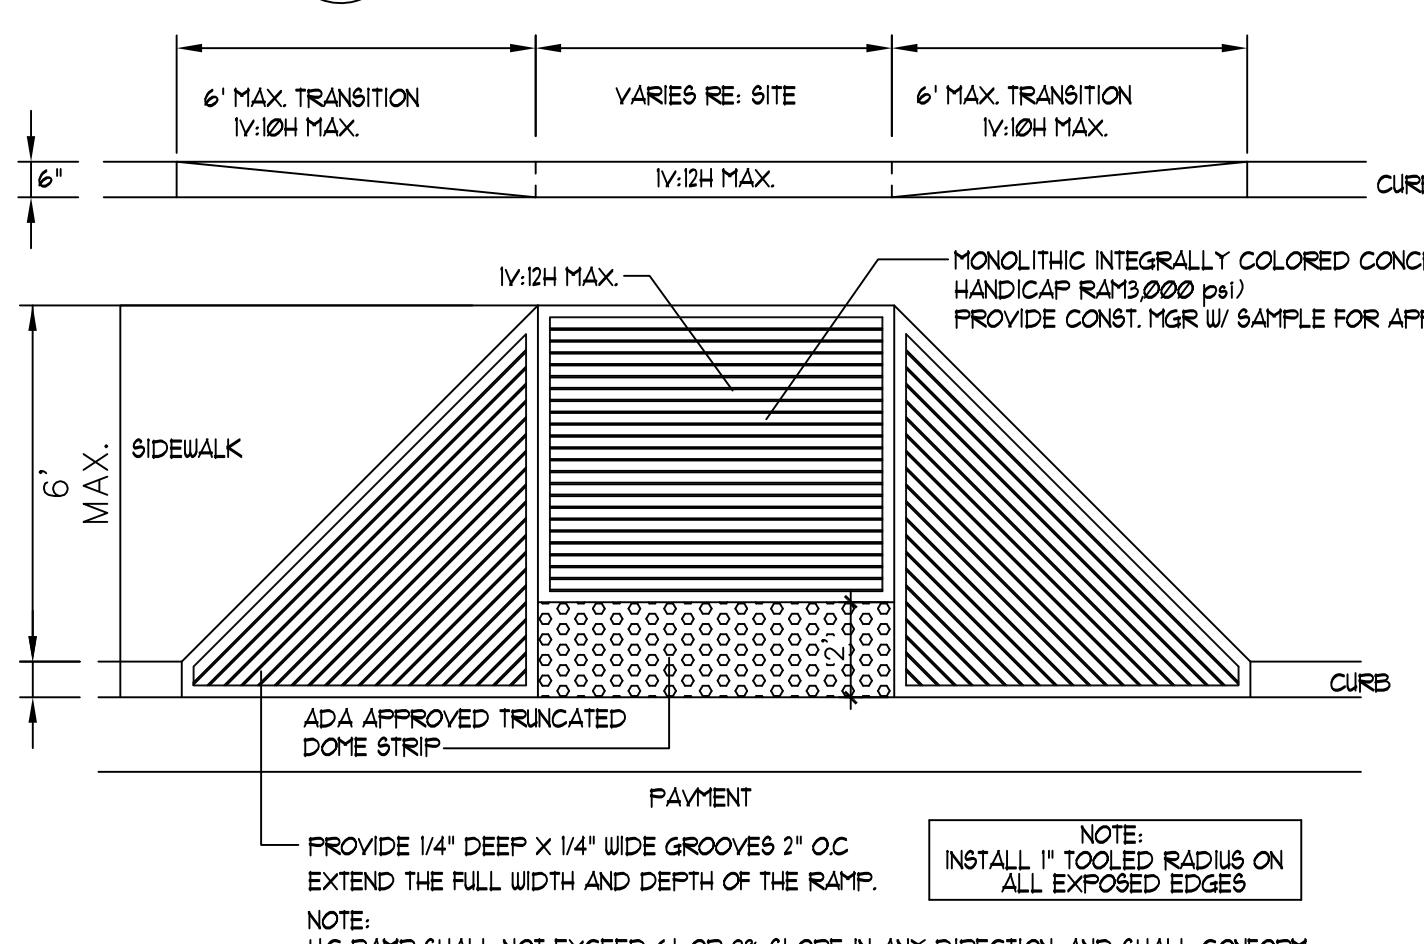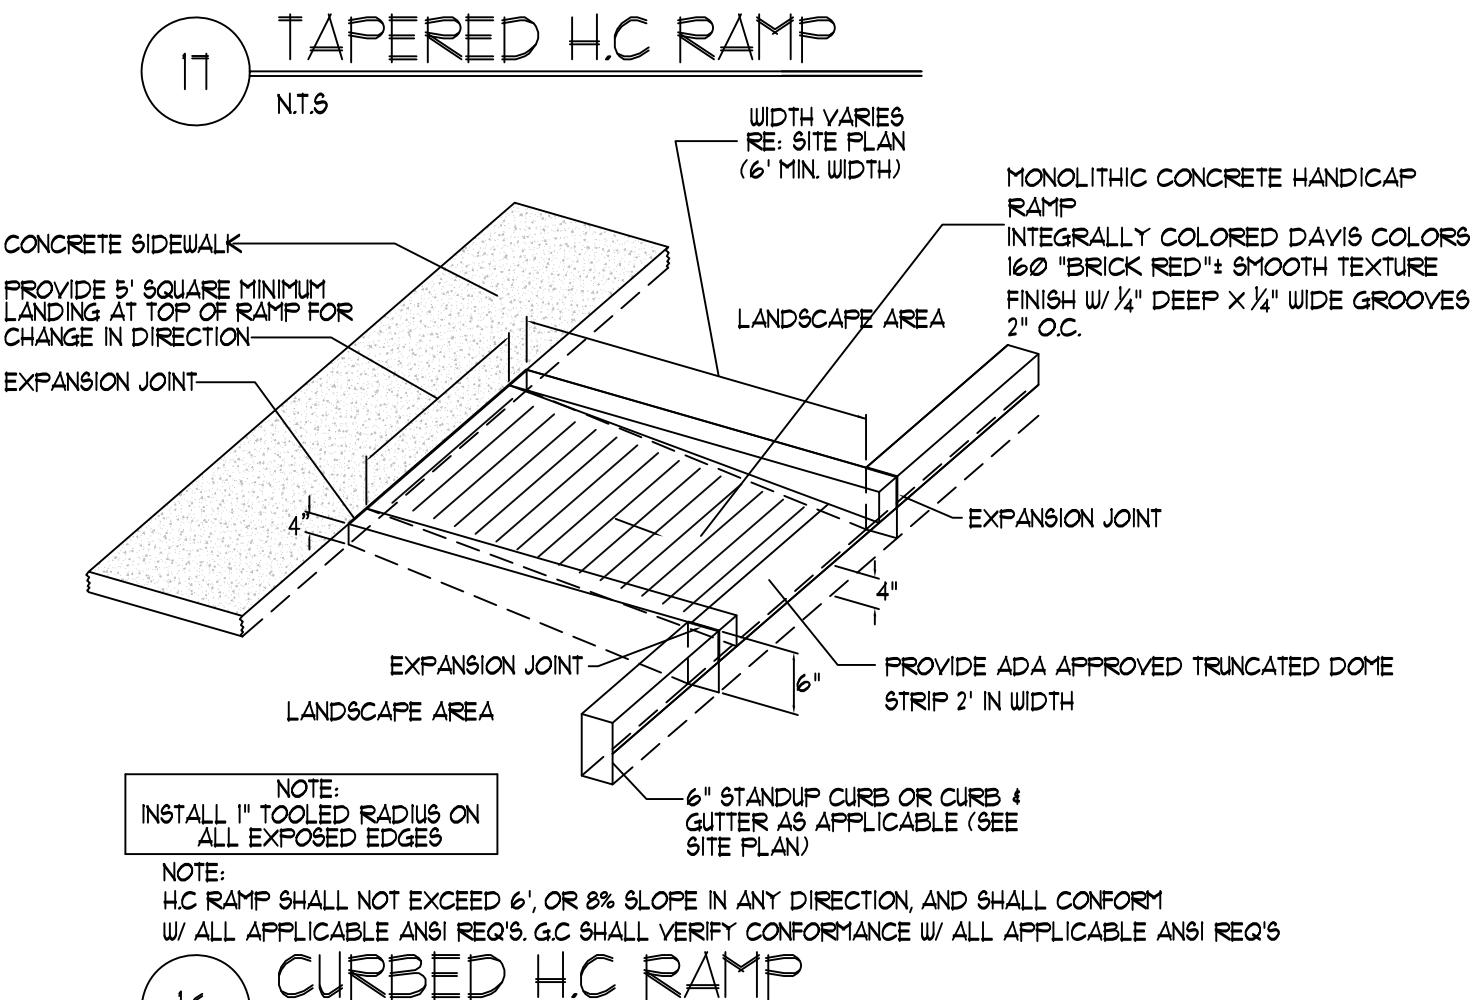


TYP. END ISLAND W/ WALK
N.T.S.

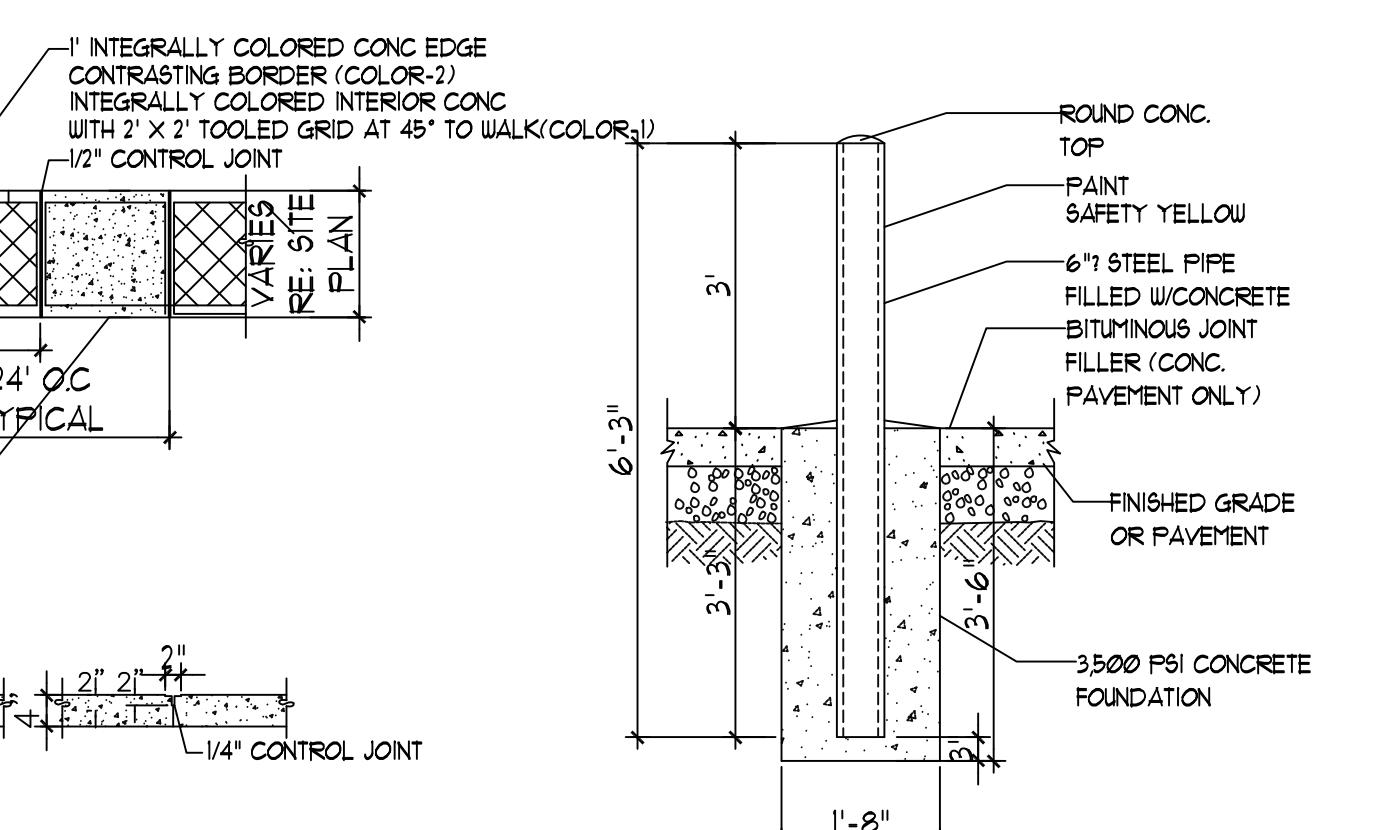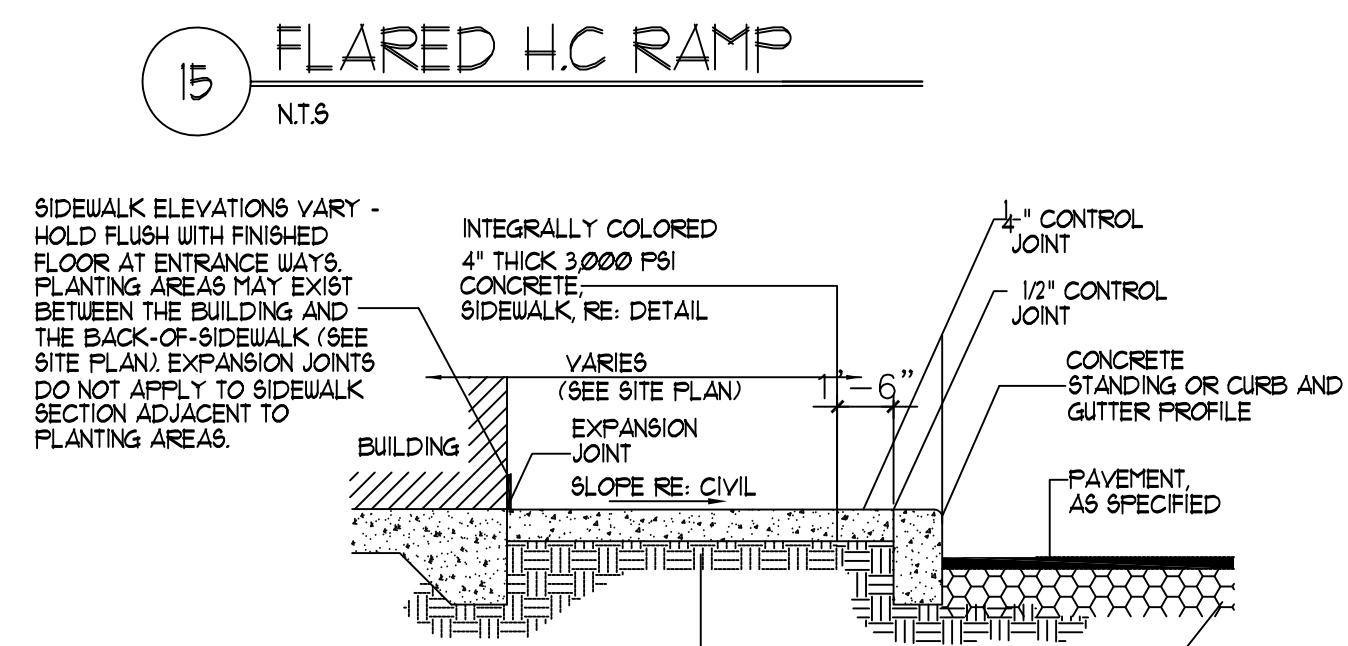


BOLLARD DETAIL
N.T.S.

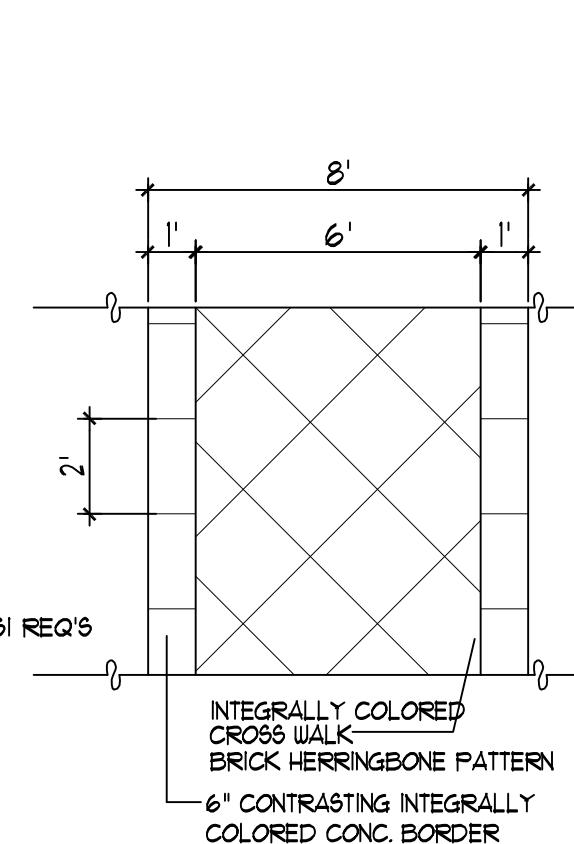


CONC. CROSSWALK
N.T.S.

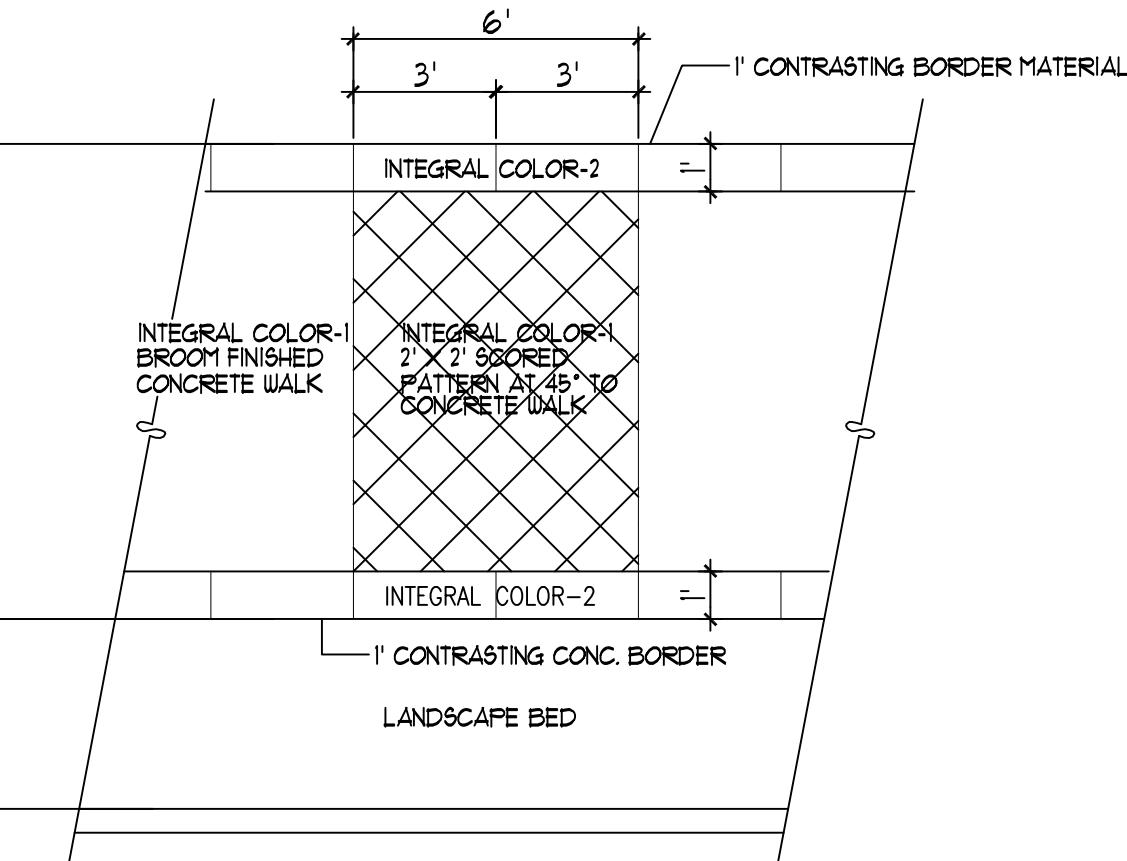

PED CONC. CROSSWALK
N.T.S.

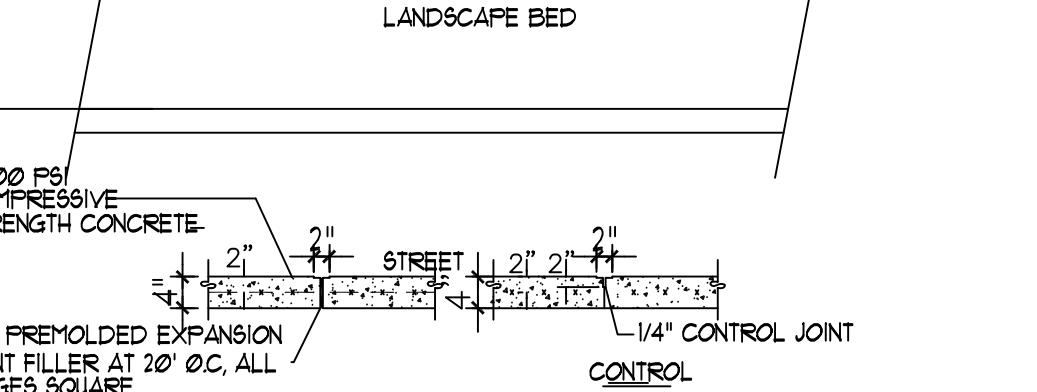

Typical Street Sidewalk
N.T.S.

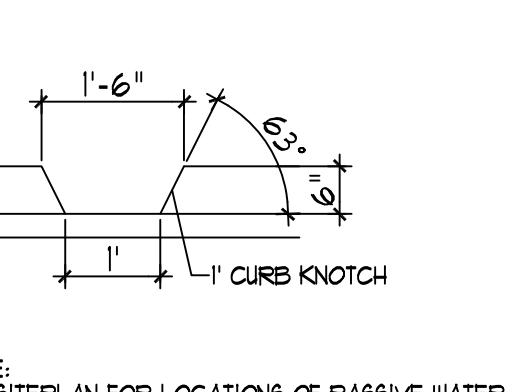

CURB NOTCH
N.T.S.

100 SUN AVE. N.W. SUITE 600
ALBUQUERQUE, NEW MEXICO 87109
PHONE (505) 338-1499 FAX (505) 338-1498

REV	DATE	BY	REVISION
1	2/16/21		
2			
3			
4			
5			

P O B X 1 0 5 9 7
A l b u q u e u r e , N M 8 7 1 8 4
5 0 5 . 8 9 8 . 2 1 0 5 (f a x)
d e s i g n @ h u l c . c o m




Date: 10/23/2019
Revisions:
12/30/2019
01/15/2020

Drawn by: VBLOUNT
Reviewed by: CM

Hotel At Winrock Landscape Plan

2100 Louisiana Blvd
Albuquerque, New Mexico

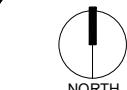


Scale: 1" = 30'
15' 0" 30' 60'

Sheet Title:
Landscape Plan

Sheet Number:

LP-01

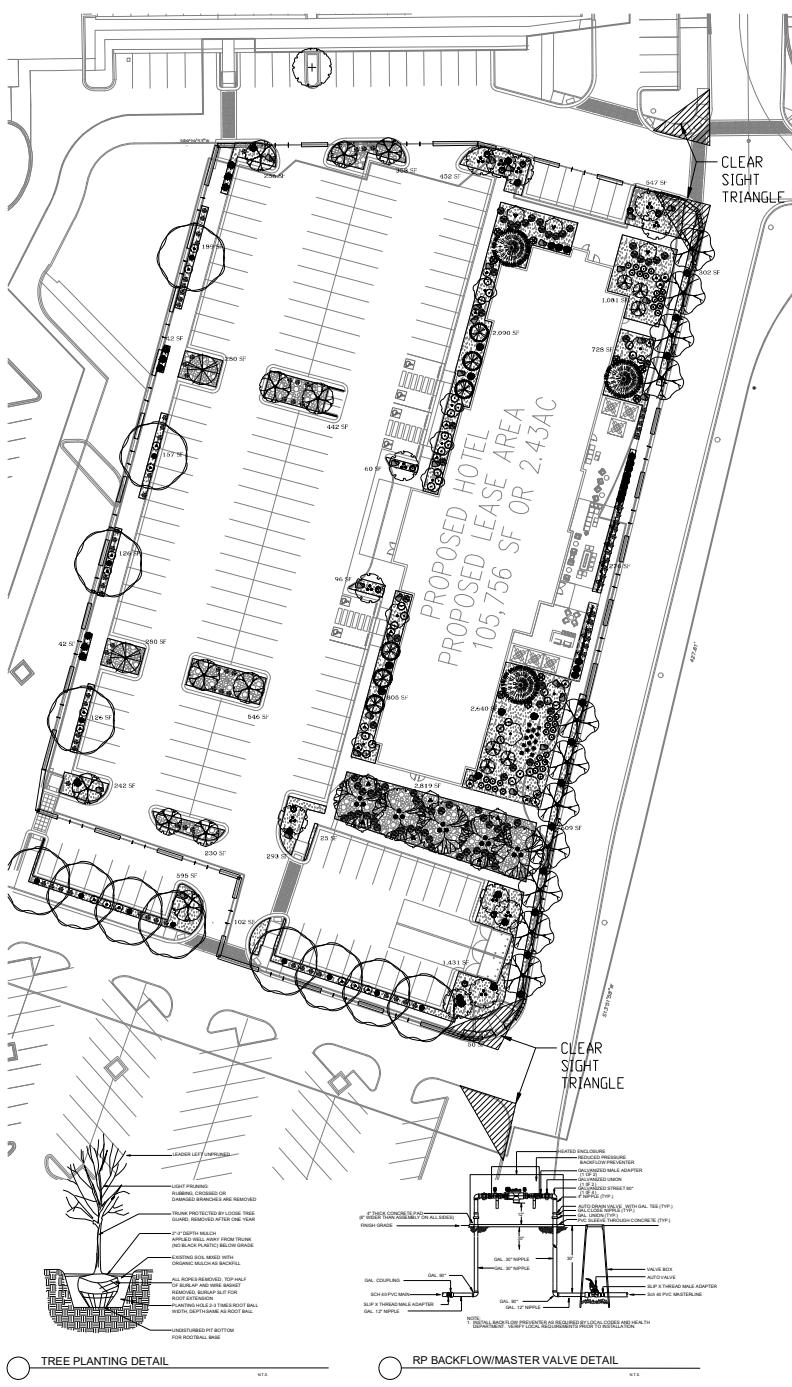

PLANT SCHEDULE BASE 12.30.19

SYMBOL	DESCRIPTION	QTY	DETAIL	2019-12-30-17:06
●	Pistacia chinensis / Chinese Pistache	12	2" B&B	Medium 60
○	Forestiera neomexicana / New Mexican Privet	10	24"box	Medium 40 15' X 15'
○	Lagerstroemia indica / Crape Myrtle	6	20 gal	High 35 15' X 15'
○	Quercus muehlenbergii / Chinkapin Oak	5	2" B&B	Medium 60 40' X 40'
○	Ulmus propinqua 'Emerald Sunshine' / Elm	12	2" B&B	Medium 60 35' X 25'
○	Vitis agnus-castus / Chaste Tree	12	24"box	Medium 50 20' X 20'
○	Picea pungens 'Baby Blue Eyes' / Baby Blue Eyes Spruce	3	6-3" B&B	Medium 60 50' x20'
○	Pinus leucodermis / Bosnian Pine	6	6-3" B&B	Medium 60 20' X 10'
○	Malus domestica 'Golden Delicious' / Golden Delicious Apple	4	1 1/2" B&B	Medium+ 55 20' X 25'
○	Prunus armeniaca 'Moopark' / Moopark Apricot	2	1 1/2" B&B	Medium+ 55 15' X 15'
○	Prunus avium 'Lapins' / Lapins Cherry	4	1 1/2" B&B	Medium+ 55 20' X 20'
○	Prunus persica 'Early Elberta' / Early Elberta Peach	3	1 1/2" B&B	Medium+ 50 15' X 15'
○	Punica granatum 'California Sunset' / California Sunset Pomegranate	9	15 gal	High 40 10' X 8'
○	Lonicera japonica 'Purpurea' / Purple Japanese Honeysuckle	8	5 gal	Medium+ 40 Climbing x 10'
○	Berberis thunbergii 'Atropurpurea' / Red Leaf Japanese Barberry	9	5 gal	Medium 40 4' X 4'
○	Lavandula angustifolia / English Lavender	35	5 gal	Medium 25 3' X 3'
○	Rhus aromatica 'Gro-Low' / Gro-Low Fragrant Sumac	30	5 gal	Low+ 40 4' X 4'
○	Rosa x 'Knockout' TM / Rose	10	5 gal	Medium 30 6' X 5'
○	Zauschneria garrettii 'Orange Carpet' / Hummingbird Trumpet	10	1 gal	Low+ 25 3' X 4'
○	Yucca pendula / Soft Leaf Yucca	30	5 gal	RW 35 5' X 4'
○	Rosmarinus officinalis 'Arp' / Arp Rosemary	41	5 gal	Low+ 40 6' X 4'
○	Calamagrostis x acutiflora 'Karl Foerster' / Feather Reed Grass	90	1 gal	Medium 20 30' X 2'
○	Miscanthus sinensis 'Gracillimus' / Maiden Grass	70	1 gal	Medium+ 20 5' X 5'
○	Muhlenbergia rigida 'Nashville' / Purple Muhy	14	1 gal	Low+ 20 2' X 3'

REFERENCE NOTES SCHEDULE BASE 12.30.19

SYMBOL	DESCRIPTION	QTY	DETAIL	2019-12-30-17:06
●	Large Boulder	29		
■	Amaranto 3/8 - 1 1/4" Gravel	13,392 sf	3" Depth over Filter Fabric	
■	2-4" Blue Saj Cobble	4,956 sf	4" Depth	

