# 

#### GENERAL NOTES

- PERMANENT ACCESS DRIVE EASEMENT. THE "DECLARATION OF COVENANTS, CONDITIONS AND RESTRICTIONS REGARDING OUTPARCEL" (RECORDED AS DOCUMENT NO. 2012138716 ON THE 316T DAY OF DECEMBER 2012) STATES WITHIN SECTION 32 THAT THE OWNER OF TRACT B-1-A-1 "HEREBY GRANTS TO THE OUTPARCEL OWNER (TRACT B-1-A-2), AS GRANTEE, FOR THE BENEFIT OF THE OUTPARCEL OWNER AND ITS RESPECTIVE PERMITEES APPURTENANT TO THE OUTPARCEL, A PERPETUAL NON-EXCLUSIVE EASEMENT FOR INGRESS AND EGRESS BY VEHICULAR AND PEDESTRIAN TRAFFIC UPON, OVER AND ACROSS THAT PORTION OF THE COMMON AREA LOCATED ON THE HOME DEPOT PARCEL (TRACT B-1-A-1) SHOWN ON EXHIBIT "B" AS THE PERMANENT ACCESS
- 2. RECIPROCAL STORM DRAINAGE EASEMENT. THE "DECLARATION OF COVENANTS, CONDITIONS AND RESTRICTIONS REGARDING OUTPARCEL" (RECORDED AS DOCUMENT NO. 2012138716 ON THE 31ST DAY OF DECEMBER, 2012) STATES WITHIN SECTION 35 THAT THE OWNER OF TRACT B-1-A-1 AND THE OWNER OF TRACT B-1-A-2 RECIPROCALLY GRANT TO ONE ANOTHER "A NON-EXCLUSIVE EASEMENT OVER AND UNDER ITS PARCEL FOR SURFACE WATER DRAINAGE OVER AND THROUGH THE DRAINAGE PATTERNS AND STORM WATER DRAINAGE SYSTEMS THAT ARE ESTABLISH FROM TIME TO TIME AMONG THE PARCELS.
- 3. GRANT OF UTILITY EASEMENTS. THE "DECLARATION OF COVENANTS, CONDITIONS AND RESTRICTIONS REGARDING OUTPARCEL "(RECORDED AS DOCUMENT NO. 2012138716 ON THE 31ST DAY OF DECEMBER, 2012) STATES WITHIN SECTION 3.1(a) THAT THE OWNER OF TRACT B-1-A-1 AND OWNER OF TRACT B-1-A-2 RECIPROCALLY GRANT TO ONE ANOTHER "A NON-EXCLUSIVE AND PERPETUAL EASEMENT UNDER, THROUGH AND ACROSS THE COMMON AREA OF THE HOME DEPOT PARCEL (TRACT B-1-A-1) OR THE OUTPARCEL (TRACT B-1-A-2), AS APPLICABLE (EXCLUSIVE OF ANY PORTION WITHIN A BUILDING AREA), FOR THE INSTALLATION, OPERATION, MAINTENANCE, REPAIR AND REPLACEMENT OF UTILITY LINES."
- 4. THE "DRIVEWAY EASEMENT AGREEMENT" DATED JUNE 6, 2006 RECORDED IN THE OFFICE OF THE COUNTY CLERK OF BERNALILLO COUNTY, NEW MEXICO AS DOCUMENT NO 2000055083 (BOOK A-6, PAGE-4862) PROVIDES VEHICULAR AND PEDESTRIAN CROSS ACCESS EASEMENT BETWEEN LOT B-IA-I AND LOT B-I-A-2 AND THE "COSTCO PARCEL" LEGALLY DESCRIBED AS "TRACT A AND TRACT C-I OF PLAT OF MANZANO
- 5. ON ADJOINING TRACT A-1 OF THE COSTCO DEVELOPMENT PLAT THERE IS AN EXISTING 70'XISS' PRIVATE ACCESS EASEMENT FOR THE BENEFIT AND USE OF TRACT B-1, VIDEO ADDITION, ALBUQUERQUE, NEW MEXICO AS THE SAME IS SHOWN AND DESIGNATED ON THE PLAT THERE OF, RECORDED IN THE OFFICE OF THE COUNTY CLERK OF BERNALILLOW COUNTY, NEW MEXICO ON AUGUST 9, 1994 IN VOLUME 94C, FOLIO 263 FILED:
- 6. AS SHOWN ON THE PLAT FILED IN PLAT BOOK 94C, PAGE 263 THERE IS A RECIPROCAL ACCESS EASEMENT BY THE OWNER OF TRACT BI AND THE OWNER OF TRACT D: EACH GRANTED TO THE OTHER RECIPROCAL EASEMENT FOR CROSS ACCESS AND VEHICULAR PARKING ON AND OVER TRACT BI FOR THE BENEFIT OF TRACTS D AND ON AND OVER TRACT D FOR THE BENEFIT OF TRACT BI. THE OWNER OF TRACT BI AND THE OWNER OF TRACT D GRANTED TO THE OWNER OF TRACT C VEHICULAR ACCESS ACROSS TRACTS BI AND D RESPECTIVELY FOR PURPOSES OF INGRESS AND EGRESS.
- 7. DESIGN GROUND-MOUNTED EQUIPMENT SCREENING TO ALLOW FOR ACCESS TO UTILITY FACILITIES. ALL SCREENING AND VEGETATION SURROUNDING GROUND-MOUNTED TRANSFORMERS AND UTILITY PADS ARE TO ALLOW 10 FEET OF CLEARANCE IN FRONT OF THE EQUIPMENT DOOR AND 5-6 FEET OF CLEARANCE ON THE REMAINING THREE SIDES FOR SAFE OPERATION, MAINTENANCE AND REPAIR PURPOSES. REFER TO THE PMN ELECTRIC SERVICE GUIDE AT WWW.PNM.COM FOR SPECIFICATIONS.
- 8. LOT NUMBERS TBD UPON RECORDATION OF PENDING SUBDIVISION PLAT. 9. THE DEVELOPER SHALL BE RESPONSIBLE FOR PERMANENT IMPROVEMENTS TO THE TRANSPORTATION FACILITIES ADJACENT TO THE PROPOSED SITE DEVELOPMENT PLAN AS MAY BE REQUIRED BY THE DEVELOPMENT REVIEW BOARD (DRB).
- 10. SITE PLAN SHALL COMPLY AND BE IN ACCORDANCE WITH ALL APPLICABLE CITY OF ALBUQUERQUE REQUIREMENTS, INCLUDING THE DEVELOPMENT PROCESS MANUAL AND CURRENT ADA CRITERIA. II. APPLICANT SHALL BE RESPONSIBLE TO ABIDE BY ANY CONDITIONS OR TERMS OF UTILITY EASEMENTS. AN EXISTING OVERHEAD ELECTRIC DISTRIBUTION IS LOCATED ALONG THE EAST SIDE OF EUBANK BOULEYARD

#### LEGEND

NE AT THE PROJECT.

PROPERTY LINE	
BUILDING LINE	
NEW CURBS	
NEW SIDEWALK	4 LA
EXISTING CURBS AND SIDEWALKS	
COLORED AND TEXTURED CONCRETE AT PEDESTRIAN CROSSING	
(COO) HEW PARKING LIGHT FIXTURE	
EAGEMENT	

## Deviations Requested- Staff Summary Tables


- Table 1: Commercial Building & Lot Standards -

	Requirement		Requirement		Difference between	Deviation &
#	Page	Name	Amount	Proposed	Required & Proposed	Classification
1	5-36	Building Front Façade Lot Width Coverage	50% minimum	142.5 feet is 50%. 56 feet is proposed and is 20%	Lot is 285 feet wide.142.5-56=86.5 feet difference, or 30%	30%- Major
2	<del>5-36</del>	Front Yard Setback	10 feet maximum	24.75 feet from building	14.75 feet, 147.5% of the standard.	50% deviation is 15 feet. The EPC cannot grant deviations >50%*

#### - Table 2: General Design Regulations

- Table 2. General Design Regulations -							
		Requirer	nent		Difference between	Deviation	
#	Page	Name	Amount	Proposed	Required & Proposed	Classification	
3	5-46	Building Façade at Least 50% of Street Frontage	50% minimum	142.5 feet is 50%. 56 feet is proposed and is 20%	Lot is 285 feet wide.142.5-56=86.5 feet difference, or 30%	30%- Major	
4	5-48	Maximum Parking Allowed	ZC min plus 10% (33 spaces)	45 spaces.	12 extra spaces, a third of the standard	36%- Major	
5	5-55	Drive-up windows and Ordering Panels at Rear of Building		1 window at rear, 1 window at side, ordering panel at side	The side window and ordering panel should be at the rear of the building	non-dimensional standard requiring review	
6	5-56	No portion of queuing lane within 40 feet of street-facing façades	<u></u>	Queuing lane is within 25 feet of street facing facade	Relocate queuing lane to another location (many available)	non-dimensional standard requiring review	

Revised application is for 5 deviations instead of 6 (#2 is addressed). Three deviations (#s 1, 3 & 4) are still major in scope. Two deviations are still to non-dimensional standards.

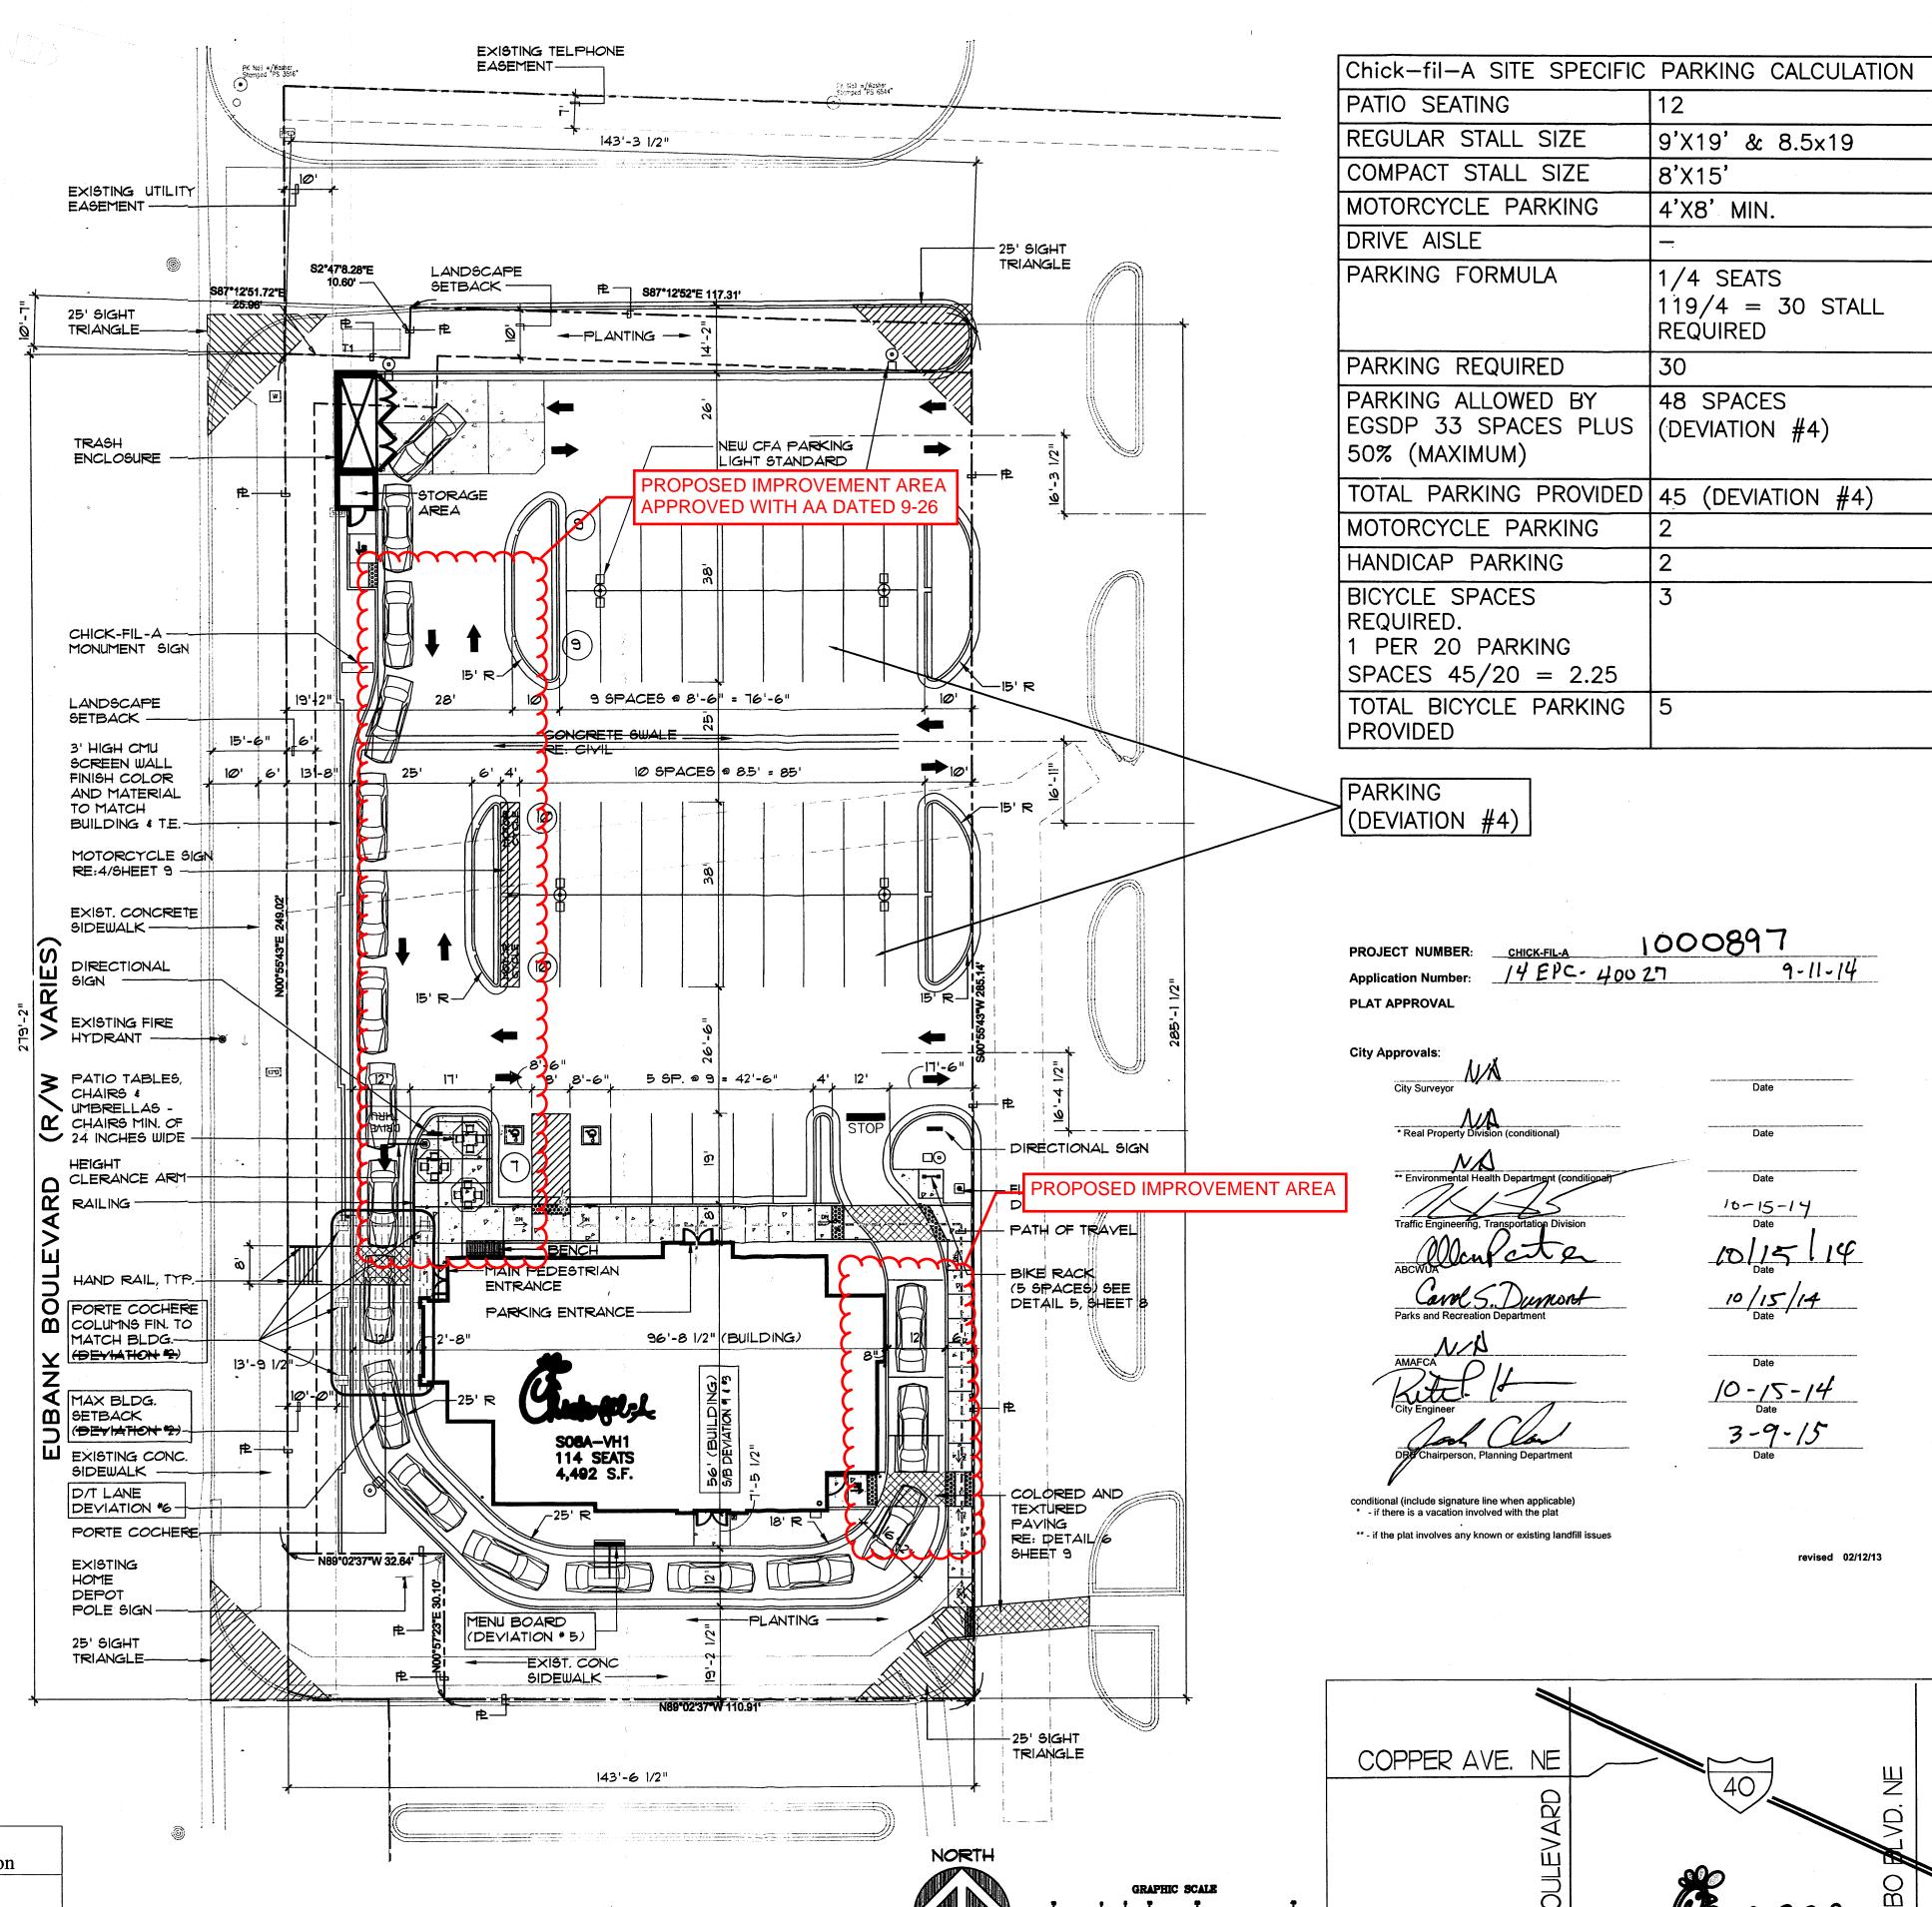

PRELIMINARY SITE PLAN

5200 Buffington F Atlanta Georgia, 30349-2998

Revisions: Mark Date 08/27/14 EF Mark Date <u>√E</u> 09/16/14 FF

Mark Date Mark Date 10/24/14 EF

Mark Date 11/07/14 EF Mark Date 11/21/14

Mark Date J 12/22/14 Mark Date

<u>M</u> 01/05/15 Mark Date 01/09/15

Mark Date 02/17/15 EF

Mark Date

 $C \circ R \circ H \circ O$ Architecture Interior Planning 195 South "C" Street 200

Tustin, California 92780 714 832-1834 FAX 832-1910

CHICK-FIL-A #03235 RESTAURANT CENTRAL & EUBANK

210 Eubank Blvd SE ALBUQUERQUE, NM 87123

SITE PLAN

VERSION: **HV1** ISSUE DATE: **07–2014** 

: <u>13–232</u> 03235 . 3-26-14 Checked By: RH

VICINITY MAP

SOUTHERN BLVD. SE

CENTRAL AVE. SE >

**OCCUPANCY:** A2 (RESTAURANT) FIRE SPRINKLERED: YES CONSTRUCTION: V-B **SITE AREA:** 40,000 S.F. BUILDING AREA: 4,492 S.F.

**FAR:** 11% **ZONING:** SU-2/EGC (EAST GATEWAY CORRIDOR ZONE)



5200 BUFFINGTON ROAD ATLANTA, GEORGIA 30349-2998 PHONE: (404) 765-8000 FAX: (404) 684-8550

# **DRAWING INDEX**

TITLE SHEET SITE PLAN LANDSCAPE PLAN LANDSCAPE DETAILS **GRADING PLAN** 

UTILITY PLAN PHOTOMETRIC SITE PLAN **EXTERIOR ELEVATIONS EXTERIOR ELEVATIONS** 

**REFUSE PLAN & ELEVATIONS** SITE DETAILS EXHIBIT "A" DELIVERY TRUCK ROUTE



Chick-fil-A 5200 Buffington Road Atlanta, Georgia 30349-2998



FOR AND AND ON-BEHALF OF **MERRICK AND COMPANY** 

TOTAL OVERALL PARKING SPACES ELIMINATED BY CFA CARVE OUT = TOTAL OVERALL PARKING SPACES AFTER CFA DEVELOPMENT =

**CHICK-FIL-A SITE PARKING REQUIREMENTS:** 

45 SPACES

49 SPACES

**EXISTING SHOPPING CENTER PARKING:** 

\* NOTE: 717 TOTAL PARKING SPACES INCLUDES 95

WITHIN CHICK-FIL-A PROPOSED DEVELOPMENT AREA.

THE HOME DEPOT PARCEL WITH THE REMOVAL OF 95

EXISTING HOME DEPOT (OVERALL PARKING LOT AREA): PARKING SPACES = 717

LOT AREA, PROPOSED CHICK-FIL-A DEVELOPMENT WILL ADD 45 PARKING SPACES TO NEW LOT AREA RESULTING IN A TOTAL NET LOSS OF 50 PARKING SPACES

TOTAL OVERALL PARKING SPACES REQUIRED BY CITY ORDINANCE =

**HOME DEPOT REQUIRED PARKING STALLS:** 

TOTAL OVERALL EXISTING PARKING SPACES

102,025 SQ. FT. HOME DEPOT BUILDING 9,000 SQ. FT. EXISTING MISC. BUILDING

**STANDARD SPACES REQUIRED:** 1 SP / 4 SEATS = 119 / 4 = 30 SP. REQ'D STANDARD SPACES PROVIDED: 42 SPACES 3 SPACES HANDICAP SPACES:

TOTAL SPACES PROVIDED: MAXIMUM PARKING ALLOWED BY EGSDP 33 SPACES PLUS 50%:

TOTAL MOTORCYCLE SPACES REQUIRED: 2 SPACES TOTAL MOTORCYCLE SPACES PROVIDED:

**TOTAL BICYCLE SPACES REQUIRED - 1 PER 20 PARKING SPACES** 3 REQUIRED **TOTAL BICYCLE SPACES PROVIDED:** 5 SPACES


# LANDLORD NOTES:

CHICK-FIL-A CONTRACTORS SHALL CONTACT BOB BURNSIDE, CONSTRUCTION MANAGER AT THE HOME DEPOT, 2 WEEKS PRIOR TO PROJECT START DATE, 714-749-6993, SUPERINTENDENT SHALL SUPPLY BOB BURNSIDE WITH WEEKLY STATUS REPORTS AND PICTURES OF PROGRESS TO BOB\_BURNSIDE@HOMEDEPOT.COM

# CHICK-FIL-A AT CENTRAL & EUBANK

TRACT B-1-A-2, OF THE PLAT OF TRACTS B-1-A-1 AND B-1-A-2, VIDEO ADDITION, WITHIN SECTION 28, TOWNSHIP 10 NORTH, RANGE 4 EAST, N.M.P.M. CITY OF ALBUQUERQUE, BERNALILLO COUNTY, NEW MEXICO

> 210 EUBANK BLVD. SE **ALBUQUERQUE, NM 87123**

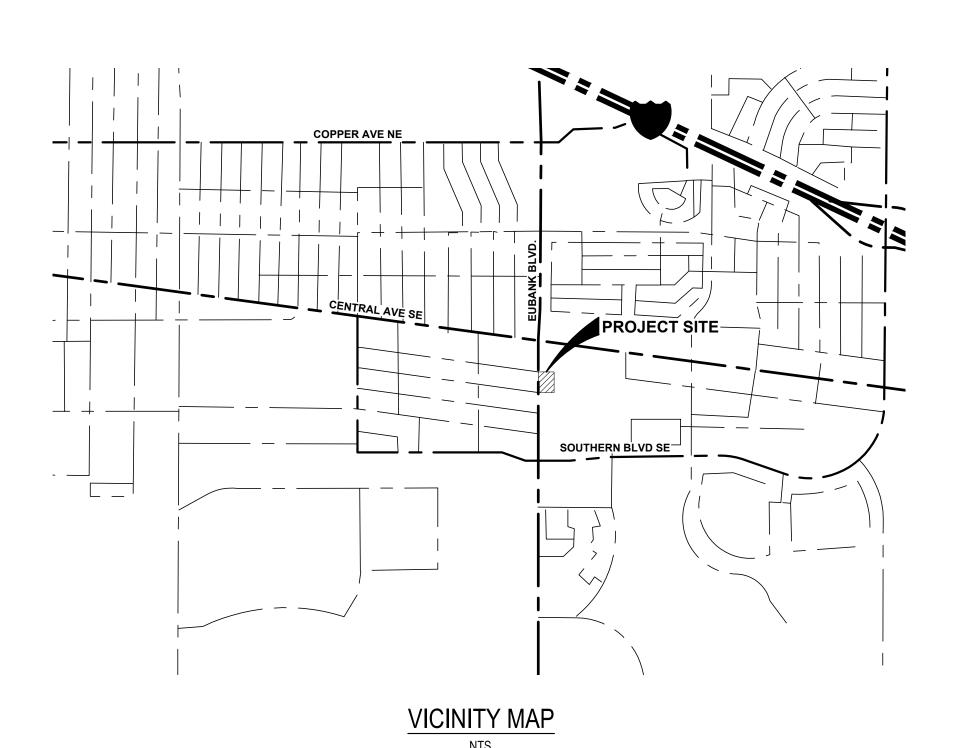

### - Table 2: General Design Regulations -

50% minimum | feet is proposed and is

**Deviations Requested - Staff Summary Tables** 

- Table 1: Commercial Building & Lot Standards -

Amount

Proposed

142.5 feet is 50%. 56

20%

24.75 feet from

Requirement

Building Front Façade

Lot Width Coverage

5-36 Front Yard Setback

Page

		Requirem	ient		Difference between	Davistas Olassitastas
#	Page	Name	Amount	Proposed	Required & Proposed	Deviation Classification
3	5-46	Building Façade at Least 50% of Street Frontage	50% minimum	142.5 feet is 50% 56 feet is proposed and is 20%	Lot is 285 feet wide. 142.5 - 56 = 86.5 feet difference, or 30%	30% - Major
4	5 – 48	Maximum Parking Allowed	ZC min plus 10% (33 spaces)	45 spaces	12 extra spaces, a third of the standard	36% - Major
5	5-55	Drive-up windows and Ordering Panels at Rear of Building	—	1 window at rear, 1 window at side, ordering panel at side	The side window and ordering panel should be at the rear of the	non-dimensional standard requiring review
6	5 – 56	No portion of queuing lane within 40 feet of street-facing façades	_	Queuing lane is within 25 feet of street façade	Relocate queuing lane to another location (many	non-dimensional standard requiring review

Revised application is for 5 deviations instead of 6 (#2 is addressed). Three deviations (#s 1, 3 & 4) are still major in scope. Two deviations are still to

non-dimensional standards.

#### **CIVIL ENGINEER:**

MERRICK AND COMPANY 5970 GREENWOOD PLAZA BLVD. GREENWOOD VILLAGE, CO, 80111 PHONE: (303) 751-0741

CONTACT: KRISTOFER WIEST EMAIL: KRIS.WIEST@MERRICK.COM

**CROSS ACCESS EASEMENT:** 

**ARCHITECT:** 

220 E CENTRAL PKWY, STE 4000

ALTAMONTE SPRINGS, FL 32701

CONTACT: JONATHAN FIESTA

EMAIL: JFIESTA@INTERPLANLLC.COM

INTERPLAN LLC

PHONE: (407) 645-5008

DRIVEWAY EASEMENT AGREEMENT, DATED APRIL 06, 2000 AND RECORDED JUNE 06, 2000 BOOK A6, PAGE 4682, BERNALILLO COUNTY, NEW MEXICO

2

C FOR

CONSULTANT PROJECT # 65121229 CONSTRUCTION

<u>DATE</u>

1229-C0.0\_COVER

SHEET NUMBER

#### OF XX

Difference between Deviation & Required & Proposed | Classification

30% - Major

50% deviation is 15

feet. The EPC cannot

grant deviations

Lot is 285 feet wide.

142.5-56 = 86.5 feet

difference, or 30%

14.75 feet, 147.5%

of the standard.

AOTORCYCLE PARKING	2
OTAL PARKING PROVIDED	45 (DEVIATION /4)
60 (MAXIMUM)	(DEVIATION 4)
SPACES PLUS	40 SFACES
PARKING ALLOWED BY EGSDP 33	48 SPACES
PARKING REQUIRED	30
ANNINGTONWOLA	11 9/4 = 30 STALL REQUIRED
PARKING FORMULA	1/4 SEATS
PRIVE AISLE	
NOTORCYCLE PARKING	4'X8' MIN.
COMPACT STALL SIZE	8'X15'
REGULAR STALL SIZE	9'X19 & 8.5x19

MOTORCYCLE PARKING HANDICAP PARKING BICYCLE SPACES REQUIRED. 1 PER 20 PARKING SPACES 45/20 - 2 25 TOTAL BICYCLE PARKING

PROVIDED

# **Deviations Requested - Staff Summary Tables**

#### - Table 1: Commercial Building & Lot Standards -

		Requirement			Difference between	Deviation &
#	Page	Name	Amount	Proposed	Required & Proposed	Classification
1	5-36	Building Front Façade Lot Width Coverage	50% minimum	142.5 feet is 50%. 56 feet is proposed and is 20%	Lot is 285 feet wide. 142.5-56 = 86.5 feet difference, or 30%	30% - Major
2	<del>5 – 36</del>	Front Yard Setback	10 feet maximum	24.75 feet from building	14.75 feet, 147.5% of the standard.	50% deviation is 15 feet. The EPC cannot grant deviations >50%*

#### - Table 2: General Design Regulations -

		Requirem	nent		Difference between	Davista Olassita stan
#	Page	Name	Amount	Proposed	Required & Proposed	Deviation Classification
3	5 – 46	Building Façade at Least 50% of Street Frontage	50% minimum	142.5 feet is 50% 56 feet is proposed and is 20%	Lot is 285 feet wide. 142.5 - 56 = 86.5 feet difference, or 30%	30% - Major
4	5 – 48	Maximum Parking Allowed	ZC min plus 10% (33 spaces)	45 spaces	12 extra spaces, a third of the standard	36% - Major
5	5 – 55	Drive-up windows and Ordering Panels at Rear of Building	_	1 window at rear, 1 window at side, ordering panel at side	The side window and ordering panel should be at the rear of the	non-dimensional standard requiring review
6	5 – 56	No portion of queuing lane within 40 feet of street-facing façades	_	Queuing lane is within 25 feet of street façade	Relocate queuing lane to another location (many available)	non-dimensional standard requiring review

Revised application is for 5 deviations instead of 6 (#2 is addressed). Three deviations (#s 1, 3 & 4) are still major in scope. Two deviations are still to

GRAPHIC SCALE

copper ave. n CENTRAL AVE. SE southern blvd. se **LEGEND** 

**TRIANGLE** 

EX DIRECTIONAL SIGN

- EX GROUND LIGHTED

- EX METAL GUARDRAIL

FLAG POLE

EX FLAG POLE

EX BIKE RACK

25' SIGHT

TRIANGLE

**EXISTING 10.0' PRIVATE** 

STORM EASEMENT

PROPERTY LINE	
BUILDING LINE	
NEW CURBS	
NEW SIDEWALK	
EXISTING CURBS AND SIDEWALKS	
EASEMENT	

#### **NOTES**

1.PERMANENT ACCESS DRIVE EASEMENT. THE "DECLARATION OF CO VENANTS, CONDITIONS AND RESTRICTIONS REGARDING OUTPARCEL" (RECORDED AS DOCUMENT NO. 2012138716 ON THE 31ST DAY OF DECEMBER 2012) STATES WITHIN SECTION 3.2 THAT THE OWNER OF TRACT B--1-- A--1 "HEREBY GRANTS TO THE OU TPARCEL OWNER (TRACT B--1-- A--2), AS CRAN TEE, FOR THE BENEFIT OF THE OU TPARCEL OWNER AND ITS RESPECTIVE PERMITEES APPURTENANT TO THE OUTPARCEL, A PERPETUAL NON -- EXCLUSIVE EASEMENT FOR INGRESS AND EGRESS BY VEHICULAR AND PEDESTRIAN TRAFFIC UPON, OVER AND ACROSS THAT PORTION OF THE COMMON AREA LOCATED ON THE HOME DEPOT PARCEL (TRACT B--1-- A--1) SHOWN ON EXHIBIT "B" AS THE PERMANENT ACCESS DRIVE"

RECIPROCAL STORM DRAINAGE EASEMENT. THE "DECLARATION OF COVENAN TS, CONDITIONS AND RESTRICTIONS RECARDING OUTPARCEL" (RECORDED AS DOCUMENT NO. 2012138716 ON THE 31ST DAY OF DECEMBER, 2012) STATES WITHIN SECTION 3.5 THAT THE OWNER OF TRACT B--1-- A--1 AND THE OWNER OF TRACT B--1-- A--2 RECIPROCALLY GRANT TO ONE ANOTHER "A NON -EXCLUSIVE EASEMENT OVER AND UNDER ITS PARCEL FOR SURFACE WATER DRAINACE OVER AND THROUGH THE DRAINAGE PATTERNS AND STORM WATER DRAINAGE SYSTEMS THAT ARE ESTABLISH FROM TIME TO TIME AMONG THE PARCELS.

3. GRANT OF UTILITY EASEMENTS. THE "DECLARATION OF COVEN ANTS, CONDITIONS AND RESTRICTIONS REGARDING OUTPARCEL "(RECORDED AS DOCUMENT NO. 2012138716 ON THE 31ST DAY OF DECEMBER, 2012) STATES WITHIN SECTION 3.1 (a) THAT THE OWNER OF TRACT B--1-- A--1 AND OWNER OF TRACT B--1-- A--2 RECIPROCALLY CRANT TO ONE ANOTHER "A NON -- EXCLUSIVE AND PERPETUAL EASEMENT UNDER, THROUGH AND ACROSS THE COMMON AREA OF THE HOME DEPOT PARCEL (TRACT B--1-- A--1) OR THE OUTPARCEL (TRACT B--1-- A--2), AS APPLICABLE (EXCLUSIVE OF AN Y POR TION WITHIN A BUILDING AREA), FOR THE INSTALLATION, OPERATION, MAINTENANCE, REPAIR AND REPLACEMENT OF UTILITY LINES."

4. THE "DRIVEWAY EASEMENT AGREEMENT" DATED JUNE 6, 2006 RECORDED IN THE OFFICE OF THE COUNTY CLERK OF BERNALILLO COUNTY, NEW MEXICO AS DOCUMEN T NO 2000055083 (BOOK A--6, PACE--4862) PROVIDES VEHICULAR AND PEDESTRIAN CROSS ACCESS EASEMEN T BETWEEN LOT B--1A--1 AND LOT B--1-- A--2 AND THE "COSTCO PARCEL" LEGALLY DESCRIBED AS "TRACT A AND TRACT C--1 OF PLAT OF MAN Z ANO MESA".

5. ON ADJOINING TRACT A--1 OF THE COSTCO DEVELOPMENT PLAT THERE IS AN EXISTING 70'X185' PRIVATE ACCESS EASEMENT FOR THE BENEFIT AND USE OF TRACT B--1, VIDEO ADDITION, ALBUQUERQUE, NEW MEXICO AS THE SAME IS SHOWN AND DESIGNATED ON THE PLAT THERE OF, RECORDED IN THE OFFICE OF THE COUNTY CLERK OF BERNALILLOW COUNTY, NEW MEXICO ON AUGUST 9, 1994 IN VOLUME 94C, FOLIO 263 FILED: FEBRUARY 20, 2001 (2001C--56).

6. AS SHOWN ON THE PLAT FILED IN PLAT BOOK 94C, PAGE 263 THERE IS A RECIPROCAL ACCESS EASEMENT BY THE OWNER OF TRACT B1 AND THE OWNER OF TRACT D: EACH GRANTED TO THE OTHER RECIPROCAL EASEMENT FOR CROSS ACCESS AND VEHICULAR PARKING ON AND OVER TRACT B1 FOR THE BENEFIT OF TRACTS D AND ON AND OVER TRACT D FOR THE BENEFIT OF TRACT B1. THE OWNER OF TRACT B1 AND THE OWNER OF TRACT D GRANTED TO THE OWNER OF TRACT C VEHICULAR ACCESS ACROSS TRACTS B1 AND D RESPECTIVELY FOR PURPOSES OF INCRESS AND ECRESS.

7. DESIGN GROUND-- MOUNTED EQUIPMENT SCREENING TO ALLOW FOR ACCESS TO UTILITY FACILITIES. ALL SCREENING AND VECETATION SURROUNDING GROUND--MOUN TED TRANSFORMERS AND UTILITY PADS ARE TO ALLOW 1 0 FEET OF CLEARANCE IN FRONT OF THE EQUIPMEN T DOOR AND 5--6 FEET OF CLEARANCE ON THE REMAINING THREE SIDES FOR SAFE OPERATION, MAINTENANCE AND REPAIR PURPOSES. REFER TO THE PMN ELECTRIC SERVICE CUIDE AT WWW.PNM. COM FOR SPECIFICATIONS.

8. LOT NUMBERS TBD UPON RECORDATION OF PENDING SUBDIVISION PLAT.

9. THE DEVELOPER SHALL BE RESPONSIBLE FOR PERMANENT IMPROVEMENTS TO THE TR ANSPOR TATION FACILITIES ADJACEN T TO THE PROPOSED SITE DEVELOPMENT PLAN AS MAY BE REQUIRED BY THE DEVELOPMENT REVIEW BOARD (DRB).

10. SITE PLAN SHALL COMPLY AND BE IN ACCORDANCE WITH ALL APPLICABLE CITY OF ALBU QUER QUE REQUIREMEN TS, INCLUDING THE DEVELOPMENT PROCESS MANUAL AND CURREN T ADA CRITERIA.

11. APPLICANT SHALL BE RESPONSIBLE TO ABIDE BY ANY CONDITIONS OR TERMS OF UTILITY EASEMEN TS. AN EXISTING OVERHEAD ELECTRIC DISTRIBUTION IS LOCATED ALONG THE EAST SIDE OF EUBANK BOULEVARD NE AT THE PROJECT.



Chick-fil-A **5200 Buffington Road** Atlanta, Georgia 30349



FOR AND AND ON-BEHALF OF **MERRICK AND COMPANY** 

BUILDING TYPE / SIZE: P12 LS LRG

REVISION SCHEDULE

NO. DATE DESCRIPTION

0

0

CONSULTANT PROJECT # 65121229 CONSTRUCTION

1229-C-1.0-SITE

SHEET NUMBER

#### OF XX

LIMITS OF C.F.A

CONSTRUCTION

EX PARKING LIGHT

TRAFFIC

DELINEATORS

CONCRETE PAN ---

- ORDER POINT CANOPY

EX MOTORCYCLE SIGN

DELINEATORS ,

- EX DIRECTIONAL

EX PATIO TABLES,

EX PARKING -

ENTRANCE

56' (BUILDING)

S/B DEVIATION #1 & #3

(N89°03'00"W 110.91') 110.91

CHAIRS &

CLEARANCE ARM

ENTRANCE

EX PORTE COCHERE

EX MENU BOARD :

EX SIDEWALK —

- EX MAIN PEDESTRIAN

UMBRELLAS

MENU ORDER

BOARD

→ PLANTING →

PROPOSED IMPROVEMENT AREA

PPROVED WITH AA DATED 9-26

- GREASE INTERCEPTOR

WITH TRAFFIC RATED LIDS

10

LANDSCAPE -

SETBACK -

25 ' SIGHT -

**TRIANGLE** 

EX TRASH

**ENCLOSURE** 

**EXISTING 10.0' PUBLIC** 

UTILITY EASEMENT

LANDSCAPE

EX 3' HIGH CMU -

PROPERTY -

DIRECTIONAL ·

EX RAILING

ARROWS

EX HOME DEPOT -

BOUNDARY

EX FIRE

EX STEPS & HAND RAIL

COLUMNS

MAX BLDG.

TRIANGLE

SETBACK

EX PORTE COCHERE

HYDRANT

SCREEN WALL

EXISTING PARKING -

BE RELOCATED

LIGHT STANDARD TO

SETBACK

CHICK-FIL-A ₩

MONUMENT SIGN

G.C TO COORD.

CABINET FINISH

W / SIGN CO.

Know what's below.

Call before you dig.

3



Chick-fil-A 5200 Buffington Road Atlanta, Georgia 30349-2998



FOR AND AND ON-BEHALF OF MERRICK AND COMPANY

# CHICK-FIL-A CENTRAL & EUBANK

FSR# 3235
BUILDING TYPE / SIZE: P12 LS LRG

BUILDING TYPE / SIZE: P12 LS LI
RELEASE: VX.YY.M

REVISION SCHEDULENO.DATEDESCRIPTION

CONSULTANT PROJECT# 65121229

PRINTED FOR CONSTRUCTION
DATE

DRAWN BY
SHEET

1229-C-2.0-UTILITY PLAN


SHEET NUMBER

9

C

**03** 

OF VV

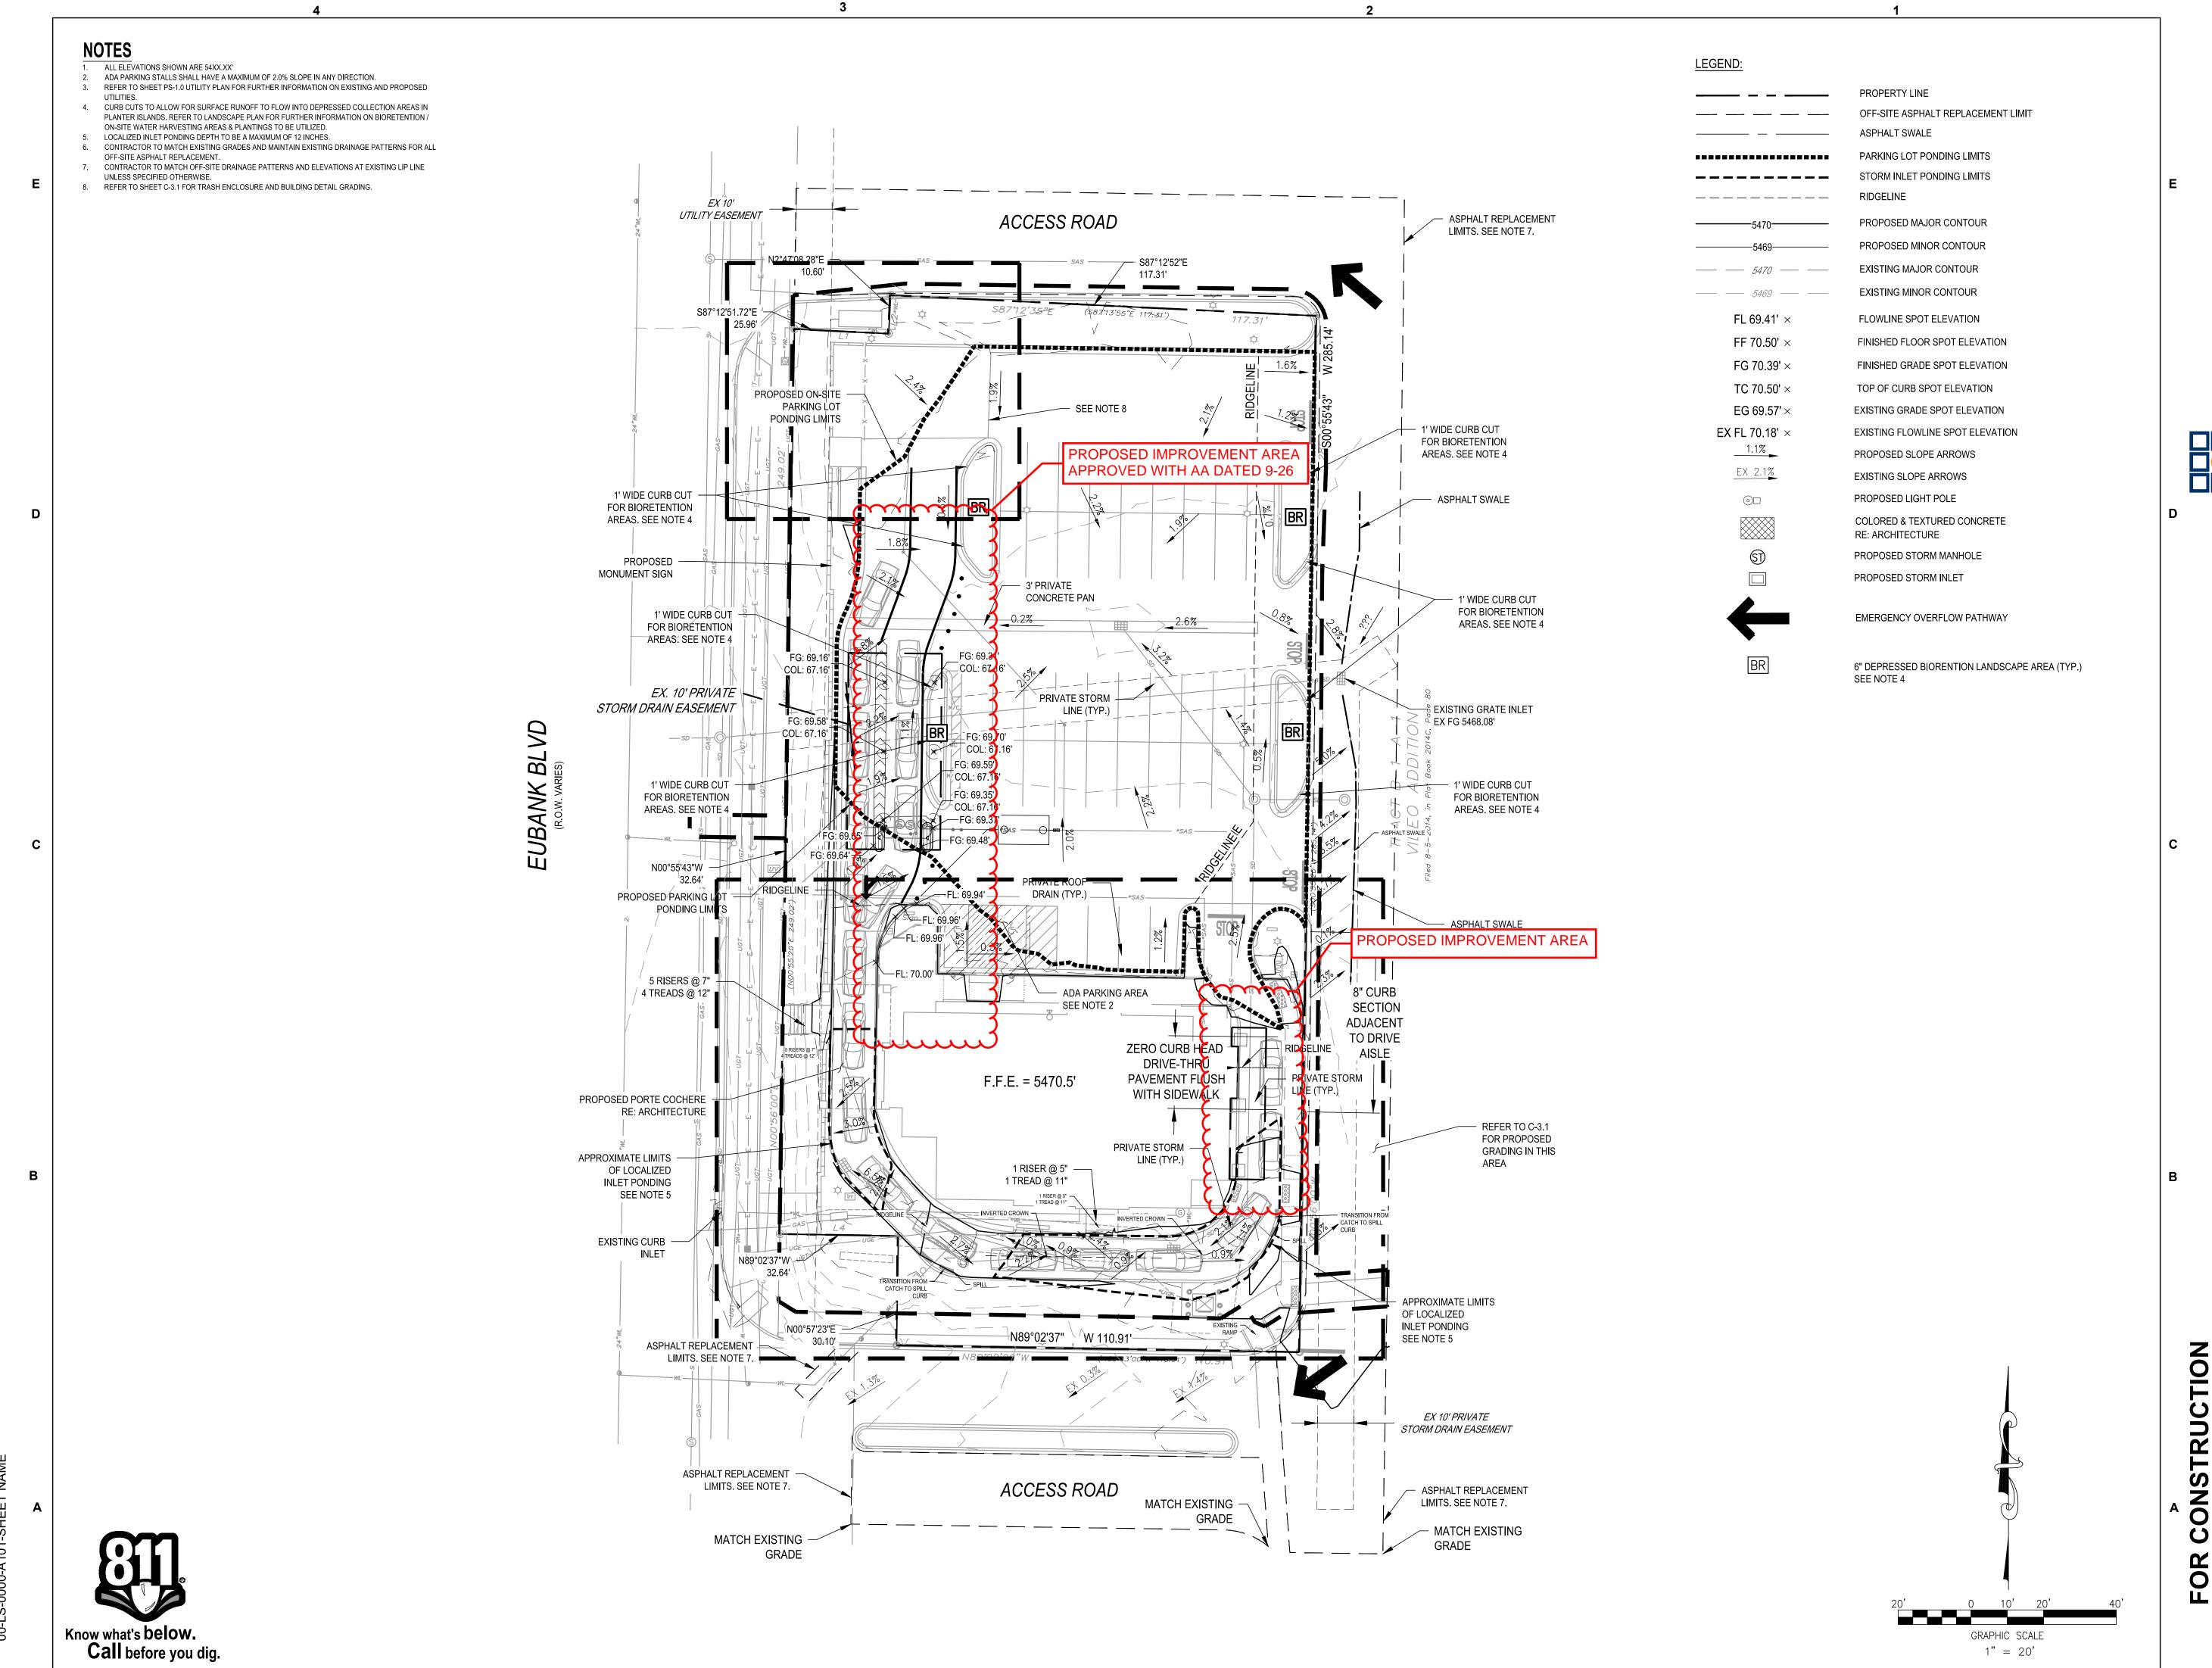

2

3


4







5200 Buffington Road

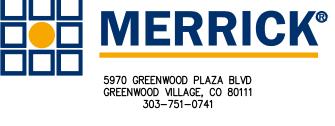

FOR AND AND ON-BEHALF OF MERRICK AND COMPANY

BUILDING TYPE / SIZE:


REVISION SCHEDULE

NO. DATE DESCRIPTION

CONSULTANT PROJECT # 65121229 CONSTRUCTION 1229-C-3.0\_GRADING

SHEET NUMBER

LIMITS OF C.F.A — AGCESS ROAD LANDSCAPE -CONSTRUCTION — 25' SIGHT 25 ' SIGHT -SETBACK \_ TRIANGLE TRIANGLE → PLANTING → EX PARKING LIGHT PROPOSED STRIPING EX TRASH -PAINTED WHITE **ENCLOSURE** PROPOSED IMPROVEMENT AREA APPROVED WITH AA DATED 9-26 DELINEATORS EX 10.0' PUBLIC UTILITY EASEMENT CONCRETE PAN — EX 3' HIGH CMU - ORDER POINT CANOPY SCREEN WALL EX 10.0' PRIVATE STORM-DRAIN EASEMENT EX MOTORCYCLE SIGN PROPERTY -- GREASE INTERCEPTOR BOUNDARY WITH TRAFFIC RATED LIDS - TRAFFIC DELINEATOR EX FIRE 🛁 HYDRANT DIRECTIONAL EX DIRECTIONAL EX DIRECTIONAL SIGN SIGN STORM EASEMENT PROPOSED IMPROVEMENT AREA CLEARANCE ARM ─ EX FLAG POLE EX STEPS & -HAND RAIL — EX MAIN PEDESTRIAN ENTRANCE – EX BIKE RACK EX PORTE COCHERE **ENTRANCE** COLUMNS — EX METAL GUARDRAIL EX PORTE COCHERE 56' (BUILDING) S/B DEVIATION #1 & #3 EX HOME DEPOT -25' SIGHT TRIANGLE EX SIDEWALK —— (N89°03'00"W 110.91') 110.91' — 25' SIGHT TRIANGLE ACCESS ROAD Know what's below.

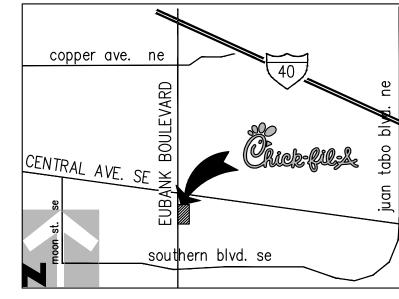

#### LEGAL DESCRIPTION

TRACT LETTERED B-ONE-A (B-1-A) OF THE PLAT FOR THE VIDEO ADDITION, TRACTS B-1-A AND B-1-B, CITY OF ALBUQUERQUE, BERNALILLO COUNTY, NEW MEXICO, AS THE SAME IS SHOWN AND DESIGNATED ON THE PLAT THEREOF, FILED IN THE OFFICE OF THE COUNTY CLERK OF BERNALILLO, NEW MEXICO, ON AUGUST 23, 1999 IN PLAT BOOK 99C, PAGE 239

#### **EXECUTIVE SUMMARY**

THE PROJECT SITE IS LOCATED AT THE SOUTH-EAST CORNER OF CENTRAL AVE. & EUBANK BLVD. THE PROPOSED IMPROVEMENTS TO THE EXISTING CHICK-FIL-A SITE WILL INCREASE THE AMOUNT OF AVAILABLE STACKING WITHIN THE DRIVE THRU LANE. IN ADDITION, A CANOPY WILL BE INSTALLED OVER THE RELOCATED ORDER POINTS AND THE MEAL DELIVERY WINDOW AT THE EXISTING BUILDING. THE CANOPIES ARE BEING INSTALLED FOR TEAM MEMBER SAFETY, AND INCLUDE HEAT, FANS, AND LIGHTING. TRAFFIC FLOWS WITHIN THE PROJECT SITE WILL NOT BE SIGNIFICANTLY ALTERED AND THEREFORE THERE ARE NO FORESEEN


- 1. THE HEIGHT OF THE PROPOSED PRECAST GREASE INTERCEPTOR WILL BE 0.2' ABOVE FINISHED GRADE OR MATCH SIDEWALK GRADES WHERE REQUIRED
- 2. ALL IMPROVEMENTS LOCATED IN THE RIGHT OF WAY MUST BE INCLUDED ON A PUBLIC WORK ORDER.
- 3. LANDSCAPING AND SIGNAGE WILL NOT INTERFERE WITH CLEAR SIGHT REQUIREMENTS. THEREFORE, SIGNS, WALLS, TREES, AND SHRUBBERY BETWEEN 3 AND8 FEET TALL (AS MEASURED FROM THE GUTTER PAN) WILL NOT BE
- 4. COLORED & TEXTURED CONCRETE WALK IN DRIVE-THRU TO UTILIZE INTEGRAL COLORING AS OPPOSED TO STAINED CONCRETE. COLOR FOR CROSSWALKS TO BE DAVID CONCRETE COLOR ADOBE. CROSSWALK PATTERN TO BE 2'X2' SCORED DIAMOND.

#### **LEGEND**

PROPERTY LINE	
BUILDING LINE	
NEW CURBS	
NEW SIDEWALK	
EXISTING CURBS AND SIDEWALKS	
EASEMENT	

SITE DATA TABLE	
TYPE OF DEVELOPMENT	RESTAURANT
SIZE OF DEVELOPMENT	0.92 ACRES
PATIO SEATING	12
BICYCLE SPACES REQUIRED	3
BICYCLE SPACES PROVIDED	5
MOTORCYCLE PARKING	2

SITE PARKING	
PARKING REQUIRED	30
STANDARD PARKING PROVIDED	43
HANDICAP PARKING PROVIDED	2
TOTAL PARKING PROVIDED	45

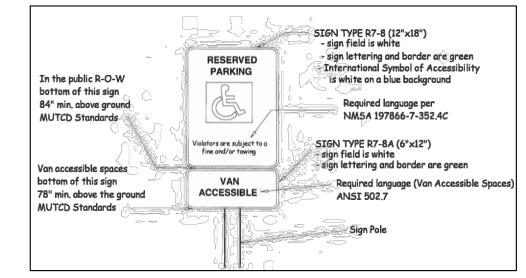

0

FSR#0000 BUILDING TYPE / SIZE: P12 LS LRG **REVISION SCHEDULE** NO. DATE DESCRIPTION X XX/XX/XX XXXXXXXXXX

65121229 FOR REVIEW

Chick-fil-A

**5200 Buffington Road** 

Atlanta, Georgia 30349

5970 GREENWOOD PLAZA BLVD

GREENWOOD VILLAGE, CO 80111 303-751-0741


FOR AND AND ON-BEHALF OF

MERRICK AND COMPANY


1229-C-4.0\_TRAFFIC **CIRCULATION PLAN** 

06/14/2022

5 OF 12

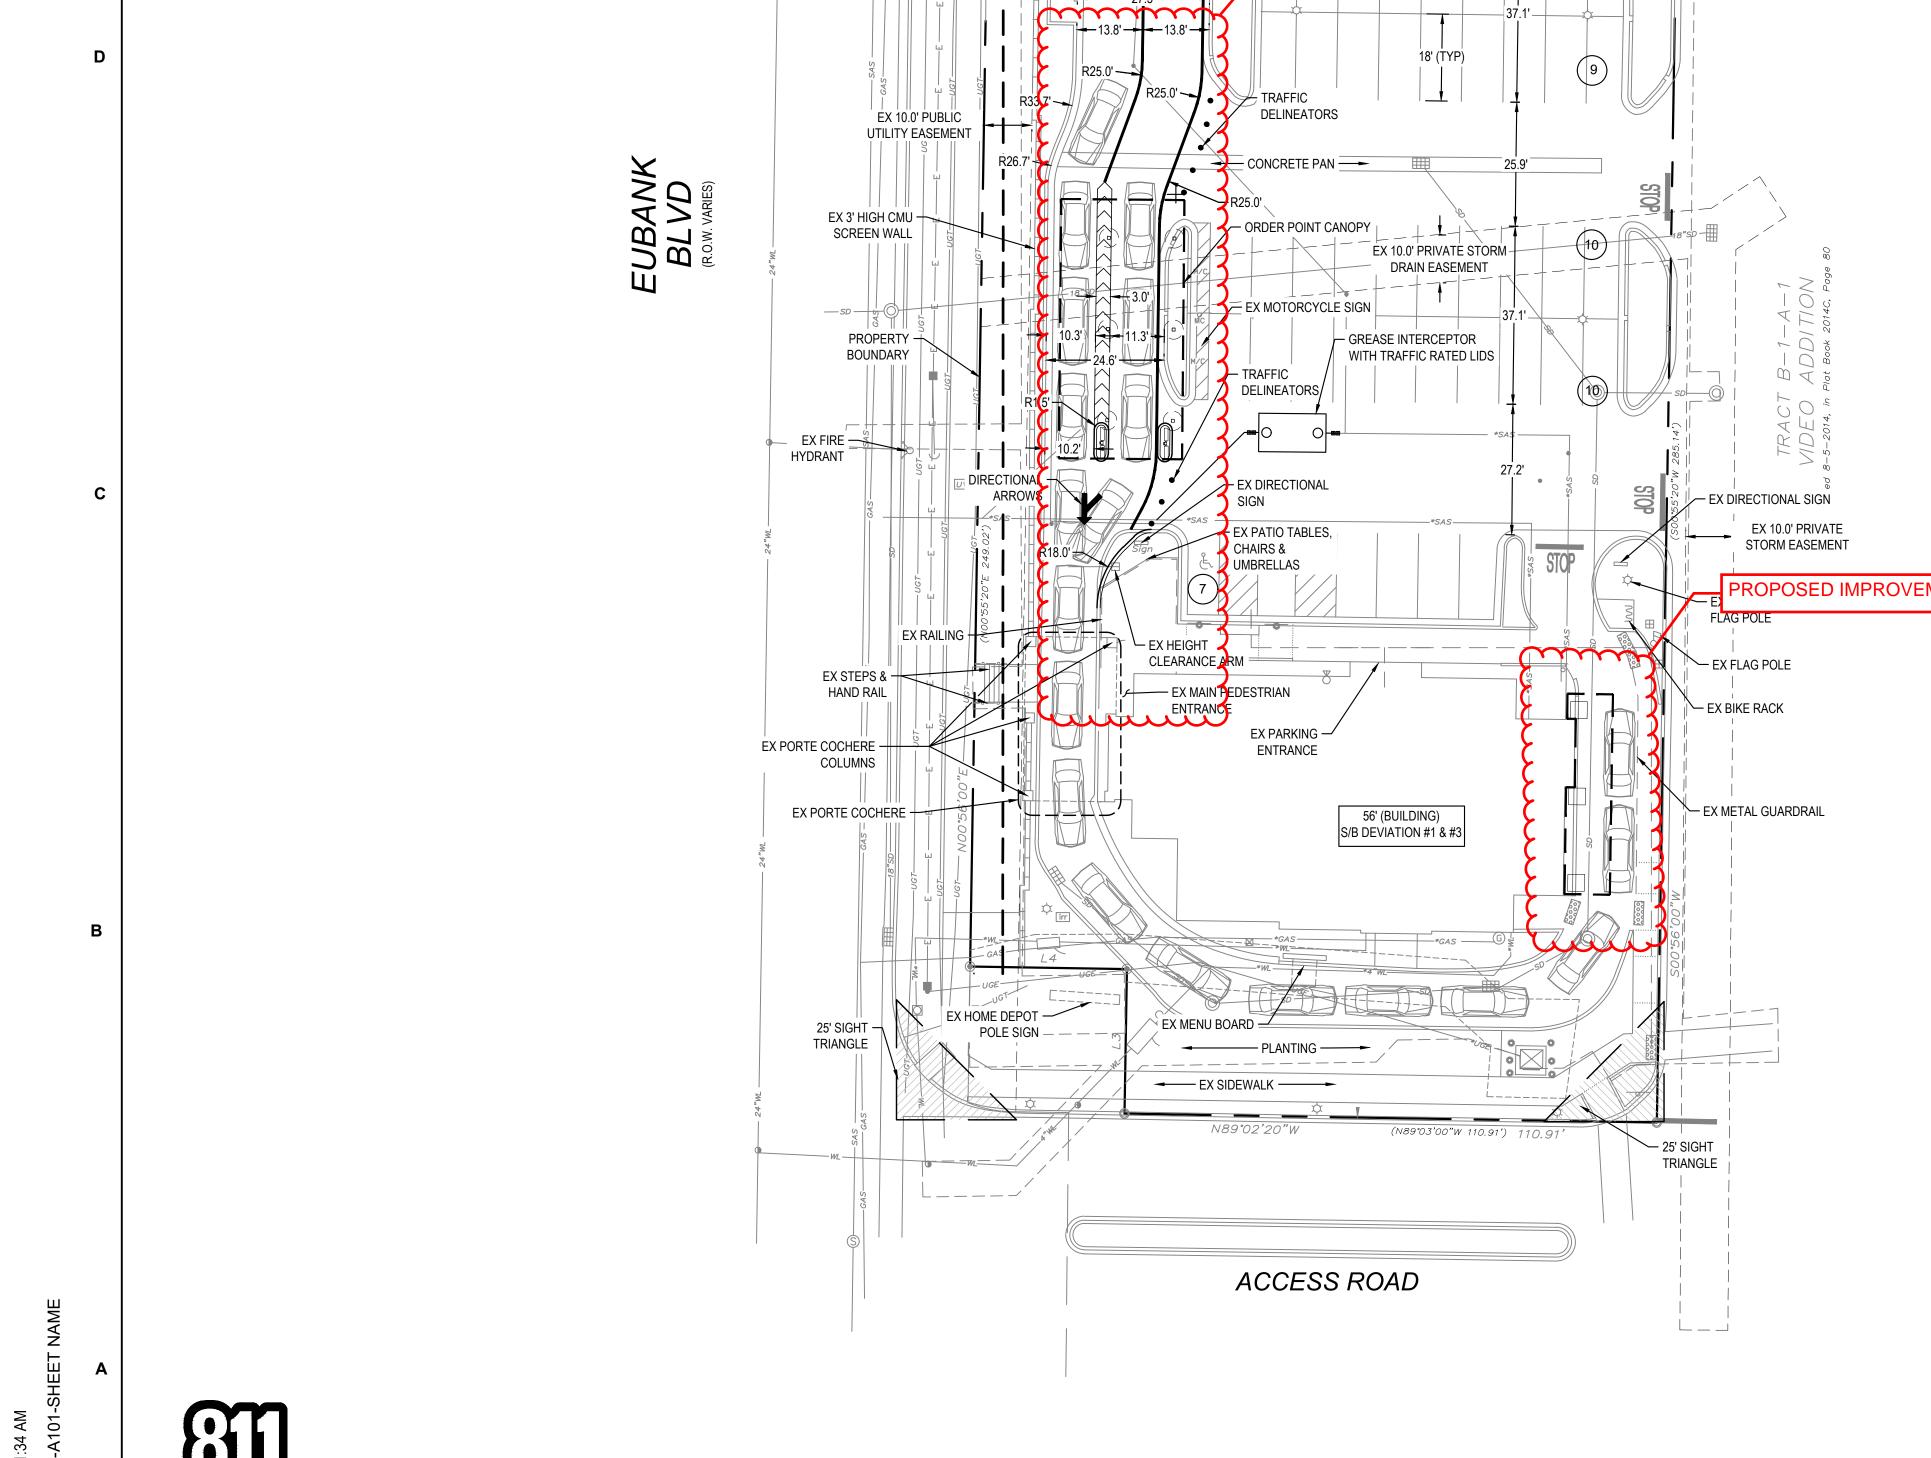

Call before you dig.

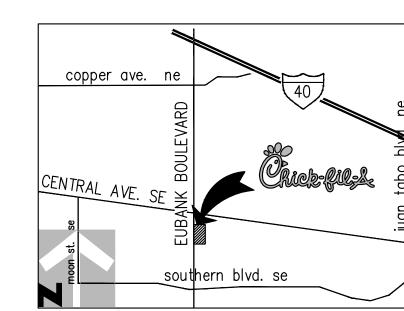

IMPACTS TO THE ADJACENT USERS.

#### **NOTES**

- ACCEPTABLE IN THE CLEAR SIGH TRIANGLE.

ERTY LINE	
DING LINE	
CURBS	
SIDEWALK	
ING CURBS SIDEWALKS	
MENT	

CITE DATA TADI E	
SITE DATA TABLE	
TYPE OF DEVELOPMENT	RESTAURANT
SIZE OF DEVELOPMENT	0.92 ACRES
PATIO SEATING	12
BICYCLE SPACES REQUIRED	3
BICYCLE SPACES PROVIDED	5
MOTORCYCLE PARKING	2

	ł
SITE PARKING	
PARKING REQUIRED	30
STANDARD PARKING PROVIDED	43
HANDICAP PARKING PROVIDED	2
TOTAL PARKING PROVIDED	/15

**PARKING SIGN DETAILS**