

**ADMINISTRATIVE AMENDMENT**

**FILE # \_\_\_\_\_ PROJECT # \_\_\_\_\_**

\_\_\_\_\_


\_\_\_\_\_

\_\_\_\_\_

**APPROVED BY**

**DATE**



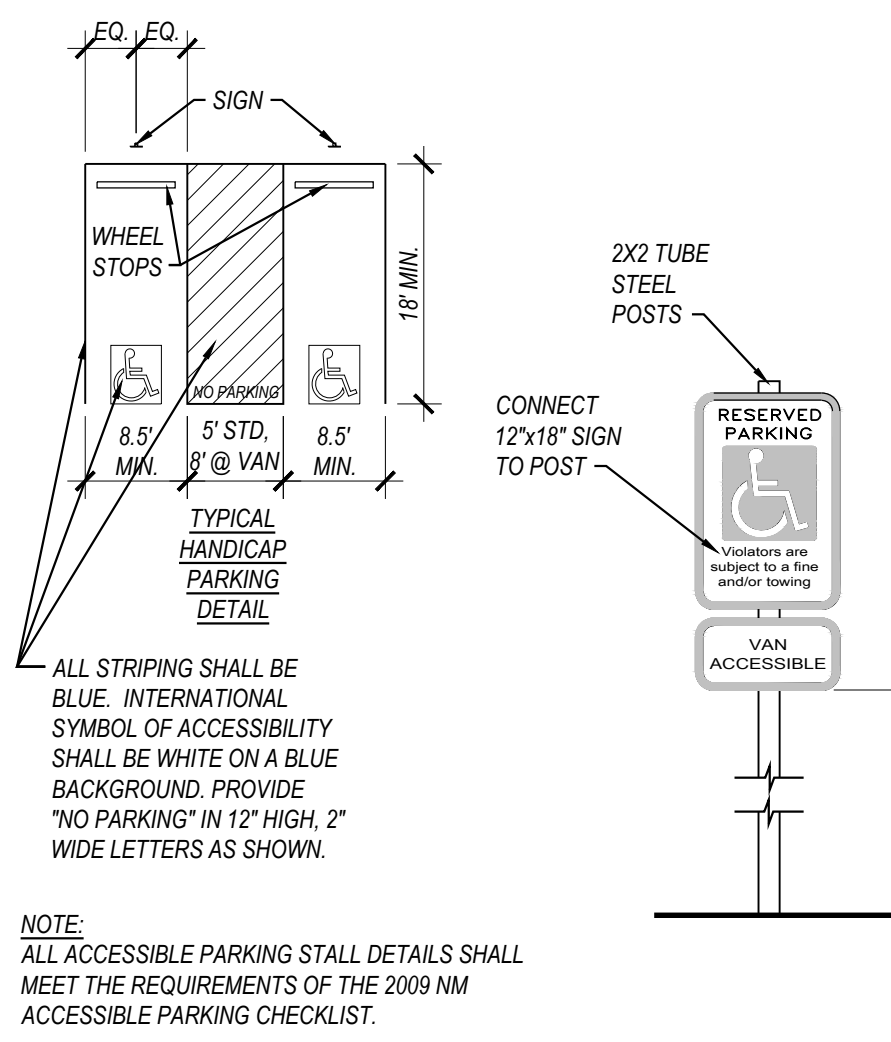

**1 ACCESSIBLE PARKING DETAILS**  
SCALE: NOT TO SCALE

**GENERAL SITE NOTES**

- ALL SITE LIGHTING IS EXISTING TO REMAIN.
- ALL SIDEWALKS TO BE 4" THICK MINIMUM 4000 PSI CONCRETE. BROOM FINISH WITH 1/8" PER 1'-0" MAXIMUM CROSS SLOPE. OVER COMPACTED GRADE UNLESS NOTED OTHERWISE ON GRADING PLAN. PROVIDE EXPANSION JOINTS EVERY 4'-0" LINEAR FEET AND CONTROL JOINTS EVERY 20'-0" LINEAR FEET. TOOL EDGES WITH 1/4" FINISHING TOOL. PROVIDE 6" WIDE X 12" DEEP TURN DOWN EDGE AT CURBS AND ADJACENT TO PAVING. REINFORCE TURNDOWNS WITH #4 BAR CONTINUOUS.
- ALL STRIPING TO BE PER MUTCD STANDARDS FOR TRAFFIC PAINT AND SHALL BE WHITE IN COLOR UNLESS NOTED OTHERWISE. THE INTERNATIONAL SYMBOL OF ACCESSIBILITY SHALL BE PAINTED WHITE ON BLUE IN EACH ACCESSIBLE PARKING STALL. ALL STRIPING IS EXISTING TO REMAIN UNLESS NOTED OTHERWISE.
- ALL HEADER CURBS, MEDIAN AND STANDARD CURB & GUTTERS TO BE CONSTRUCTED PER C.O.A. STANDARD DRAWINGS #2415A AND #2415B.
- CONCRETE PARKING BUMPERS TO BE 7'-0" WIDE MINIMUM. SLOT BOTTOM AND REINFORCED WITH AT LEAST (2) #3 BARS TYPICAL. ANCHOR TO PAVING WITH WITH (2) 1/8" LONG #6 DOWELS TYPICAL.

**CITY OF ALBUQUERQUE NOTES**

- "THE RESPONSIBLE PARTY MUST RECTIFY ALL UNAPPROVED CONSTRUCTION RESULTING FROM ERRORS ON THE APPROVED SITE PLAN"
- THIS SITE PLAN HAS BEEN APPROVED AND ACCEPTED BY ALL PARTIES. ANY FIELD CHANGES NOT EXCEPTED BY THE TRAFFIC ENGINEER AFTER APPROVAL WILL RESULT IN: (1) UNTIMELY DELAY OF INITIAL INSPECTION FOR TEMPORARY CERTIFICATE OF OCCUPANCY IN ORDER TO CORRECT UNAPPROVED WORK, AND (2) INCREASE IN CONSTRUCTION COST TO RESPONSIBLE PARTIES.
- ALL ASPHALT AND CONCRETE CONSTRUCTION MUST BE 100% COMPLETE BEFORE INITIAL INSPECTION, FOR TEMPORARY C.O. WILL BE SCHEDULED.
- ALL SIDEWALK AND C&G IN DISREPAIR WILL BE REMOVED AND REPLACED. CONTRACTOR MUST BE MADE AWARE THAT ANY AGREEMENT WITH THE OWNER STATING PORTIONS OF THIS BUILDING PERMIT WORK TO BE COMPLETED BY THE OWNER, OR A REPRESENTATIVE, WILL MEAN CERTIFICATE OF OCCUPANCY WILL NOT BE ISSUED UNTIL ALL WORK IS FINISHED.
- CERTIFICATION BY THE DESIGNER OF RECORD, REQUIRED BY THE TRANSPORTATION SECTION, NEEDS TO STATE THAT THIS SITE WAS CONSTRUCTED IN ACCORDANCE WITH THE TRAFFIC CIRCULATION LAYOUT (TCL) BEFORE C.O. IS RELEASED.

**SITE PLAN KEYED NOTES:**

- REMOVE EXISTING TOWER ELEMENT AND REPAIR PARAPET TO MATCH EXISTING.
- REMOVE EXISTING DAMAGED CONCRETE SIDEWALK AND CURBING AND REPLACE WITH NEW. ADD RADIUS CURBS AS SHOWN. ALL NEW CURBING SHALL BE PAINTED RED WITH "FIRE LANE" MARKINGS IN WHITE TO MATCH EXISTING.
- RE-STRIPES PARKING ISLAND AS SHOWN. ALL OTHER AREAS ARE EXISTING TO REMAIN.
- NOT USED.
- NOT USED.
- NEW PAINTED TUBULAR STEEL SHADE STRUCTURE. PROVIDE FABRIC MESH SHADE CANOPIES AS SHOWN.
- NEW 400 S.F. OUTDOOR SEATING AREA WITH DECORATIVE 42" HIGH PAINTED STEEL FENCE AND SELF-CLOSING GATES. 32 SEATS.
- NOT USED.
- NOT USED.
- NEW STUCCO FINISHED TAPERED DECORATIVE PARAPET. FURROUT EXISTING COLUMNS AS SHOWN. ALL COLORS TO MATCH EXISTING USED THROUGHOUT THE CENTER. PROVIDE EMPTY CONDUITS AND ACCESS PANELS FOR FUTURE TENANT SIGNAGE (UNDER SEPARATE PERMIT).
- REMOVE EXISTING PARKING LOT STRIPING AS SHOWN.
- EXISTING MOTORCYCLE PARKING SPACES, 4' x 8' WITH SIGNAGE.

**PARKING CALCULATIONS:**

PARKING CALCULATIONS BELOW ARE BASED ON THE PARKING REQUIREMENTS IN EFFECT AT THE TIME OF DEVELOPMENT. IDO REQUIREMENTS WOULD BE 4:1000 FOR RETAIL AND 8:1000 FOR RESTAURANT SPACE. THIS WOULD EQUATE TO 414 S.F. FOR 103,642 S.F. RETAIL AND 150.4 FOR 18,834 S.F. RESTAURANT FOR A TOTAL OF 565 LESS 10% PER 5-C(5)(a) = 509.

GROSS BUILDING AREA	122,476 S.F.
BUILDING 1 AREA	41,109 S.F.
BUILDING 2 AREA	9,980 S.F.
BUILDING 3 AREA	14,156 S.F.
BUILDING 4 AREA	3,588 S.F.
BUILDING 5 AREA	30,802 S.F.
BUILDING 6 AREA	11,980 S.F.
BUILDING 7 AREA	4,800 S.F.
BUILDING 8 AREA	6,061 S.F.

RESTAURANT SEATING:	14 INSIDE, 12 OUTSIDE (1,858 S.F.)
R1 WHISPERING BEAN	104 INSIDE, 32 OUTSIDE (3,588 S.F.)
R2 ICHIBAN	80 INSIDE (2,562 S.F.)
R3 ANATOLIA	80 INSIDE, 20 OUTSIDE (2,651 S.F.)
R4 THAI KITCHEN	100 INSIDE, 80 OUTSIDE (4,800 S.F.)
R5 IL VICINO	100 INSIDE (3,375 S.F.)
R6 FREDDY'S	622 SEATS (18,834 S.F.)
TOTAL	

RETAIL PARKING REQUIRED:	103,642 S.F. TOTAL RETAIL
	15,000 / 200 = 75
	45,000 / 250 = 180
	43,642 / 300 = 145
	RETAIL TOTAL = 400



RESTAURANT PARKING REQUIRED:	622 SEATS
	622 / 4 = 156

TOTAL PARKING REQUIRED:	556 LESS 10% FOR BUS ROUTE = 500
TOTAL PARKING PROVIDED:	517 TOTAL SPACES PROVIDED
	493 STANDARD SPACES
	24 ACCESSIBLE SPACES (6 VAN SPACES)
	8 MOTORCYCLE SPACES PROVIDED (7 REQUIRED 7:501-750)

**PROJECT INFORMATION:**

Site Address: 10701 CORRALES RD NW ALBUQUERQUE NM 87114  
 UPC: 10140662710584/102  
 Owner: REPOSADO LLC O LEE S BLAUGRUND  
 Owner Address: PO BOX 7817 ALBUQUERQUE NM 87194-7817  
 Legal Description: TRACT A-1-1-A REVISED SUMMARY PLAT THE BLACK RANCH (AKA-TR E SUMMARY PLAT OF SEVEN-BAR RANCH) CONT 11.5227 AC  
 Acres: 11.52  
 Zone Atlas Page: A-14  
 Tax Year: 2019  
 IDO Zone District: NR-C (Old SU-1 for C2 uses)  
 Case History: Project #1000857, AA-97-131, DRB-96-208, Z-96-14, Z-79-146

Existing construction: type III-B and III-B sprinklered  
 Existing Occupancies: A2, B, M  
 Existing Gross Building Area: 122,476 S.F. (No increase in area proposed)  
 Existing net lot area: 383,552 S.F.

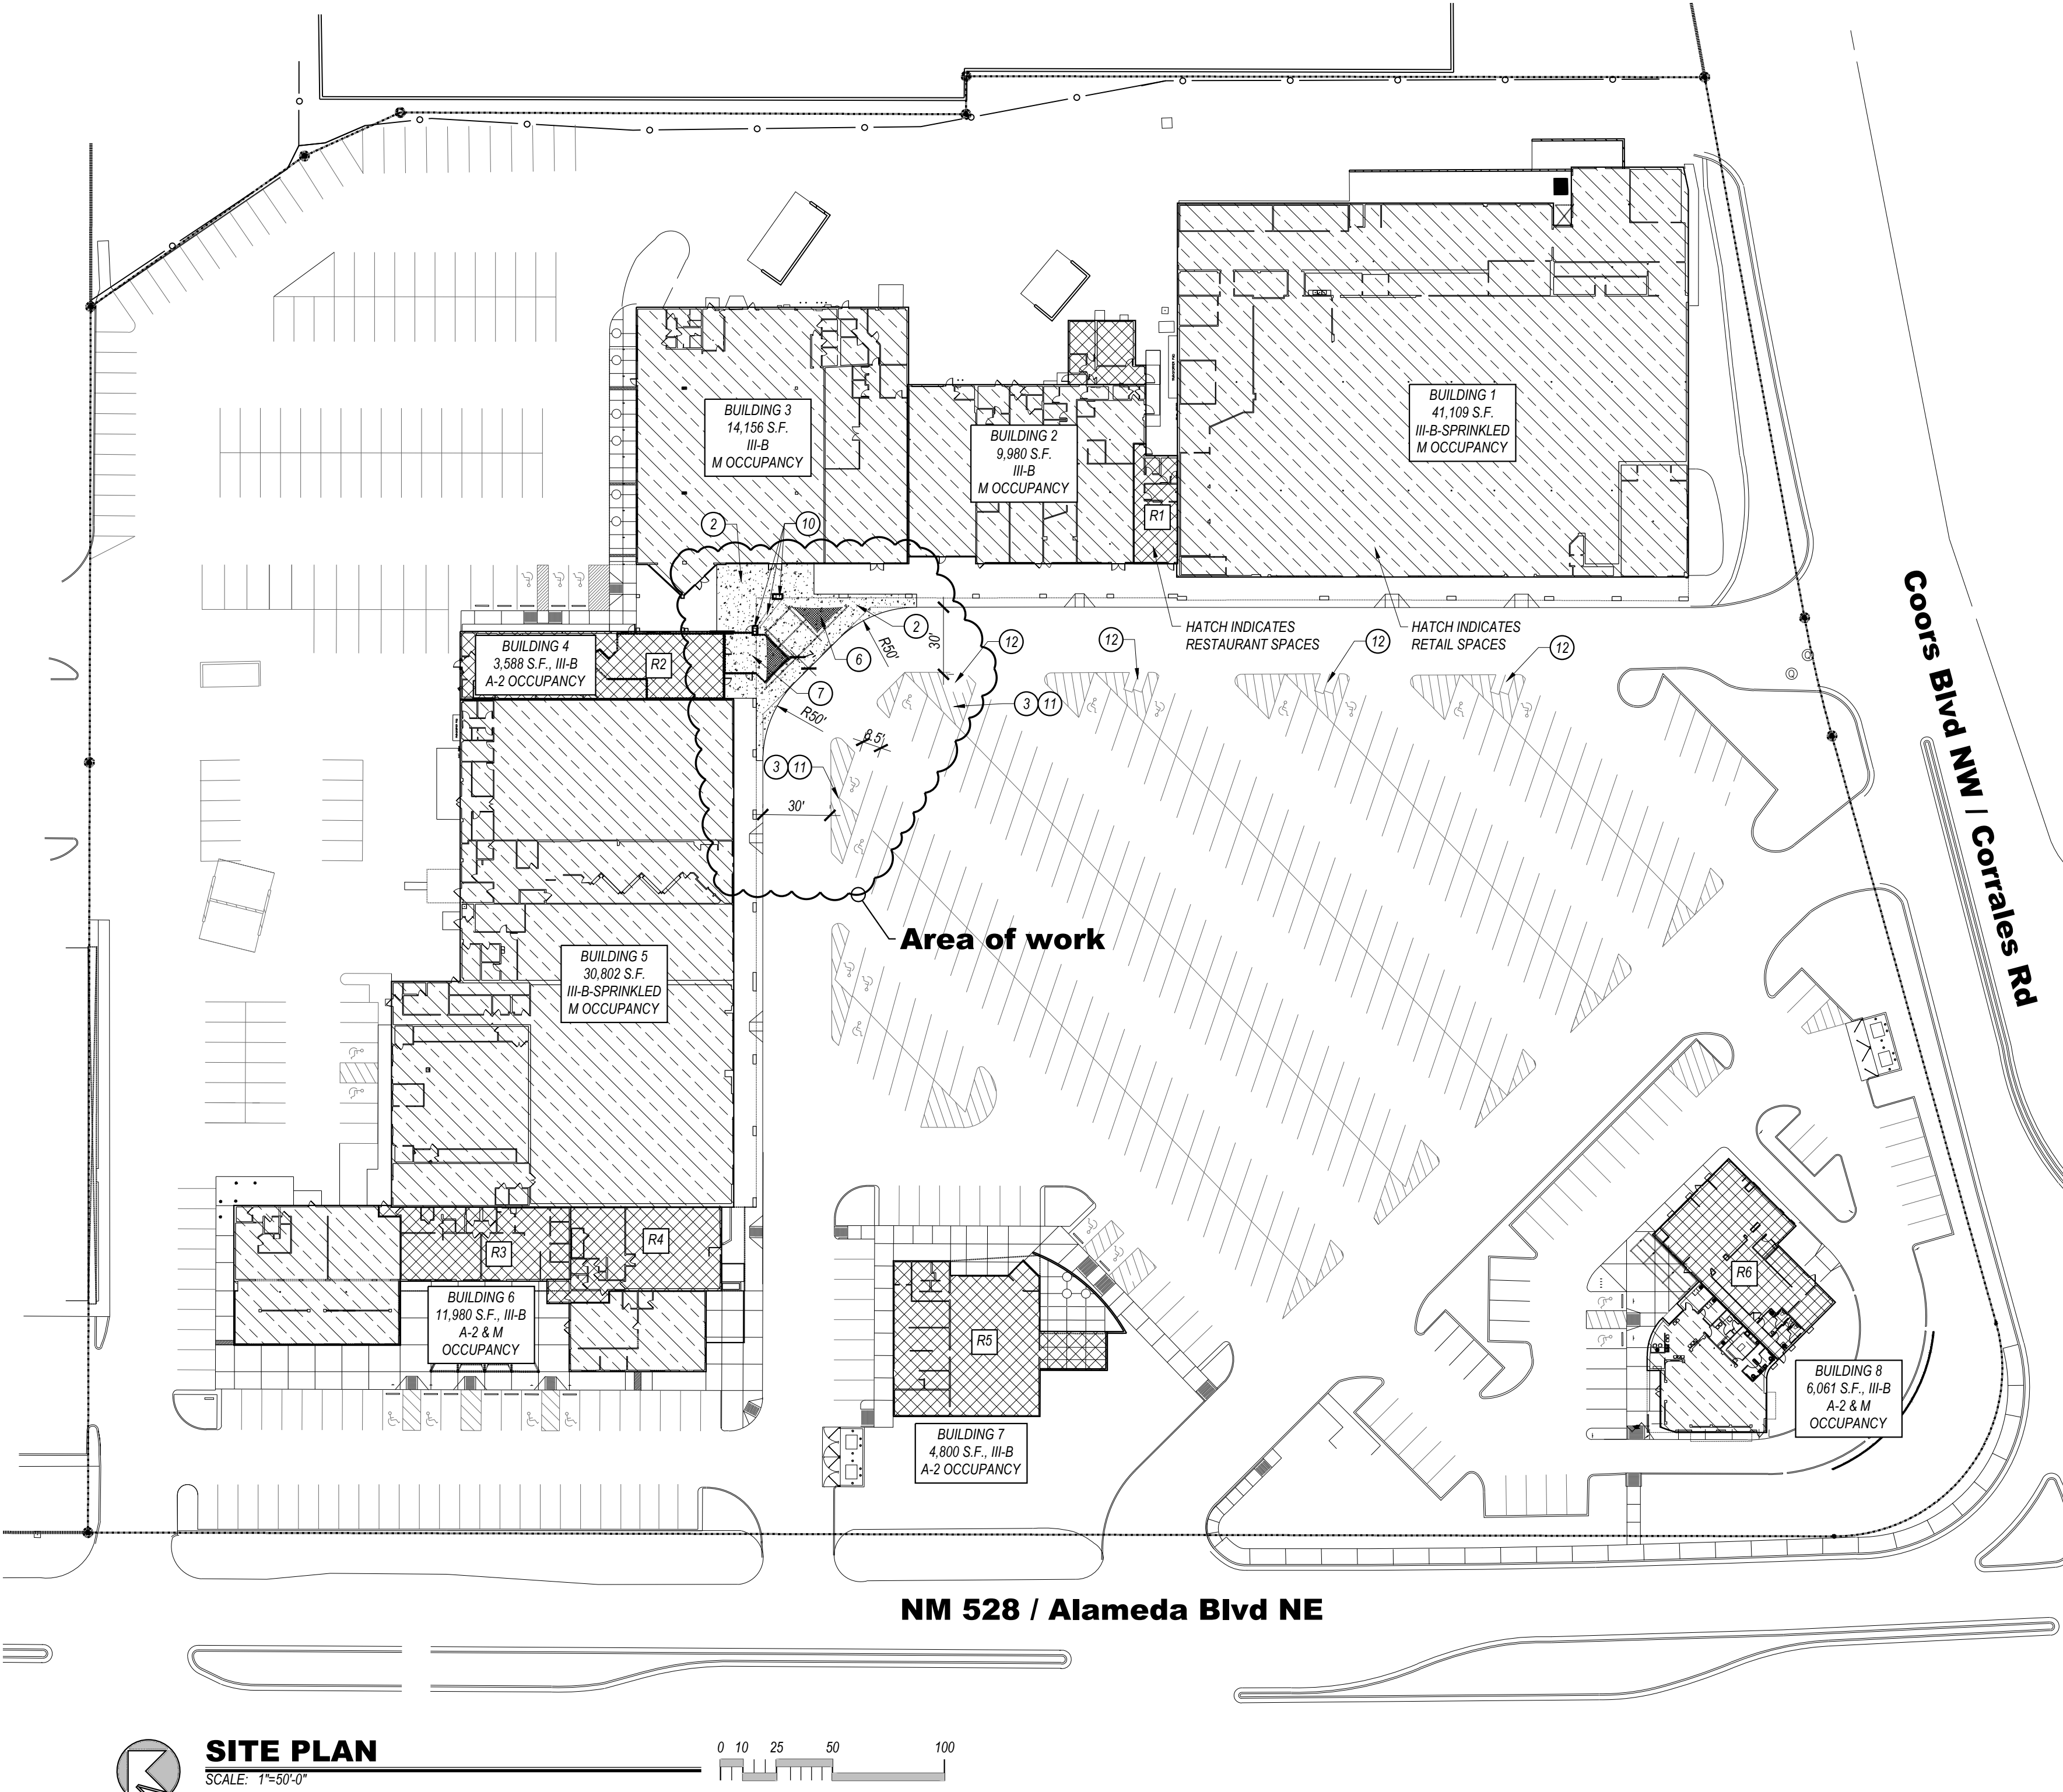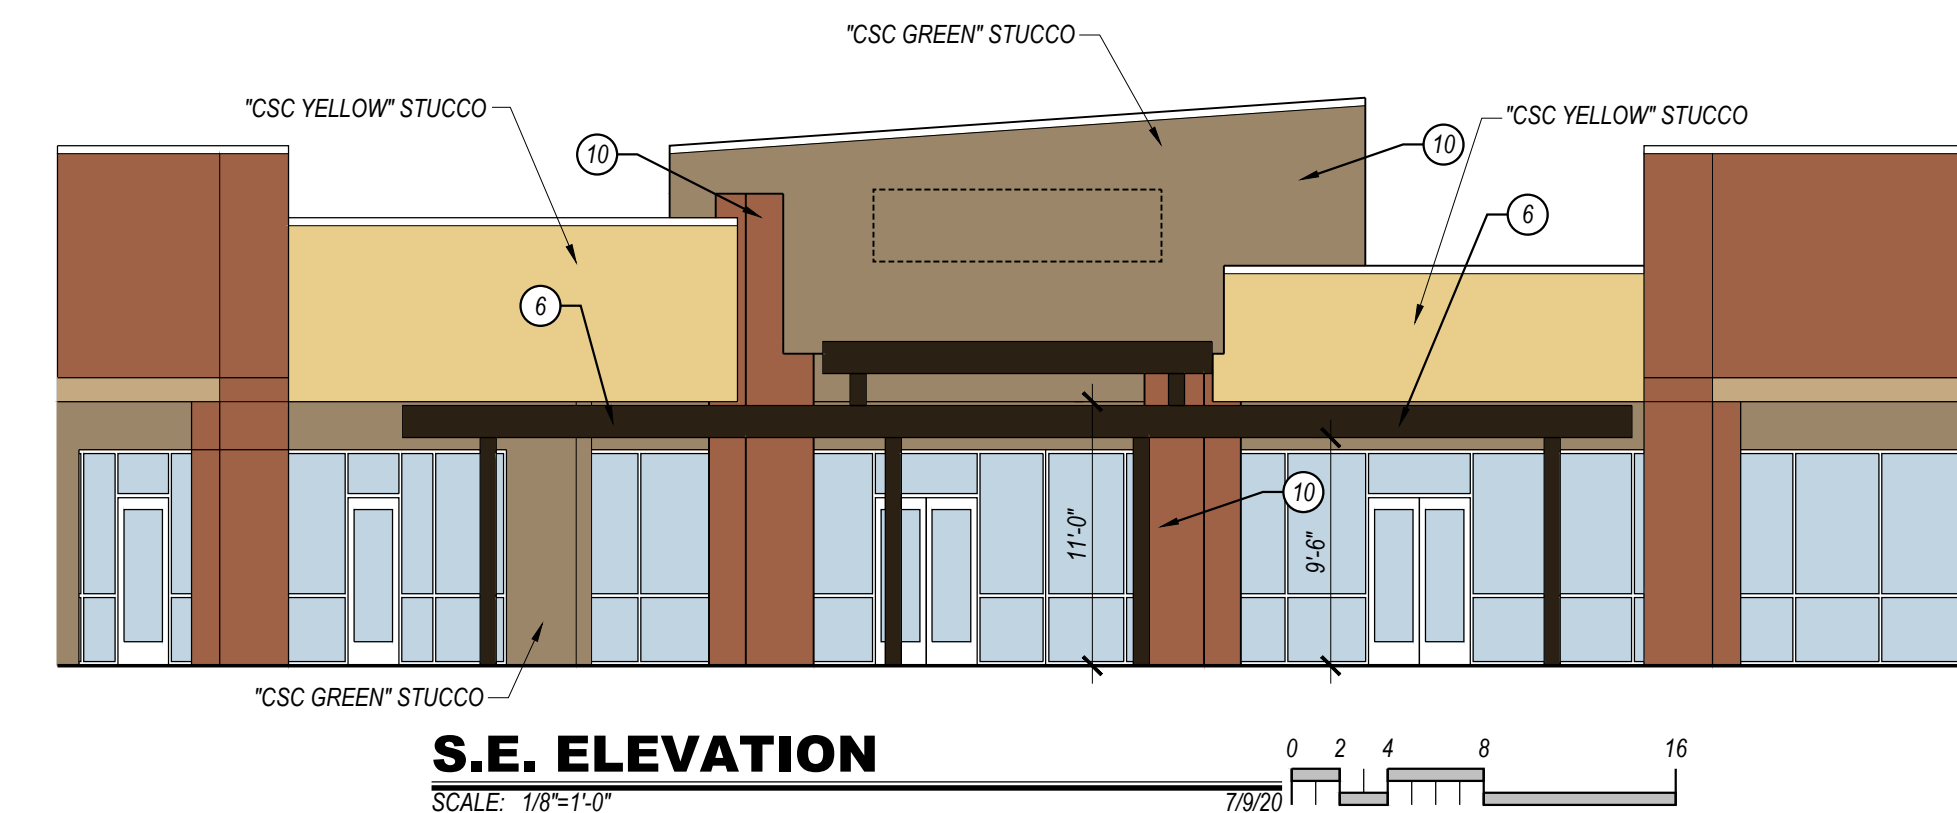

**ICHIBAN REMODEL**  
 10701 CORRALES ROAD NW, SUITE #18  
 ALBUQUERQUE, NM 87114

THIS DOCUMENT IS THE PROPERTY OF DESIGN 2 FUNCTION, LLC AND SHALL NOT BE USED OR COPIED WITHOUT EXPRESS WRITTEN CONSENT.  
 DUE TO VARIATIONS IN PRINTING AND COPYING TECHNIQUES, THERE MAY BE SLIGHT VARIATIONS IN THE SCALE OF THE DRAWINGS. ONLY PRINTED DIMENSIONS SHALL BE USED. CONTRACTOR TO VERIFY ALL LAYOUTS, DIMENSIONS AND OTHER RELATED INFORMATION PRIOR TO BIDDING OR CONSTRUCTION.  
 ERRORS MAY OCCUR IN THE TRANSMISSION OF ELECTRONIC FILES. DESIGN 2 FUNCTION, LLC IS NOT RESPONSIBLE FOR ANY CLAIMS, DAMAGES OR EXPENSES ARISING OUT OF THE UNAUTHORIZED USE OF THE INFORMATION CONTAINED IN ELECTRONIC FILES.

**DRAWING ISSUE DATES:**  
 11/4/20 Revised A.A.

**PROJECT MANAGER:**  
 NICK PIRKL

**DRAWN BY:**  
 NAP

**SHEET TITLE:**  
 Site Development Plan  
 Administrative  
 Amendment