

KEYED NOTES

1. ALL UTILITIES SHOWN ON THIS PLAN ARE BASED ON THE MOST RECENT RECORD DRAWINGS AND FIELD SURVEY DATA. THE CLIENT IS RESPONSIBLE FOR VERIFYING THE LOCATION AND DEPTH OF ALL UTILITIES PRIOR TO CONSTRUCTION. ANY UNDETECTED UTILITIES SHALL BE RELOCATED AT THE OWNER'S RISK AND EXPENSE.

2. THE PROPOSED CONSTRUCTION SHALL BE IN ACCORDANCE WITH THE CITY OF SAN ANTONIO ZONING ORDINANCE AND ALL APPLICABLE ORDINANCES. THE CITY ENGINEER'S REVIEW AND APPROVAL IS REQUIRED FOR ALL CONSTRUCTION ACTIVITIES.

3. THE PROPOSED CONSTRUCTION SHALL BE IN ACCORDANCE WITH THE CITY OF SAN ANTONIO'S DESIGN STANDARDS SPECIFICATIONS FOR STREETS AND SANITATION. THE CITY ENGINEER'S REVIEW AND APPROVAL IS REQUIRED FOR ALL CONSTRUCTION ACTIVITIES.

4. THE PROPOSED CONSTRUCTION SHALL BE IN ACCORDANCE WITH THE CITY OF SAN ANTONIO'S DESIGN STANDARDS SPECIFICATIONS FOR UTILITIES. THE CITY ENGINEER'S REVIEW AND APPROVAL IS REQUIRED FOR ALL CONSTRUCTION ACTIVITIES.

5. THE PROPOSED CONSTRUCTION SHALL BE IN ACCORDANCE WITH THE CITY OF SAN ANTONIO'S DESIGN STANDARDS SPECIFICATIONS FOR TRAFFIC CONTROL DEVICES. THE CITY ENGINEER'S REVIEW AND APPROVAL IS REQUIRED FOR ALL CONSTRUCTION ACTIVITIES.

GENERAL NOTES

A. ALL UTILITIES SHOWN ON THIS PLAN ARE BASED ON THE MOST RECENT RECORD DRAWINGS AND FIELD SURVEY DATA. THE CLIENT IS RESPONSIBLE FOR VERIFYING THE LOCATION AND DEPTH OF ALL UTILITIES PRIOR TO CONSTRUCTION. ANY UNDETECTED UTILITIES SHALL BE RELOCATED AT THE OWNER'S RISK AND EXPENSE.

B. THE PROPOSED CONSTRUCTION SHALL BE IN ACCORDANCE WITH THE CITY OF SAN ANTONIO ZONING ORDINANCE AND ALL APPLICABLE ORDINANCES. THE CITY ENGINEER'S REVIEW AND APPROVAL IS REQUIRED FOR ALL CONSTRUCTION ACTIVITIES.

C. THE PROPOSED CONSTRUCTION SHALL BE IN ACCORDANCE WITH THE CITY OF SAN ANTONIO'S DESIGN STANDARDS SPECIFICATIONS FOR STREETS AND SANITATION. THE CITY ENGINEER'S REVIEW AND APPROVAL IS REQUIRED FOR ALL CONSTRUCTION ACTIVITIES.

D. THE PROPOSED CONSTRUCTION SHALL BE IN ACCORDANCE WITH THE CITY OF SAN ANTONIO'S DESIGN STANDARDS SPECIFICATIONS FOR UTILITIES. THE CITY ENGINEER'S REVIEW AND APPROVAL IS REQUIRED FOR ALL CONSTRUCTION ACTIVITIES.

E. THE PROPOSED CONSTRUCTION SHALL BE IN ACCORDANCE WITH THE CITY OF SAN ANTONIO'S DESIGN STANDARDS SPECIFICATIONS FOR TRAFFIC CONTROL DEVICES. THE CITY ENGINEER'S REVIEW AND APPROVAL IS REQUIRED FOR ALL CONSTRUCTION ACTIVITIES.

SOUTH PARKING LOT COUNT




TOTAL NUMBER OF CONTRACT PARKING SPACES: 9 (AS A PORTION OF TOTAL SOUTH LOT)

FURNISHING TABLE

ASPHALT DRIVE	1.11
CONCRETE DRIVE	1.11
ASPHALT SIDEWALK	1.11
CONCRETE SIDEWALK	1.11
ASPHALT DRIVE	1.11
CONCRETE DRIVE	1.11
ASPHALT SIDEWALK	1.11
CONCRETE SIDEWALK	1.11
ASPHALT DRIVE	1.11
CONCRETE DRIVE	1.11
ASPHALT SIDEWALK	1.11
CONCRETE SIDEWALK	1.11

Project	SAH HEALTHCARE GROUP INC
Sheet Title	WORLD HEADQUARTERS BUILDING AND PARKING LOT CONSTRUCTION AND FINISHES
Sheet No.	DRB-2
Scale	AS SHOWN

Sheet
DRB-2
2 of 8

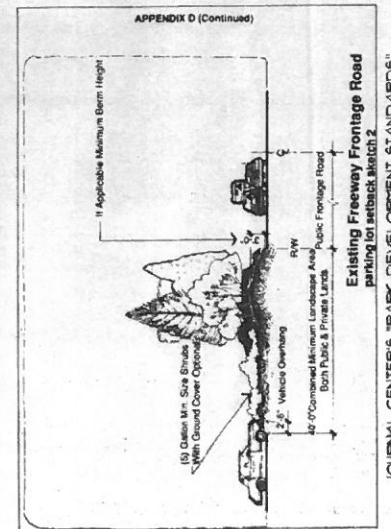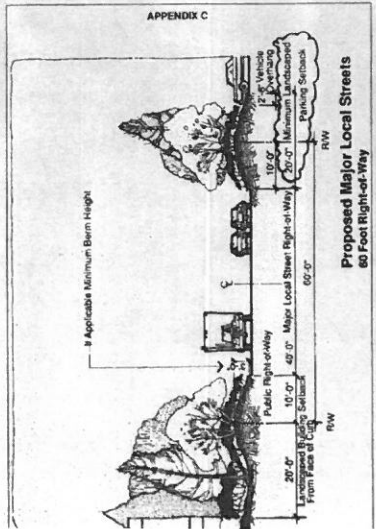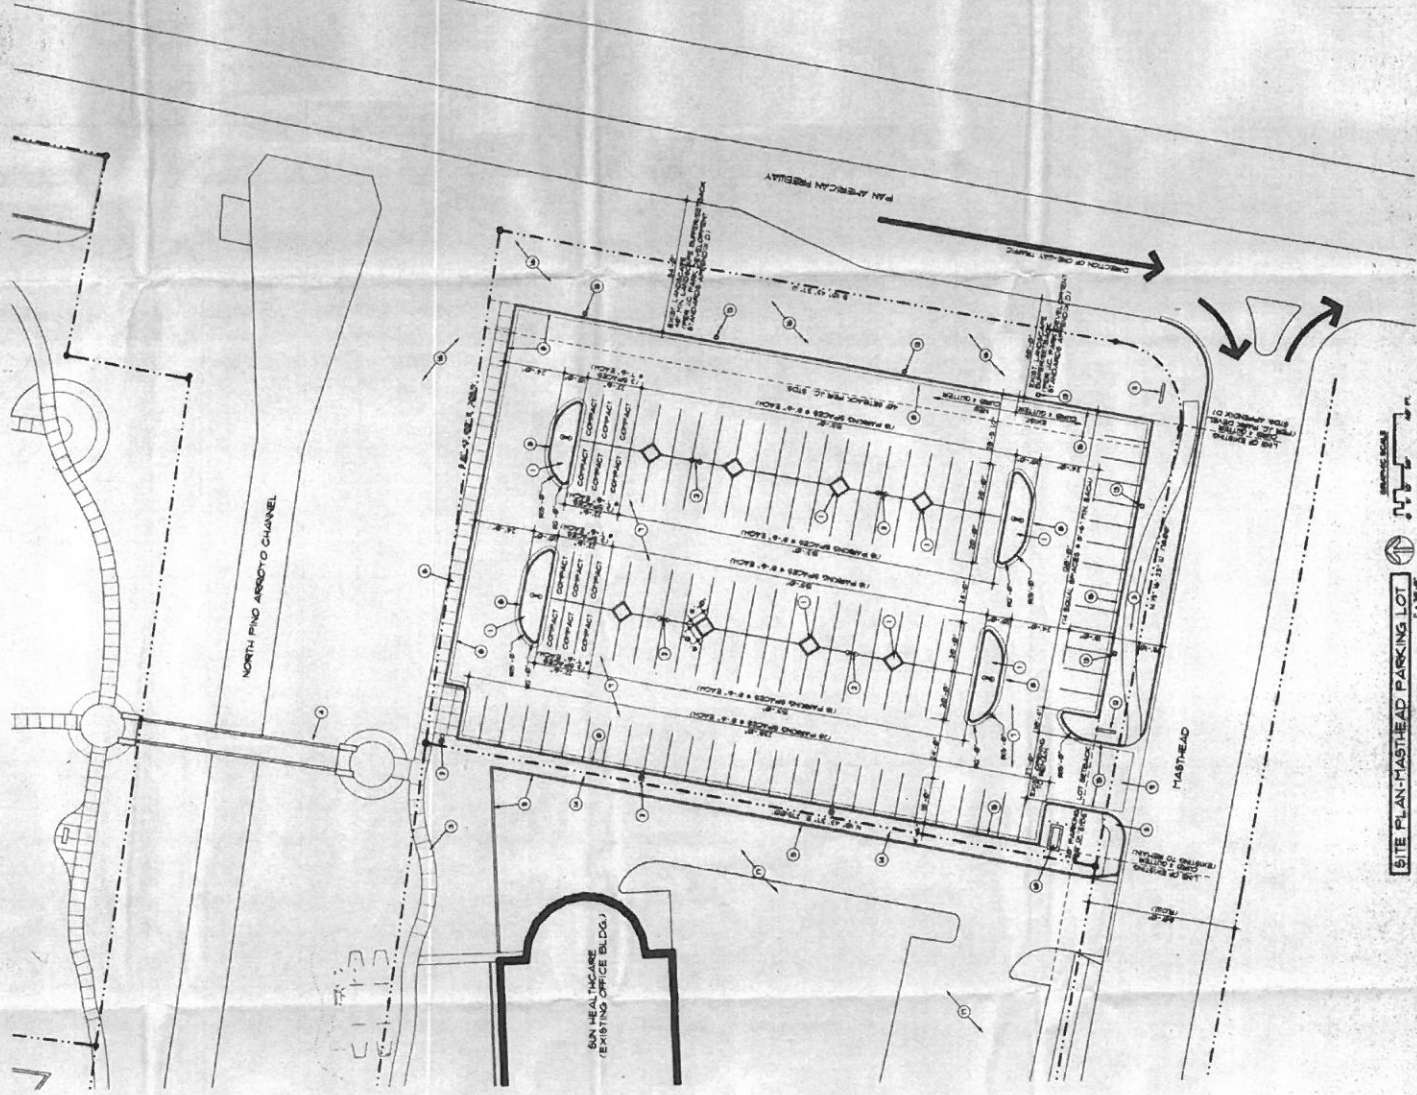


KEYED NOTES
 1. EXISTING BUILDING FOOTPRINTS
 2. EXISTING DRIVEWAYS
 3. EXISTING SIDEWALKS
 4. EXISTING UTILITIES
 5. EXISTING LANDSCAPE
 6. EXISTING DRIVEWAYS

INDEX OF DRAWINGS
 1. OVERALL SITE PLAN
 2. SANITARY PLAN
 3. ELECTRICAL PLAN
 4. MECHANICAL PLAN
 5. PLUMBING PLAN
 6. CIVIL PLAN
 7. LANDSCAPE ARCHITECTURE
 8. SIGNAGE
 9. EXISTING UTILITIES
 10. EXISTING DRIVEWAYS
 11. EXISTING SIDEWALKS
 12. EXISTING LANDSCAPE
 13. EXISTING DRIVEWAYS



VICINITY MAP

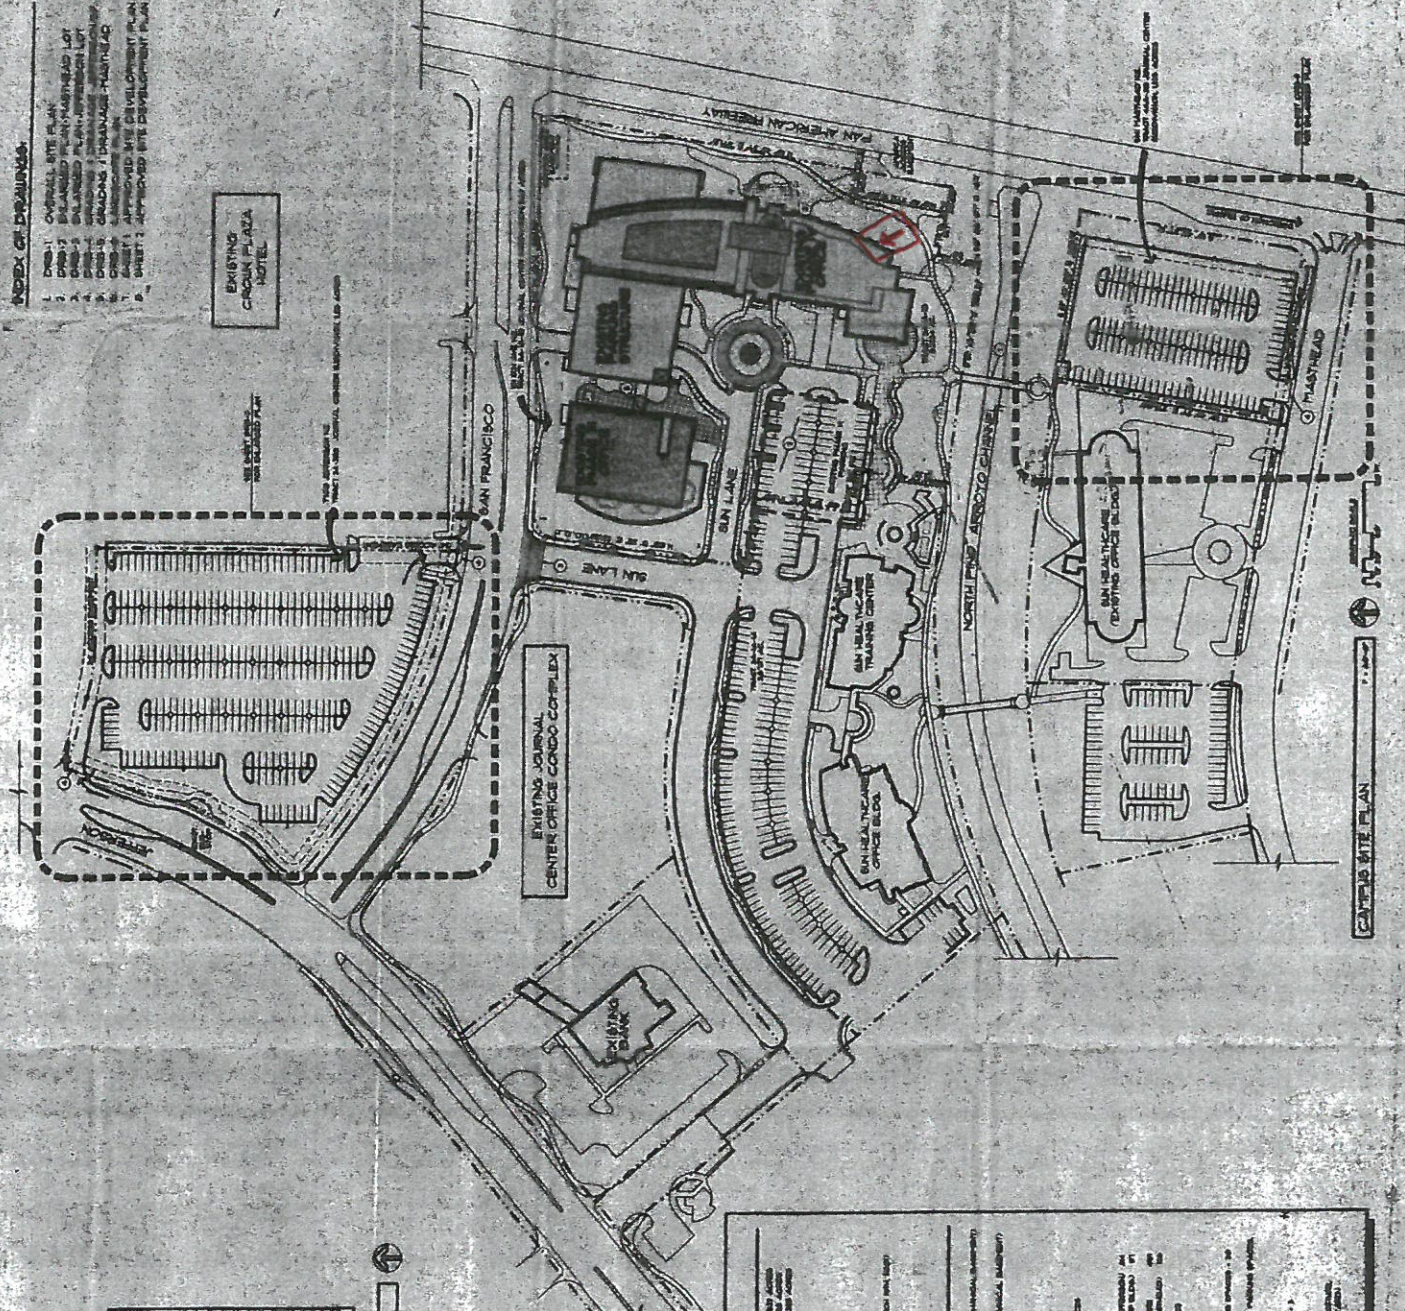

EXISTING CASINO PLAZA HOTEL

EXISTING JOURNAL CENTER OFFICE COMPLEX

DEVELOPER DATA
 NAME: [Redacted]
 ADDRESS: [Redacted]
 CITY: [Redacted]
 STATE: [Redacted]
 ZIP: [Redacted]

PROJECT DESCRIPTION
 PROJECT: [Redacted]
 LOCATION: [Redacted]
 TYPE: [Redacted]

GENERAL NOTES
 1. ALL CONSTRUCTION SHALL BE IN ACCORDANCE WITH THE LATEST EDITIONS OF THE CALIFORNIA BUILDING CODE AND ALL APPLICABLE ORDINANCES.
 2. THE CONTRACTOR SHALL BE RESPONSIBLE FOR OBTAINING ALL NECESSARY PERMITS AND APPROVALS FROM THE APPROPRIATE AGENCIES.
 3. THE CONTRACTOR SHALL MAINTAIN ACCESS TO ALL ADJACENT PROPERTIES AT ALL TIMES.
 4. THE CONTRACTOR SHALL PROTECT ALL EXISTING UTILITIES AND STRUCTURES.
 5. THE CONTRACTOR SHALL MAINTAIN ALL EXISTING LANDSCAPE AND PLANTING.

THIS MAP REFLECTS THE (1) SPACE WE PROPOSE TO ADD (2) WALL SIGN. THE PROPOSED SPACE IS MARKED BY [Red Arrow]

FOR SALES - \$150
 DIB (REVISED) #99-389
 [Redacted]
 [Redacted]
 [Redacted]

FABRIC DARD TABLES

1100	1101	1102	1103	1104	1105	1106	1107	1108	1109	1110
1111	1112	1113	1114	1115	1116	1117	1118	1119	1120	1121

PROJECT: [Redacted]
 SHEET: [Redacted]
 DATE: [Redacted]

Sheet
 DRB-1
 1 of 6

GENERAL NOTES
 1. ALL DIMENSIONS ARE TO FACE UNLESS NOTED OTHERWISE.
 2. ALL DIMENSIONS ARE TO FACE UNLESS NOTED OTHERWISE.
 3. ALL DIMENSIONS ARE TO FACE UNLESS NOTED OTHERWISE.




KEYED NOTES
 1. ALL DIMENSIONS ARE TO FACE UNLESS NOTED OTHERWISE.
 2. ALL DIMENSIONS ARE TO FACE UNLESS NOTED OTHERWISE.
 3. ALL DIMENSIONS ARE TO FACE UNLESS NOTED OTHERWISE.

JEFFERSON PARKING LOT COUNT:
 1. ALL DIMENSIONS ARE TO FACE UNLESS NOTED OTHERWISE.
 2. ALL DIMENSIONS ARE TO FACE UNLESS NOTED OTHERWISE.
 3. ALL DIMENSIONS ARE TO FACE UNLESS NOTED OTHERWISE.

ADMINISTRATIVE AMENDMENT
 No. 1000381
 B-172

1000381

Goodman Realty Group
 Sun Parking Addition
 101 Sun Ave.
 Albuquerque, NM

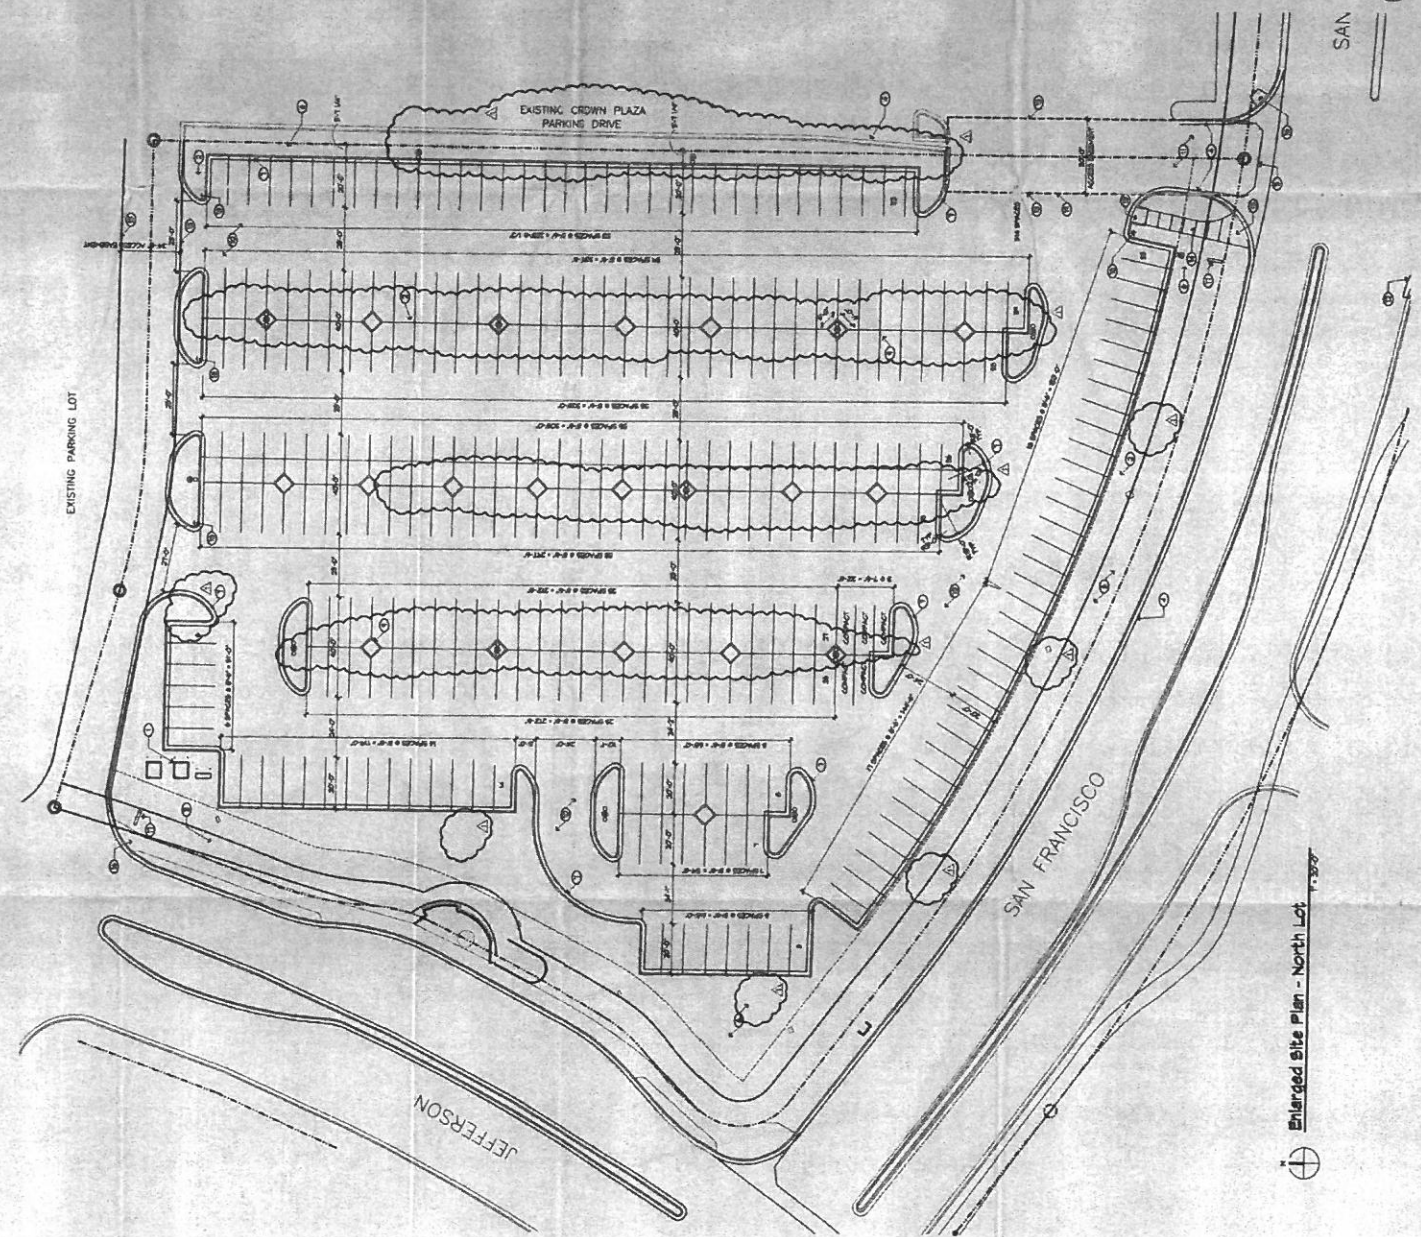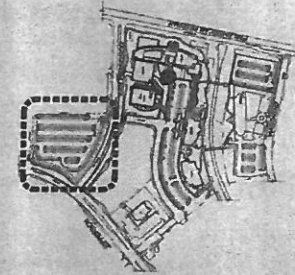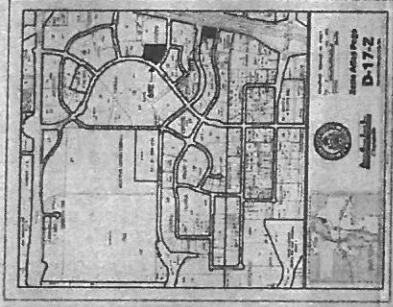

Enlarged Site Plan - North Lot

K&J Plan

1000381

DATE: 11/11/11
 DRAWN BY: [Signature]
 CHECKED BY: [Signature]

Dakkor Porch Sabatini
 1011 1st Street NE
 Albuquerque, NM 87106
 TEL: 505.243.1111
 FAX: 505.243.1111
 WWW.DAKKORPORCHSABATINI.COM



