




#### **DEVELOPMENT REVIEW APPLICATION**

Effective 4/17/19

Please check the appropriate box and refer to supplemental forms for submittal requirements. All fees must be paid at the time of application.								
Administrative Decisions	De	ecisions	Requiring a Pu	blic Meeting or Hearing	Policy	Policy Decisions		
☐ Archaeological Certificate (Form P3)		☐ Site Plan – EPC including any Variances – EPC (Form P1)				option or Amendment of r Facility Plan <i>(Form Z)</i>	Comprehensive	
☐ Historic Certificate of Appropriateness – M (Form L)	inor	☐ Master Development Plan (Form P1)				☐ Adoption or Amendment of Historic Designation (Form L)		
☐ Alternative Signage Plan (Form P3)		Historic (	Certificate of Ap	oropriateness – Major	□ Am	☐ Amendment of IDO Text (Form Z)		
Minor Amendment to Site Plan (Form P3)		Demolition	on Outside of H	PO (Form L)	□ Anr	☐ Annexation of Land (Form Z)		
☐ WTF Approval (Form W1)		Historic I	Design Standard	ls and Guidelines (Form L)	□ Am	☐ Amendment to Zoning Map – EPC (Form Z)		
		☐ Wireless Telecommunications Facility Waiver (Form W2)			□ Am	☐ Amendment to Zoning Map – Council (Form Z)		
					Appea	Appeals		
						□ Decision by EPC, LC, ZHE, or City Staff (Form		
					A)	•		
APPLICATION INFORMATION					-			
Applicant: Lucas Rogers - SDB Co	ntractir	ng Serv	/ices		Ph	one: 480-967-581	0	
Address: 1001 S. Edward Drive					En	nail: Lucas.Roger	s@sdb.com	
City: Tempe				State: AZ	Zip	o: 85281		
Professional/Agent (if any): Warren Callahan - SSOE Group					Ph	one: 205-397-232	28	
Address: 2204 Lakeshore Drive, Suite 110					nail: wcallahan@:	ssoe.com		
City: Homewood				State: AL	Zip	Zip: 35209		
Proprietary Interest in Site: Rehabilitation Hospital				List all owners: Encom	npass Health			
BRIEF DESCRIPTION OF REQUEST								
Site plan revisions for final appr	oval of	revise	d landscapi	ng.				
SITE INFORMATION (Accuracy of the exist	ting lega	descrip	tion is crucial!	Attach a separate sheet if	necessa	ary.)		
Lot or Tract No.: TR 4A & 4B1				Block:	Unit: 5			
Subdivision/Addition: Interstate Indl 04	1-a Un	05		MRGCD Map No.: 28 UPC Code:10-170-63356021		35602140320		
Zone Atlas Page(s): D-17-Z		Existing	Zoning: MX	1 1,571 (110 0)				
# of Existing Lots: 2		# of Pro	posed Lots:	N/A (No Change)	То	tal Area of Site (acres):	6.6578	
LOCATION OF PROPERTY BY STREETS								
Site Address/Street: 7000 Jefferson N	E	Between	n: Ellison S	t. NE	and: Osuna Rd. NE			
CASE HISTORY (List any current or prior p	oroject a	nd case r	number(s) that	may be relevant to your re	equest.)			
Building Permit # BP-2019-36690	0							
Signature: Warren Callahan				Da	Date: 07/28/2020			
Printed Name: Warren Callahan □ Applicant or 🌣 Agent								
FOR OFFICIAL USE ONLY								
Case Numbers	Action		Fees	Case Numbers		Action	Fees	
					•			
Meeting/Hearing Date:					Fe	Fee Total:		
Staff Signature: Date:					Project #			

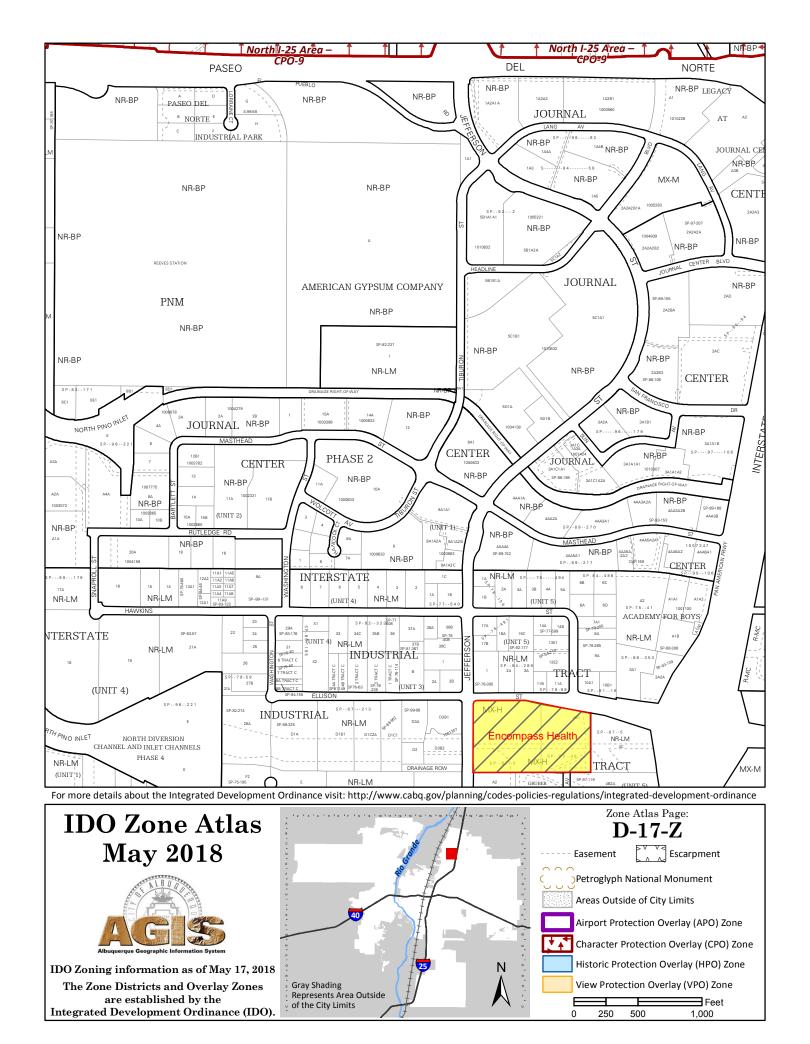



June 10, 2020

City of Albuquerque Planning Department C/O Maggie Gould or Jay Rodenback 600 2<sup>nd</sup> Street NW, Ground Floor Albuquerque, NM 87102

RE: LETTER OF AUTHORIZATION / DESIGNATED AGENT

ENCOMPASS HEALTH REHABILITATION HOSPITAL OF ALBUQUERQUE 7000 Jefferson NE Albuquerque, NM 87109 SSOE Group Project # 019-00712-00

To whom it may concern:

Our facility, listed above, has been constructing an ADA upgrade project. The project included minor renovations to make ADA corrections to the existing patient room toilets and several public toilets throughout the facility as well as site improvements to the existing ADA parking and new landscaping.

Our designated agent / architectural firm for the project is SSOE Group in Birmingham, AL. They are authorized to submit any required information to the various agencies / departments as needed on our behalf. If you have any questions please contact Warren Callahan with SSOE Group at 205-323-2373.

Thank you,

Rachelle Spencer, CEO

Rachelle E. Spencer

Encompass Health Rehabilitation Hospital of Albuquerque

**SSOE Group**2204 Lakeshore Drive
Ste. 110
Birmingham, AL 35209
205.323.2373 T
205.802.9301 F

www.ssoe.com

July 28, 2020

City of Albuquerque Planning Department C/O Annette V. Ortiz – Planning Assistant II 600 2<sup>nd</sup> Street NW Ground Floor Albuquerque, NM 87102

RE: JUSTIFICATION LETTER FOR ADMINISTRATIVE AMENDMENT
ORIGINAL PERMIT # BP-2019-36690

ENCOMPASS HEALTH REHABILITATION HOSPITAL OF ALBUQUERQUE 7000 Jefferson NE Albuquerque, NM

**SSOE Group Project # 019-00712-00** 

To whom it may concern:

The facility, listed above, has been undergoing an ADA upgrade project. The project included minor renovations to make ADA corrections to the existing patient room toilets and several public toilets throughout the facility as well as site improvements to the existing ADA parking and new landscaping. Items discovered during construction of the exterior caused the landscaping to require revisions in order to meet the current City of Albuquerque requirements. The new revised landscape plan were submitted separately for review and approval. We would like to amend the original drawings to include the new landscaping plan. Our understanding is that this is required to get our final approval and sign offs for the project.


We are the designated architectural firm for the project and have been working with SDB Contracting Services. They are also authorized to submit any required additional information to the various agencies / departments as needed on the clients' behalf. If you have any questions please contact me at 205-323-2373 or call my cell at 205-369-2208.

Thank you,

Warren Callahan

Warren Callahan, RAS

SSOE Group

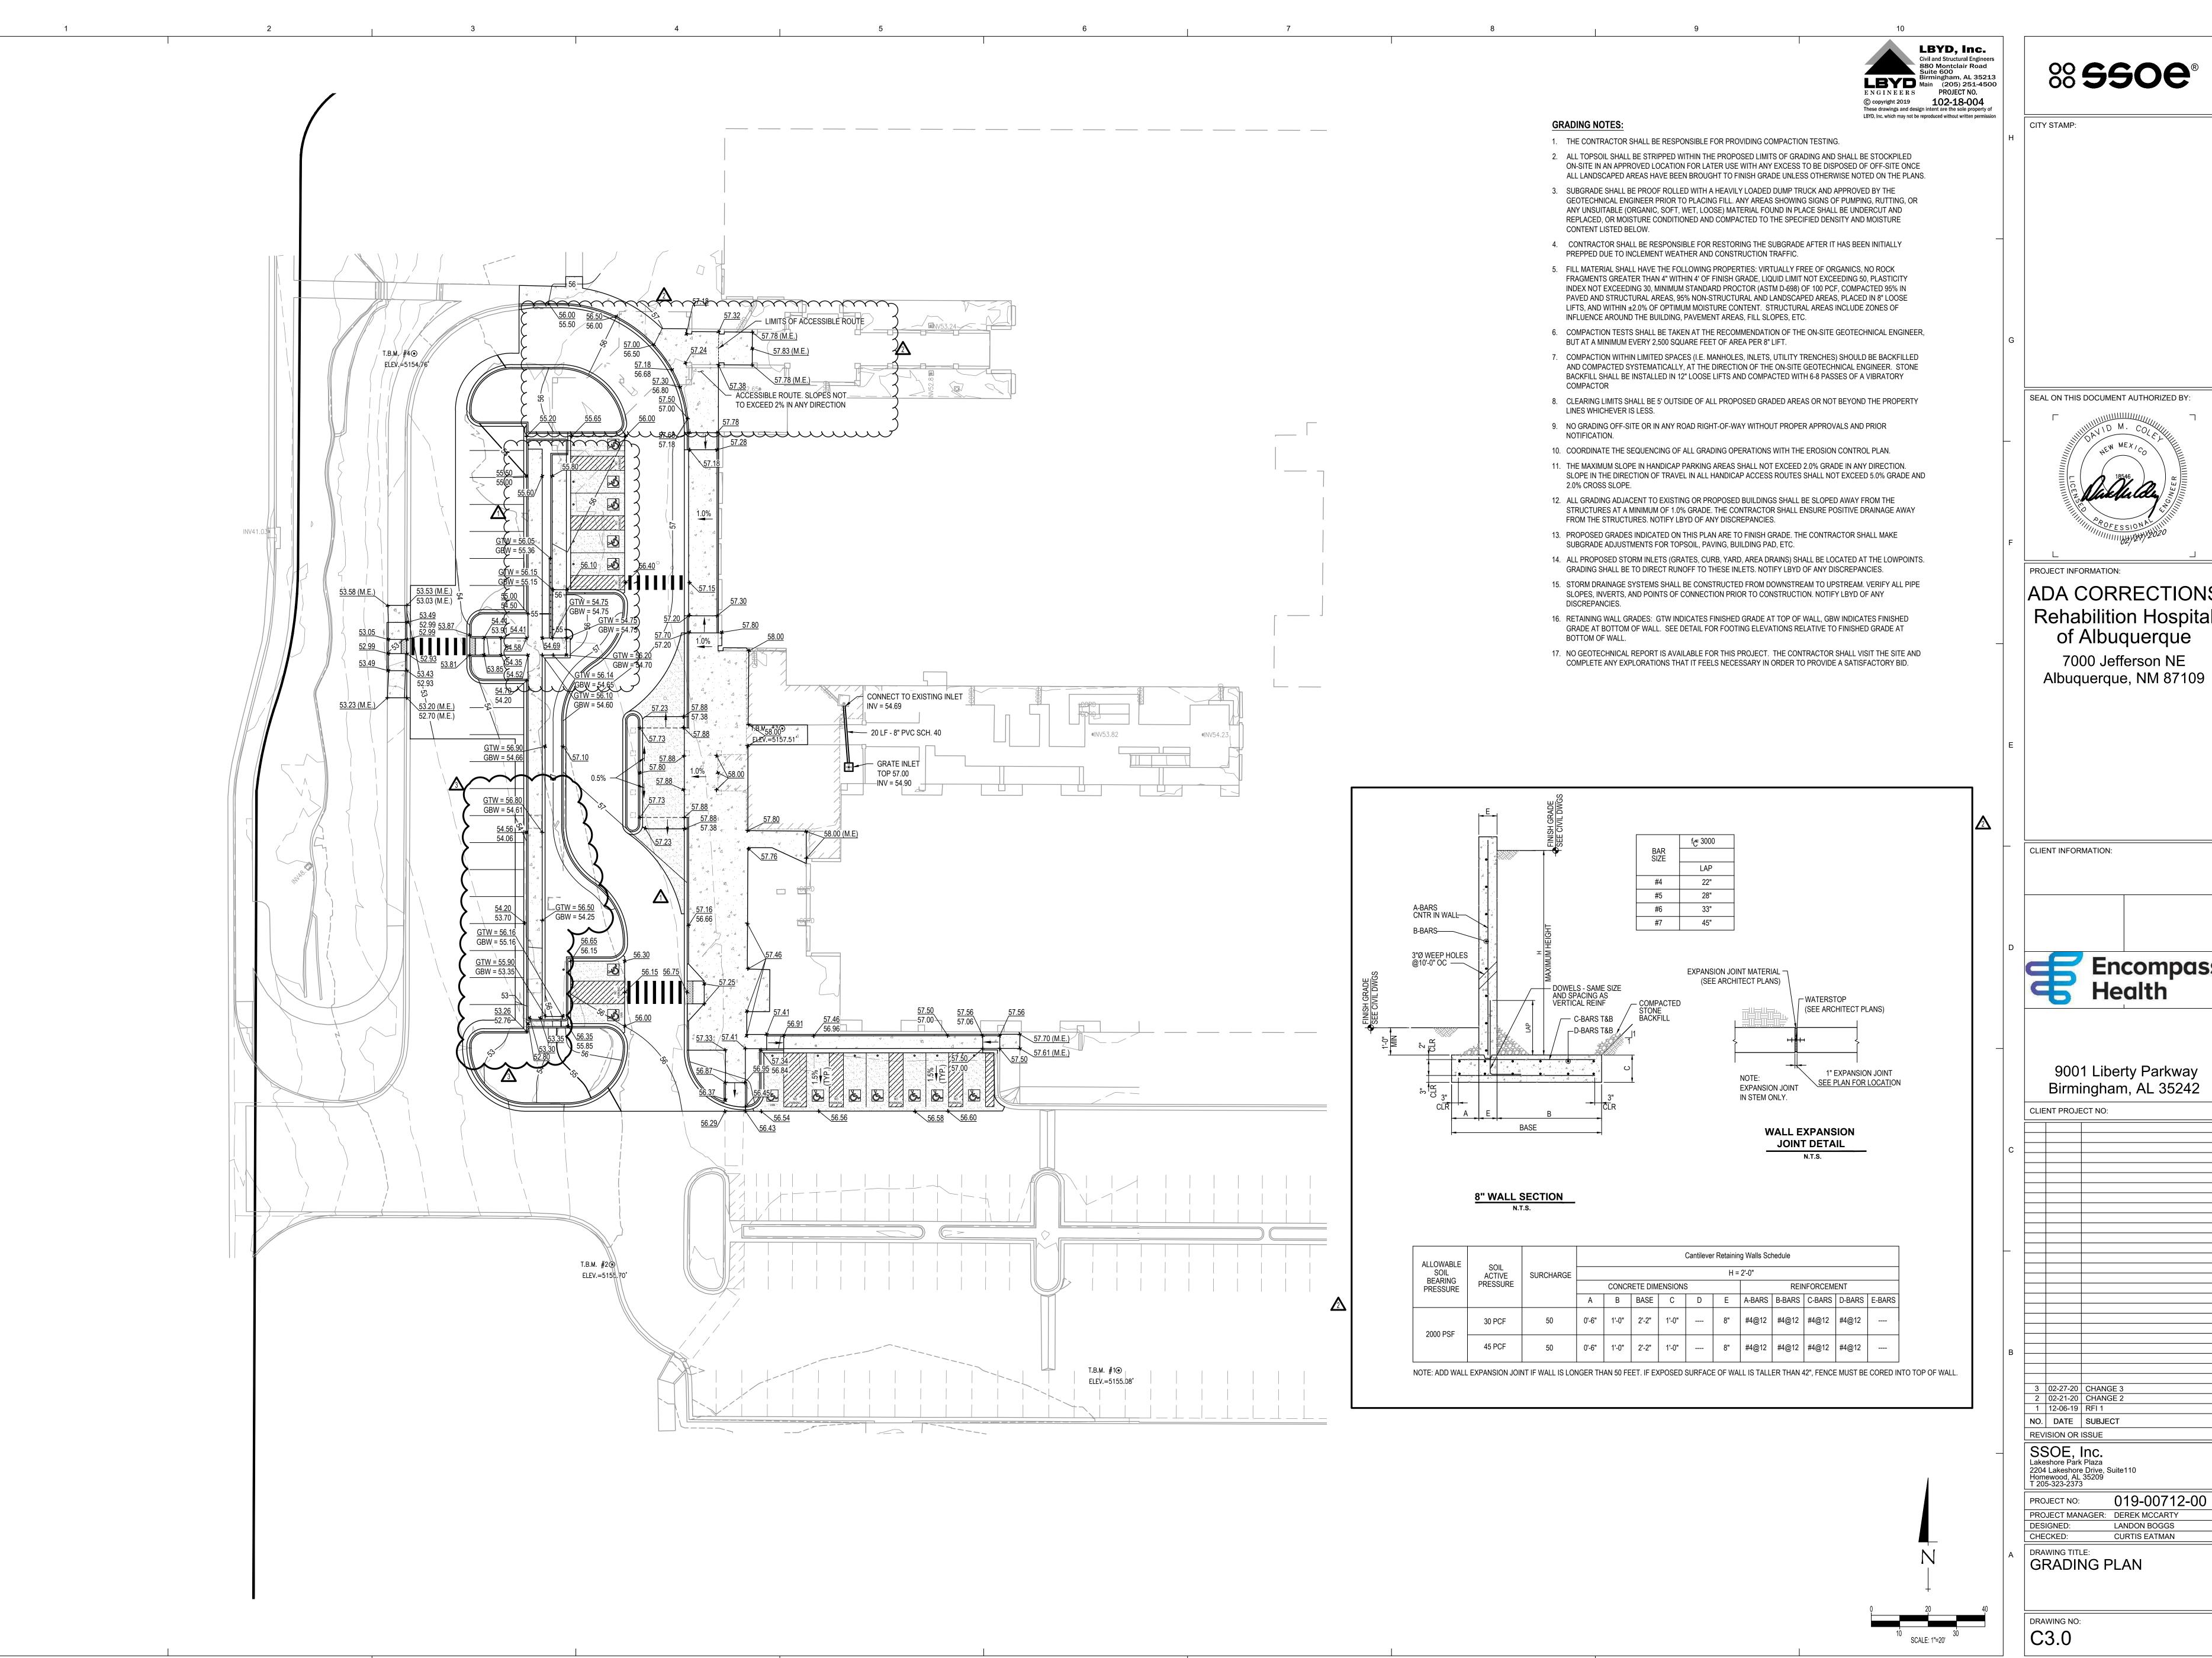



# ADA CORRECTIONS Rehabilition Hospital of Albuquerque


7000 Jefferson NE Albuquerque, NM 87109




9001 Liberty Parkway

		CHANGE 3	
2		CHANGE 2	
1	12-06-19		
NO.	DATE	SUBJECT	
REVISION OR ISSUE			
SSOE, Inc.			

CURTIS EATMAN

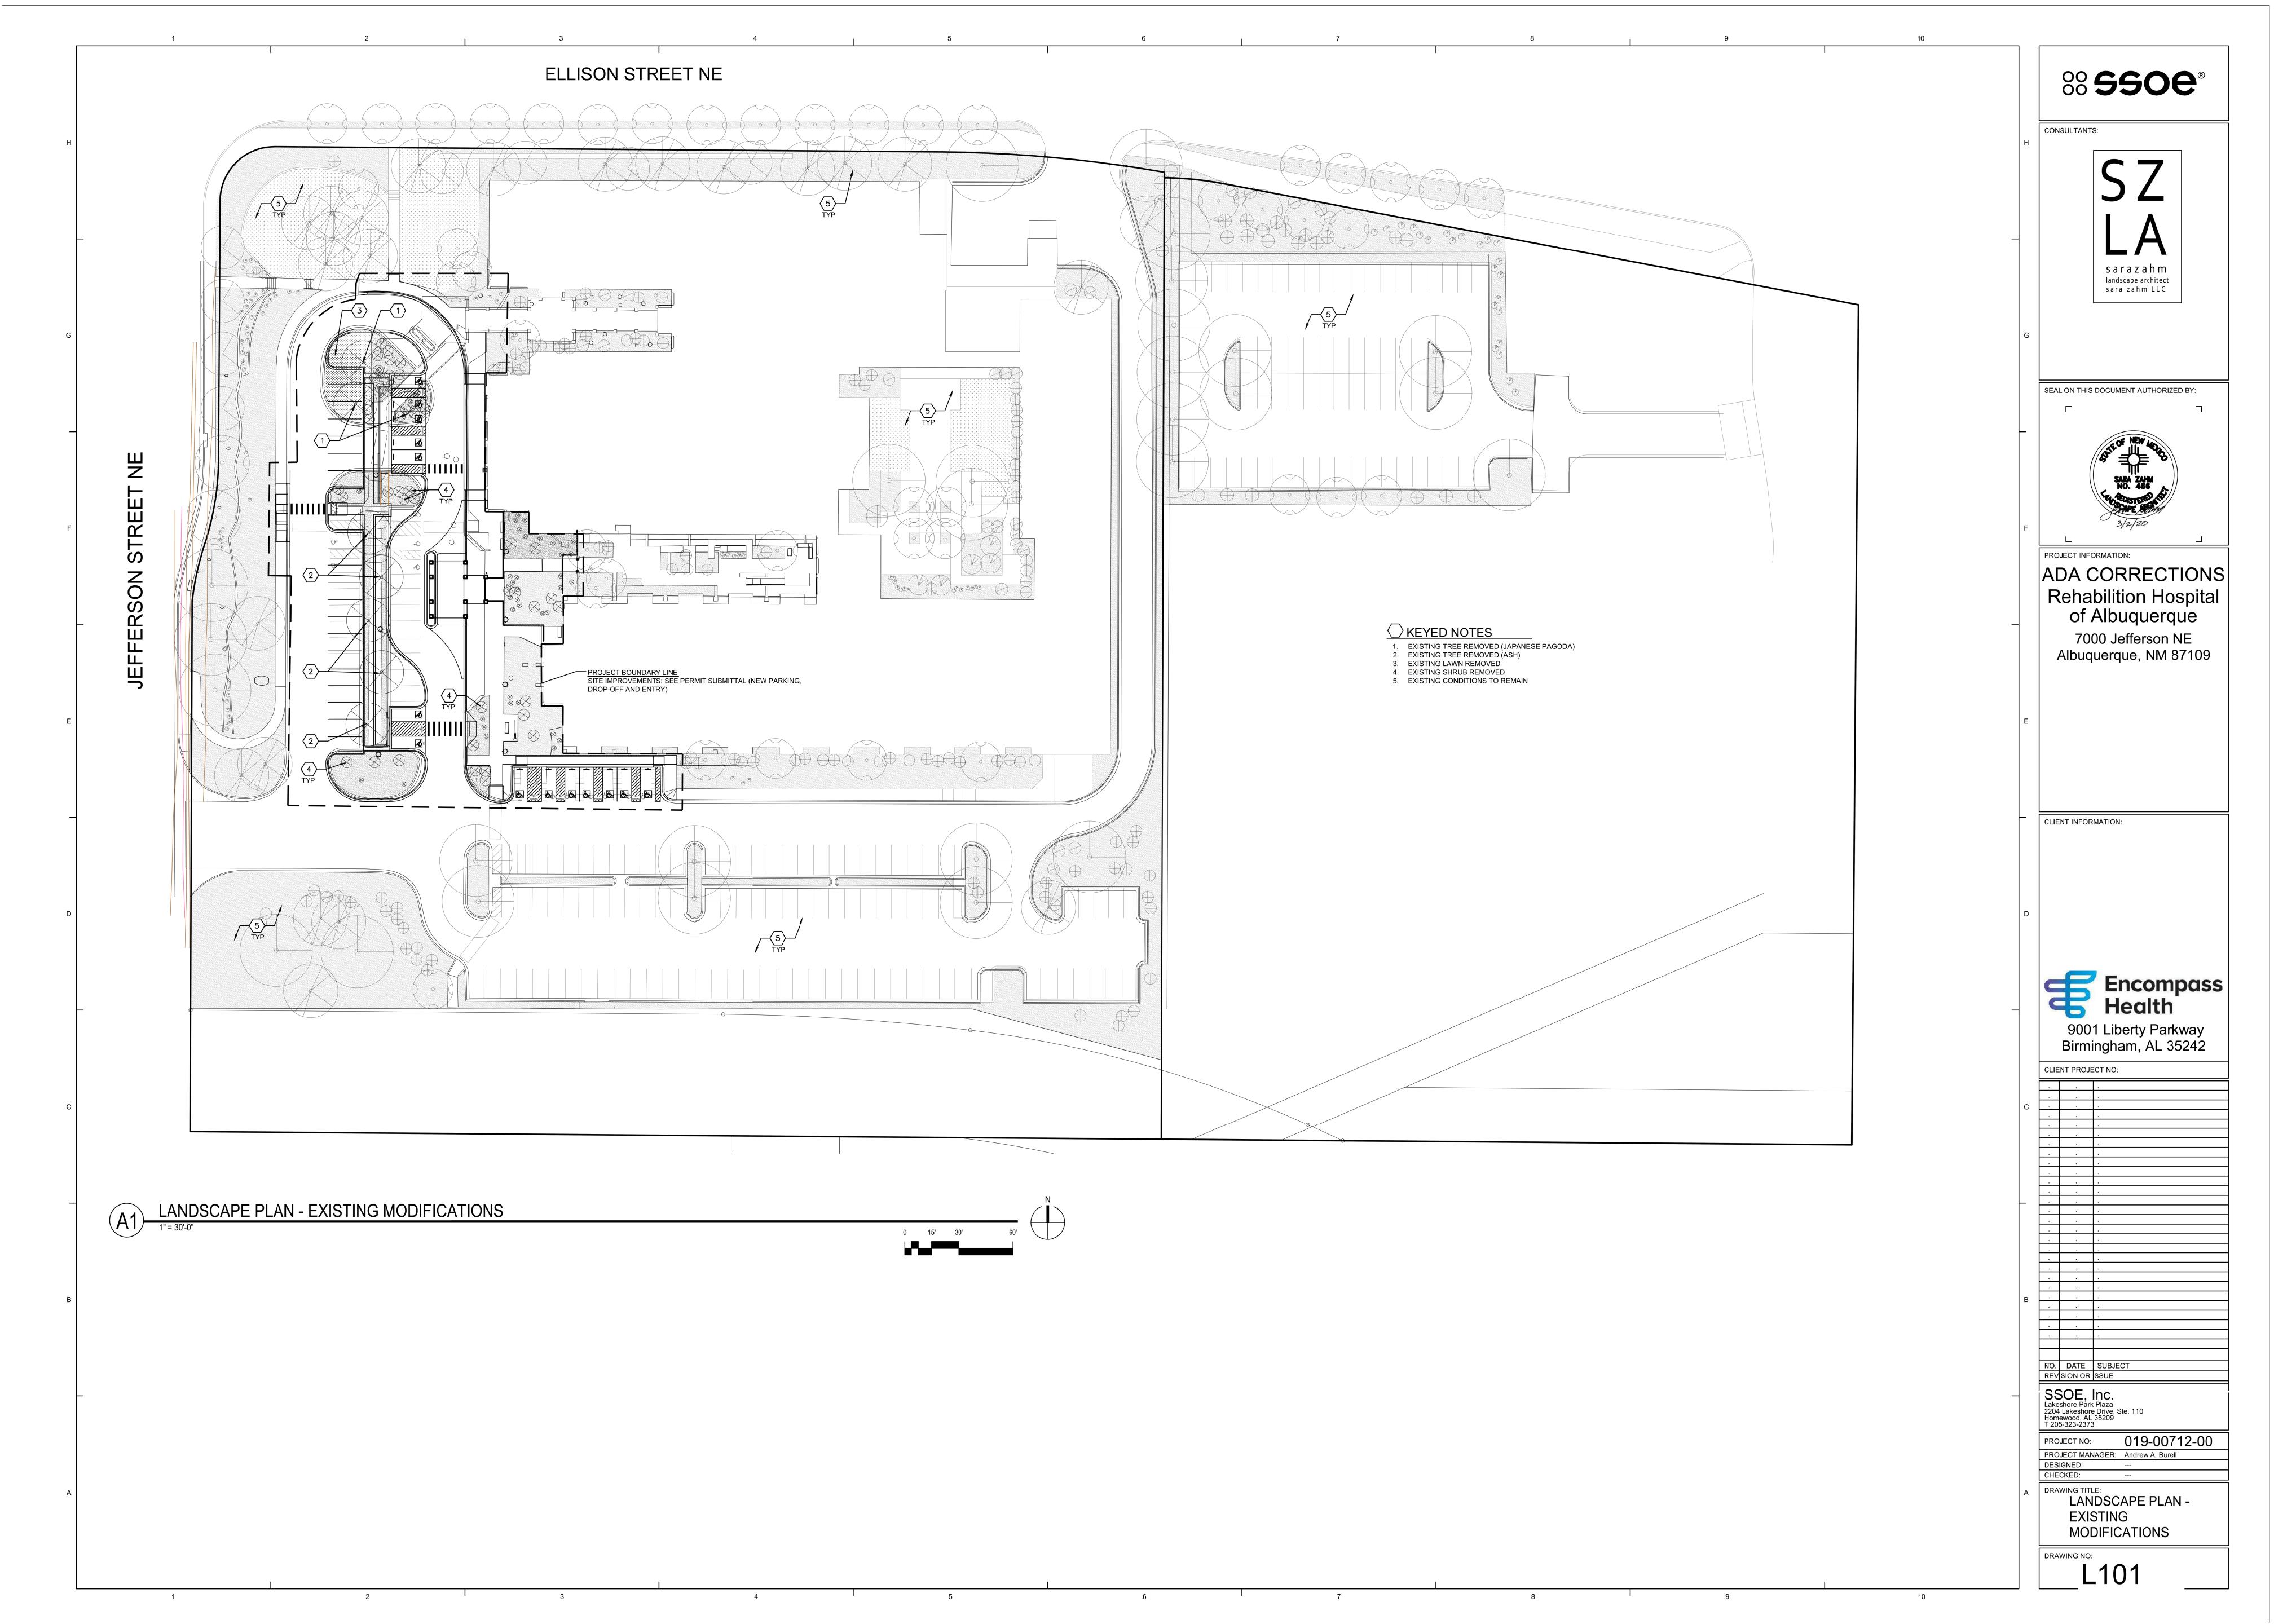

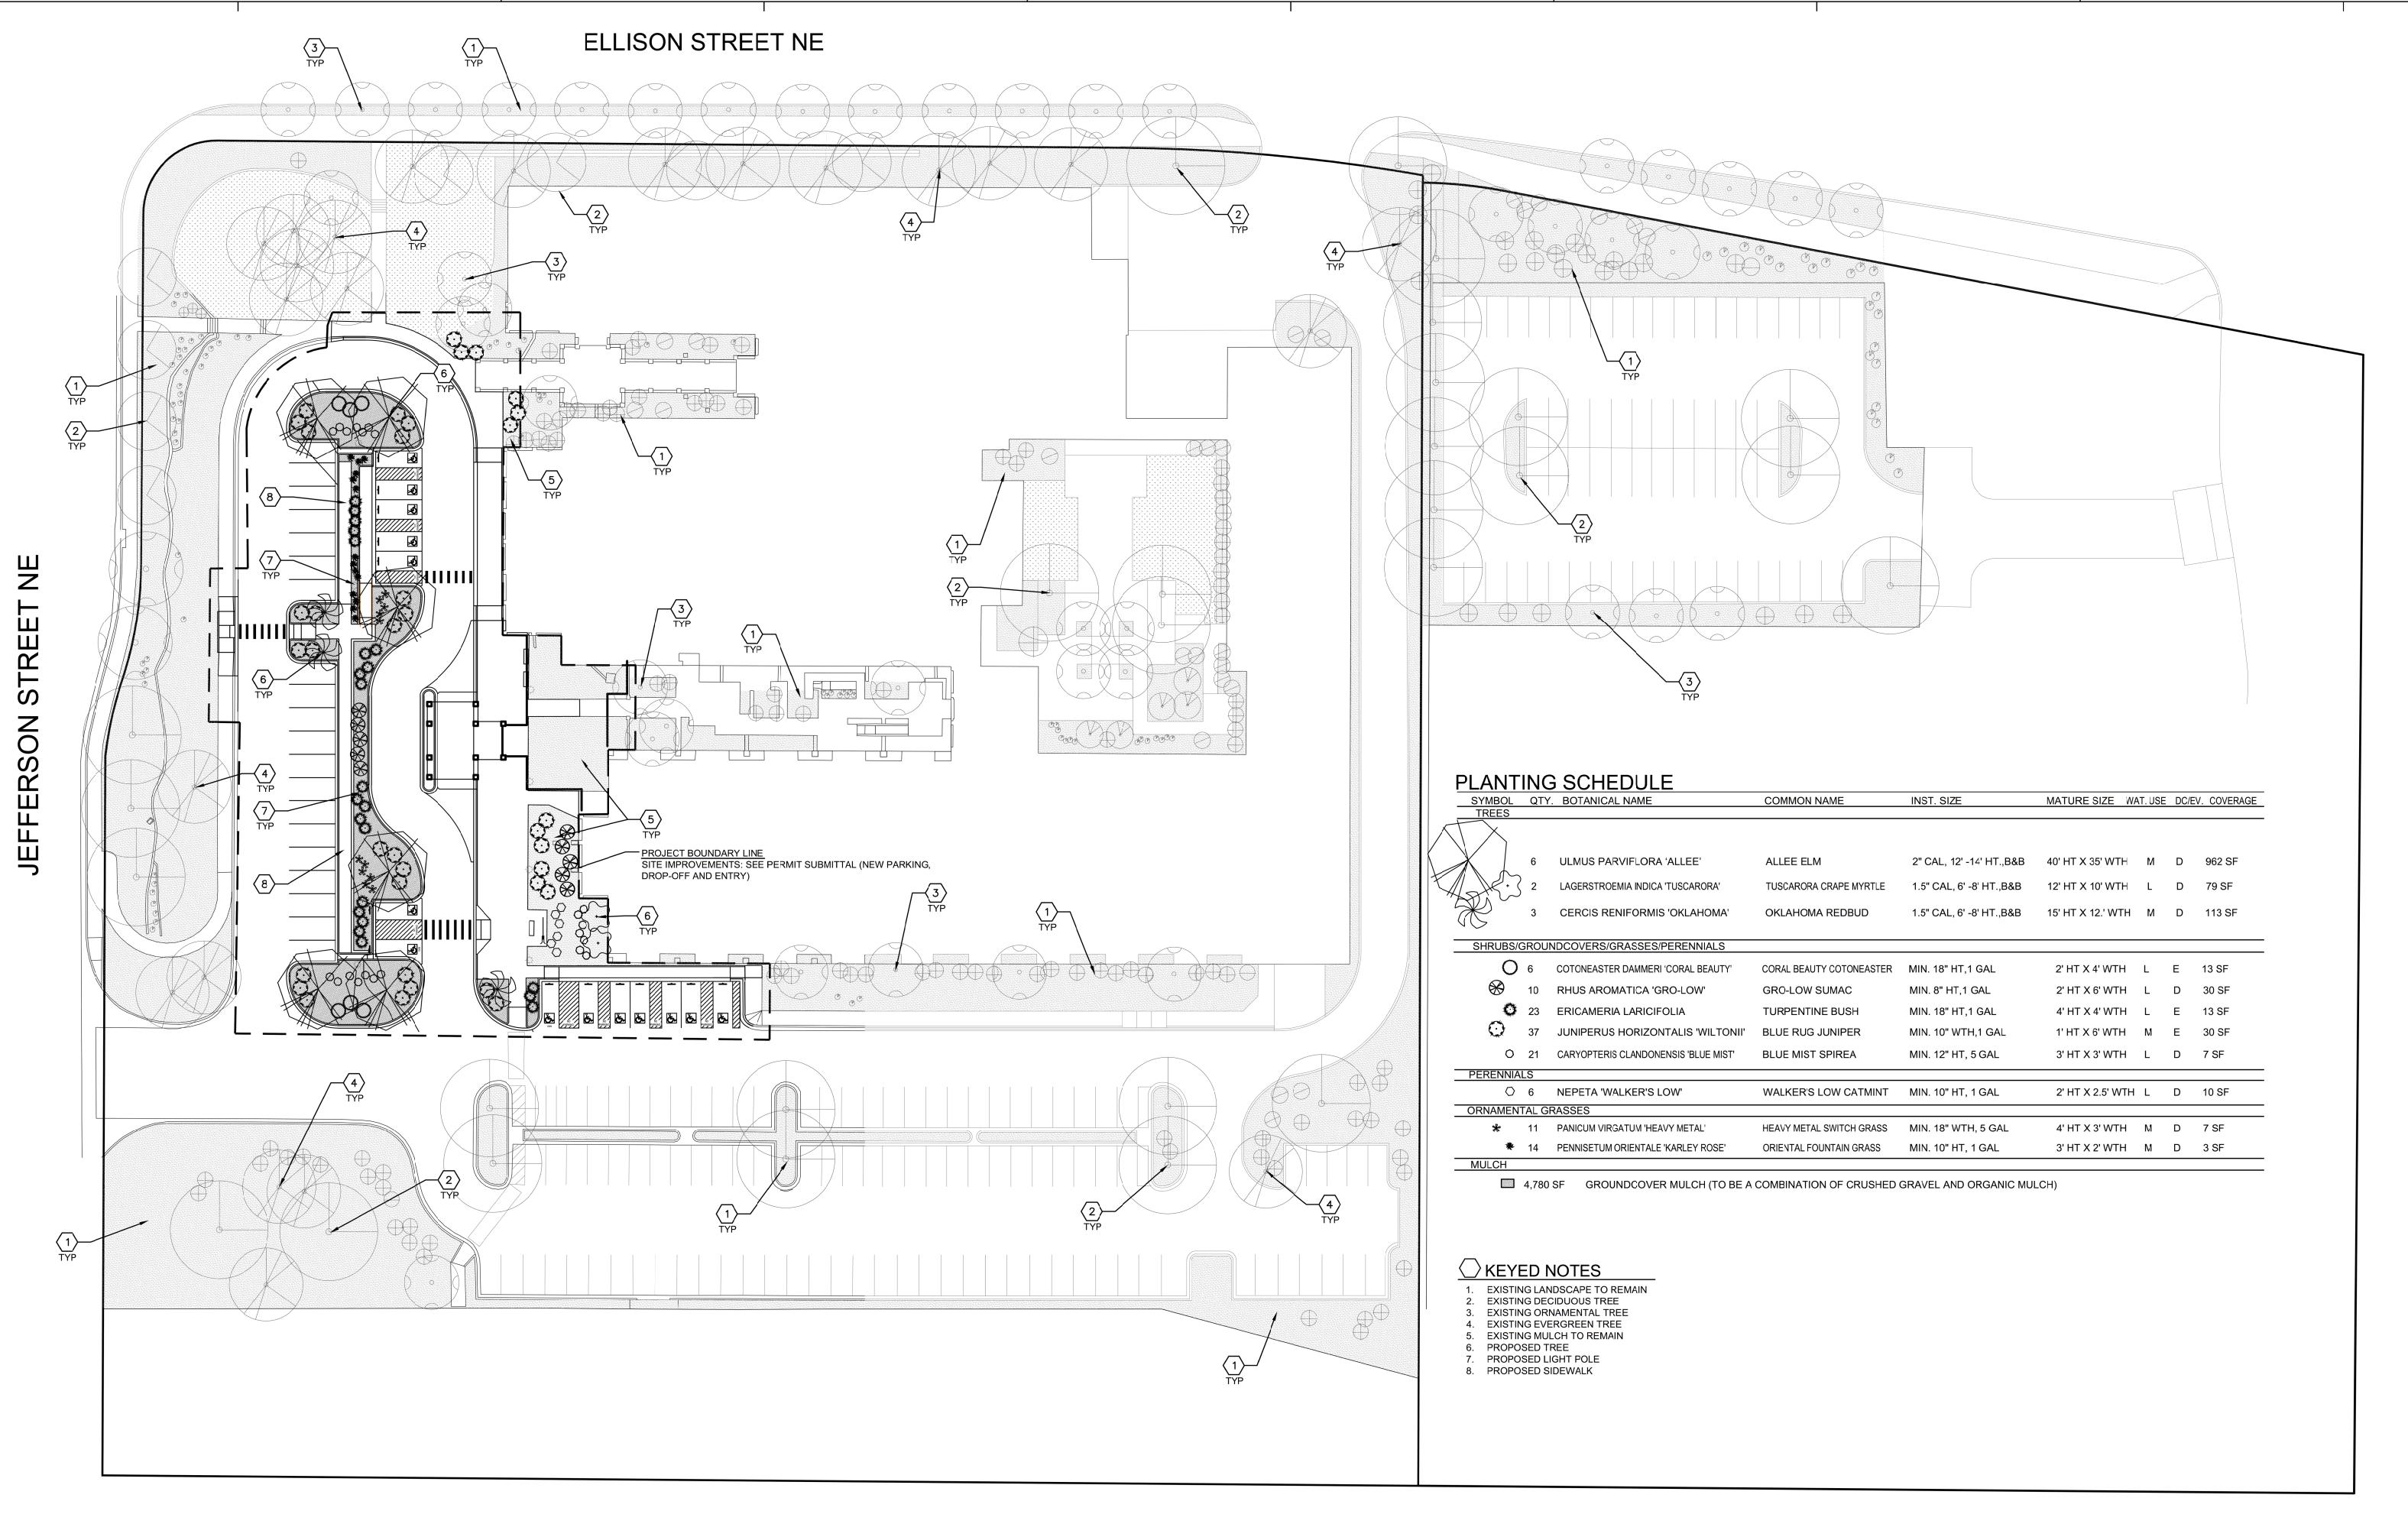

LANDSCAPE PLAN - PROPOSED MODIFICATIONS

1" = 30'-0"



### CITY OF ALBUQUERQUE LANDSCAPE ORDINANCE COMPLIANCE

### COMPLIANCE WITH GENERAL LANDSCAPING STANDARDS:

- 1. GROUNDCOVER MULCH SHALL COMPRISE A COMBINATION OF CRUSHED GRAVEL (NOT TO EXCEED 75% OF TOTAL AREA) AND ORGANIC MULCH SUCH AS SHREDDED BARK OR PECAN SHELLS.
- 2. REFERENCE CITY OF ALBUQUERQUE STANDARD DETAILS FOR TREE AND SHRUB PLANTING.

### LANDSCAPING RESPONSIBILITY FOR MAINTENANCE:

- 1. THE OWNER WILL BE RESPONSIBLE FOR ALL LANDSCAPE MAINTENANCE.
- COMPLIANCE WITH WATER CONSERVATION ORDINANCE: 1. NO SPRAY IRRIGATION IS PROPOSED
- 2. PLANT SPECIES WILL BE LOW OR MEDIUM USE SPECIES PER THE OFFICIAL
- ALBUQUERQUE PLANT PALETTE
- 3. THE PROPOSED AMENDMENTS DO NOT HAVE TURF OR HIGH WATER USE LANDSCAPING
- 4. AN AUTOMATIC IRRIGATION SYSTEM WILL BE INSTALLED FOR ALL PLANT MATERIAL. THE SYSTEM WILL BE CONTROLLED BY AN AUTOMATIC CONTROLLER. PLANTS WILL BE IRRIGATED BY DRIP SYSTEM. REDUCED PRESSURE BACKFLOW PREVENTER WILL BE INSTALLED IN A HEATED ENCLOSURE, FEBCO 825Y, INSTALLED PER CITY OF ALBUQUERQUE STANDARD DRAWING.

LANDSCAPE CALCULATIONS TOTAL LOT AREA: 327,000 SF TOTAL EXISTING BUILDING AREA: 76,053 SF

REQUIRED MINIMUM LANDSCAPE AREA (15% OF NET LOT AREA) 37,316 SF

### PROPOSED LANDSCAPE AMENDMENTS: 58,223 SF

TREES REMOVED FROM PREVIOUS APPROVED LANDSCAPE: 8 TREES PROPOSED TREE ADDITIONS:11 TREES

PARKING LOT REQUIRED PARKING LOT TREES AT ONE TREE PER TEN SPACES: 28 TOTAL SPACES

3 REQUIRED TREES PROVIDED PARKING LOT TREES: 8 TREES **\$\$500** 

sarazahm landscape architect sara zahm LLC

SEAL ON THIS DOCUMENT AUTHORIZED BY:



ADA CORRECTIONS Rehabilition Hospital of Albuquerque

7000 Jefferson NE Albuquerque, NM 87109

CLIENT INFORMATION:



9001 Liberty Parkway Birmingham, AL 35242

CLIENT PROJECT NO:

C	-	-	L -
_			
В			
Ь			
	NO.	DATE	SUBJECT
	REV	SION OR	SSUE

SSOE, Inc.

Lakeshore Park Plaza 2204 Lakeshore Drive, Ste. 110 Homewood, AL 35209 T 205-323-2373

019-00712-00 PROJECT NO: PROJECT MANAGER: Andrew A. Burell DESIGNED: CHECKED:

DRAWING TITLE: LANDSCAPE PLAN -PROPOSED

**MODIFICATIONS DRAWING NO:** 

These plans have been reviewed for code compliance and are:

# EVity of Albuquerque

Planning Department

Project Title: BP-2019-36690 AND TR  Project Title: But A printed copy of these plans shall be on the job site for all DRB#: requested inspections. EP	ANSPORTATION INFORMATION	ON SHEET (REV 6/2018)
DATE: 01/03/20 Businet Title: 11/10 Bu	ilding Permit #:BP-2019-36690	Hydrology File #: 0170061A
A printed copy of these plans shall be on the job site for all	C#:	Work Order#:
Legal Description:		
City Address: 7000 Jefferson NE		
		Contact: Ron Blackwell
Applicant: SDB, Inc.	ann Addison T	75001
40E1 Nimort Parkway. S	100 067 5941	Ron.Blackwell@SDB.com
Address: 4951 All polic Fallway, 2 Phone#: 214-770-9949 Fa	x#:_480-967-3841	E-mail:
Other Contact: LBYD, Inc.  Address: 880 Montclair Road, Stte		Contact: Landon Boggs
Address: 880 Montclair Road, Stte	e 600 Birmingham, AL	35213
Phone#: 205-488-4630 Fa	nx#:	E-mail: lboggs@lbyd.com
TYPE OF DEVELOPMENT: PLAT (# o	f lots) RESIDENCE	DRB SITE ADMIN SITE
IS THIS A RESUBMITTAL? Yes	XXNo	
DEPARTMENT XX TRANSPORTATION		
Check all that Apply:		AL/ACCEPTANCE SOUGHT:
	XX BUILDING PER	
TYPE OF SUBMITTAL: ENGINEER/ARCHITECT CERTIFICATION	CERTIFICATE	OF OCCUPANCE
PAD CERTIFICATION	PRFI IMINARY	PLAT APPROVAL
CONCEPTUAL G & D PLAN		OR SUB'D APPROVAL
GRADING PLAN	XX SITE PLAN FO	R BLDG. PERMIT APPROVAL
DRAINAGE REPORT	FINAL PLAT	
DRAINAGE MASTER PLAN	<del></del>	
FLOODPLAIN DEVELOPMENT PERMIT AP	PLIC SIA/ RELEASE	E OF FINANCIAL GUARANTEE
ELEVATION CERTIFICATE	FOUNDATION	PERMIT APPROVAL
CLOMR/LOMR	GRADING PEI	RMIT APPROVAL
XX TRAFFIC CIRCULATION LAYOUT (TCL)	SO-19 APPRO	VAL
TRAFFIC IMPACT STUDY (TIS)		MIT APPROVAL
STREET LIGHT LAYOUT		D CERTIFICATION
OTHER (SPECIFY)	WORK ORDER	APPROVAL
PRE-DESIGN MEETING?	CLOMR/LOMI	
		DEVELOPMENT PERMIT
		CIFY)
DATE SUBMITTED: 09-30-19	By:Ron_Blackwell	
COA STAFF:	ELECTRONIC SUBMITTAL RECEIVED:(\$225.00	

FEE PAID:\_

## CITTIVOCALIDOUROUEBUQUERQUE

These plans have been reviewed.

Plantoingde compliance and are:

Praymon Will Director

Bre mon Will: .... Director

The Approval of these plans shall not be construed to be a permit for any violations of any code or ordinance of this city.

PERMIT #: BP-2019-36690

DATE: 01/03/20

A printed copy of these plans shall be on the job site for all

SDB, nic. 4951 Airport Parkway, Suite 800 Addison, TX 75001

**RE:** Encompass Health

7000 Jefferson NE

**Grading Plan Stamp Date: 10/17/19** 

Hydrology File: D17D061A

Dear Mr. Coley:

Based on the submittal received on 12/2/19, this project is approved for Building Permit.

PO Box 1293

NM 87103

If you have any questions, please contact me at 924-3695 or dpeterson@cabq.gov.

Albuquerque Sincerely,

Dana Peterson, P.E.

Senior Engineer, Planning Dept.

www.cabq.gov Development Review Services

Mayor Timothy M. Keller

#### FORM P3: ADMINISTRATIVE DECISIONS AND MINOR AMENDMENTS

A Single PDF file of the complete application including all documents being submitted must be emailed to <a href="PLNDRS@cabq.gov">PLNDRS@cabq.gov</a> prior to making a submittal. Zipped files or those over 9 MB cannot be delivered via email, in which case the PDF must be provided on a CD. PDF <a href="https://shall.be.organized">shall be organized</a> with the Development Review Application and this Form P3 at the front followed by the remaining documents <a href="mailto:in">in</a> the order provided on this form.

<u>tne</u>	order provided on this form.					
	ARCHEOLOGICAL CERTIFICATE  PDF of application as described above Zone Atlas map with the entire site clearly outlined and labeled Letter of authorization from the property owner if application is submitted by an agent Archaeological Compliance Documentation Form with property information section com Note: Only the information above is required unless the City Archaeologist determines a Certificate of No Effect, in which case a treatment plan prepared by a qualified archae archeological impacts of the proposed development must be submitted and reviewed for criteria in IDO Section 14-16-6-5(A)(3)(b)	that the application does not qualify for eologist that adequately mitigates any				
	MINOR AMENDMENT TO SITE PLAN – ADMIN, EPC, or DRB  PDF of application as described above Zone Atlas map with the entire site clearly outlined and labeled Letter of authorization from the property owner if application is submitted by an agent Justification letter describing, explaining, and justifying the request per the criteria in ID One copy of all applicable sheets of the approved Site Plan being amended, folded Copy of the Official Notice of Decision associated with the prior approval Three (3) copies of the proposed Site Plan, with changes circled and noted Refer to the Site Plan Checklist for information needed on the proposed Site Plan.	O Section 14-16-6-4(X)(2)				
	Minor Amendments must be within the thresholds established in IDO TABLE 6-4-5 thresholds is considered a Major Amendment and must be processed through the the request.					
	MINOR AMENDMENT TO SITE DEVELOPMENT PLAN APPROVED PRIOR TO THE EFFECTIVE DATE OF THE IDO  PDF of application as described above Zone Atlas map with the entire site clearly outlined and labeled Letter of authorization from the property owner if application is submitted by an agent Justification letter describing, explaining, and justifying the request per the criteria in IDO Section 14-16-6-4(Y)(1)(a) One copy of all applicable sheets of the approved Site Development Plan being amended, folded Copy of the Official Notice of Decision associated with the prior approval Three (3) copies of the proposed Site Plan, with changes circled and noted Refer to the Site Plan Checklist for information needed on the proposed Site Plan.					
	Minor Amendments must be within the thresholds established in IDO TABLE 6-4-5 thresholds is considered a Major Amendment and must be processed through the the request.					
	ALTERNATIVE SIGNAGE PLAN  PDF of application as described above Zone Atlas map with the entire site clearly outlined and labeled Letter of authorization from the property owner if application is submitted by an agent Proposed Alternative Signage Plan compliant with IDO Section 14-16-5-12(F)(5) Justification letter describing, explaining, and justifying the request per the criteria in IDO Section 14-16-6-5(F)(4)(c) Required notices with content per IDO Section 14-16-6-4(K)(6) Office of Neighborhood Coordination notice inquiry response and proof of emailed notice to affected Neighborhood Association representatives Sign Posting Agreement					
	the applicant or agent, acknowledge that if any required information is not submitted with the heduled for a public meeting or hearing, if required, or otherwise processed until it is complete.	is application, the application will not be				
	nature: Warpen Callahan	Date: 07/29/2020				
	ited Name: Warren Callahan	☐ Applicant or ☒ Agent				
FOF	R OFFICIAL USE ONLY					
Stat	Case Numbers: Project Number:  f Signature:	ALB UT				
Date		ME				