


1 Overall Site Plan
1" = 40'-0"

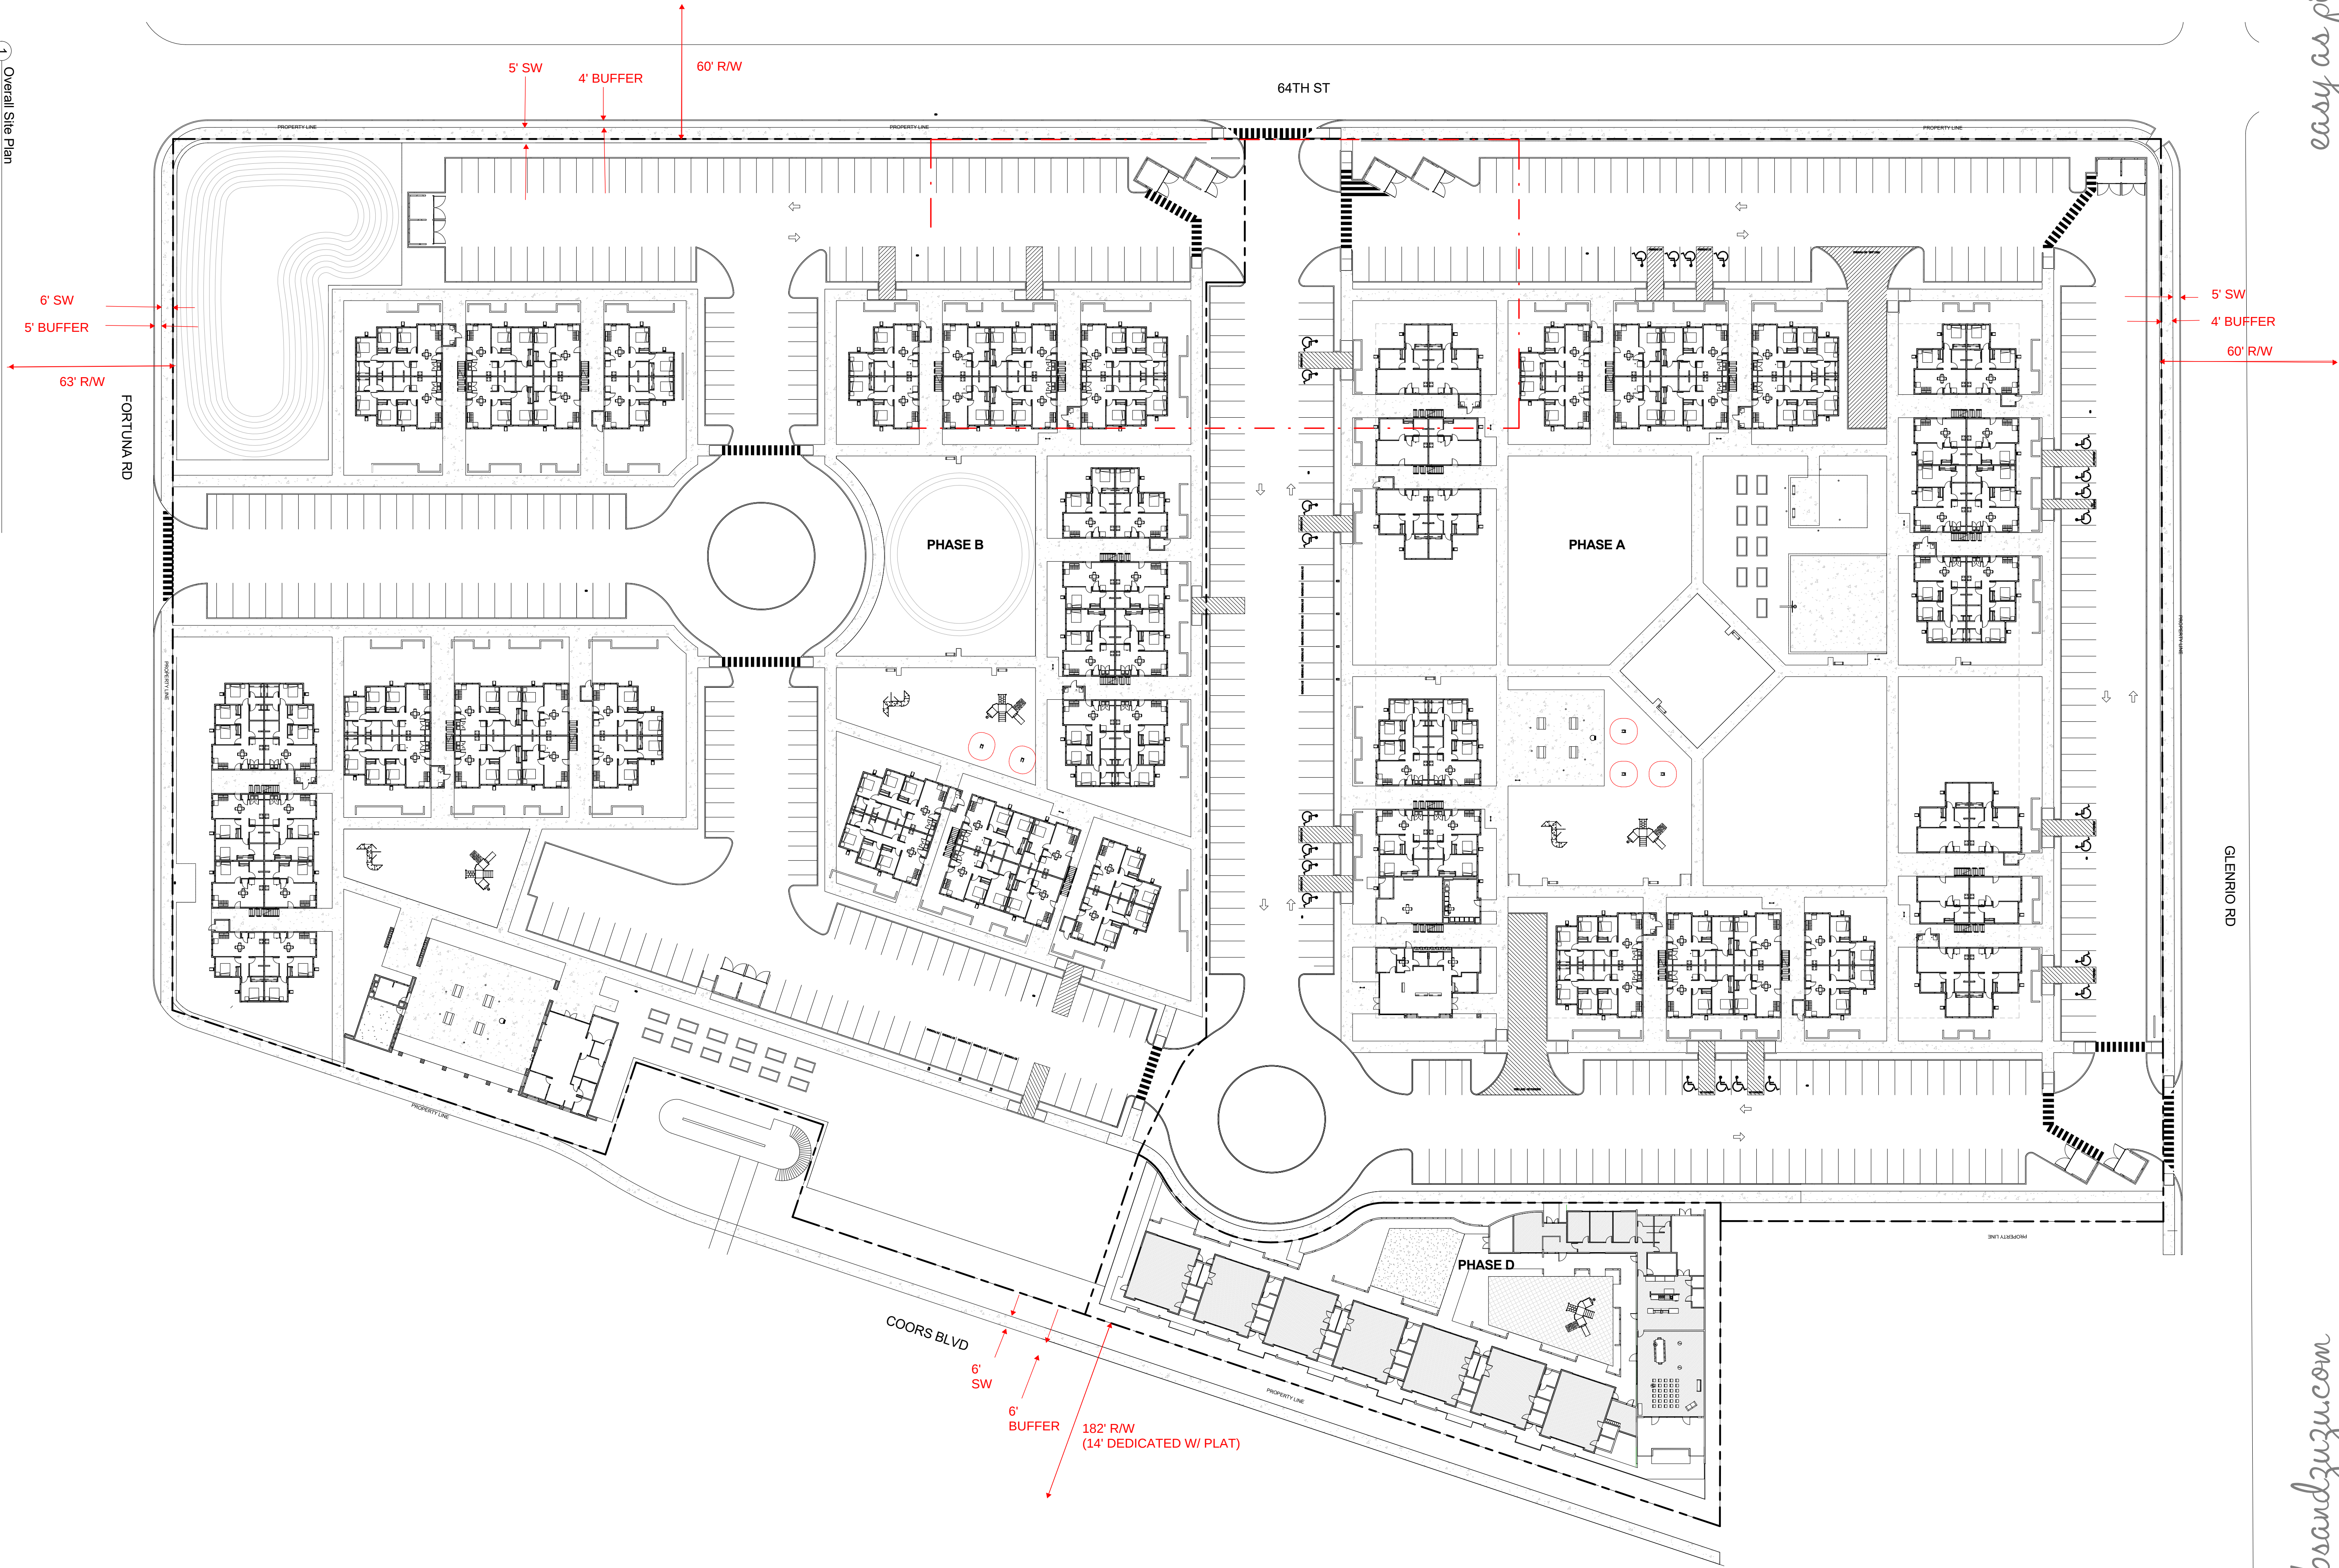

www.jebsandzuzu.com

easy as pie


OVERALL SITE PLAN

West Mesa Ridge - Phase B

sheet no:

5

701 COORS BLVD NW ALBUQUERQUE NM 87121

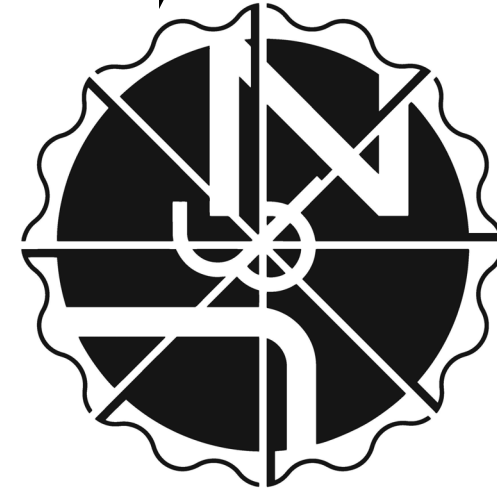

JEBS & ZUZU, LLC.

**Architecture
Construction
Design-Build**

5924 ANAHEIM AVENUE NE SUITE A
ALBUQUERQUE, NM 87113

P: 505-797-1318

job no:

drawn: J&Z

checked: J&Z

date: Aug. 8, 2024