

H - 15

VICINITY MAP SCALE: 1" = 750'

INDEX OF DRAWINGS

1. COVER SHEET

2. BOUNDARY SURVEY WITH DIGITAL ORTHOPHOTO UNDERLAY

3. TOPOGRAPHIC AND UTILITY SURVEY - SOUTH PORTION 3. TOPOGRAPHIC AND UTILITY SURVEY - NORTH PORTION

CONTROL SURVEY NOTE

A CONTROL SURVEY WAS CONDUCTED AT THE SITE IN AUGUST, 2014 AND VERIFIED IN DECEMBER, 2019 AND DECEMBER, 2024. CONTROL WAS PROJECTED ONTO THE SUBJECT SITE UTILIZING RTK GPS OBSERVATIONS COMBINED WITH GEOID MODEL 18(CONUS) TO ESTABLISH HORIZONTAL AND VERTICAL POSITIONS BASED UPON NAD 83/NAVD 88 DATUM. THE RTK OBSERVATIONS WERE USED TO ESTABLISH THE TEMPORARY BENCHMARKS AT THE PROJECT SITE.

THE POINTS OBSERVED HAVE BEEN QUALITY CONTROLLED FOR RELATIVE ACCURACY. AN AGRS BENCHMARK/HORIZONTAL CONTROL STATION "A-438" IN THE VICINITY OF THE PROJECT WERE OBSERVED IN ORDER TO PROVIDE REFERENCE TIES TO THE SITE. ALL HORIZONTAL COORDINATES ARE MODIFIED NAD 83 GRID VALUES AND HAVE BEEN ADJUSTED TO THE GROUND AT THE PROJECTION POINT (THE SCALE FACTOR USED IS 1/CF=1.0003189671). THE CONTROL STATION USED TO PROJECT FROM GRID TO GROUND FOR THIS PROJECT IS THE PROJECT BENCHMARK "A-438" WITH NAD GRID COORDINATES OF:

NORTHING = 1,495,747.49 FEET LATITUDE = $35^{\circ}06'37.87634"$ NORTH EASTING = 1.523.137.26 FEET LONGITUDE= 106°38'31.73465" WEST ELEVATION = 4975.35 FEETHEIGHT= 4905.29 FEET

THE ELEVATIONS ARE BASED UPON THE NAVD DATUM AND REQUIRE NO FURTHER ADJUSTMENT

PROJECT BENCHMARK - DESTROYED

AN A.G.R.S. 1 3/4" ALUMINUM DISK STAMPED "ACS BM, 11-H15" EPOXIED ON TOP OF CONCRETE CURB RETURN, AT THE ENE QUADRANT OF THE INTERSECTION OF MENAUL BOULEVARD AND BROADBENT PARKWAY N.E.

ELEVATION = 5015.50 FEET (NAVD 1988)

TEMPORARY BENCHMARK #250 (T.B.M.)

A #5 REBAR W/CAP STAMPED "HMCG CONTROL NMPS 15075", SET IN DIRT APPROXIMATELY 50' NORTH OF THE NORTHEAST CORNER OF A BUILDING NEAR THE WEST PROPERTY LINE. AS SHOWN ON THIS SHEET AND SHEET 4.

MODIFIED GROUND COORDINATES: NORTHING = 1,495,080.29 FEETEASTING = 1,526,558.52 FEET ELEVATION = 5,026.24 FEET (NAVD 1988)

TEMPORARY BENCHMARK #251 (T.B.M.)

A #5 REBAR W/CAP STAMPED "HMCG CONTROL NMPS 15075", SET IN DIRT APPROXIMATELY 78' EAST OF THE SOUTHWEST CORNER OF THE SOUTHWEST PROPERTY CORNER, AS SHOWN ON THIS SHEET AND SHEET 3.

MODIFIED GROUND COORDINATES:


NORTHING = 1,494,054.84 FEET EASTING = 1,525,903.66 FEET

ELEVATION = 5,028.65 FEET (NAVD 1988)

TEMPORARY BENCHMARK #254 (T.B.M.)

A #5 REBAR W/CAP STAMPED "HMCG CONTROL NMPS 15075", SET IN DIRT AT THE WEST END OF THE WEST CONCRETE DRIVE PAD ONTO THE SITE, AS SHOWN ON THIS SHEET AND SHEET 4.

MODIFIED GROUND COORDINATES: NORTHING = 1,495,174.24 FEET EASTING = 1,527,097.68 FEET ELEVATION = 5,027.94 FEET (NAVD 1988)

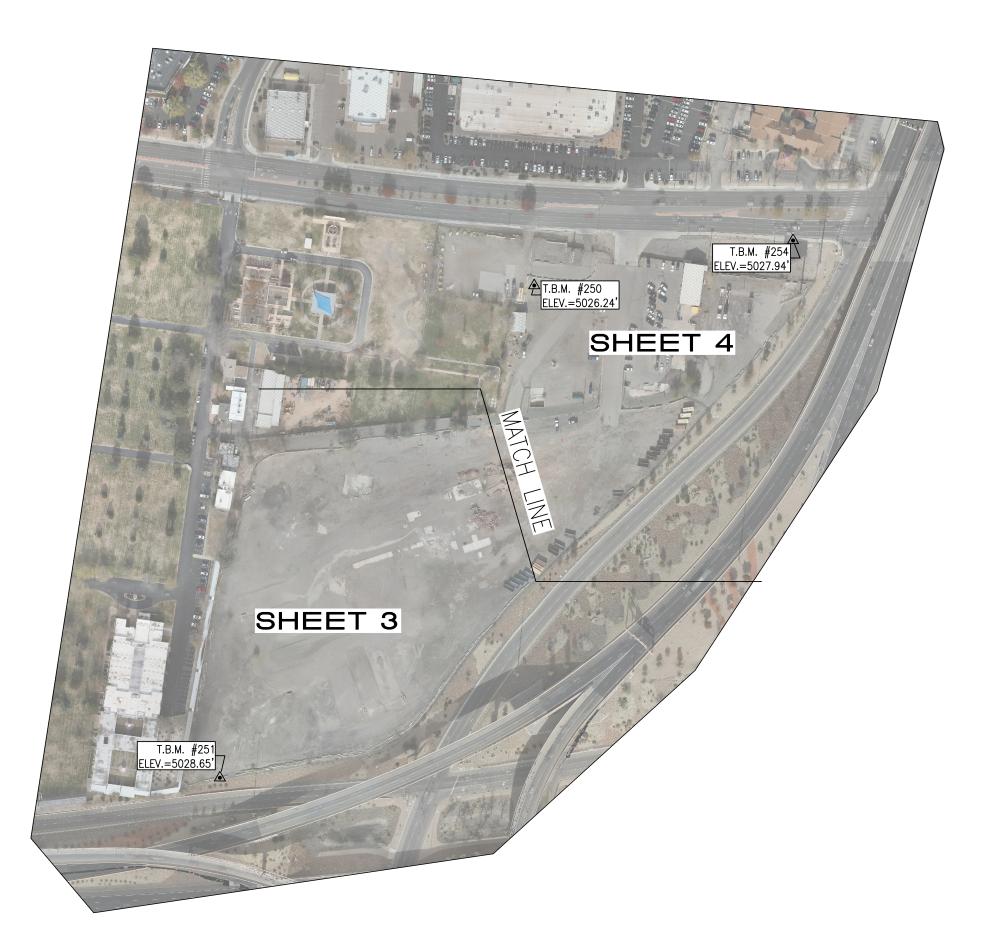

KEY MAP

SUBSURFACE UTILITY ENGINEERING (SUE) QUALITY LEVEL DESCRIPTIONS

THERE ARE FOUR QUALITY LEVELS OF SUBSURFACE UTILITY ENGINEERING. QUALITY LEVELS D, C & B ARE NOT A STATEMENT OF THE ACCURACY OF THE PHYSICAL POSITION OF THE UTILITY; RATHER, THEY ARE A VALUE JUDGMENT OF RELIABILITY THAT THE POSITION OF THE UTILITY SEGMENT IS DOCUMENTED AS ACCURATELY TO ITS TRUE LOCATION AS POSSIBLE, BASED ON THE EVIDENCE IN HAND AT A PARTICULAR POINT IN TIME. QUALITY LEVEL A IS A DOCUMENTATION OF THE SURVEYED PHYSICAL POSITION OF THE UTILITY AND DIRECT MEASUREMENT OF OBSERVABLE ATTRIBUTES

QUALITY LEVEL A (QLA) — UTILITY COMPOSITION, SIZE AND PRECISE VERTICAL AND HORIZONTAL POSITION OF DESIGNATED UTILITY LINE OBTAINED THROUGH NON-DESTRUCTIVE METHODS OF

EXCAVATION. ALSO REFERRED TO AS POTHOLING OR DAYLIGHTING.

QUALITY LEVEL B (QLB) - HORIZONTAL UTILITY LOCATIONS ASCERTAINED THROUGH THE APPLICATION OF APPROPRIATE SURFACE GEOPHYSICAL METHODOLOGIES AND UTILITY LOCATING TECHNIQUES. ALSO REFERRED TO AS DESIGNATION OR LINE-SPOTTING. (---UTIL QLB---UTIL QLB--)

QUALITY LEVEL C (QLC) — SURVEYING VISIBLE UTILITY FACILITIES (E.G., MANHOLES, VALVE BOXES, ETC.) AND CORRELATING THIS INFORMATION WITH EXISTING UTILITY RECORDS (QLD INFORMATION). QLC INFORMATION CONFIRMS THE EXISTENCE, GENERAL LOCATION, ATTRIBUTES, AND, WHERE APPLICABLE, DIRECTION OF SUBSURFACE UTILITY ASSETS THAT CAN AT LEAST BE PARTIALLY VIEWED OR INFERRED WITHOUT EXCAVATION (---UTIL QLC---UTIL QLC--)

QUALITY LEVEL D (QLD) - UTILITY INFORMATION DERIVED FROM EXISTING UTILITY RECORDS AND VARIOUS OTHER RESOURCES OF UTILITY INFORMATION INCLUDING BUT NOT LIMITED TO: RECORD OR AS-BUILT DRAWINGS, SITE UTILITY PLANS, DISTRIBUTION AND SERVICE MAPS, EXISTING GEOGRAPHIC INFORMATION SYSTEM (GIS) DATABASES, ORAL RECOLLECTIONS, ETC. (---UTIL QLD---UTIL QLD--)

SUBSURFACE UTILITY NOTES

- 1. UTILITIES SHOWN ARE A DEPICTION OF VISIBLE UTILITY FEATURES AND ASCERTAINABLE SUBSURFACE UTILITY LOCATIONS THAT HAVE BEEN DESIGNATED AND/OR OBSERVED BY. AND SUBSEQUENTLY SURVEYED BY HIGH MESA CONSULTING GROUP. AS A GENERAL GUIDELINE, ASCE STANDARD 38-22 (STANDARD GUIDELINE FOR INVESTIGATING AND DOCUMENTING EXISTING UTILITIES) HAS BEEN FOLLOWED FOR GATHERING AND PRESENTING THE LEVEL OF UTILITY INFORMATION THAT HAS BEEN REQUESTED FOR THIS PROJECT. SUBSURFACE UTILITY ENGINEERING (SUE) QUALITY LEVELS B. C. AND D HAVE BEEN COMPLETED AT THIS TIME.
- 2. SURFACE GEOPHYSICAL LOCATING AND SUBSURFACE UTILITY DESIGNATION (SUE QLB) EFFORTS HAVE BEEN BASED UPON VARIOUS RESOURCES OF UTILITY INFORMATION ALONG WITH CURRENT SITE CONDITIONS INCLUDING ACCESSIBLE SURFACE FEATURES OBSERVED WITHIN THE PROJECT LIMITS. RESULTS OF THIS EFFORT HAVE BEEN CORRELATED TO EXISTING RECORD DRAWINGS (OR OTHER RESOURCES OF UTILITY INFORMATION) THAT WERE AVAILABLE AT THE TIME THIS WORK WAS PERFORMED. UTILITY LOCATIONS THAT COULD NOT BE ASCERTAINED THROUGH SURFACE GEOPHYSICAL LOCATING METHODS, BUT WERE RECONCILED FROM UTILITY RECORDS, HAVE BEEN IDENTIFIED AND LABELED ON THIS SURVEY ACCORDINGLY. ADDITIONALLY, ANY DISCOVERED DISCREPANCIES RELATED TO THE RECORD DRAWINGS, UTILITY CONNECTIVITY OR PUBLIC UTILITY RESPONSE HAVE BEEN DOCUMENTED. REFER TO KEYED SUBSURFACE UTILITY NOTES ON SHEETS 3 AND 4 FOR LOCATIONS AND SUBSURFACE UTILITY KEYED NOTES BELOW FOR DETAILS.
- 3. PUBLICLY-OWNED UTILITIES REPRESENTED ON THIS SURVEY HAVE BEEN IDENTIFIED BY THE OWNER IN RESPONSE TO HIGH MESA NM811 DESIGN LOCATE REQUESTS (NM811 TICKET 24NV220188) AND/OR THROUGH SUPPLEMENTAL DESIGNATION EFFORTS BY HIGH MESA BASED UPON SURFACE EVIDENCE AND VARIOUS OTHER RESOURCES OF UTILITY INFORMATION OBTAINED FROM THE OWNER AT THE ONSET OF THE PROJECT. A LIST OF UTILITY OWNERS REGISTERED WITH NM811 HAS BEEN PROVIDED BELOW:

*TELEDUONE NILIMDEE

NM811 UTILITY OWNER/OPERATOR LIST

NAME	*IELEPHONE NUMBER			
CITY OF ALBUQUERQUE - STORM DRAINS	1-505-857-8022			
CITY OF ALBUQUERQUE — STREET LIGHTING DEPT	1-505-508-0744			
CITY OF ALBUQUERQUE — STREET LIGHTING DEPT	1-505-857-8689			
ALBUQUERQUE/BERNALILLO COUNTY WUA	1-505-842-9287			
COMCAST	1-800-778-9140			
CITY OF ALBUQUERQUE	1-505-857-8044			
MCI CABLE SEC	1-919-414-2782			
NEW MEXICO DEPARTMENT OF TRANSPORTATION - FIBER	1-505-206-7497			
NEW MEXICO DEPARTMENT OF TRANSPORTATION - FIBER	1-505-216-8538			
NEW MEXICO GAS COMPANY — ALBUQUERQUE	1-505-934-5853			
PNM ELECTRIC — ALBUQUERQUE	1-505-463-0024			
CENTURYLINK LOCAL NETWORK CENTRAL	1-800-283-4237			
UNITE PRIVATE NETWORKS, LLC	1-816-368-9039			
VEXUS FIBER LLC	1-505-269-4300			
ZAYO GROUP — ALBUQUERQUE	1-866-364-6033			

*TELEPHONE NUMBERS OBTAINED THROUGH NM811 WEB PORTAL

4. THIS UTILITY SURVEY AND SUBSURFACE UTILITY ENGINEERING EFFORT IS NOT ALL-INCLUSIVE AND MAY NOT REPRESENT UTILITIES/INFRASTRUCTURE THAT HAVE BEEN ABANDONED-IN-PLACE, WERE INACCESSIBLE, OR OTHERWISE UNDETECTABLE DUE TO UNFORESEEN AND UNCONTROLLABLE SITE AND/OR UTILITY CONDITIONS. FURTHER, THIS UTILITY INVESTIGATION MAY BE INCOMPLETE, OR MAY BE OBSOLETE BY THE TIME CONSTRUCTION COMMENCES, THEREFORE, MAKES NO REPRESENTATION PERTAINING THERETO, AND ASSUMES NO RESPONSIBILITY OR LIABILITY THEREFORE. THE PROPERTY OWNER, DEVELOPER, OR CONTRACTOR IS FULLY RESPONSIBLE FOR ANY AND ALL DAMAGE CAUSED BY ITS FAILURE TO LOCATE, IDENTIFY AND PRESERVE ANY AND ALL EXISTING UNDERGROUND UTILITY LINES. IN PLANNING AND CONDUCTING EXCAVATION, THE CONTRACTOR SHALL COMPLY WITH STATE STATUES, NEW MEXICO EXCAVATION LAWS (NM811), MUNICIPAL AND LOCAL ORDINANCES,

SITE SPECIFIC RULES AND REGULATIONS, IF ANY, PERTAINING TO THE LOCATION OF THESE UTILITY

SUBSURFACE UTILITY KEY NOTES

LINES AND FACILITIES.

- (1) THE EXACT LOCATION OF THE WATER LINE COULD NOT BE ASCERTAINED THROUGH THIS GEOPHYSICAL INVESTIGATION. THE WATER LINE IS DEPICTED ON THIS SURVEY IN AN APPROXIMATE MANNER BASED UPON RECORD DRAWINGS OR OTHER RESOURCES OF UTILITY INFORMATION.
- A STANDALONE (UNARMORED) FIBER OPTIC CABLE WAS DISCOVERED IN THE RISER THAT WAS NOT ACCOMPANIED BY A TRACER WIRE OR OTHER DETECTABLE TELECOMMUNICATION LINE. THE PATHWAY AND DESTINATION OF THE STANDALONE FIBER OPTIC CABLE COULD NOT BE DETERMINED. DESIGNATION IS INCOMPLETE.
- THE SIGNAL APPLIED TO THE ELECTRIC LINE FOR THE LIGHTING CIRCUIT ABRUPTLY STOPS AT THIS POINT. THE LOCATION OF THE ELECTRIC LINE COULD NOT BE DETERMINED BEYOND THIS POINT. DESIGNATION IS INCOMPLETE.
- VACANT CONDUITS WERE DISCOVERED INSIDE THE ELECTRIC PULLBOX. THE PATHWAY AND DESTINATION OF THE VACANT CONDUITS COULD NOT BE DETERMINED. DESIGNATION IS
- THE SIGNAL APPLIED TO THE TELECOMMUNICATION LINE ABRUPTLY STOPS AT THIS POINT. THE TELECOMMUNICATION LINE WAS NOT DETECTABLE BEYOND THIS POINT. DESIGNATION IS
- THE EXACT LOCATION OF THE WATER LINE COULD NOT BE ASCERTAINED THROUGH THIS GEOPHYSICAL INVESTIGATION. DESIGNATION IS INCOMPLETE. ELECTRIC LINES HAVE BEEN ABANDONED. THE RELIC AND ABANDONED-IN-PLACE CABLES ARE
- NO LONGER DETECTABLE. DESIGNATION IS INCOMPLETE.
- NEW MEXICO DEPARTMENT OF TRANSPORTATION FIBER OPTIC CABLE MARKED BY OTHERS. LOCATION OF STORM DRAIN (SD) COULD NOT BE DETERMINED.
- CLEANOUT DISCOVERED AT THIS LOCATION MAY BE RELATED TO AN UNDERGROUND TANK. DESIGNATION IS INCOMPLETE.

LEGAL DESCRIPTION

TRACT 1, LANDS OF M-T INVESTMENT COMPANY, ALBUQUERQUE, NEW MEXICO, AS THE SAME IS SHOWN AND DESIGNATED ON THE PLAT FILED IN THE OFFICE OF THE COUNTY CLERK OF BERNALILLO COUNTY, NEW MEXICO ON JANUARY 08, 1991, PLAT BOOK 91C, PAGE 9, DOC. #1991001507. TOGETHER WITH TRACT A-1, SPRINGER-SPEECHLY PLAT, ALBUQUERQUE, NEW MEXICO, AS THE SAME IS SHOWN AND DESIGNATED ON THE PLAT FILED IN THE OFFICE OF THE COUNTY CLERK OF BERNALILLO COUNTY, NEW MEXICO ON NOVEMBER 24, 1981, PLAT BOOK B19, PAGE 86, DOC. #1981061763.


GENERAL NOTES

- 1. A BOUNDARY, TOPOGRAPHIC AND UTILITY SURVEY WAS PERFORMED IN DECEMBER, 2024. PROPERTY CORNERS WERE FOUND OR SET AS INDICATED.
- 2. SITE LOCATED WITHIN PROJECTED SECTION 9, TOWNSHIP 10 NORTH, RANGE 3 EAST, N.M.P.M. (TOWN OF ALBUQUERQUE GRANT).
- 3. ORTHOPHOTOGRAPHY WAS CAPTURED BY HIGH MESA UNMANNED AERIAL VEHICLE (UAV).
- 4. ALL DISTANCES ARE GROUND DISTANCES.
- 5. BEARINGS SHOWN HEREON ARE NEW MEXICO STATE PLANE GRID BEARINGS, CENTRAL ZONE (NAD 83). THESE BEARINGS ARE POSITIONED FROM AGRS CONTROL STATION "A-438".
- RECORD BEARINGS AND DISTANCES ARE SHOWN IN PARENTHESIS
- 7. THE FOLLOWING DOCUMENTS AND INSTRUMENTS (ALL FROM RECORDS OF BERNALILLO COUNTY, NEW MEXICO, UNLESS OTHERWISE NOTED) WERE USED FOR THE PERFORMANCE AND PREPARATION OF THIS SURVEY:
 - A. SPRINGER-SPEECHLY PLAT, FILED 11-24-1981, PLAT BOOK B19, PAGE 86, DOC. #1981061763.
 - B. PLAT OF TRACTS 1 AND 2, SUNSET MEMORIAL PARK, FILED 01-08-1991, PLAT BOOK 91C, PAGE 8, DOC. #1991001506.
 - C. PLAT OF TRACT 1, LANDS OF M-T INVESTMENT COMPANY, FILED 01-08-1991, PLAT BOOK 91C, PAGE 9, DOC. #1991001507.
 - D. RIGHT OF WAY, ACCESS CONTROL & MONUMENTATION MAP OF N.M.S.H.T.D., SPRINGER—SPEECHLY, FILED 08—06—2002, BOOK 2002C, PAGE 264, DOC. #2002098731.
 - E. BOUNDARY SURVEY PLAT FOR STATE OF NEW MEXICO GENERAL SERVICES DEPARTMENT, TRACT 1. LANDS OF M-T INVESTMENT COMPANY AND TRACT A-1. SPRINGER-SPEECHLY. FILED 09-10-2024, BOOK 2024S, PAGE 86, DOC. #2024063261.
 - F. SPECIAL WARRANTY DEED, EXECUTED 12-09-2002, TRACT 1, LANDS OF M-T INVESTMENT COMPANY.
 - G. SPECIAL WARRANTY DEED, EXECUTED 12-09-2002, TRACT A-1, SPRINGER-SPEECHLY.
 - H. WARRANTY DEED, FILED 08-01-1930, BOOK 114, PAGE 421.
 - I. SPECIAL WARRANTY DEED, FILED 03-30-1998, BOOK 9807, PAGE 5972, DOC. #1998037478.
 - J. SPECIAL WARRANTY DEED, FILED 03-30-1998, BOOK 9807, PAGE 5973, DOC. #1998037479.
 - K. SPECIAL WARRANTY DEED, FILED 03-30-1998, BOOK 9807, PAGE 5975, DOC. #1998037481.
 - L. SPECIAL WARRANTY DEED, FILED 03-30-1998, BOOK 9807, PAGE 5976, DOC. #1998037482.
 - M. SPECIAL WARRANTY DEED, FILED 03-30-1998, BOOK 9807, PAGE 5977, DOC. #1998037483. N. SPECIAL WARRANTY DEED, FILED 03-30-1998, BOOK 9807, PAGE 5978, DOC.
 - #1998037484. O. SPECIAL WARRANTY DEED, FILED 03-30-1998, BOOK 9807, PAGE 5979, DOC. #1998037485.
 - P. QUITCLAIM DEED, FILED 02-19-1999, BOOK 9903, PAGE 2542, DOC. #1999022604.
 - Q. SPECIAL WARRANTY DEED, FILED 03-30-1999, BOOK 9905, PAGE 2908, DOC. #1999043039.
 - R. WARRANTY DEED, FILED 03-30-1999, BOOK 9905, PAGE 2909, DOC. #1999043040.
 - S. WARRANTY DEED, FILED 05-14-1999, BOOK 9907, PAGE 4146, DOC. #1999064305.
 - T. SPECIAL WARRANTY DEED, FILED 12-13-2002, BOOK A46, PAGE 6388, DOC. #2002166824.
 - U. SPECIAL WARRANTY DEED, FILED 12-13-2002, BOOK A46, PAGE 6390, DOC. #2002166826.
 - V. SPECIAL WARRANTY DEED, FILED 09-30-2016, DOC. #2016093160. W. QUITCLAIM DEED, FILED 09-30-2019, DOC. #2016093161.
 - X. SPECIAL WARRANTY DEED, FILED 11-05-2021, DOC. #2021131112.


 - Y. QUITCLAIM DEED, FILED 11-25-2024, DOC. #2024084667.
 - Z. VACATION ORDINANCE #V-78-4, FILED 02-16-1978.
 - AA. PNM AND MST&T EASEMENT GRANTED BY DOCUMENT FILED 12-22-1986, BOOK MISC. 432A, PAGE 995, DOC. #1986126348.
 - AB. UNDERGROUND PNM AND MST&T EASEMENT GRANTED BY DOCUMENT FILED 04-26-2000, BOOK A4, PAGE 9800, DOC. #2000039968. AC. PNM EASEMENT GRANTED BY DOCUMENT FILED 04-15-2003, BOOK A54, PAGE 1196, DOC.
 - #2003061320. AD. WAVER AND RELEASE OF PNM EASEMENT GRANTED BY DOCUMENT FILED 04-15-2003,
 - BOOK A54, PAGE 1200, DOC. #2003061324. AE. RETAINING WALL EASEMENT GRANTED BY DOCUMENT FILED 08-13-2003, BOOK A62, PAGE
 - 2550, DOC. #2003142855. AF. TITLE SEARCH AND REPORT PREPARED BY OLD REPUBLIC NATIONAL TITLE INSURANCE
- COMPANY DATED 09-16-2014, FILE NO. 1406129. (TRACT 1, SUNSET MEMORIAL PARK). THE PROPERTY SURVEYED HEREON MAY BE SUBJECT TO THE RESERVATIONS CONTAINED IN THE
- ORIGINAL PATENT FROM THE UNITED STATES OF AMERICA. 9. THE PROPERTY SURVEYED HEREON MAY BE SUBJECT TO VACATION ORDINANCE #V-78-4, FILED 02 - 16 - 1978.

12-2024



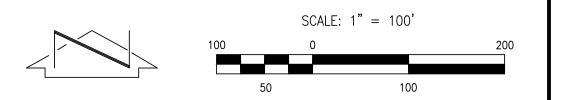

BOUNDARY, TOPOGRAPHIC AND UTILITY SURVEY COVER SHEET

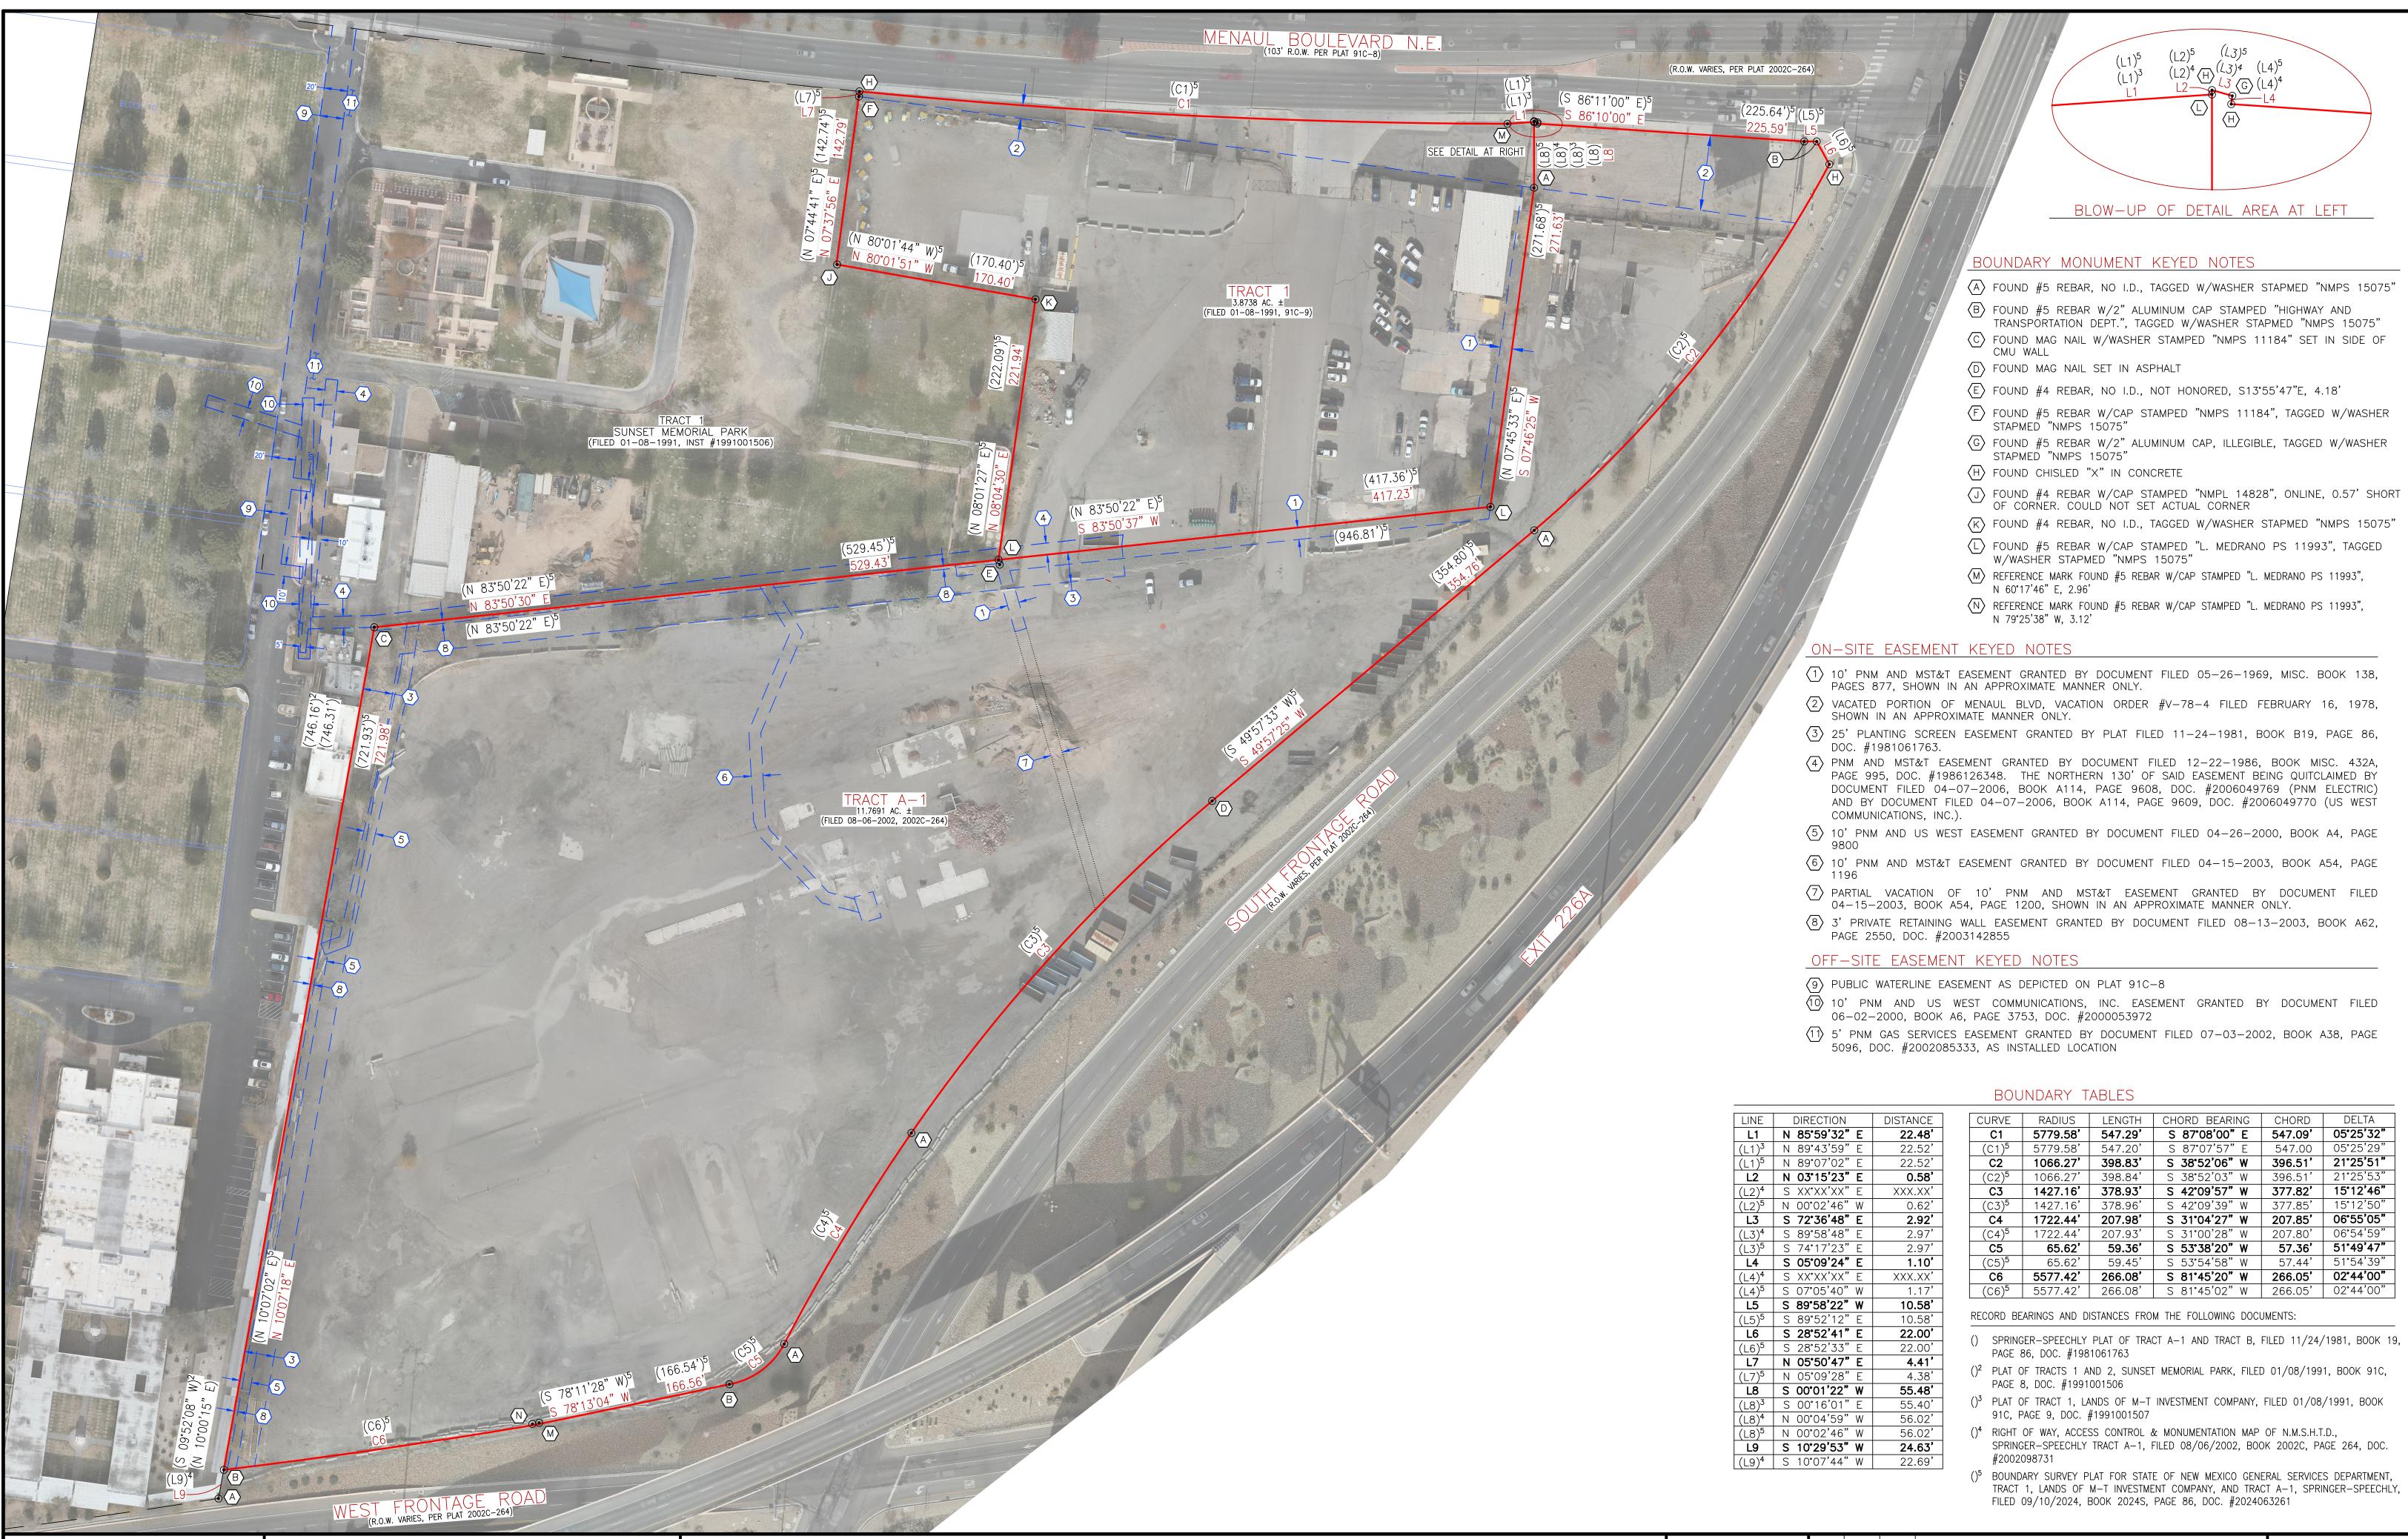

BOUNDARY SURVEY
TRACT 1 AND TRACT 1-A, VULCAN SITE
ALBUQUERQUE, NM

	NO.	DATE	BY	REVISIONS	JOB NO.			
VEYED BY M.V.Z.						46027	′3–(<u> </u>
F 10					DATE	12-20	721	
WN BY <u>E.J.S.</u>						12-20	JZ4	
ROVED BY J.M.S.					SHEET	γ	OF	1
						_		4

