
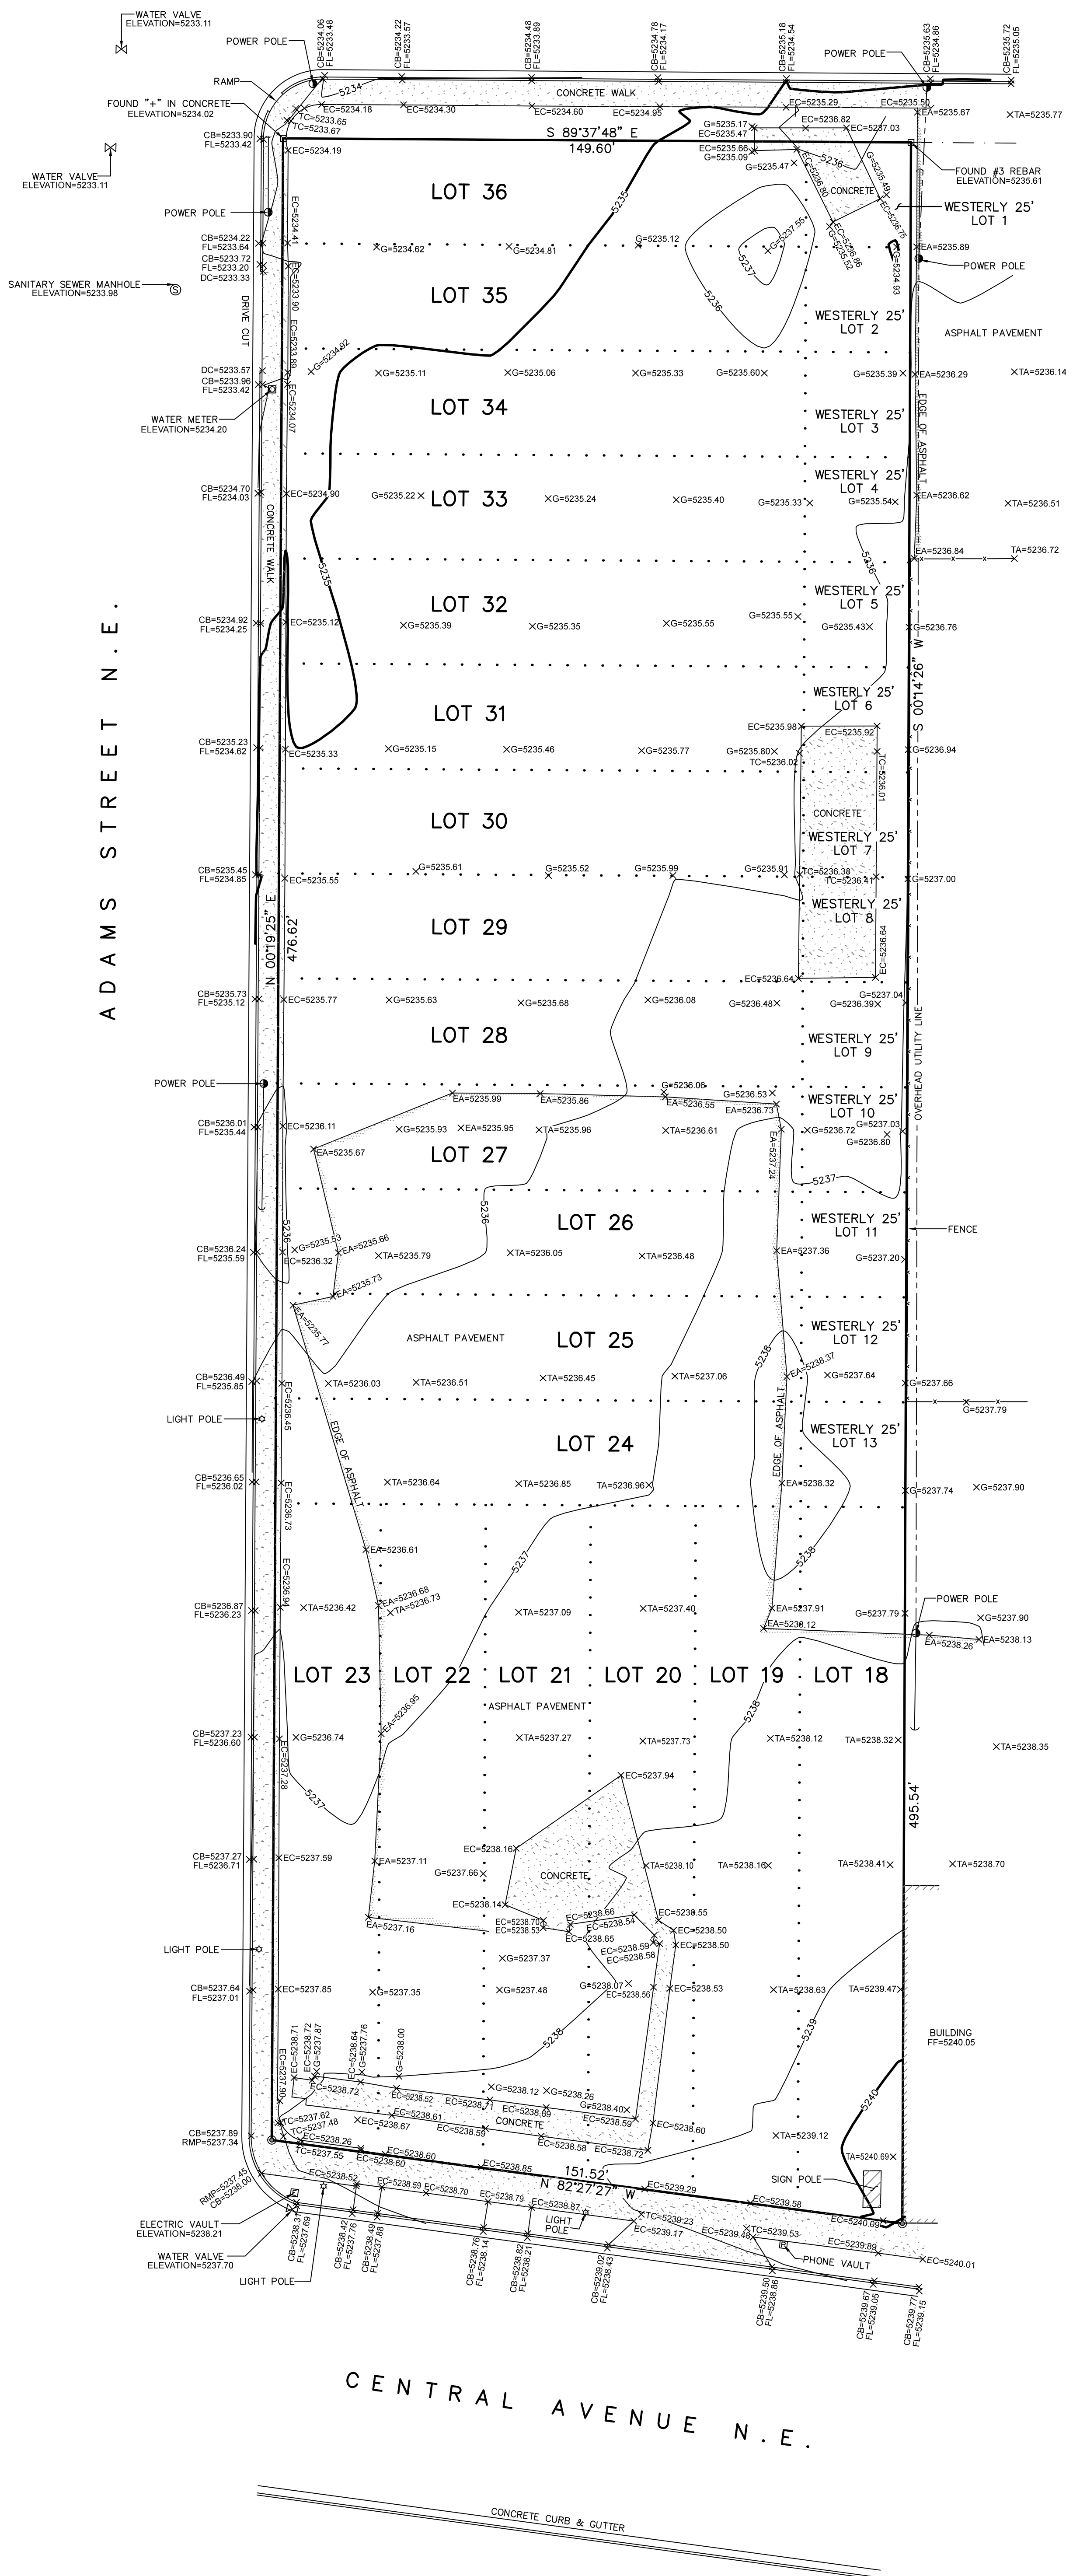


C O P P E R A V E N U E N . E .

- 1: CONTOUR INTERVAL IS ONE (1) FOOT.
- 2: ELEVATIONS ARE BASED ON CITY OF ALBUQUERQUE STATION No. "6-K18A", HAVING AN ELEVATION OF 5249.996, NAVD 1988.
- 3: UTILITIES SHOWN HEREON ARE IN THE APPROXIMATE LOCATION BASED ONLY ON ABOVE GROUND EVIDENCE FOUND IN THE FIELD AND AS-BUILT INFORMATION PROVIDED BY THE CLIENT. UTILITIES SHOWN HEREON, WHETHER INDICATED AS ABANDONED OR NOT, SHALL BE VERIFIED BY OTHERS FOR EXACT LOCATION AND/OR DEPTH PRIOR TO EXCAVATION OR DESIGN CONSIDERATIONS.
- 4: THIS IS **NOT** A BOUNDARY SURVEY. APPARENT PROPERTY CORNERS AND PROPERTY LINES ARE SHOWN FOR INFORMATION ONLY. BOUNDARY DATA SHOWN IS FROM PREVIOUS SURVEY REFERENCE HEREON.

LEGEND
CB = CURB
DC = DRIVE CUT
EC = EDGE OF CONCRETE
FL = FLOWLINE
G = GROUND
TA = TOP OF ASPHALT
TC = TOP OF CONCRETE

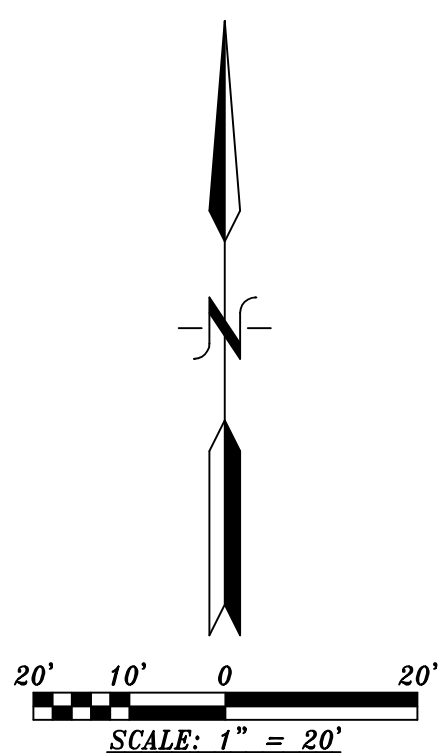

Anthony L. Harris, N.M.P.S.#11463 HARRIS SURVEYING, INC.
1308 Cielo Vista Del Sur, NW • Corrales, New Mexico 87048
Telephone (505) 250-2273 •