


KATHRYN INLET STRUCTURE




KATHRYN OUTLET STRUCTURE

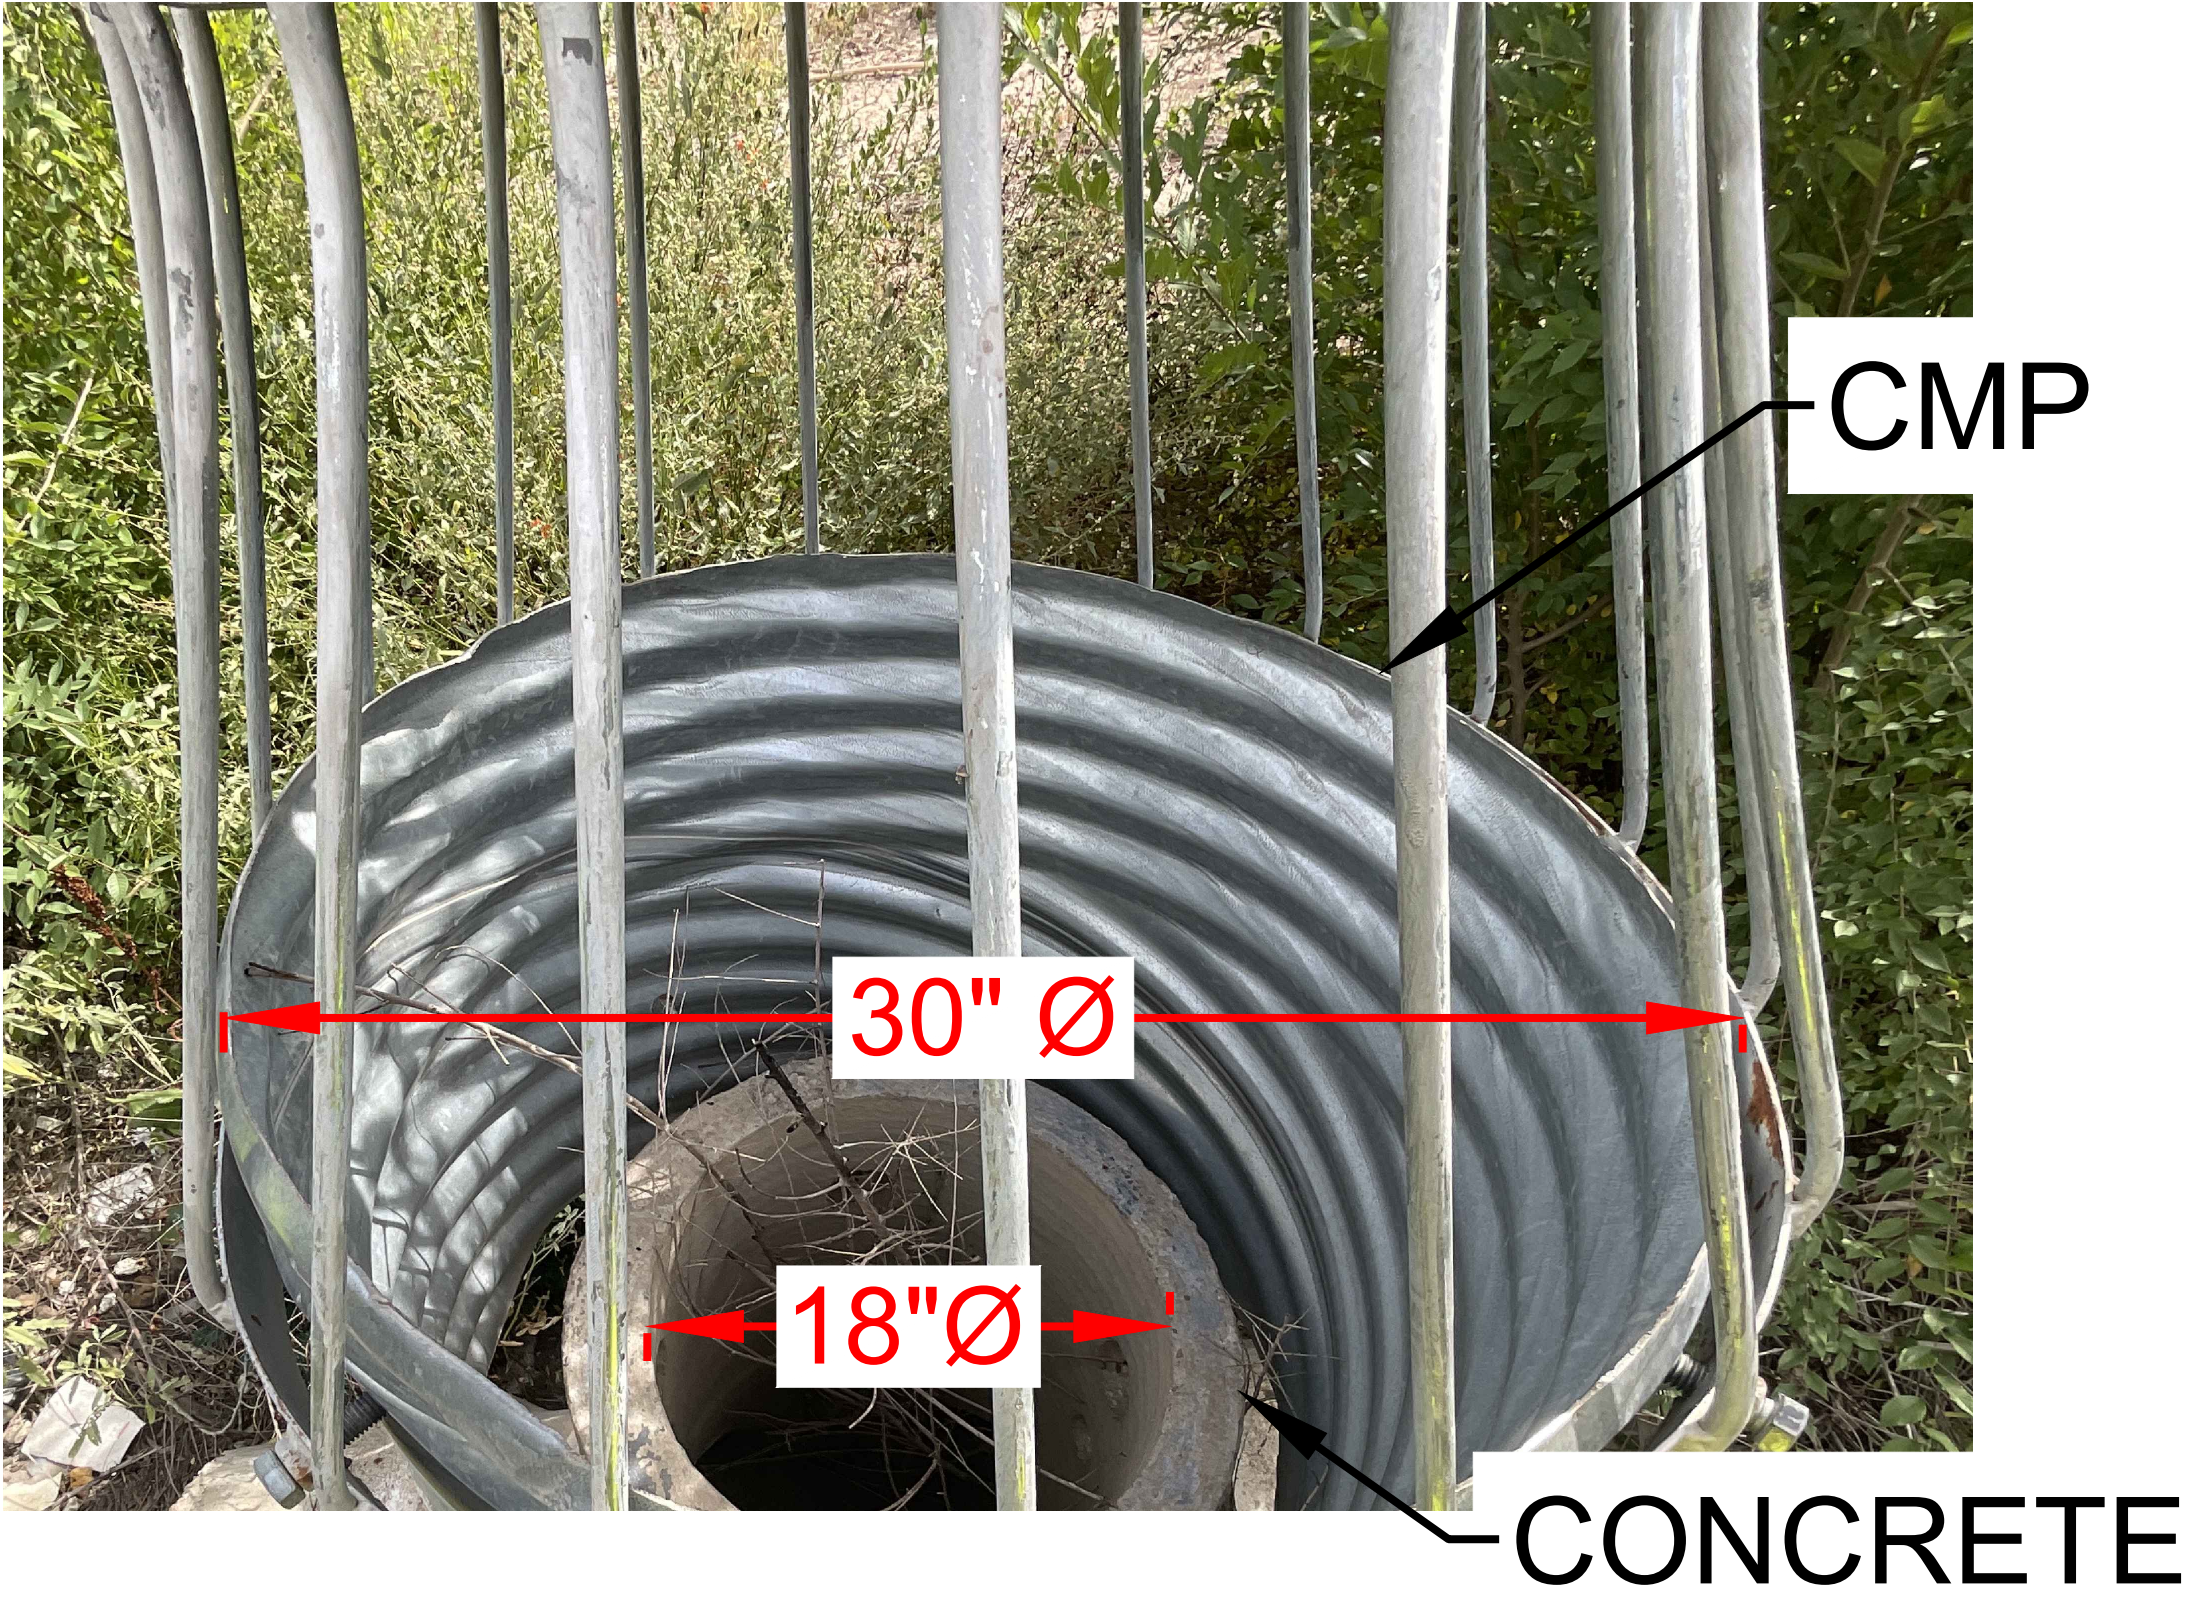

NTS

Kathryn

Inlet Structure

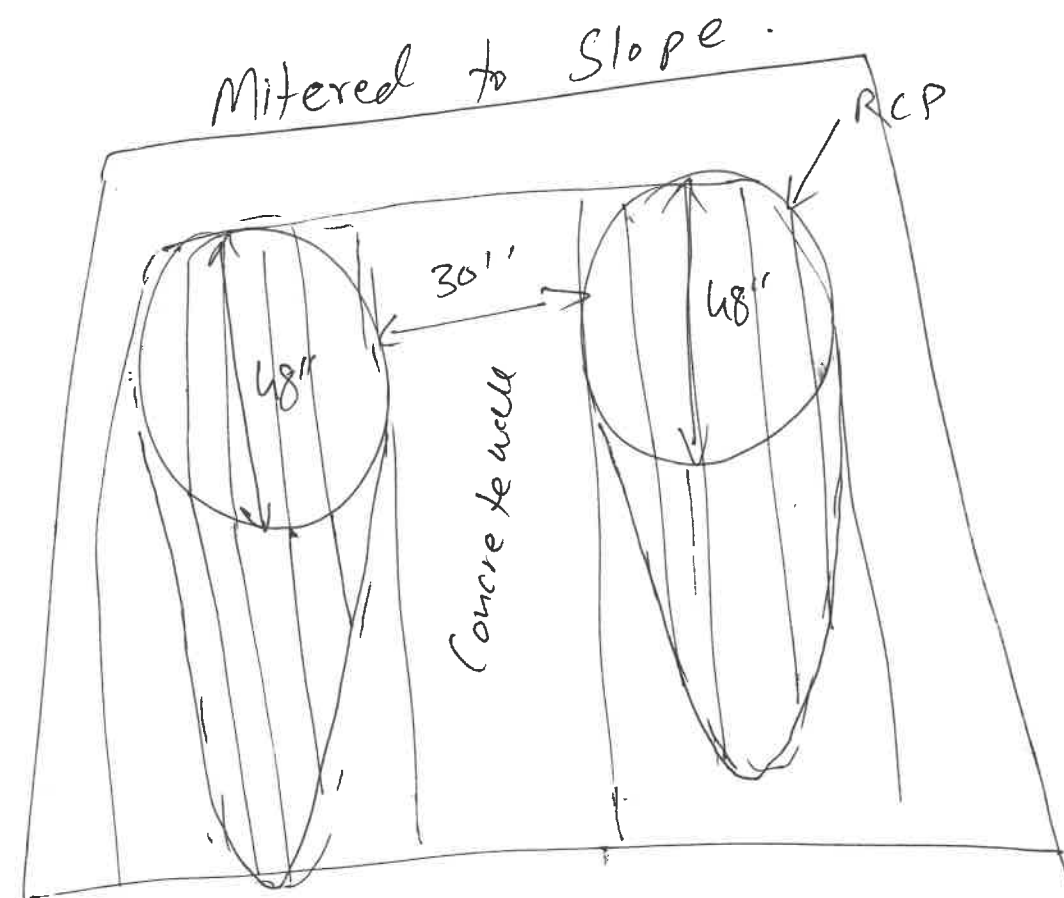

Outlet Structure

