


MECHEM INLET STRUCTURE



NTS



MECHEM OUTLET STRUCTURE

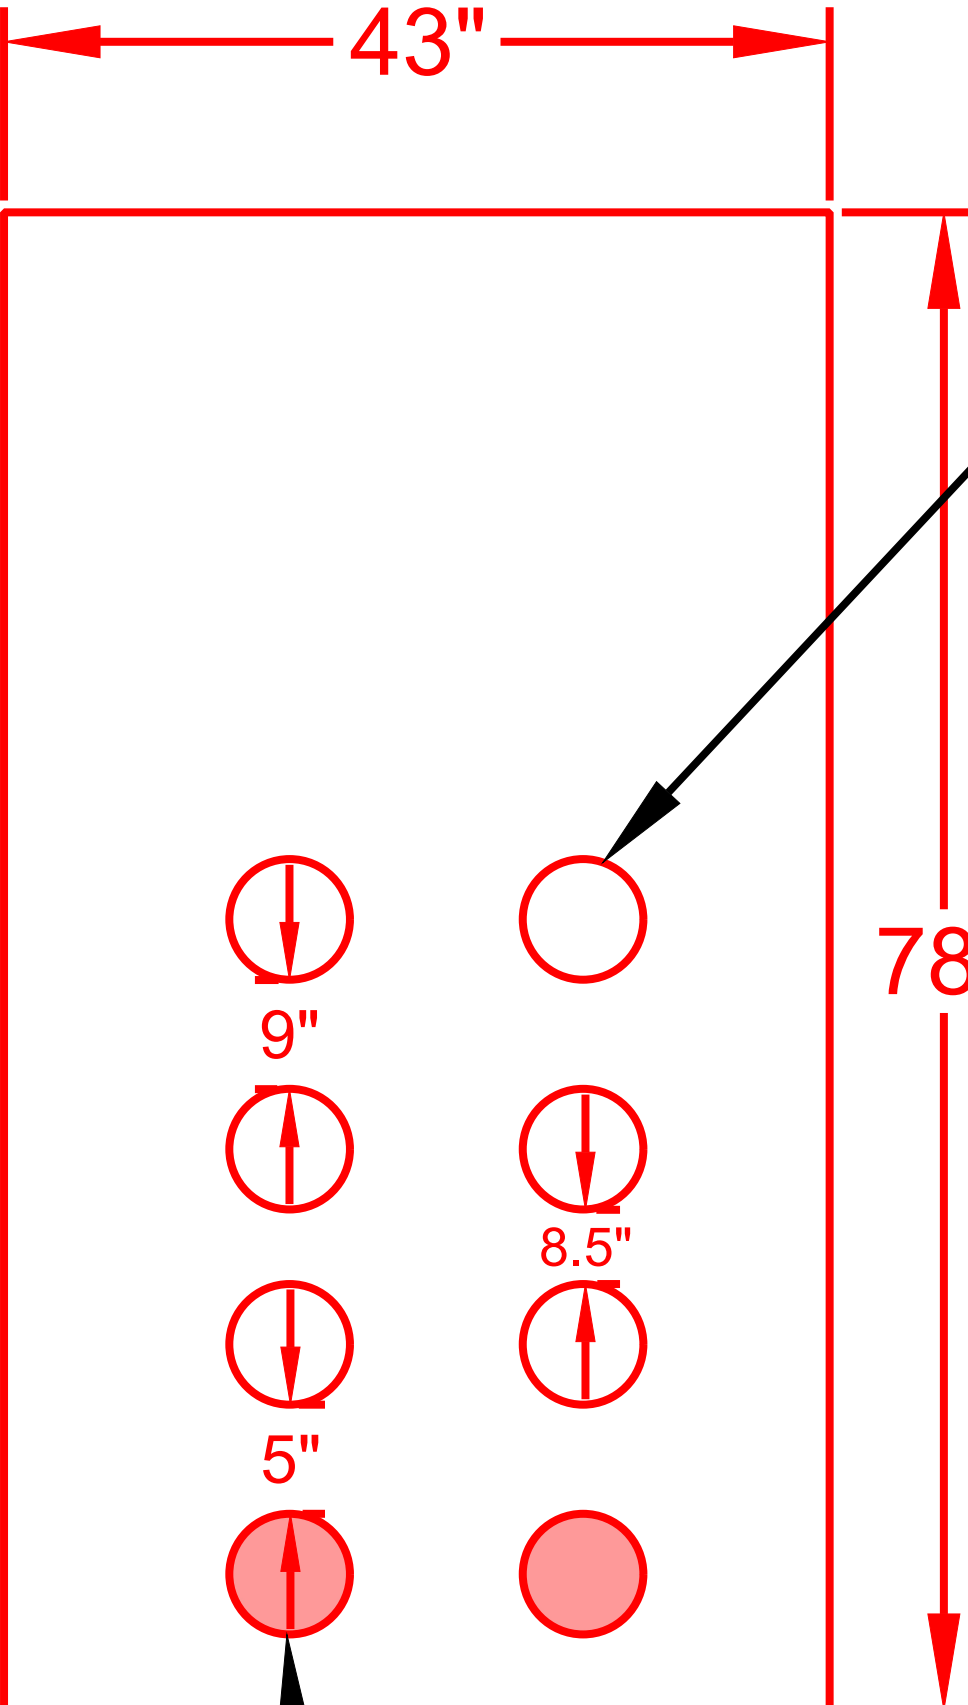

8-6" Ø PORTS

GRATE




WEST SIDE:
CLOGGED
FIRST ROW

24-6" Ø PORTS

CLOGGED FIRST ROW


8-6" Ø PORTS

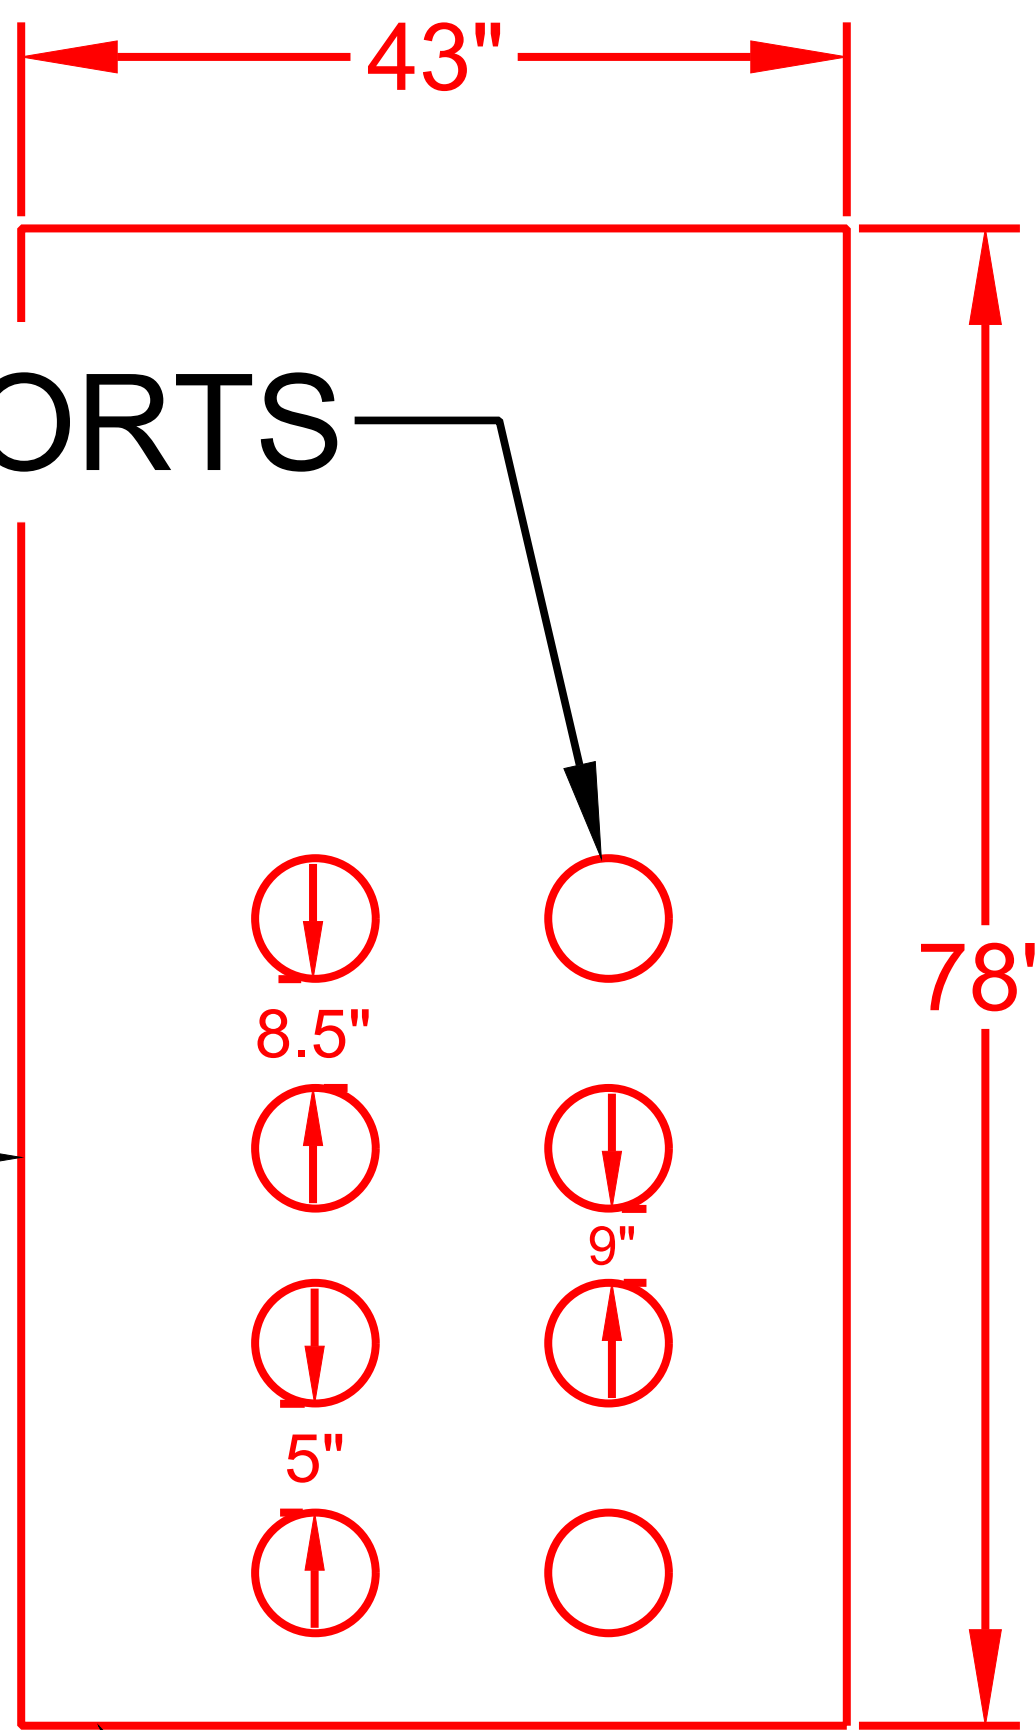


EAST SIDE
(NOT
CLOGGED)

NTS

TOPVIEW - MECHEM OUTLET STRUCTURE

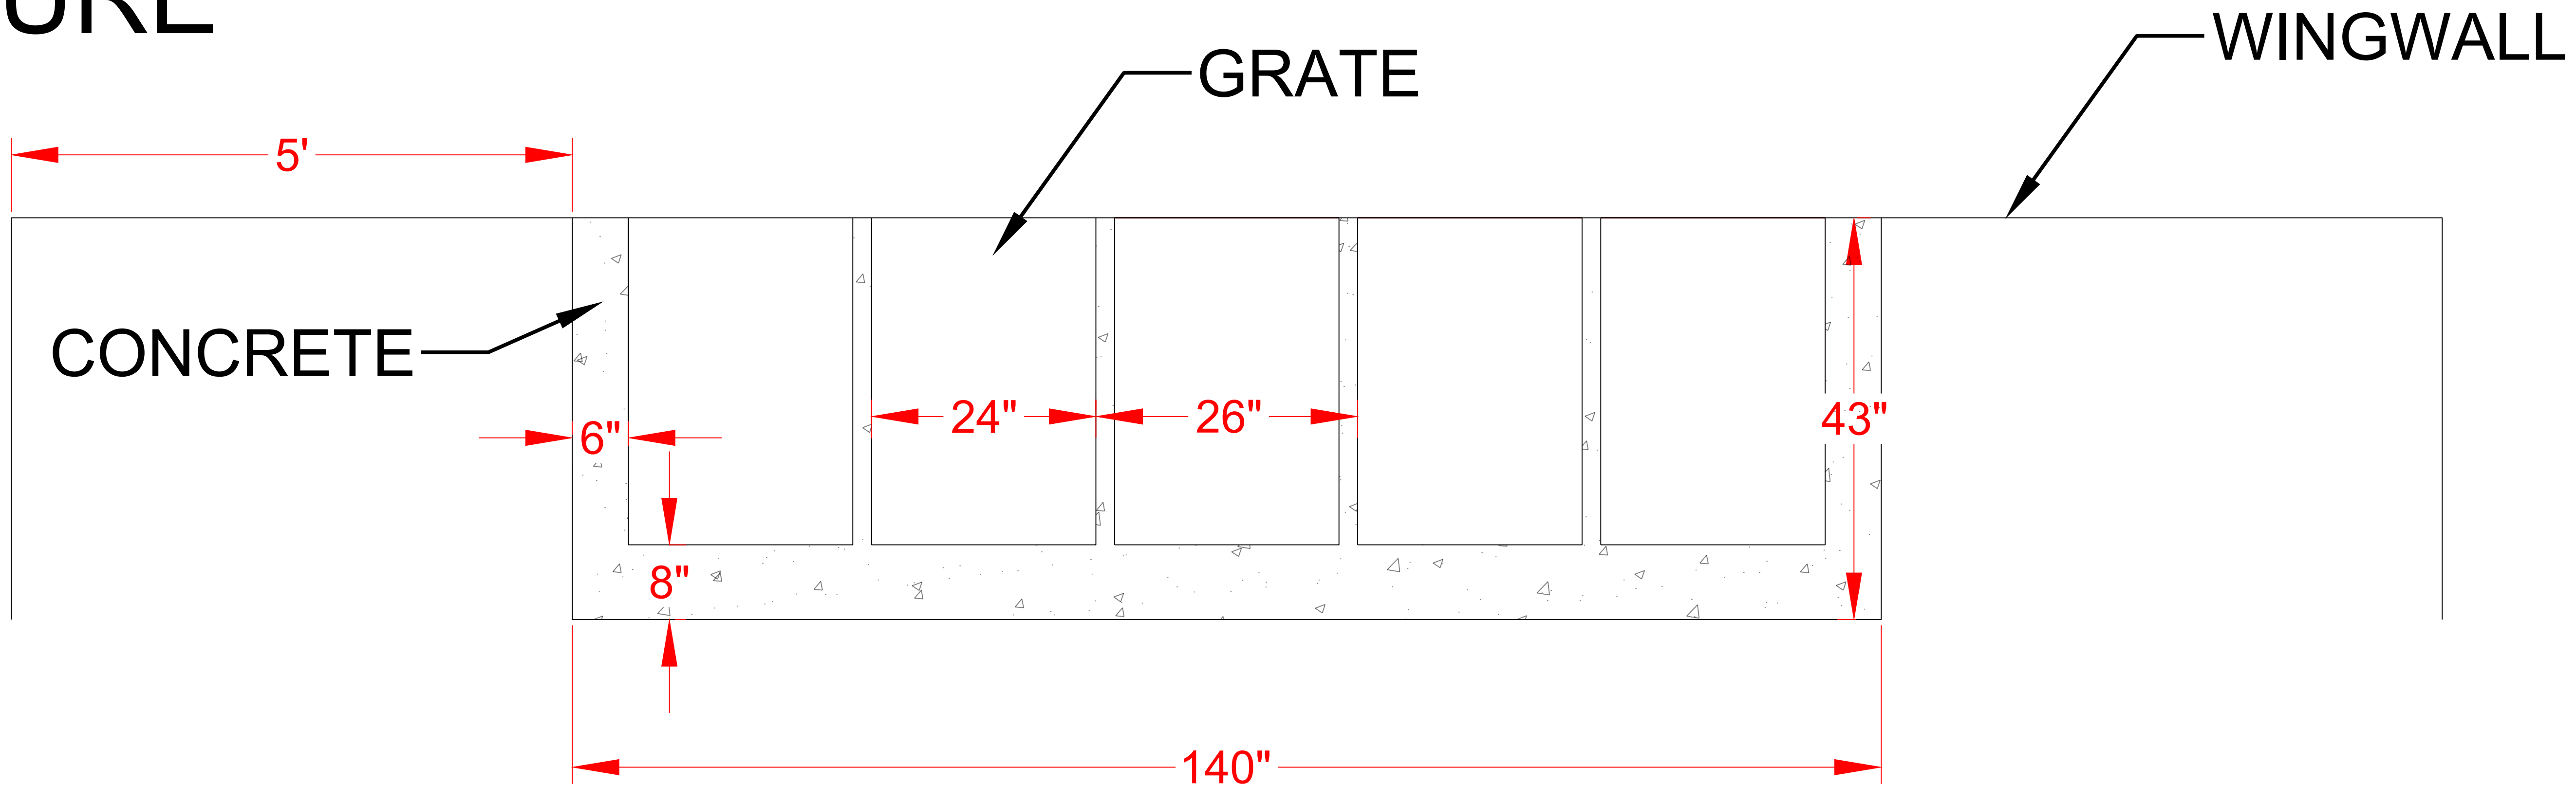



NTS

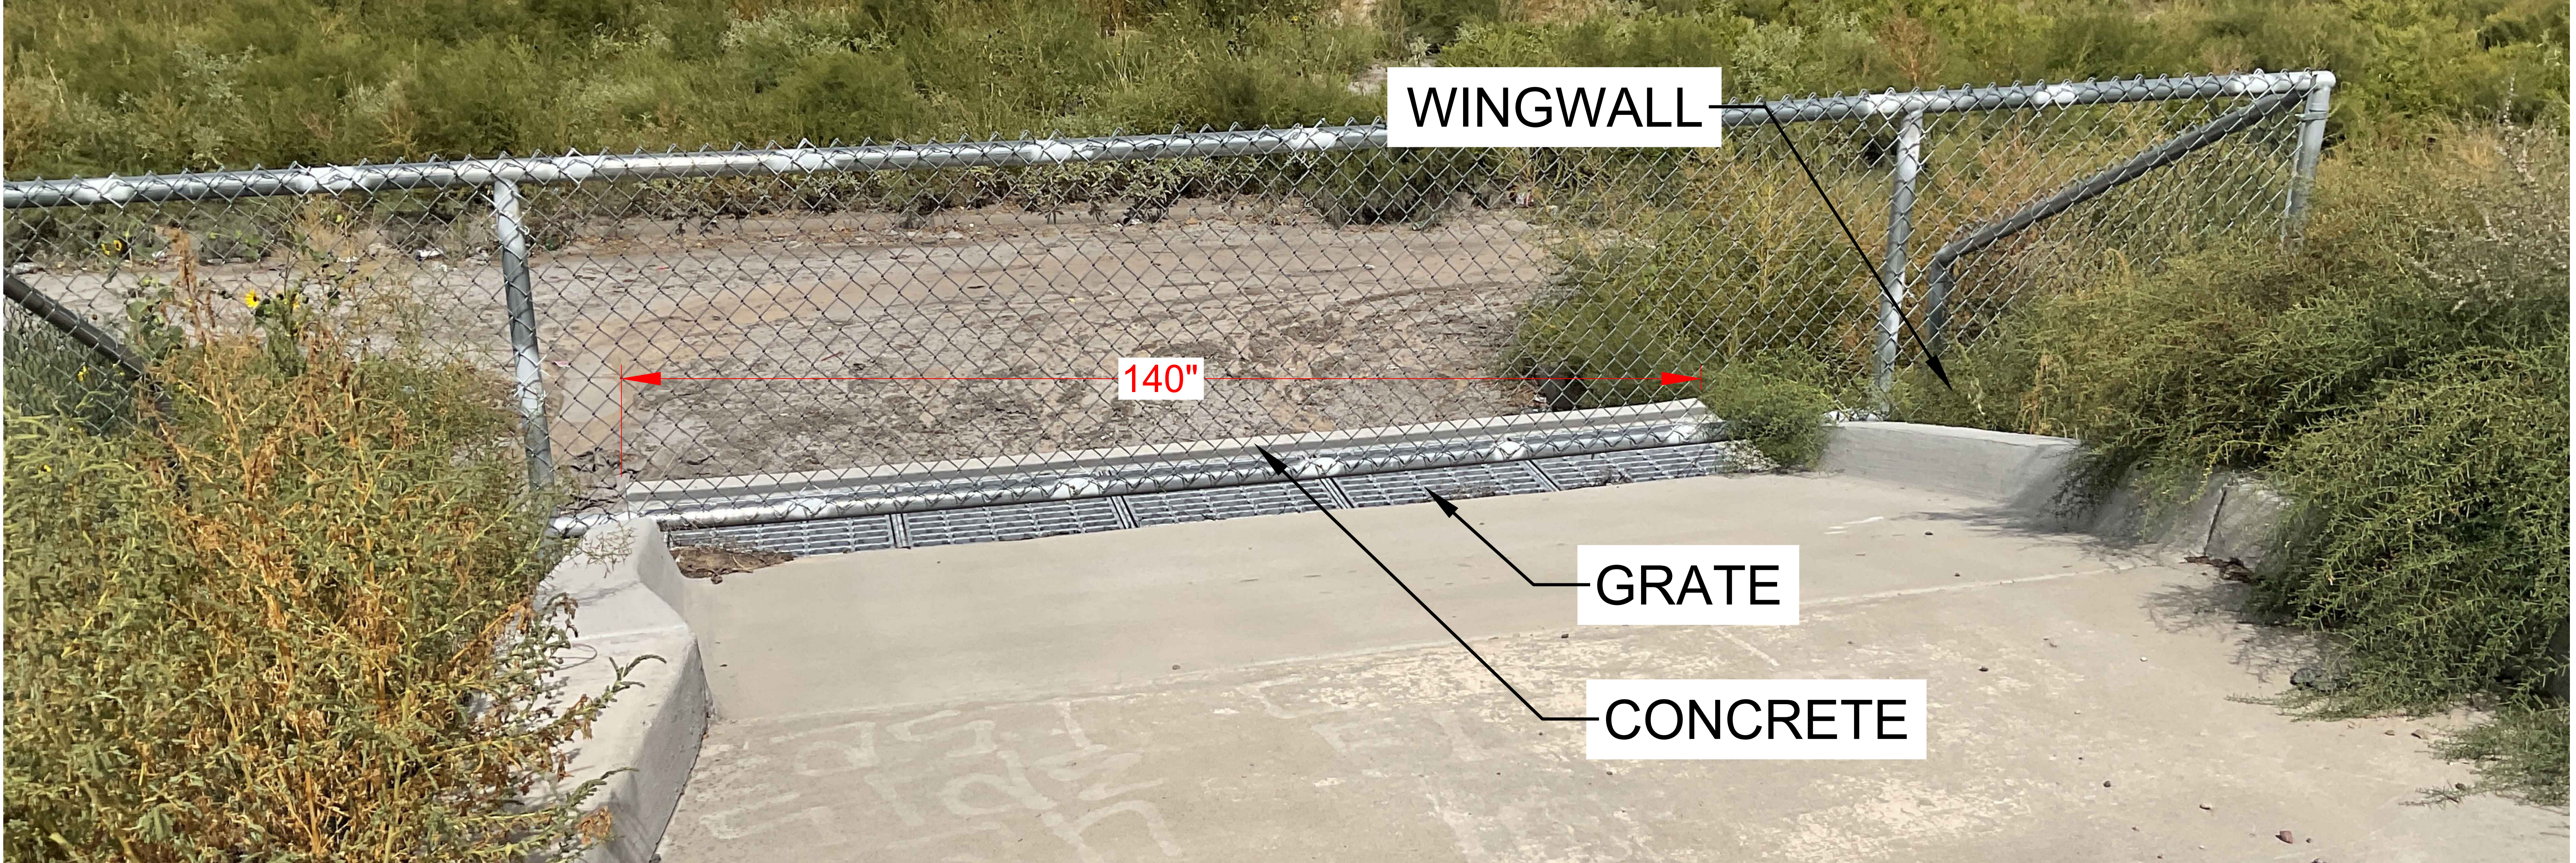

MECHEM POND

U+2205

PIPE
behind = 6' (72")

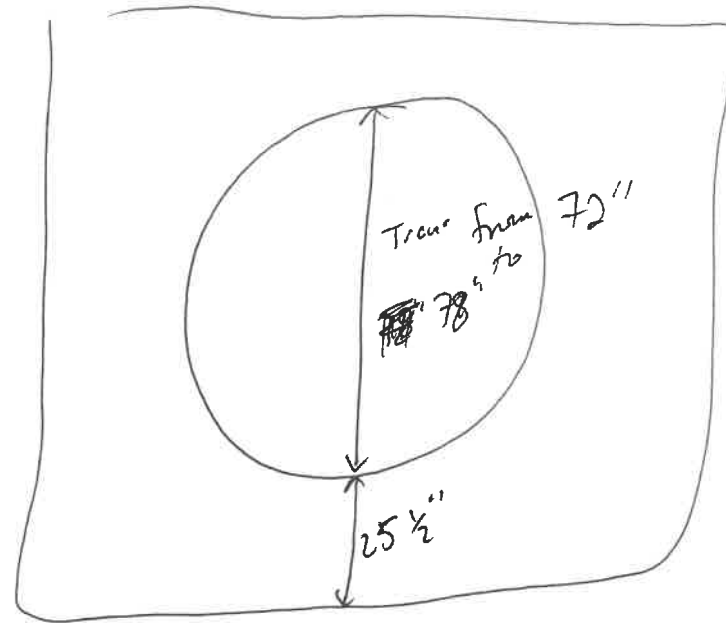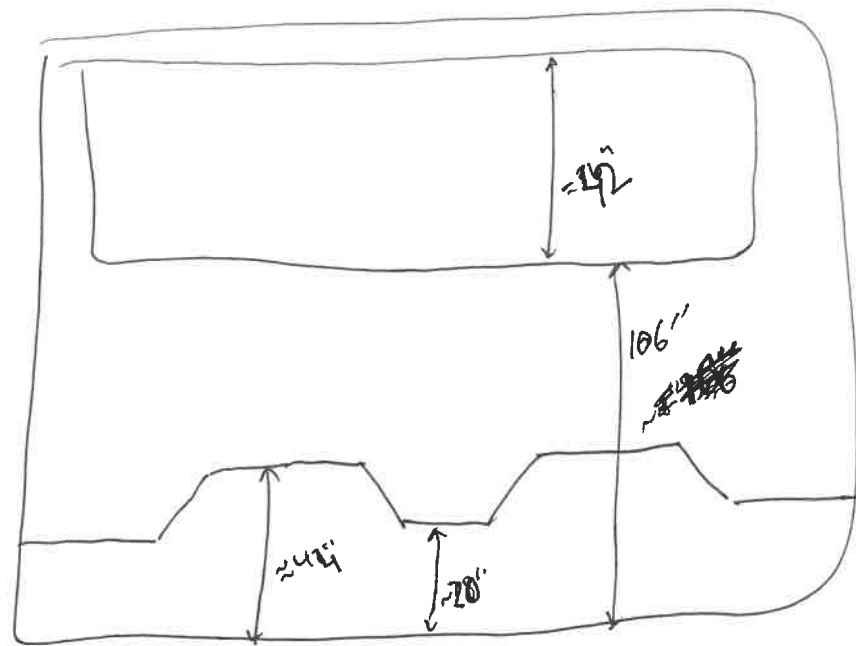


Top View

Outlet Structure

Fence


Wing wall

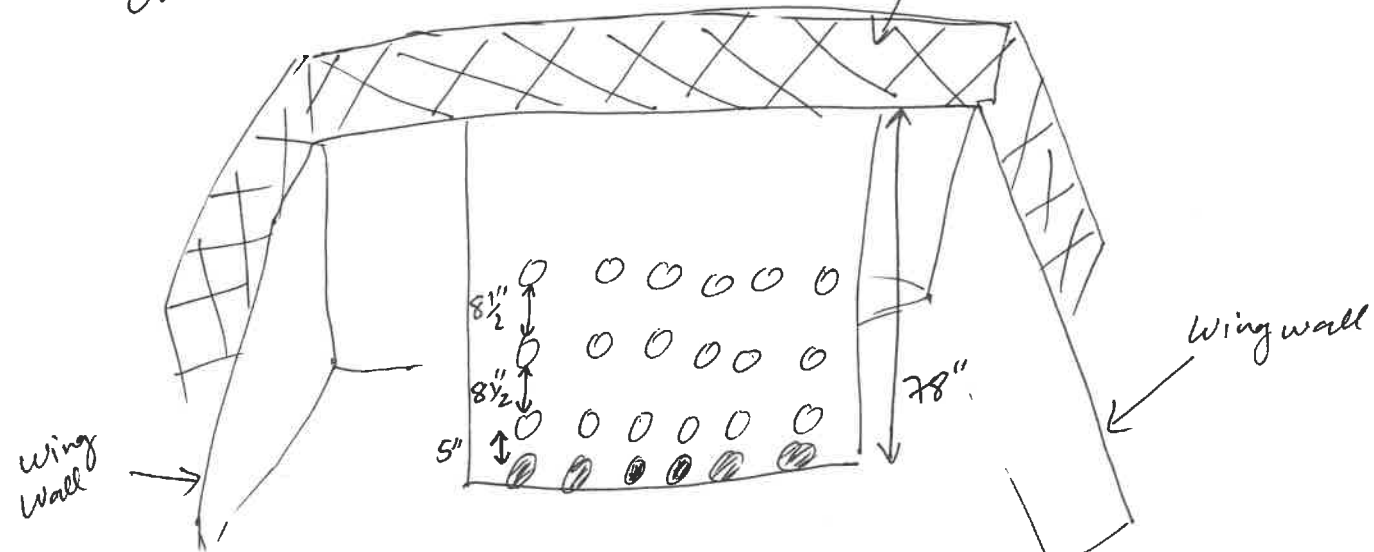


First row closed

8 ports on Side Ports
West side

East side

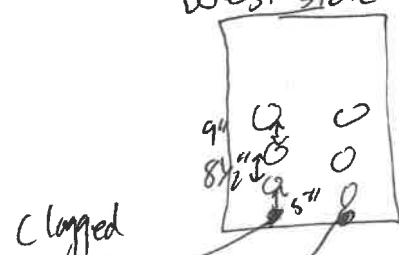

closed

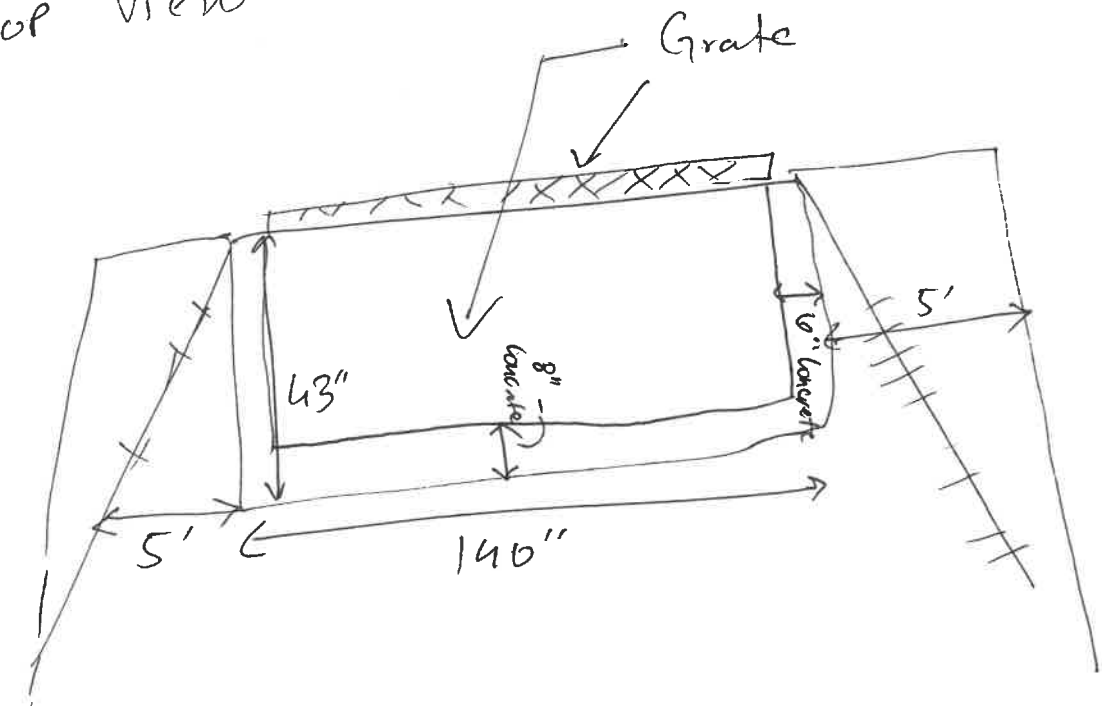

Grate Detail

