

1ST CROSSING BETHEL & SAN JOSE



ABAJO PENETRATION



NTS

JOHN'S STREET PENETRATION




BROKEN FLAP GATE

36"Ø

NTS


DESCANSO STREET

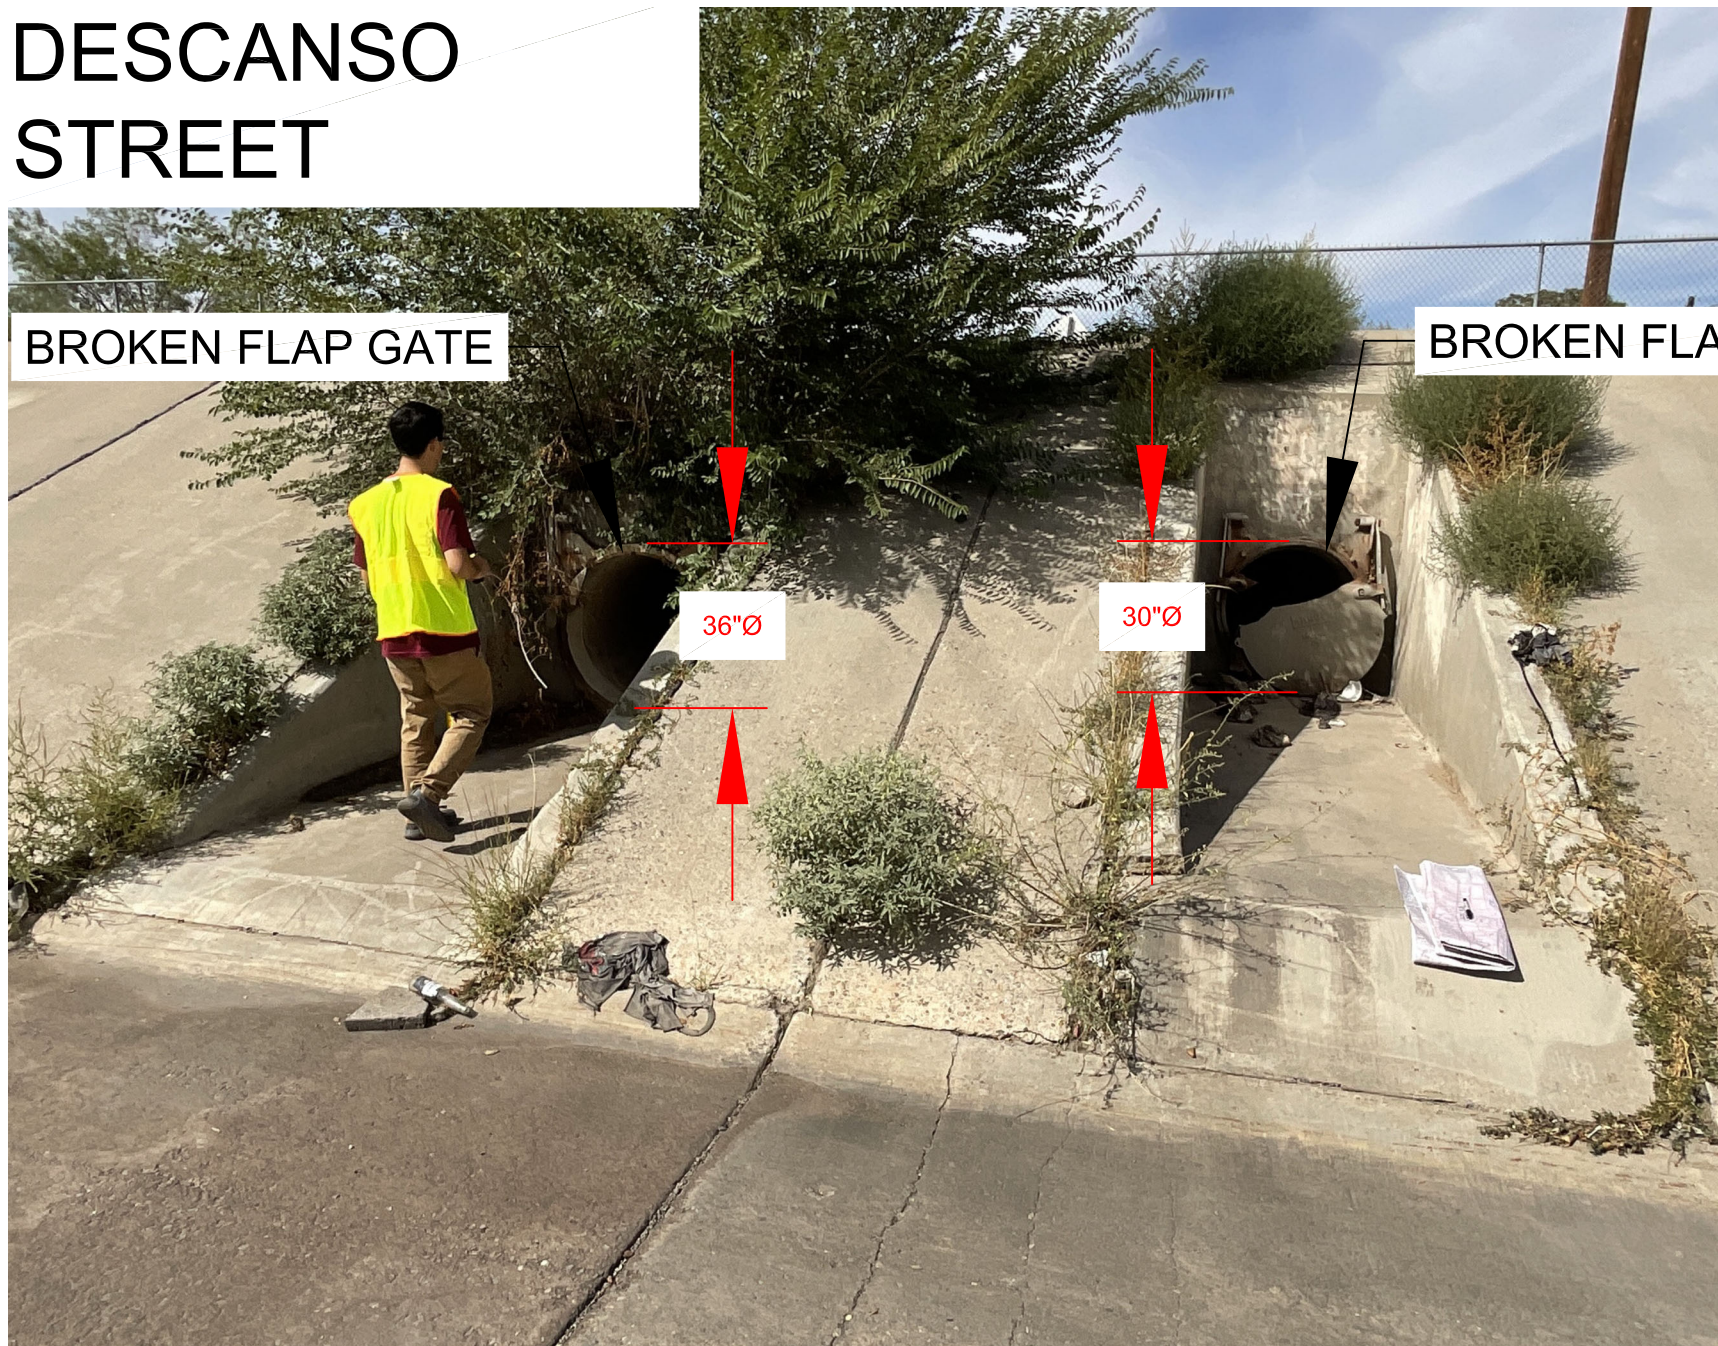


NTS

2ND CROSSING @ WESMECO


14' STEEL PENETRATION

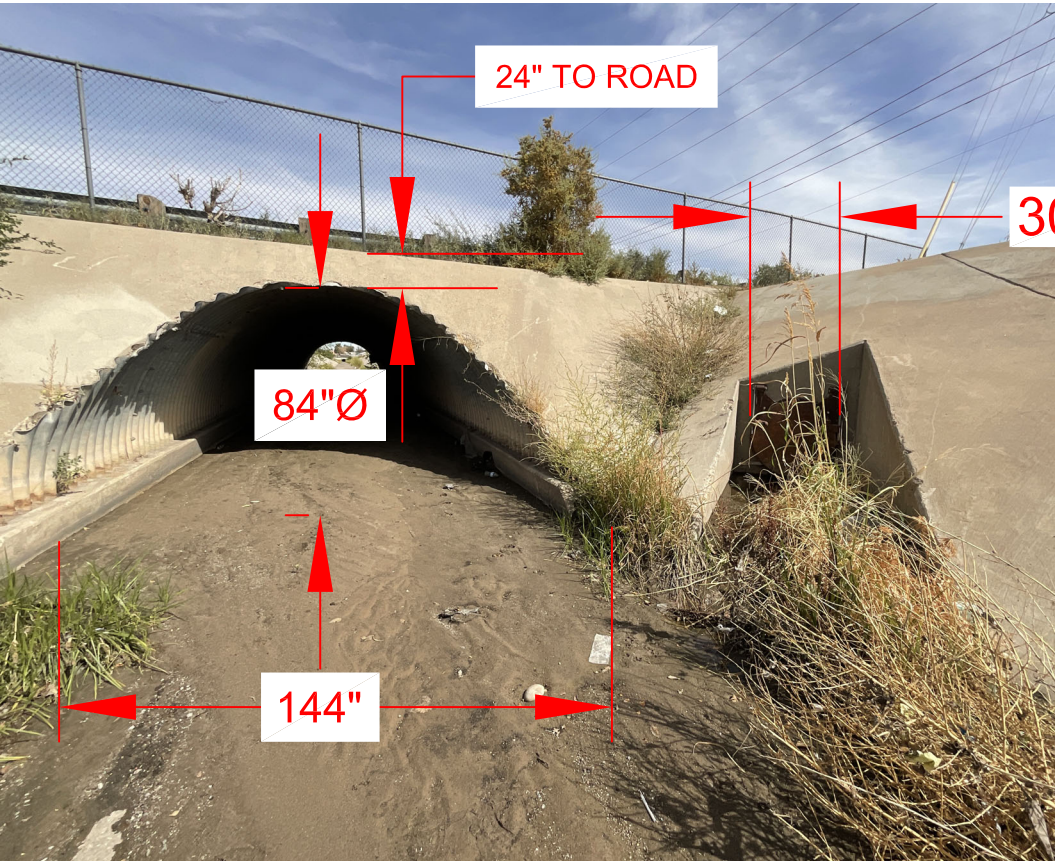


PENETRATION MIDWAY 2ND TO 3RD

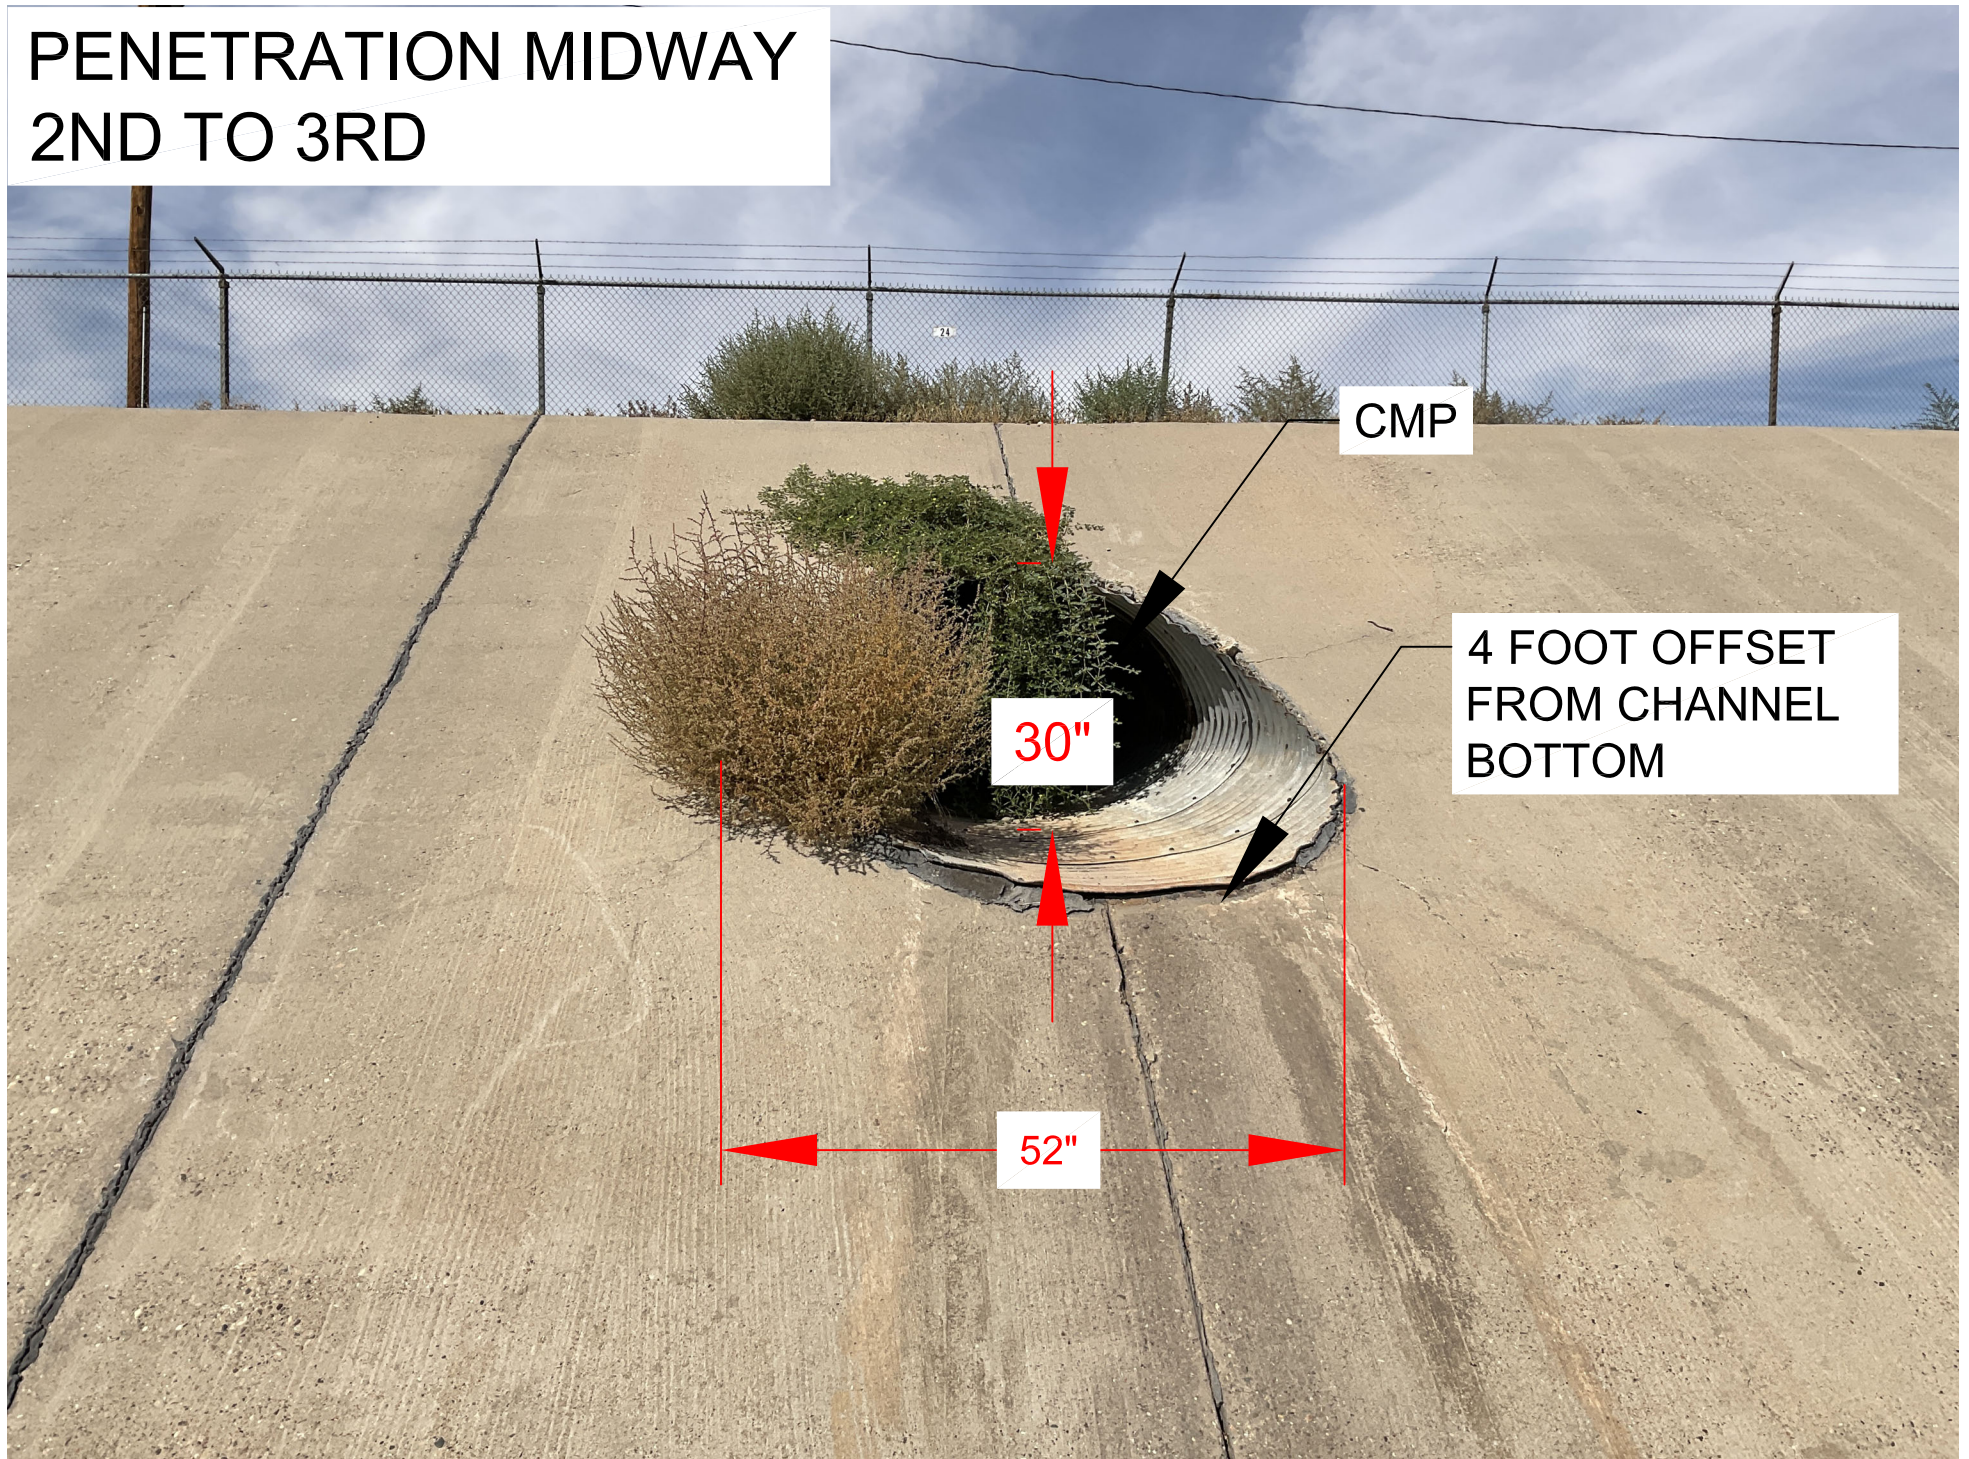


WOODWARD CROSSING

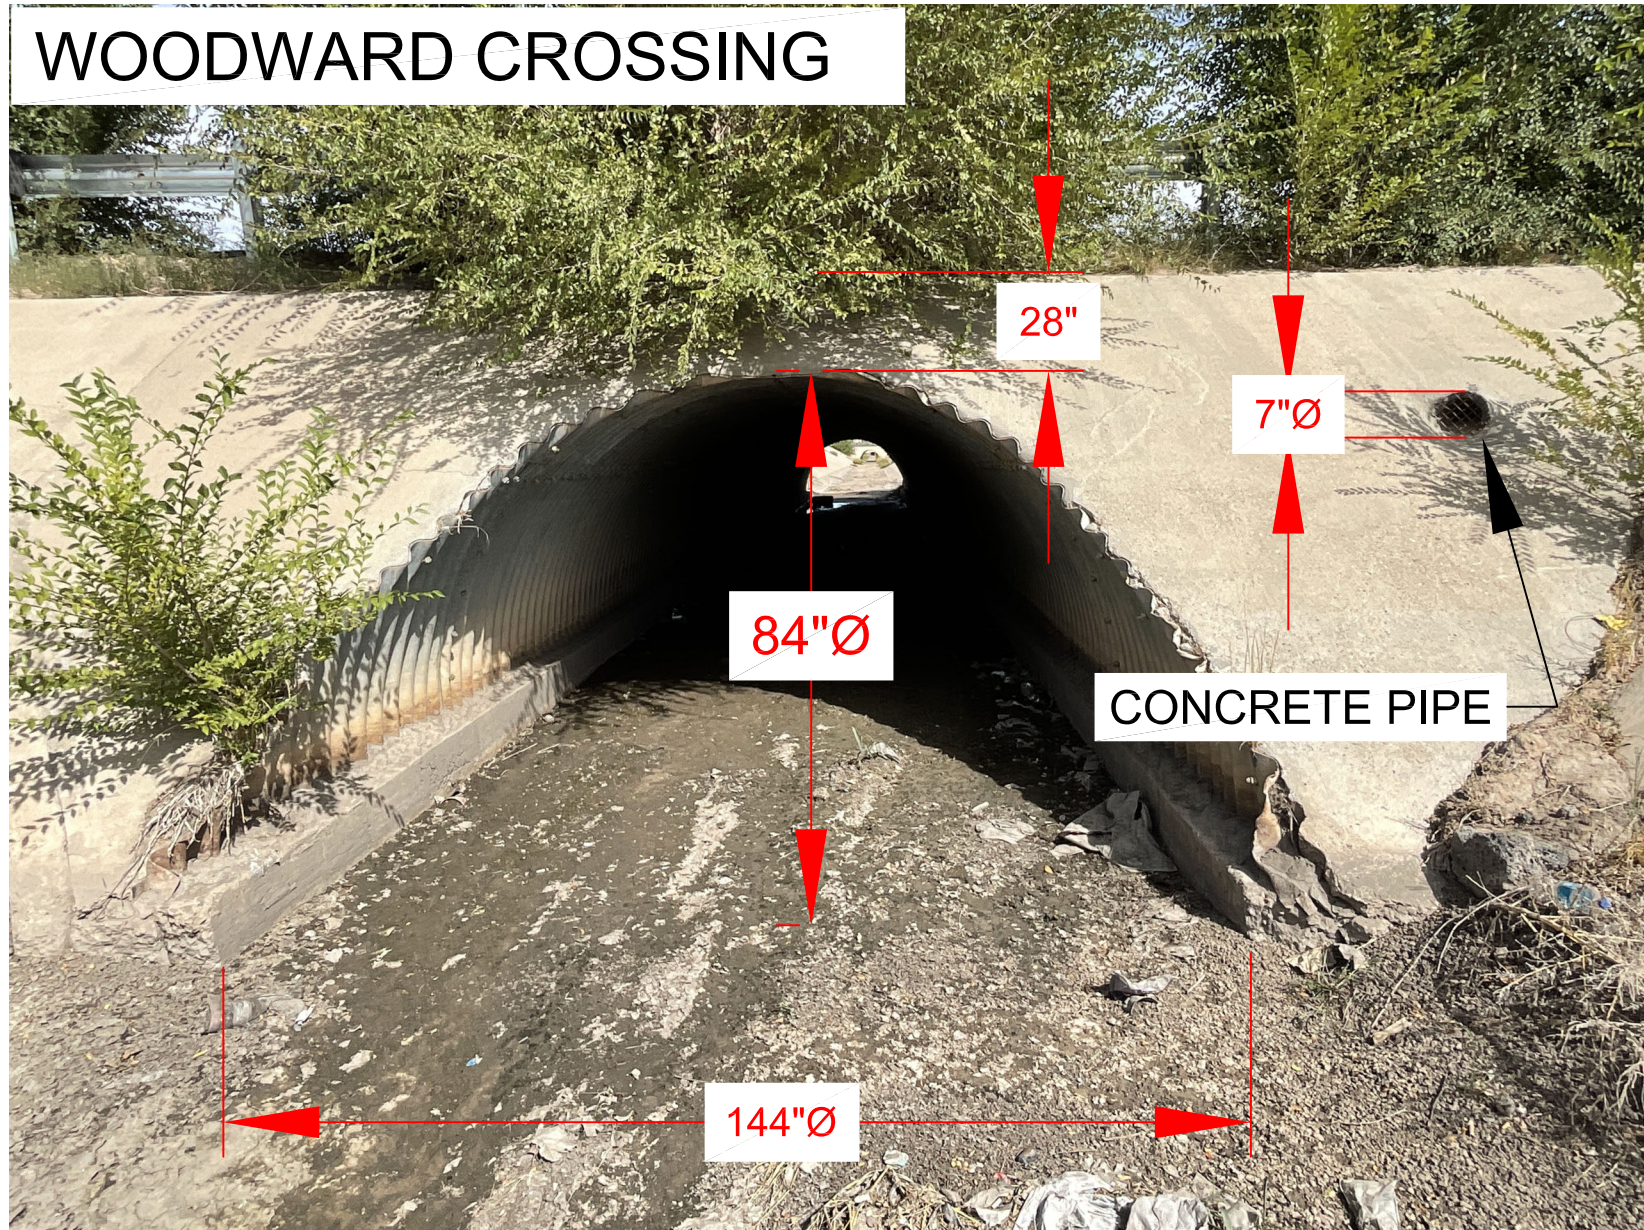

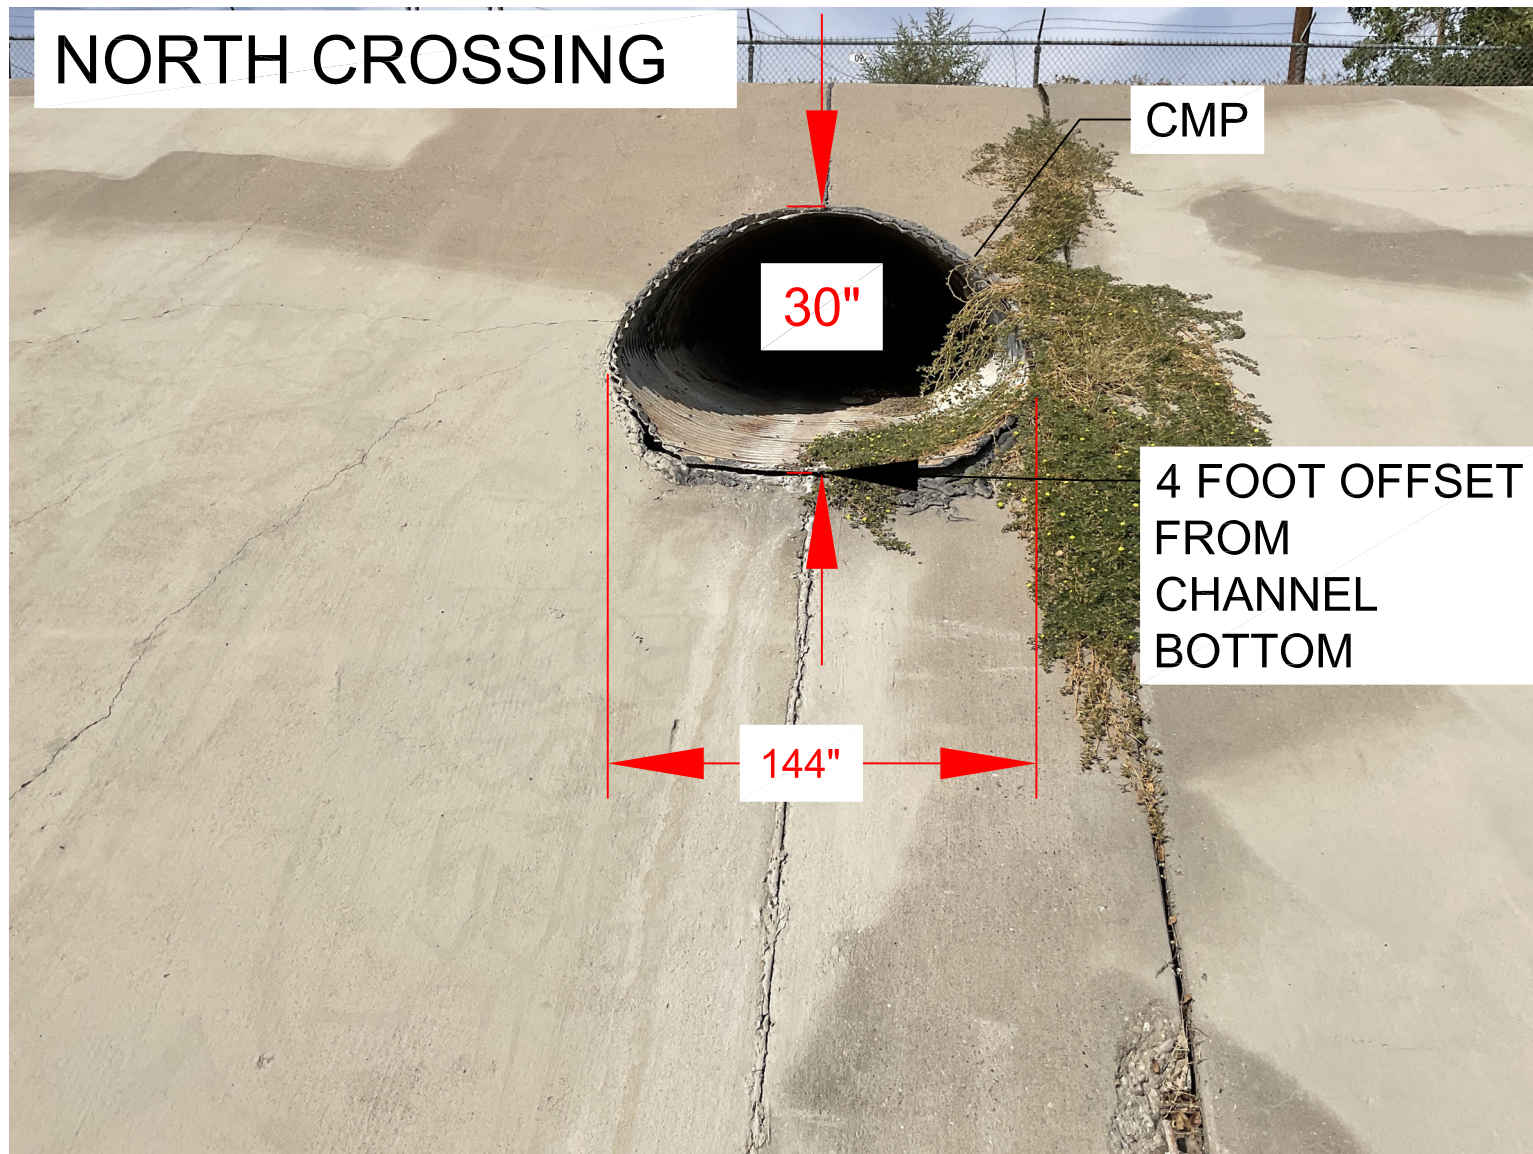


NTS


RAILROAD CROSSING

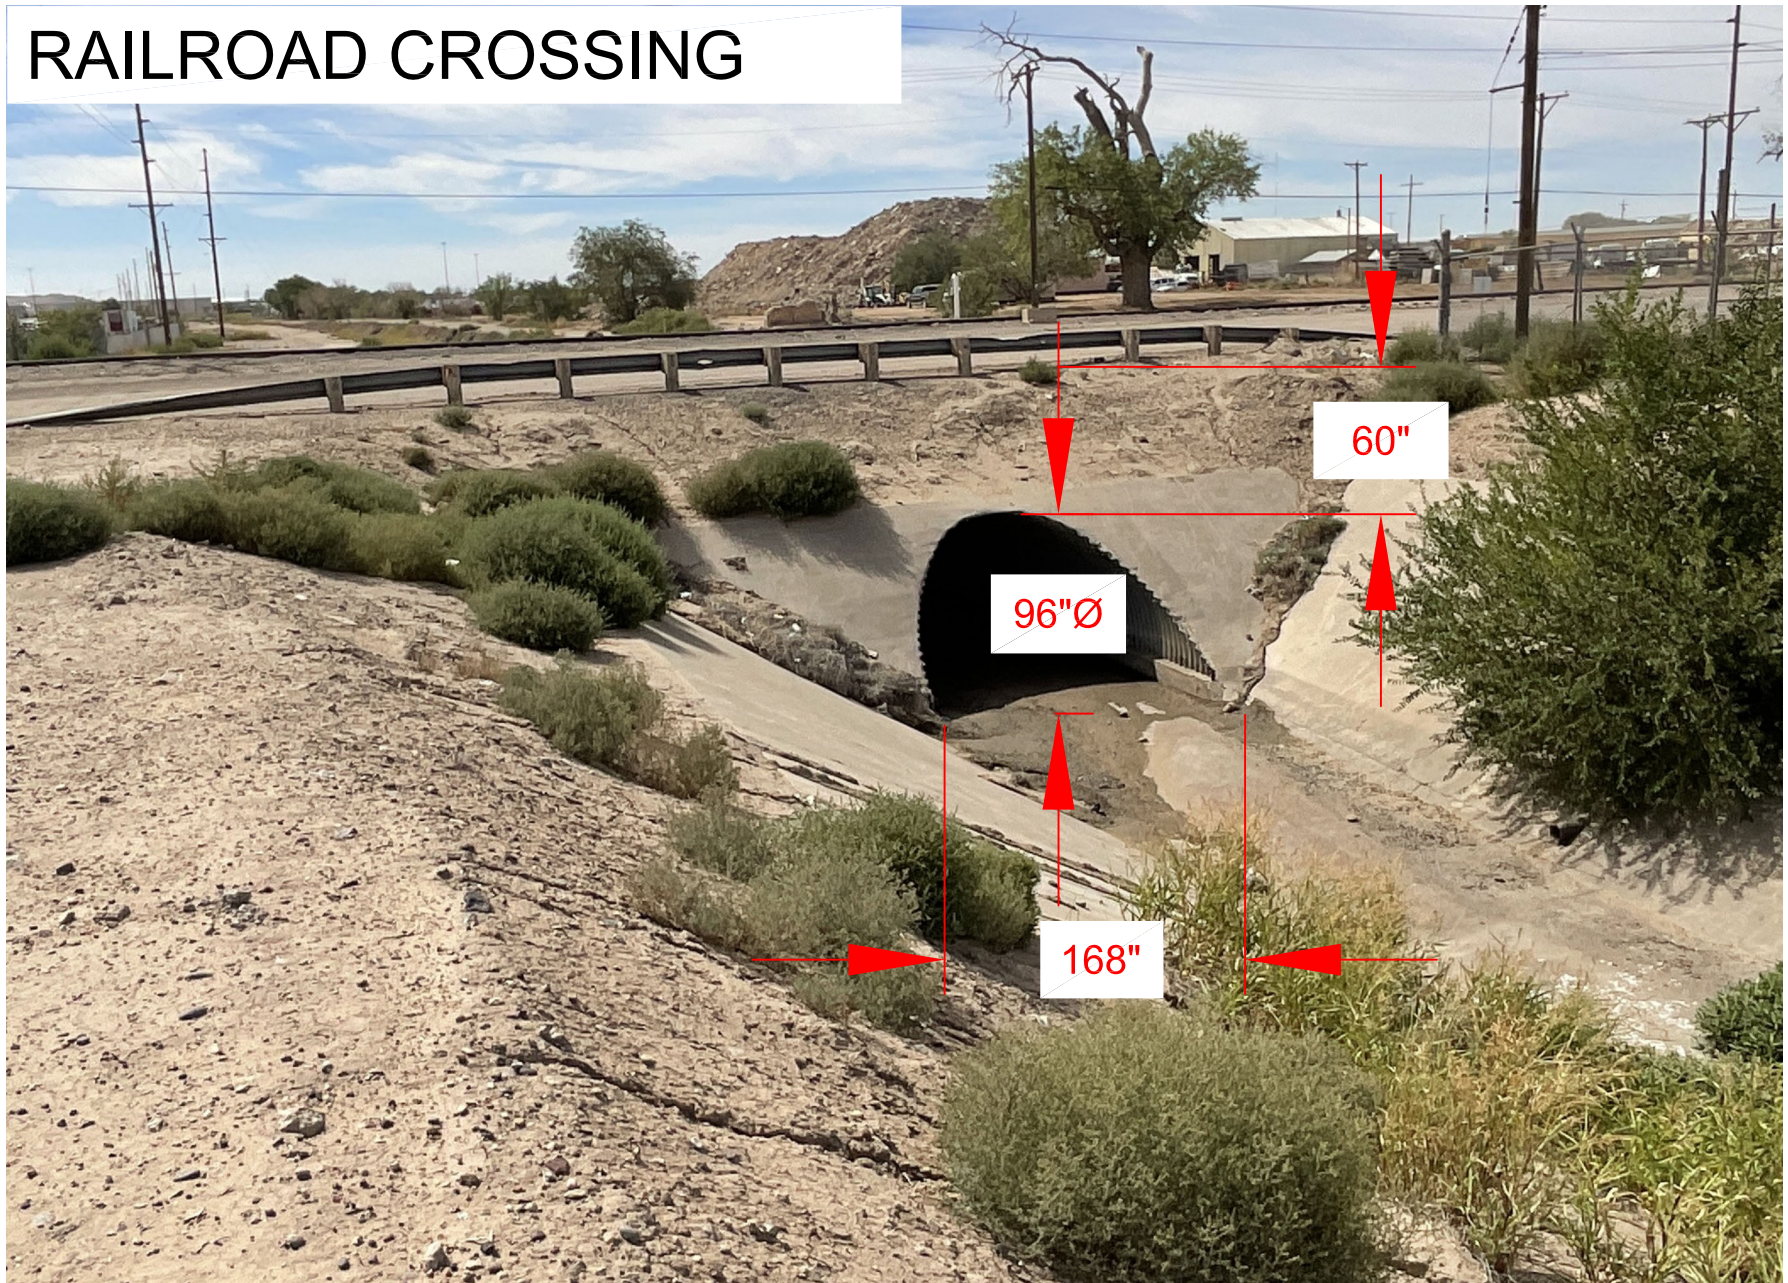


1st Crossing ~~Johnst~~ Bethel & San Jose

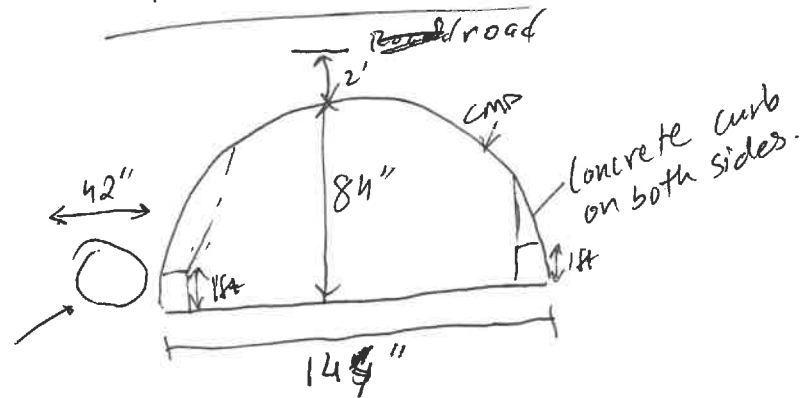


Abajo Penetration

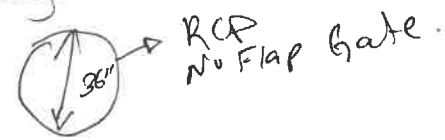


Johns Street Penetration

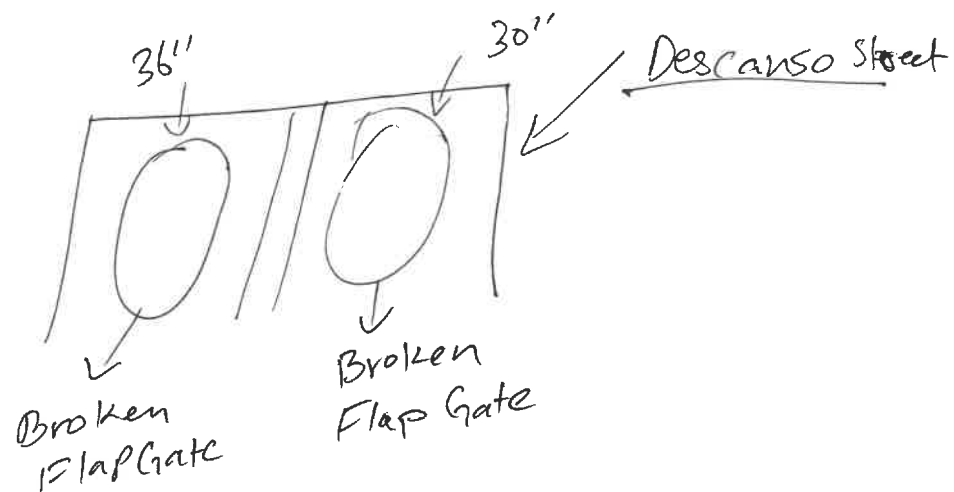


Crossing ~~Wesmeo~~ ~~Wesmeo~~

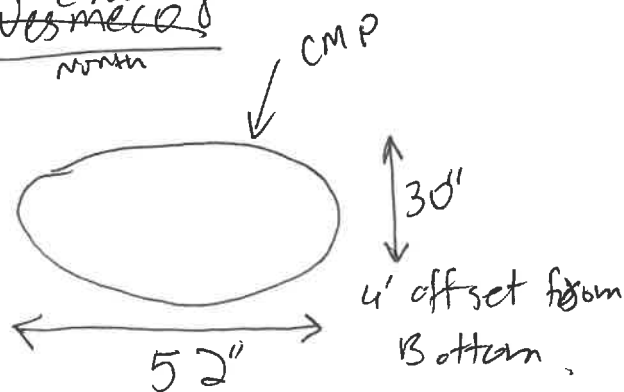


SAN JOSE
2nd Crossing @ Wesmeo.

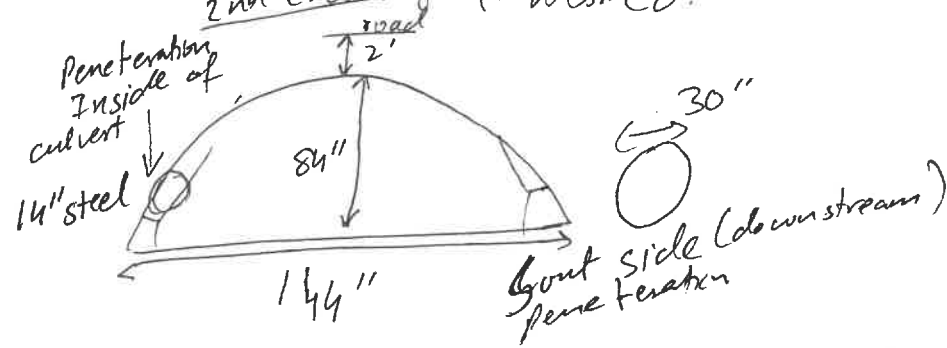


Penetration midway from second crossing to third

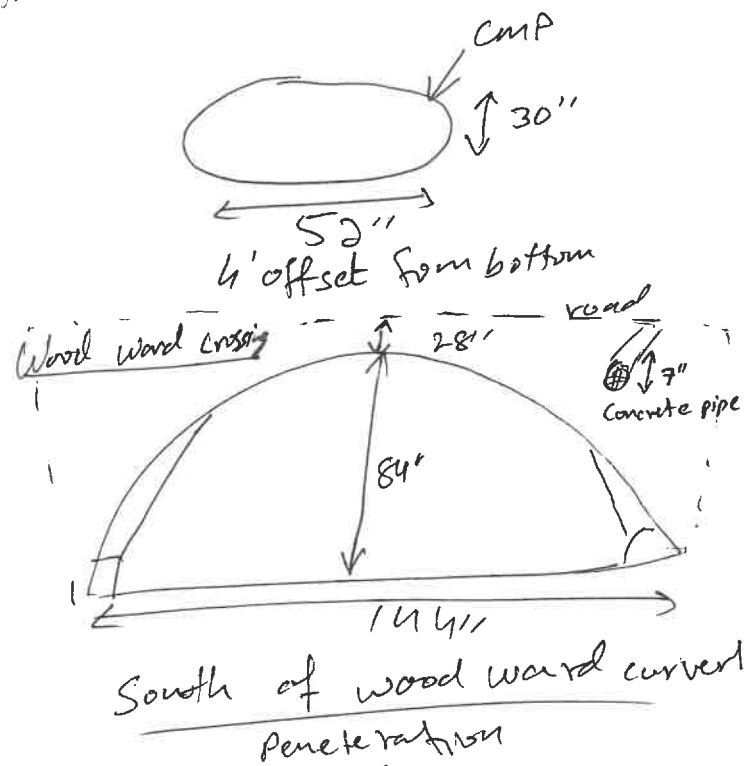

Penetration

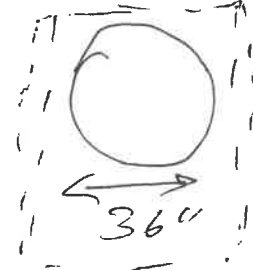

30 inch Penetration more south of Woodward.

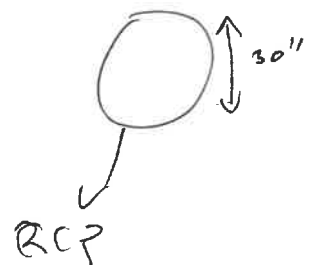

~~Ant Road~~ ~~Ant~~ ~~Woo~~
Railroad Crossing

