


SOUTH BROADWAY INLET STRUCTURE





EASTSIDE

BROKEN FLAPGATE

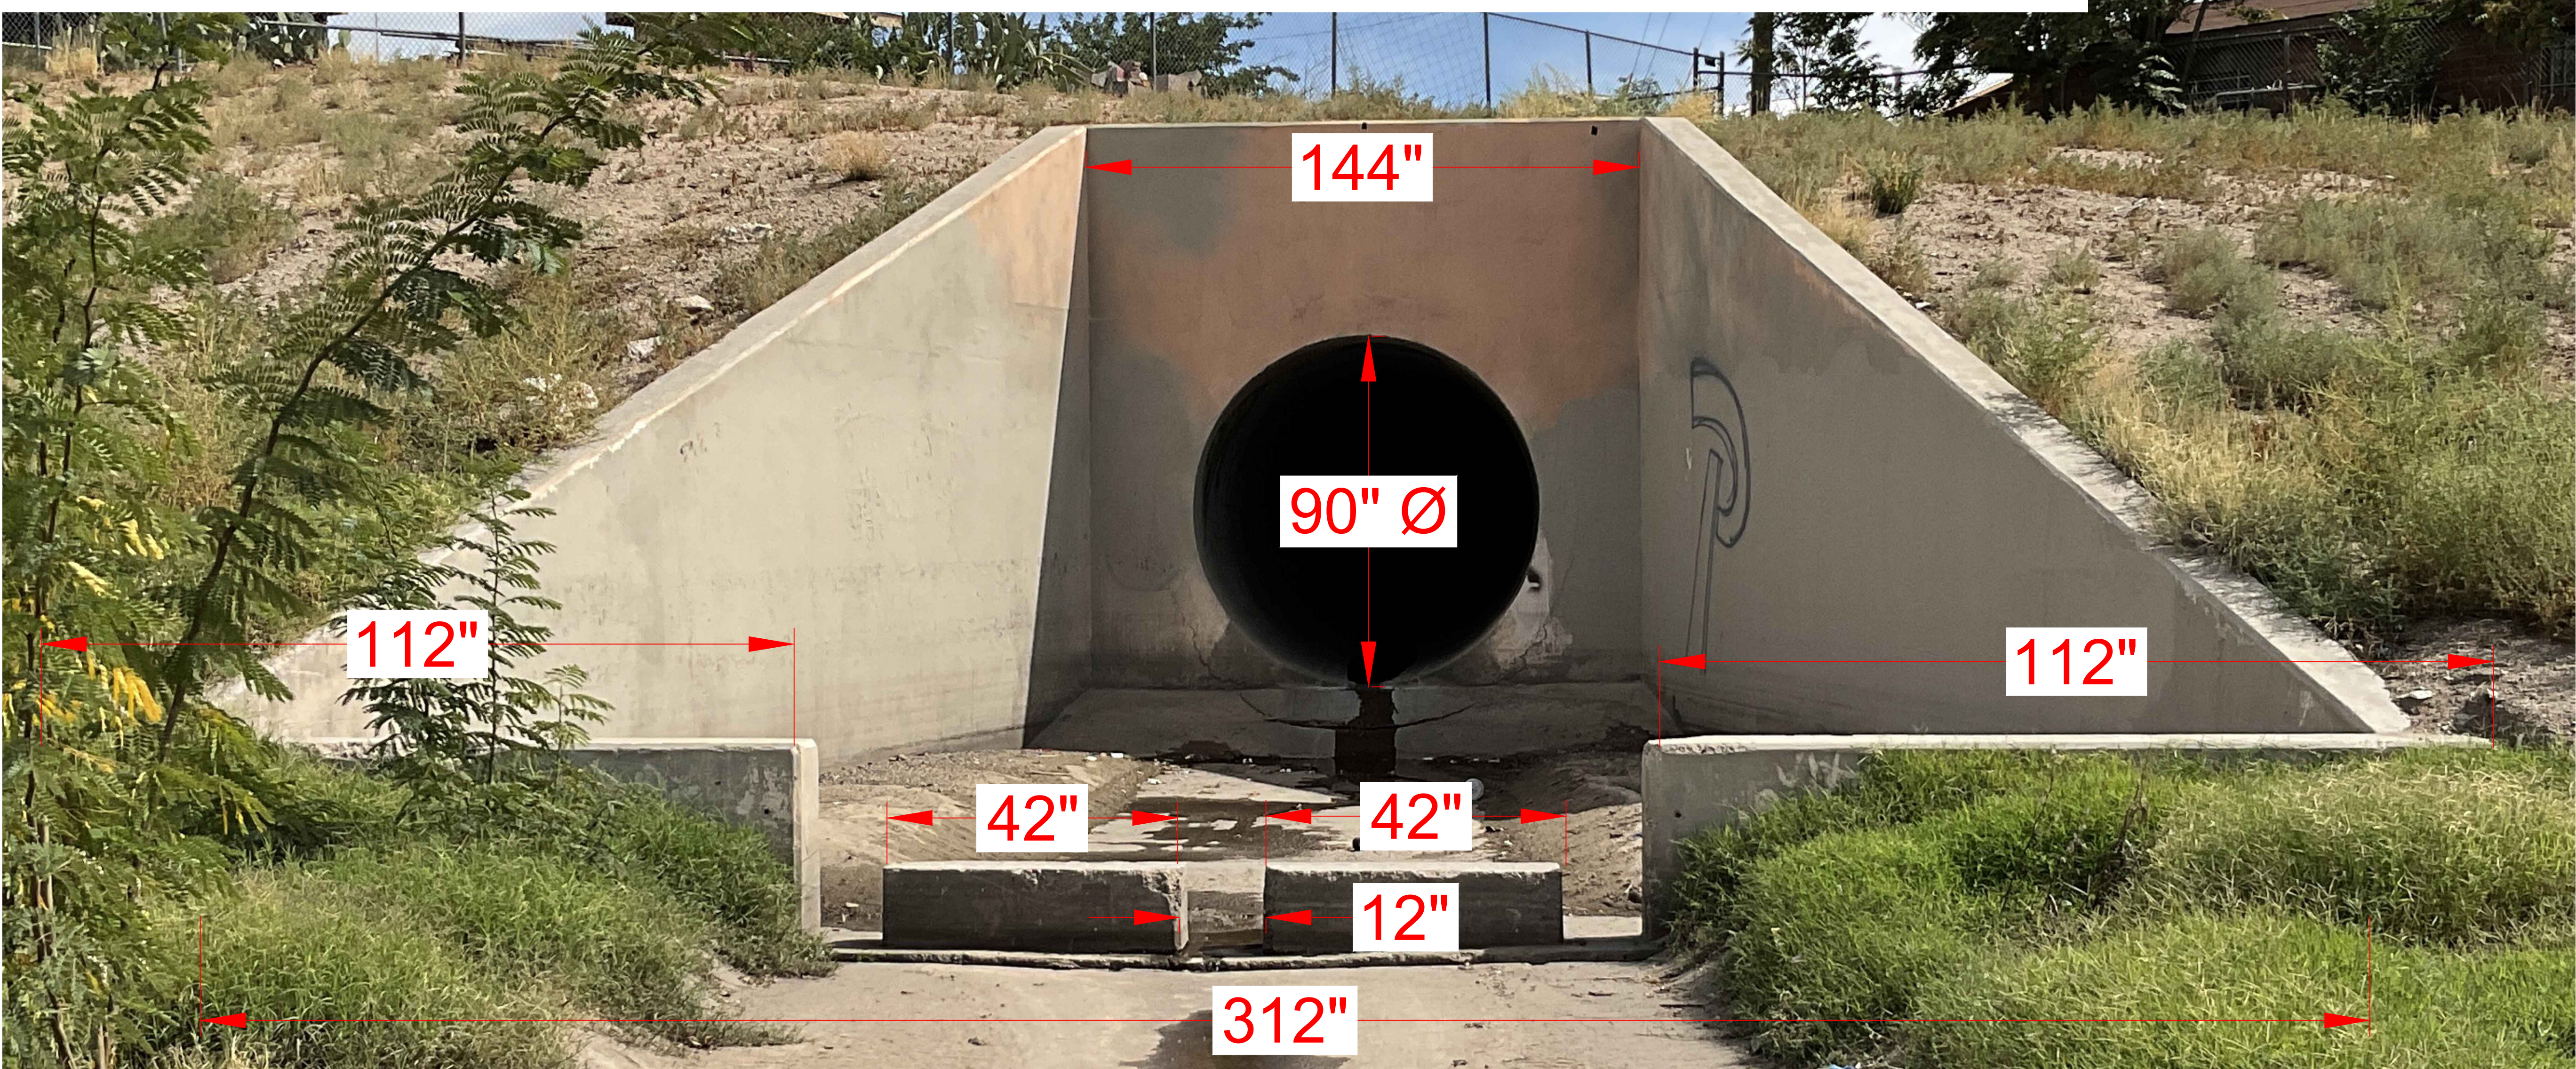


WESTSIDE

SOUTH BROADWAY OUTLET STRUCTURE

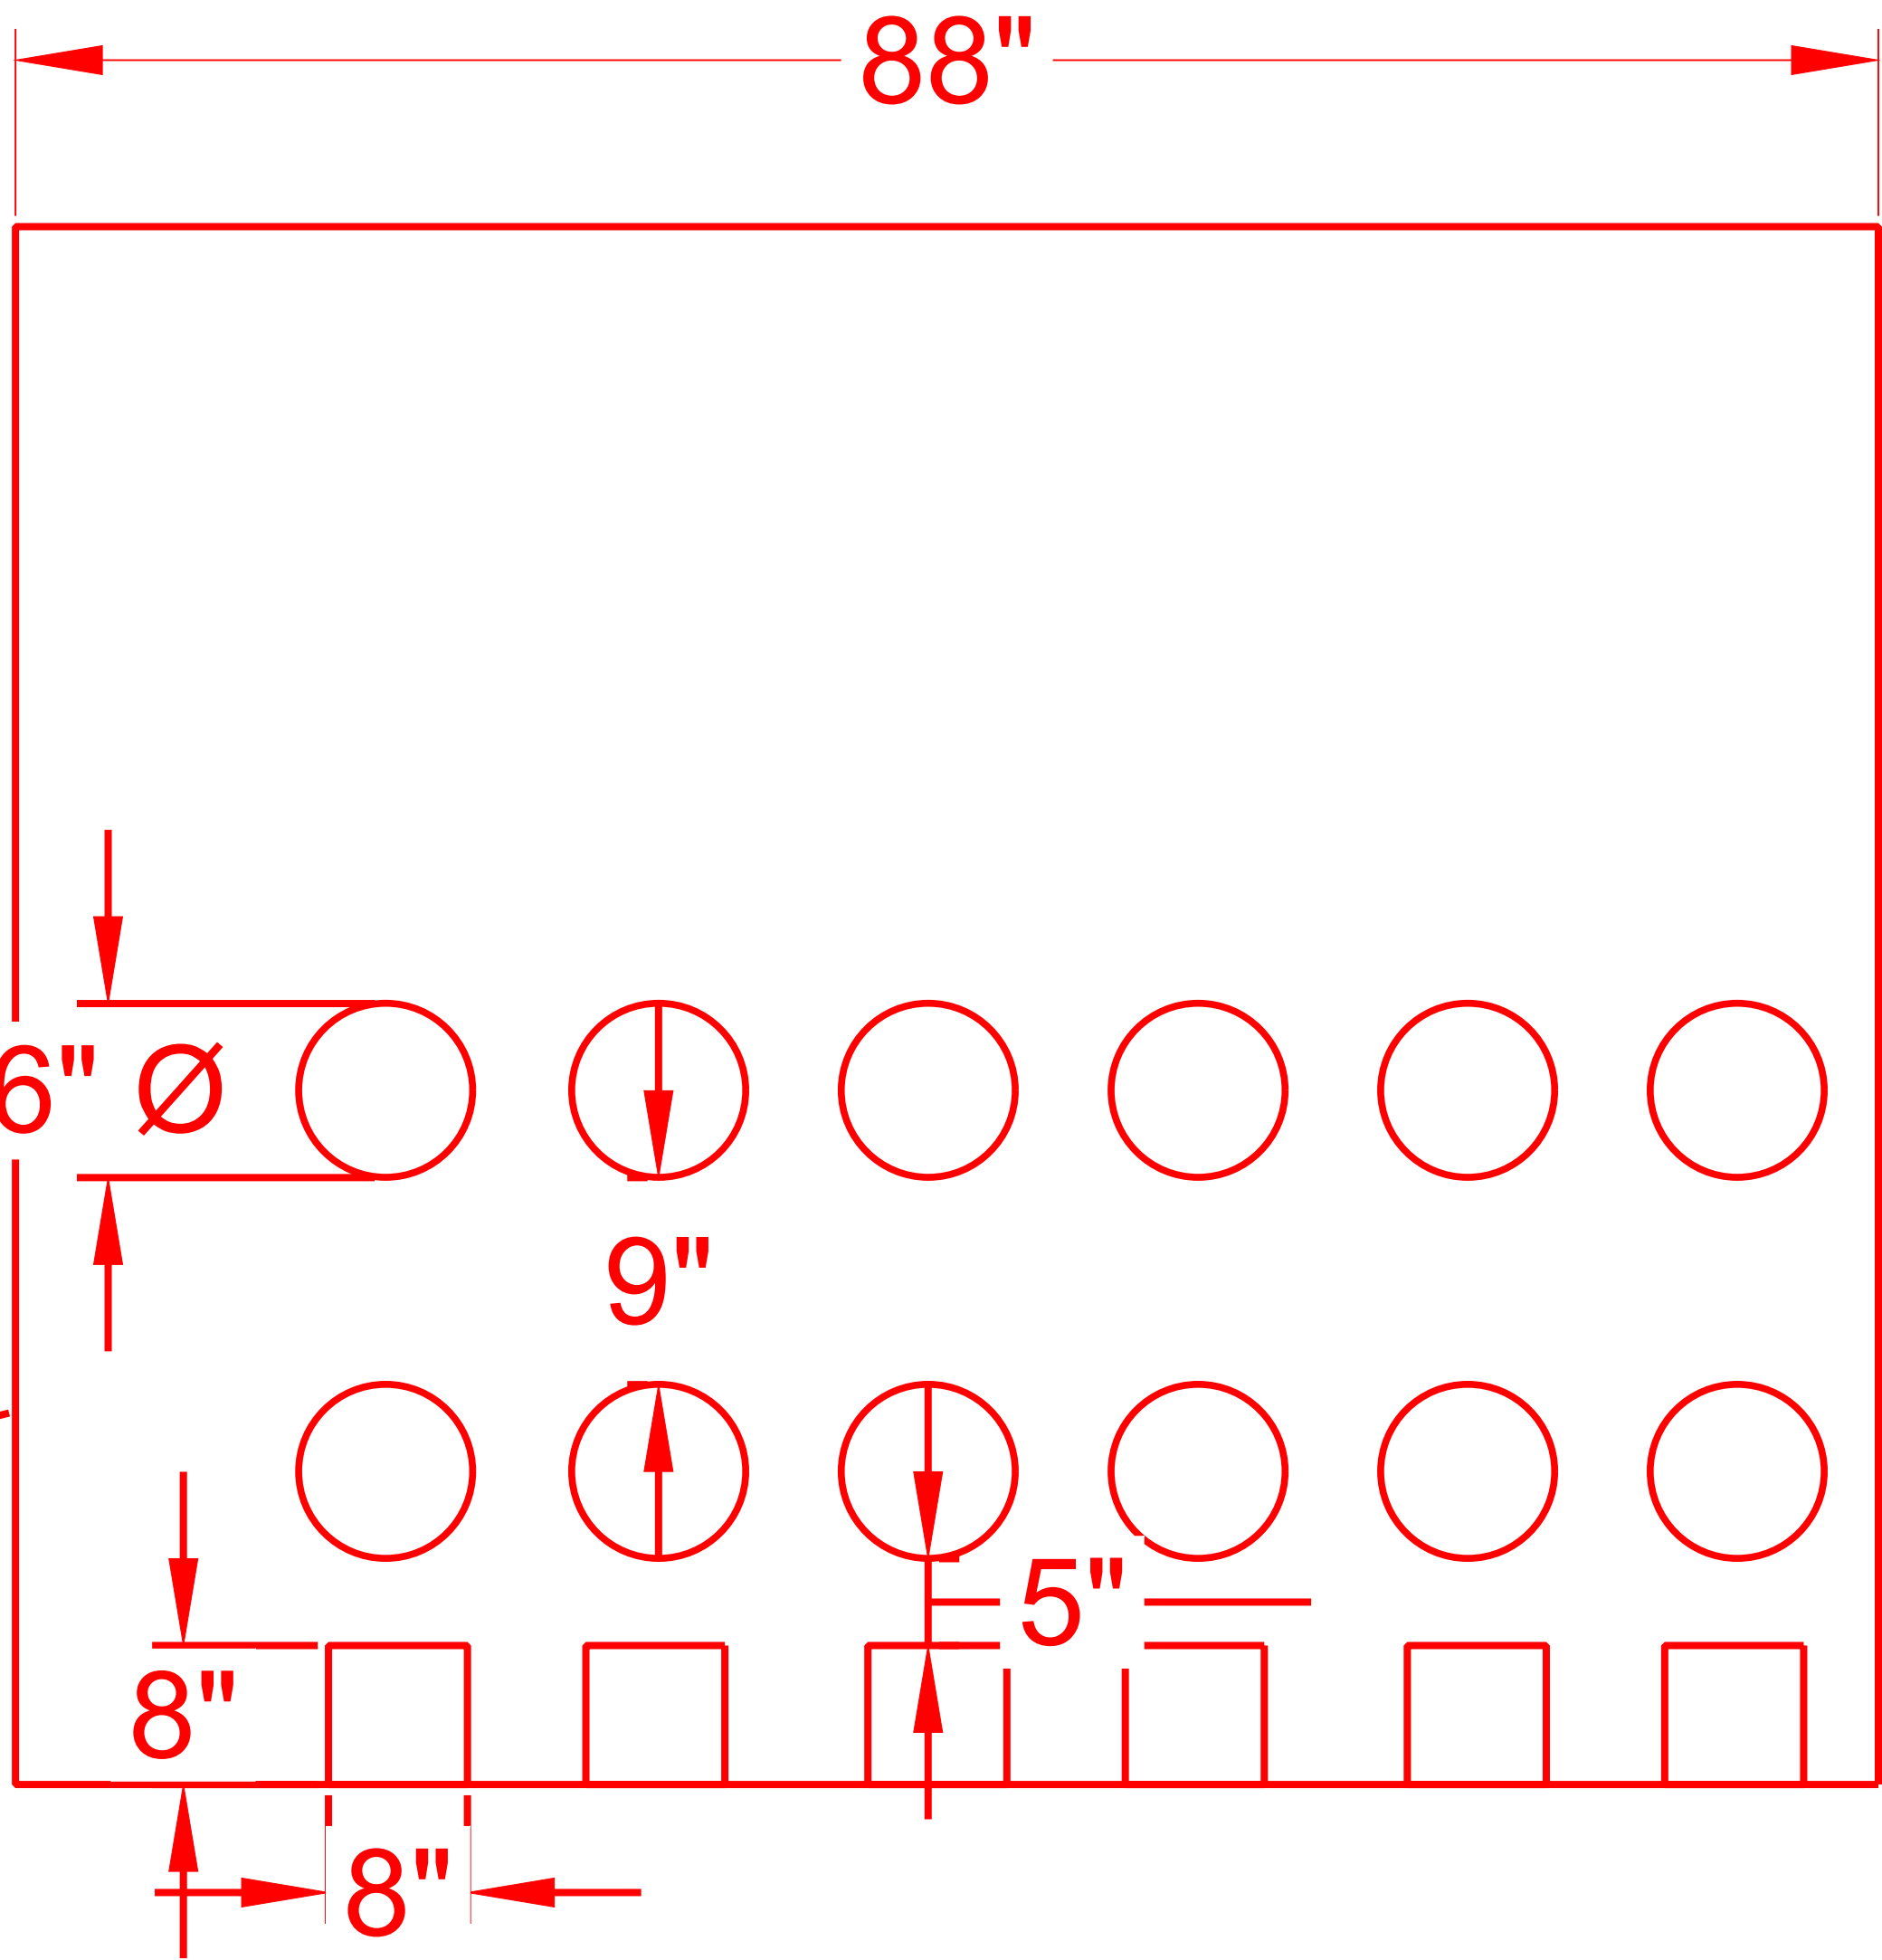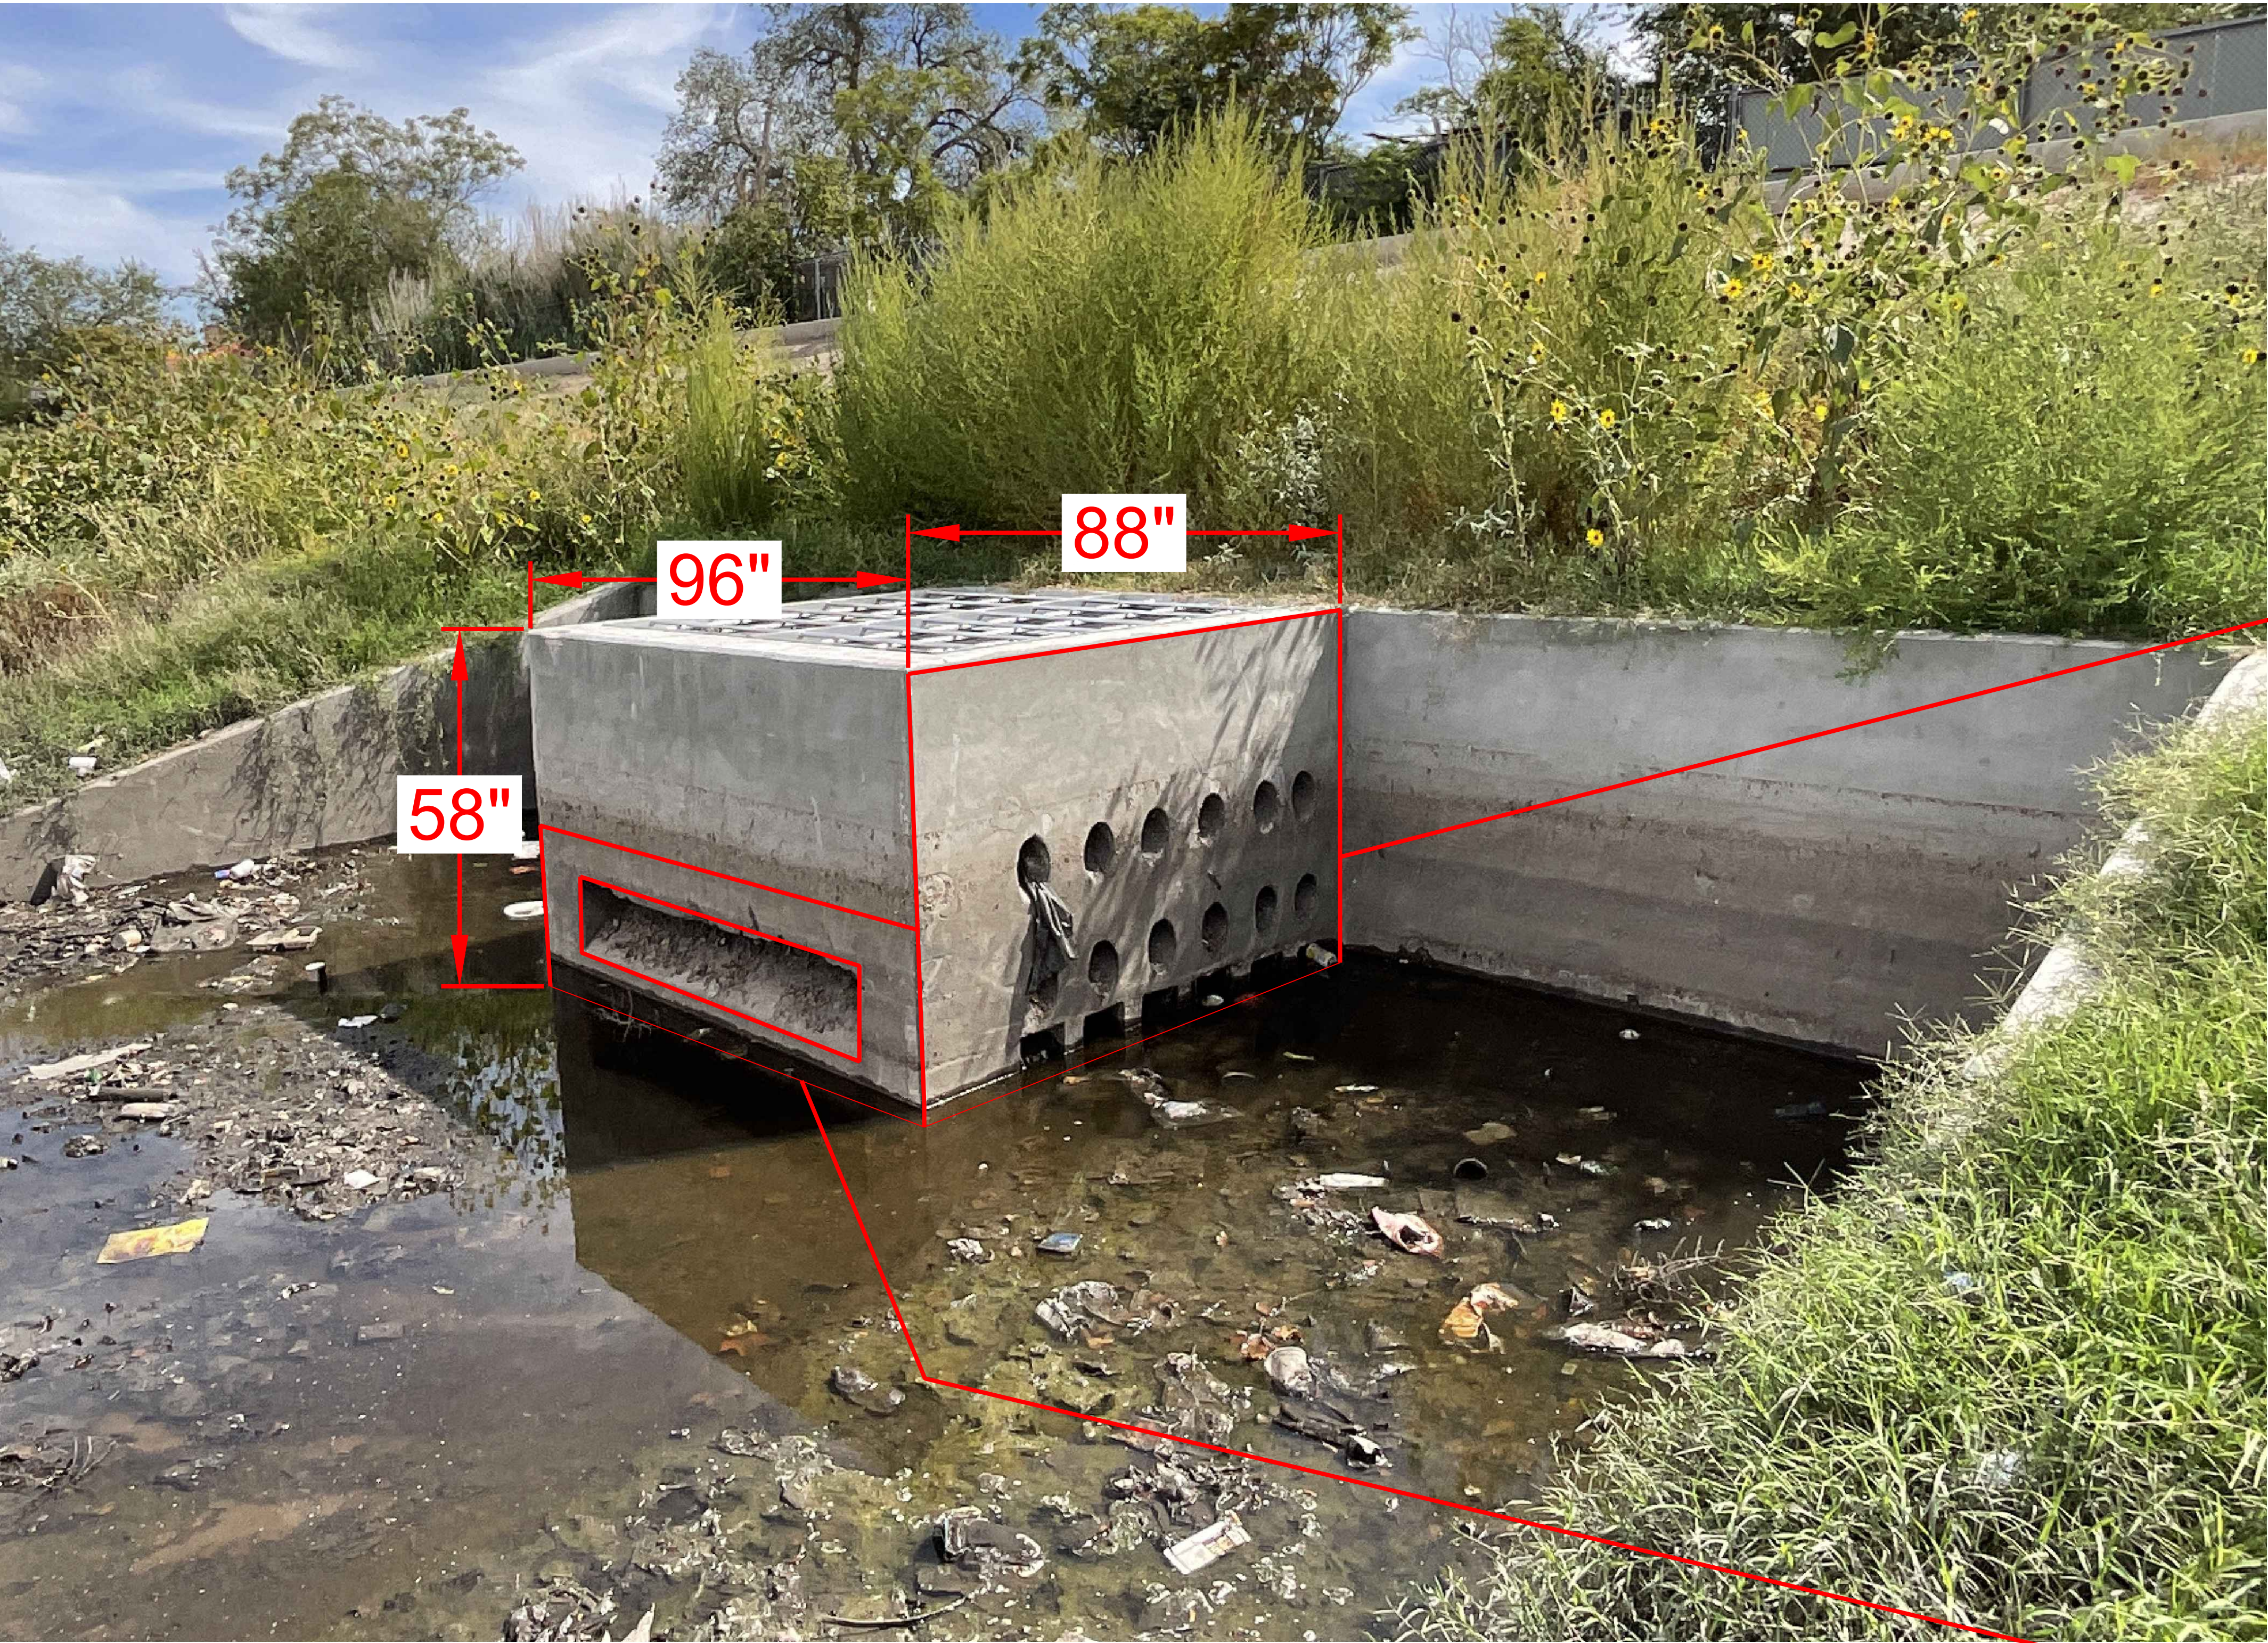

WESTSIDE FACE

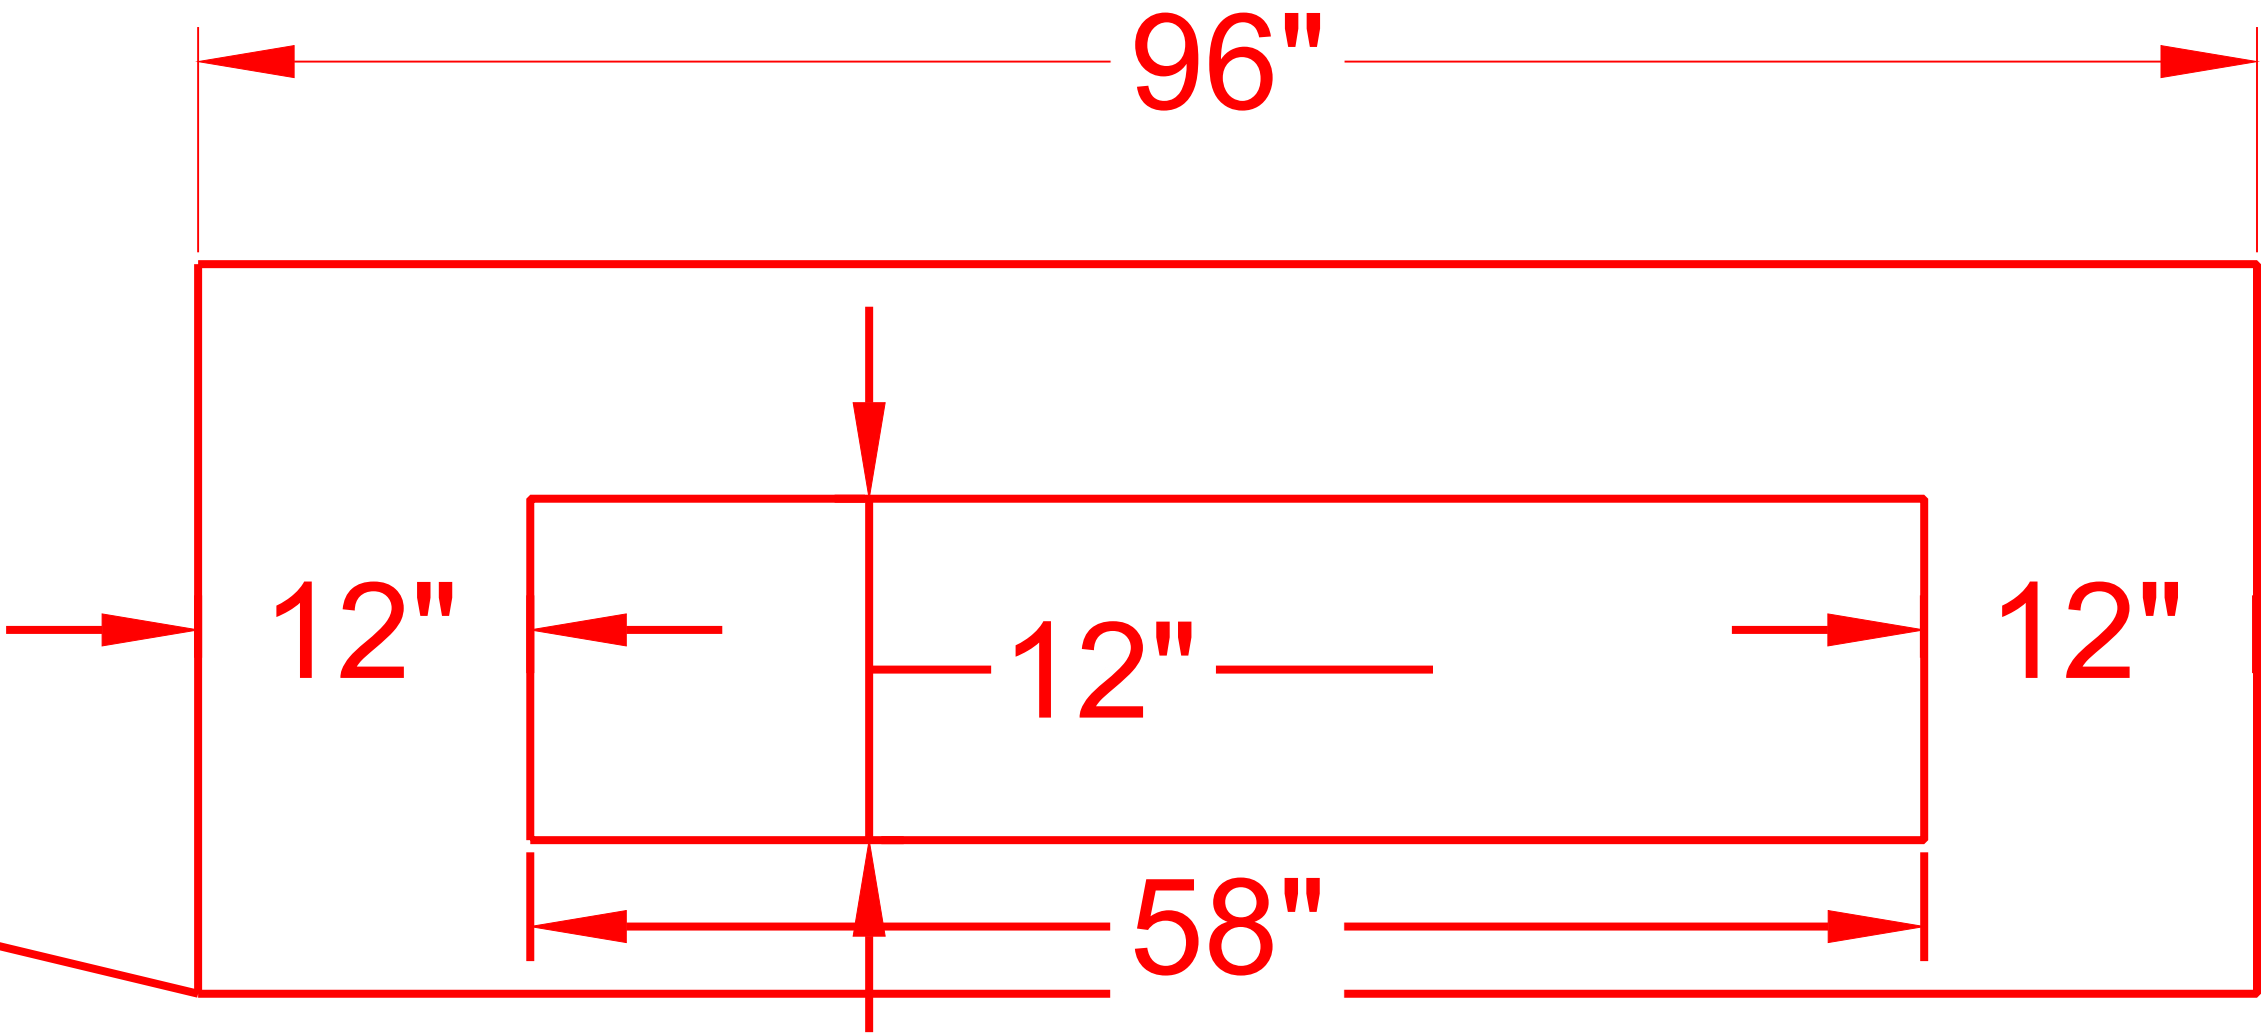

FRONT FACE OPENING

NTS

SOUTH BROADWAY OUTLET STRUCTURE - TOPVIEW



30" Ø RCP
OUTFALL NOT
PICTURED

NTS