



City of Albuquerque

P.O. BOX 1293 ALBUQUERQUE, NEW MEXICO 87103

November 4, 2003

David Harrison, P.E.
Wilson & Company
2600 American Rd. Suite 100
Albuquerque, NM 87124

**Re: Seville Unit 6, SIA/Financial Guarantee Release
Engineer's Stamp dated 1-06-03 (A10/D2D)
Certification dated 10-30-03**

Dear Mr.Harrison,


Based upon the information provided in your submittal received 11-03-03, the above referenced certification is approved for release of SIA and Financial Guarantee.

If you have any questions, you can contact me at 924-3981.

Sincerely,

Kristal D. Metro
Engineering Associate, Planning Dept.
Development and Building Services

C: Arlene Portillo, COA# 702081
file

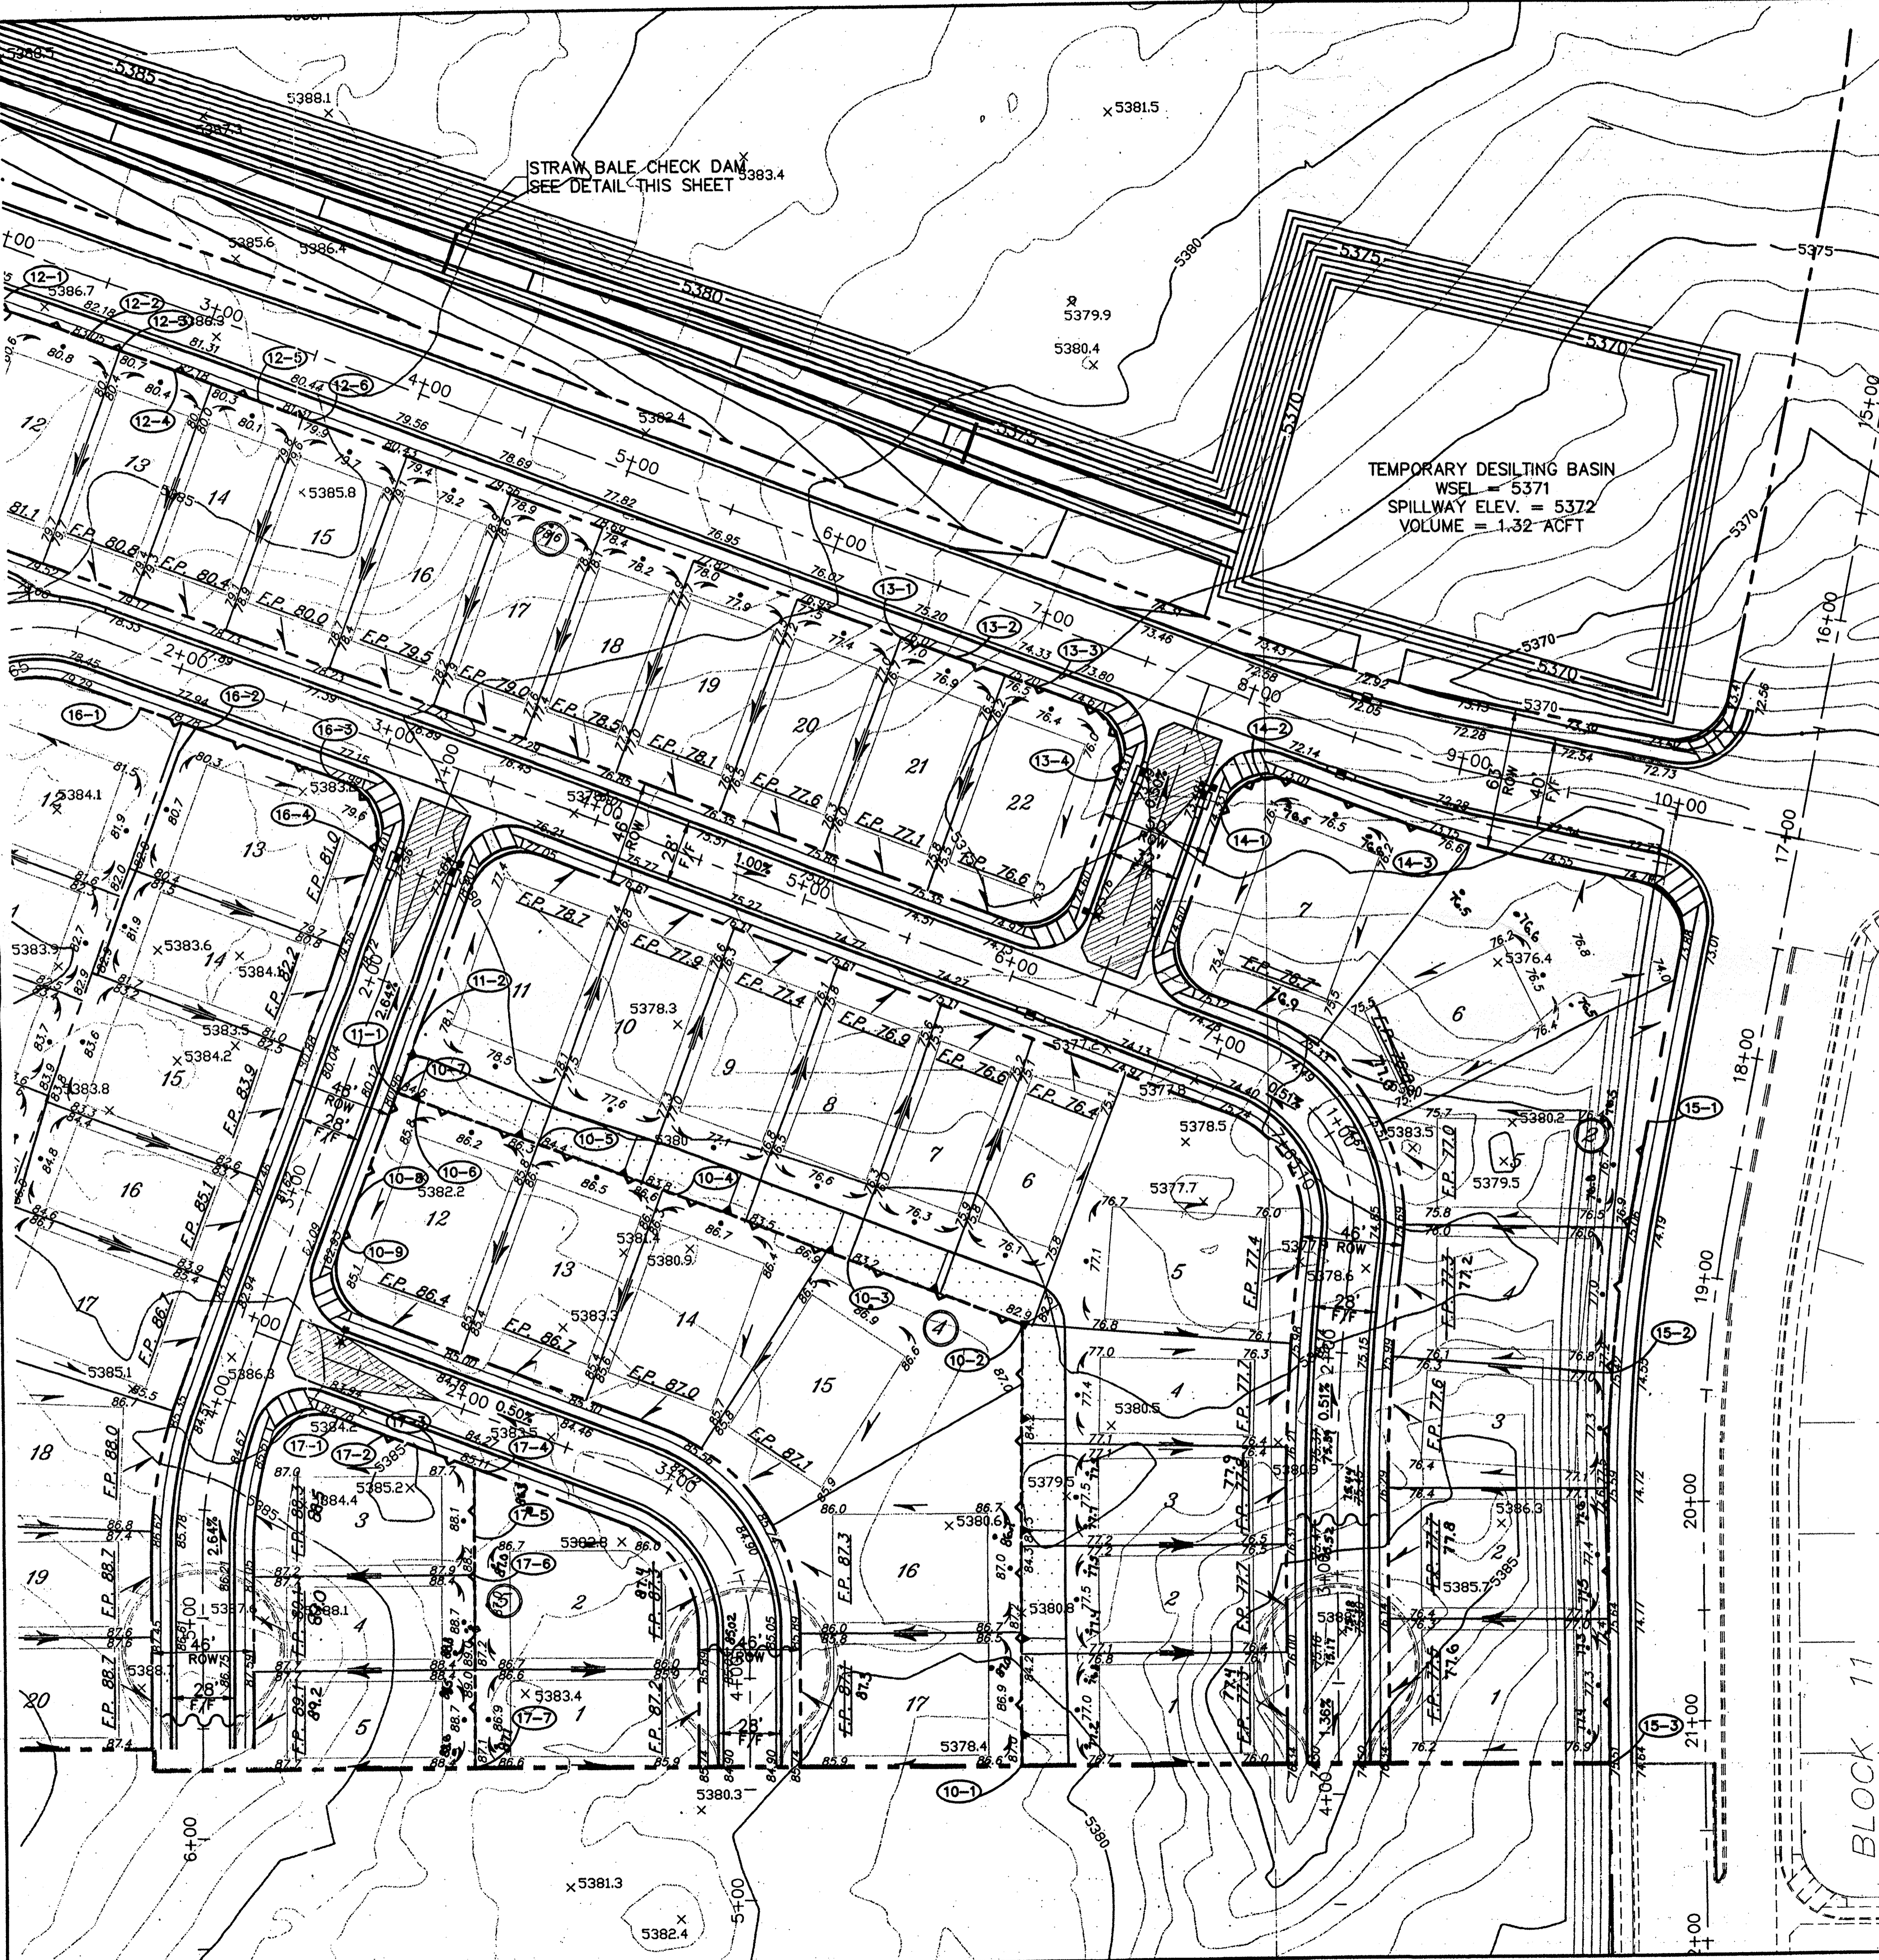


STRAW BALE CHECK DAM
SEE DETAIL THIS SHEET

TEMPORARY DESILTING BASIN
WSEL = 5371
SPILLWAY ELEV. = 5372
VOLUME = 1.32 ACFT

RETAINING WALL TABLE

WALL POINT	TOP OF WALL ELEV	TOP OF FOOTING ELEV	WALL HEIGHT (FT)	APPROX. WALL LENGTH (FT)
10-1	87.00	83.00	4.00	199.0
10-2	87.00	83.00/81.67	5.33	83.0
10-3	87.00	81.67/82.33	4.67	90.0
10-4	87.00	82.33/83.00	4.00	60.0
10-5	87.00/86.33	83.00/83.67	2.67	57.0
10-6	86.33	83.67/80.33	6.00	12.0
10-7	86.33/85.67	80.33	5.33	53.0
10-8	85.67	80.33/81.00	4.67	17.0
10-9	85.67	81.00		
14-1	75.00	73.00	2.00-2.67	26.0
14-2	75.00/77.00	72.33	4.67	97.5
14-3	77.00	72.33		
15-1	77.33	74.00	3.33	113.5
15-2	77.33	74.00/74.67	2.67	177.0
15-3	77.33	74.67		

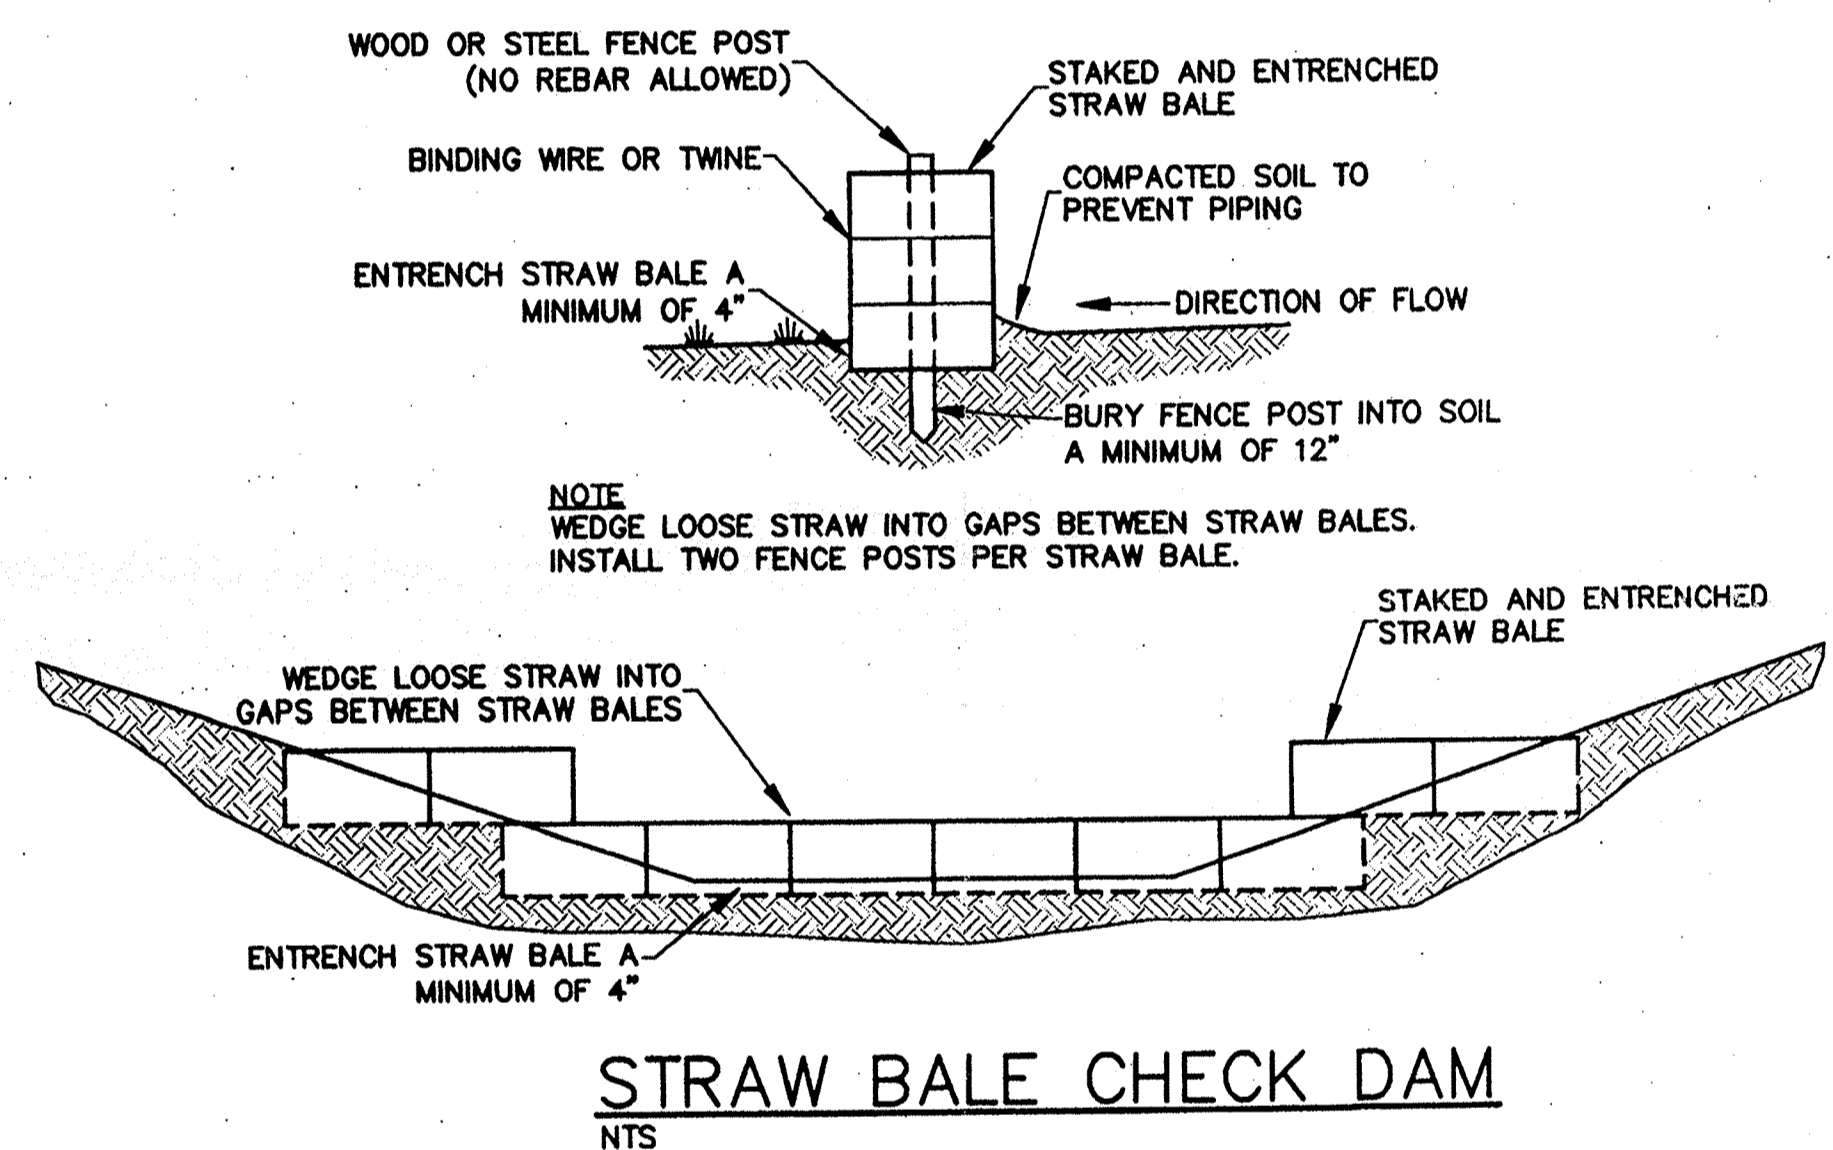


STRAW BALE CHECK DAM
NTS

Brad L. Blum 1-19-03
Approval for Rough Grading

- LEGEND
- RETAINING WALL
 - HIGH POINT
 - DIRECTION OF FLOW
 - LINE ELEVATION
 - RETAINING WALL POINT

NOTE: BACKYARD SLOPES ARE 3:1 UNLESS OTHERWISE NOTED.

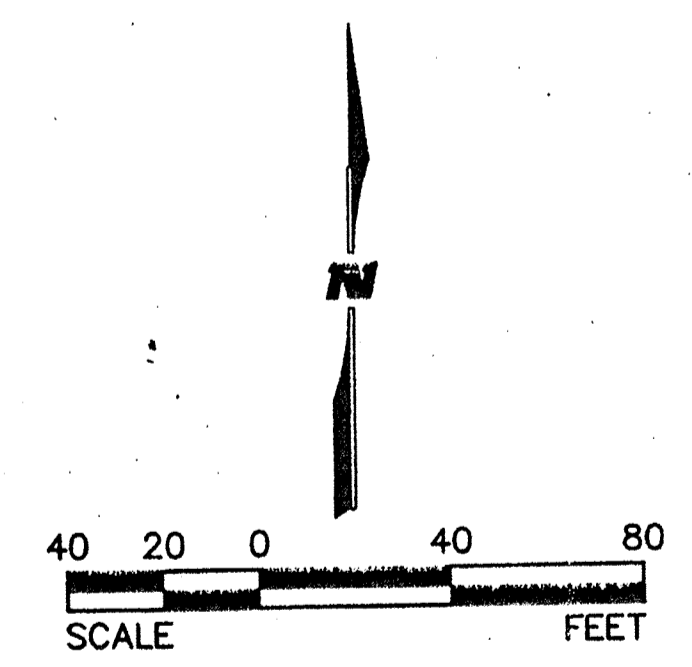

WILSON & COMPANY
2600 THE AMERICAN ROAD S.E.
SUITE 100
RIO RANCHO, NEW MEXICO
87124
(505) 898-8021

CITY OF ALBUQUERQUE
PUBLIC WORKS DEPARTMENT
ENGINEERING GROUP

SEVILLE SUBDIVISION - UNIT 6
GRADING & DRAINAGE PLAN

Design Review Committee	City Engineer Approval	Mo./Day/Yr.	Mo./Day/Yr.
FOR INFORMATION ONLY			
City Project No.	Zone Map No.	Sheet	Of
XXXXXX	A-10-Z	7	7

AS-BUILT INFORMATION

CONTRACTOR	A.C.S. Survey Monument "SANDERN"
DATE	New Mexico State Plane Coord's, Central Zone (NAD 27) as published:
DATE	Y = 1,534,209.29
DATE	X = 361,854.29
DATE	Elevation = 5456.92 (SLD 1929)
DATE	Ground to grid factor = 0.99966079

SURVEY INFORMATION

NO.	FIELD NOTES
BY	PHOTOGRAMMETRY BY 3/2/89
DATE	T.R. MANN & ASSOC.
NO.	FIELD SURVEYS BY
DATE	SURV-TEK, INC.

ENGINEER'S SEAL

NO.	REVISIONS	BY	DATE
	WILSON & COMPANY, ENGINEERS & ARCHITECTS		
	DRAWN BY	DATE	NOV 02
	CHECKED BY	DATE	NOV 02