

ALBUQUERQUE METROPOLITAN
ARROYO FLOOD CONTROL AUTHORITY

CONSTRUCTION PLANS
FOR
CALABACILLAS ARROYO IMPROVEMENTS
ANASAZI RIDGE SUBDIVISION
SPURS & BANK PROTECTION
ALBUQUERQUE, NEW MEXICO

INDEX TO DRAWINGS	
SHEET NO.	SHEET
1	INDEX OF SHEETS
2	MASTER PLAN
3 - 5	CHANNEL PLAN & PROFILES
6 - 7	SHOT-CRETE SPUR DETAILS
8 - 9	PENETRATION DETAILS & SHOT-CRETE SPECIFICATIONS

RECORD DRAWING
CERTIFICATE OF SUBSTANTIAL COMPLIANCE ON PLANS



I, Mark Goodwin, NMPE #8948, of the firm Mark Goodwin & Associates, PA, a Registered Professional Engineer in the State of New Mexico, do hereby certify, to the best of my knowledge and belief, that the infrastructure installed as part of this project has been inspected by me or by a qualified person under my direct supervision, and has been constructed in accordance with the plans and specifications approved by the City Engineer and that the original design intent of the approved plans has been met, except as noted by me on the as-built construction drawings. This Certification is based on site inspections by me or personnel under my direction, and survey information provided by Russ P. Hugg, NMPS number 9750.

Mark Goodwin 9/27/10
Mark Goodwin NMPE 8948

I, Mark Goodwin, certify that this electronic version is identical to the original reproducible APPROVED FOR CONSTRUCTION drawings signed by me on 11/29, 2007.

{One cover sheet only put:}

This set of drawings is accepted for RECORD purposes by _____ on _____, 2010.

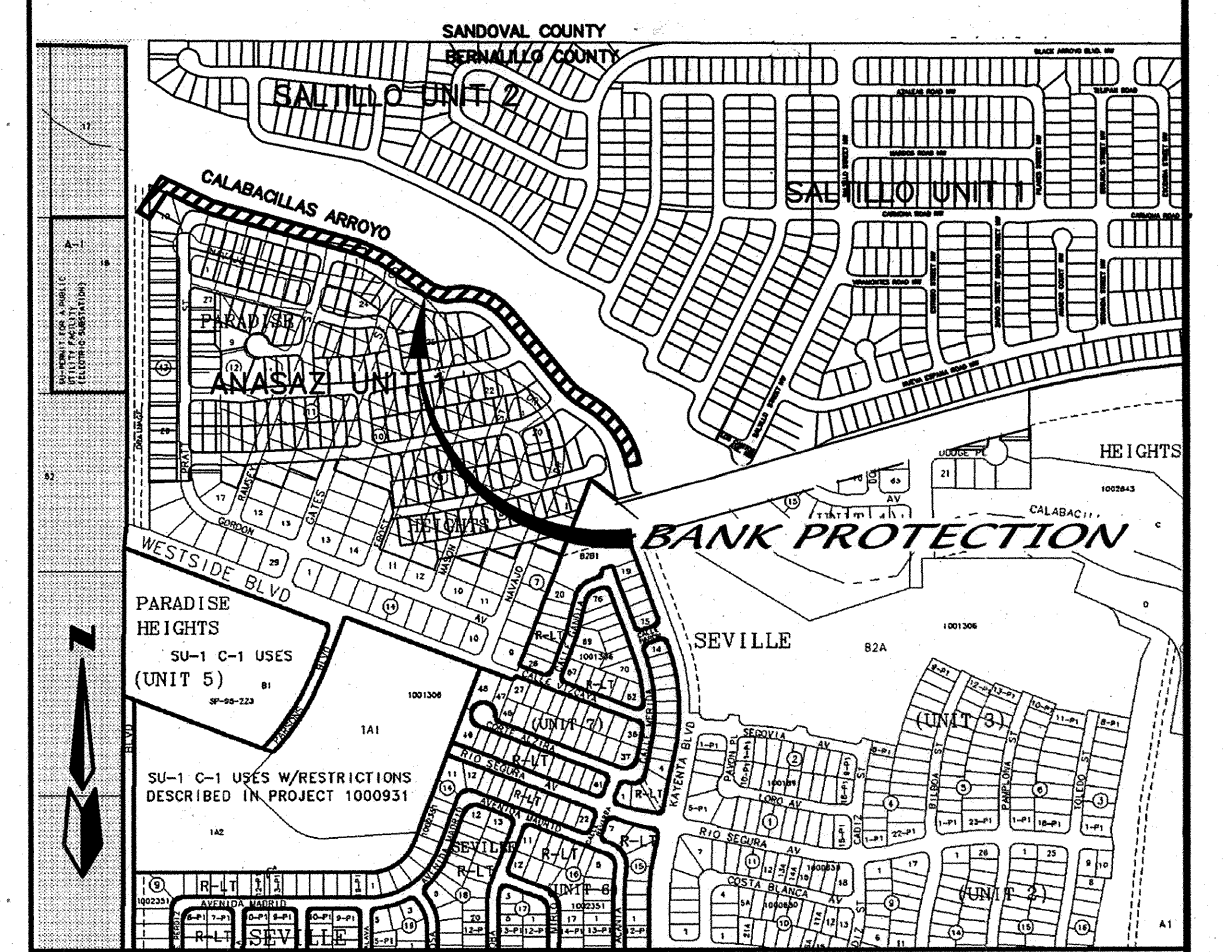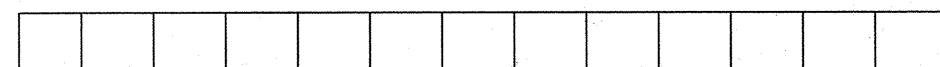

VICINITY MAP ZONE ATLAS A-10-Z
SCALE: NONE

AMAFCA NOTES

1. AMAFCA FIELD ENGINEER SHALL BE NOTIFIED 48-HOURS PRIOR TO ANY WORK WITHIN THE AMAFCA RIGHT-OF-WAY.
2. NO WORK WILL BE PERFORMED WITHIN THE AMAFCA RIGHT-OF-WAY BETWEEN MAY 15 AND OCTOBER 15 WITHOUT WRITTEN PERMISSION FROM AMAFCA.
3. ALL SUBGRADE, BACKFILL AND EMBANKMENT SHALL BE COMPACTED TO 95% (MODIFIED PROCTOR) WITHIN AMAFCA RIGHT-OF-WAY, EXCEPT TOP 1" AT 90% TESTING RESULTS SHALL BE PROVIDED TO AMAFCA FIELD ENGINEER. (MOISTURE CONTROL: -2% TO 5% OF OPT.)
4. AMAFCA FIELD ENGINEER WILL BE NOTIFIED 48-HOURS PRIOR TO FINAL INSPECTION OF ANY FACILITIES WITHIN THE AMAFCA R/W.
5. ALL DISTURBED GROUND SHALL BE REVEGETATED IN ACCORDANCE WITH THE CITY OF ALBUQUERQUE STANDARD SPECIFICATIONS FOR PUBLIC WORKS CONSTRUCTION, SECTION 1012 NATIVE GRASS SEEDING, AS CURRENTLY UPDATED.
6. PRIOR TO CONSTRUCTION, THE CONTRACTOR SHALL EXCAVATE AND VERIFY THE HORIZONTAL AND VERTICAL LOCATIONS OF ALL OBSTRUCTIONS. SHOULD A CONFLICT EXIST, THE CONTRACTOR SHALL NOTIFY THE ENGINEER IMMEDIATELY SO THAT THE CONFLICT CAN BE RESOLVED WITH A MINIMUM AMOUNT OF DELAY.
7. FIVE (5) WORKING DAYS PRIOR TO BEGINNING OF CONSTRUCTION, THE CONTRACTOR SHALL SUBMIT TO CONSTRUCTION COORDINATION DIVISION A DETAILED CONSTRUCTION SCHEDULE. TWO (2) WORKING DAYS PRIOR TO THE START OF CONSTRUCTION, THE CONTRACTOR SHALL OBTAIN A BARRICADING PERMIT FROM THE CONSTRUCTION COORDINATION DIVISION. CONTRACTOR SHALL NOTIFY THE CONSTRUCTION COORDINATION ENGINEER (924-3400) PRIOR TO OCCUPANCY AN INTERSECTION. REFER TO SECTION 19 OF THE GENERAL CONDITIONS OF THE STANDARD SPECIFICATIONS.
8. CONTRACTOR SHALL NOTIFY THE ENGINEER NOT LESS THAN SEVEN (7) DAYS PRIOR TO STARTING WORK IN ORDER THAT THE CITY SURVEYOR MAY TAKE NECESSARY MEASURES TO INSURE THE PRESERVATION OF SURVEY MONUMENTS. CONTRACTOR SHALL NOT DISTURB PERMANENT SURVEY MONUMENTS WITHOUT THE CONSENT OF THE CITY SURVEYOR AND SHALL NOTIFY THE CITY SURVEYOR AND BEAR THE EXPENSE OF REPLACING ANY THAT MAY BE DISTURBED WITHOUT PERMISSION. REPLACEMENT SHALL BE DONE ONLY BY THE CITY SURVEYOR. WHEN A CHANGE IS MADE IN THE FINISHED ELEVATIONS OF THE PAVEMENT OF ANY ROADWAY IN WHICH A PERMANENT SURVEY MONUMENT IS LOCATED, CONTRACTOR SHALL, AT HIS OWN EXPENSE, ADJUST THE MONUMENT TO COVER THE NEW GRADE UNLESS OTHERWISE SPECIFIED. REFER TO SECTION 4.4 OF THE GENERAL CONDITIONS OF THE STANDARD SPECIFICATIONS.
9. CONTRACTOR SHALL RECORD DATA ON ALL UTILITY LINES AND ACCESSORIES AS REQUIRED BY THE CITY OF ALBUQUERQUE FOR THE PREPARATION OF "AS CONSTRUCTED" DRAWINGS. CONTRACTOR SHALL NOT COVER UTILITY LINES AND ACCESSORIES UNTIL ALL DATA HAVE BEEN RECORDED.
10. CONTRACTOR SHALL PROTECT ALL SURVEY MONUMENTS. ANY SURVEY MONUMENTS DISTURBED WILL BE REPLACED BY A LICENSED SURVEYOR AT CONTRACTORS EXPENSE.
11. ALL WORK DETAILED IN THESE PLANS SHALL BE CONSTRUCTION IN ACCORDANCE WITH MMSHD SPECIFICATIONS, 1994.
12. ALL ELECTRICAL, TELEPHONE, CABLE TV, GAS AND ANY OTHER UTILITY LINES, CABLES AND APPURTENANCES ENCOUNTERED DURING CONSTRUCTION THAT REQUIRE RELOCATION, SHALL BE COORDINATED WITH THAT UTILITY BE IT PRIVATE OR CITY OWNED. THE CONTRACTOR SHALL BE RESPONSIBLE FOR COORDINATION OF ALL NECESSARY UTILITY ADJUSTMENTS. NO ADDITIONAL COMPENSATION WILL BE ALLOWED FOR DELAYS OR INCONVENIENCES CAUSED BY UTILITY COMPANY WORK CREWS. THE CONTRACTOR MAY BE REQUIRED TO RESCHEDULE HIS ACTIVITIES TO ALLOW UTILITY CREWS TO PERFORM THEIR REQUIRED WORK.

APPROVED FOR CONSTRUCTION WITHIN AMAFCA RIGHT-OF-WAY:

BY John P Kelly 3-19-08
JOHN P. KELLY, PE
EXECUTIVE ENGINEER
DATE

CAUTION:
NOTE THAT ALL EXISTING UTILITIES MAY NOT BE SHOWN. ALL EXISTING SERVICE CONNECTIONS ARE NOT SHOWN. ANY EXISTING UTILITIES THAT ARE SHOWN ARE APPROXIMATE LOCATION ONLY. IT SHALL BE THE SOLE RESPONSIBILITY OF THE CONTRACTOR TO CONTACT ALL THE UTILITY OWNERS AND TO CONDUCT ALL NECESSARY FIELD INVESTIGATIONS PRIOR TO ANY EXCAVATIONS TO DETERMINE THE ACTUAL LOCATION OF UTILITIES AND OTHER IMPROVEMENTS.



REFERENCES:

Musseterr Engineering, Inc. March 2005 Report
Hydraulic and Channel Stability Analysis
Calabacillas Arroyo Upstream from Swinburne Dam

dmg D. MARK GOODWIN & ASSOCIATES, P.A.
CONSULTING ENGINEERS
P. O. BOX 90606
ALBUQUERQUE, NEW MEXICO 87199
(505) 828-2200, FAX (505) 797-9539

ALBUQUERQUE METROPOLITAN
ARROYO FLOOD CONTROL
AUTHORITY

ENGINEERS STAMP & SIGNATURE	APPROVALS	ENGINEER	DATE	*****
	DRC CHAIRMAN			APPROVED FOR CONSTRUCTION
	TRANSPORTATION			
	WATER/WASTEWATER			
	HYDROLOGY			
	CIP			
	CONSTR. MGMT.			
	CONSTR. COORD.			
	CITY PROJECT NO.			SHEET OF <i>1 9</i>

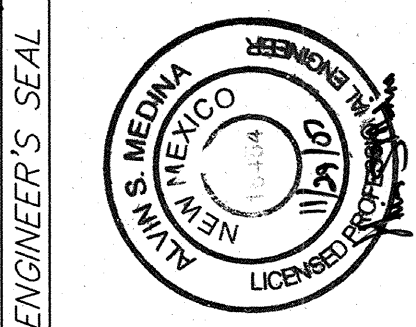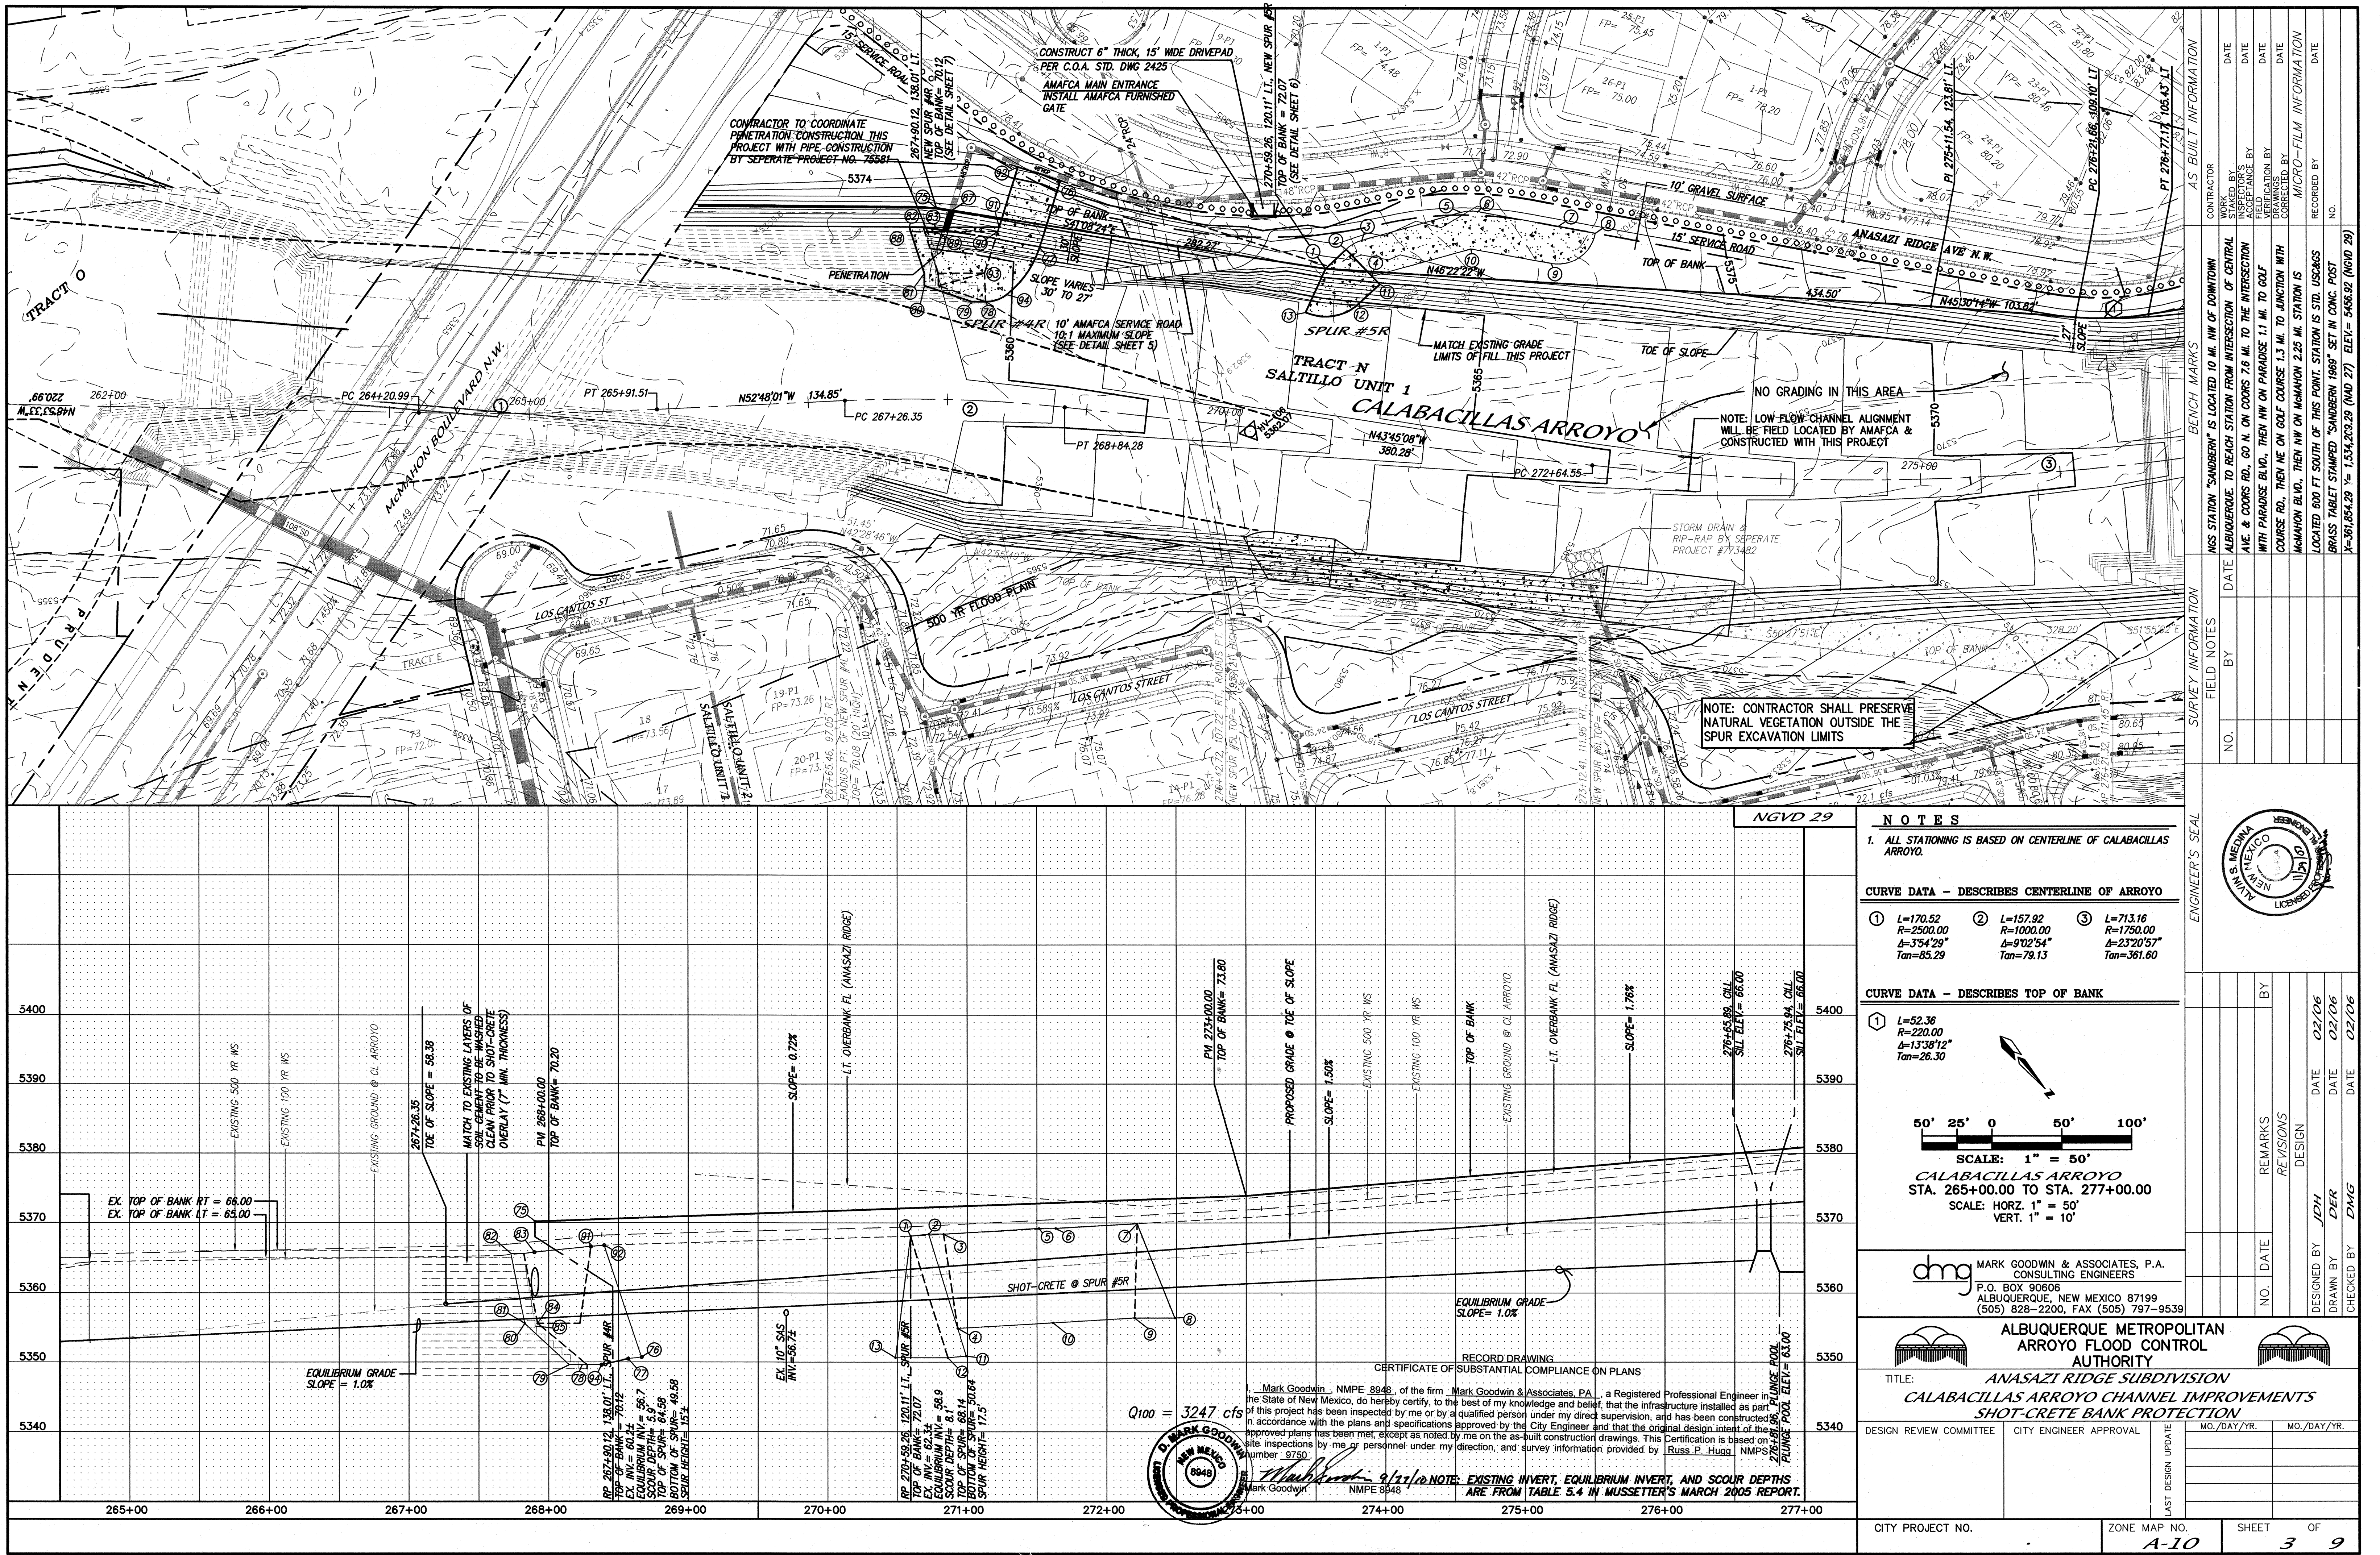

NOTES

1. ALL STATIONING IS BASED ON CENTERLINE OF CALABACILLAS ARROYO.

CURVE DATA - DESCRIBES CENTERLINE OF ARROYO

1	2	3
L=170.52 R=2500.00 Δ=3°54'29" Tan=85.29	L=157.92 R=1000.00 Δ=9°02'54" Tan=79.13	L=713.16 R=1750.00 Δ=23°20'57" Tan=361.60

CURVE DATA - DESCRIBES TOP OF BANK

1
L=52.36 R=220.00 Δ=13°38'12" Tan=26.30

SCALE: 1" = 50'
SCALE: HORZ. 1" = 50'
SCALE: VERT. 1" = 10'



MARK GOODWIN & ASSOCIATES, P.A.
P.O. BOX 90606
ALBUQUERQUE, NEW MEXICO 87199
(505) 828-2200, FAX (505) 797-9539

ALBUQUERQUE METROPOLITAN ARROYO FLOOD CONTROL AUTHORITY

TITLE: **ANASAZI RIDGE SUBDIVISION CALABACILLAS ARROYO CHANNEL IMPROVEMENTS SHOT-CRETE BANK PROTECTION**

DESIGN REVIEW COMMITTEE	CITY ENGINEER APPROVAL	MO./DAY/YR.	MO./DAY/YR.

CITY PROJECT NO. _____ ZONE MAP NO. **A-10** SHEET **3** OF **9**

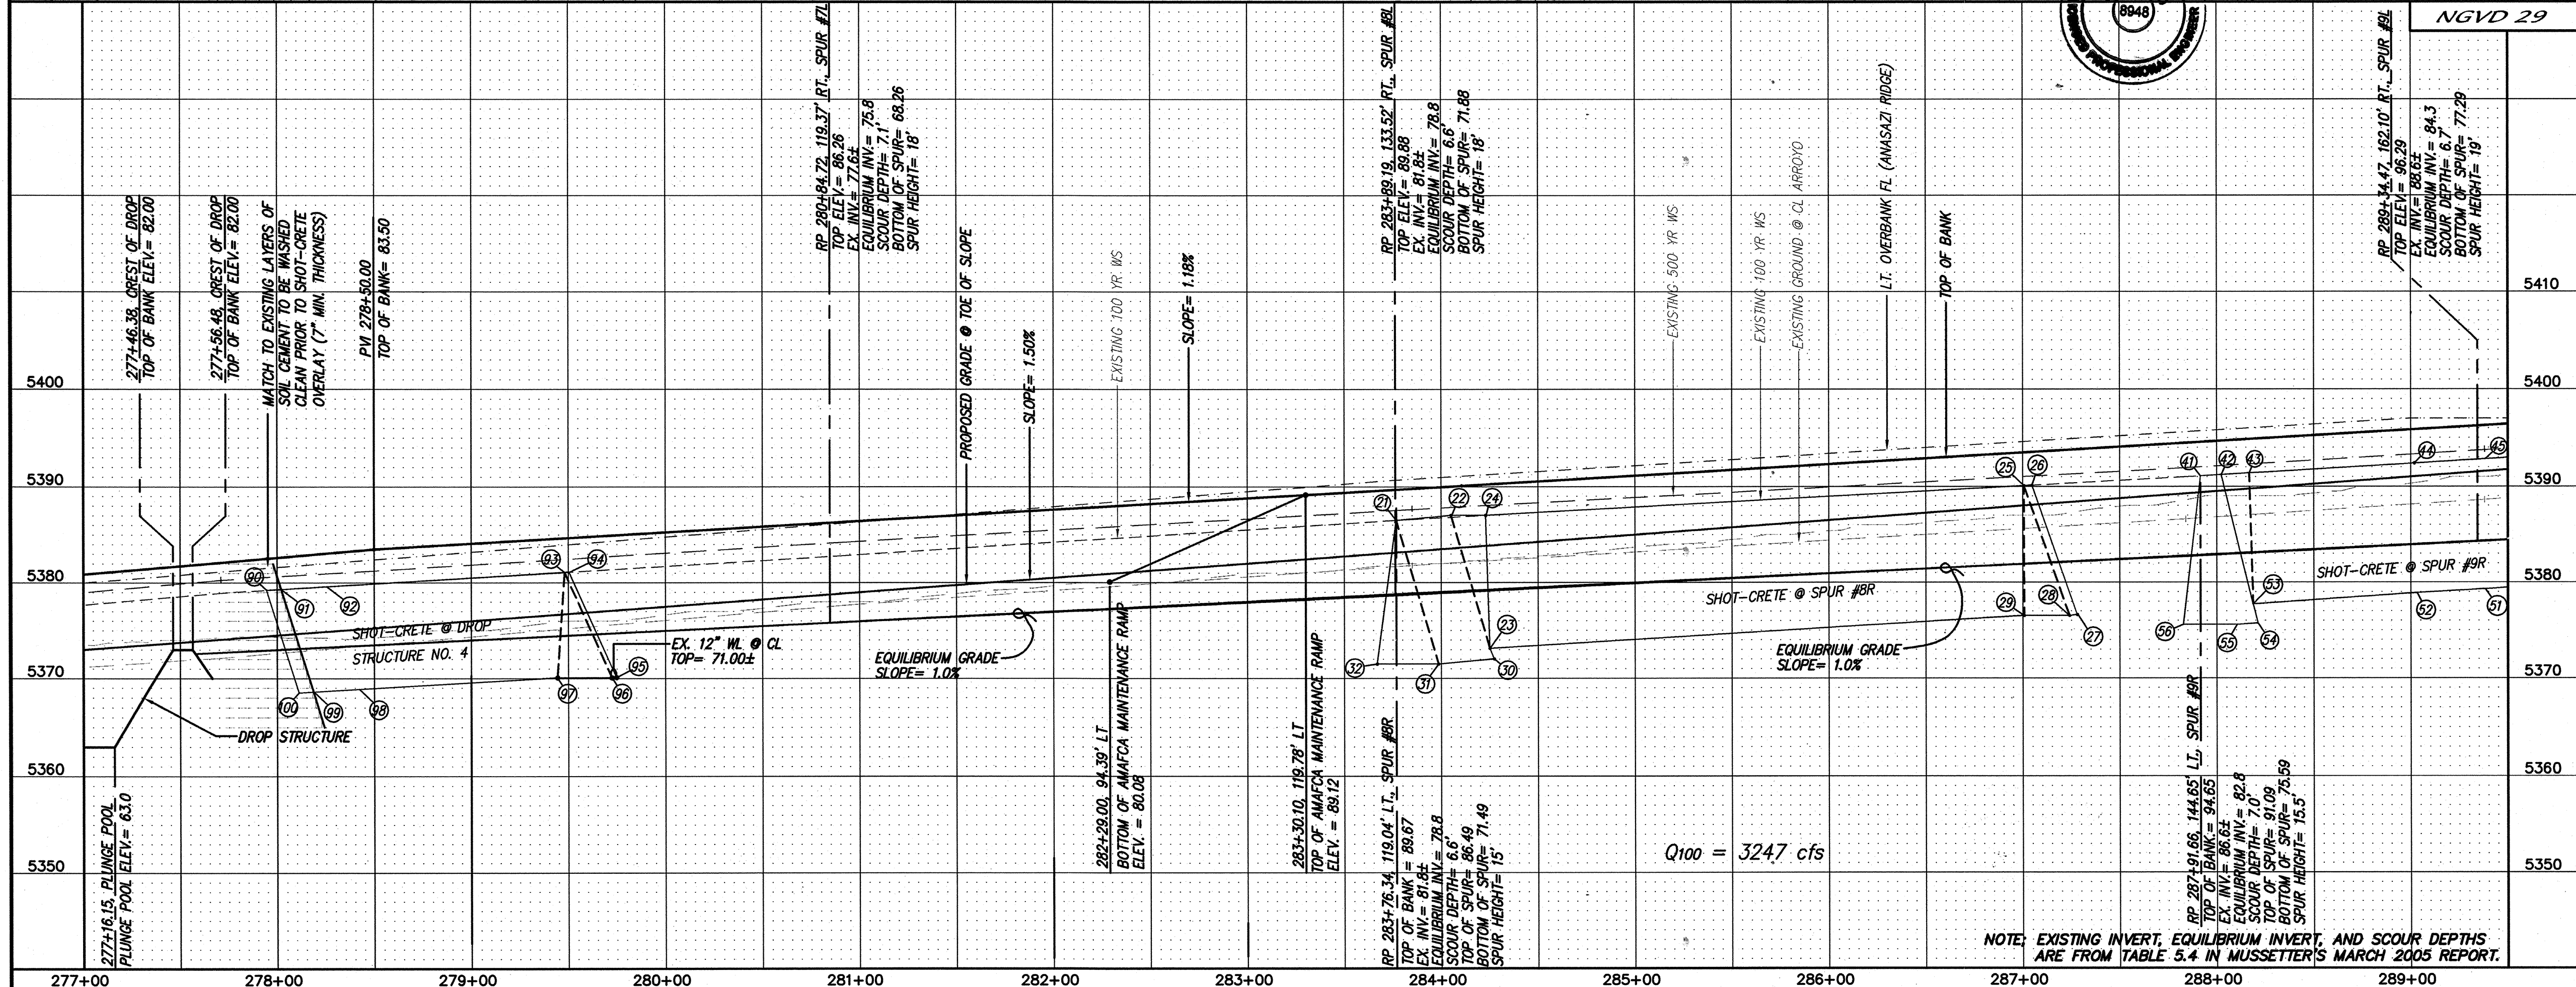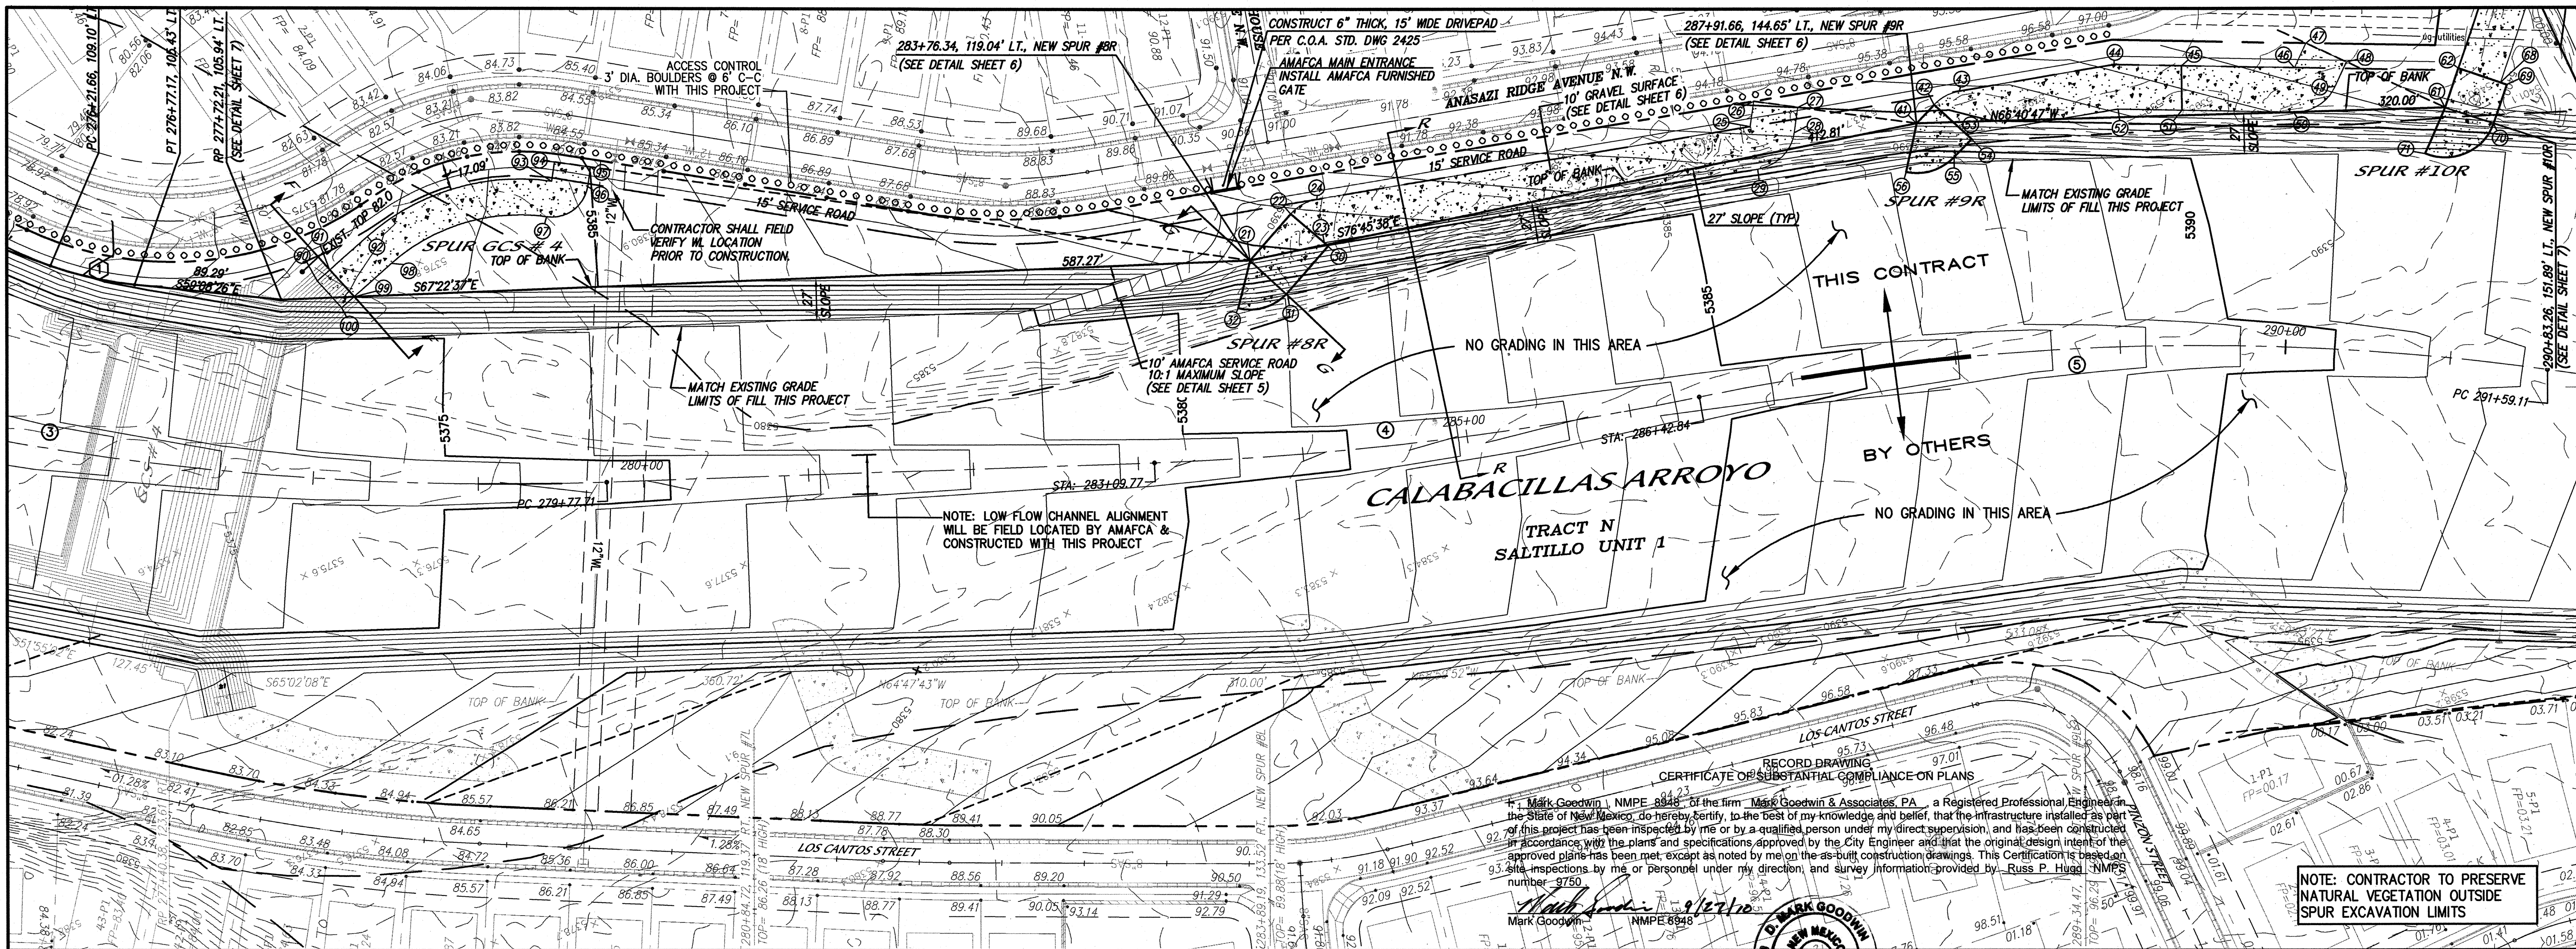

NOTES

1. ALL STATIONING IS BASED ON CENTERLINE OF CALABACILLAS ARROYO.

CURVE DATA - DESCRIBES CENTERLINE OF ARROYO

Station	L	R	Δ	Tan
③	L=713.16 R=1750.00 Δ=23°20'57"			Tan=361.60
④	L=333.07 R=2000.00 Δ=9°32'30"			Tan=166.92
⑤	L=516.28 R=1500.00 Δ=19°43'13"			Tan=260.72

CURVE DATA - DESCRIBES TOP OF BANK

Station	L	R	Δ	Tan
①	L=52.36 R=220.00 Δ=13°38'12"			Tan=26.30

SCALE: 1" = 50'

CALABACILLAS ARROYO
STA. 277+00.00 TO STA. 289+50.00
SCALE: HORIZ. 1" = 50'
VERT. 1" = 10'

MARK GOODWIN & ASSOCIATES, P.A.
CONSULTING ENGINEERS
P.O. BOX 90606
ALBUQUERQUE, NEW MEXICO 87199
(505) 828-2200, FAX (505) 797-9539

ALBUQUERQUE METROPOLITAN ARROYO FLOOD CONTROL AUTHORITY


TITLE: ANASAZI RIDGE ~ CALABACILLAS ARROYO CHANNEL IMPROVEMENTS SHOT-CRETE BANK PROTECTION

DESIGN REVIEW COMMITTEE CITY ENGINEER APPROVAL


LAST DESIGN UPDATE

CITY PROJECT NO. ZONE MAP NO. SHEET OF

AS BUILT INFORMATION				BENCH MARKS				SURVEY INFORMATION				ENGINEER'S SEAL			
CONTRACTOR	WORK	DATE	BY	CONTRACTOR	WORK	DATE	BY	NO.	DATE	BY	NO.	NO.	DATE	BY	NO.
INSPECTOR'S	ACCEPTANCE	DATE	BY	INSPECTOR'S	ACCEPTANCE	DATE	BY	NO.	DATE	BY	NO.	NO.	DATE	BY	NO.
DRAWINGS	DATE	BY	NO.	DRAWINGS	DATE	BY	NO.	NO.	DATE	BY	NO.	NO.	DATE	BY	NO.
MICRO-FILM	DATE	BY	NO.	MICRO-FILM	DATE	BY	NO.	NO.	DATE	BY	NO.	NO.	DATE	BY	NO.
RECORDED	DATE	BY	NO.	RECORDED	DATE	BY	NO.	NO.	DATE	BY	NO.	NO.	DATE	BY	NO.

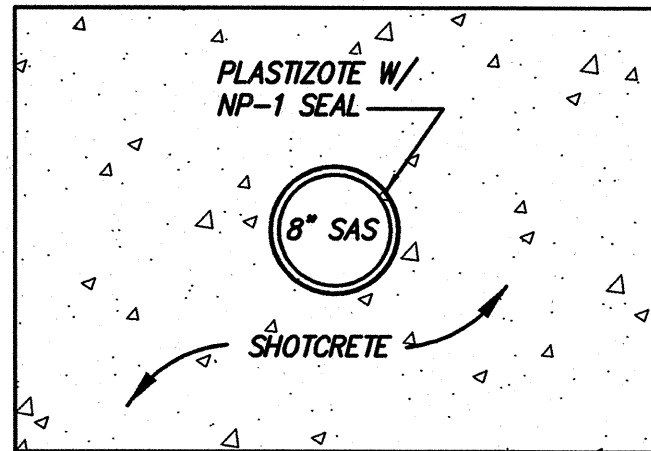


SAS PENETRATION DETAIL
N.T.S.

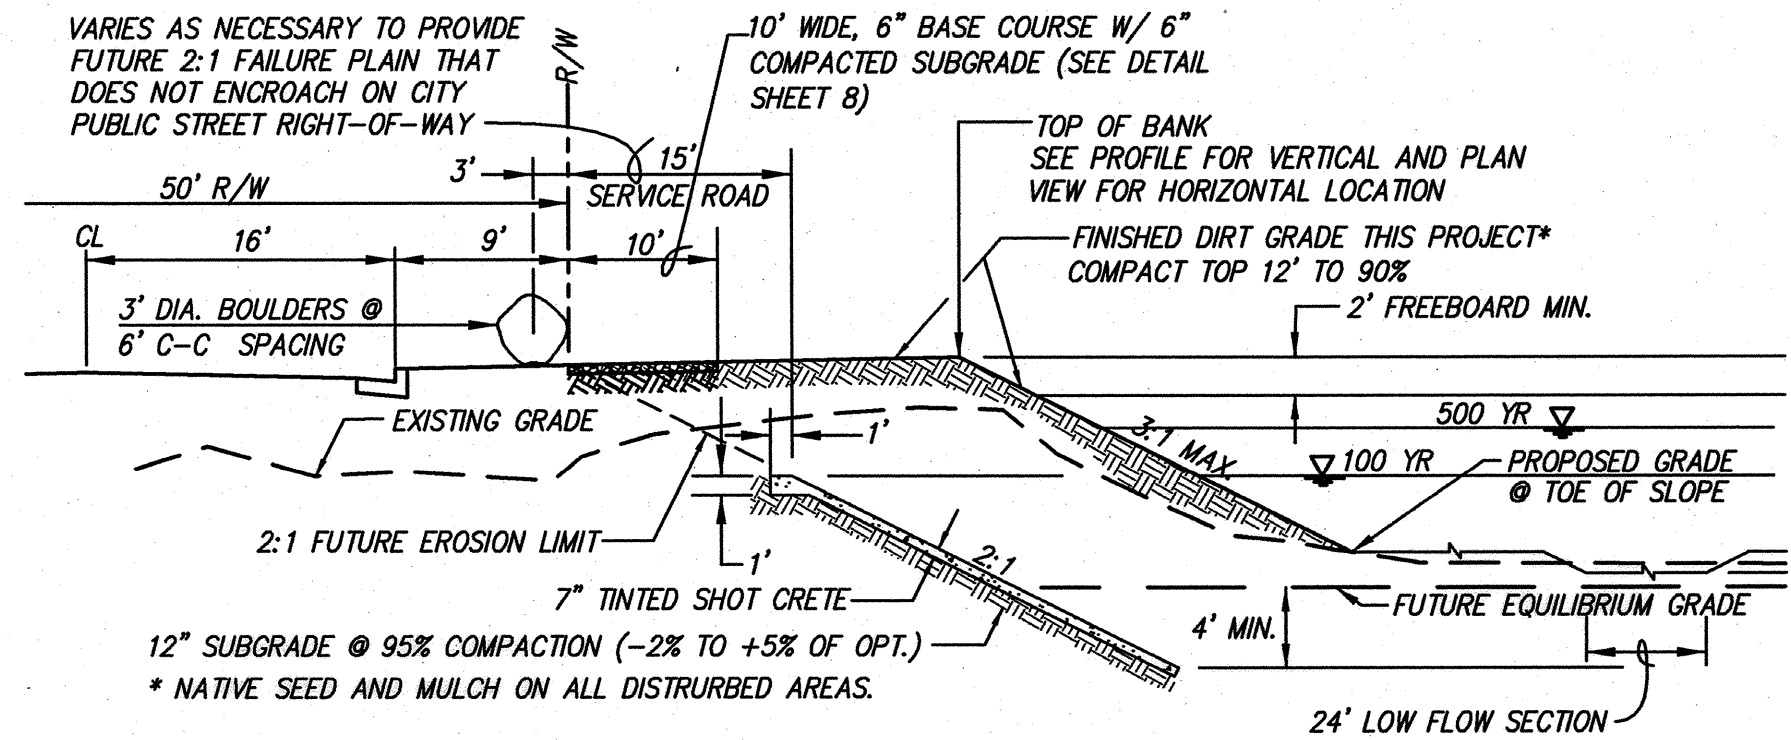







SECTION R-R
N.T.S.

NOTE: CONTRACTOR TO
CALL FOR DRY UTILITY
LINE LOCATION PRIOR
TO EXCAVATION

NOTE: CONTRACTOR SHALL
PRESERVE NATURAL VEGETATION
OUTSIDE SPUR EXCAVATION LIMITS

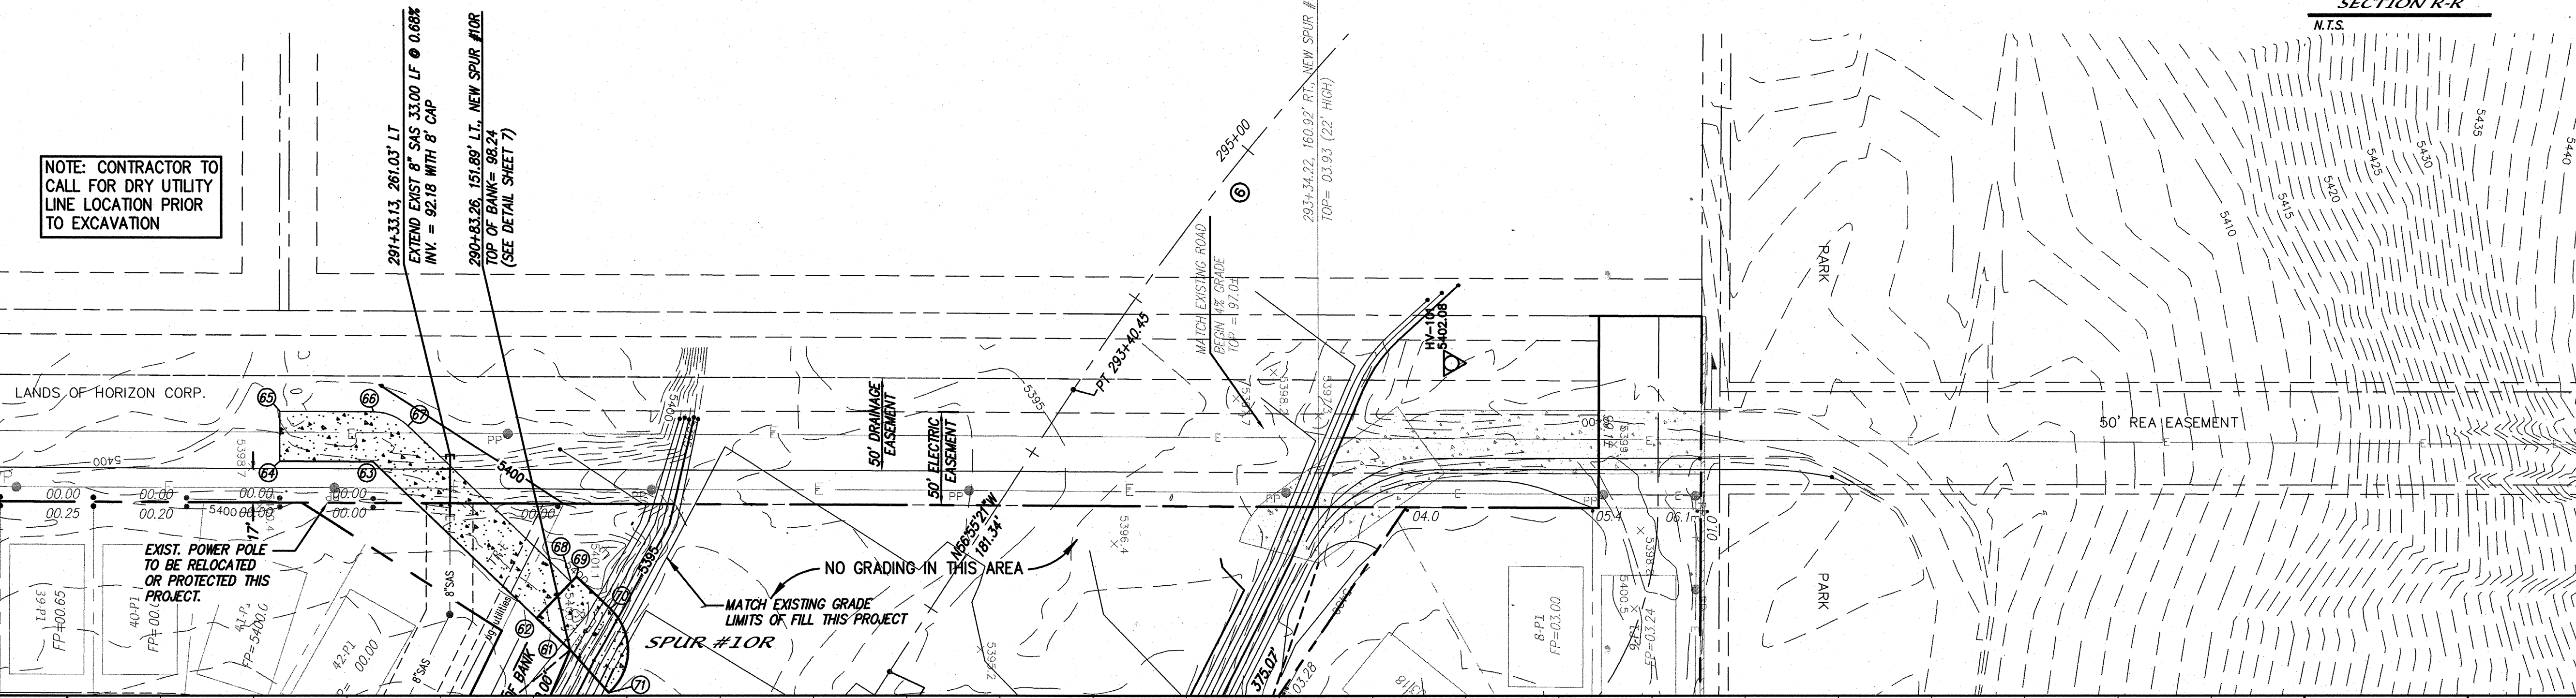

		LOT 1-P1 BLK 1		LOT 2-P1 BLK 1		LOT 3-P1 BLK 1		LOT 4-P1 BLK 1		LOT 594-P1 BLK 1		LOT	
--	--	-------------------	--	-------------------	--	-------------------	--	-------------------	--	-------------------	--	-------------------	--	-------------------	--	-------------------	--	-------------------	--	--------------------	--	--------------------	--	---------------------	--	---------------------	--	-----	--

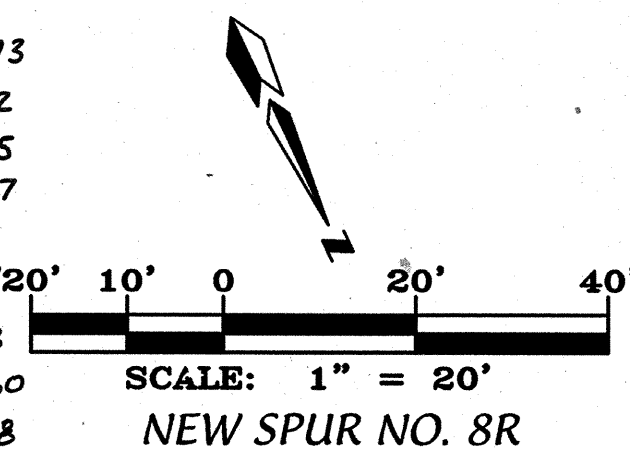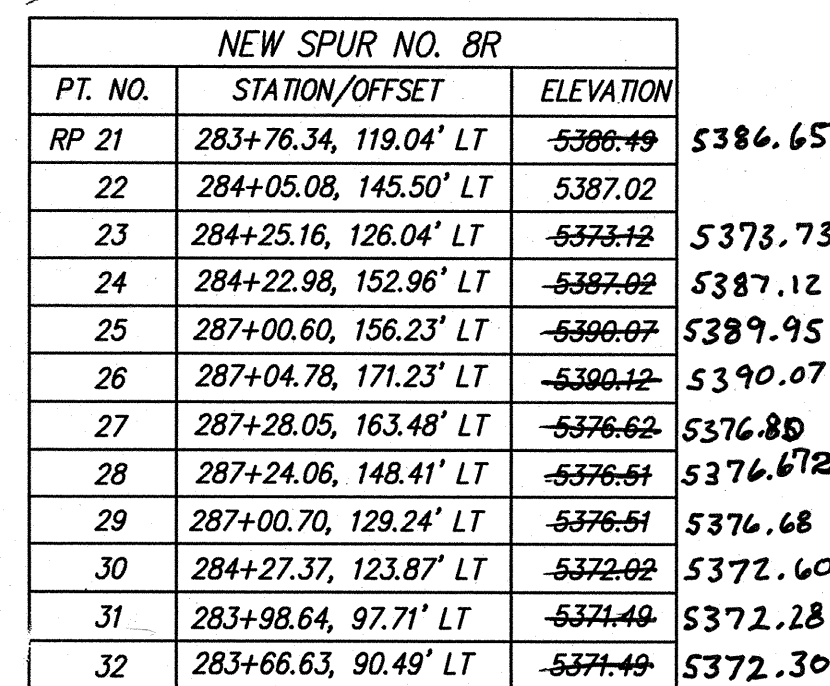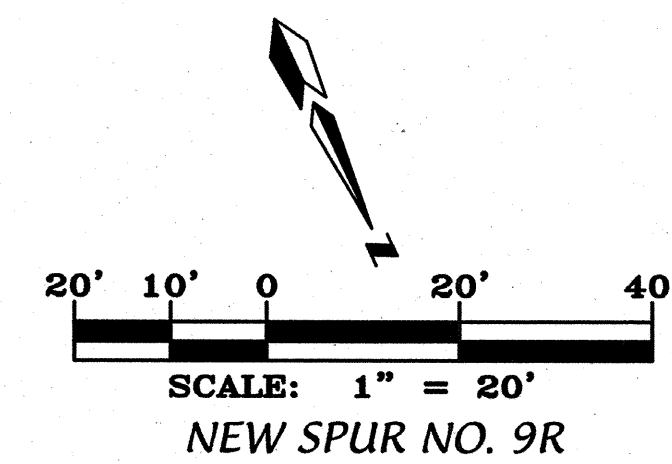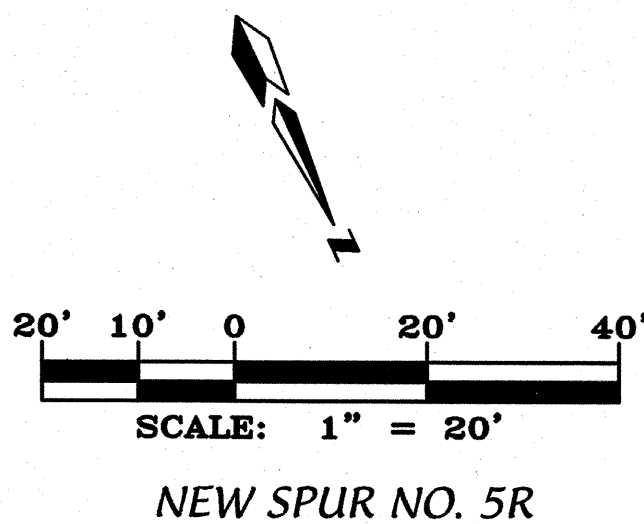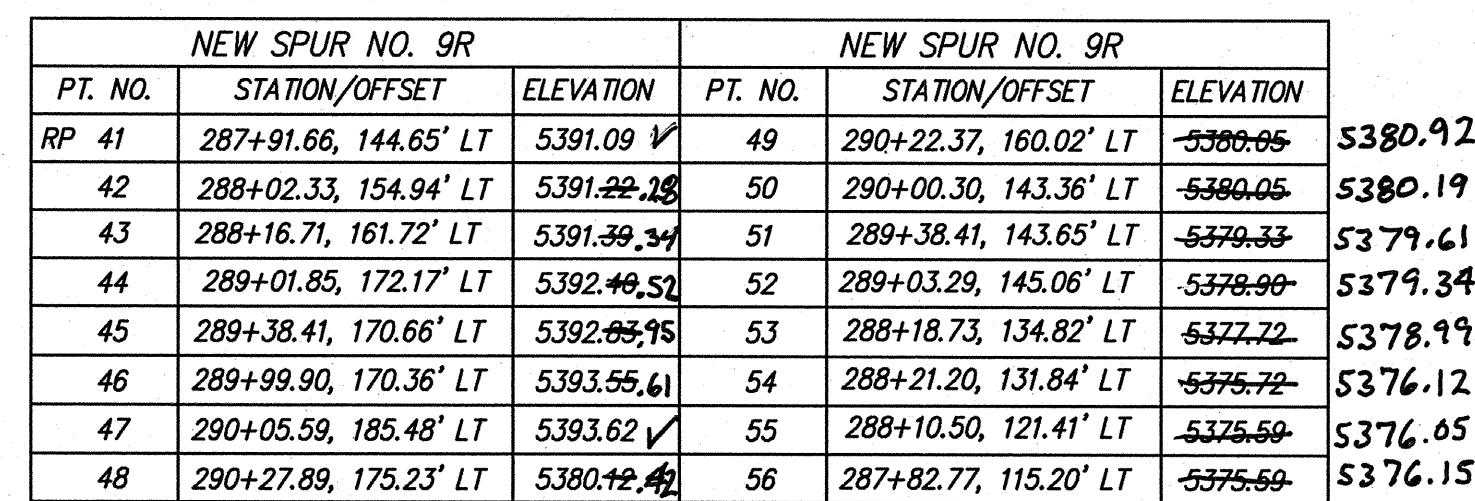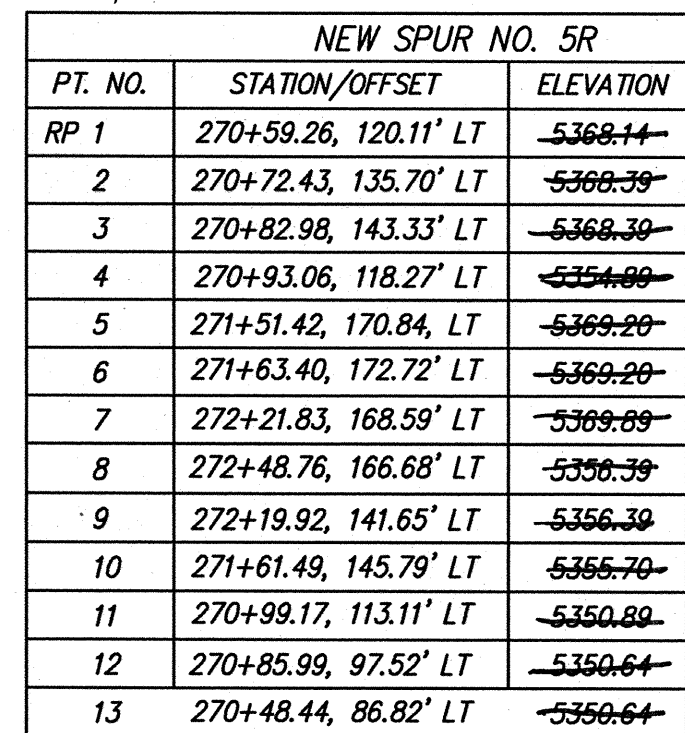


A3030PH5/CALABACILLAS ARROYO PLANS 2/Calabacillas-Anasazi.dwg/12-16-08/ RDQ

[illegible]

RECORD DRAWING
CERTIFICATE OF SUBSTANTIAL COMPLIANCE ON PLANS

I, Mark Goodwin, NMPE 8948, of the firm Mark Goodwin & Associates, PA a Registered Professional Engineer in the State of New Mexico, do hereby certify, to the best of my knowledge and belief, that the infrastructure installed as part of this project has been inspected by me or by a qualified person under my direct supervision, and has been constructed in accordance with the plans and specifications approved by the City Engineer and that the original design intent of the approved plans has been met, except as noted by me on the as-built construction drawings. This Certification is based on site inspections by me or personnel under my direction, and survey information provided by Russ P. Hugg NMPS number 97567.


Mark Goodwin 9/17/17
Mark Goodwin NMPE 8948

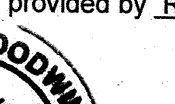



 MARK GOODWIN & ASSOCIATES, P.A.
CONSULTING ENGINEERS
P.O. BOX 90606
ALBUQUERQUE, NEW MEXICO 87199
(505) 828-2200, FAX (505) 797-9539

	ALBUQUERQUE METROPOLITAN ARROYO FLOOD CONTROL AUTHORITY	
	TITLE: ANASAZI RIDGE SUBDIVISION CALABACILLAS ARROYO IMPROVEMENTS SHOT-CRETE BANK PROTECTION	



DESIGN REVIEW COMMITTEE	CITY ENGINEER APPROVAL	LAST DESIGN UPDATE	MO./DAY/YR.	MO./DAY/YR.
CITY PROJECT NO.	ZONE MAP NO.	SHEET	OF	
	A-10	6	9	

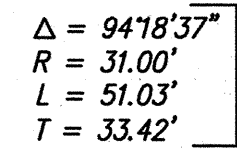

291+33.13, 261.03' LT
EXTEND EXIST 8" SAS
33.00 LF @ 0.68%
INV. = 92.18
WITH 8' CAP

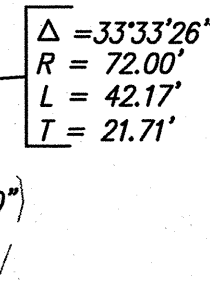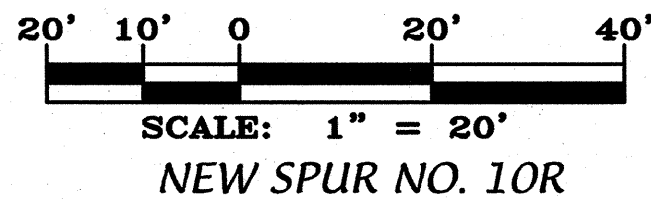

NEW SPUR NO. 4R				AB
PT. NO.	STATION/OFFSET	ELEVATION	COMMENT	
88	267+73.86, 121.15' LT	5364.58	MATCH EXISTING	
89	267+89.63, 121.17' LT	5364.58	MATCH EXISTING	5364.66
90	268+29.50, 122.99' LT	5366.45	TOP OF SHOT-CRETE	5366.79
91	268+30.21, 126.05' LT	5366.45	TOP OF SHOT-CRETE	5366.87
92	268+39.76, 169.40' LT	5366.67	TOP OF SHOT-CRETE	5366.99
93	268+32.26, 92.46' LT	5355.58	TOP OF SHOT-CRETE	20
94	268+37.78, 77.69' LT	5349.58	BOTTOM OF SHOT-CRETE	5350.66

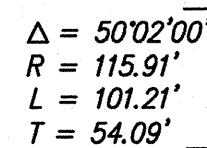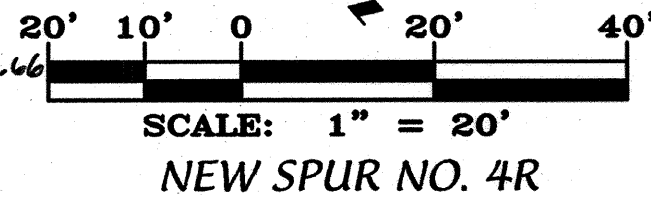

RECORD DRAWING
CERTIFICATE OF SUBSTANTIAL COMPLIANCE ON PLANS


I, Mark Goodwin, NMPE 8948, of the firm Mark Goodwin & Associates, PA, a Registered Professional Engineer in the State of New Mexico, do hereby certify, to the best of my knowledge and belief, that the infrastructure installed as part of this project has been inspected by me or by a qualified person under my direct supervision, and has been constructed in accordance with the plans and specifications approved by the City Engineer and that the original design intent of the approval plans has been met, except as noted by me on the as-built construction drawings. This Certification is based on site inspections by me or personnel under my direction, and survey information provided by Russ P. Hugg, NMPS number 9750.

Mark Goodwin 9/27/10
Mark Goodwin NMPE 8948




NGVD 29


MARK GOODWIN & ASSOCIATES, P.A.
CONSULTING ENGINEERS
P.O. BOX 90606
ALBUQUERQUE, NEW MEXICO 87199
(505) 828-2200, FAX (505) 797-5959

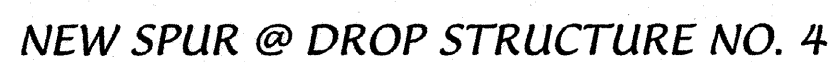


ENGINEER'S SEAL						SURVEY INFORMATION			BENCH MARKS		AS BUILT INFORMATION	
						FIELD NOTES						
						NO.	BY	DATE				
						ALBUQUERQUE TO REACH STATION FROM INTERSECTION OF CENTRAL AVE. & COORS RD. GO N. ON COORS 7.6 MI. TO THE INTERSECTION WITH PARADISE BLVD., THEN NW ON PARADISE 1.1 MI. TO GOLF COURSE RD., THEN NE ON GOLF COURSE 1.3 MI. TO JUNCTION WITH AGUAHON BLVD., THEN NW ON AGUAHON 2.25 MI. STATION IS LOCATED 600 FT SOUTH OF THIS POINT. STATION IS STD. USC&GS BRASS TABLET STAMPED "SANDBERY 1969" SET IN CONC. POST X=361,654.29 Y= 1,534,208.29 (NAD 27) ELEV= 5456.92 (NGVD 29)						
						MICRO-FILM INFORMATION RECORDED BY NO.						
						DESIGNED BY JDH DATE 07/06 DRAWN BY RDC DATE 07/06 CHECKED BY DMG DATE 07/06						

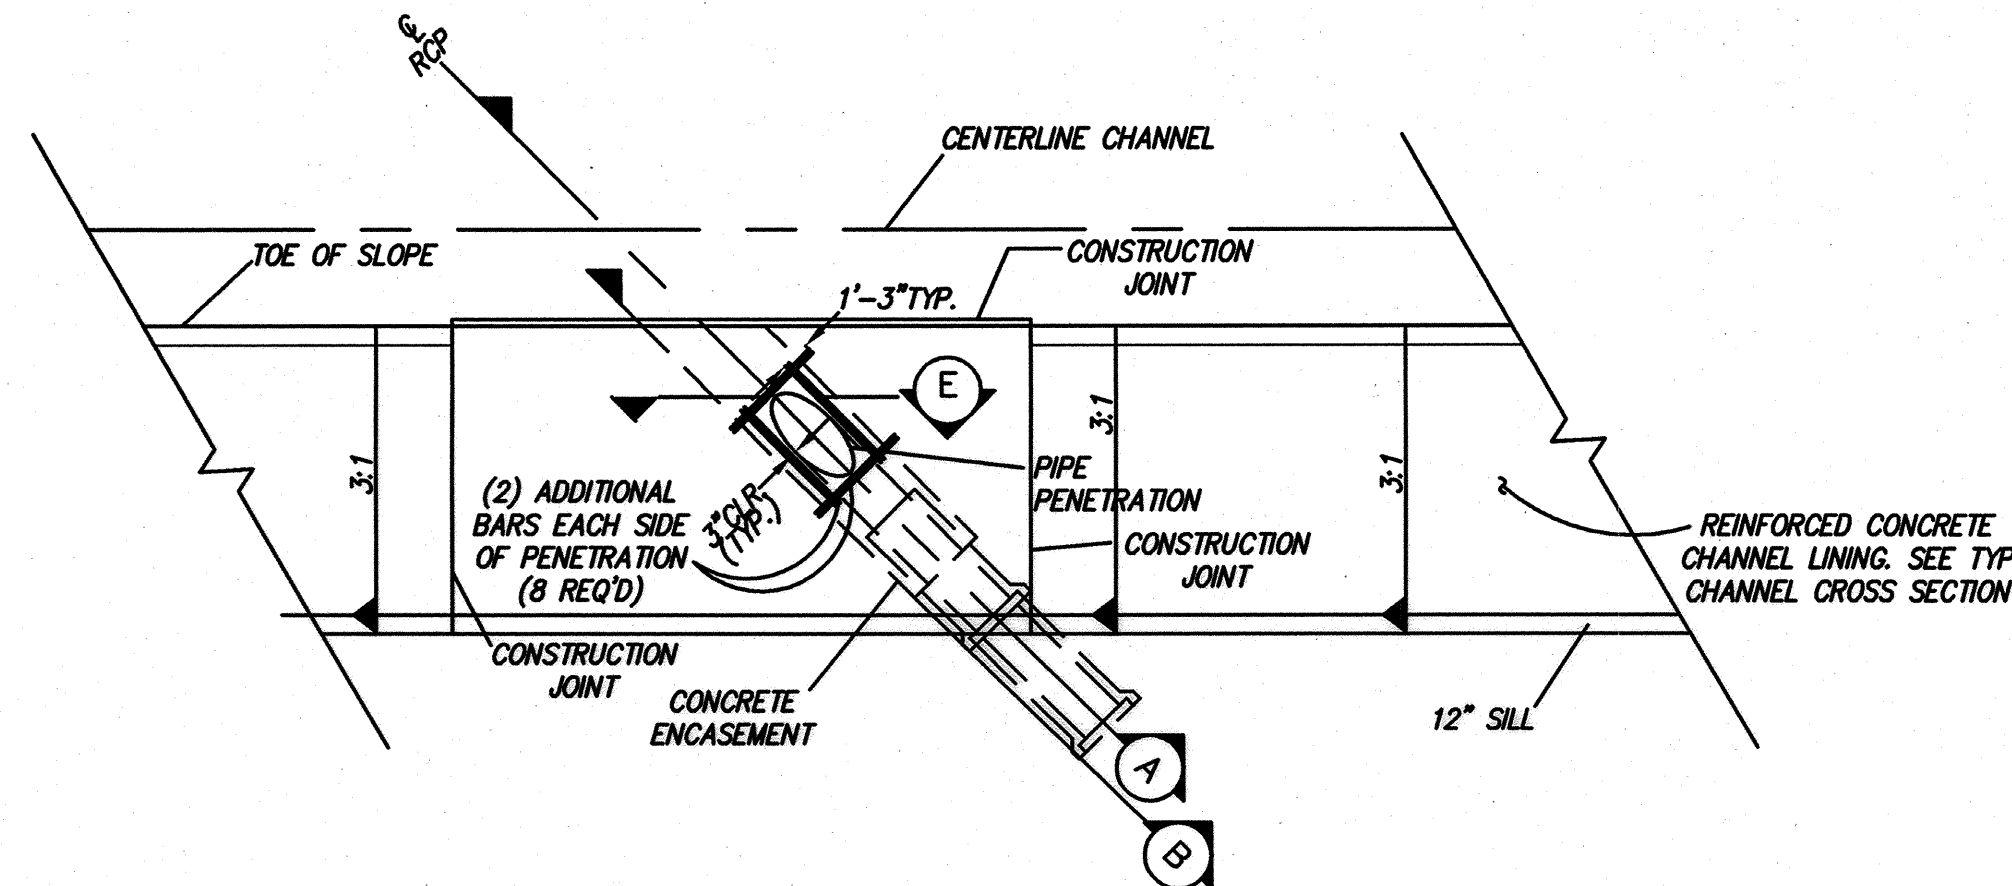

TYPICAL PIPE PENETRATION (PLAN VIEW)
N.T.S.

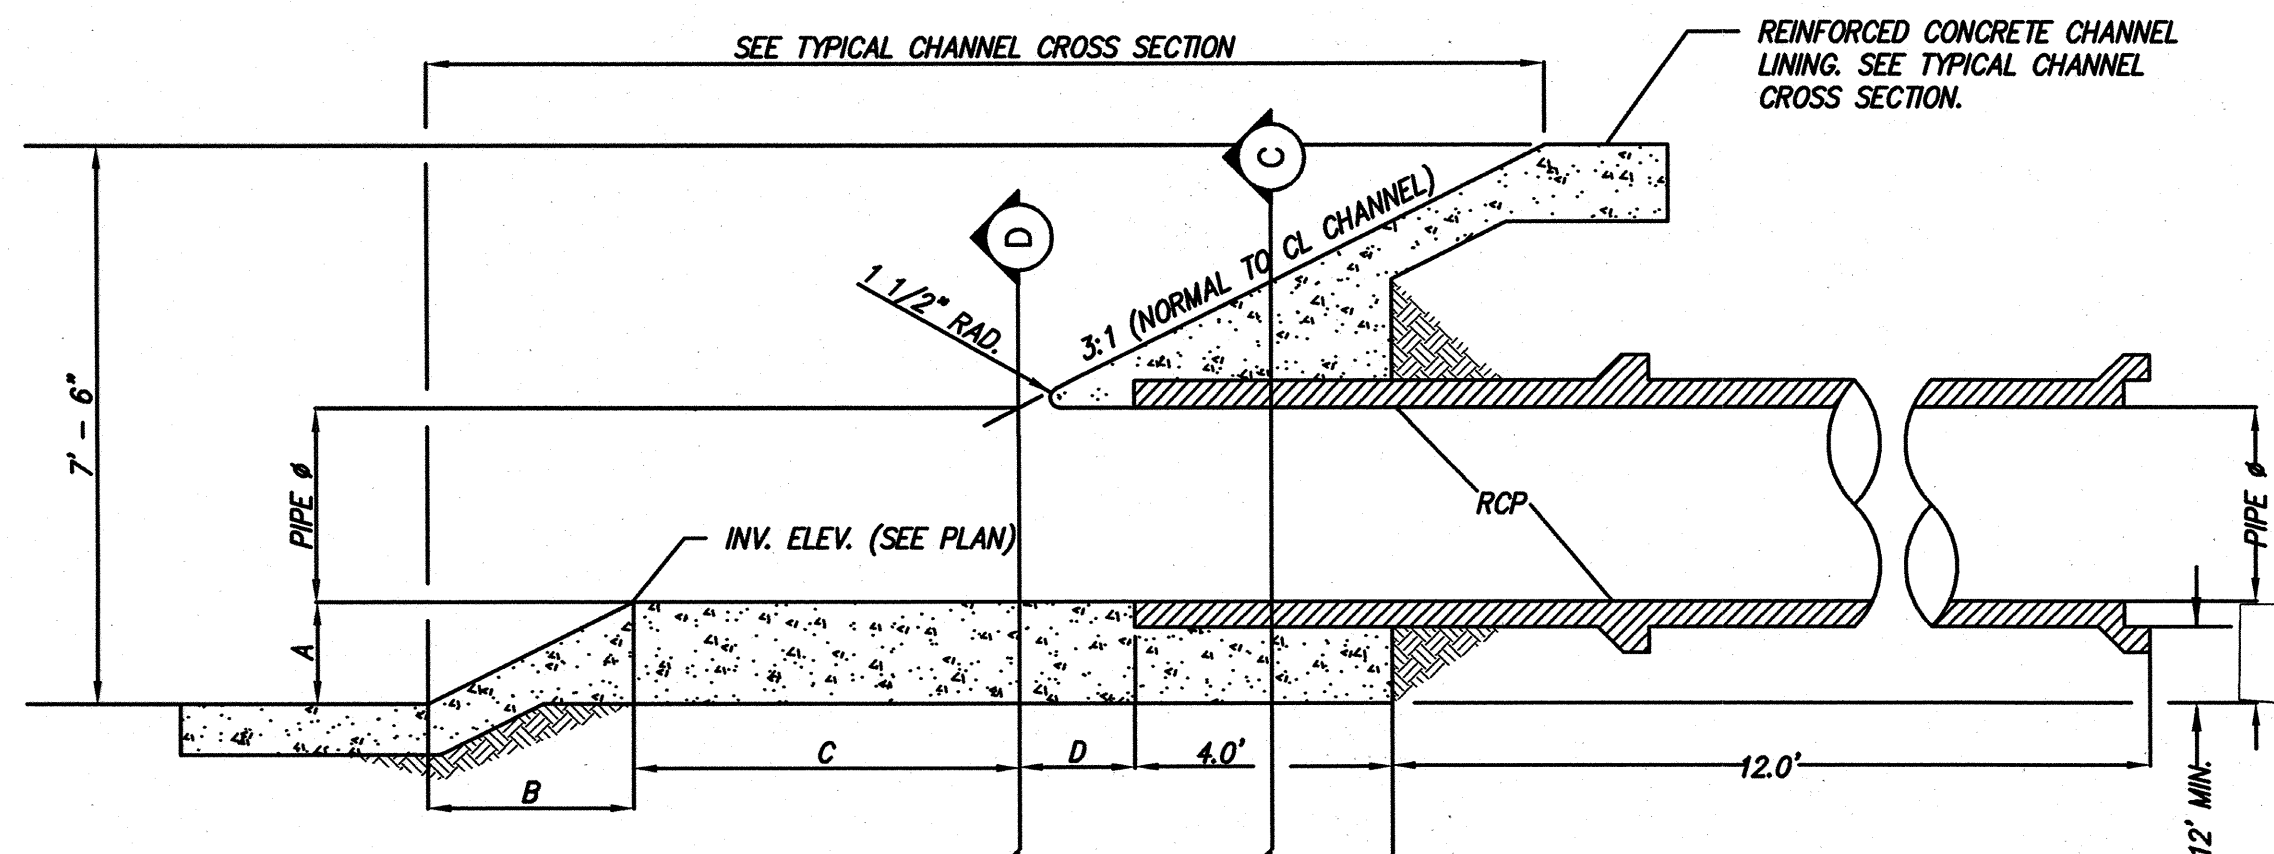

SECTION A - A
N.T.S.

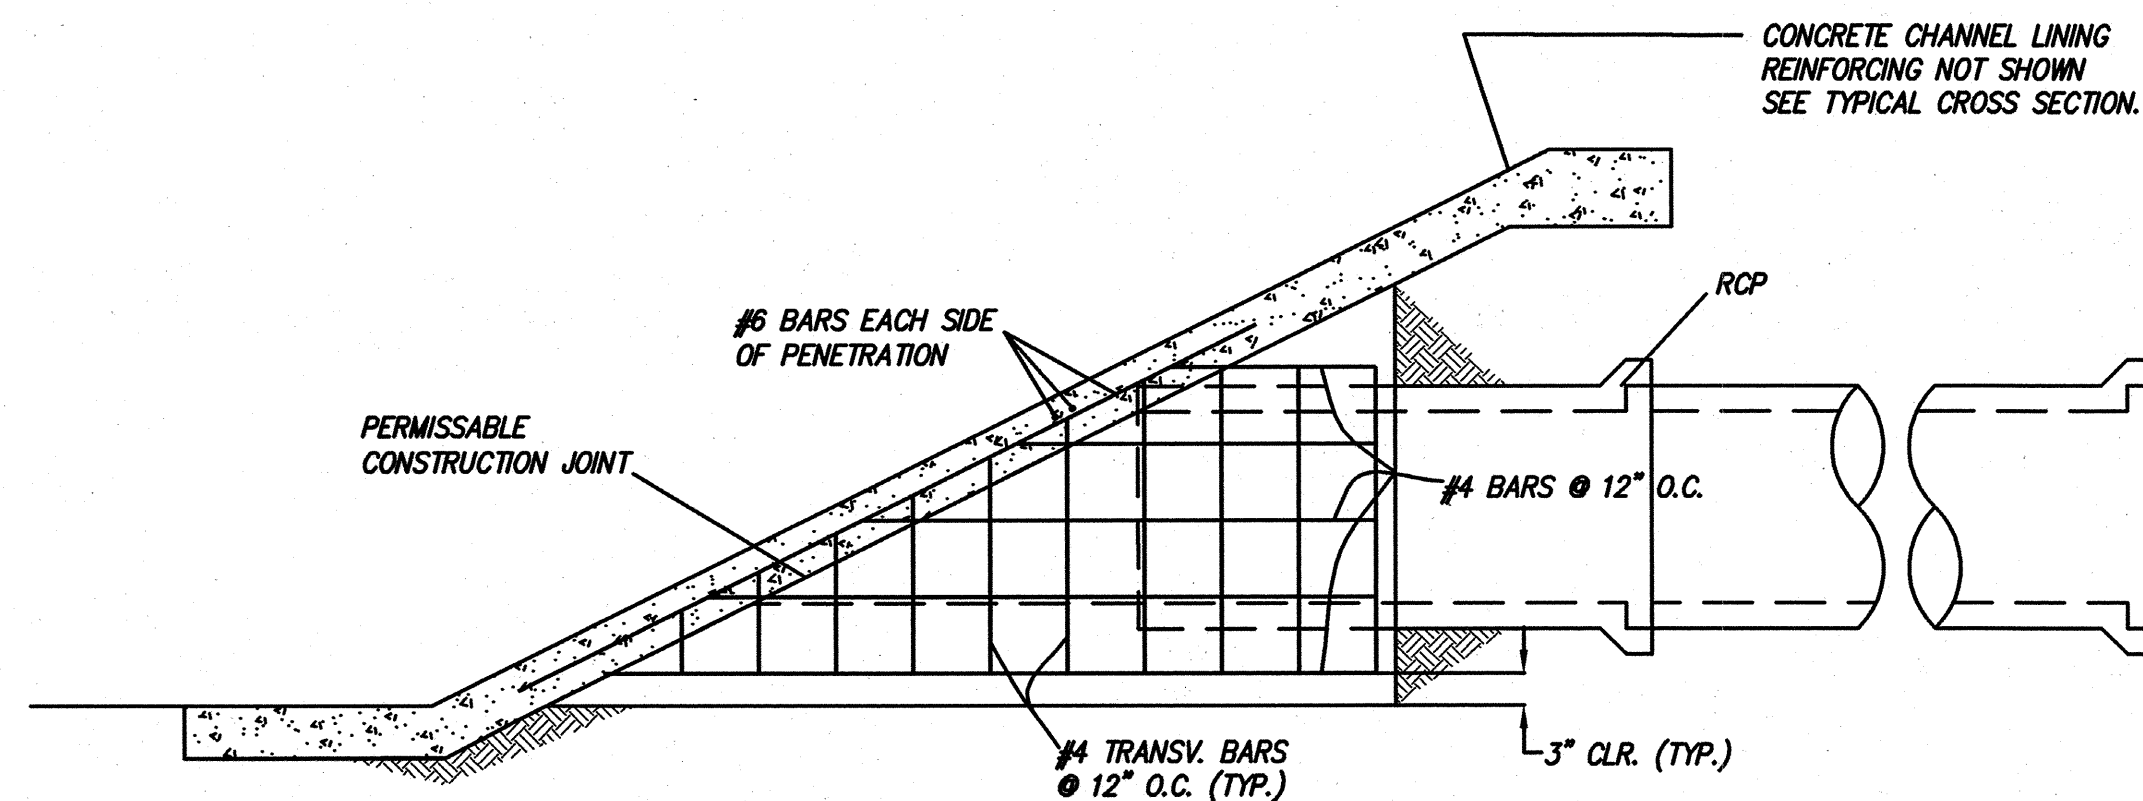


SECTION B - B
N.T.S.


TABLE OF DIMENSIONS					
PIPE DIAMETER	SKEW	CHANNEL DEPTH	B	C	D
4.5	30°	20"	N/A	15.6	3.0
4.0	30°	20"	N/A	13.85	3.0
FEET	DEGREES	FEET	FEET	FEET	FEET

NOTES


1. THE PIPE PENETRATION DETAILED HEREIN SHALL BE PAID FOR UNDER PIPE PENETRATION, (EACH) AND SHALL BE COMPENSATED FOR THE PENETRATION COMPLETE AND IN PLACE, INCLUDED IN THIS WORK (BUT NOT LIMITED TO) IS GRADING, SUBGRADE PREPARATION, REINFORCED CONCRETE, CONSTRUCTION JOINTS, CONCRETE PLACEMENT, 16' OF PROPER SIZE RCP, CONNECTION WITH THIS PROJECT, BACKFILL, AND FINISHING. NOTE: THE MEASUREMENT FOR CONCRETE CHANNEL LINING IS CONTINUOUS AND UNINTERRUPTED AT THE PENETRATION LOCATION.
2. THE TYPICAL TRANSVERSE AND LONGITUDINAL REINFORCEMENT SHALL BE CONTINUOUS THRU THE CONSTRUCTION JOINT LAPPED BAR SPICES ADJACENT TO THE JOINT IS PERMITTED.
#8 BAR LAP = 4'-2"
#7 BAR LAP = 3'-2"
#5 BAR LAP = 2'-2"

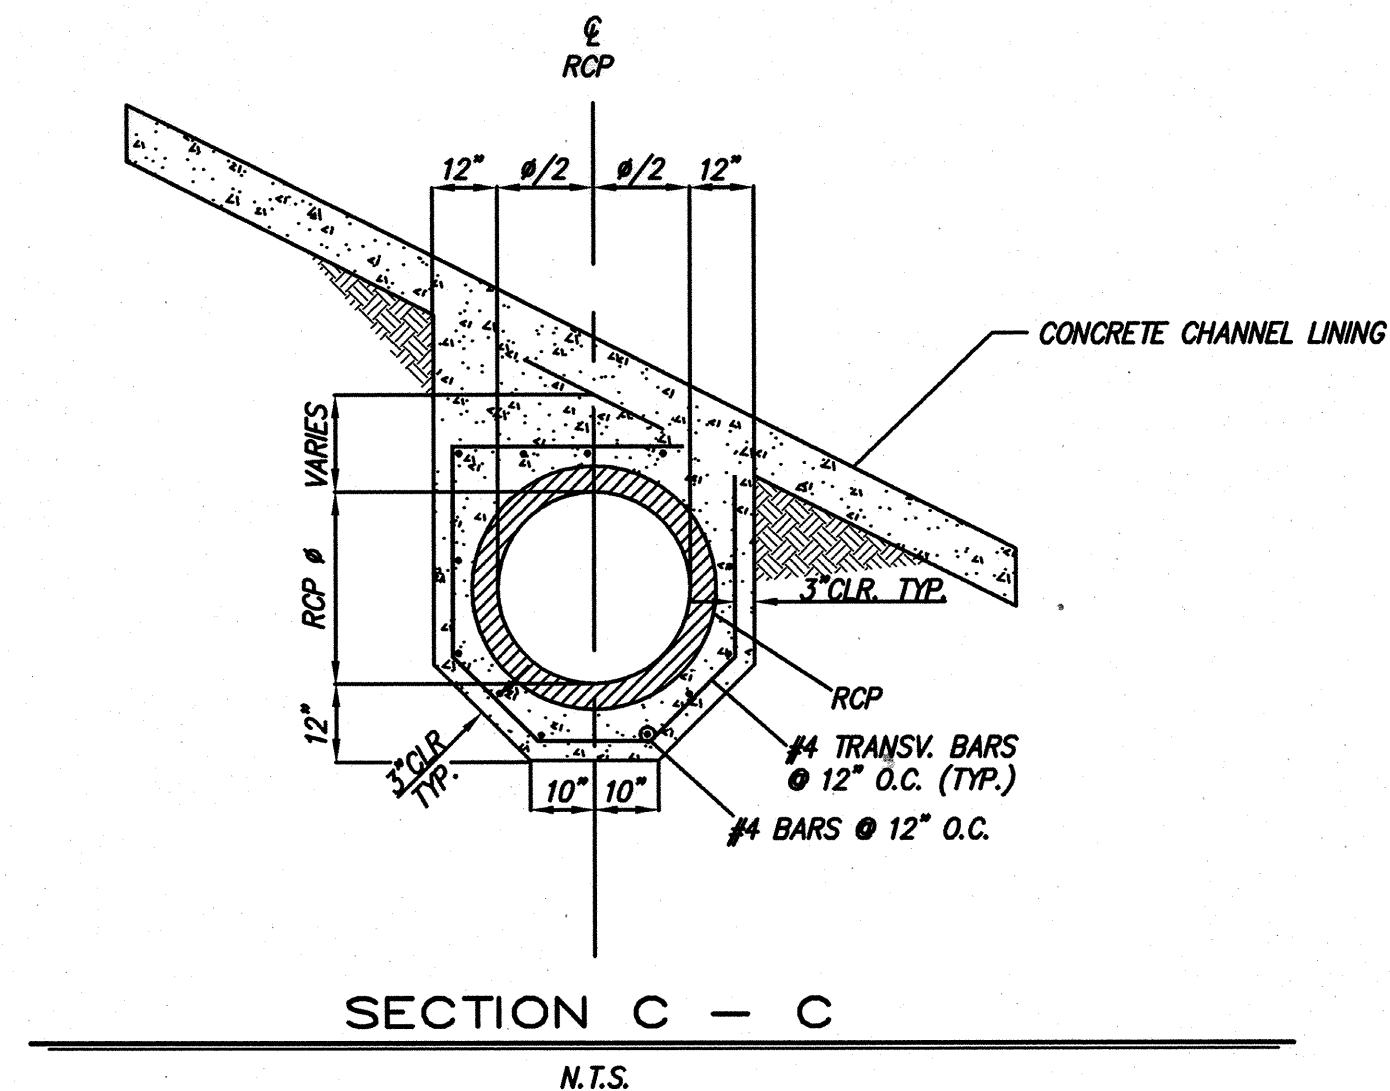


SECTION C - C
N.T.S.

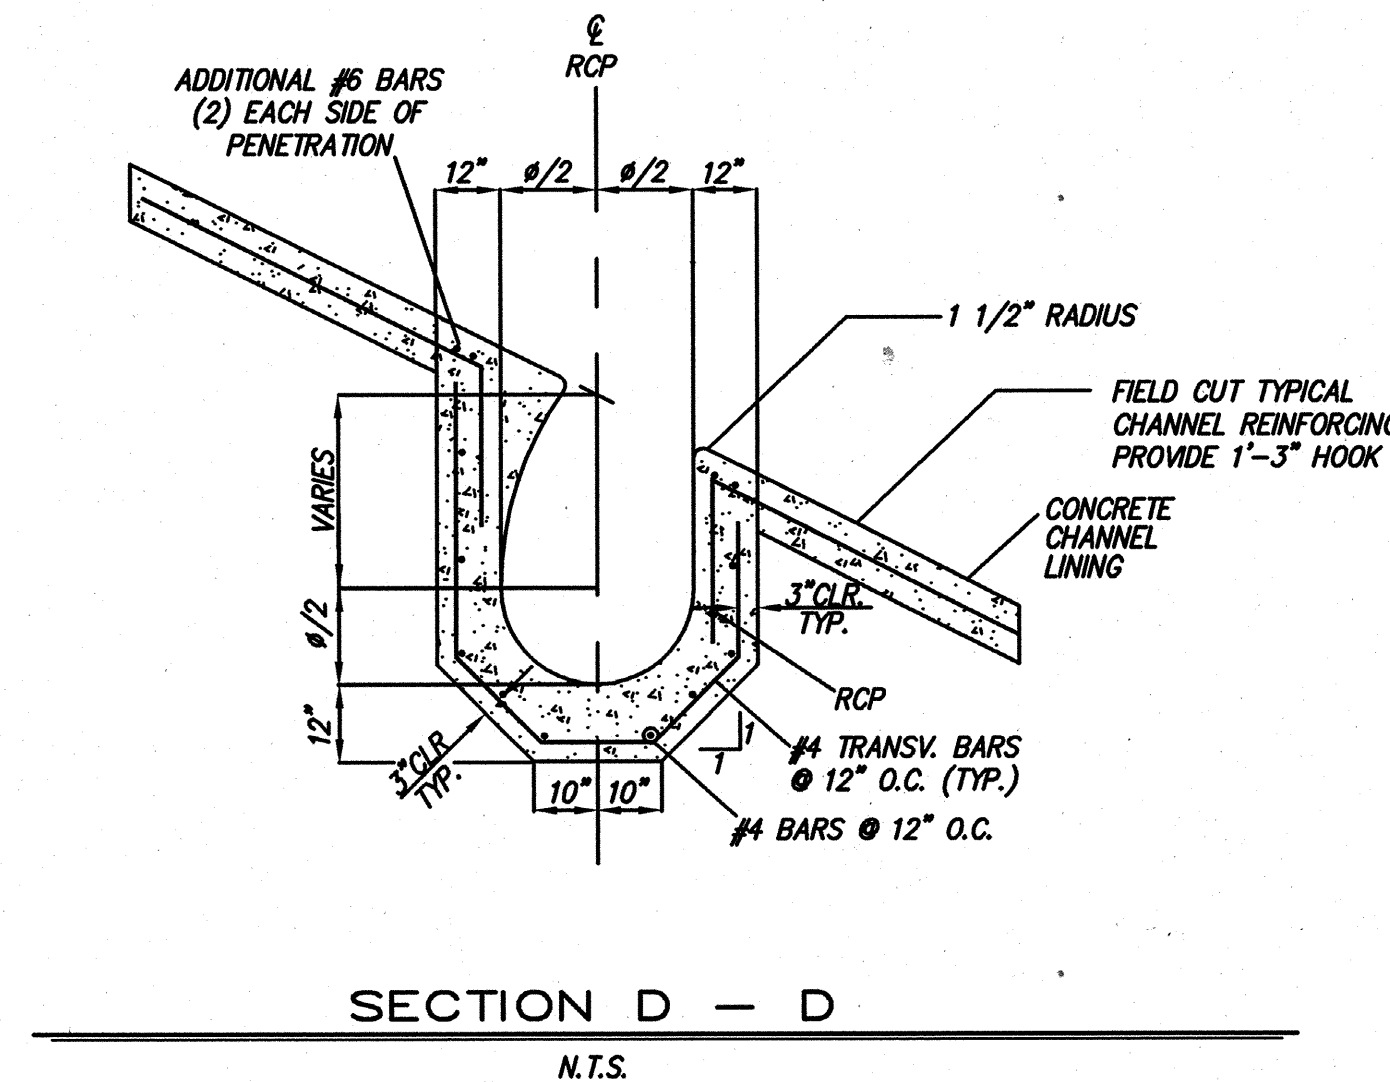


SECTION D - D
N.T.S.

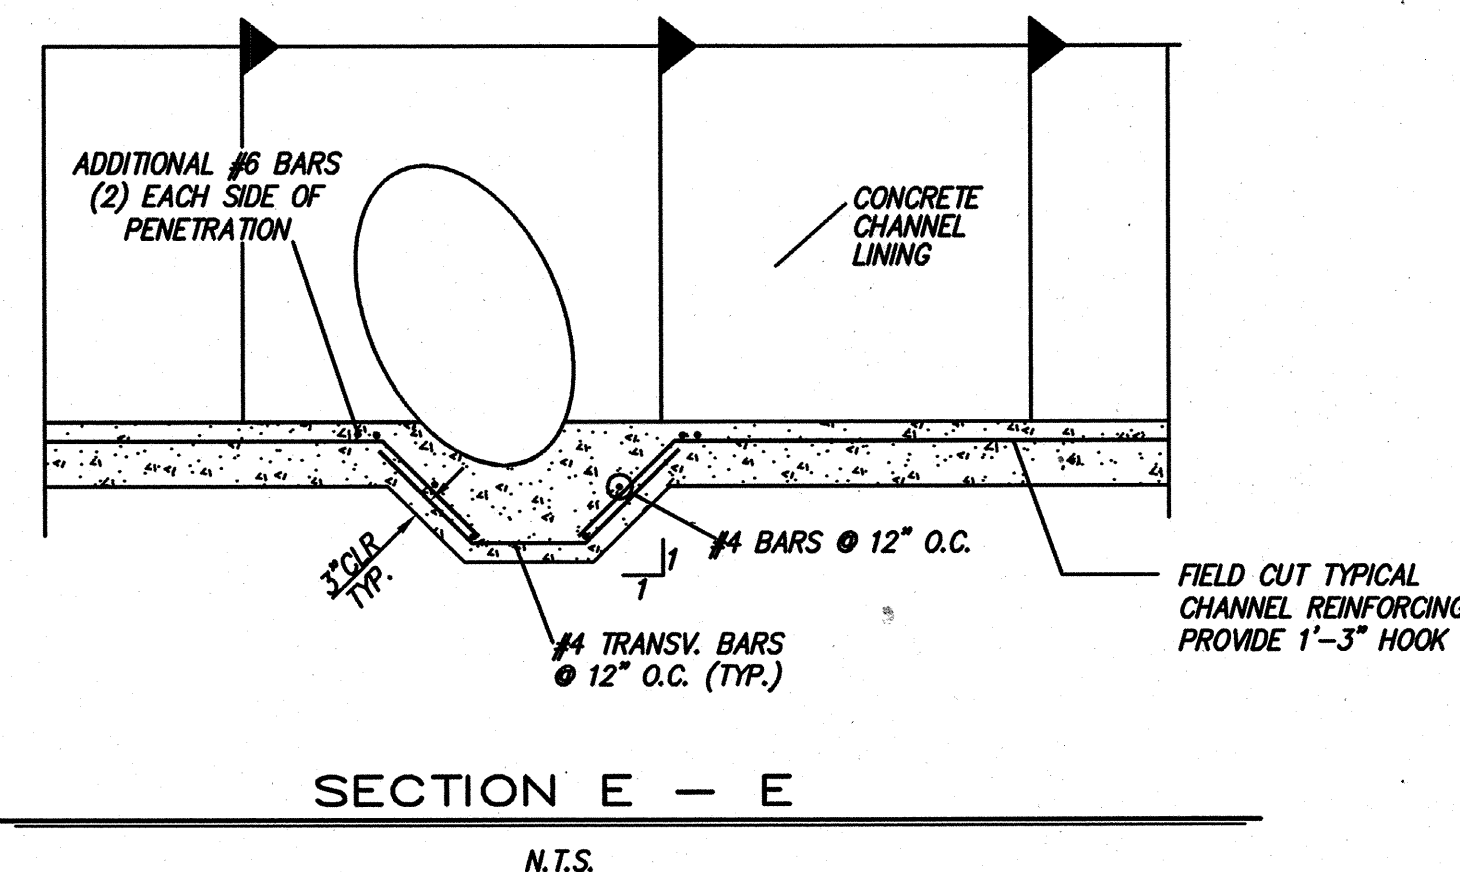


SECTION E - E
N.T.S.

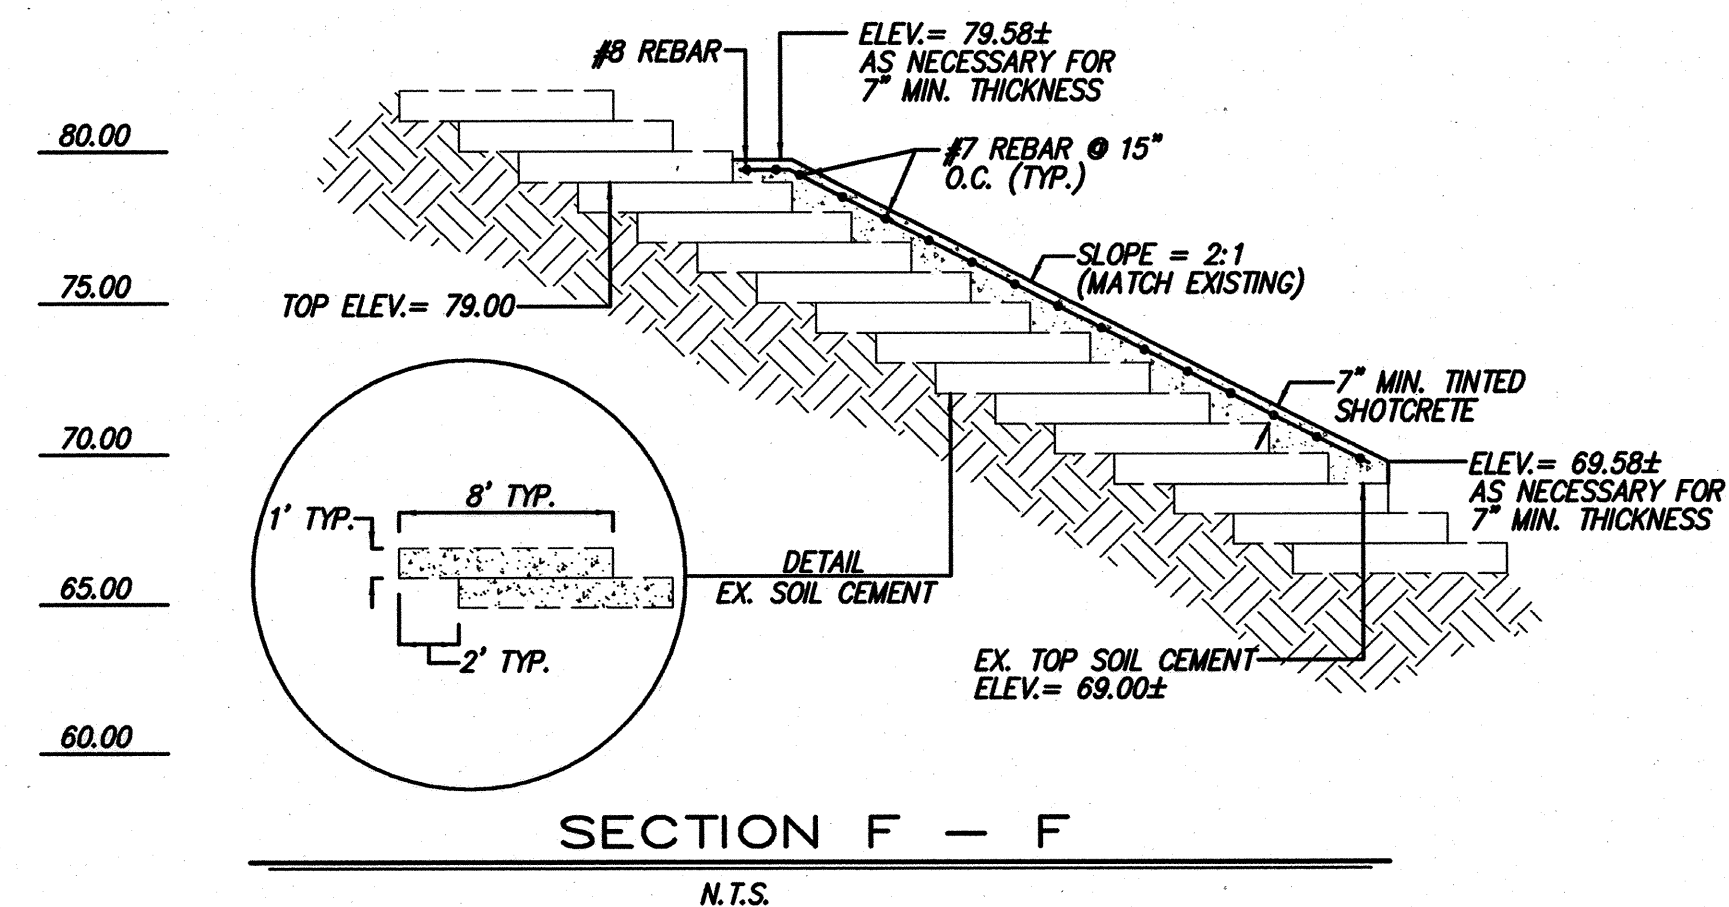


SECTION F - F
N.T.S.

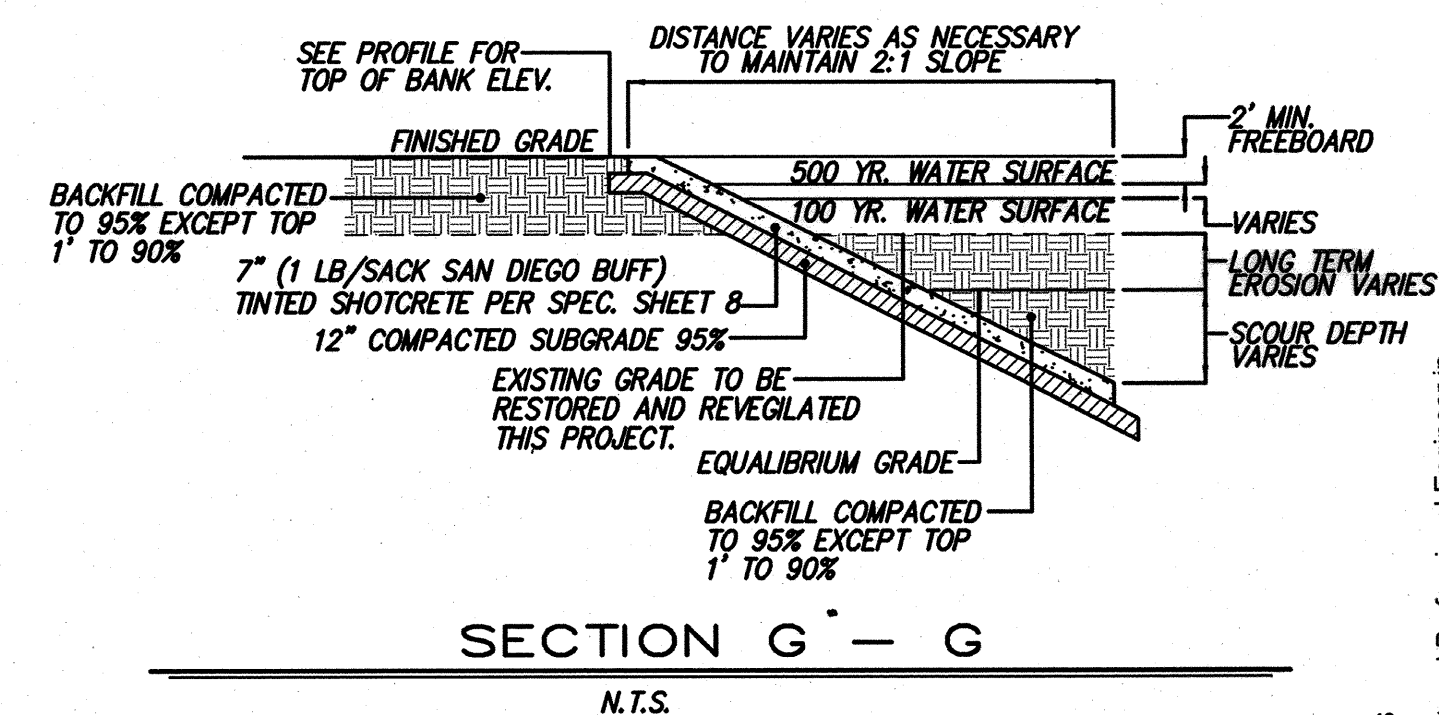

SECTION G - G
N.T.S.

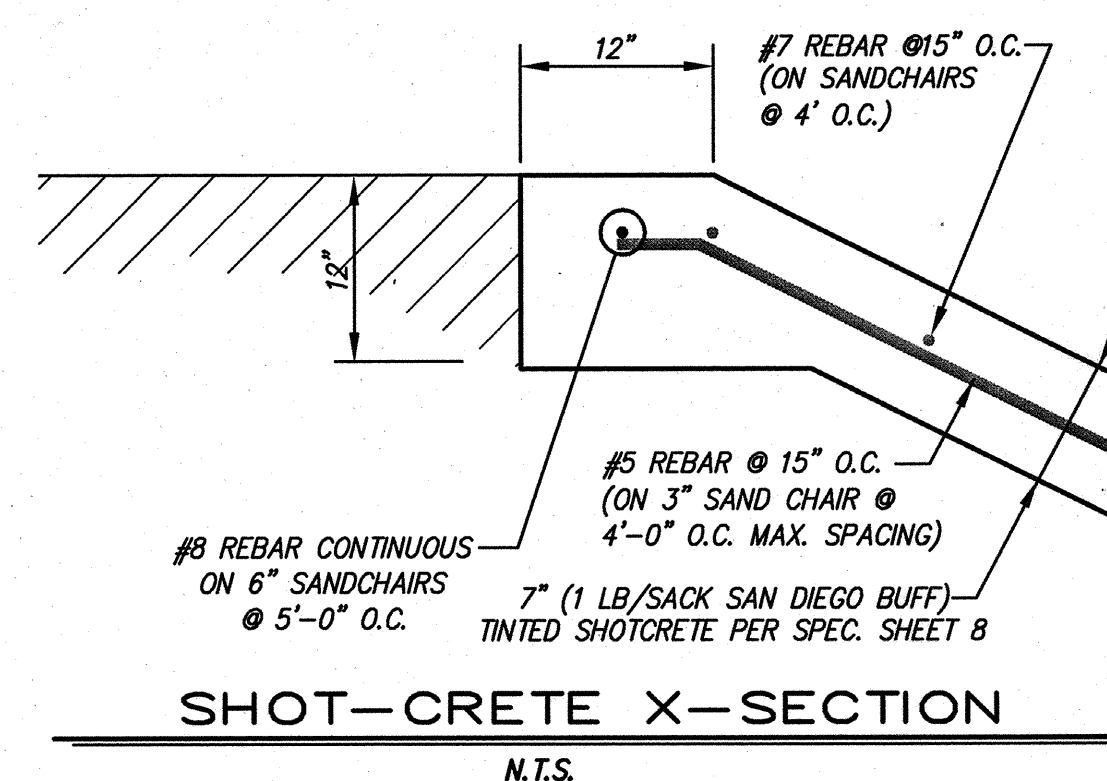


SHOT-CRETE X-SECTION
N.T.S.

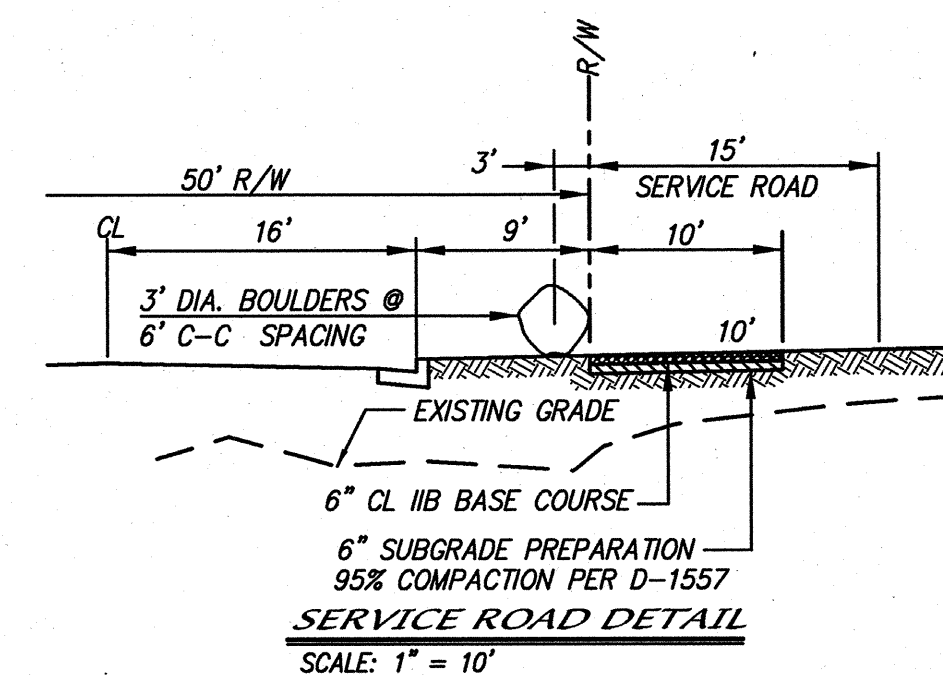

SERVICE ROAD DETAIL
SCALE: 1" = 10'

CERTIFICATE OF SUBSTANTIAL COMPLIANCE ON PLANS
I, Mark Goodwin, NMPE 8948, of the firm Mark Goodwin & Associates, P.A., a Registered Professional Engineer in the State of New Mexico, do hereby certify, to the best of my knowledge and belief, that the infrastructure installed as part of this project has been inspected by me or by a qualified person under my direct supervision, and has been constructed in accordance with the plans and specifications approved by the City Engineer. This Certification is based on the site inspection and the information provided by the contractor. I am not responsible for the design of the project or the construction of the project. My responsibility is limited to the inspection and certification of the project.

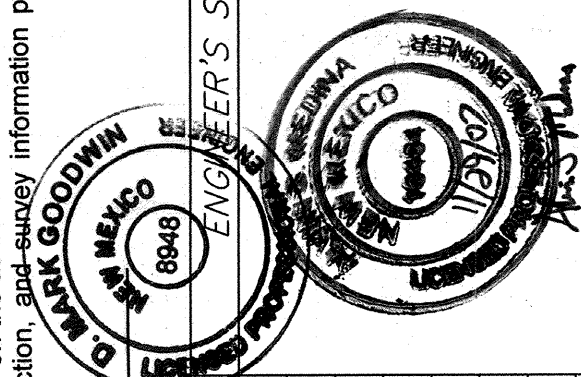

NGVD 29

MARK GOODWIN & ASSOCIATES, P.A.
CONSULTING ENGINEERS
P.O. BOX 30606
ALBUQUERQUE, NEW MEXICO 87199
(505) 828-2200, FAX (505) 797-9539

ALBUQUERQUE METROPOLITAN ARROYO FLOOD CONTROL AUTHORITY	
TITLE: ANASAZI RIDGE SUBDIVISION CALABACILLAS ARROYO IMPROVEMENTS SHOT-CRETE BANK PROTECTION - DETAILS	
DESIGN REVIEW COMMITTEE	CITY ENGINEER APPROVAL
DATE	DATE
MO./DAY/YR.	MO./DAY/YR.
CITY PROJECT NO.	ZONE MAP NO.
	A-10
SHEET	OF
8	9

SECTION 625
SHOTCRETE

625.1 GENERAL

625.11 This work shall consist of construction of the shotcrete lining utilizing the shotcrete process, including mixing, placing, finishing, testing and curing as shown in the contract in compliance with these specifications:

625.12 The requirements of Section 101 - Portland Cement Concrete and Section 510 - Concrete Structures shall apply where appropriate and not expressly modified by these specifications. Fly Ash shall be used in all concrete and shotcrete per section 510.

625.2 MATERIALS

625.21 All requirements of Section 101 - Portland Cement Concrete shall apply except as modified herein. Shotcrete shall have a minimum compressive strength of 4,000 PSI at 28 days, 5-8% air content at the pump and a slump of 1-1/2" to 4" at the pump. Shotcrete shall be tinted in accordance with Subsection 602.2.2 of these specifications.

625.211 Tinted concrete will be made by the addition of an approved concrete coloring agent to the concrete mix. The coloring agent will be added in addition to other concrete ingredients and no reductions to other ingredients will be made.

The concrete coloring for use on this project shall be:

Davis Color or Approved Equal		
	lbs./sack of cement	Color number
San Diego Buff	1 lb	

The design mixes must be submitted by the Contractor for approval by the Project Manager prior to placement. Coordination with the General contractor, shotcrete subcontractor, AMAFCA Project Manager will be required prior to any shotcrete placement

625.22 Coarse Aggregate. Coarse aggregate shall meet the following gradation requirements.

Sieve Size	Percent Passing
½ inch	100
3/8 inch	85-100
No. 4	10-30
No. 8	0-10
No. 16	0-5

625.23 Proportioning. Shotcrete shall be mixed and pneumatically applied by the wet-mix process. The concrete shall meet the minimum requirements set forth in Section 510 including the addition of air entrainment, fly ash, and tint.

625.24 The design mixes must be submitted by the Contractor for approval by the Project Manager.

625.25 Preconstruction Testing:

Test panels simulating actual field conditions shall be fabricated prior to start of construction. Test panels shall be colored shotcrete for color approval prior to construction.

The panels shall be at least 36" square and 6" thick with a back form of heavy plywood. The forms should be set for each shooting position to be encountered in the structure. Part of the panel should contain the same reinforcement as the structure, to show whether sound shotcrete is obtained behind the reinforcing bars. The panel is fabricated by gunning the proposed shotcrete design mix, including all materials and additives, to simulate actual field conditions. Curing will be field cured as specified. Cores shall be obtained for compression test and tested at 7, 14, and 28 days.

Prior to gunning the mixture three concrete test cylinders shall be taken from the design mix and tested at 7, 14, and 28 days. Cylinders to be field cured.

625.26 Quality Acceptance Tests:

A minimum of three cores shall be taken for each 500 linear feet of channel. Cores shall be obtained and tested in accordance with ASTM C-42-90. One core shall be removed and tested at 7 days, one at 14 days, and one at 28 days. Minimum compression strengths shall be as follows:

7 day	14 day	28 day
2,400 PSI	3,000 PSI	4,000 PSI

If shotcrete cores at 28 days show deficient strength, additional cores shall be taken at the contractor's expense from adjacent areas. Two cores shall be required for each deficient core. Should either additional core prove deficient, the defective shotcrete shall be removed and replaced at the Contractor's expense. No additional shotcreting shall be done until the shotcrete mixture is revised and approved by the Project Manager.

Should a strength deficiency be evident in 7-day or 14-day cores, on approval of Project Manager, the Contractor may proceed with the work on his own responsibility until the 28 day cores are tested. These cores shall also be used for determining shotcrete thickness.

625.3 CONSTRUCTION

625.31 Equipment and Workmen. Shotcreting shall be done only by experienced personnel. When requested by the Project Manager, the Contractor shall furnish evidence that each foreman, nozzle operator and delivery equipment operator has done satisfactory work in a similar capacity elsewhere and is fully qualified to perform the work.

625.311 Premixed Shotcrete. The mixing equipment shall be capable of thoroughly mixing the specified materials in sufficient quantity to maintain continuous placing.

625.32 Surface Preparation. The foundation for areas to receive shotcrete shall be evenly graded to the required elevation before the shotcrete is applied. The areas shall be thoroughly compacted with sufficient mixture to provide a firm foundation and to prevent absorption of water form the shotcrete. No high subgrade will be permitted.

Surfaces shall not contain free surface water, loose material or frozen material at the time of shotcrete application.

625.33 Forms and Reinforcement. Forms, headers, and shooting strips shall be provided and rigidly braced as required for backing. Ground or gaging wires and depth gages shall be used where necessary to establish and insure thickness, surface and finish lines.

Steel reinforcement shall be rigidly supported in the position shown in the contract. Metal chairs shall be used to properly anchor and place the reinforcement. All reinforcement shall be clean and free from loose mill scale, loose rust, overspray from previous shotcrete application, soil and other undesirable materials that interfere with bonding.

625.34 Placing. Each layer of shotcrete shall be built up by making several passes of the nozzle over the working area. When enclosing steel reinforcement, the nozzle shall be held so as to direct the material around the bars. The shotcrete shall emerge from the nozzle in a steady, uninterrupted flow. The nozzle shall be directed so as to result in minimum rebound. The velocity of the material as it leaves the nozzle shall be maintained uniform and at a rate determined for the given job conditions.

Contractor shall use appropriate form work to separate areas of different tinting, and shall prevent adjacent areas from being discolored by overspray and rebound.

Rebound shall not be worked back into the construction or salvaged. Rebound that does not fall clear of the work shall be removed.

Shotcrete shall not be placed when the air temperature is below forty degrees (40°)F unless the air temperature is at least thirty-five degrees (35°)F and rising.

The mixing, transporting, and placement time for shotcrete materials, shall not exceed two hours or 250 revolutions of the mixer drum whichever comes first. Additional water may be added at job site only if requested by the Project Manager. When additional water is added, the drum shall be rotated a minimum of 30 additional revolutions. The ready-mix plant shall certify the material for weight, water, admixtures and mixing time.

625.35 Finishing. After the shotcrete has been placed as nearly as practical to the required thickness, the ground wires may be removed, the surfaces shall be checked with a straight edge, and low spots or depressions shall be corrected by placing additional shotcrete in such a manner that the finished surface is natural as left by the nozzle and will be reasonably smooth and uniform.

Loose areas of shotcrete shall be removed and replaced by the Contractor at no additional cost.

625.36 Curing. In all cases, the period of protection shall be not less than 7 days.

625.37 Tolerance in Shotcrete Thickness. Acceptance of the finished channel lining with respect to thickness shall be on the basis of random core sampling, as designated by the Project Manager. A minimum of two core samples will be taken from longitudinal lengths of lining not exceed 500 linear feet. If deficiencies are noted, the Project Manager may require additional core samples. All coring required by the Project Manager shall be at the Owner's expense.

Should the Contractor desire to have additional core samples taken these samples would be taken at the Contractor's expense.

Deduction for a deficiency in thickness shall be made according to the following: Thickness deficiency shall be based on the average thickness of the number of samples taken within each 500 or less linear feet of lining.

Thickness Deficiency	Percent of Contract Price Allowed
0-1/2"	100%
Greater than 1/2"	Reject

Any 500 linear foot span of channel lining that is noted to deficient in thickness by more than the reject level shall be removed and replaced at the Contractor's expense.

It shall be the responsibility of the Contractor to have the core holes immediately filled with fresh shotcrete. This shotcrete shall be of the same mix and of equal compressive strength as the original.

For quality acceptance, the Project Manager may have the core samples tested for compressive strength.

All cores will be measured in accordance with ASTM C-174.

625.38 Method of Measurement. Shotcrete will be measured by the square yard parallel to the surface.

Basis for Payment. The accepted quantities of shotcrete will be paid for at the contract unit price per square yard. Such payment shall constitute full reimbursement for all materials, labor and equipment used in the placement of all shotcrete, steel reinforcement, support chairs, forms, joints, tinting, finishing, curing, and all other necessary operations to complete the shotcrete in place. No extra payment will be made for additional shotcrete placed in excess of that shown on the plans unless directed by the Project Manager.

The Contractor shall furnish the Project Manager with copies of the manufacturer's specifications and operating instructions for the equipment used. No shotcrete shall be placed until the type of equipment and method of operation have been approved by the Project Manager.

SHOTCRETE QUANTITY SUMMARY						
SPUR ID	A=FLAT AREA	2:1 SLOPE AREA (A x 1.12)	3:1 SLOPE AREA (A x 1.05)	1' THICKENED EDGE	TOTAL AREA (S.F.)	TOTAL AREA (S.Y.)
SPUR #4R	3723 SF	4170 SF	-	236 SF	4406 SF	490 SY
	1356 SF	-	1424 SF	-	1424 SF	158 SY
SPUR #5R	5927 SF	6639 SF	-	205 SF	6843 SF	760 SY
GCS #4	3974 SF	4451 SF	-	168 SF	4619 SF	513 SY
SPUR #6R	9957 SF	11152 SF	-	338 SF	11490 SF	1277 SY
SPUR #9R	8047 SF	9013 SF	-	254 SF	9267 SF	1030 SY
SPUR #10R	6459 SF	7234 SF	-	196 SF	7430 SF	826 SY
TOTAL					45,479 SF	5054 SY

RECORD DRAWING
CERTIFICATE OF SUBSTANTIAL COMPLIANCE ON PLANS


I, Mark Goodwin, NMPE 8948, of the firm Mark Goodwin & Associates, P.A., a Registered Professional Engineer in the State of New Mexico, do hereby certify, to the best of my knowledge and belief, that the infrastructure installed as part of this project has been inspected by me or by a qualified person under my direct supervision, and has been constructed in accordance with the plans and specifications approved by the City Engineer and that the original design intent of the approved plans has been met, except as noted by me on the as-built construction drawings. This Certification is based on site inspections by me or personnel under my direction, and survey information provided by Russ P. Hugg, NMPS number 9750.

Mark Goodwin
Mark Goodwin
9/27/10
NMPE 8948




NGVD 29

MARK GOODWIN & ASSOCIATES, P.A.
CONSULTING ENGINEERS
P.O. BOX 90606
ALBUQUERQUE, NEW MEXICO 87199
(505) 828-2200, FAX (505) 797-9539

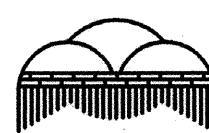

ALBUQUERQUE METROPOLITAN
ARROYO FLOOD CONTROL
AUTHORITY

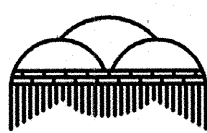

TITLE: **ANASAZI RIDGE SUBDIVISION
CALABACILLAS ARROYO IMPROVEMENTS
SHOT-CRETE BANK PROTECTION SPECIFICATIONS**

DESIGN REVIEW COMMITTEE

CITY ENGINEER APPROVAL

LAST DESIGN UPDATE

MO./DAY/YR. MO./DAY/YR.

CITY PROJECT NO.

ZONE MAP NO.

SHEET OF