

**LEGEND**

|  |                         |
|--|-------------------------|
|  | DRAINAGE BASIN BOUNDARY |
|  | DRAINAGE BASIN NAME     |
|  | ROUTING                 |
|  | COMBINATION POINT       |
|  | STORAGE ROUTING         |
|  | ROUTE LINE              |


North arrow pointing North (N), South (S), East (E), and West (W).

GRAPHIC SCALE 1" = 400'

0 400 800 1200

NOTES:  
1. ALL ELEVATIONS SHOWN ARE BASED ON THE NAVD88 VERTICAL DATUM.

PREPARED BY:  
  
5571 Midway Park Pl., NE  
Albuquerque, NM 87109

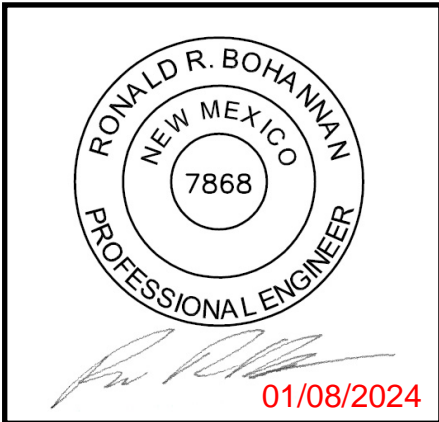

AS-BUILT CONDITIONS  
DRAINAGE AREA MAP  
FOR  
LOS DIAMANTES FLOOD STUDY  
CITY OF RIO RANCHO, NEW MEXICO  
January, 2024