

LEGEND

	DRAINAGE BASIN BOUNDARY
	DRAINAGE BASIN NAME
	ROUTING
	COMBINATION POINT
	STORAGE ROUTING
	ROUTE LINE

GRAPHIC SCALE 1" = 400'


0 400 800 1200

NOTES:

1. ALL ELEVATIONS SHOWN ARE BASED ON THE NAVD88 VERTICAL DATUM.

PREPARED BY:

5571 Midway Park Pl., NE
Albuquerque, NM 87109

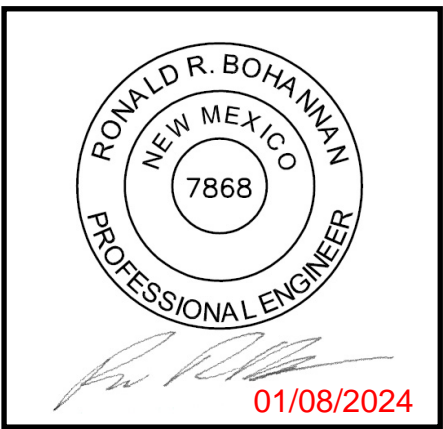

**AS-BUILT CONDITIONS
DRAINAGE AREA MAP**

FOR

LOS DIAMANTES FLOOD STUDY
CITY OF RIO RANCHO, NEW MEXICO
January, 2024