

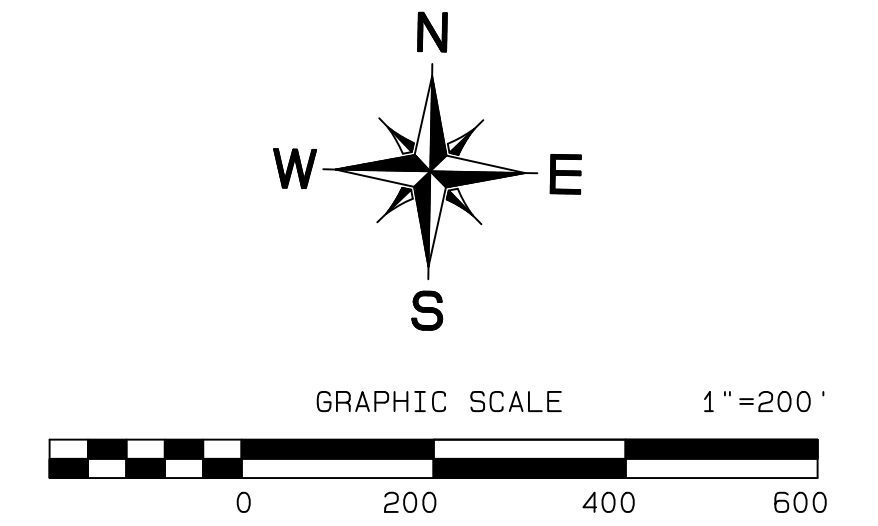


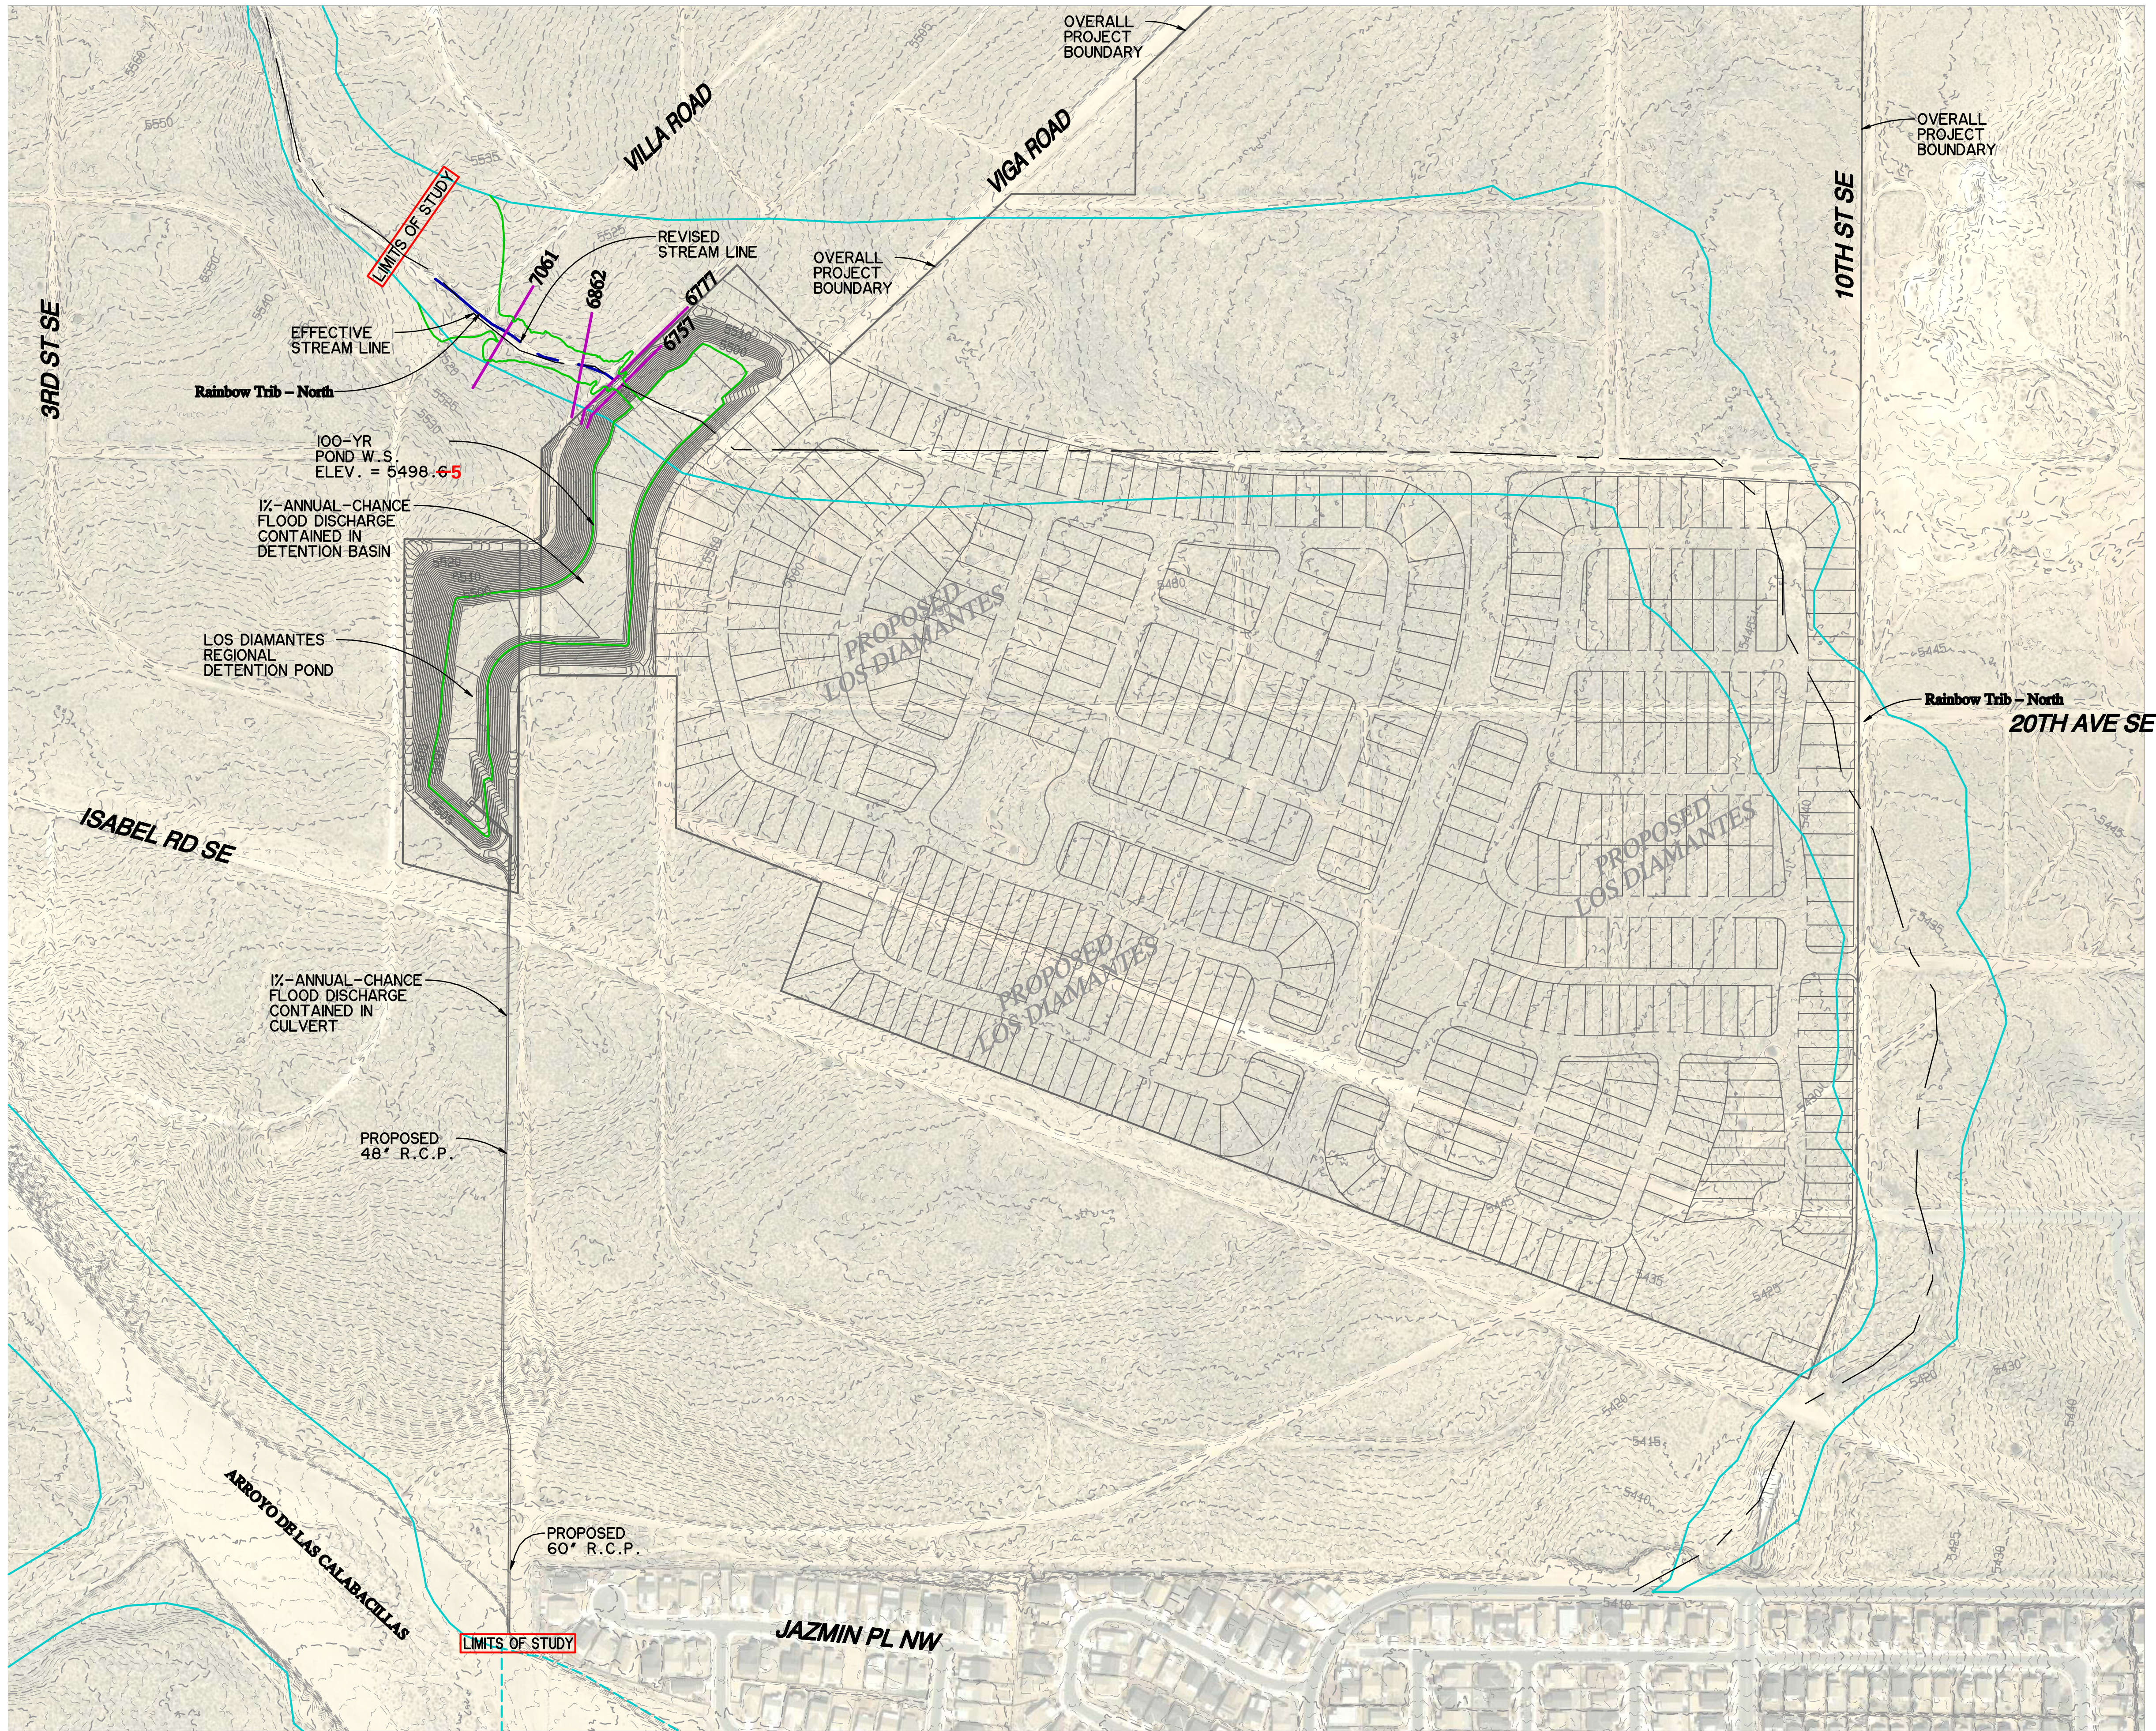

LEGEND	
	STREAM CENTERLINE
	CROSS SECTION
	CROSS SECTION NUMBER
	EXISTING CONTOUR
	PROPOSED CONTOUR
	EFFECTIVE 100-YR FLOODWAY
	EFFECTIVE 100-YR FLOODPLAIN
	PROPOSED CONDITIONS 100-YR FLOODPLAIN

NOTES:
1. ALL ELEVATIONS SHOWN ARE BASED ON THE NAVD88 VERTICAL DATUM.

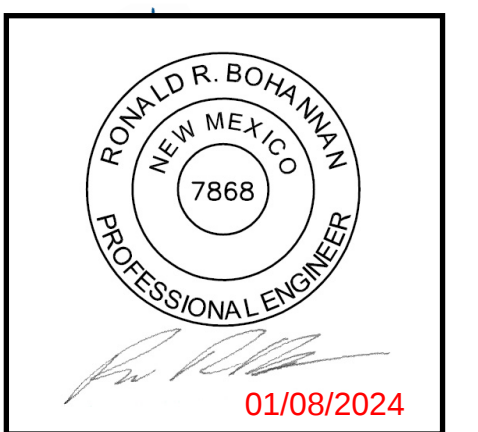

PREPARED BY:
TIERRA WEST
5571 Midway Park Pl., NE
Albuquerque, NM 87109
**AS-BUILT CONDITIONS
HYDRAULIC BASE MAP
FOR
RAINBOW TRIBUTARY – NORTH
LOS DIAMANTES FLOOD STUDY
CITY OF RIO RANCHO, NEW MEXICO
January, 2024**