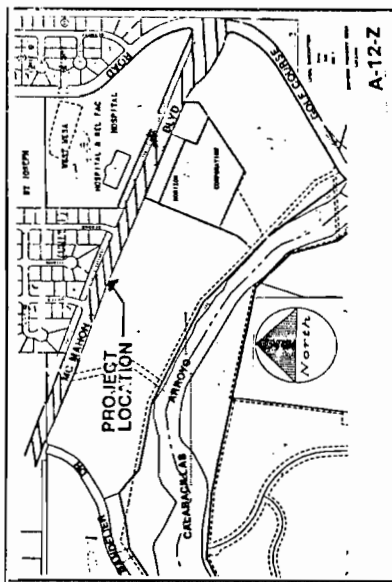



VICINITY MAP
N.T.S.

INDEX OF DRAWINGS:

SHEET TITLE	SHEET NUMBER
COVER SHEET	1
GENERAL NOTES AND LEGEND	2
PLAN AND PROFILE STATION 10+00 TO 15+00	3
PLAN AND PROFILE STATION 15+00 TO 20+00	4
PLAN AND PROFILE STATION 20+00 TO 25+00	5
PLAN AND PROFILE STATION 25+00 TO 30+00	6
PLAN AND PROFILE STATION 30+00 TO 35+00	7
PLAN AND PROFILE STATION 35+00 TO 40+00	8
PLAN AND PROFILE STATION 40+00 TO 45+00	9
PLAN AND PROFILE STATION 45+00 TO 48+00	10
ROADWAY SECTIONS AND DETAILS	11
DRAINAGE AND WALL DETAILS	12
DRAINAGE DETAILS	13
SIGNING AND STRIPING	14
SIGNING AND STRIPING	15
CROSS-SECTIONS STATION 12+00 TO 21+00	16
CROSS-SECTIONS STATIONS 22+00 TO 32+00	17
CROSS-SECTIONS STATIONS 33+00 TO 34+00	18

CURB WEST, INC.

6301 INDIAN SCHOOL ROAD
SUITE 600
ALBUQUERQUE, NM 87110

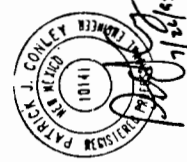

Smith Engineering Company
A Full Services Engineering Company

3420 Dolans Boulevard, N.E. Suite 400E Minneapolis, New Mexico 87110

PROJECT NO.



52(18 07)

[illegible]

WERNER, R. 1994. *WERNER*

APPROVED FOR
CONSTRUCTION

١٢

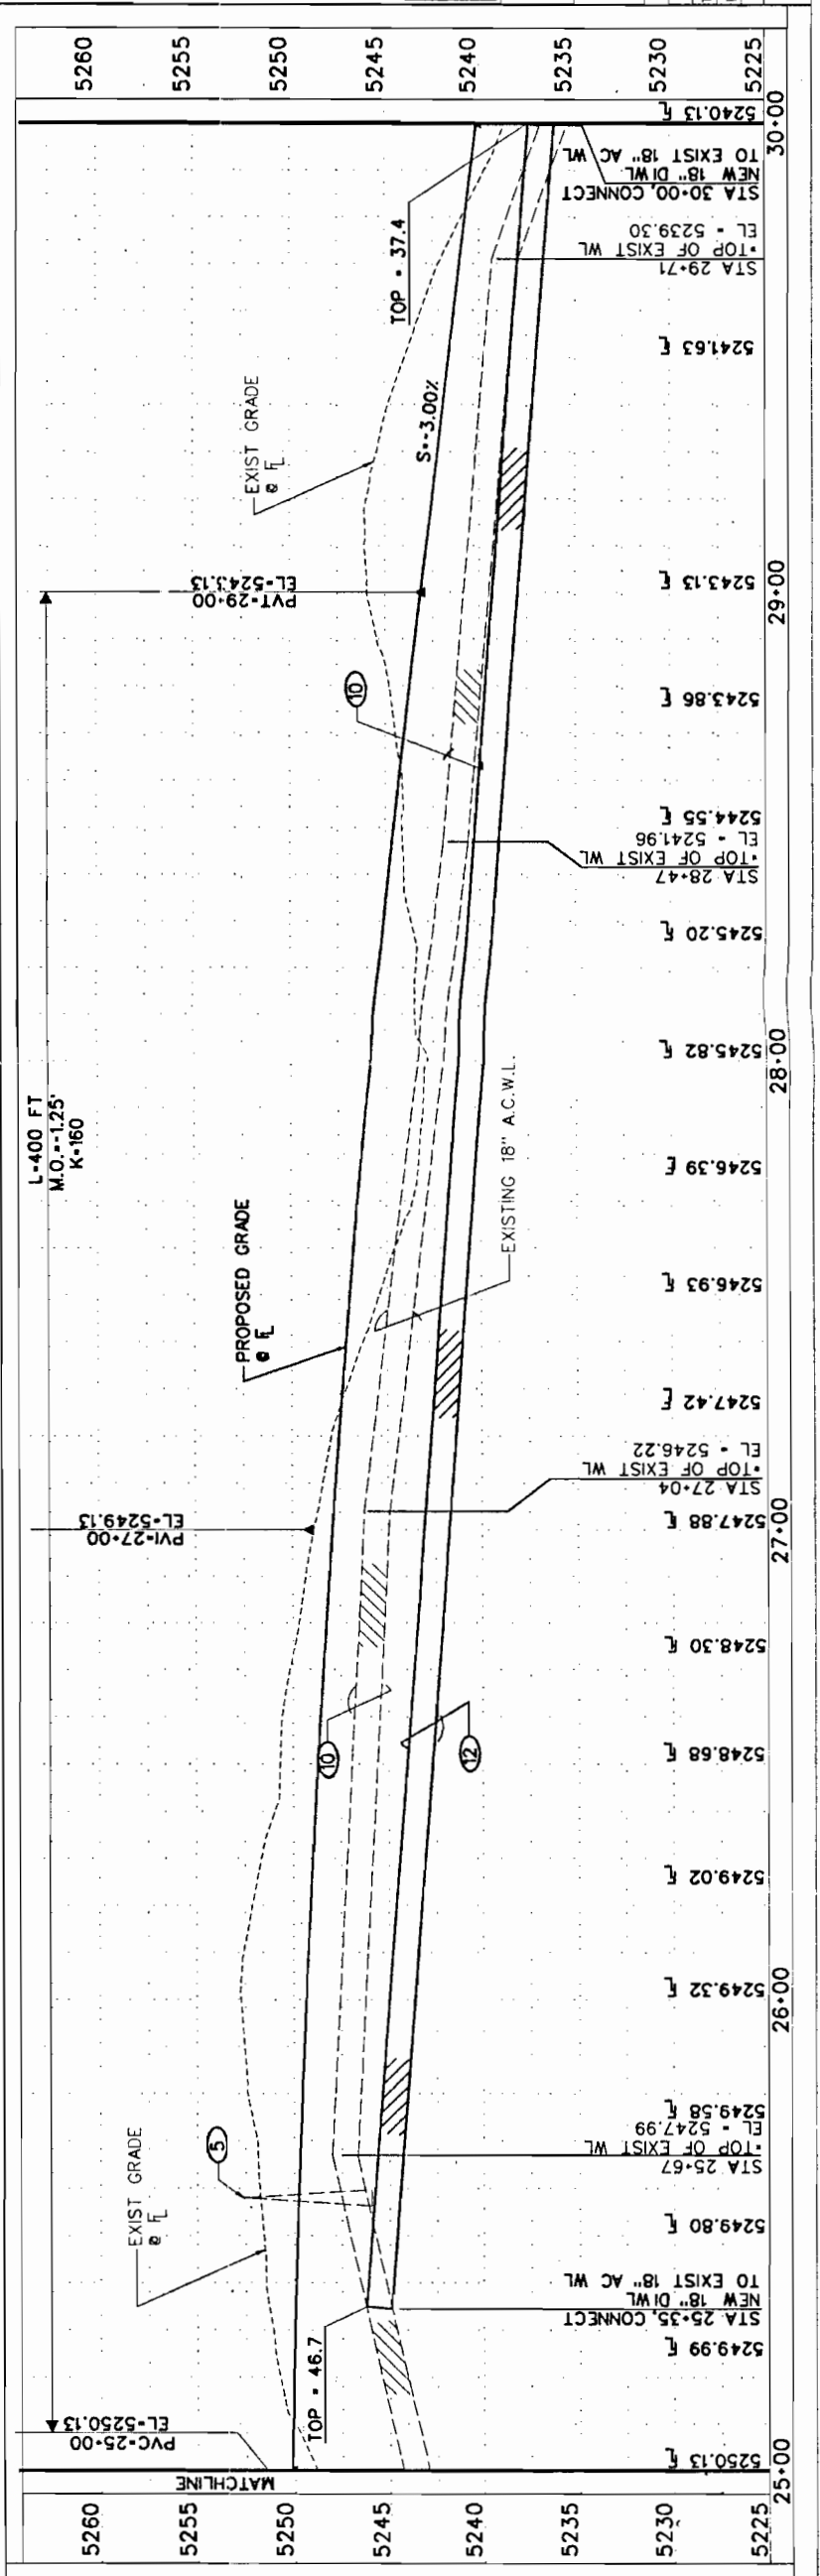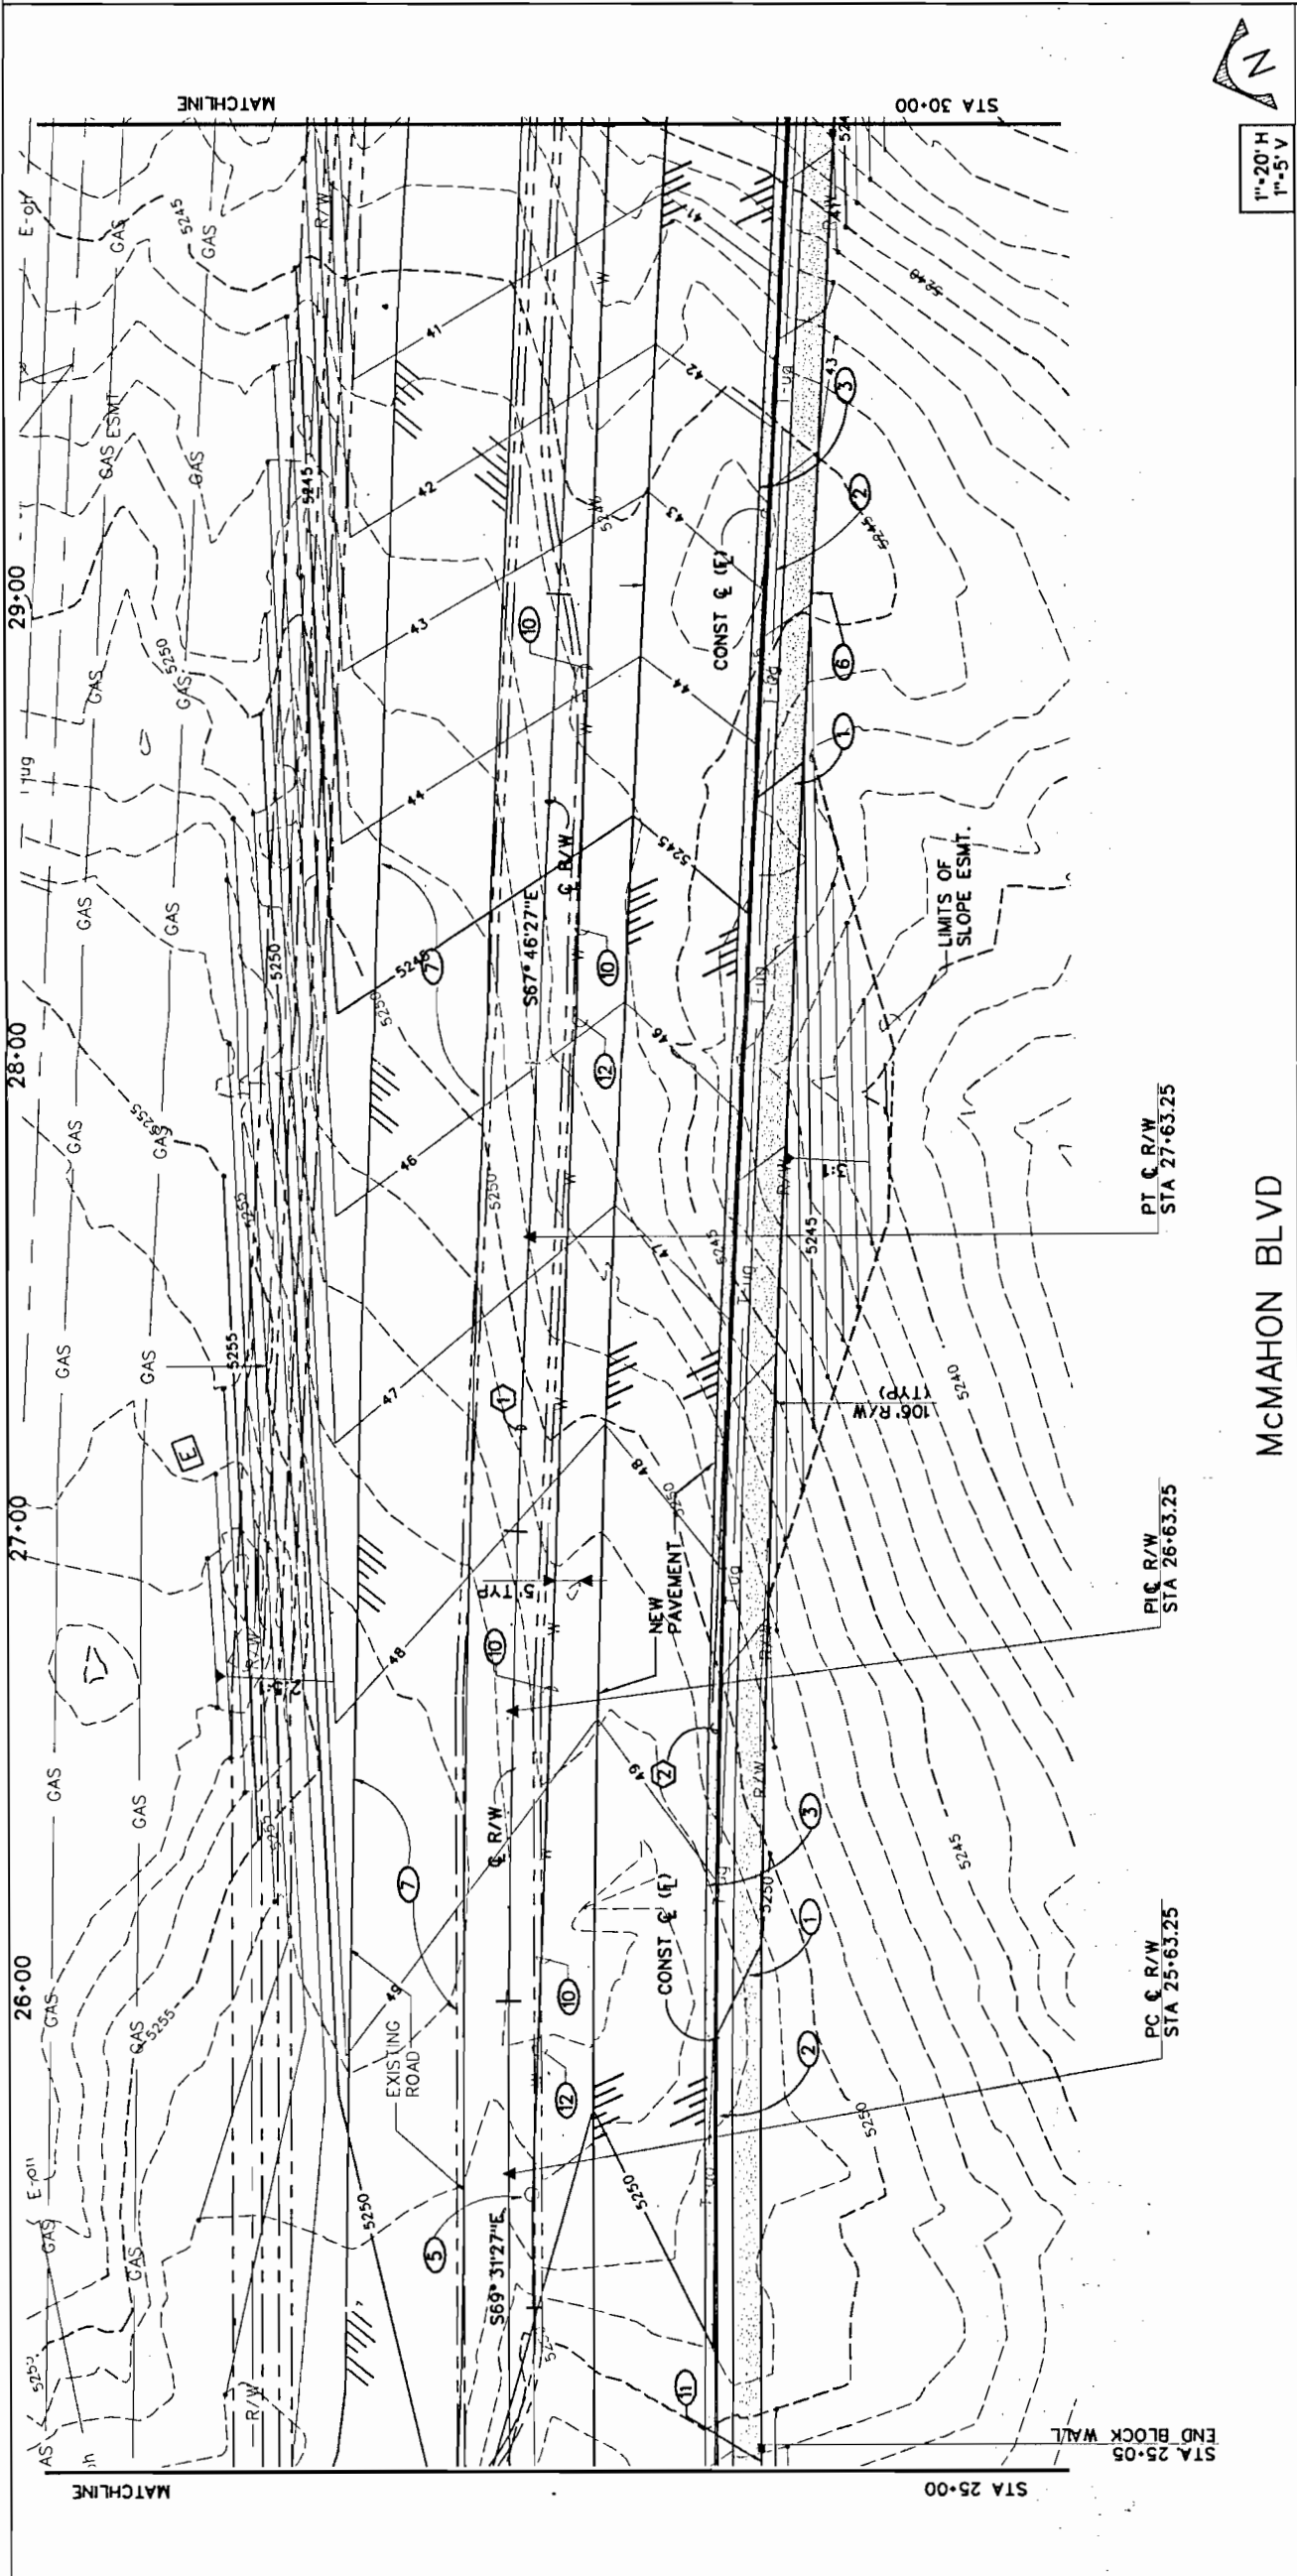

KEYED NOTES									
1	6-FOOT WIDE SIDEWALK PER COA STD. DWG. 24.30.								
2	SETBACK AREA.								
3	STANDARD CURB-AND-GUTTER PER COA STD. DWG. 2415.								
4	NOT USED								
5	REMOVE AND DISPOSE OF EXISTING MANHOLE.								
6	CONSTRUCT ROAD PER SECTION, SHEET 11.								
7	REMOVE AND DISPOSE OF EXISTING ROAD AFTER NEW ROAD IS ACCEPTED COA								
8	INSTALL 18" D.I. 11 1/4" FITTING.								
9	INSTALL NEW 18" D.I. WL.								
0	REMOVE AND DISPOSE OF EXISTING 18" WL AFTER NEW WL IS INSTALLED AND ACCEPTED BY NMUT.								
1	CONSTRUCT CMU BLOCK WALL ALONG R/W. SEE DETAILS ON SHEET 12.								
2	CONSTRUCT NEW 18" PVC WL								

AS BUILT INFORMATION									
BENCH MARK IS USGS BRASS TABLET STAMPED "BLACK 2 1977"									
CONTRACTOR									
DATE									
BY									
7/6/95									
FIELD NOTES									
NO.									
12657 DAVID THOMPSON									
DATE									
7/6/95									
SURVEY TO ESTABLISH X,Y COORDINATES FOR "BLACK 2 1977"									
ING PUBLISHED X,Y COORDINATES FOR "BLACK 2 1977"									
SURVEY TO ESTABLISH X,Y COORDINATES FOR "BLACK 2 1977"									
RECORDED BY									
DATE									
NO									
S 65°38'22" E, A DISTANCE OF 3,506.75 FEET									
MICRO-FILM INFORMATION									
DATE									
NO									
RECORDED BY									
DATE									
NO									
RECORDED BY									
DATE									
NO									
RECOR									

