
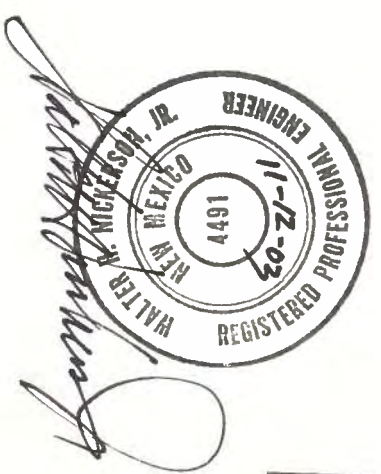


6/19/14

DRAINAGE REPORT
FOR
CRESTVIEW
ALBUQUERQUE, NM

KB HOME

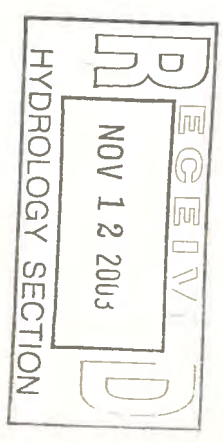

COMMUNITY SCIENCES CORPORATION
PO BOX 1328
CORRALES, NM 87048
BY
WALTER NICKERSON, JR. PE

TABLE OF CONTENTS

DESIGN-CRITERIA/LAND TREATMENT 1

LAND TREATMENT 1

EXISTING DRAINAGE CONDITIONS 1

FEMA MAP 2

PREVIOUS STUDIES..... 3

DEVELOPED DRAINAGE CONDITIONS..... 3

CONCLUSION 3

AHYMO CALCULATIONS..... 4

INLET AND PIPE CALCULATIONS 15

APPENDIX..... 20

 McMAHON PROFILE Wilson & Company Proj. 658981

 TUSCANY DRIVE PROFILE Bohannon Huston Proj #603481

 FINELAND DEVELOPMENT ULTIMATE DRAINAGE MAP

PLATES 25

BASIN MAP

GRADING AND DRAINAGE PLAN

PRELIMINARY PLAT

EROSION CONTROL

SITE DESCRIPTION

The proposed subdivision, Crestview, is comprised of 10.4 acres zoned SU-1 for residential to be developed on the south side of McMahon Blvd. Near the intersection of Unser and McMahon. The site location is shown on the enclosed zone atlas map A-11 and A-12, The report represents an overall drainage management and conceptual grading plan for approval by the City of Albuquerque in order that the subsequent subdivision and development may proceed. The site is not located in a designated Flood Hazard Zone per FEMA – Firm Map 35001C0404 D. Per the USDA Soil Conservation Services (SCS), the soils type for this site is “Type A”.

DESIGN-CRITERIA/LAND TREATMENT

The drainage plan presented in this report has been prepared in accordance with the City of Albuquerque Drainage Ordinances and Chapter 22 of the Development Process Manual DPM.

The hydrological analysis is based on the 100-year frequency, 6-hour duration storm, as represented in Section 22, Part A, Hydrology, of the Development Process Manual. Rainfall intensities per this report are as follows:

Zone	P60	P360	P1440
1	1.87	2.20	2.66

LAND TREATMENT

Residential DPM-Eqn a-4, pg 22-n

Treatment Type	A	B	C	D
	0.00%	45%	7%	48%

EXISTING DRAINAGE CONDITIONS

The site is currently undeveloped. Topography consists of sparse vegetation and native grasses and chamisa weeds. It has as cross-slope of approximately 3.0 to 4.5%.

The site accepts no offsite flows. The existing drainage is to the north through McMahon Blvd. The existing discharge for the site is 17.07 cfs.

PREVIOUS STUDIES

The allowable runoff for this site was previously determined in “Drainage Report for Fineland Development” dated March 7, 2001 and the plans for Tuscany Ridge Unit 2 city project #603481. In the Fineland report, flows from McMahon Blvd. drain directly into the Tuscany Ridge drainage system at 21.6 cfs. and it allowed for 24.0 cfs from tracts E & F of the Fineland Development. Final design profiles for McMahon Blvd. have designed flows for the Tuscany system at 8.5 cfs. Final design for the Tuscany system allows for 37.5 cfs.

DEVELOPED DRAINAGE CONDITIONS

It is the intent for the developed flows to be surface transported via street sections to an inlet in the cul-de-sac at the east end of the subdivision. This flow will be routed to the proposed storm drain extension in McMahon Blvd. The storm drain extension in McMahon outfalls to the existing system in Tuscany Unit 2. Drop inlets in McMahon Blvd. have been designed to capture 8.5 cfs. The inlet in Crestview will add an additional 29.3 cfs. The total flow into the Tuscany system will be 37.8 cfs. The design capacity of the system can accommodate the proposed drainage.

Drainage area “DA5” will be routed to the west via surface flow to drainage improvements adjacent to and in McMahon Blvd. A temporary pond will be provided until completion of the drainage system proposed with the McMahon improvements.

CONCLUSION

No adverse impact will result due to developed conditions. Flows will be contained within proposed and existing improvements. Existing and currently designed improvements for McMahon Blvd. and the Tuscany system flows are 37.5 cfs.

Developed flows for the system will be 37.8 cfs.

AP-1

Worksheet

Worksheet for Irregular Channel


Project Description	
Worksheet	Irregular Channel - 1
Flow Element	Irregular Channel
Method	Manning's Formula
Solve For	Channel Depth

Input Data	
Slope	0.730000 ft/ft
Discharge	17.45 cfs

Options	
Current Roughness Method	Improved Lotter's Method
Open Channel Weighting Method	Improved Lotter's Method
Closed Channel Weighting Methc	Horton's Method

Results	
Mannings Coefficient	0.015
Water Surface Elevation	0.39 ft
Elevation Range	0.17 to 1.00
Flow Area	1.1 ft²
Wetted Perimeter	14.16 ft
Top Width	13.80 ft
Actual Depth	0.22 ft
Critical Elevation	0.61 ft
Critical Slope	0.005547 ft/ft
Velocity	15.59 ft/s
Velocity Head	3.78 ft
Specific Energy	4.17 ft
Froude Number	9.65
Flow Type	Supercritical

Calculation Messages:
Flow is divided.

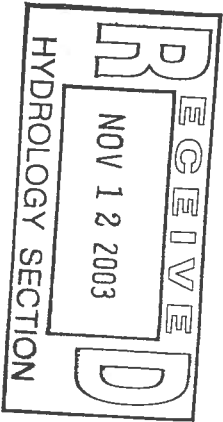

AP-1

Worksheet

Worksheet for Irregular Channel

Project Description			
Worksheet	Irregular Channel - 1		
Flow Element	Irregular Channel		
Method	Manning's Formula		
Solve For	Channel Depth		
Input Data			
Slope	0.730000	ft/ft	
Discharge	17.45	cfs	
Options			
Current Roughness Method	Improved Lotter's Method		
Open Channel Weighting Method	Improved Lotter's Method		
Closed Channel Weighting Methc	Horton's Method		
Results			
Mannings Coefficient	0.015		
Water Surface Elevation	0.39 ft		
Elevation Range	0.17 to 1.00		
Flow Area	1.1 ft²		
Wetted Perimeter	14.16 ft		
Top Width	13.80 ft		
Actual Depth	0.22 ft		
Critical Elevation	0.61 ft		
Critical Slope	0.005547 ft/ft		
Velocity	15.59 ft/s		
Velocity Head	3.78 ft		
Specific Energy	4.17 ft		
Froude Number	9.65		
Flow Type	Supercritical		
Calculation Messages:			
Flow is divided.			
Roughness Segments			
Start Station	End Station	Mannings Coefficient	
0+00	0+46	0.015	
Natural Channel Points			
Station (ft)	Elevation (ft)		
0+00	1.00		
0+08	0.83		
0+09	0.83		
0+09	0.17		
0+11	0.29		
0+23	0.53		
0+35	0.29		
0+37	0.17		
0+37	0.83		
0+38	0.83		
0+46	1.00		

AP-2

Worksheet

Worksheet for Irregular Channel

Project Description			
Worksheet	Irregular Channel - 1		
Flow Element Method	Irregular Channel Manning's Formula		
Solve For	Channel Depth		
Input Data			
Slope	0.005000	ft/ft	
Discharge	24.02	cfs	
Options			
Current Roughness Method	Improved Lotter's Method		
Open Channel Weighting Method	Improved Lotter's Method		
Closed Channel Weighting Methc	Horton's Method		
Results			
Mannings Coefficient	0.015		
Water Surface Elevation	0.67	ft	
Elevation Range	0.17 to 1.00		
Flow Area	8.1	ft²	
Wetted Perimeter	29.05	ft	
Top Width	28.25	ft	
Actual Depth	0.50	ft	
Critical Elevation	0.67	ft	
Critical Slope	0.005188	ft/ft	
Velocity	2.98	ft/s	
Velocity Head	0.14	ft	
Specific Energy	0.81	ft	
Froude Number	0.98		
Flow Type	Subcritical		
Roughness Segments			
Start Station	End Station	Mannings Coefficient	
0+00	0+46	0.015	
Natural Channel Points			
Station (ft)	Elevation (ft)		
0+00	1.00		
0+08	0.83		
0+09	0.83		
0+09	0.17		
0+11	0.29		
0+23	0.53		
0+35	0.29		
0+37	0.17		
0+37	0.83		
0+38	0.83		
0+46	1.00		

AP-2

Worksheet

Worksheet for Irregular Channel

Project Description		
Worksheet	Irregular Channel - 1	
Flow Element	Irregular Channel	
Method	Manning's Formula	
Solve For	Channel Depth	
Input Data		
Slope	0.005000	ft/ft
Discharge	24.02	cfs
Options		
Current Roughness Method	Improved Lotter's Method	
Open Channel Weighting Method	Improved Lotter's Method	
Closed Channel Weighting Methc	Horton's Method	
Results		
Mannings Coefficient	0.015	
Water Surface Elevation	0.67 ft	
Elevation Range	0.17 to 1.00	
Flow Area	8.1 ft²	
Wetted Perimeter	29.05 ft	
Top Width	28.25 ft	
Actual Depth	0.50 ft	
Critical Slope	0.67 ft	
Critical Elevation	0.005188 ft/ft	
Velocity	2.98 ft/s	
Velocity Head	0.14 ft	
Specific Energy	0.81 ft	
Froude Number	0.98	
Flow Type	Subcritical	
Roughness Segments		
Start Station	End Station	Mannings Coefficient
0+00	0+46	0.015
Natural Channel Points		
Station (ft)	Elevation (ft)	
0+00	1.00	
0+08	0.83	
0+09	0.83	
0+09	0.17	
0+11	0.29	
0+23	0.53	
0+35	0.29	
0+37	0.17	
0+37	0.83	
0+38	0.83	
0+46	1.00	

AP-3
Worksheet
Worksheet for Irregular Channel

Project Description		
Worksheet	Irregular Channel - 1	
Flow Element Method	Irregular Channel Manning's Formula	
Solve For	Channel Depth	
Input Data		
Slope	0.017500 ft/ft	
Discharge	31.96 cfs	
Options		
Current Roughness Method	Improved Lotter's Method	
Open Channel Weighting Method	Improved Lotter's Method	
Closed Channel Weighting Methc	Horton's Method	
Results		
Mannings Coefficient	0.015	
Water Surface Elevation	0.62 ft	
Elevation Range	0.17 to 1.00	
Flow Area	6.6 ft²	
Wetted Perimeter	28.94 ft	
Top Width	28.22 ft	
Actual Depth	0.45 ft	
Critical Elevation	0.73 ft	
Critical Slope	0.004890 ft/ft	
Velocity	4.87 ft/s	
Velocity Head	0.37 ft	
Specific Energy	0.99 ft	
Froude Number	1.78	
Flow Type	Supercritical	
Roughness Segments		
Start Station	End Station	Mannings Coefficient
0+00	0+46	0.015
Natural Channel Points		
Station (ft)	Elevation (ft)	
0+00	1.00	
0+08	0.83	
0+09	0.83	
0+09	0.17	
0+11	0.29	
0+23	0.53	
0+35	0.29	
0+37	0.17	
0+37	0.83	
0+38	0.83	
0+46	1.00	

AP-3
Worksheet

Worksheet for Irregular Channel


Project Description		
Worksheet	Irregular Channel - 1	
Flow Element	Irregular Channel	
Method	Manning's Formula	
Solve For	Channel Depth	
Input Data		
Slope	0.017500	ft/ft
Discharge	31.96	cfs
Options		
Current Roughness Method	Improved Lotter's Method	
Open Channel Weighting Method	Improved Lotter's Method	
Closed Channel Weighting Method	Horton's Method	
Results		
Mannings Coefficient	0.015	
Water Surface Elevation	0.62 ft	
Elevation Range	0.17 to 1.00	
Flow Area	6.6 ft²	
Wetted Perimeter	28.94 ft	
Top Width	28.22 ft	
Actual Depth	0.45 ft	
Critical Elevation	0.73 ft	
Critical Slope	0.004890 ft/ft	
Velocity	4.87 ft/s	
Velocity Head	0.37 ft	
Specific Energy	0.99 ft	
Froude Number	1.78	
Flow Type	Supercritical	
Roughness Segments		
Start Station	End Station	Mannings Coefficient
0+00	0+46	0.015
Natural Channel Points		
Station (ft)	Elevation (ft)	
0+00	1.00	
0+08	0.83	
0+09	0.83	
0+09	0.17	
0+11	0.29	
0+23	0.53	
0+35	0.29	
0+37	0.17	
0+37	0.83	
0+38	0.83	
0+46	1.00	

AT-1

Cross Section

Cross Section for Irregular Channel


Project Description	
Worksheet	Irregular Channel - 1
Flow Element	Irregular Channel
Method	Manning's Formula
Solve For	Channel Depth
Section Data	
Mannings Coefficient	0.015
Slope	0.730000 ft/ft
Water Surface Elevation	0.39 ft
Elevation Range	0.17 to 1.00
Discharge	17.45 cfs

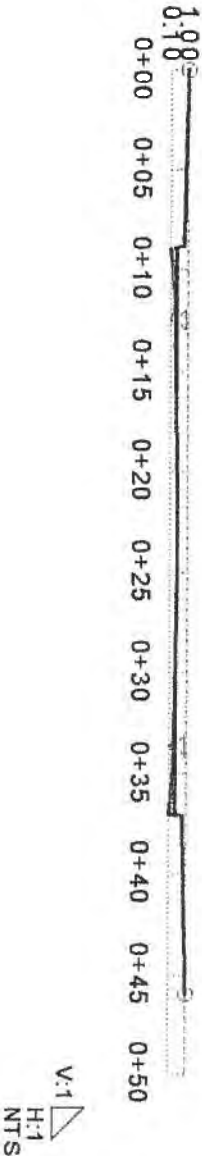

AT-1
Cross Section
Cross Section for Irregular Channel

Project Description	
Worksheet	Irregular Channel - 1
Flow Element	Irregular Channel
Method	Manning's Formula
Solve For	Channel Depth

Section Data	
Mannings Coefficient	0.015
Slope	0.730000 ft/ft
Water Surface Elevation	0.39 ft
Elevation Range	0.17 to 1.00
Discharge	17.45 cfs

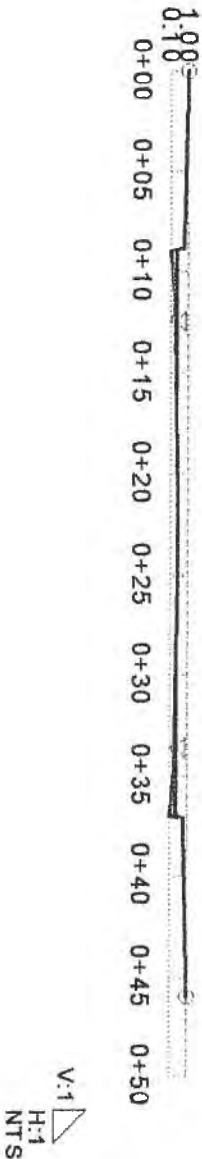


AT-2

Cross Section


Cross Section for Irregular Channel

Project Description	
Worksheet	Irregular Channel - 1
Flow Element	Irregular Channel
Method	Manning's Formula
Solve For	Channel Depth
Section Data	
Mannings Coefficient	0.015
Slope	0.005000 ft/ft
Water Surface Elevation	0.67 ft
Elevation Range	0.17 to 1.00
Discharge	24.02 cfs

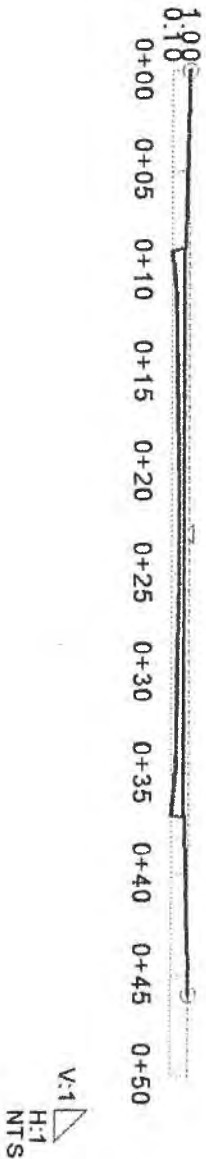

AT-2
Cross Section
Cross Section for Irregular Channel

Project Description	
Worksheet	Irregular Channel - 1
Flow Element	Irregular Channel
Method	Manning's Formula
Solve For	Channel Depth
Section Data	
Mannings Coefficient	0.015
Slope	0.005000 ft/ft
Water Surface Elevation	0.67 ft
Elevation Range	0.17 to 1.00
Discharge	24.02 cfs

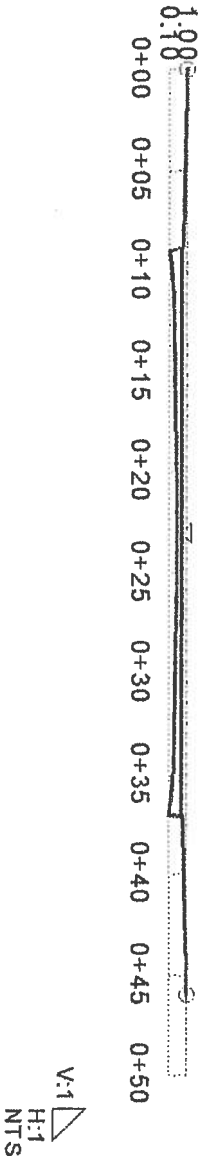


AP-5

Cross Section

Cross Section for Irregular Channel

Project Description	
Worksheet	Irregular Channel - 1
Flow Element	Irregular Channel
Method	Manning's Formula
Solve For	Channel Depth

Section Data	
Mannings Coefficient	0.015
Slope	0.017500 ft/ft
Water Surface Elevation	0.62 ft
Elevation Range	0.17 to 1.00
Discharge	31.96 cfs

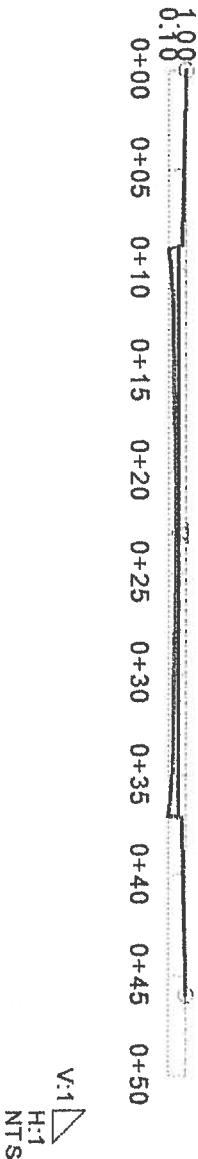


AP-3

Cross Section

Cross Section for Irregular Channel

Project Description	
Worksheet	Irregular Channel - 1
Flow Element	Irregular Channel
Method	Manning's Formula
Solve For	Channel Depth
Section Data	
Mannings Coefficient	0.015
Slope	0.017500 ft/ft
Water Surface Elevation	0.62 ft
Elevation Range	0.17 to 1.00
Discharge	31.96 cfs

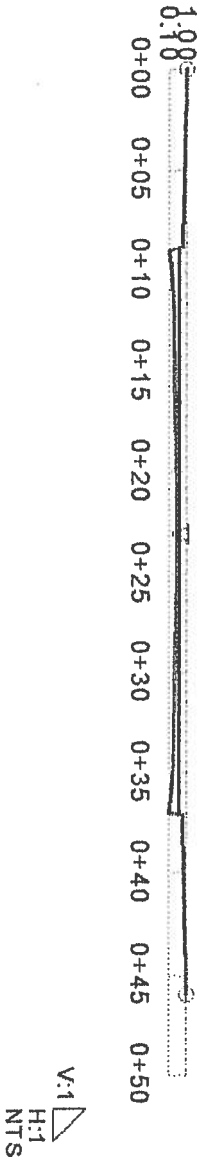

Hydraflow Storm Sewer Inventory Report



Line No.	Alignment				Flow Data				Physical Data								Line ID
	Dnstr line No.	Line length (ft)	Defl angle (deg)	Junc type	Known Q (cfs)	Drng area (ac)	Runoff coeff (C)	Inlet time (min)	Invert El Dn (ft)	Line slope (%)	Invert El Up (ft)	Line size (in)	Line type	N value (n)	J-loss coeff (K)	Inlet/ Rim El (ft)	
1	End	50.5	0.0	Curb	0.00	0.00	0.00	0.0	5284.68	0.53	5284.95	36	Cir	0.013	0.50	0.00	Existing 36
2	1	158.0	0.0	Curb	5.50	0.00	0.00	0.0	5284.68	0.64	5285.69	36	Cir	0.013	1.50	5290.38	McMahon Proposed 3
3	2	108.0	-90.0	MH	0.00	0.00	0.00	0.0	5285.69	2.00	5287.85	24	Cir	0.013	0.45	5296.00	Crestview 36
4	3	43.0	19.0	Comb	29.34	0.00	0.00	0.0	5287.85	2.00	5288.71	24	Cir	0.013	1.00	5294.48	Crestview Inlet
Project File: crest1.stm						I-D-F File: crest1.IDF					Total number of lines: 4					Date: 11-11-2003	

Hydratlow Inlet Report

Line No	Line ID	A	Inlet time	I	C	Q = CIA	Q carry	Q capt	Q byp	Junc type	Curb Inlet		Grate Inlet			Gutter				Flow		Byp line No
		(ac)	(min)	(in/hr)		(cfs)	(cfs)	(cfs)	(cfs)		Ht (in)	L (ft)	area (sqft)	L (ft)	W (ft)	So (ft/ft)	W (ft)	Sw (ft/ft)	Sx (ft/ft)	depth (ft)	spread (ft)	
1	Existing 36	0.00	0.0	0.00	0.00	0.00	2.93	2.93	0.00	Curb	8.0	7.39	0.00	0.00	0.00	Sag	2.00	0.080	0.020	0.31	9.41	Offsite
2	McMahon Proposed	0.00	0.0	0.00	0.00	5.50*	0.00	2.57	2.93	Curb	8.0	7.80	0.00	0.00	0.00	0.025	2.00	0.083	0.020	0.35	11.20	1
3	Crestview 36	0.00	0.0	0.00	0.00	0.00	0.00	0.00	0.00	MH	0.0	0.00	0.00	0.00	0.00	0.000	0.00	0.000	0.000	0.00	0.00	2
4	Crestview Inlet	0.00	0.0	0.00	0.00	29.34*	0.00	29.34	0.00	Comb	8.0	15.39	14.00	7.39	2.00	Sag	2.00	0.083	0.020	0.57	6.87	3
Project File: crest1.stm						I-D-F File: crest1.IDF							Total number of lines: 4					Run Date: 11-11-2003				
NOTES: Inlet N-Values = 0.017 ; Design depth for grate(s) = 0.83 (ft); Intensity = 0.00 / (Inlet time + 0.00) ^ 0.00; Return period = 100 Yrs. ; * Indicates Known Q added																						

Hydraflow Hydraulic Grade Line Computations

Line	Size	Q	Downstream								Len	Upstream								Check		JL coeff	Minor loss
			Invert elev (ft)	HGL elev (ft)	Depth (ft)	Area (sqft)	Vel (ft/s)	Vel head (ft)	EGL elev (ft)	Sf (%)		Invert elev (ft)	HGL elev (ft)	Depth (ft)	Area (sqft)	Vel (ft/s)	Vel head (ft)	EGL elev (ft)	Sf (%)	Ave Sf (%)	Enrgy loss (ft)		
1	36	34.84	5284.68	5287.68	3.00	7.07	4.93	0.38	5288.06	0.273	50.5	5284.95	5287.79	2.84	6.93	5.03	0.39	5288.19	0.236	0.255	0.129	0.50	0.20
2	36	34.84	5284.68	5287.99	3.00	7.07	4.93	0.38	5288.37	0.273	158	5285.69	5288.34	2.65	6.61	5.27	0.43	5288.77	0.244	0.259	0.409	1.50	0.65
3	24	29.34	5285.69	5288.99	2.00	3.14	9.34	1.36	5290.35	1.683	108	5287.85	5290.81	2.00	3.14	9.34	1.36	5292.16	1.683	1.683	1.818	0.45	0.61
4	24	29.34	5287.85	5291.42	2.00	3.14	9.34	1.36	5292.78	1.683	43.0	5288.71	5292.14	2.00	3.14	9.34	1.36	5293.50	1.683	1.683	0.724	1.00	1.36
Project File: crest1.stm							I-D-F File: crest1.IDF							Total number of lines: 4					Run Date: 11-11-2003				
NOTES: Initial tailwater elevation = 5287.68 (ft) , * Normal depth assumed., ** Critical depth assumed.																							

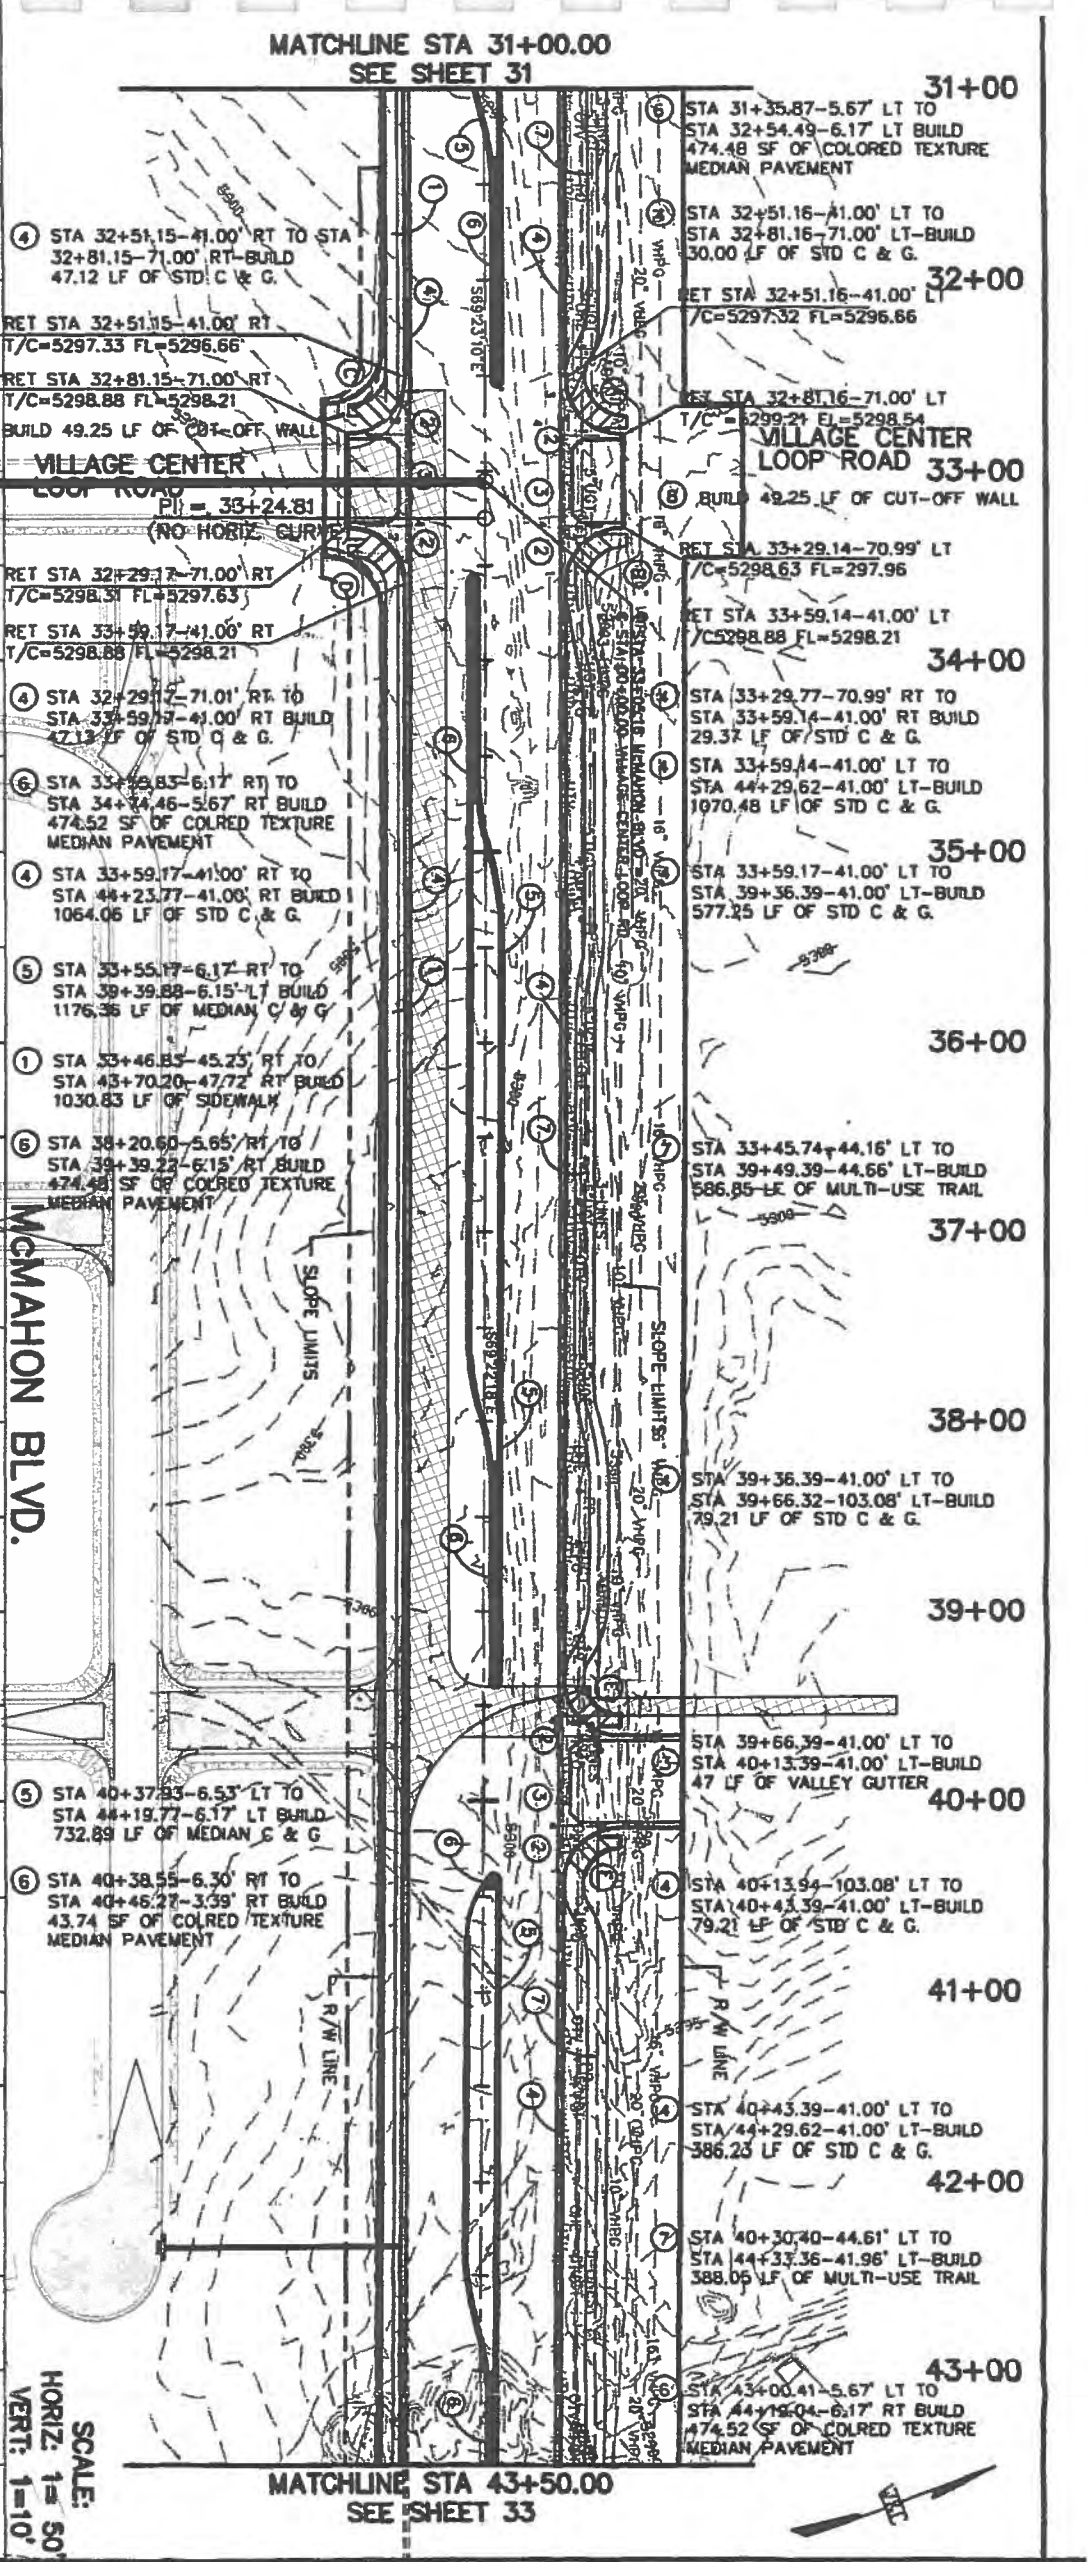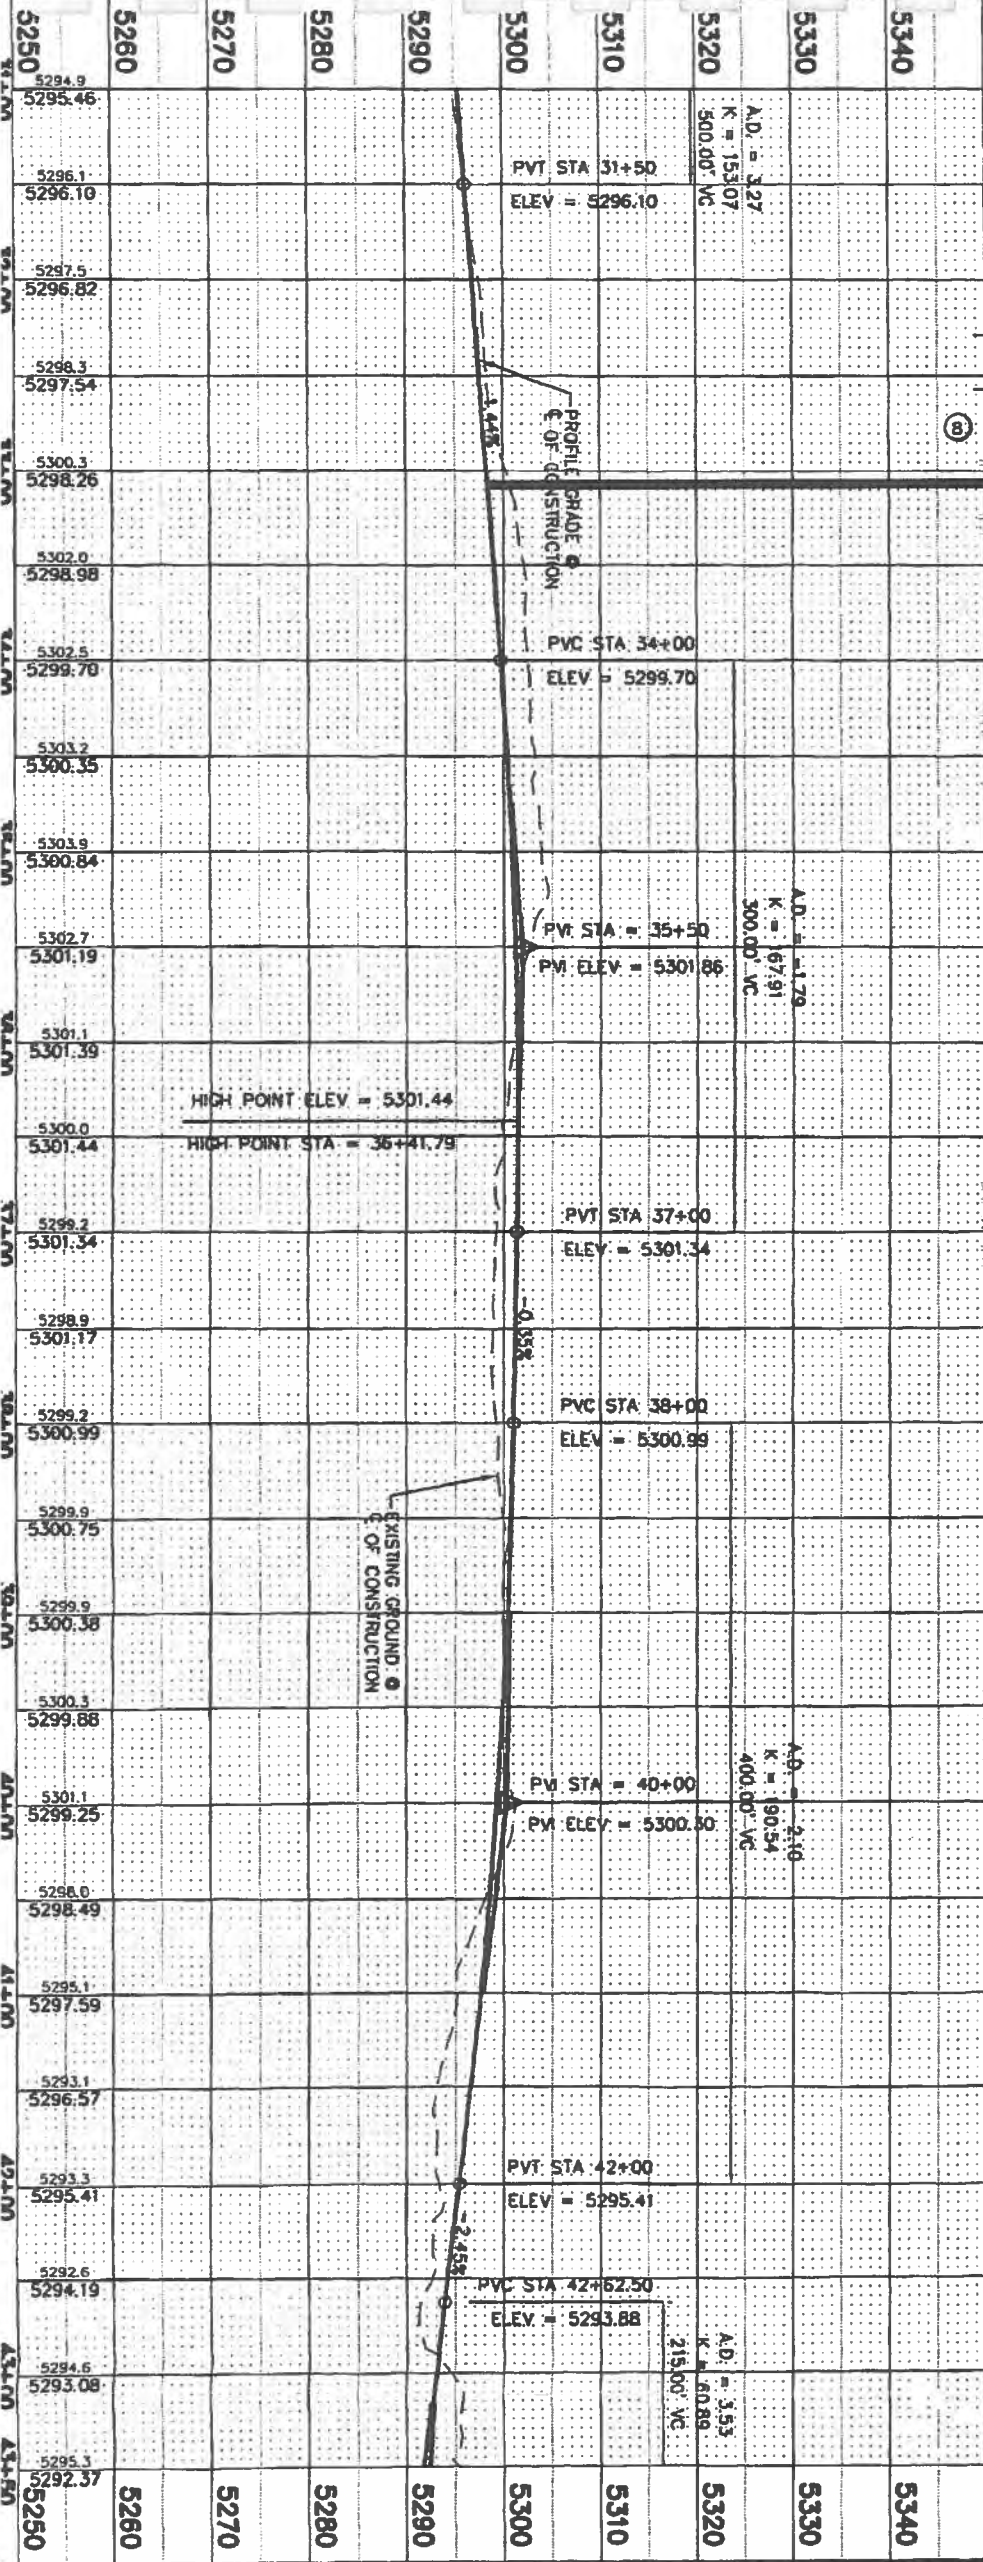

KEYED NOTES

- CONSTRUCT 6' SIDEWALK PER COA STD DWG 2430 OR PER ADA SIDEWALK DETAIL SHIT 14
- CONSTRUCT WHEELCHAIR RAMP PER COA STD DWG 2441 AND DETAIL SHIT 14
- CONSTRUCT VALLEY GUTTER PER COA STD DWG 2415
- CONSTRUCT STD C & G PER COA STD DWG 2415
- CONSTRUCT MEDIAN CURB & GUTTER PER COA STD DWG 2415 SEE SHEETS 23 TO 27 FOR GEOMETRICS
- CONSTRUCT COLORED TEXTURE MEDIAN PAVEMENT SEE SHEETS 23 TO 27 FOR LIMITS
- CONSTRUCT 10' MULTI-USE TRAIL SEE SHIT 28 TO 29 FOR GEOMETRICS
- CONSTRUCT 8" CUT-OFF WALL PER COA STD DWG 2415 SEE PLAN NOTE FOR LENGTH
- CONSTRUCT DEEPENED C & G PER COA STD DWG 2415
- CONSTRUCT POC DRIVEPAD PER COA STD DWG 2425, SEE BUILD NOTE FOR WIDTH

ENGINEER'S SEAL

WILSON & COMPANY
ENGINEERS AND PLANNERS

CITY OF ALBUQUERQUE
PUBLIC WORKS DEPARTMENT
ENGINEERING GROUP

MCMAHON BOULEVARD
TRANSPORTATION IMPROVEMENTS
PAVING PLAN AND PROFILE - MCMA

Design Review Committee City Engineer Approved

Last Design Update 05/08/17

BENCH MARKS

THE STA. IS A USGS BRASS TABLET STAMPED "BLACK-2 1977 SET FLUSH W/THE GROUND. THE STA IS LOCATED 8.5 MI. N.W. OF DOWNTOWN ALBU. TO REACH THE STA FROM


AS-BUILT INFORMATION

CONTRACTOR DATE
WORK STARTED BY DATE
CHECKED BY DATE
APPROVED BY DATE


STATION	DATE	DESCRIPTION
1	10/10/97	100' WIDE
2	10/10/97	100' WIDE

STATION	DATE	DESCRIPTION
1	10/10/97	100' WIDE
2	10/10/97	100' WIDE

STATION	DATE	DESCRIPTION
1	10/10/97	100' WIDE
2	10/10/97	100' WIDE

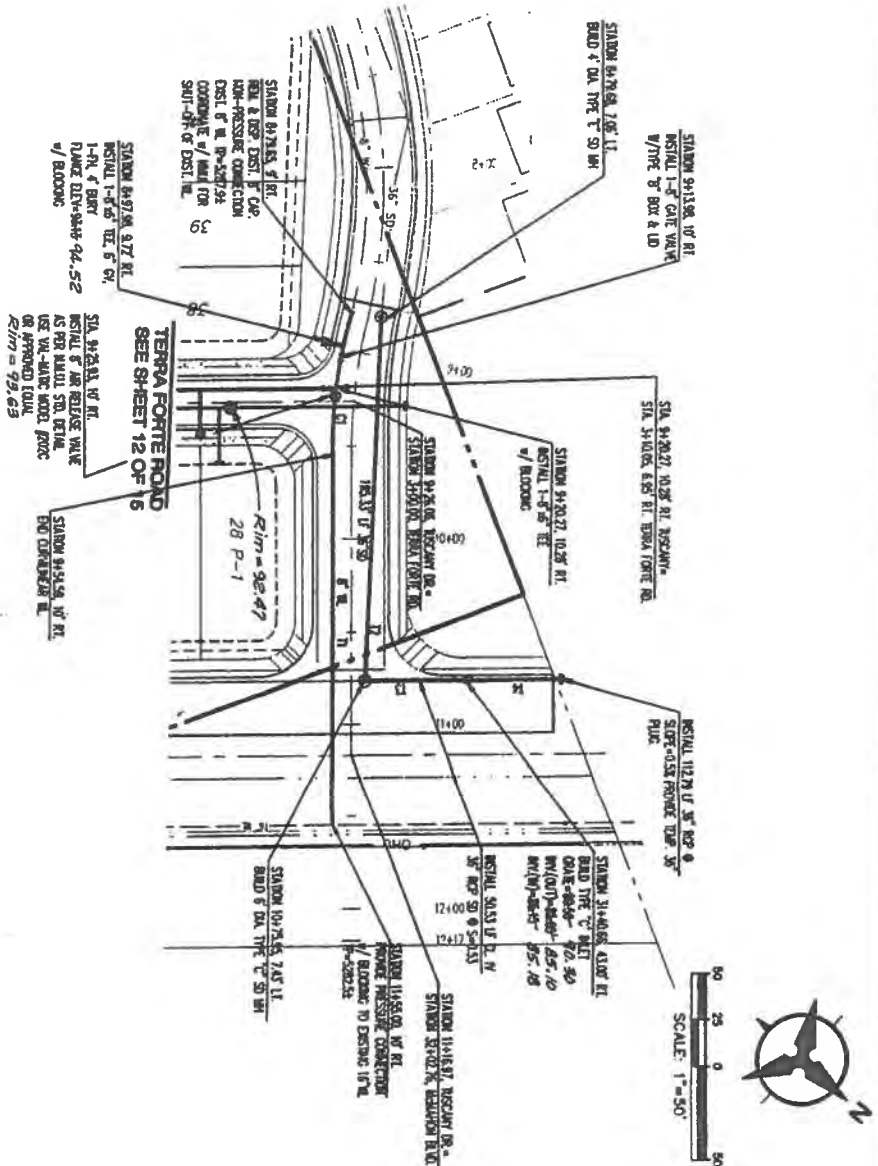

TUSCANY DRIVE

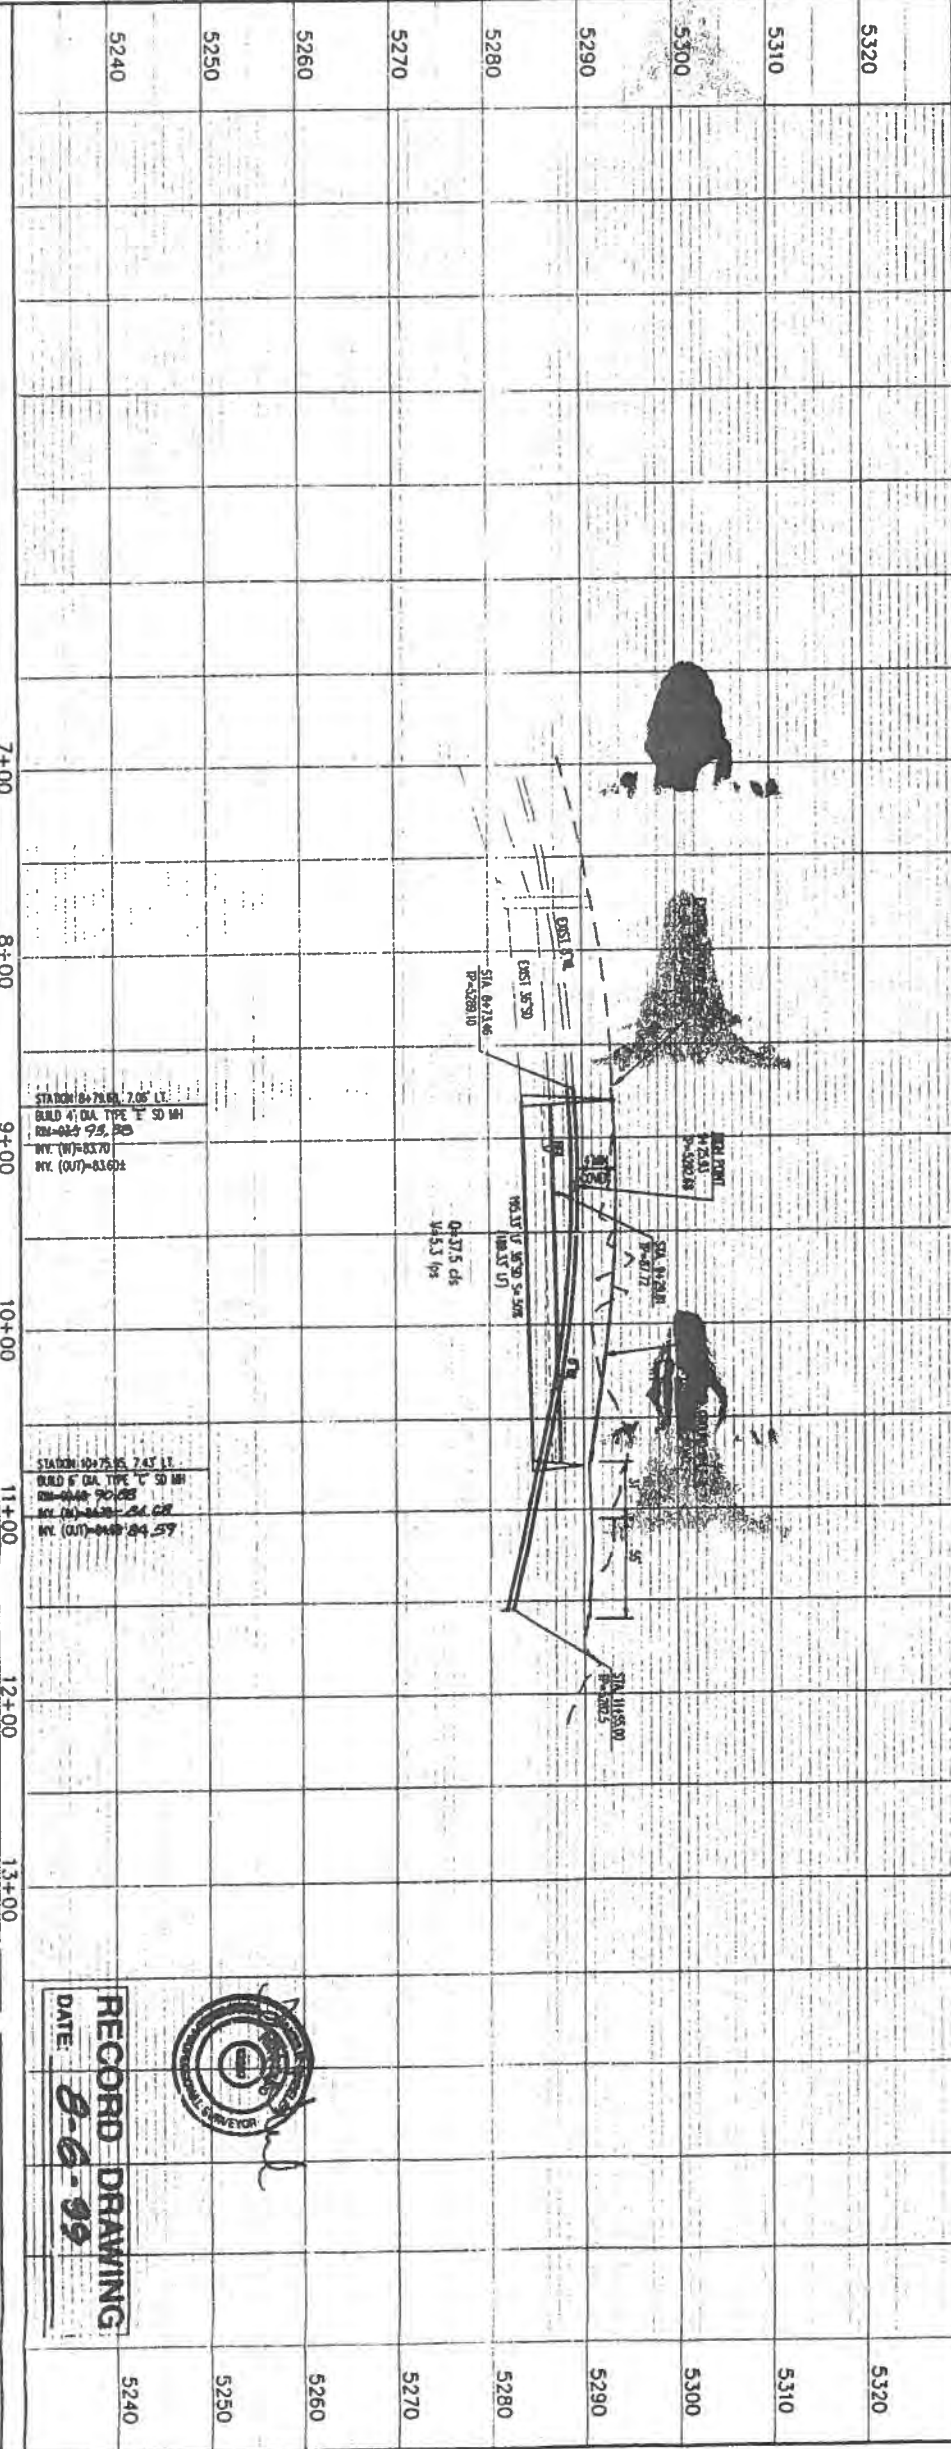

- NOTES**
1. THE CONTRACTOR SHALL FIELD VERIFY ALL EXISTING UTILITY LOCATIONS AND NOTIFY THE ENGINEER IMMEDIATELY OF ANY DISCREPANCIES.
 2. ALL CURB RETURN RADII SHALL BE 20' UNLESS OTHERWISE SPECIFIED.
 3. ALL CURVE DATA AND DIMENSIONS REFER TO FACE OF CURB UNLESS OTHERWISE SPECIFIED.
 4. GRADE ELEVATIONS, WHERE NOTED, ARE TO FACE OF CURB UNLESS OTHERWISE SPECIFIED.
 5. CONTRACTOR IS TO INSTALL A 4" X 4" X 5' POST AND END AT THE END OF EACH SANITARY SEWER SERVICE.
 6. CONTRACTOR IS RESPONSIBLE FOR REPAIR AND/OR REPLACEMENT OF ALL UTILITY CONDUITS AND EXISTING LINES.
 7. ANY ADDITIONAL GRADING REQUIRED TO MATCH BE PROPOSED STREET GRADICES SHALL BE INCIDENTAL TO PAVING ITEMS.
 8. CONTRACTOR SHALL PROVIDE THE INSPECTORS (CITY AND PRIVATE) WITH THE PROPOSED HYDROSTATIC TESTING PLAN. THE PLAN MUST BE APPROVED BEFORE TESTING OPERATIONS BEGIN.
 9. CONTRACTOR SHALL PARK EQUIPMENT AND VEHICLES AS NOT TO INTERFERE WITH NORMAL ACTIVITIES OF RESIDENTS OR OTHER CONTRACTORS ON SITE.
 10. ANY DAMAGE TO THE EXISTING FACILITIES (CURB & GUTTER, PAVEMENT, CONDUITS, LANDSCAPING, UTILITY LINES, ETC.) DURING CONSTRUCTION SHALL BE REPLACED AT THE CONTRACTOR'S EXPENSE.
 11. REMOVAL OF THE EXISTING CURB AND GUTTER SHALL BE AS PER COA STD. DWG. 2415 (SAWTOOTH ONLY).
 12. WHEELCHAIR RAMPS SHALL BE CONSTRUCTED PRIOR TO ACCEPTANCE OF CURB & GUTTER.

SURVEY INFORMATION			BENCH MARKS		AS-BUILT INFORMATION	
NO.	BY	DATE			CONTRACTOR	DATE
			ACS Brass Tablet stamped "Black-2 1977"		CCM	7/99
			Geographic Position (NAD 1927)		DATE	7/99
			N.M. State Plane Coordinates (Central Zone)		DATE	7/99
			X= 372,920.43 Y= 1,530,241.52		DATE	7/99
			Ground-to-Grid Factor= 0.9996692		DATE	7/99
			GDA= -0074'43"		DATE	7/99
			S.D. 1929 Elevation= 5213.926		DATE	7/99

ENGINEER'S SEAL

SURVEY INFORMATION

BENCH MARKS

AS-BUILT INFORMATION

REMARKS

DESIGN

DESIGNED BY: BS, CG

DRAWN BY: RB, LR

CITY OF ALBUQUERQUE

PUBLIC WORKS DEPARTMENT

ENGINEERING DEVELOPMENT GROUP

TUSCANY RIDGE UNIT 2

UTILITY & STORM DRAIN PLAN & PROFILE

TUSCANY DRIVE STA. 2+00 TO STA. 12+00

City Engineer Approval

City Project No. 0000000000

Zone Map No. A-12-7

Sheet 11

OF 15

