

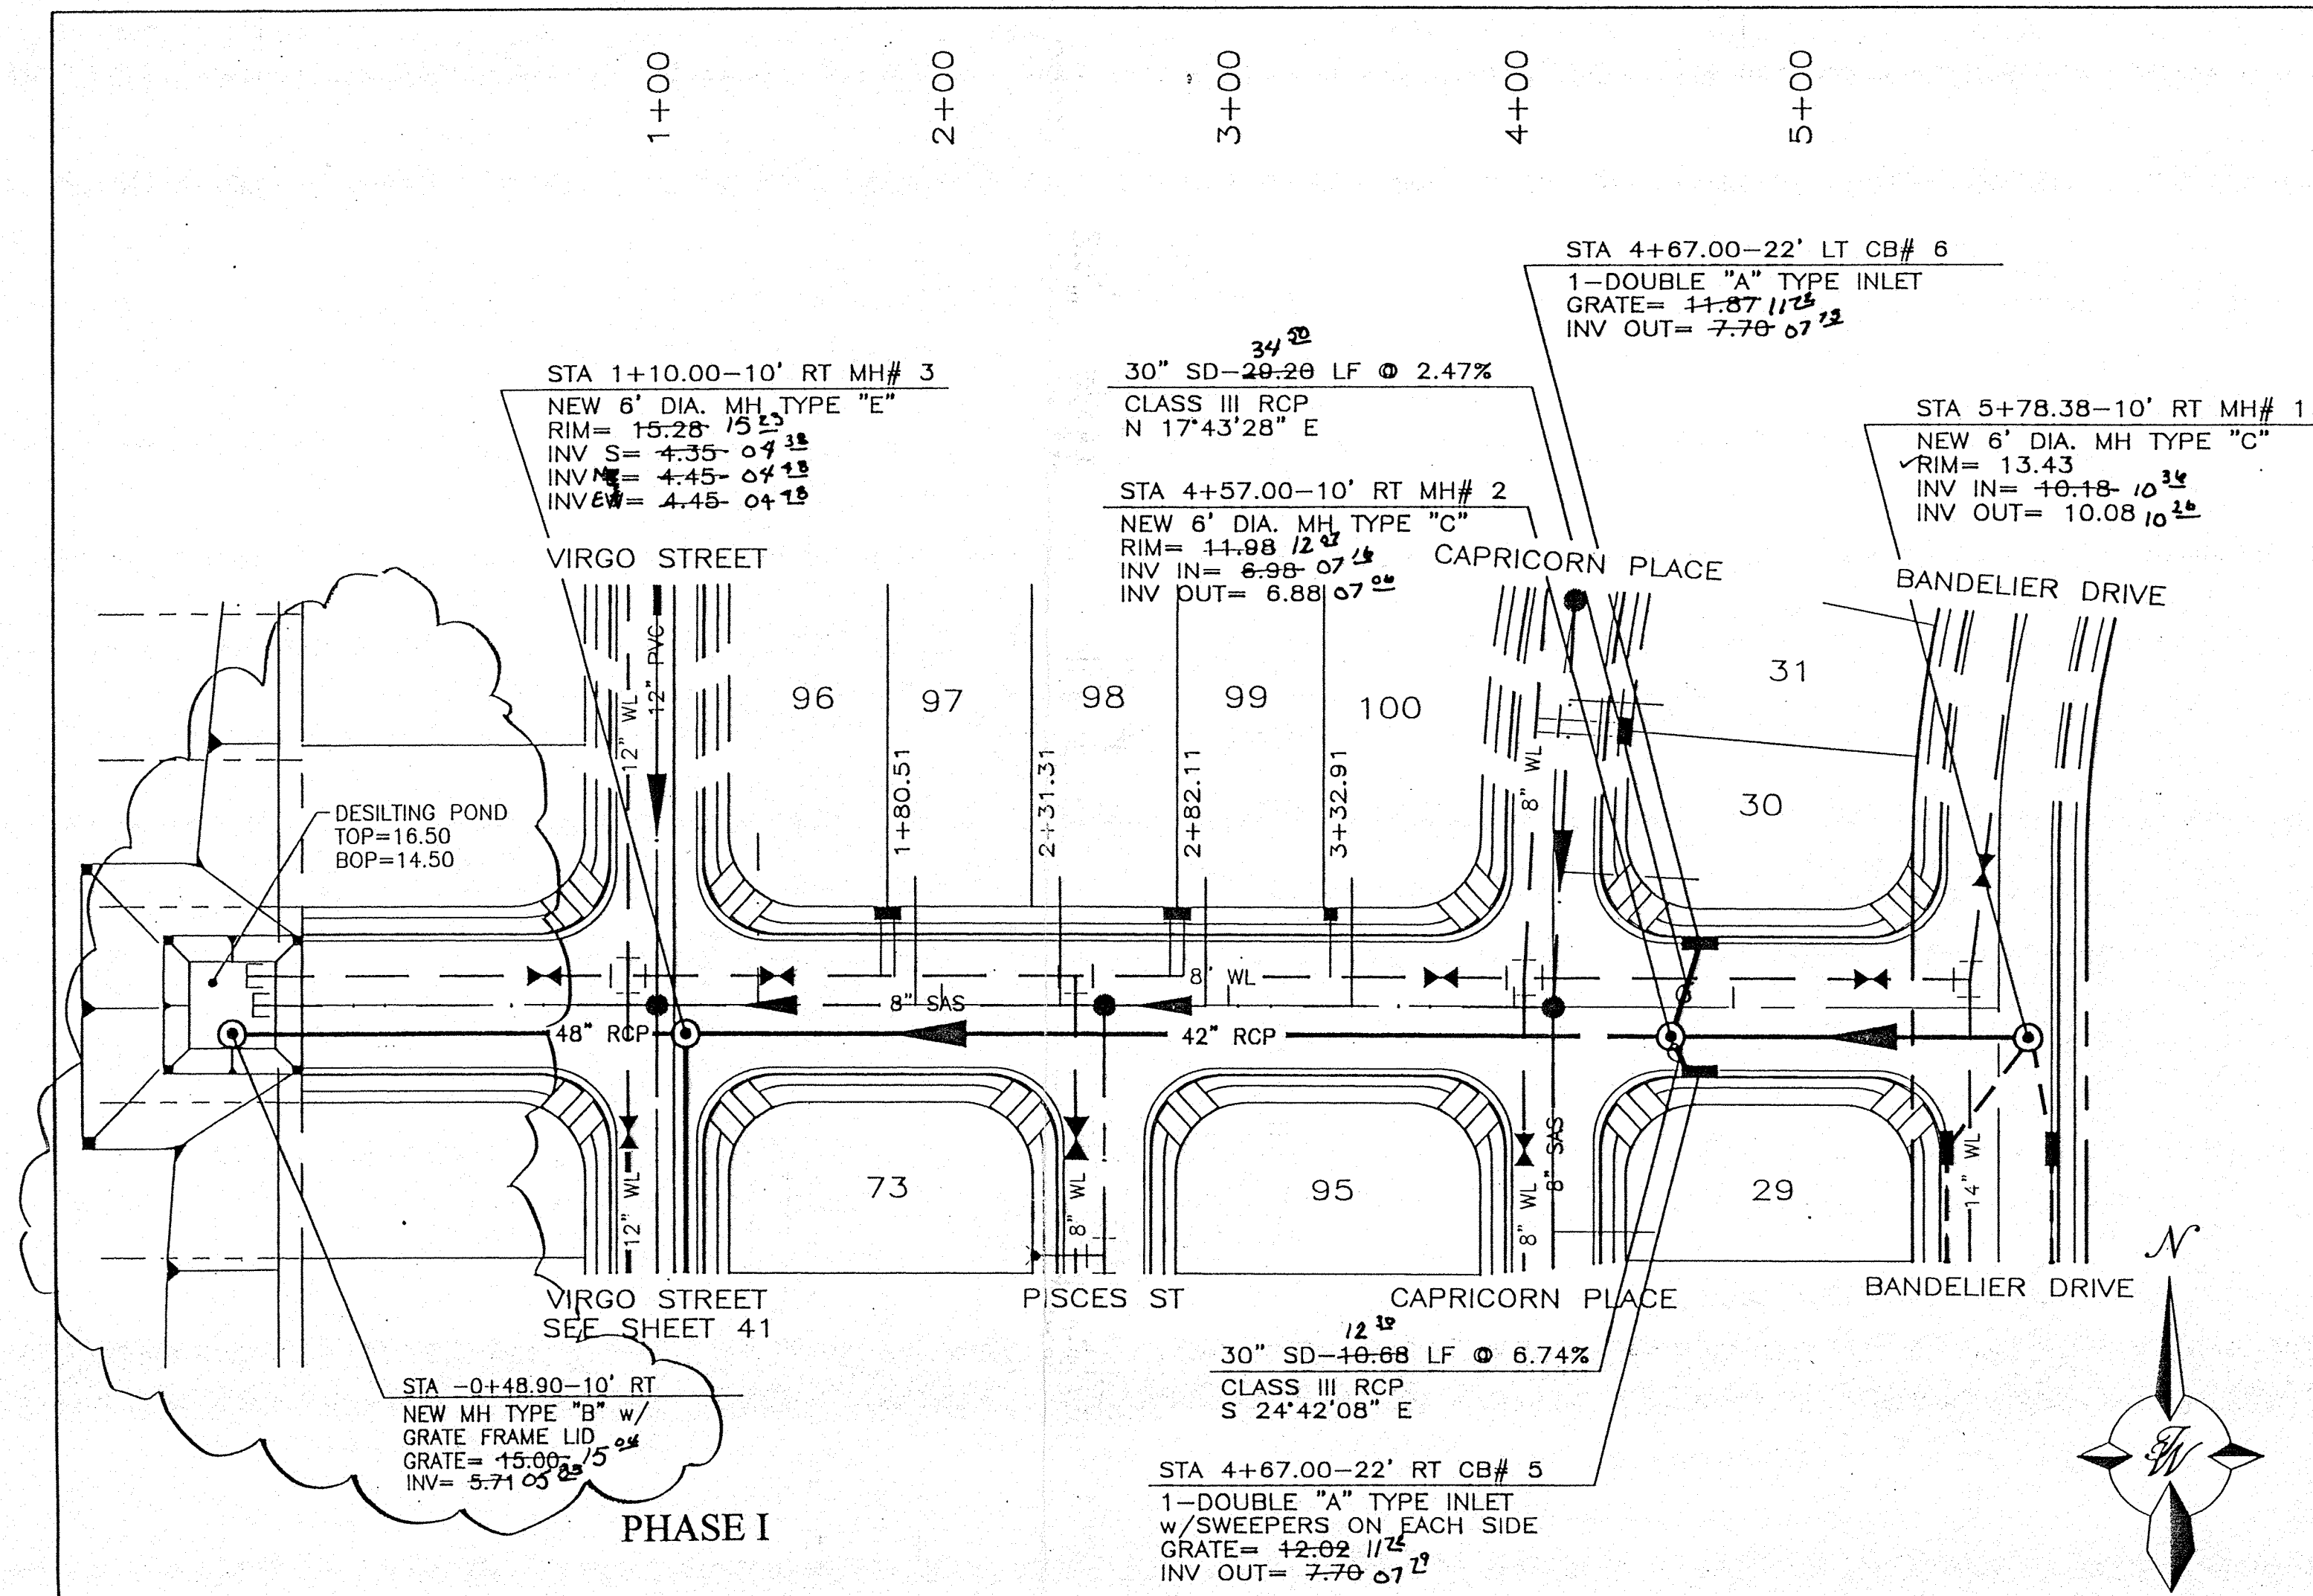


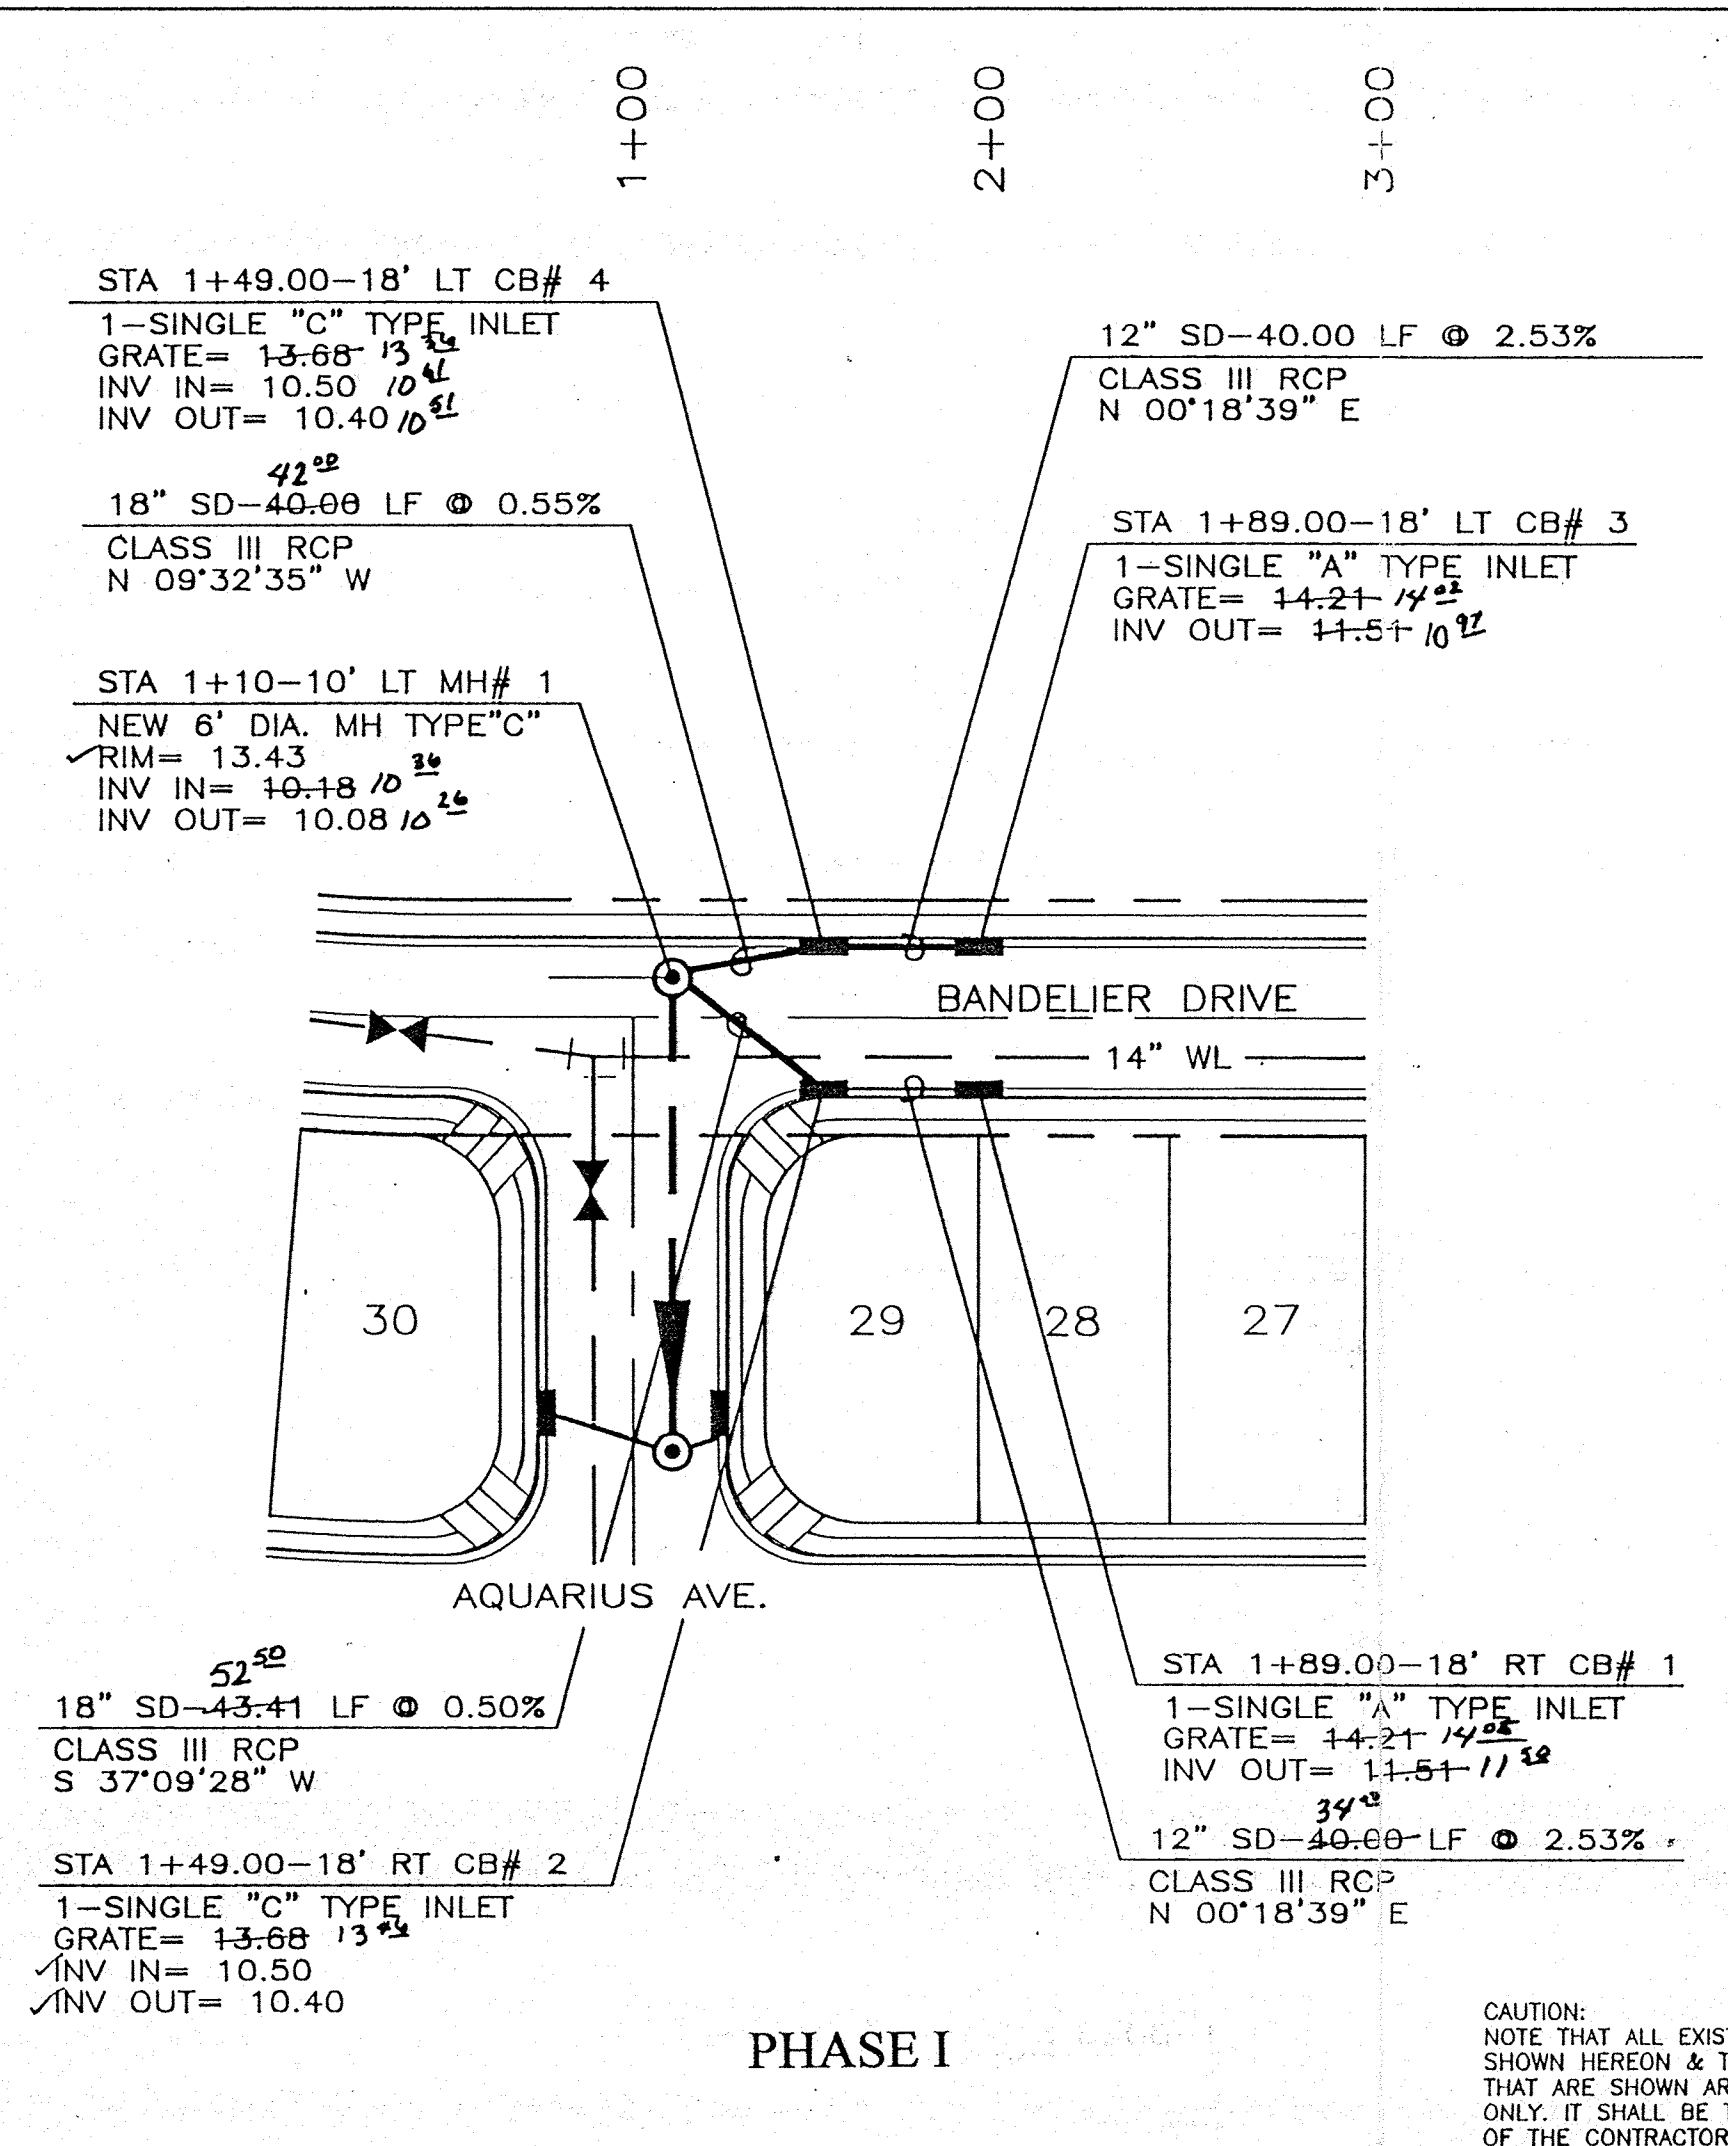


PHASE I
AQUARIUS AVENUE NW
STA -0+48.90 TO STA 5+68.38

SCALE: HORIZ. 1"=50'
VERT. 1"= 5'

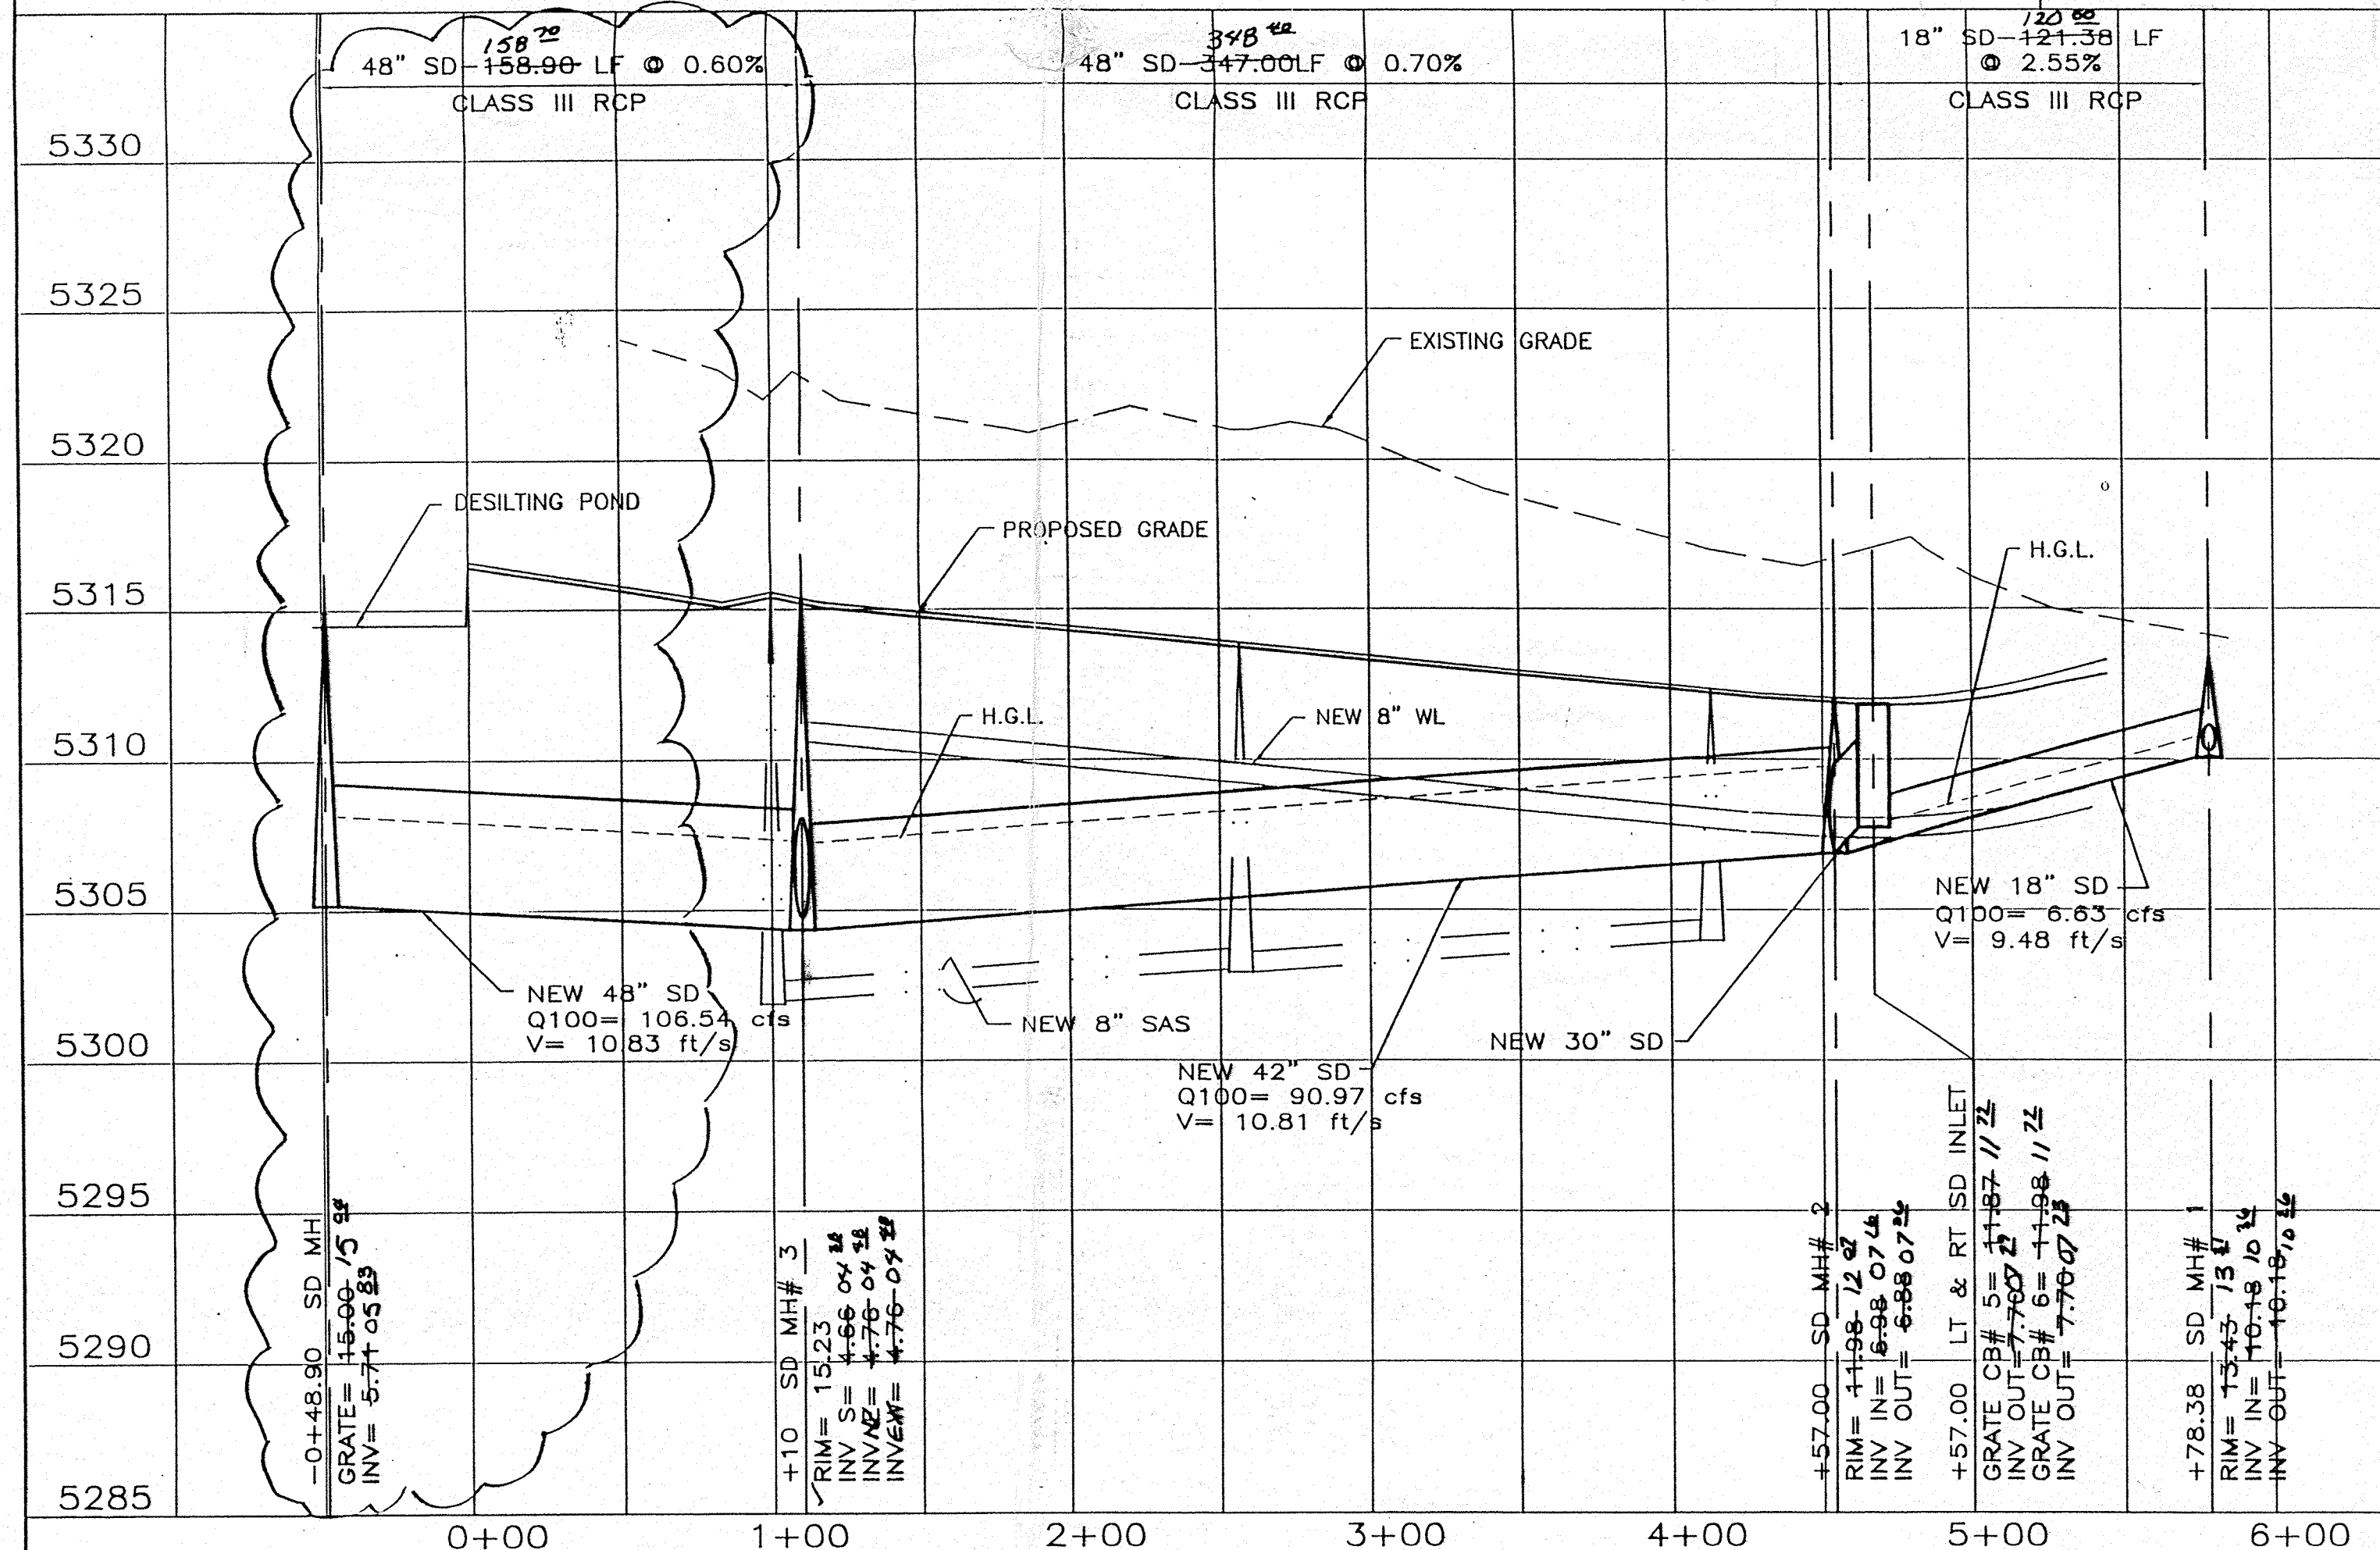

PHASE I
BANDELIER DRIVE
STA 1+00 TO STA 1+89.00



SCALE: HORIZ. 1"=50'
VERT. 1"= 5'

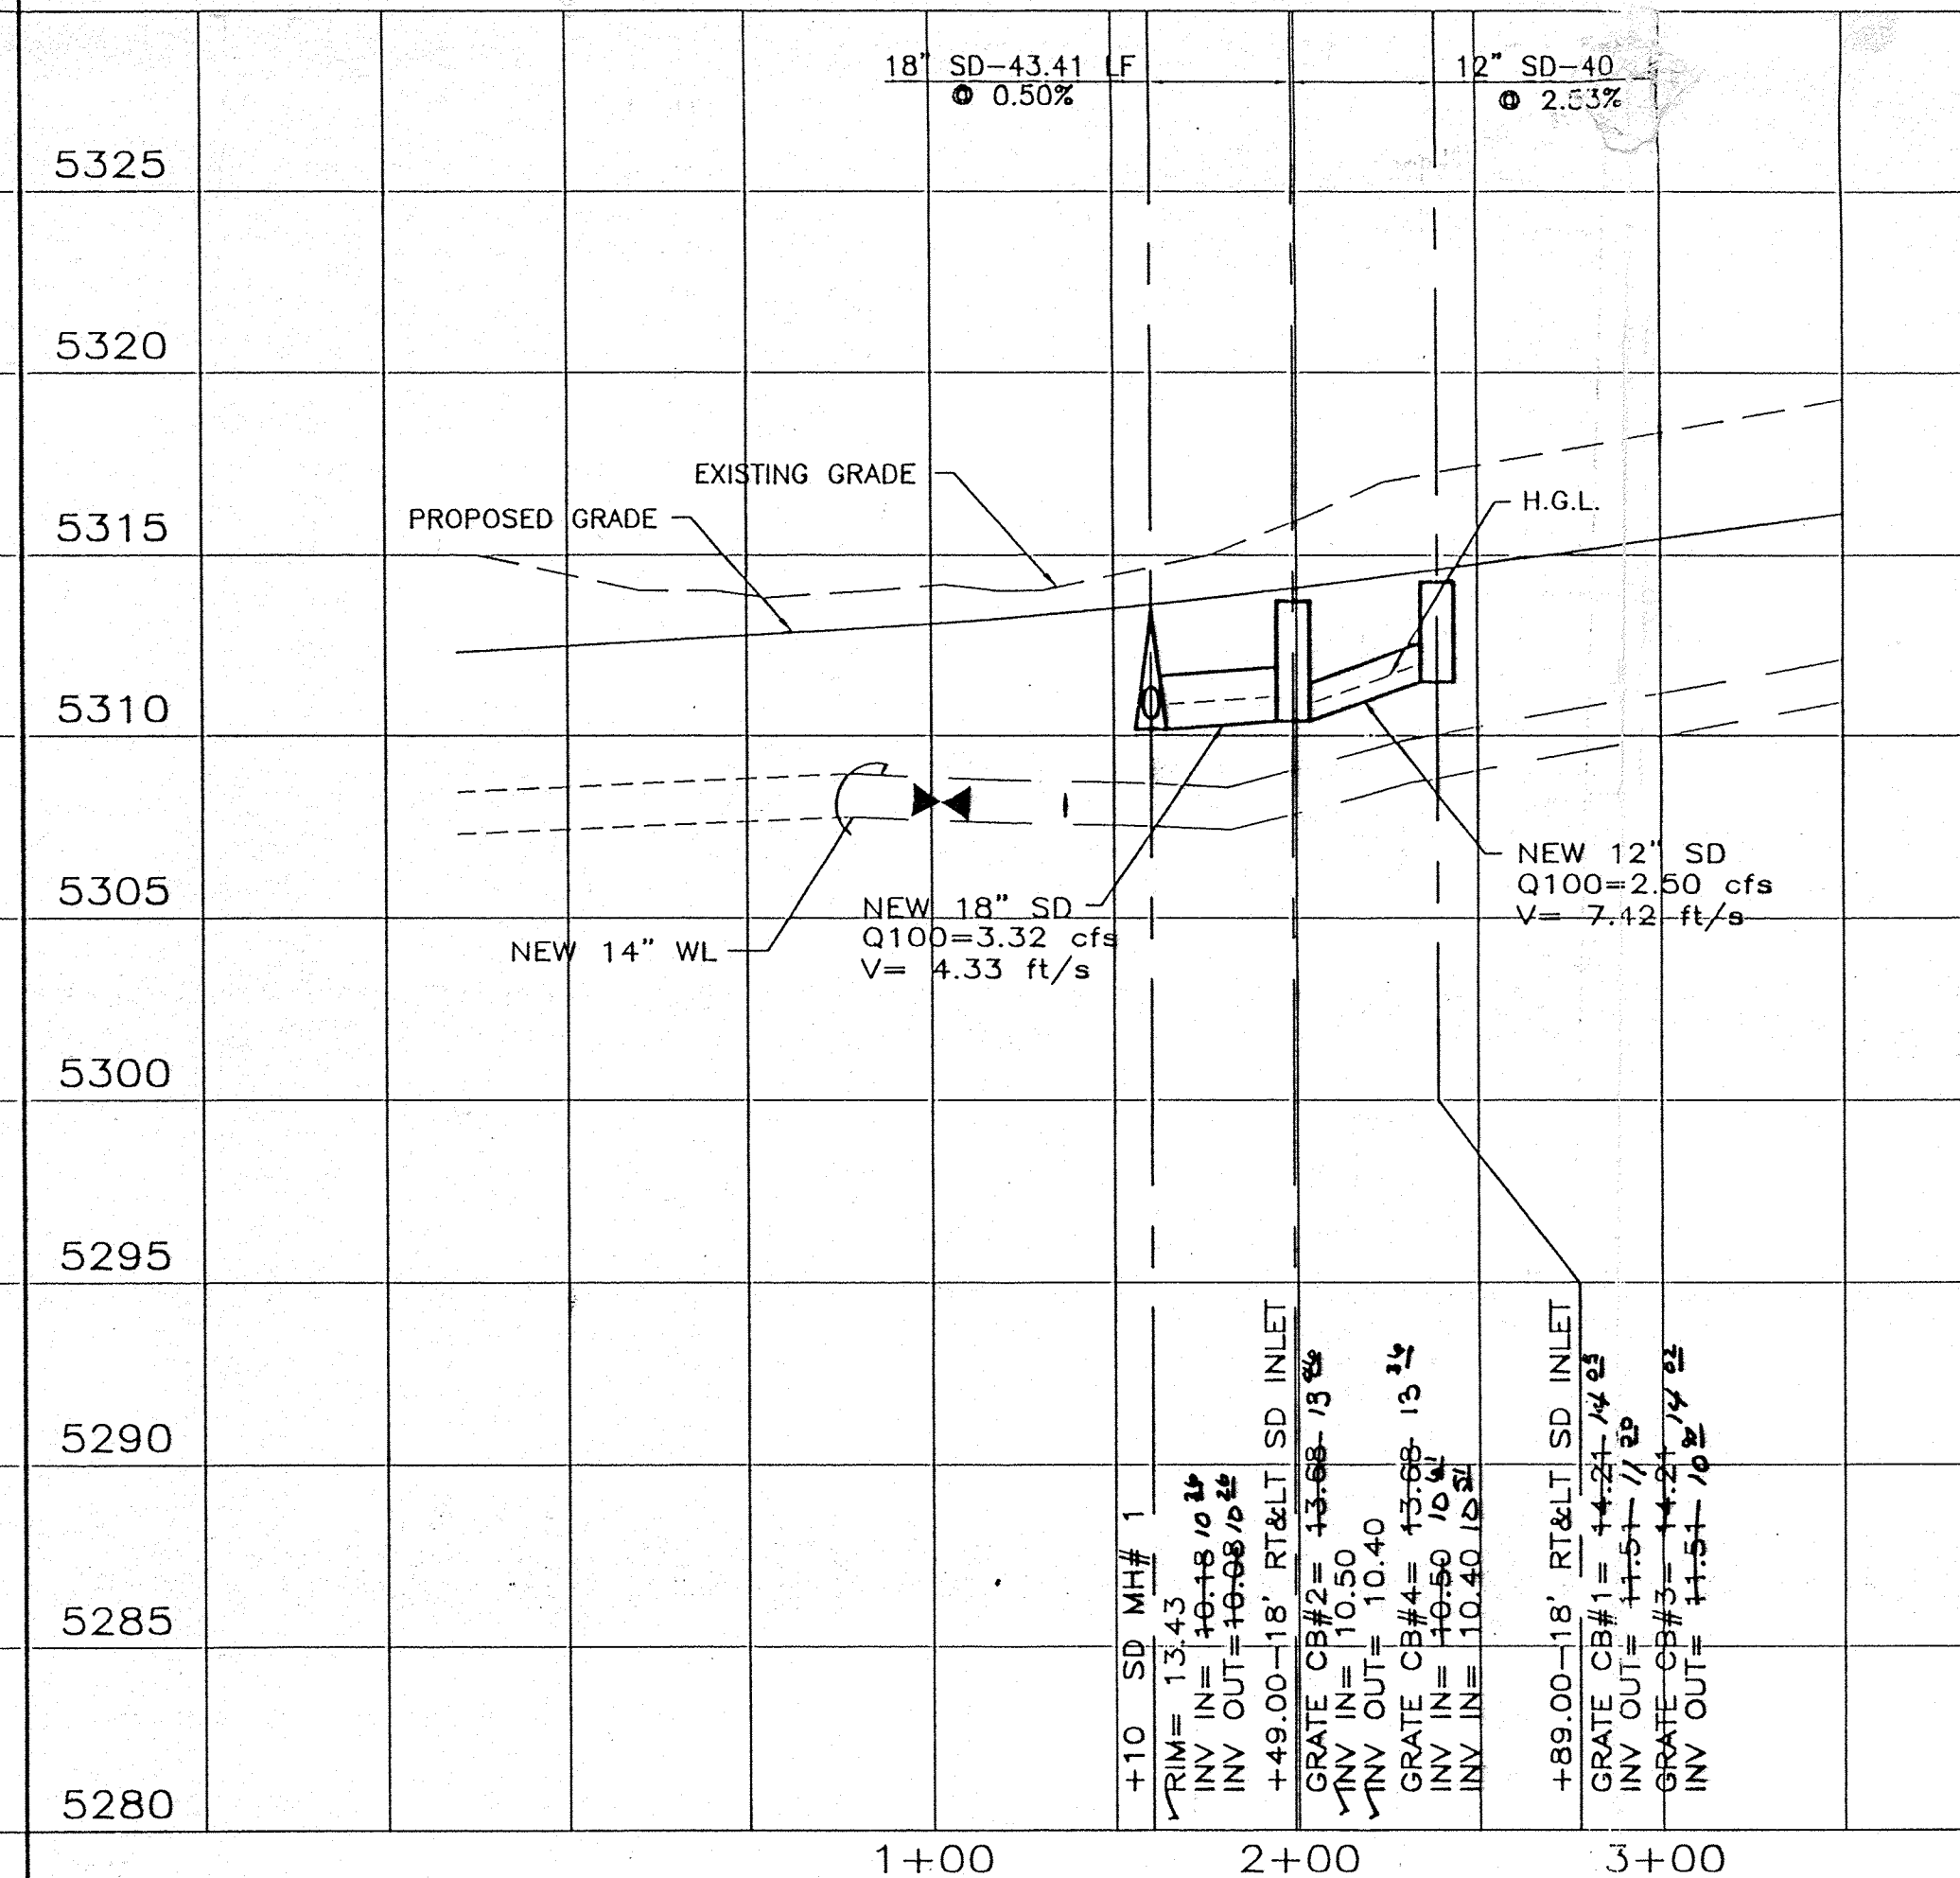

RECORD DRAWING
DATE: 12/18/96
DRAFTED BY: Tierra West Dev.
THESE RECORD DRAWINGS HAVE BEEN PREPARED IN PART, ON THE BASIS OF INFORMATION COMPILED AND FURNISHED BY OTHERS. THE ENGINEER WILL NOT BE RESPONSIBLE FOR ANY ERRORS OR OMISSIONS WHICH HAVE BEEN INCORPORATED INTO THIS DOCUMENT AS A RESULT.


TERRA WEST DEVELOPMENT MANAGEMENT SERVICES 4421 MCLEOD ROAD, N.E., SUITE D ALBUQUERQUE, NEW MEXICO 87109 (505)883-7592			CITY OF ALBUQUERQUE PUBLIC WORKS DEPARTMENT ENGINEERING GROUP		
TITLE: PARADISE SKIES STORM SEWER IMPROVEMENTS AQUARIUS AVENUE & BANDELIER DRIVE					
APPROVALS	ENGINEER	DATE	APPROVALS	ENGINEER	DATE
DRC CHAIRMAN	<i>[Signature]</i>	12-29-95	WATER	<i>[Signature]</i>	11-30-95
TRANSPORTATION	<i>[Signature]</i>	11-30-95	WASTE WATER	<i>[Signature]</i>	11-30-95
HYDROLOGY	<i>[Signature]</i>	12-29-95	NMU		
PROJECT NO. 5279.90		MAP NO. A-11-Z		SHEET 40 OF 43	

AS BUILT INFORMATION		BENCH MARKS		SURVEY INFORMATION		ENGINEER'S SEAL	
CONTRACTOR	SPRALL CONSTRUCTION INC.	ACS	"1-A11"	NO.	DATE	BY	DATE
WORKED BY	JEFF MORTENSEN	CENTRAL STATION DATA					
INSPECTOR'S	CONAL SCIENCE	NW STATE PLANE COORDINATES					
ACCEPTANCE BY	DATE 12/18/96	Central Zone					
VERIFICATION BY	TERRA WEST DEV.	X=365236.60					
DRAWINGS	DATE 12/19/96	Y=1531711.91					
CORRECTIONS	DATE 12/19/96	G=0-0999658					
MICRO-FILM INFORMATION		RECORDED BY		DATE		NO.	

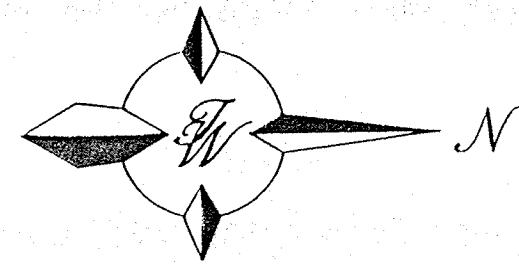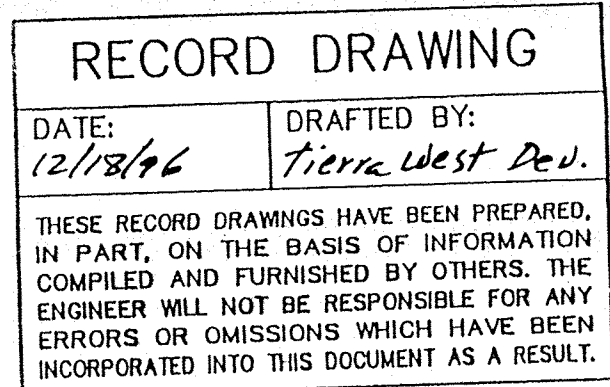

SCALE: HORIZ. 1"=50'
VERT. 1"= 5'

SURVEY INFORMATION		BENCH MARKS		AS BUILT INFORMATION	
FIELD NOTES					
NO.	BY	DATE			
			ACS "1-A11"	CONTRACTOR	STARLING CONSTRUCTION INC.
			CENTRAL STATION DATA	WORK	JEFF MORTENSEN DATE 5/1/95
			NM STATE PLANE COORDINATES	STAKED BY	JEFF MORTENSEN DATE 5/1/95
			Central Zone	ACCEPTANCE BY	COMM. SCIENCE DATE 12/18/96
			X=365236.60	FIELD LOCATION	R ² SPARLING INC. DATE 12/15/96
			Y=1531711.91	DRAWINGS	DATE 12/19/96
			G-G=0.9996658	CORRECTED BY	TERRA WEST DEV. DATE 12/19/96
			A-B=0.001536	MICRO-FILM INFORMATION	
				RECORDED BY	DATE
				NO.	

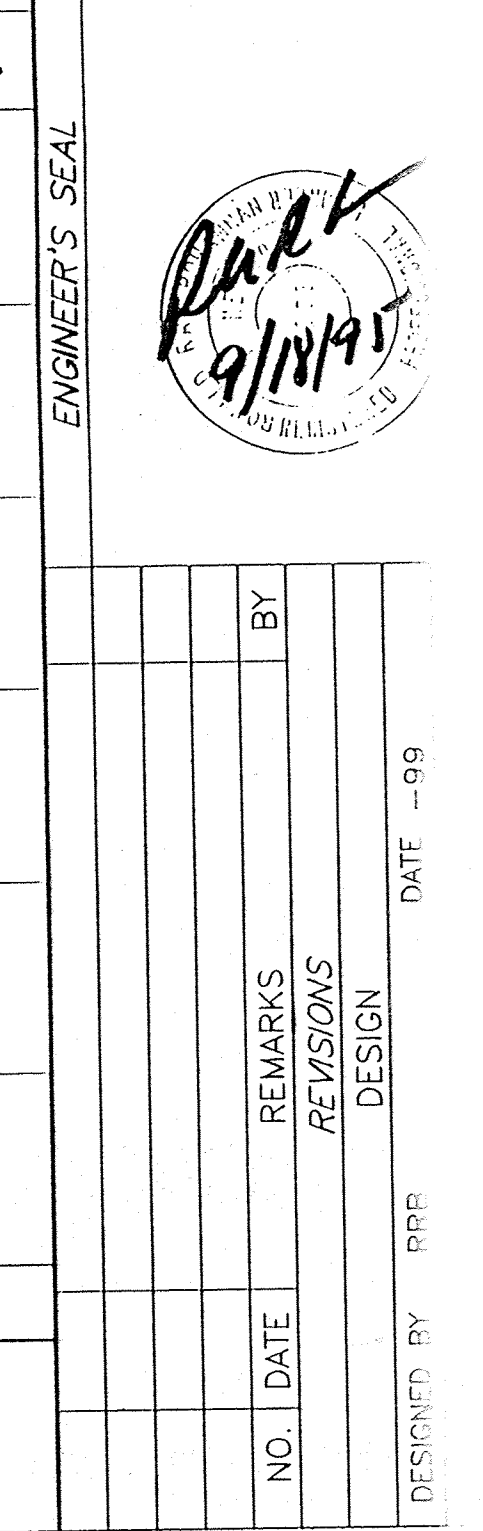


CITY OF ALBUQUERQUE
PUBLIC WORKS DEPARTMENT
ENGINEERING GROUP


APPROVALS	ENGINEER	DATE	APPROVALS	ENGINEER	DATE
DRC CHAIRMAN	B.P. Sankar	11-15-95	WATER	R.W. Kane	10-15-95
TRANSPORTATION	M. R. Rito	10-20-95	WASTE WATER	R.W. Kane	10-15-95
HYDROLOGY	M. R. Rito	10-25-95	NMU	[Signature]	10-25-95

PROJECT NO.	MAP NO.	SHEET OF
5279.90	A-11-Z	41 43


PHASE I

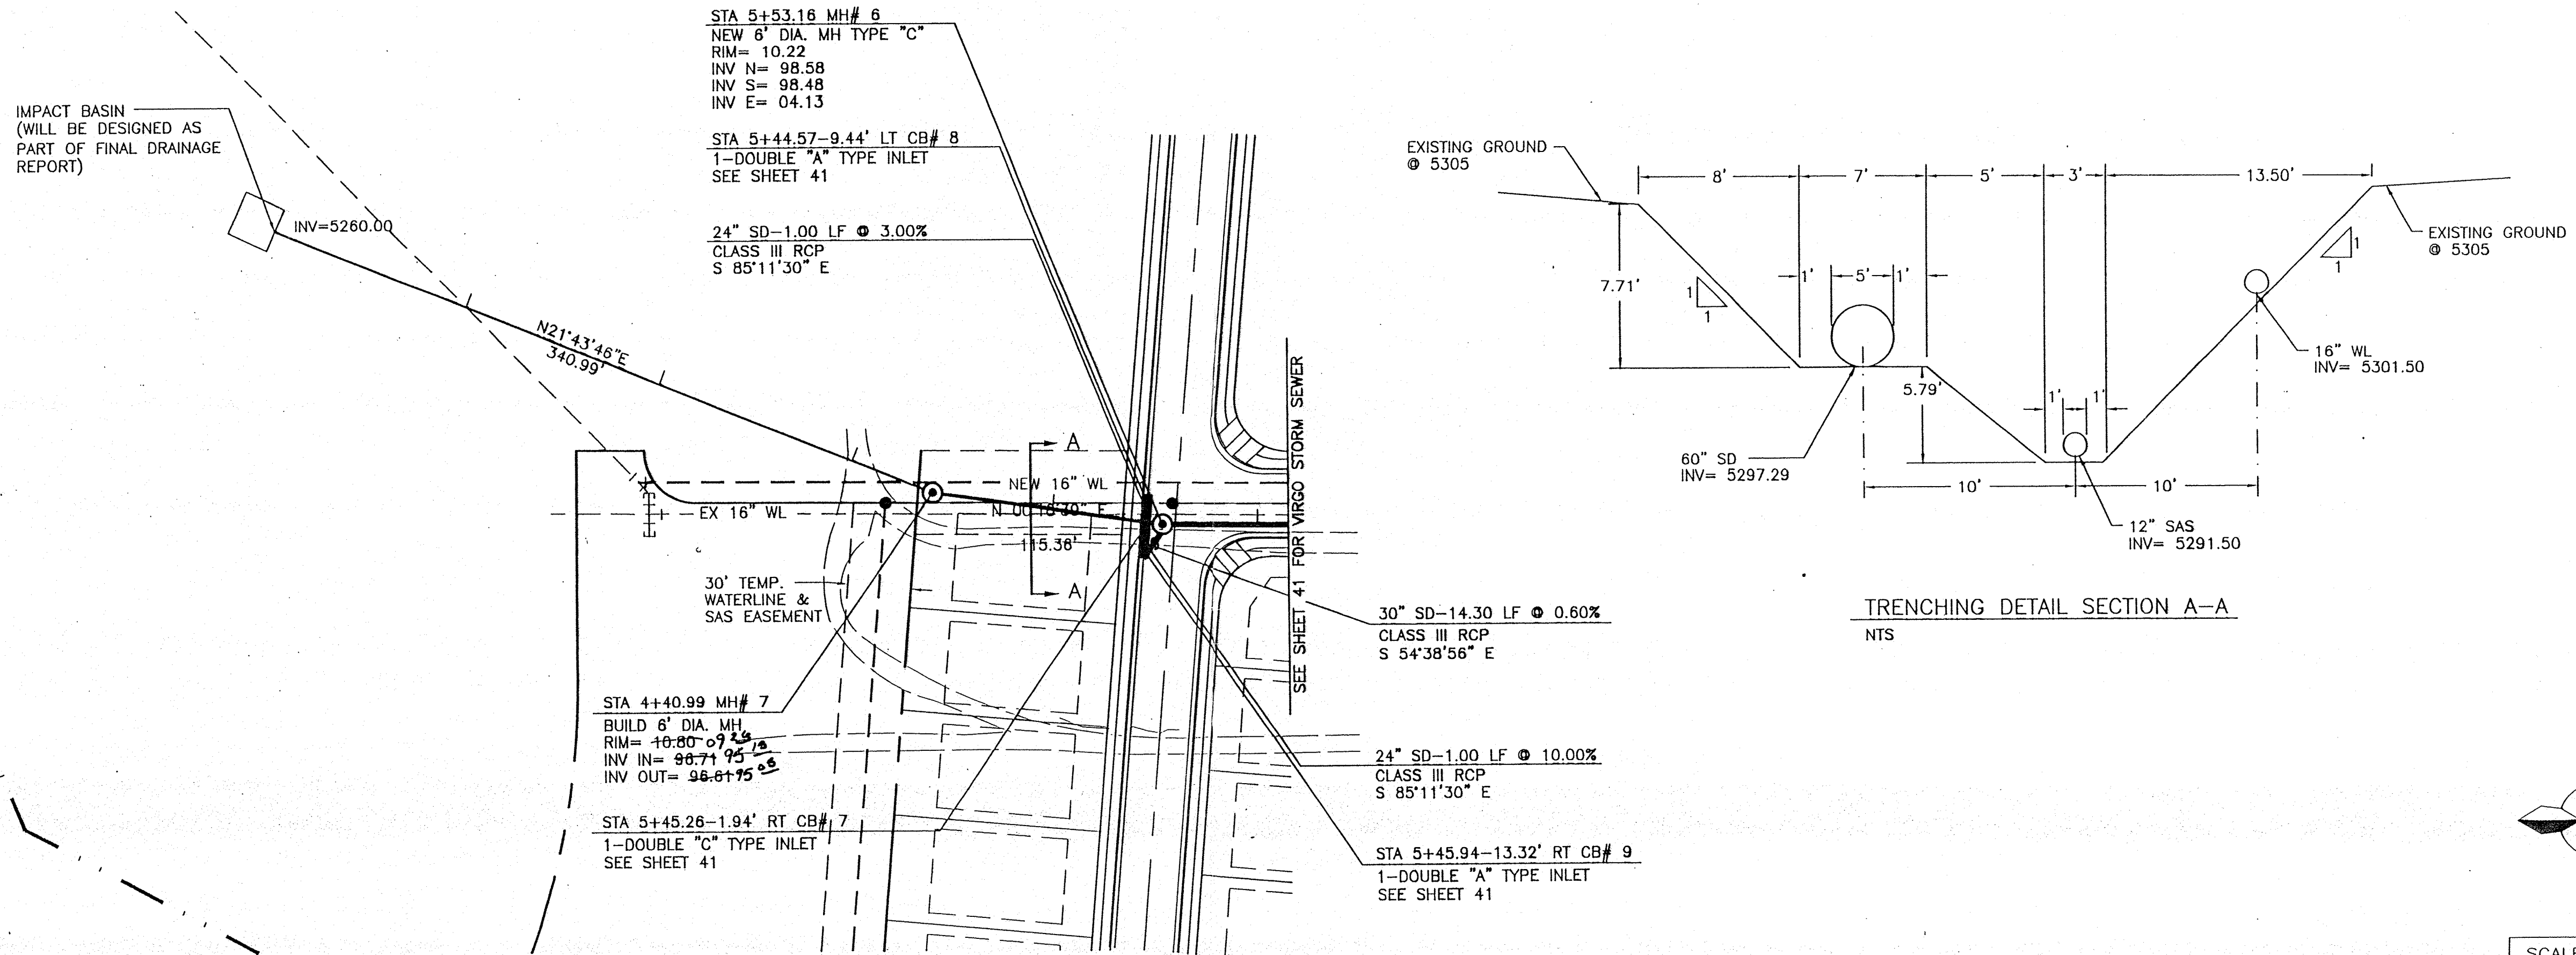

TRENCHING DETAIL SECTION A-A
NTS

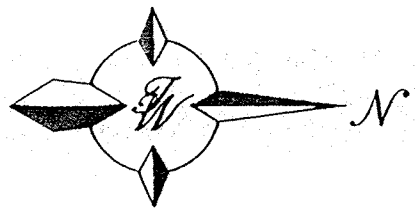

SCALE: HORIZ. 1"=50'
VERT. 1"=10'

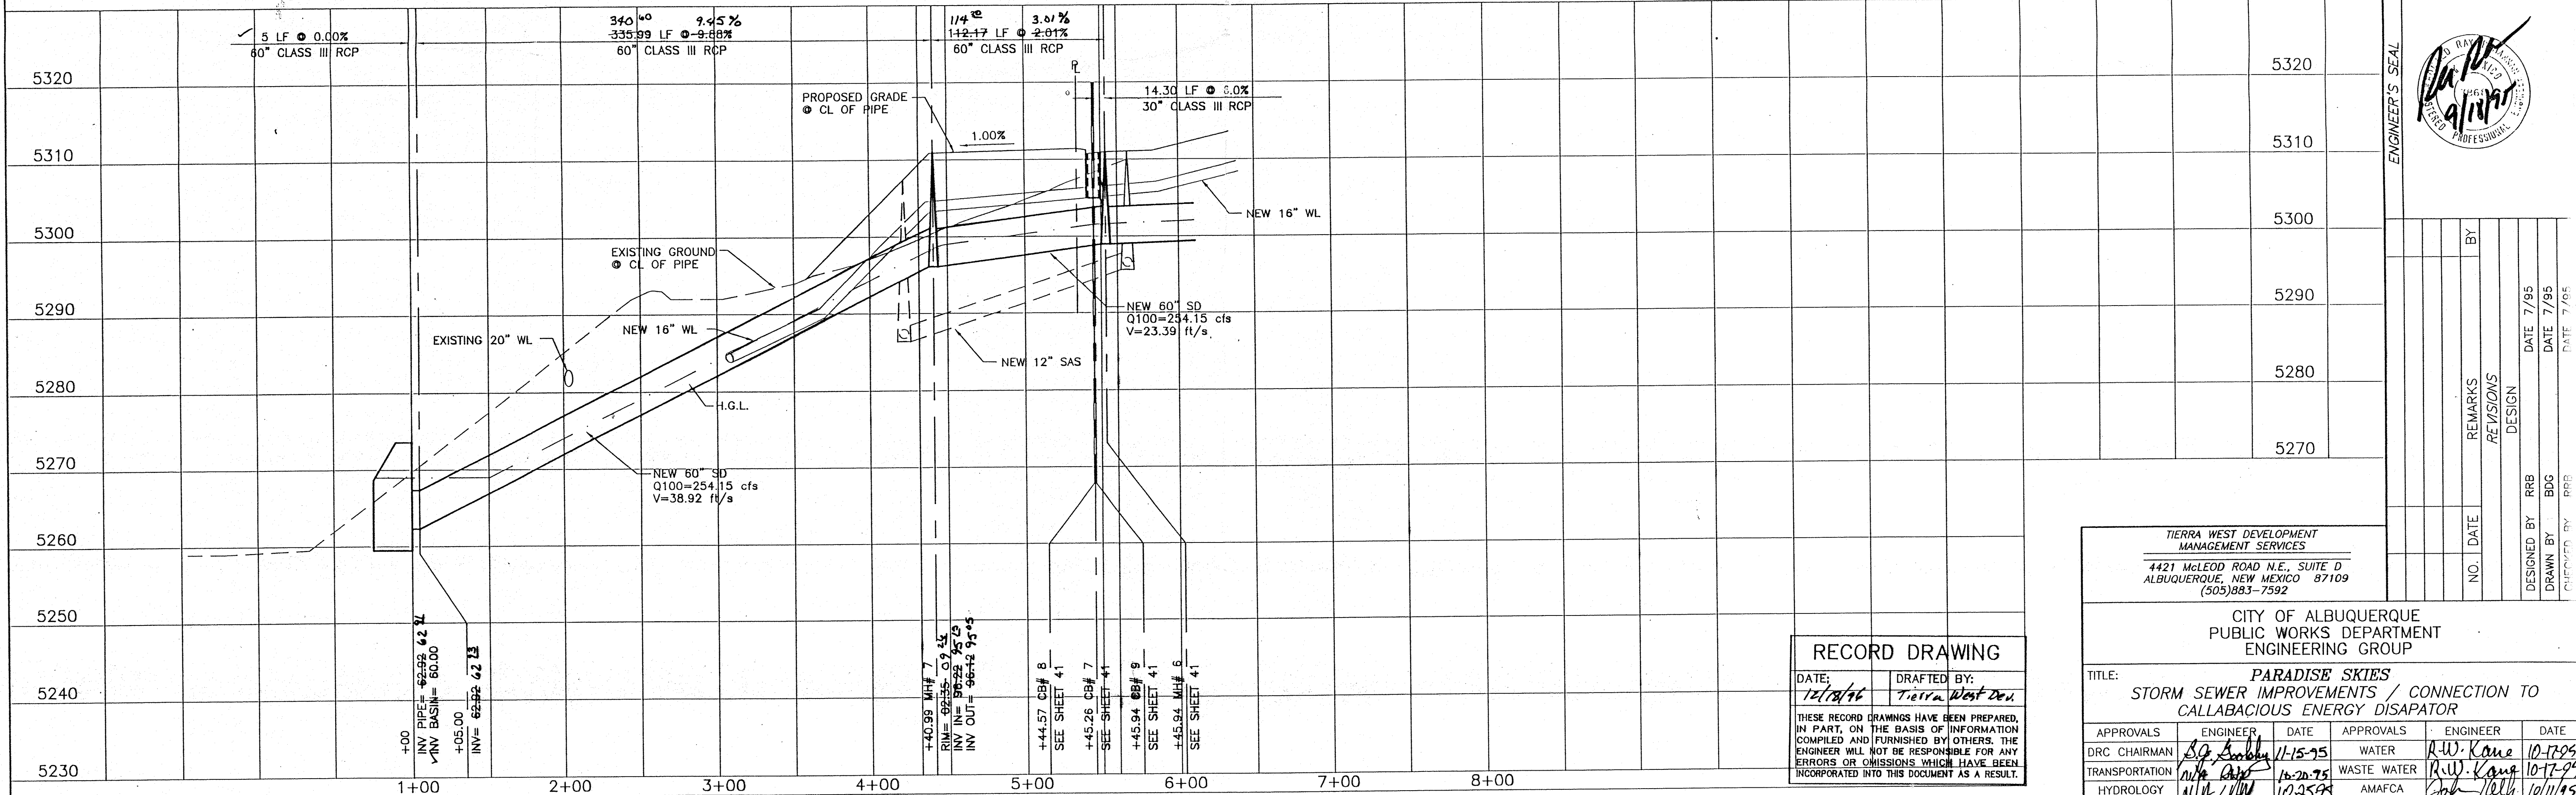

RECORD DRAWING

DATE: 12/18/96
DRAFTED BY: Terra West Inc.

THESE RECORD DRAWINGS HAVE BEEN PREPARED, IN PART, ON THE BASIS OF INFORMATION COMPILED AND FURNISHED BY OTHERS. THE ENGINEER WILL NOT BE RESPONSIBLE FOR ANY ERRORS OR OMISSIONS WHICH HAVE BEEN INCORPORATED INTO THIS DOCUMENT AS A RESULT.

TIERRA WEST DEVELOPMENT
MANAGEMENT SERVICES
4421 McLEOD ROAD N.E., SUITE D
ALBUQUERQUE, NEW MEXICO 87109
(505)883-7592

CITY OF ALBUQUERQUE
PUBLIC WORKS DEPARTMENT
ENGINEERING GROUP
TITLE: PARADISE SKIES
STORM SEWER IMPROVEMENTS / CONNECTION TO
CALLABACIOUS ENERGY DISAPATOR

APPROVALS	ENGINEER	DATE	APPROVALS	ENGINEER	DATE
DRC CHAIRMAN	<i>[Signature]</i>	11-15-95	WATER	<i>[Signature]</i>	10-17-95
TRANSPORTATION	<i>[Signature]</i>	10-20-95	WASTE WATER	<i>[Signature]</i>	10-17-95
HYDROLOGY	<i>[Signature]</i>	10-25-95	AMAFCA	<i>[Signature]</i>	10/11/95

PROJECT NO. 5279.90
MAP NO. A-11-Z
SHEET 42 OF 43

PHASE I

SURVEY INFORMATION			BENCH MARKS		AS BUILT INFORMATION	
NO.	FIELD NOTES		AS "1-A11"	CENTRAL STATION DATA	CONTRACTOR	SPARKLING CONSTRUCTION INC.
	BY	DATE				
					WORKED BY	JEFF MORTENSEN
					INSPECTOR'S	DATE 5/1/95
					FIELD VERIFICATION	DATE 2/18/96
					COORDINATED BY	BY CONN. SCIENCE
					FIELD VERIFICATION	DATE 12/15/96
					COORDINATED BY	BY SPARKLING INC.
					COORDINATED BY	DATE 12/19/96
					MICRO-FILM INFORMATION	
					RECORDED BY	DATE
					NO.	
						</



NO.	DATE	REMARKS	BY
		DESIGN	
		DESIGNED BY	RRB
		DRAWN BY	BDC
		CHECKED BY	RRB
		DATE	7/95
		DATE	7/95