

DRAINAGE MANAGEMENT PLAN

I. PURPOSE

The purpose of this submittal is to present the grading and drainage management plan for McMahon Marketplace. The project consists of approximately 12.16 acres of land to be developed for commercial use.

II. SITE LOCATION AND CHARACTERISTICS

The project is south of McMahon Blvd and north of Tuscan West Unit 4 and bordered to the west by Unser Blvd and to the east by Fineland Drive. The site is currently undeveloped tracts, with native shrubs and grasses.

III. EXISTING HYDRAULIC AND HYDROLOGIC CONDITIONS

In the existing conditions, the site drains across moderately sloped terrain towards the north. Currently the westerly portion of the site discharges directly to McMahon and Unser, while the easterly portion discharges to an existing pond located on the east half of the site. The runoff then flows north on Unser and west on McMahon which ultimately is captured by inlet upstream of the intersection. The flow is then carried north within the Unser storm drain to the Black Arroyo Blvd storm drain system and ultimately to the Black Arroyo.

A Master Drainage Study for the Unser/ McMahon Area was prepared by Bohannan Huston, dated July 17, 2001 and revised November 13, 2001, analyzes the entire basin area discharging to the Black Arroyo Blvd storm drain system. That report also addresses this site specifically. The proposed McMahon Marketplace is described in the report as Basin DC2 and allows full discharge ($Q_{100} = 41.55\text{cfs}$) into McMahon.

IV. INTERIM HYDRAULIC AND HYDROLOGIC CONDITIONS

In the interim conditions, the only portion of the site which will be developed is the northwest corner. A CVS Drugstore is proposed at this location. Basin A, B, C1, C2 and E-1 are the only part of the site which will be developed at this time. Basin A is the CVS site, Basin B is the entrance off of McMahon and Basins C and Basin E are the access roads off of Fineland and Unser. Basin A ($Q_{100}=6.81\text{cfs}$) drains toward and is collected at the northeast corner of the basin by a Type "D" inlet which is connected to the main storm drain line in McMahon Blvd. Basin B ($Q_{100}=1.12\text{cfs}$) discharges directly in McMahon Blvd where it is collected by existing inlets downstream. Basin C-1 ($Q_{100}=0.35\text{cfs}$) discharges north to the lowpoint located at the southeast corner of the CVS site where it is collected by a Type "A" inlet and conveyed north via a 24" storm drain which connects to the same above mentioned storm drain in McMahon. Basin C-2 ($Q_{100}=1.53\text{cfs}$) is conveyed to a lowpoint with curb cuts and discharges in Basin D and follows existing drainage patterns into McMahon Blvd where it will be collected by existing inlets downstream. Basin E-1 ($Q_{100}=1.67\text{cfs}$) will discharge north and combine with Basin A-1 ($Q_{100}=1.68\text{cfs}$) where the combined flow will be carried downstream to the Type "D" inlet on the northeast corner of the site via a 2" ribbon channel a sidewalk culvert. Basin E-2 ($Q_{100}=1.72\text{cfs}$) discharges to a desilatation pond located at the northeast corner of the site where it will discharge via curb cut to same lowpoint, inlet end manner as Basin C-2. Basin D ($Q_{100}=3.97\text{cfs}$) is undeveloped therefore the existing drainage patterns will not be changed. The westerly portion discharges directly into McMahon and the easterly portion discharges into an existing retention pond. Basin F ($Q_{100}=4.18\text{cfs}$) discharges to a desilatation pond located south of lowpoint within Basin C-2. Basin G ($Q_{100}=2.83\text{cfs}$) flows to a swale where it is diverted west to the same desilatation pond from Basin F. Both Basin F and combine with Basin C and a portion of Basin D where they follow existing drainage patterns and discharge in McMahon Blvd. The total discharge from the interim site is $Q_{100}=24.5\text{cfs}$ which is well below the allowable discharge of 41.55cfs.

V. FULLY DEVELOPED HYDRAULIC AND HYDROLOGIC CONDITIONS

In the ultimate conditions, the total McMahon Market place discharges a 100-yr, 6-hour flow of 49.9cfs. The total discharge allowed from the Master Drainage Study for the Unser/McMahon Area is 41.55cfs. The total flow was based a land treatment type of 0% A, 5% B, 10% C and 85% D. The future development can either create a pond to restrict the flow to the 41.55cfs or modify the amount of landscaping to reduce the amount of Land Treatment Type "D" to reduce the runoff from 49.9cfs to 41.55cfs. The storm drain pipe being constructed with the interim plan have been sized to accommodate future flow, however a second storm drain connection to the McMahon storm drain maybe necessary to discharge a future runoff.

VI. CONCLUSION

This plan provides hydrologic and hydraulic considerations for McMahon Marketplace. These flows can be safely conveyed by the improvements proposed in this plan to the existing storm systems, which have adequate capacity to accept such runoff. With the exception of the approximate 3cfs difference in the total developed flow and the allowable discharge in McMahon as stated above. This information provides adequate supporting documentation and guidance for approval of this plan.



FULLY DEVELOPED CONDITIONS FOR INLETS IN MCMAHON MARKETPLACE

	INLET	CONDITION	TYPE	FLOW TO INLET 100-YR	STREET DEPTH (FT)	GRATE CAP.(cfs)
AP1	1	ON 0.60% GRADE: "A" Double Grate		2.00	0.20	7.90
AP2	2	SUMP	"A" Single Grate	5.38	0.25	6.65
AP3	3	ON 3.33% GRADE: "D" Single Grate		7.82	0.33	9.48

STORM DRAIN ANALYSIS

PIPE NO.	SIZE/TYPE	LENGTH (ft.)	SLOPE (%)	INTERIM Q (100-YR, cfs)	ULTIMATE Q (100-YR, cfs)	PIPE CAPACITY (100-YR, cfs)
SD1	18" SD	123.00	2.51	2.00	2.00	16.64
SD2	24" SD	32.00	0.00	0.00	13.28	17.52
SD3	24" SD	56.89	1.00	5.38	18.66	22.64
SD4	24" SD	189.15	0.80	7.35	20.66	20.98
SD5	24" SD	94.25	6.18	15.20	28.48	56.24
ESD6	36" SD	N/A	0.92	26.20	52.55	63.97
SD7	18" SD	6.00	2.00	0.00	7.77	14.37

* EX STORM DRAIN INFO TAKEN FROM CPN 618591 SHEET 51
Q100 FROM INLET IN MCMAHON = 11cfs
ALLOW DISCHARGE FROM SITE = 41.55cfs
ULTIMATE Q100 = 52.55cfs
INTERIM = 15.20cfs + 11cfs = 26.20 cfs

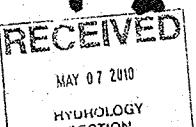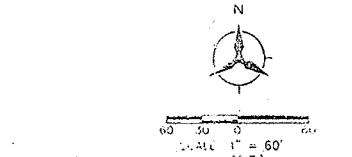

MAY 07 2010

HYDROLOGY
SECTION

Bohannan Huston

Courtyard I 7500 Jefferson St. NE Albuquerque, NM 87108-4335

ENGINEERING □ SPATIAL DATA □ ADVANCED TECHNOLOGIES

McMAHON MARKETPLACE DRAINAGE MANAGEMENT PLAN


ALBUQUERQUE, NEW MEXICO
MARCH, 2010


DRAINAGE BASIN CALCULATIONS FOR McMAHON MARKETPLACE						
BASIN	AREA (AC)	% LAND TREATMENT	DISCHARGE (CFS)			
ID.		A B C D	10 YR 100YR			
BASIN A	1.66	98.0% 2.0% 0.0% 0.0%	0.43 2.13			
BASIN B	0.29	100.0% 0.0% 0.0% 0.0%	0.07 0.37			
BASIN C	0.43	95.0% 2.5% 2.5% 0.0%	0.13 0.57			
BASIN D	2.77	96.0% 7.0% 7.0% 0.0%	1.03 3.97			
BASIN E	1.96	86.0% 9.0% 5.0% 0.0%	0.70 2.78			
BASIN F	3.03	90.0% 6.0% 4.0% 0.0%	1.00 4.18			
BASIN G	2.02	90.0% 3.0% 7.0% 0.0%	0.71 2.83			
TOTAL	12.16			4.08 16.83		

HYDROLOGICAL VOLUMETRIC & DISCHARGE DATA (EXISTING CALCULATED)						
BASIN A-1	0.41	0.0%	5.0%	10.0%	85.0%	1.08 1.68
BASIN A-2	1.25	0.0%	5.0%	10.0%	85.0%	3.30 5.13
BASIN B	0.29	0.0%	0.0%	33.0%	37.0%	0.70 1.12
BASIN C-1	0.05	0.0%	0.0%	0.0%	100.0%	0.23 0.35
BASIN C-2	0.35	0.0%	0.0%	0.0%	100.0%	1.01 1.53
Subtotal developed on site						9.81
BASIN D	2.77	86.0%	7.0%	7.0%	0.0%	1.03 3.97
BASIN E-1	0.71	56.0%	9.0%	5.0%	30.0%	0.82 1.67
BASIN E-2	1.25	90.0%	6.0%	4.0%	0.0%	0.41 1.72
BASIN F	3.03	90.0%	6.0%	4.0%	0.0%	1.00 4.18
BASIN G	2.02	90.0%	3.0%	7.0%	0.0%	0.71 2.83
Subtotal	12.16					10.30 24.2

FOLY DEVELOPED CONDITIONS FOR INLETS IN MCMAHON MARKETPLACE						
	INLET	CONDITION	TYPE	FLOW TO INLET 100-YR	STREET DEPTH (FT)	GRATE CAP.(cfs)
AP1	1	ON 0.60% GRADE: "A" Double Grate		2.00	0.20	7.90
AP2	2	SUMP	"A" Single Grate	5.38	0.25	6.65
AP3	3	ON 3.33% GRADE: "D" Single Grate		7.82	0.33	9.48

HYDROLOGICAL VOLUMETRIC & DISCHARGE DATA (DEVELOPED)						
INTERIM						
BASIN A-1	0.41	0.0%	5.0%	10.0%	85.0%	1.08 1.68
BASIN A-2	1.25	0.0%	5.0%	10.0%	85.0%	3.30 5.13
BASIN B	0.29	0.0%	0.0%	33.0%	37.0%	0.70 1.12
BASIN C-1	0.05	0.0%	0.0%	0.0%	100.0%	0.23 0.35
BASIN C-2	0.35	0.0%	0.0%	0.0%	100.0%	1.01 1.53
Subtotal developed on site						9.81
BASIN D	2.77	86.0%	7.0%	7.0%	0.0%	1.03 3.97
BASIN E-1	0.71	56.0%</				

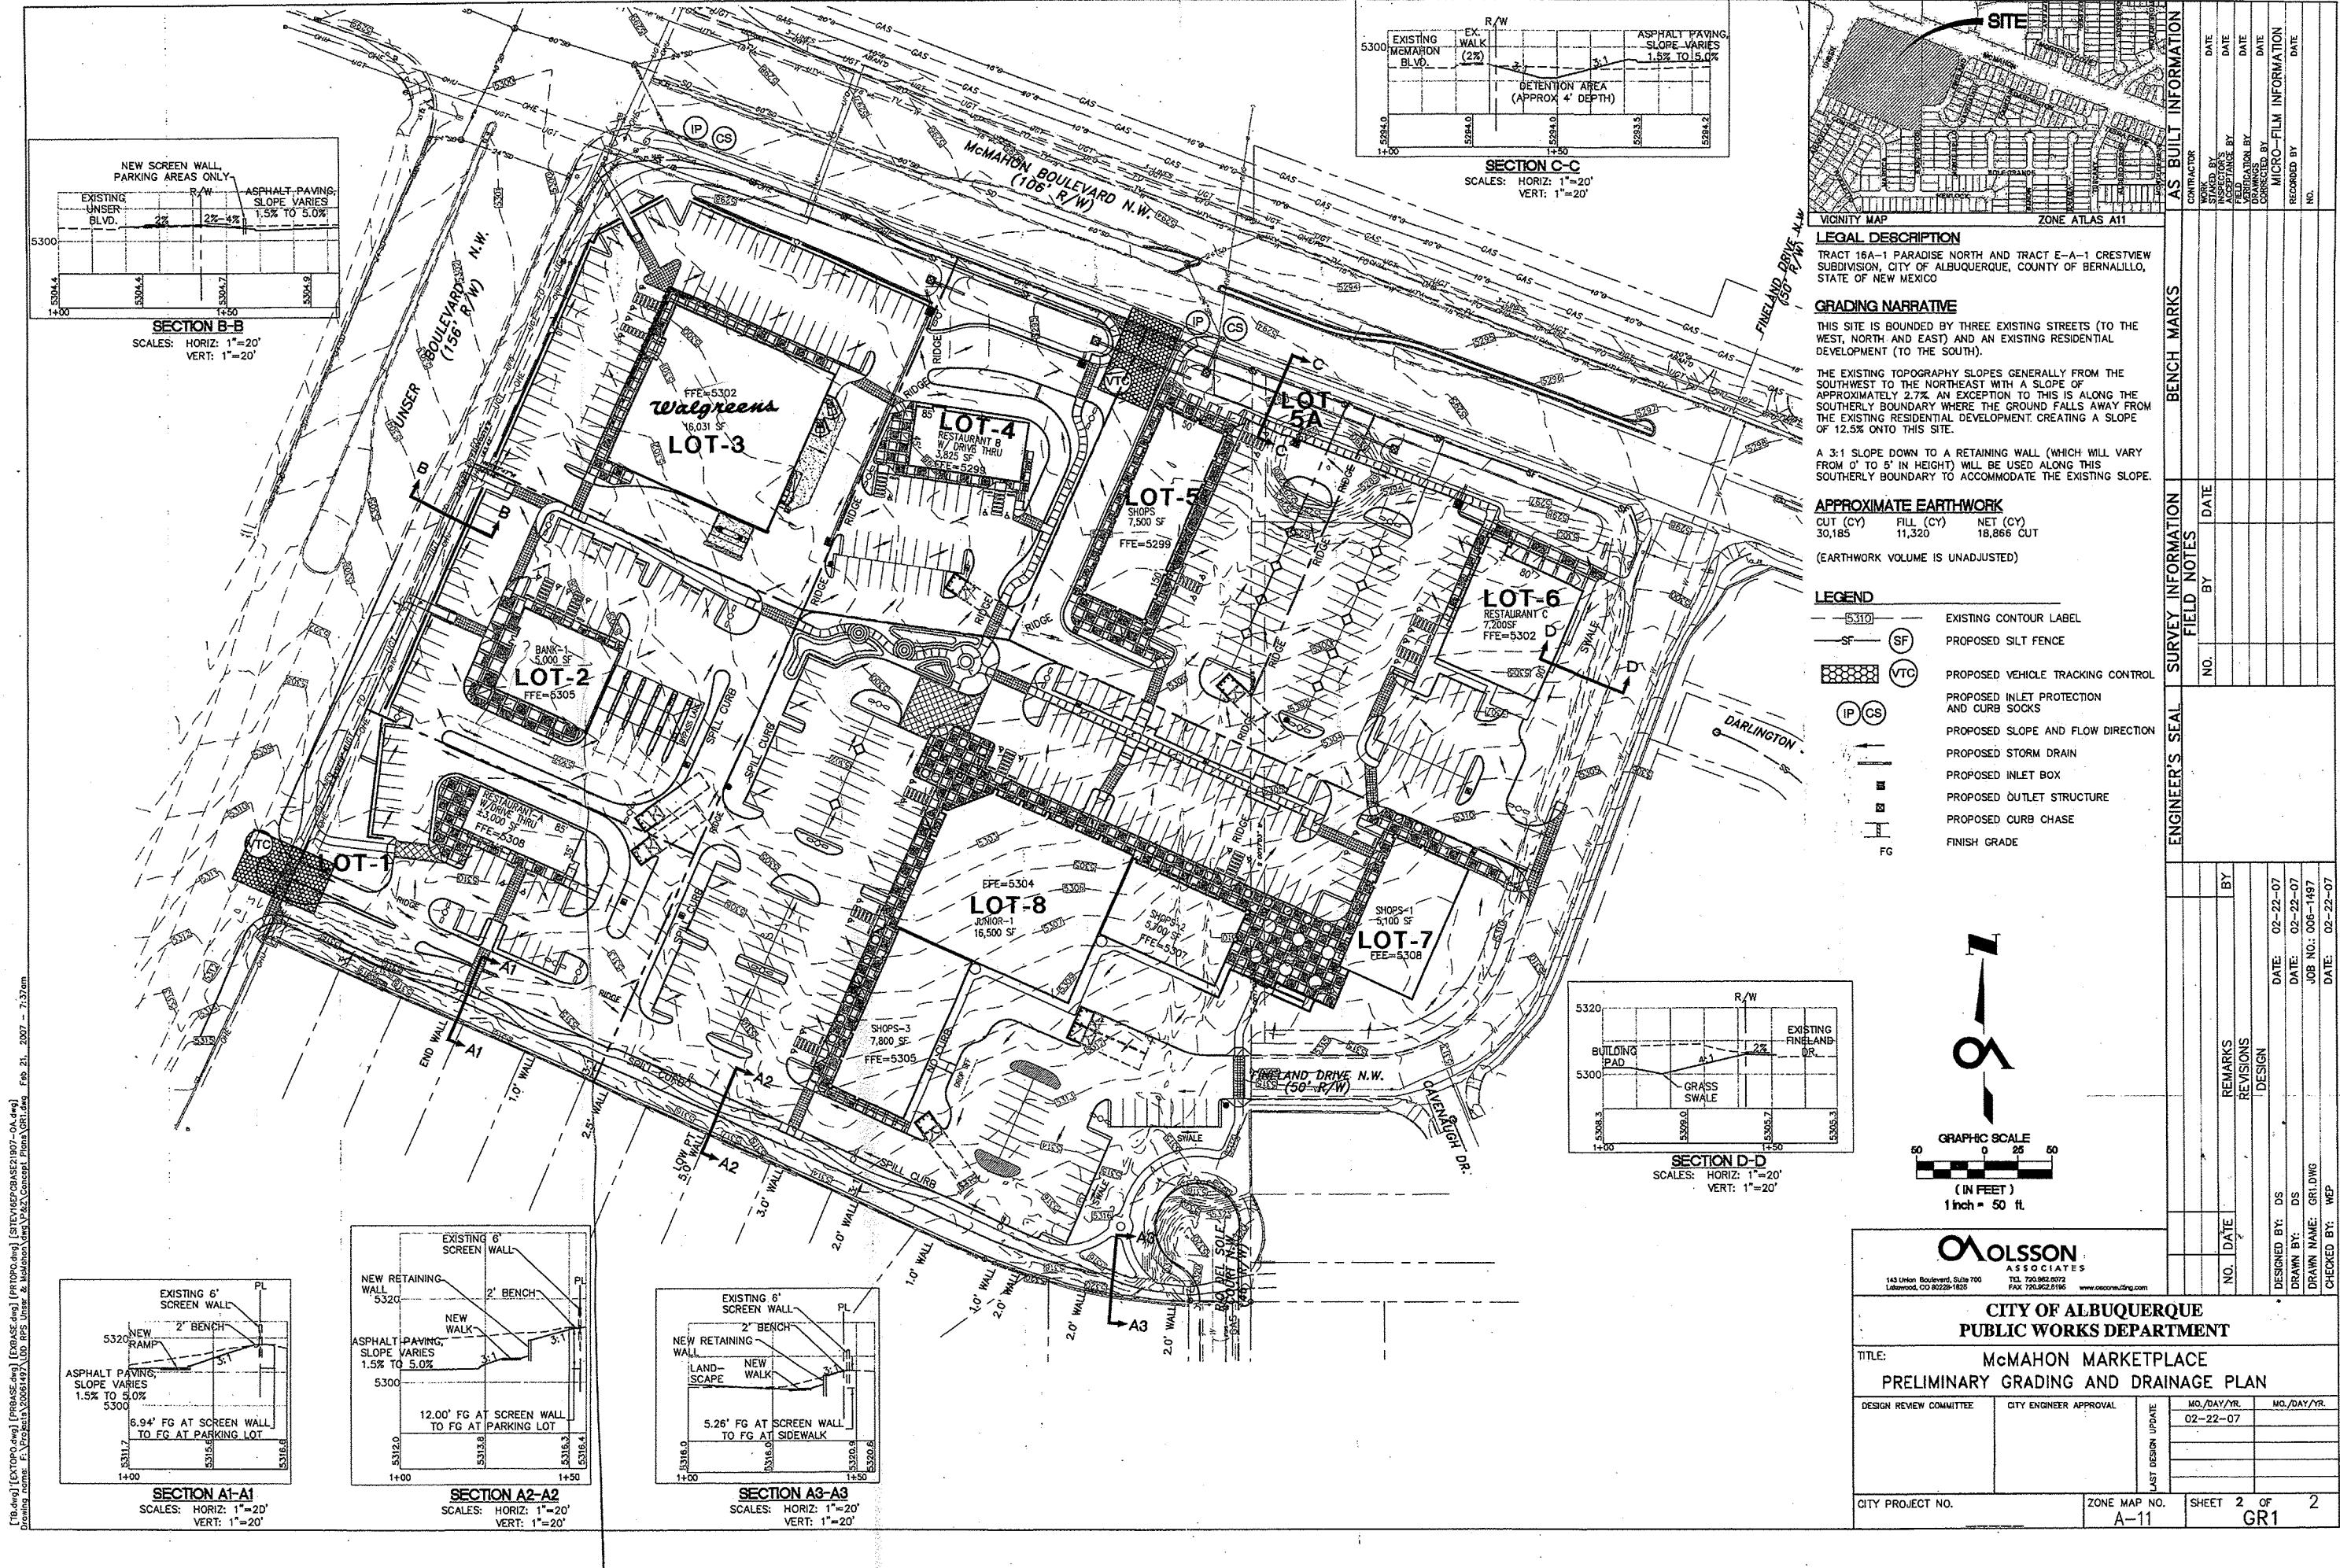

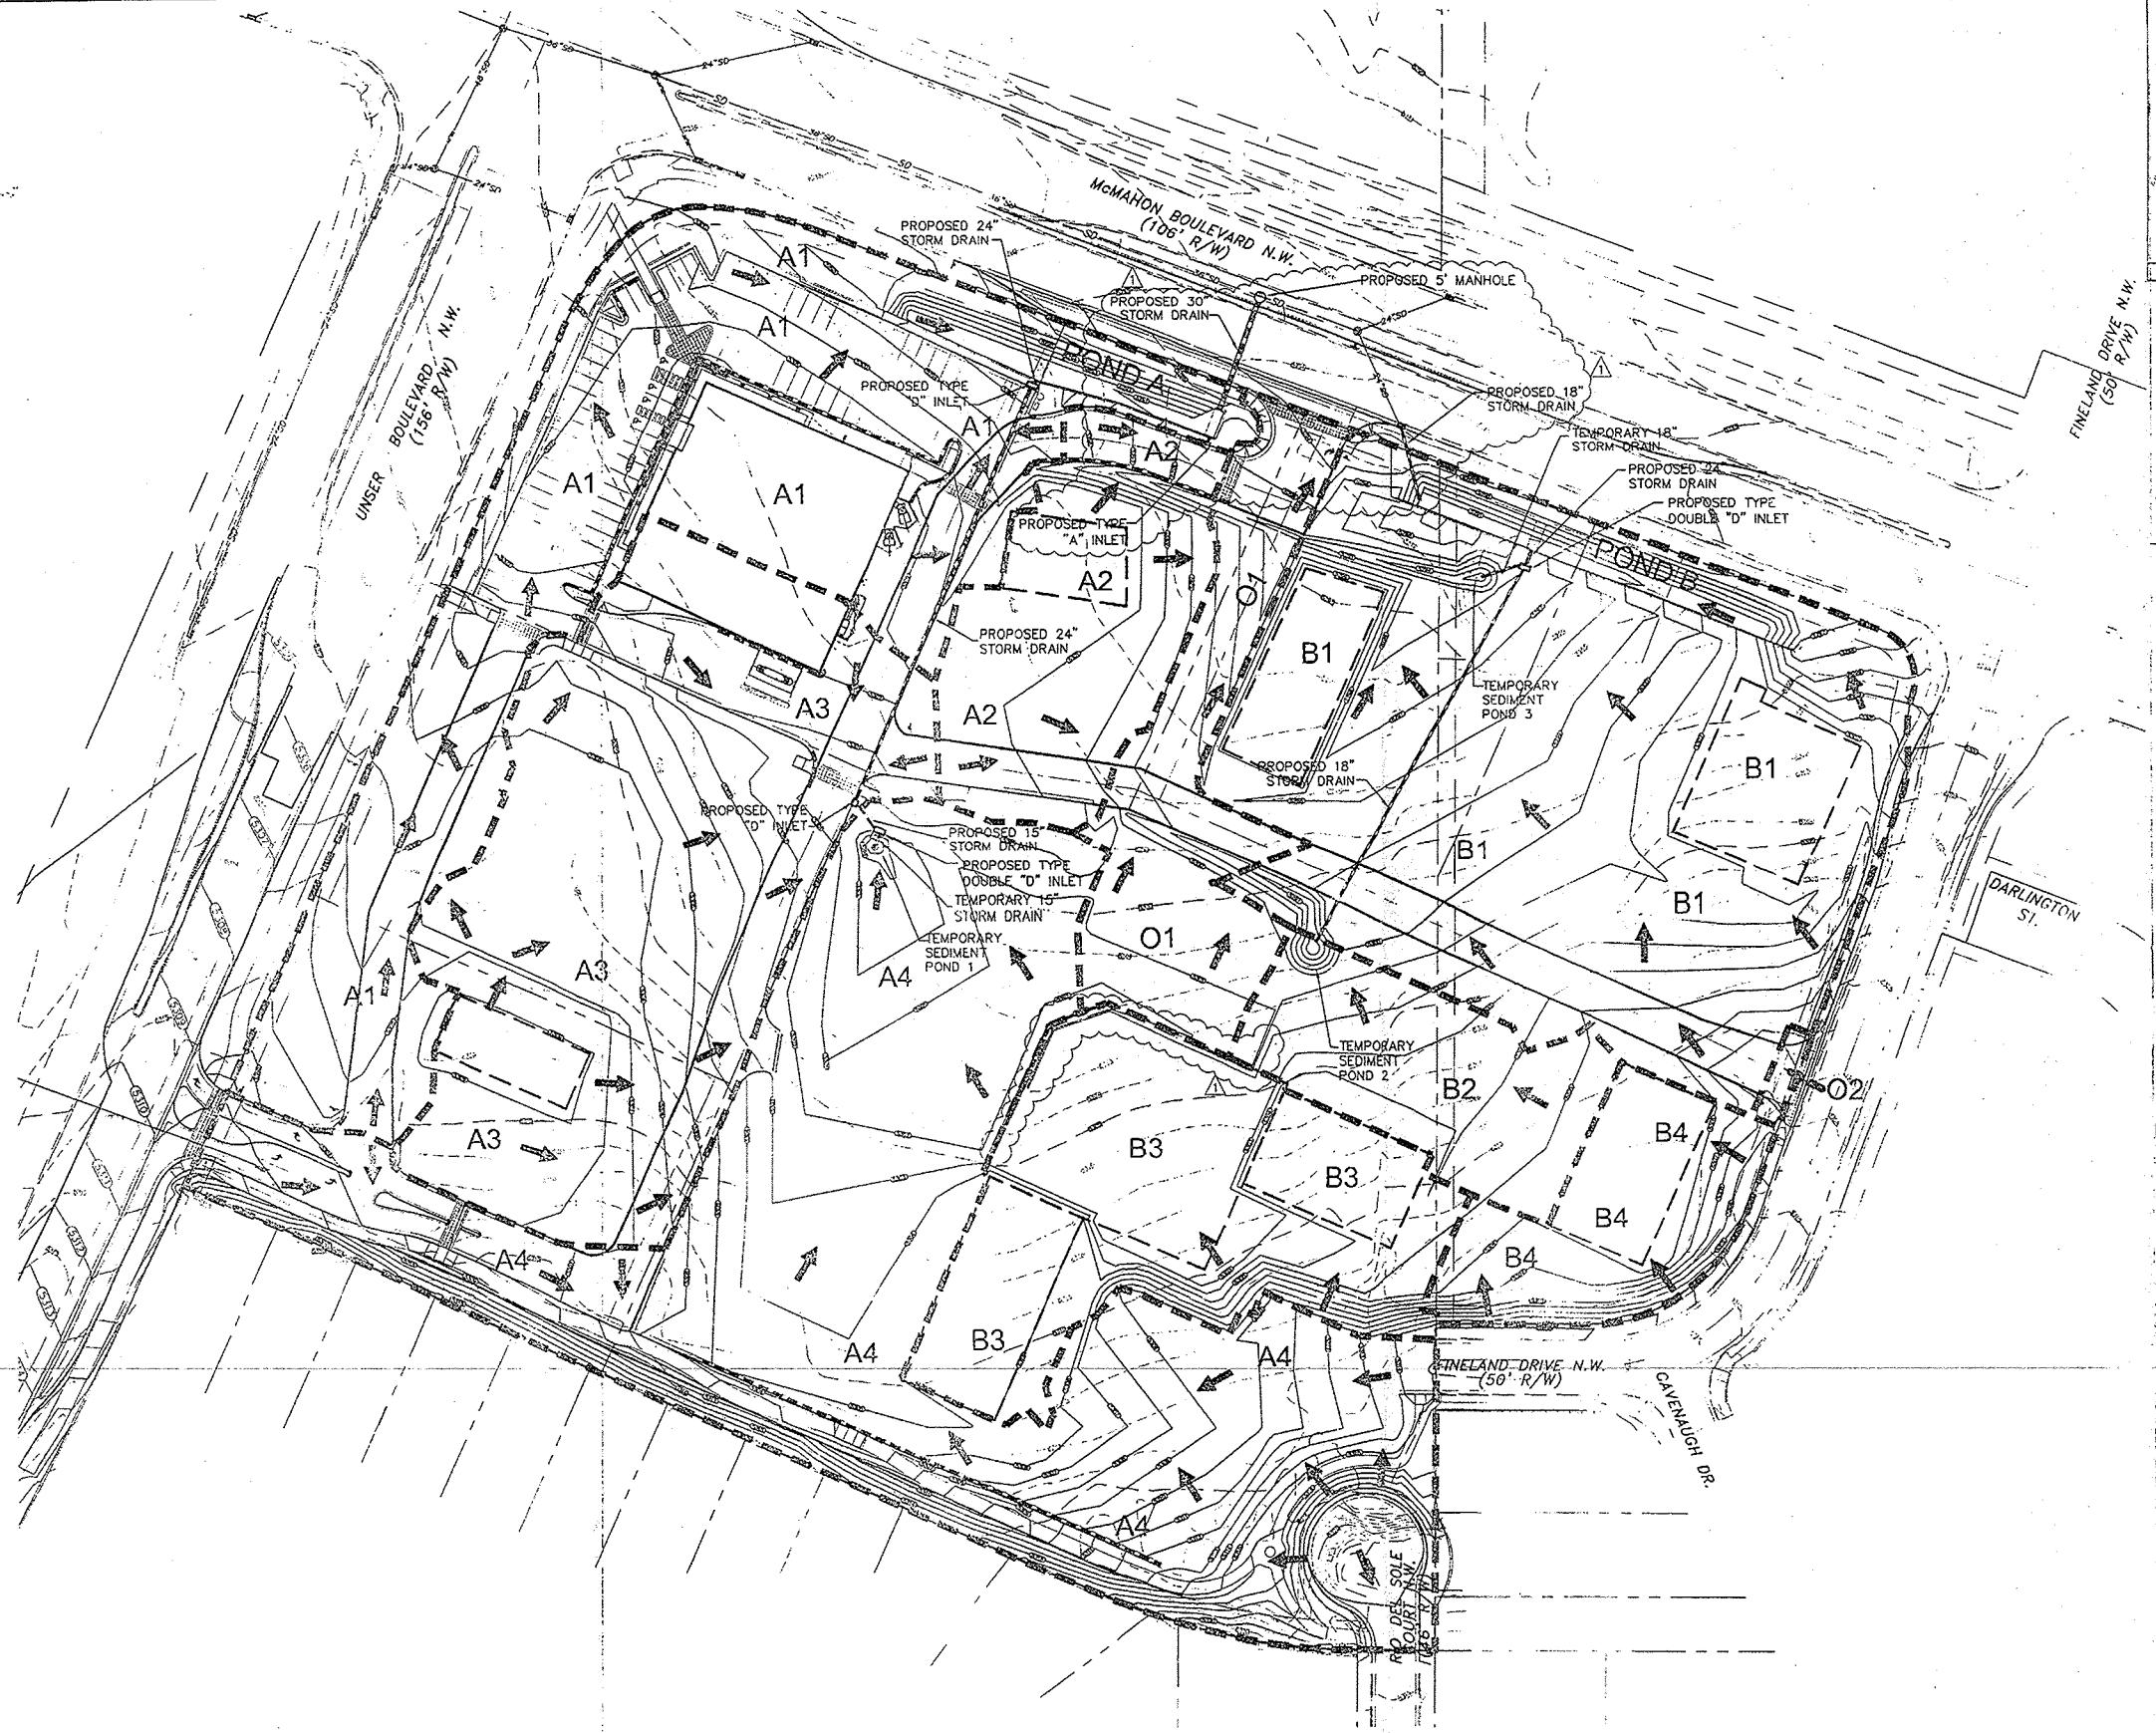

A vertical line on the left side of the page, ending at the bottom with a small circle. To its right is a circular seal with the following text:


WILLIAM E. ROBERTSON
REGISTERED PROFESSIONAL ENGINEER
CE 1101
17964



DATE:	04-20-01
DATE:	04-20-01
JOB NO.:	006-1497
DATE:	04-20-01




		CITY REVIEW COMMENTS	REMARKS	REVISIONS	DESIGN
25-07	DATE				
<p style="text-align: center;">GRAPHIC SCALE</p>  <p style="text-align: center;">(IN FEET)</p> <p style="text-align: center;">1 inch = 50 ft.</p>					
BY: OS DS NAME: PH1 / 2010.DWG BY: WEP					

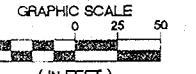

OLSSON
ASSOCIATES
751-422-8012

**CITY OF ALBUQUERQUE
PUBLIC WORKS DEPARTMENT**

TITLE:		MCMAHON MARKETPLACE GRADING AND DRAINAGE PLAN OVERALL DRAINAGE PLAN		
14	15	16	17	18
		LAND AREA APPRAISAL	19	MO./DAY/YR.
			20	MO./DAY/YR.
			21	MO./DAY/YR.
			22	MO./DAY/YR.
			23	MO./DAY/YR.
CITY PROJECT NO.		ZONE MAP NO.	SHEET 10 OF	12
		A-11	GD010	

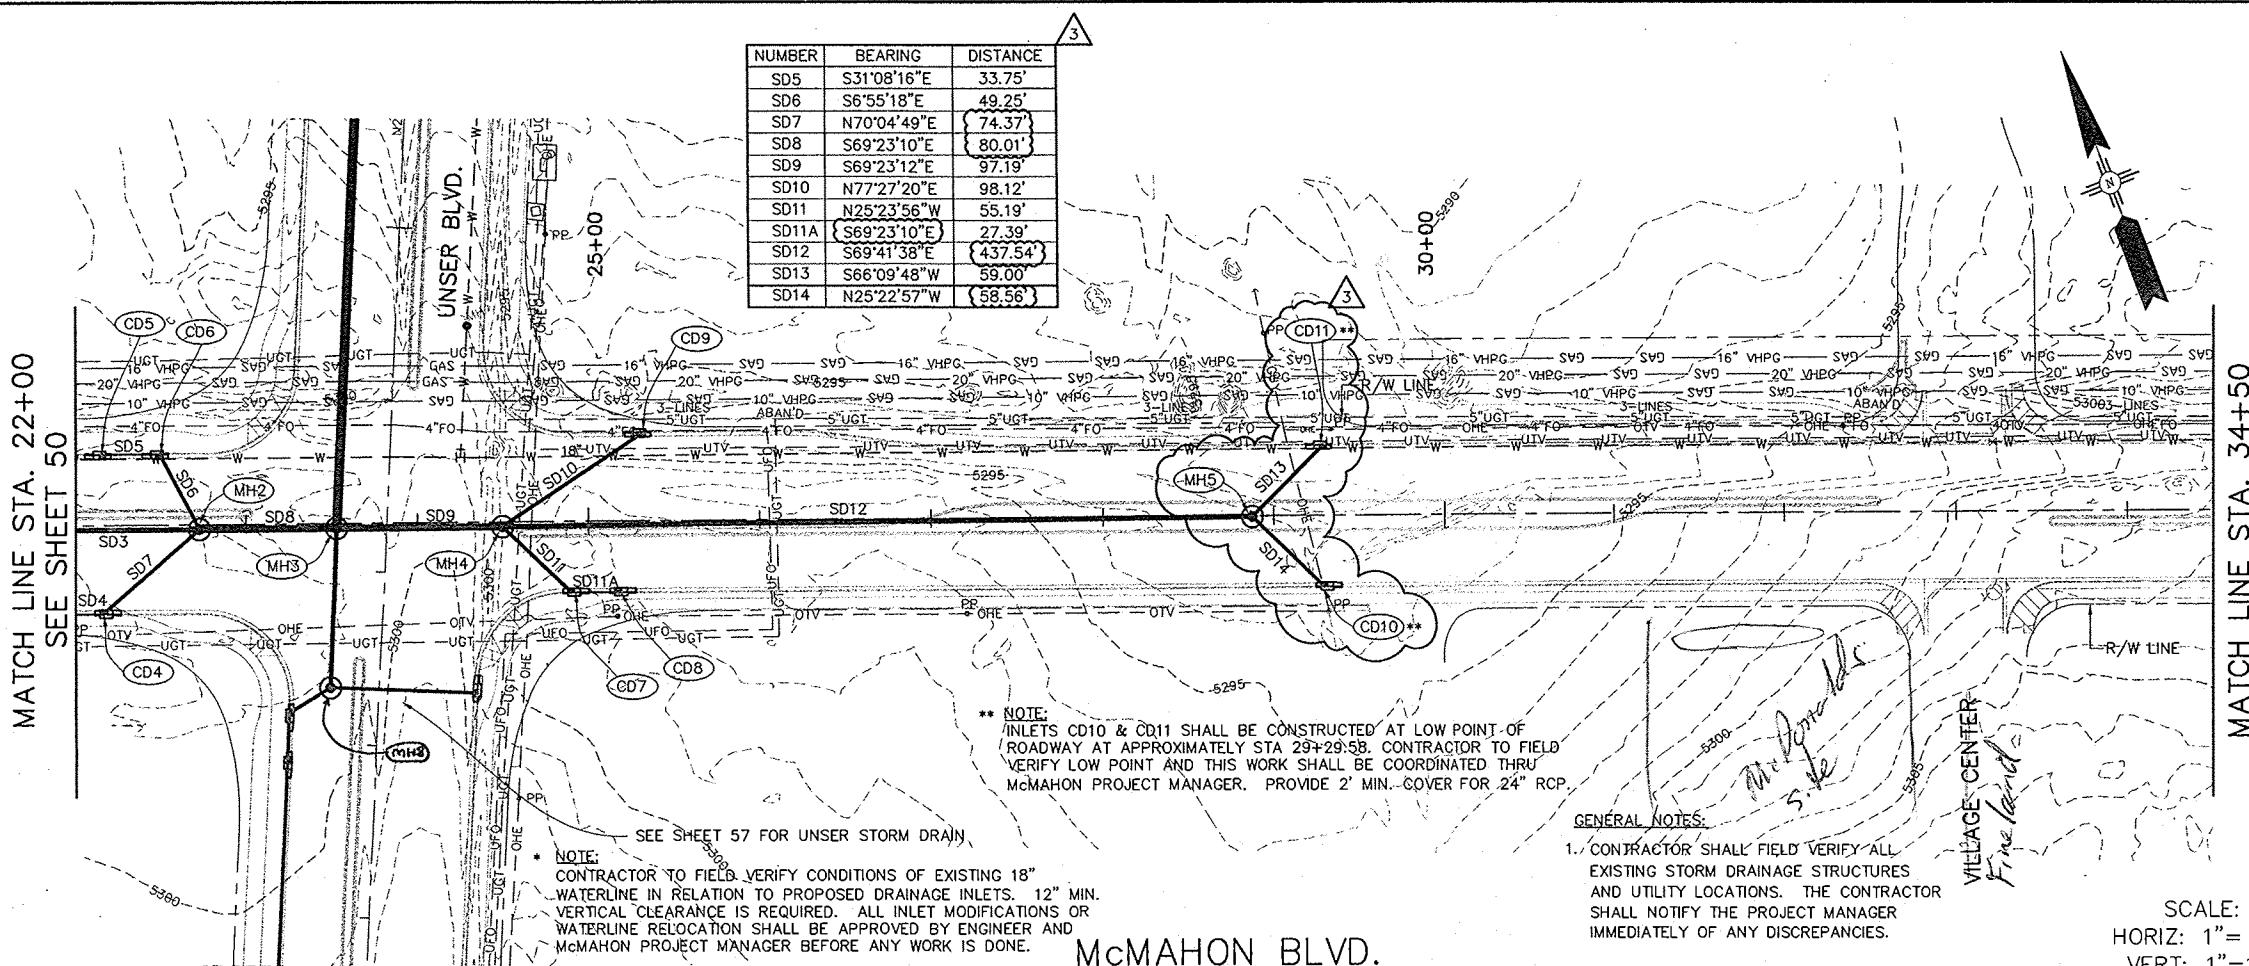MATCH LINE STA. 22+00
SEE SHEET 50

McMAHON BLVD.

* NOTE:
CONTRACTOR TO FIELD VERIFY CONDITIONS OF EXISTING 18"
WATERLINE IN RELATION TO PROPOSED DRAINAGE INLETS. 12" MIN.
VERTICAL CLEARANCE IS REQUIRED. ALL INLET MODIFICATIONS OR
WATERLINE RELOCATION SHALL BE APPROVED BY ENGINEER AND
McMAHON PROJECT MANAGER BEFORE ANY WORK IS DONE.

GENERAL NOTES:

1. CONTRACTOR SHALL FIELD VERIFY ALL EXISTING STORM DRAINAGE STRUCTURES AND UTILITY LOCATIONS. THE CONTRACTOR SHALL NOTIFY THE PROJECT MANAGER IMMEDIATELY OF ANY DISCREPANCIES.

SCALE:
HORIZ: 1" = 50'
VERT: 1" = 10'

