CITY OF ALBUQUERQUE



May 21, 2018

Martin Grummer Martin FM Grummer Architects 331 Wellesley Albuquerque, NM 87106

Re:

McMahon Marketplace Taproom, 5720 McMahon Market Place NW

Request for Certificate of Occupancy

Transportation Development Final Inspection

Engineer's/Architect's Stamp dated 8-25-17 (A11D011H)

Certification dated 04-27-18

Dear Mr. Grummer,

Based upon the information provided in your submittal received 4-27-18, Transportation Development has no objection to the issuance of a <u>Permanent Certificate of Occupancy</u>. This letter serves as a "green tag" from Transportation Development for a <u>Permanent Certificate of Occupancy</u> to be issued by the Building and Safety Division.

PO Box 1293

If you have any questions, please contact Ernie Gomez at (505) 924-3981.

Albuquerque

Sincerely,

NM 87103

Racquel M. Michel, P.E.

Traffic Engineer, Planning Dept. Development Review Services

www.cabq.gov

Ernie Gomez

Plan Checker, Planning Dept. Development Review Services

EG

via: email

C:


CO Clerk, File

KEYED NOTES

- 8' INTEGRALLY COLORED, RAISED, AND TEXTURED CONCRETE PEDESTRIAN CROSSWALK (RAISED TO TWO INCHES WHERE ALLOWED BY GRADES)
- PROPOSED LIGHT POLE LOCATION RE: 3/AI.5 FOR POLE DETAIL
- EXISTING 6' SIDEMALK
- PROPOSED PONDING AREA (RE: CONCEPTUAL GRADING PLAN)
- EXISTING 10' ASPHALT TRAIL TO REMAIN
- LOCATION OF NEW 10' ASPHALT TRAIL
- HANDICAP RAMP PER COA DWG @2441
- INDICATES EXISTING 6' HIGH CMU (HEIGHT TO BE FIELD VERIFIED) SCREEN WALL FROM ADJACENT GRADE OF R ZONE AREA COLOR OF WALL FACING COMMERCIAL DEVELOPMENT SHALL BE TAN IN COLOR
- INDICATES BIKE RACK LOCATION (9 BIKE CAPACITY)
- OUTDOOR DINING/SEATING AREA (RE: LOCATION FOR SIZE) W/ 8' LONG X 3' WIDE BENCH SHADED BY TRELLIS AND LANDSCAPING
- PROPOSED 3'-0" HIGH 8" INTEGRALLY COLORED SPLIT-FACED CMU BLOCK SCREEN WALL (TAN/RED COLOR) RE: 14/A3.0 FOR DETAIL)
- INDICATES SMALL CAR PARKING SPACE (9' X 15'-6" TYP.)
- PROPOSED 30' LANDSCAPE BUFFER W/ 8' PEDESTRIAN PATHWAY
- INDICATES PROPOSED FIRE HYDRANT LOCATION RE: UTILITY PLAN FOR INFO
- INDICATES PROPOSED 5' X 10' MOTORCYCLE PARKING STALL
- LOCATION RE: SITE PLAN FOR LOCATIONS
- INDICATES SIGN TYPE B.
- HATCHED AREA INDICATES PROPOSED LANDSCAPE AREA TO BE WATERED W/ SUPPLEMENTAL WATER HARVESTING SYSTEM
- INDICATES DUMPSTER LOCATION RE: DETAIL 2/AI.5 -INCLUDING SANITARY DRAIN FOR FOOD SERVICES NOTE: ENCLOSURE SHALL MATCH ADJACENT BUILDING COLOR
- INDICATES DUMPSTER LOCATION W/ RECYCLE INCLUDING SANITARY DRAIN FOR FOOD SERVICES
- INDICATES 18" HIGH BENCH LOCATION
- 2) SPEED BUMP

LANDSCAPE GRAVEL TO BE 2-3 INCH DEPTH OVER FABRIC. COLOR TO BE SANTA FE BROWN.



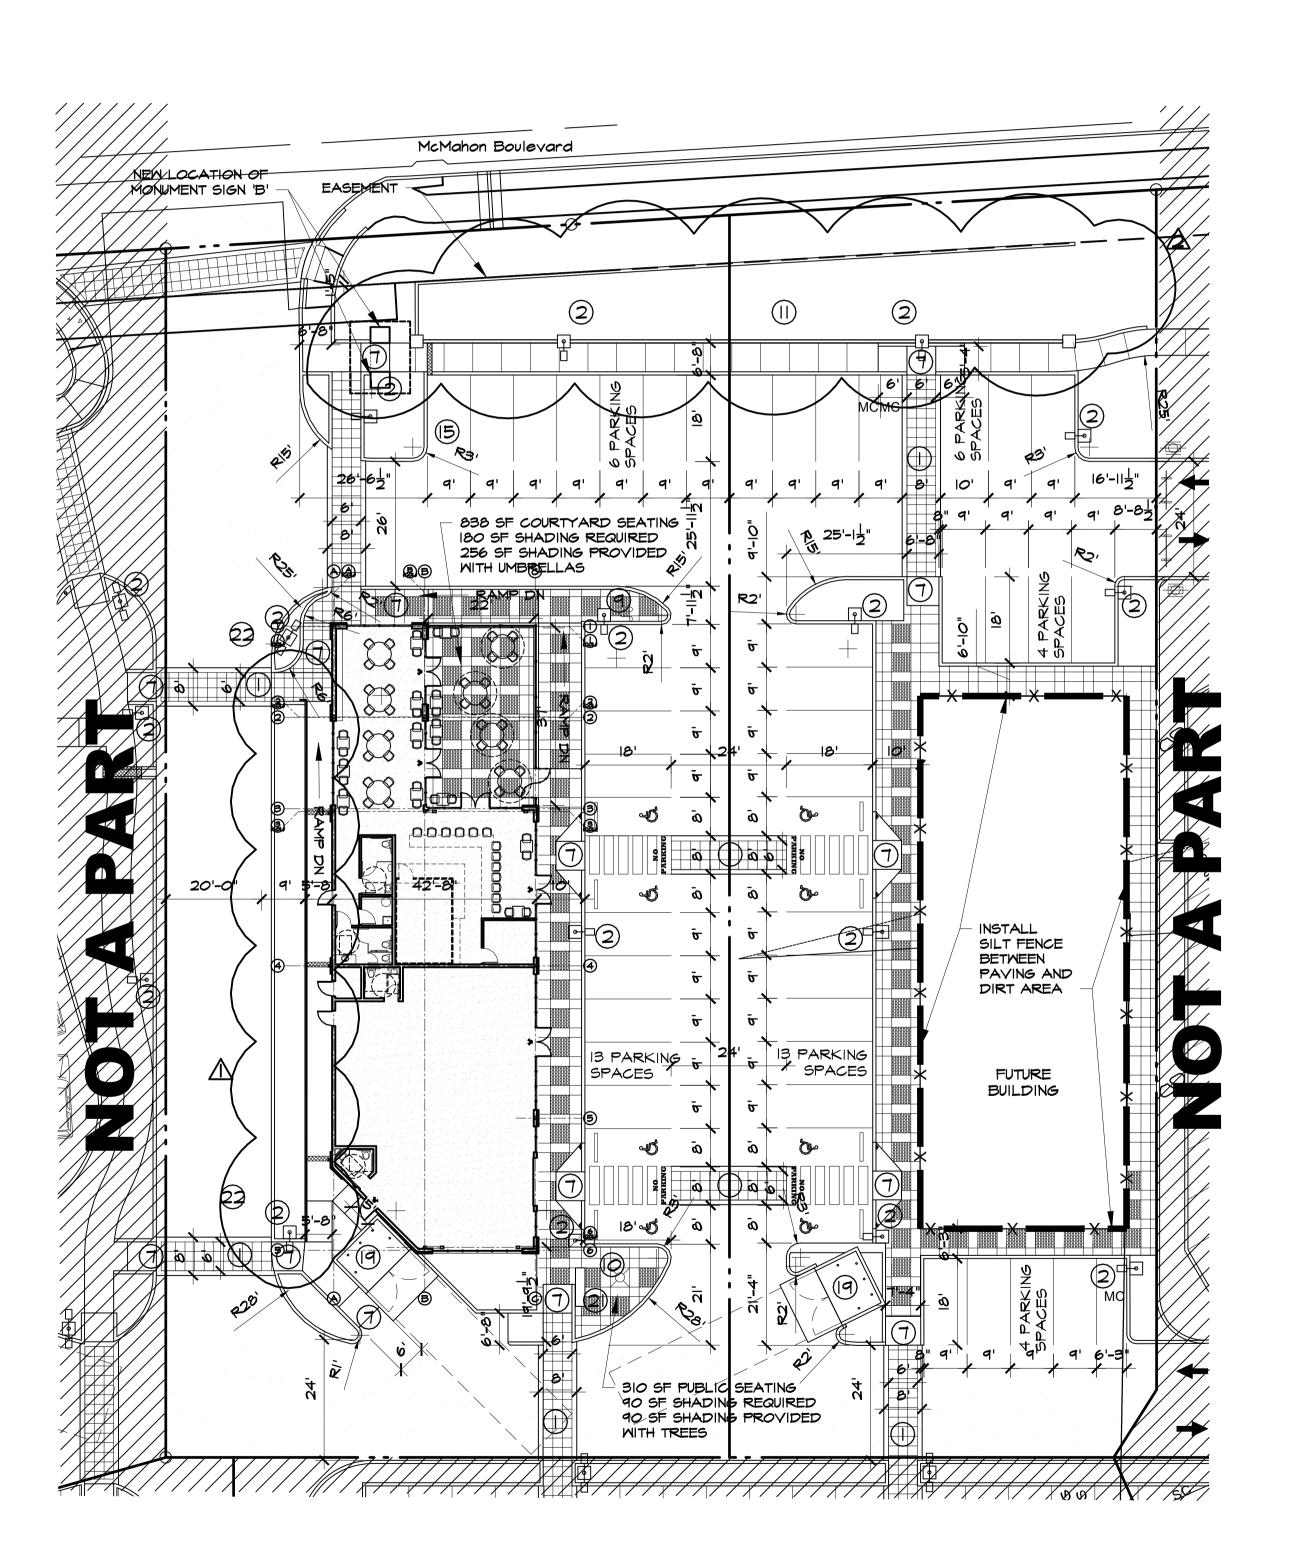






PETERSON PROPERTIES

LOT

25 AUG 2017 DRAWN BY: MFMG CHECKED BY:

VERIFIED BY:

REVISIONS 126 SEP 2017 <u>A</u> 4 OCT 2017

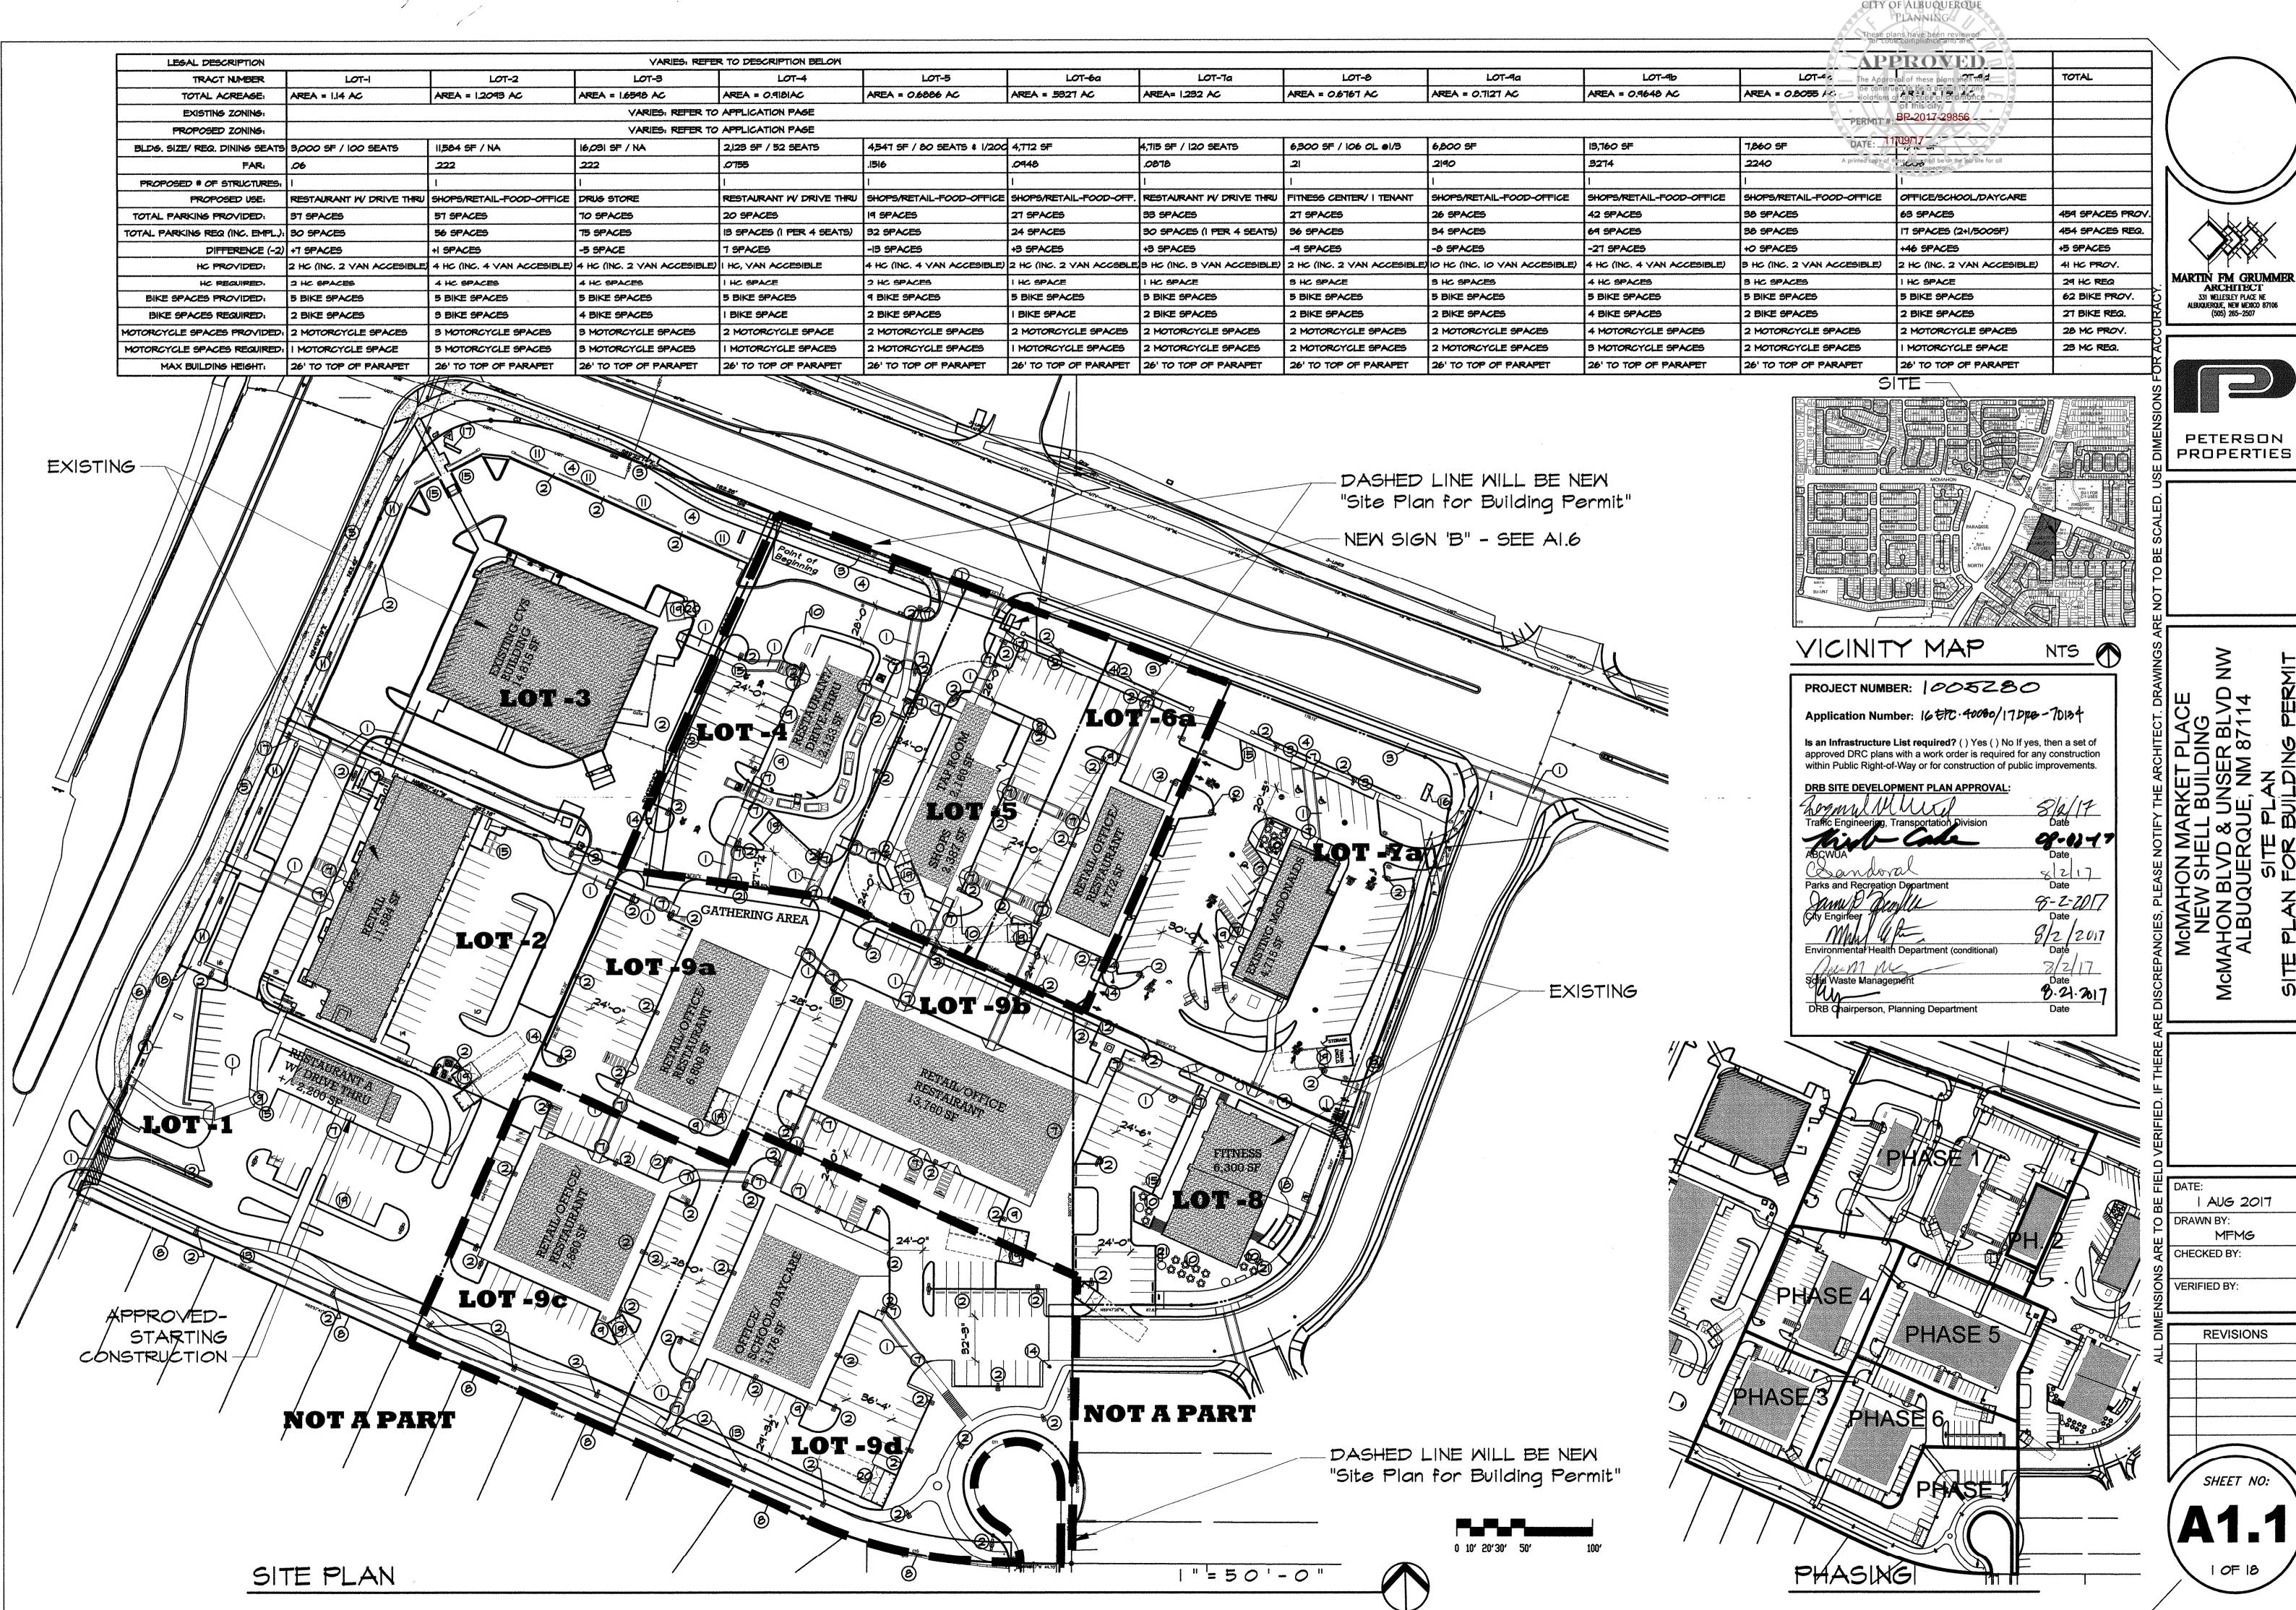





Project Title:

City of Albuquerque

Planning Department

Development & Building Services Division

DRAINAGE AND TRANSPORTATION INFORMATION SHEET


(REV 02/2013)

Building Permit #: City Drainage #: _

DRB#: EPC	#: Work 0	Order#:	
Legal Description:			
City Address:			
Engineering Firm:	Contac	t:	
Address:			
Phone#: Fax#	E-mail:		
Owner:	Contac	t:	
Address:			
Phone#: Fax#	: E-mail:		
Architect:	Contac	t:	
Address:			
Phone#: Fax#	: E-mail:	:	
Surveyor:	Contac	t:	
Address:			
Phone#: Fax#	E-mail:		
Contractor:	Contac	t:	
Address:			
Phone#: Fax#	: E-mail:		
TYPE OF SUBMITTAL:	CHECK TYPE OF APPROVAL/ACC	CEPTANCE SOUGHT:	
DRAINAGE REPORT	SIA/FINANCIAL GUARANTEE REI	SIA/FINANCIAL GUARANTEE RELEASE	
DRAINAGE PLAN 1st SUBMITTAL	PRELIMINARY PLAT APPROVAL	PRELIMINARY PLAT APPROVAL	
DRAINAGE PLAN RESUBMITTAL	S. DEV. PLAN FOR SUB'D APPROV	S. DEV. PLAN FOR SUB'D APPROVAL	
CONCEPTUAL G & D PLAN	S. DEV. FOR BLDG. PERMIT APPR	S. DEV. FOR BLDG. PERMIT APPROVAL	
GRADING PLAN	GRADING PLAN SECTOR PLAN APPROVAL		
EROSION & SEDIMENT CONTROL PLAN (E	ROSION & SEDIMENT CONTROL PLAN (ESC) FINAL PLAT APPROVAL		
ENGINEER'S CERT (HYDROLOGY)	CERTIFICATE OF OCCUPANCY (P	CERTIFICATE OF OCCUPANCY (PERM)	
CLOMR/LOMR	CERTIFICATE OF OCCUPANCY (T	CERTIFICATE OF OCCUPANCY (TCL TEMP)	
TRAFFIC CIRCULATION LAYOUT (TCL)	FOUNDATION PERMIT APPROVA	FOUNDATION PERMIT APPROVAL	
ENGINEER'S CERT (TCL)	BUILDING PERMIT APPROVAL	BUILDING PERMIT APPROVAL	
ENGINEER'S CERT (DRB SITE PLAN)	GRADING PERMIT APPROVAL	SO-19 APPROVAL	
ENGINEER'S CERT (ESC)	PAVING PERMIT APPROVAL	ESC PERMIT APPROVAL	
SO-19	WORK ORDER APPROVAL	ESC CERT. ACCEPTANCE	
OTHER (SPECIFY)	GRADING CERTIFICATION	OTHER (SPECIFY)	
WAS A PRE-DESIGN CONFERENCE ATTENDED:	Yes No Copy Provi	ided	
DATE SUBMITTED:	By:		

Requests for approvals of Site Development Plans and/or Subdivision Plats shall be accompanied by a drainage submittal. The particular nature, location, and scope to the proposed development defines the degree of drainage detail. One or more of the following levels of submittal may be required based on the followin

- 1. Conceptual Grading and Drainage Plan: Required for approval of Site Development Plans greater than five (5) acres and Sector Plans
- Drainage Plans: Required for building permits, grading permits, paving permits and site plans less than five (5) acres Drainage Report: Required for subdivision containing more than ten (10) lots or constituting five (5) acres or more
- Erosion and Sediment Control Plan: Required for any new development and redevelopment site with 1-acre or more of land disturbing area, including project less than 1-acre than are part of a larger common plan of development

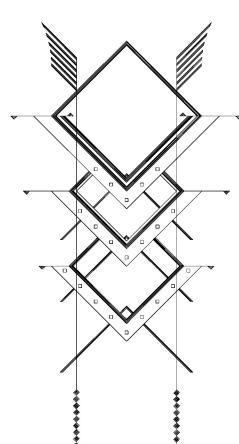

TRAFFIC CERTIFICATION

I, MARTIN GRUMMER, NMRA 2044, OF THE FIRM MARTIN GRUMMER - ARCHITECT, HEREBY CERTIFY THAT THIS PROJECT (TAPROOM SHELL) IS IN SUBSTANTIAL COMPLIANCE WITH AND IN ACCORDANCE WITH THE DESIGN INTENT OF THE APPROVED PLAN DATED 1 AUG 2017. THE RECORD INFORMATION EDITED ONTO THE ORIGINAL DESIGN DOCUMENT HAS BEEN OBTAINED BY MARTIN GRUMMER OF THE FIRM MARTIN GRUMMER - ARCHITECT. I FURTHER CERTIFY THAT I HAVE PERSONALLY VISITED THE PROJECT SITE ON 27 APRIL 2018 AND HAVE DETERMINED BY VISUAL INSPECTION THAT THE SURVEY DATA PROVIDED IS REPRESENTATIVE OF ACTUAL SITE CONDITIONS AND IS TRUE AND CORRECT TO THE BEST OF MY KNOWLEDGE AND BELIEF. THIS CERTIFICATION IS SUBMITTED IN SUPPORT OF A REQUEST FOR CERTIFICATE OF OCCUPANCY.

THE RECORD INFORMATION PRESENTED HEREON IS NOT NECESSARILY COMPLETE AND INTENDED ONLY TO VERIFY SUBSTANTIAL COMPLIANCE OF THE TRAFFIC ASPECTS OF THIS PROJECT. THOSE RELYING ON THE RECORD DOCUMENT ARE ADVISED TO OBTAIN INDEPENDENT VERIFICATION OF ITS ACCURACY BEFORE USING IT FOR ANY OTHER PURPOSE.

Martin FM Grummer

Date: 27 April 2018