

FIRE LANE STRIPING SHALL BE 6" RED STRIPES WITH 4" INCH WHITE LETTERS READING "NO PARKING FIRE LANE" STRIPING SHALL BE PLACED ON THE TOP EDGE OF THE SIDEWALK ABUTTING THE PAVED DRIVE OR AS SPECIFIED BY LOCAL REQUIREMENTS.

NO PARKING FIRE LANE NO PARKING FIRE

FIRE LANE MARKING

KEYED NOTES

- (1) EXISTING FIRE HYDRANT
- 2 KNOX BOX
- 3 PREMISE ID LOCATION
- 4 FIRE LANE

LEGEND

UTILITY EASEMENT

BOUNDARY LINE

SIDEWALK

EXISTING OVERHEAD UTILITIES

EXISTING SANITARY SEWER LINE

EXISTING WATER LINE

EXISTING STORM SEWER LINE


SAS MANHOLE

EXISTING FIRE HYDRANT

FIRE ACCESS ROAD

FIRE ACCESS ROAD

FIRE LANE MARKING
(SEE DETAIL THIS SHEET)

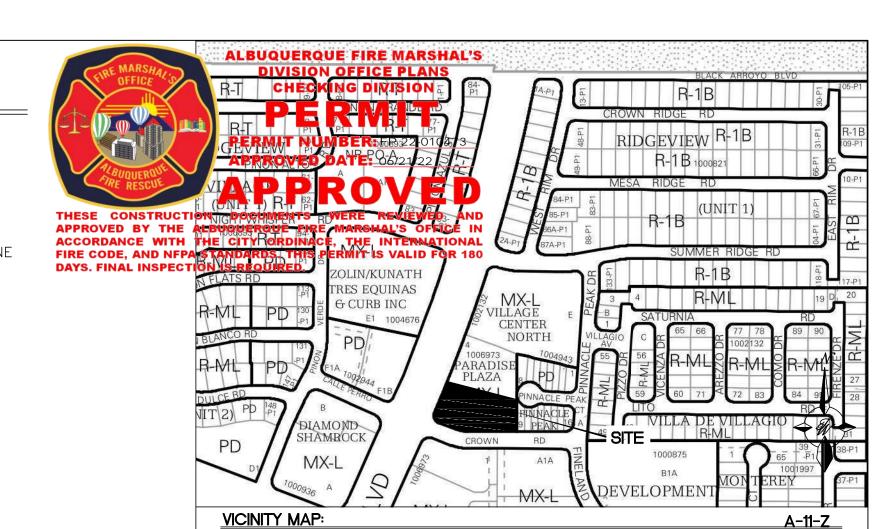

LEGAL DESCRIPTION

TR 4 PLAT OF TRS 1, 2, 3 & 4 PARADISE PLAZA CONT 1.8131 AC

SITE DATA


NOTHEAST CORNER UNSER BLVD AND CROWN RD, ALBUQUERQUE NM, 87114 BUILDING FOOTPRINT = 1,407 SF OCCUPANCY TYPE = B CONSTRUCTION TYPE = V-B NOT SPRINKLED FIRE-FLOW = 1,500 GPM

<u>NOTES</u>

- 1. ON SITE FIRE LANE ROAD SHALL BE MARKED ON BOTH SIDES, AS DIRECTED BY FIRE MARSHALL.
- 2. FIRE APPARATUS ACCESS ROADS SHALL NOT EXCEED 10 PERCENT IN GRADE AND SHALL HAVE AN ALL WEATHER DRIVING SURFACE CAPABLE OF SUPPORTING THE IMPOSED LOAD OF FIRE APPARATUS WEIGHING AT LEAST 75000 LBS.
- 3. KNOX KEY SWITCH SHALL BE MOUNTED BETWEEN 4 AND 6 FEET ABOVE GRADE AND SHALL BE ILLUMINATED. ONE IS TO BE PROVIDED FOR ALL ELECTRIC GATES AND ALL BUILDINGS.
- 4. KNOX KEY SWITCH REQUIRED FOR ALL ELECTRIC GATES AND ALL BUILDINGS.
- 5. NO BUILDING SHOWN HEROIN SHALL EXCEED 30 FEET IN HEIGHT


CAUTION:

ALL EXISTING UTILITIES SHOWN WERE OBTAINED FROM RESEARCH, AS-BUILTS, SURVEYS OR INFORMATION PROVIDED BY OTHERS. IT SHALL BE THE SOLE RESPONSIBILITY OF THE CONTRACTOR TO CONDUCT ALL NECESSARY FIELD INVESTIGATIONS PRIOR TO AND INCLUDING ANY EXCAVATION, TO DETERMINE THE ACTUAL LOCATION OF UTILITIES AND OTHER IMPROVEMENTS, PRIOR TO STARTING THE WORK. ANY CHANGES FROM THIS PLAN SHALL BE COORDINATED WITH AND APPROVED BY THE ENGINEER.

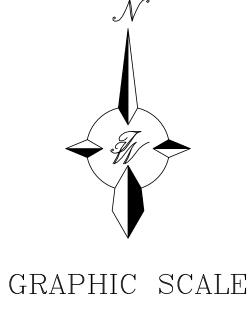

SCALE: 1"=20'

| ENGINEER'S SEAL | TAKE 5 OIL CHANGE ALBUQUERQUE, N.M. | DRAWN BY RMG <i>DATE</i> |
|----------------------------------|---|--------------------------------|
| | FIRE 1 | 06/08/2022 |
| | PLAN | FIREONEPLAN 2 |
| | | SHEET # |
| | TIERRA WEST, LLC 5571 MIDWAY PARK PLACE NE ALBUQUERQUE, NM 87109 | F-1 |
| RONALD R. BOHANNAN P.E. #7868 | (505) 858—3100 www.tierrawestllc.com | ЈОВ # 2022007 |

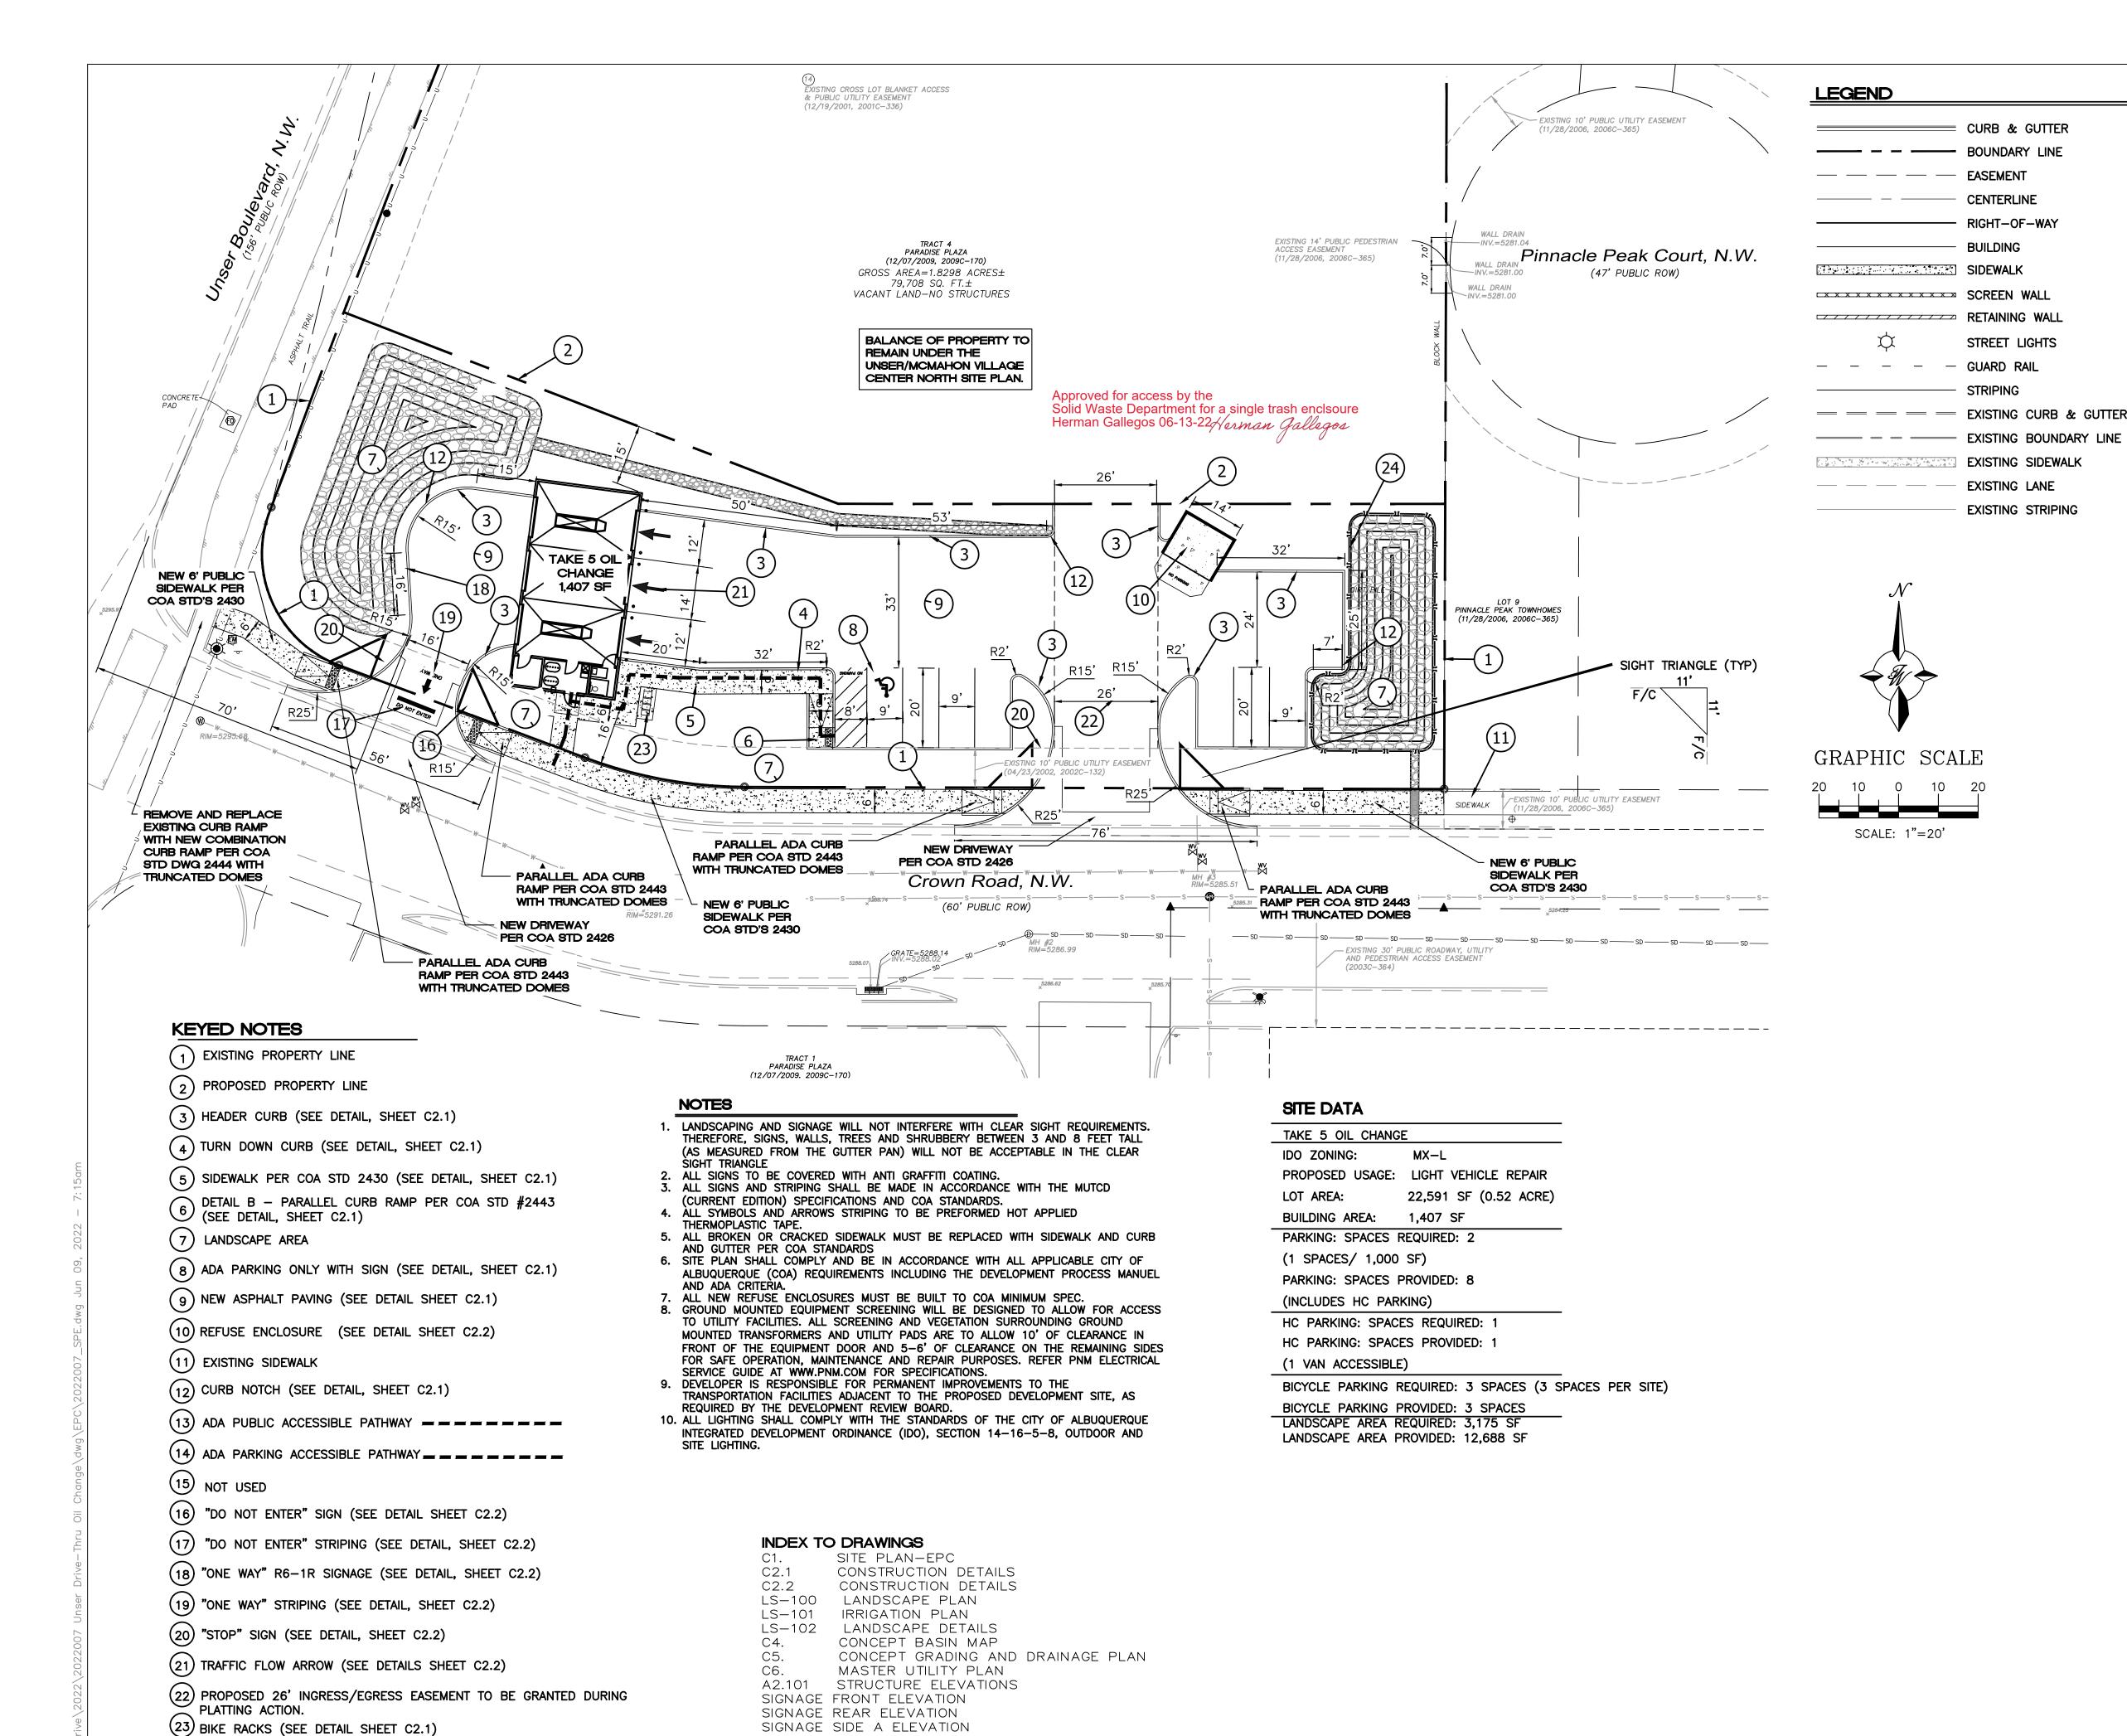


SIGNAGE SIDE A ELEVATION SIGNAGE SIDE B ELEVATION

SHEET 1 GOVERNING SITE PLAN SHEET 2 GOVERNING SITE PLAN

SHEET 3 GOVERNING SITE PLAN

(24) 42" (MINIMUM) WROUGHT IRON FENCE WITH MAINTENANCE GATE

TO BE INSTALLED AROUND PERIMETER OF POND.

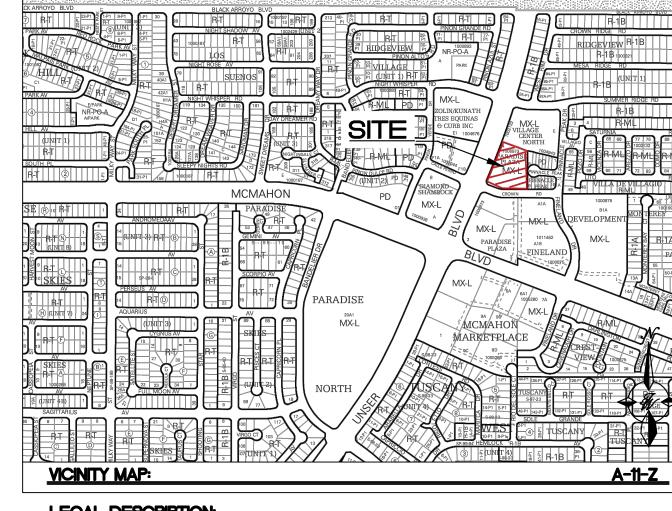

LEGAL DESCRIPTION:

PROJECT NUMBER:

APPLICATION NUMBER:

BOUNDARY LINE

RIGHT-OF-WAY

STREET LIGHTS

EXISTING SIDEWALK

EXISTING STRIPING

EXISTING LANE

GUARD RAIL

EASEMENT

BUILDING

CENTERLINE

TR 4 PLAT OF TRS 1, 2, 3 + 4 PARADISE PLAZA CONT 1,8131 AC

This plan is consistent with the specific Site Development Plan approved by the Environmental Planning Commission (EPC), dated _____, and the Findings and Conditions in the Official Notification of Decision are satisfied. Is an Infrastructure List required? () Yes () No If Yes, then a set of approved DRC plans with a work order is required for any construction within Public Right—of—Way or for construction of public improvements. DRB SITE DEVELOPMENT PLAN APPROVAL: Date Traffic Engineer, Transportation Division ABCWUA Date Date Parks & Recreation Department City Engineer/Hydrology Date Date Code Enforcement

Date

Date

Date

06-13-22

* Environmental Health, if necessary

DRB Chairperson, Planning Department

Herman Gallegos Herman Gallegos

Solid Waste Management

*Environmental Health Department (conditional)

| ENGINEER'S SEAL | TAKE 5 OIL CHANGE | DRAWN BY RMG |
|----------------------------------|---|---------------------------|
| | ALBUQUERQUE, N.M. SITE PLAN - EPC | <i>DATE</i> 06/08/2022 |
| | SITE FEAR - EFC | 2022007_SPE |
| | | SHEET # |
| | TIERRA WEST, LLC 5571 MIDWAY PARK PLACE NE ALBUQUERQUE, NM 87109 | C1 |
| RONALD R. BOHANNAN P.E. #7868 | (505) 858-3100 www.tierrawestllc.com | ЈОВ # 2022007 |