



September 29, 1998

James Topmiller
Bohannon-Huston Inc.
7500 Jefferson NE
Albuquerque, New Mexico 87109

RE: ENGINEER CERTIFICATION FOR HIGH VISTA APARTMENTS (A12-D13)
CERTIFICATION STATEMENT DATED 9/17/98

Dear Mr. Topmiller:

Based on the information provided on your September 18, 1998, Engineer Certification for the above referenced site is acceptable.

If I can be of further assistance, please feel free to contact me at 924-3986.



C: Andrew Garcia
File

Sincerely


Bernie J. Montoya CE
Associate Engineer

Good for You, Albuquerque!



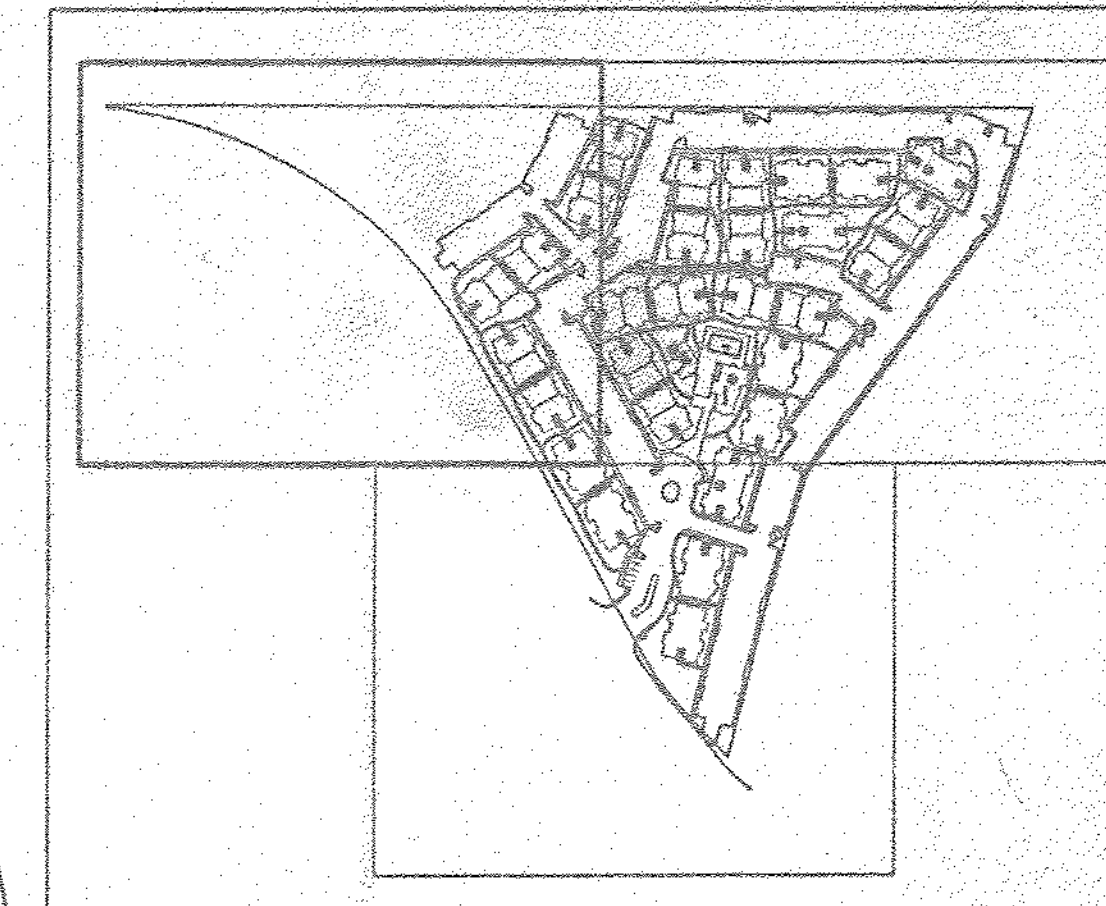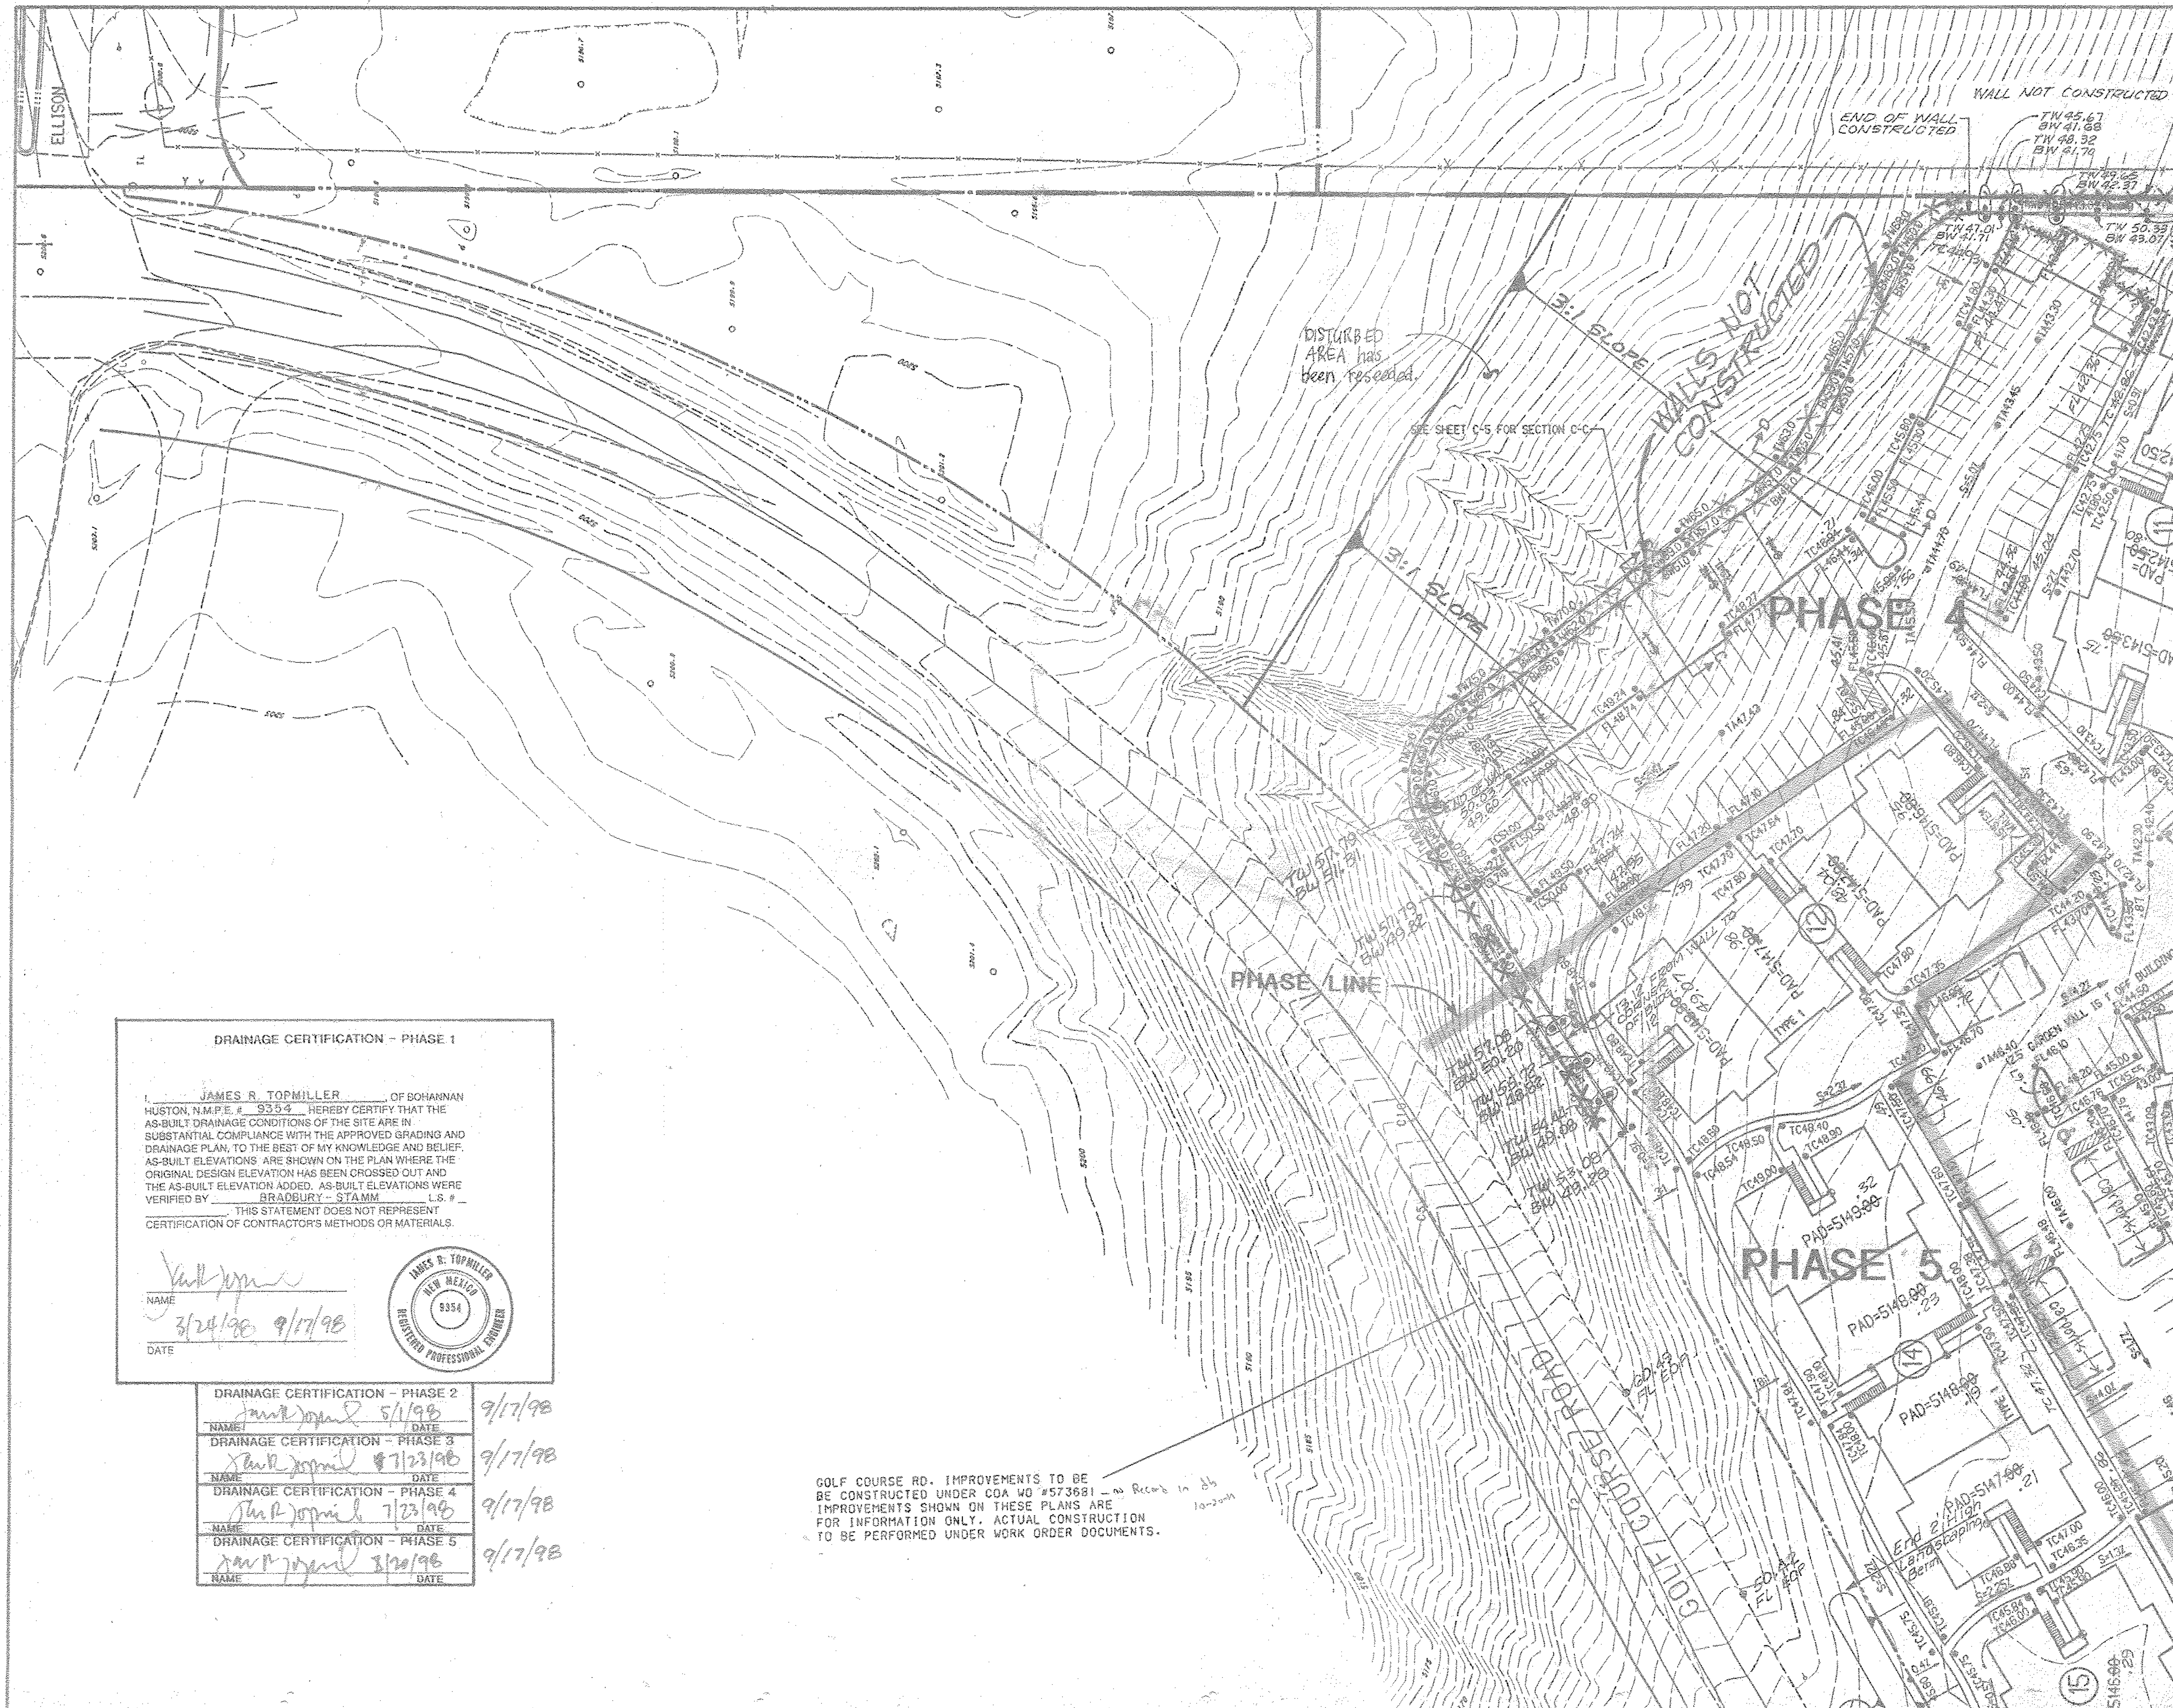

KEYMAP
NO SCALE

NOT CONSTRUCTED



SCALE: 1" = 30'

LEGEND


- PROJECT BOUNDARY
- EXISTING CONTOUR
- EXISTING SPOT ELEVATION
- PROPOSED SPOT ELEVATION
- DIRECTION OF FLOW
- PROPOSED PIPE PENETRATION
- PROPOSED RETAINING WALL
- PROPOSED GARDEN WALL
- ROOF DRAIN LOCATION

TC=TOP OF CURB, FL=FLOW LINE
TA=TOP OF ASPHALT

DRAINAGE CERTIFICATION - PHASE 1

I, JAMES R. TOPMILLER, OF BOHANNAN
HUSTON, N.M.P.E. # 9354, HEREBY CERTIFY THAT THE
AS-BUILT DRAINAGE CONDITIONS OF THE SITE ARE IN
SUBSTANTIAL COMPLIANCE WITH THE APPROVED GRADING AND
DRAINAGE PLAN, TO THE BEST OF MY KNOWLEDGE AND BELIEF.
AS-BUILT ELEVATIONS ARE SHOWN ON THE PLAN WHERE THE
ORIGINAL DESIGN ELEVATION HAS BEEN CROSSED OUT AND
THE AS-BUILT ELEVATION ADDED. AS-BUILT ELEVATIONS WERE
VERIFIED BY BRADBURY - STAMM L.S. #
THIS STATEMENT DOES NOT REPRESENT
CERTIFICATION OF CONTRACTOR'S METHODS OR MATERIALS.

NAME James R. Topmiller
DATE 3/24/98 9/17/98

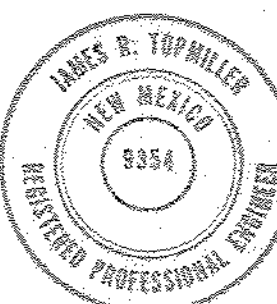

DRAINAGE CERTIFICATION - PHASE 2

NAME James R. Topmiller DATE 5/1/98

DRAINAGE CERTIFICATION - PHASE 3

NAME James R. Topmiller DATE 7/23/98


DRAINAGE CERTIFICATION - PHASE 4

NAME James R. Topmiller DATE 7/23/98

DRAINAGE CERTIFICATION - PHASE 5

NAME James R. Topmiller DATE 8/20/98

GOLF COURSE RD. IMPROVEMENTS TO BE
BE CONSTRUCTED UNDER COA NO #573681 - no Record in db
IMPROVEMENTS SHOWN ON THESE PLANS ARE
FOR INFORMATION ONLY. ACTUAL CONSTRUCTION
TO BE PERFORMED UNDER WORK ORDER DOCUMENTS.

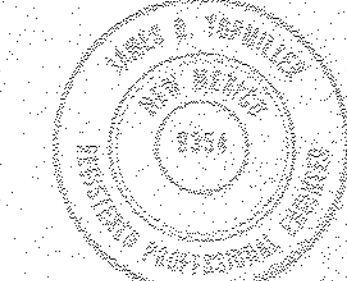

SEP 18 1998
HYDROLOGY SECTION

SHEET C3: GRADING PLAN

BOHANNAN-HUSTON, INC.
ENGINEERS • PLANNERS • PHOTOGRAPHERS • SURVEYORS • LANDSCAPE ARCHITECTS
ALBUQUERQUE LAS CRUCES SANTA FE