
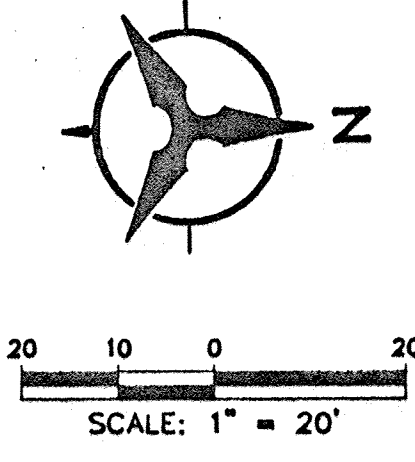


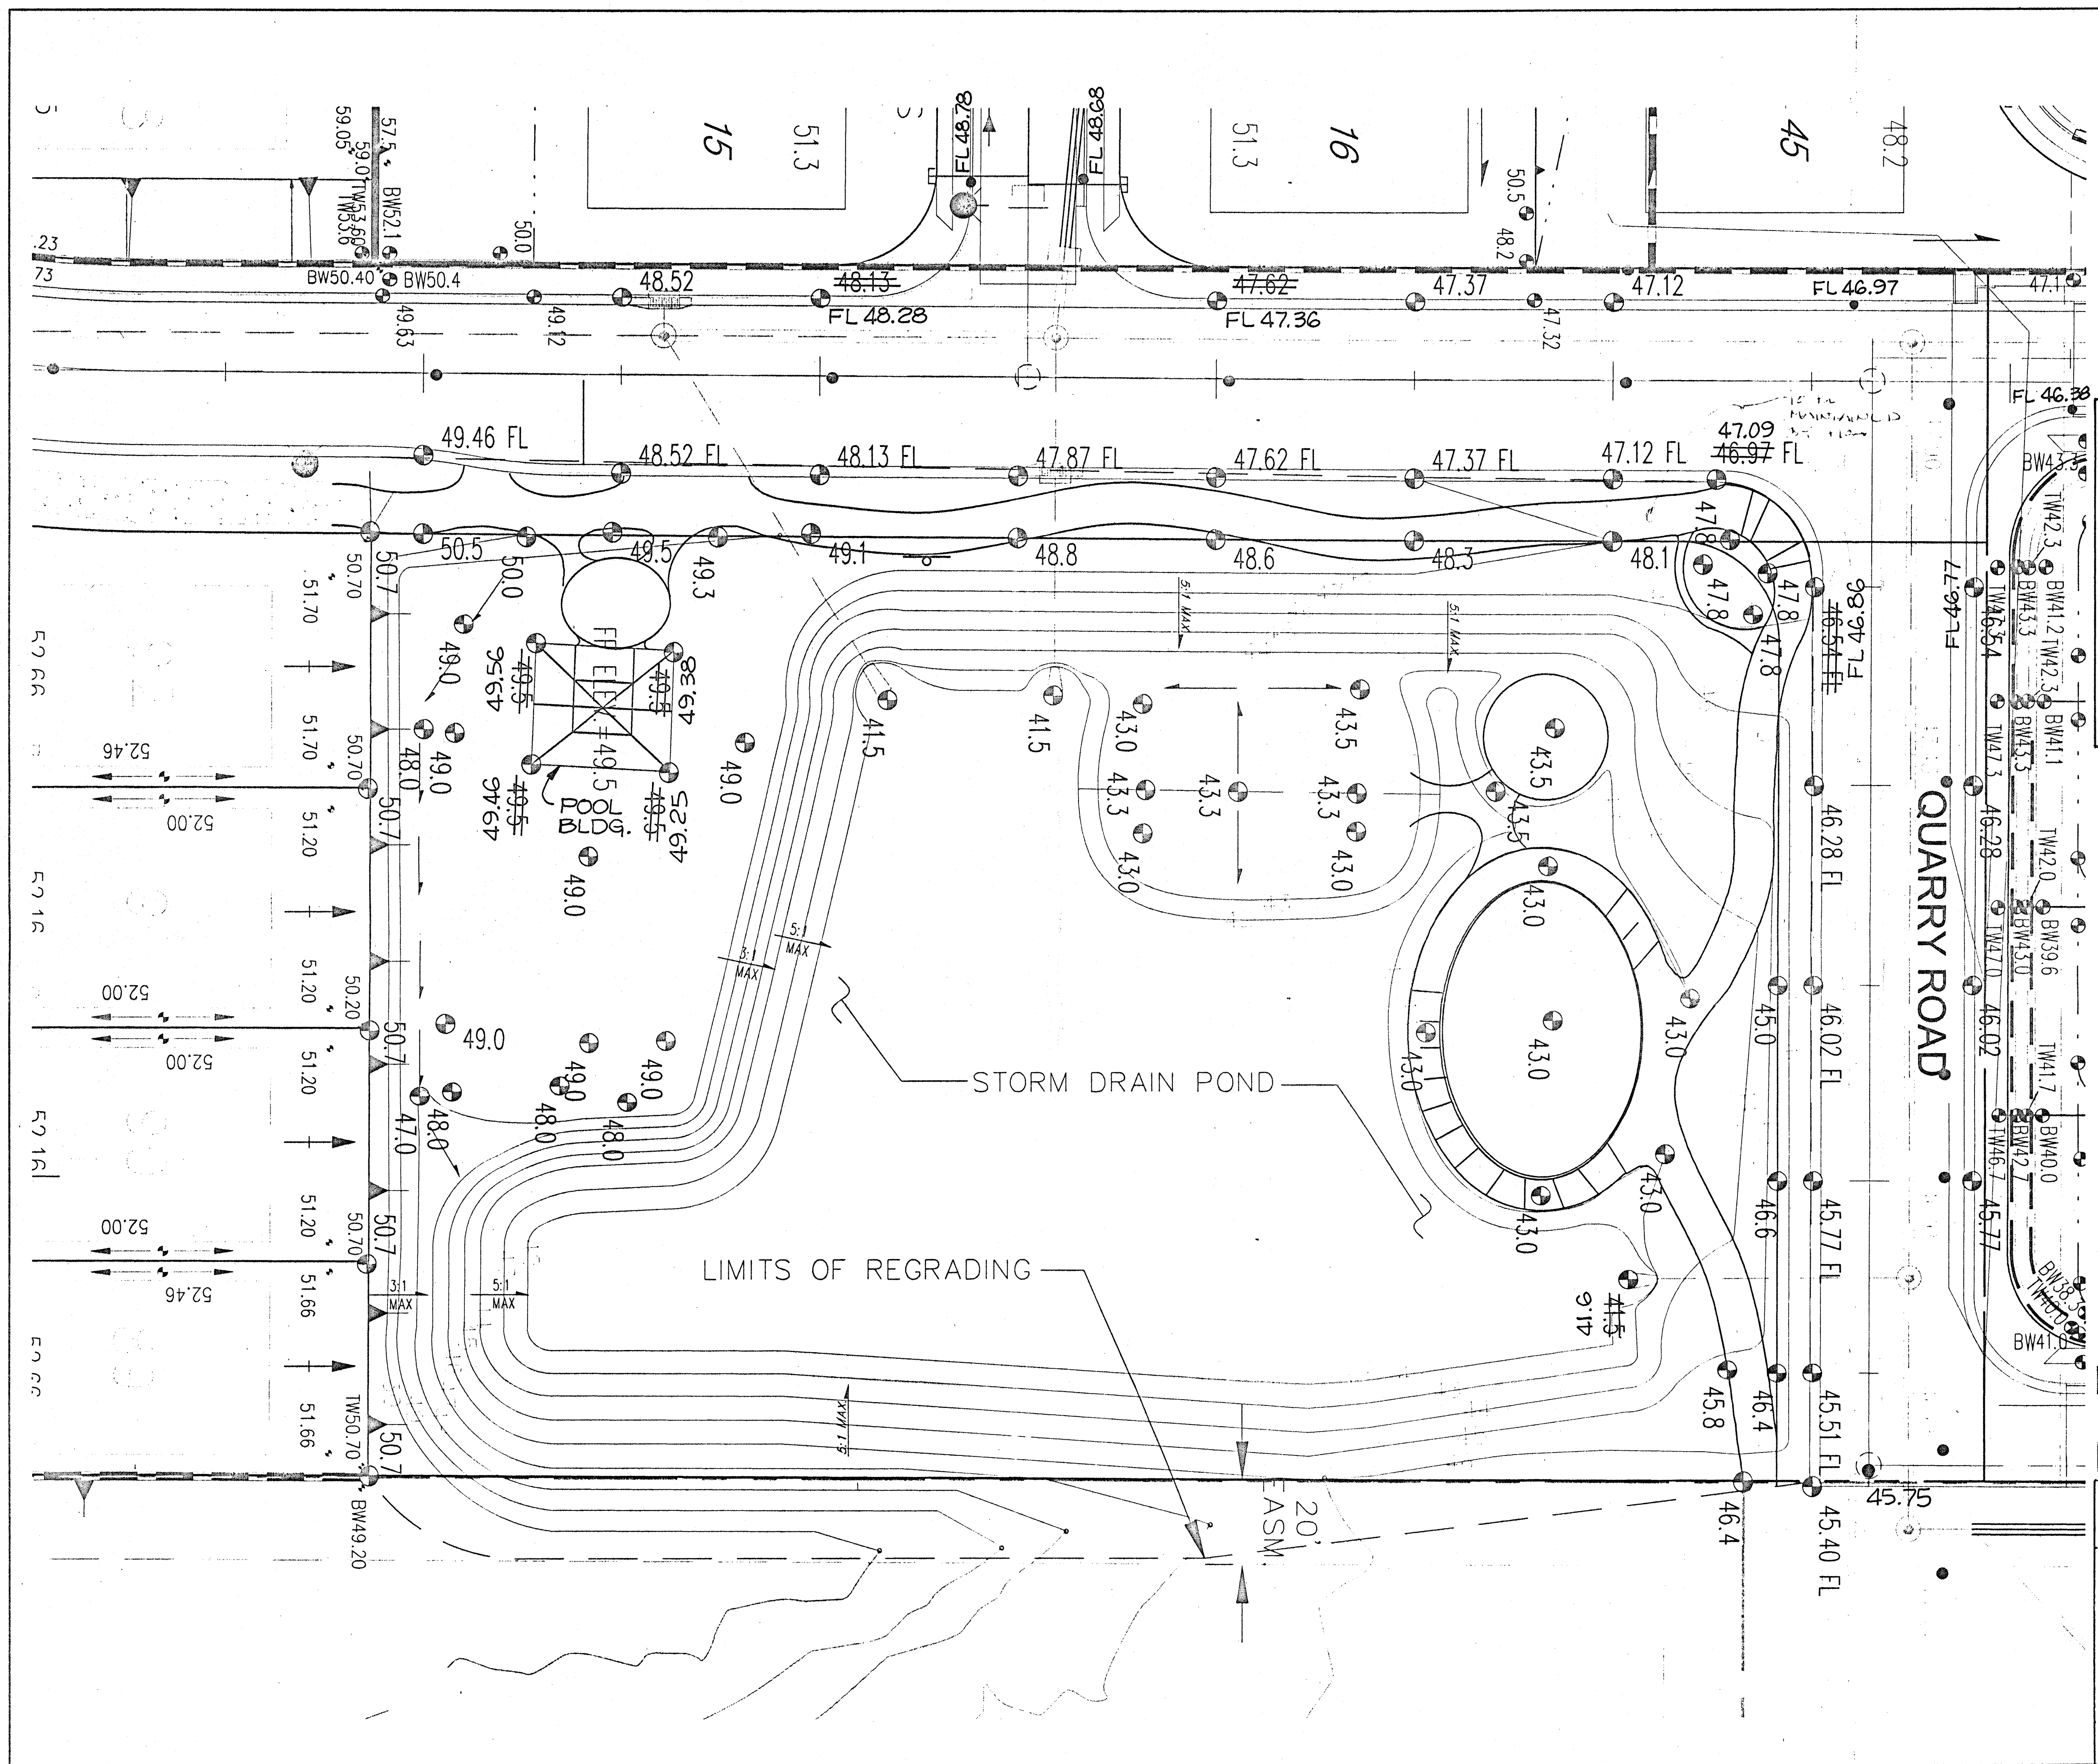

DRAINAGE CERTIFICATION

I, RICHARD L. BELTRAMO OF BOHANNAN HUSTON, N.M.P.E. # 10536, HEREBY CERTIFY THAT THE AS-BUILT DRAINAGE CONDITIONS OF THE SITE ARE IN SUBSTANTIAL COMPLIANCE WITH THE APPROVED GRADING AND DRAINAGE PLAN, TO THE BEST OF MY KNOWLEDGE AND BELIEF. AS-BUILT ELEVATIONS ARE SHOWN ON THE PLAN WHERE THE ORIGINAL DESIGN ELEVATION HAS BEEN CROSSED OUT AND THE AS-BUILT ELEVATION ADDED. AS-BUILT ELEVATIONS WERE VERIFIED BY SALLS BROTHERS CONSTRUCTION, L.S. # 03996658.

THIS STATEMENT DOES NOT REPRESENT CERTIFICATION OF CONTRACTOR'S METHODS OR MATERIALS.

[Signature]
DATE: 11/13/00

[Seal]
RICHARD L. BELTRAMO
N.M.P.E. # 10536
REGISTERED PROFESSIONAL ENGINEER

LEGEND

	EXISTING CONTOUR
	PROPOSED CONTOUR
	SPOT ELEVATION
	CMU RETAINING WALL
	CMU WALL
	SWALE
	DIRECTION OF FLOW
	WATER BLOCK
	SLOPE
	STORM DRAIN INLET
	TEMPORARY GRADING LIMIT
	UNIT BOUNDARY

Bohannon & Huston
Courtyard One 7500 JEFFERSON NE Albuquerque NEW MEXICO 87109
ENGINEERS PLANNERS PHOTOGRAMMETRISTS SURVEYORS SOFTWARE DEVELOPERS

CITY OF ALBUQUERQUE
PUBLIC WORKS DEPARTMENT
ENGINEERING DEVELOPMENT GROUP
STONEBRIDGE SUBDIVISION - UNITS 1 & 2
PARK REGRADING PLAN

Design Review Committee	City Engineer Approval	Mo./Day/Yr.	Mo./Day/Yr.
City Project No.	Zone Map No.	Sheet	Of
612981	A-12-Z	88	37

AS-BUILT INFORMATION		BENCH MARKS		SURVEY INFORMATION		ENGINEER'S SEAL		REVISIONS		DESIGN		REVISIONS		DESIGN	
CONTRACTOR	DATE	CONTRACTOR	DATE	NO.	DATE	NO.	DATE	NO.	DATE	NO.	DATE	NO.	DATE	NO.	DATE
BOHANNAN HUSTON	11/13/00	ACS Brass Tablet stamped	11-11-1980												
STATIONED BY	DATE	Geographic Position	DATE												
BOHANNAN HUSTON	11/13/00	N.M. State Plane Coordinates (Central Zone)	1927												
ADJUSTED BY	DATE	X =	Y =												
BOHANNAN HUSTON	11/13/00	365,236.60	1,531,711.91												
SUPERVISOR BY	DATE	Ground-to-Grid Factor													
BOHANNAN HUSTON	11/13/00	0.9996658													
RECORDED BY	DATE	SD 1929 Elevation													
BOHANNAN HUSTON	11/13/00	5331.73													

