



City of Albuquerque

P.O. BOX 1293 ALBUQUERQUE, NEW MEXICO 87103

February 15, 2001

Rick Beltramo, P.E.
Bohannon Huston, Inc.
7500 Jefferson NE
Albuquerque, NM 87109

Re: Engineers Certification – Stonebridge Subd Unit 1 (A-12/D16)
Submitted for Release of Financial Guaranty
Engineers Stamp dated 5/17/ 1999
Engineers Certification Dated 11/13/2000

Dear Mr. Beltramo:


Based upon the information provided in your submittal dated 1/13/2001, the Engineering Certification for the above referenced project is approved for Release of Financial Guaranty.

If I can be of further assistance, please contact me at 924-3986.

Sincerely,


Bradley L. Bingham, PE
Senior Civil Engineer, Hydrology
Public Works Dept./C.O.A.

C: Arlene Portillo, PWD – #612981
file

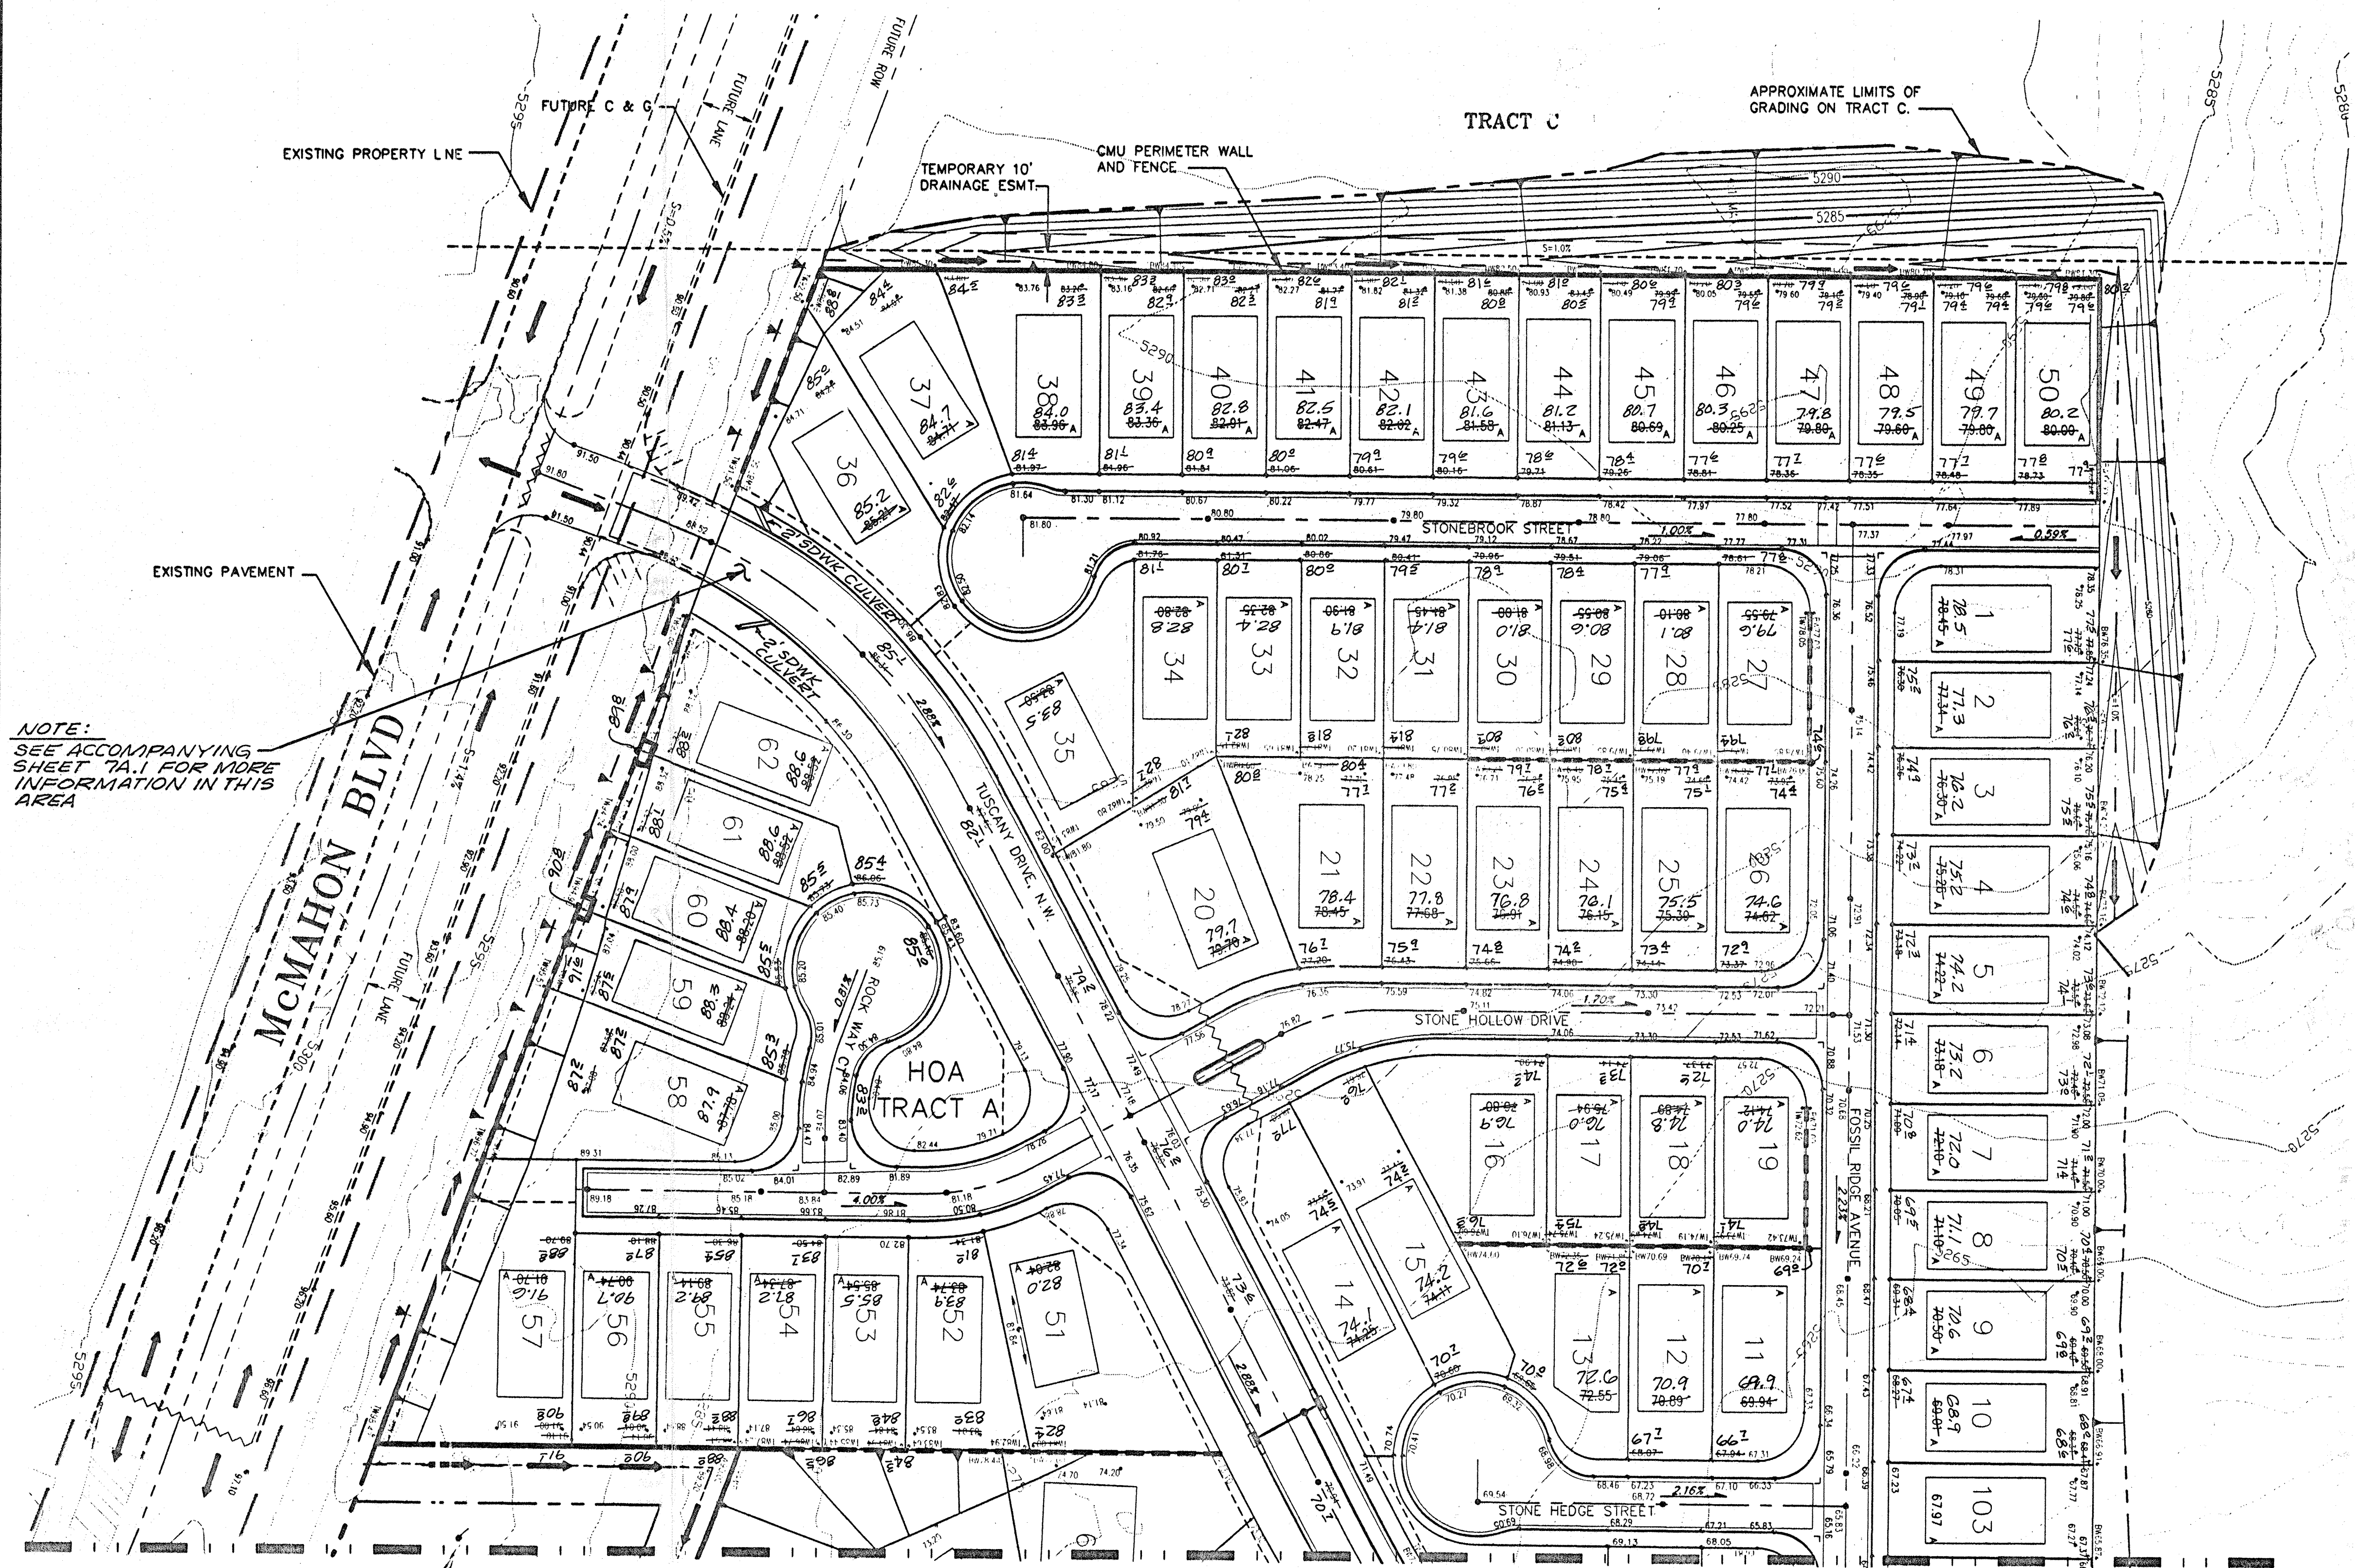

NOTE:
SEE ACCOMPANYING
SHEET 7A.1 FOR MORE
INFORMATION IN THIS
AREA

MATCHLINE ~ SEE SHEET 4 FOR CONTINUATION

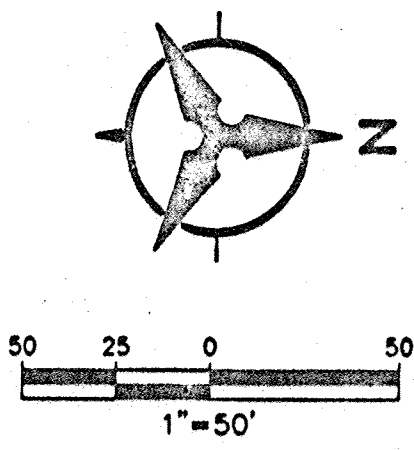

DRAINAGE CERTIFICATION

I, **RICHARD L. BELTRAMO** OF BOHANNAN HUSTON, N.M.P.E. # 105586, HEREBY CERTIFY THAT THE AS-BUILT DRAINAGE CONDITIONS OF THE SITE ARE IN SUBSTANTIAL COMPLIANCE WITH THE APPROVED GRADING AND DRAINAGE PLAN, TO THE BEST OF MY KNOWLEDGE AND BELIEF. AS-BUILT ELEVATIONS ARE SHOWN ON THE PLAN WHERE THE ORIGINAL DESIGN ELEVATION HAS BEEN CROSSED OUT AND THE AS-BUILT ELEVATION ADDED. AS-BUILT ELEVATIONS WERE VERIFIED BY SALLS BROTHERS CONSTRUCTION, L.S. # 3720243. THIS STATEMENT DOES NOT REPRESENT CERTIFICATION OF CONTRACTOR'S METHODS OR MATERIALS.

DATE: 11/13/00

[Signature]

BOHANNAN LYN BELTRAMO
REGISTERED PROFESSIONAL ENGINEER
105586

LEGEND

- 5470 — EXISTING CONTOUR
- 5470 — PROPOSED CONTOUR
- 54.12 SPOT ELEVATION
- CMU RETAINING WALL
- CMU WALL
- SWALE
- DIRECTION OF FLOW
- WATER BLOCK
- SLOPE
- STORM DRAIN INLET
- TEMPORARY GRADING LIMIT

Bohannon & Huston


County One 7500 JEFFERSON NE ALBUQUERQUE NEW MEXICO 87109

ENGINEERS PLANNERS PHOTOGRAMMETRISTS SURVEYORS SOFTWARE DEVELOPERS


CITY OF ALBUQUERQUE
PUBLIC WORKS DEPARTMENT
ENGINEERING DEVELOPMENT GROUP

STONEBRIDGE SUBDIVISION
GRADING AND DRAINAGE PLAN

Design Review Committee	City Engineer Approval	Mo./Day/Yr.	Mo./Day/Yr.
APPROVED AT DRB	<i>[Signature]</i>		
City Project No.	Zone Map No.	Sheet	Of
612981	A-12-Z	3	37

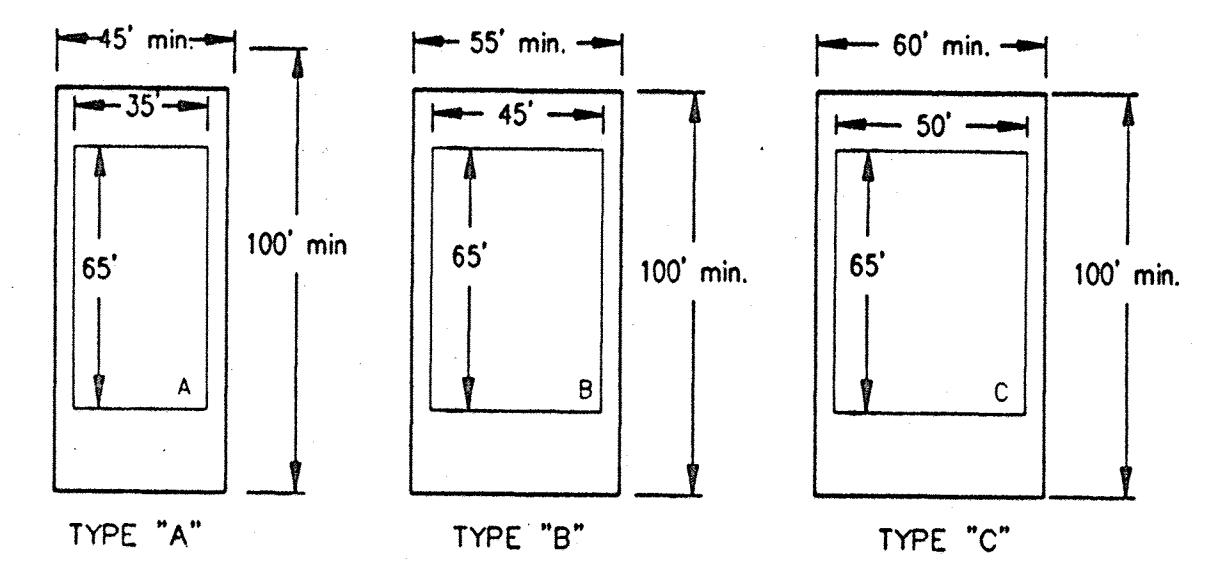


MATCHLINE ~ SEE SHEET 3 FOR CONTINUATION

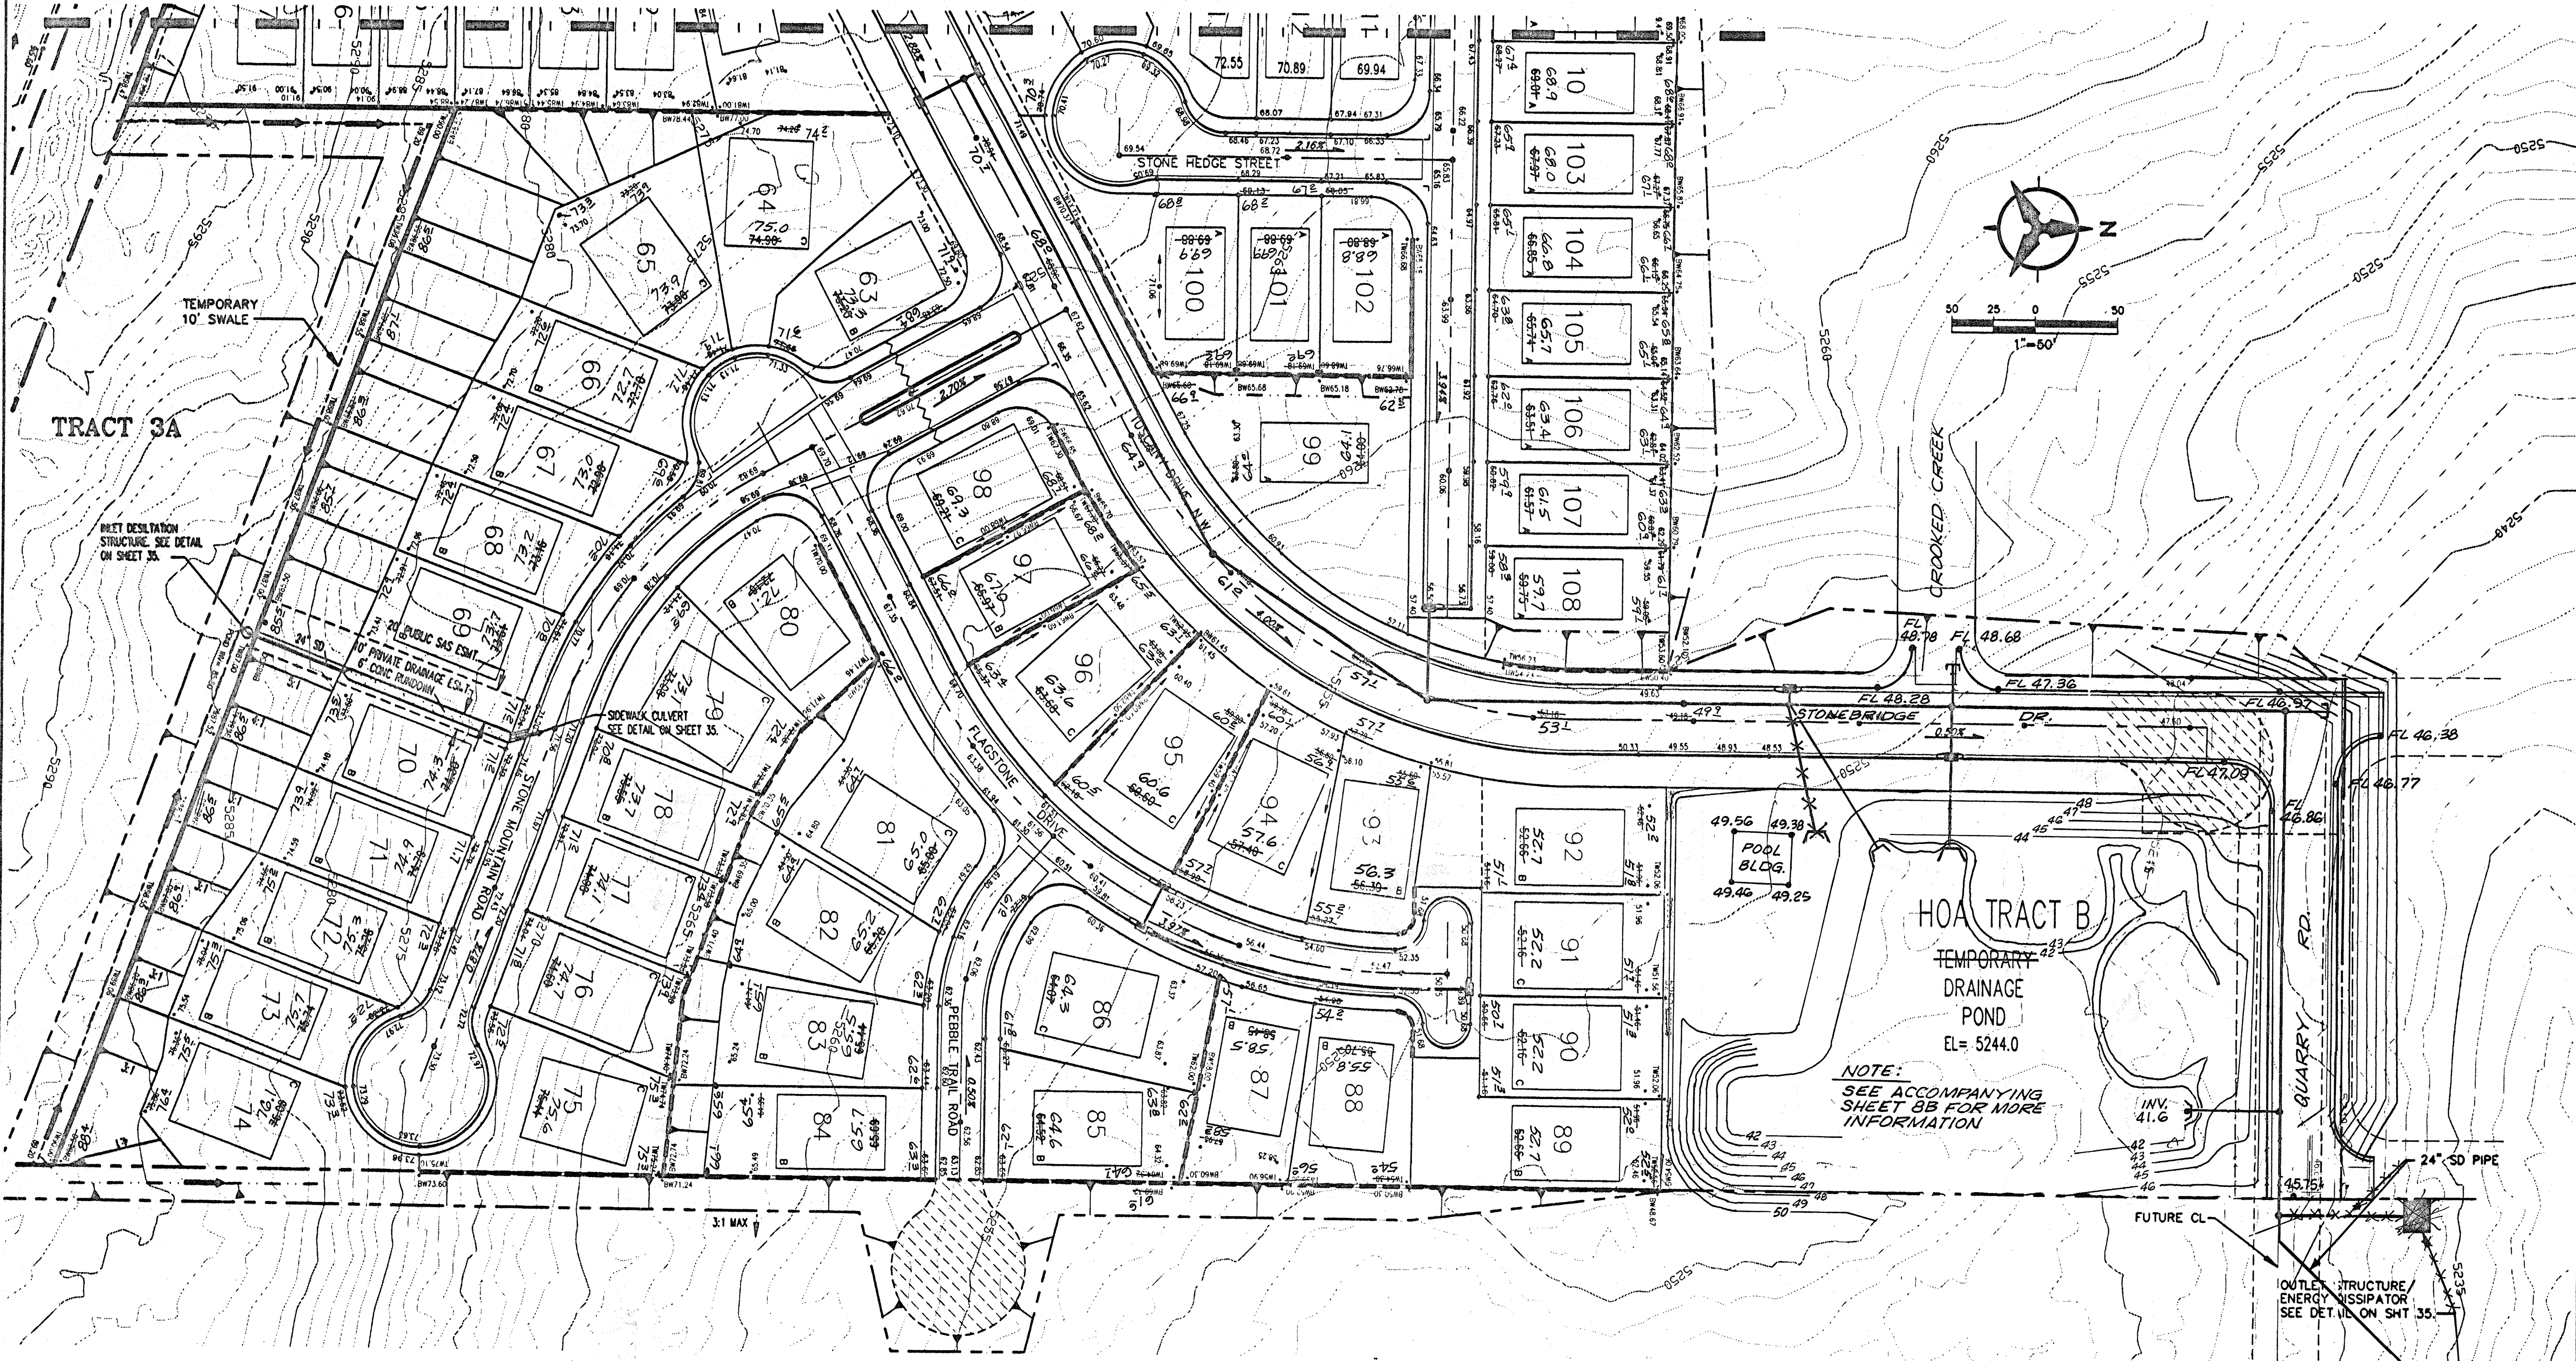

DRAINAGE CERTIFICATION

I, RICHARD L. BELTRAMO OF BOHANNAN HUSTON, N.M.P.E. # 10596 HEREBY CERTIFY THAT THE AS-BUILT DRAINAGE CONDITIONS OF THE SITE ARE IN SUBSTANTIAL COMPLIANCE WITH THE APPROVED GRADING AND DRAINAGE PLAN, TO THE BEST OF MY KNOWLEDGE AND BELIEF. AS-BUILT ELEVATIONS ARE SHOWN ON THE PLAN WHERE THE ORIGINAL DESIGN ELEVATION HAS BEEN CROSSED OUT AND THE AS-BUILT ELEVATION ADDED. AS-BUILT ELEVATIONS WERE VERIFIED BY SALLS BROTHERS CONSTRUCTION, L.S. # 1113100. THIS STATEMENT DOES NOT REPRESENT CERTIFICATION OF CONTRACTOR'S METHODS OR MATERIALS.

NAME: Richard L. Beltramo
DATE: 11/13/00

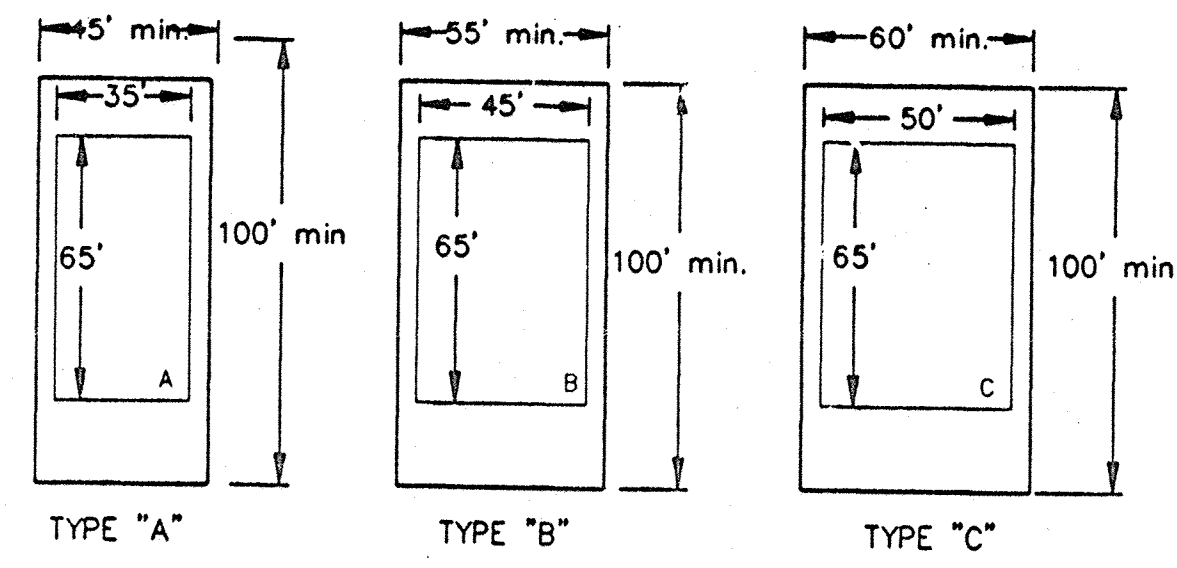

LEGEND

- 5470 — EXISTING CONTOUR
- 54.12 — PROPOSED CONTOUR
- SPOT ELEVATION
- CAU WALL
- RETAINING WALL
- SWALE
- ← DIRECTION OF FLOW
- ~ WATER BLOCK
- SLOPE
- STORM DRAIN INLET
- TEMPORARY GRADING LIMIT


Bohannon & Huston
Engineers Planners PM's GRAMMETISTS SURVEYORS SOFTWARE DEVELOPERS
County One 7500 JEFFERSON NE Albuquerque NEW MEXICO 87109

CITY OF ALBUQUERQUE
PUBLIC WORKS DEPARTMENT
ENGINEERING DEVELOPMENT GROUP

STONEBRIDGE SUBDIVISION
GRADING AND DRAINAGE PLAN

Design Review Committee: City Engineer Approval
APPROVED AT DRS

City Project No. **612981** Zone Map No. **A-12-Z** Sheet **4** of **37**

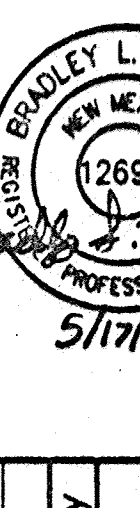ENGINEER'S SEAL		SURVEY INFORMATION		BENCH MARKS		AS-BUILT INFORMATION			
 5/17/99		FIELD NOTES							
		NO.	BY	DATE					