
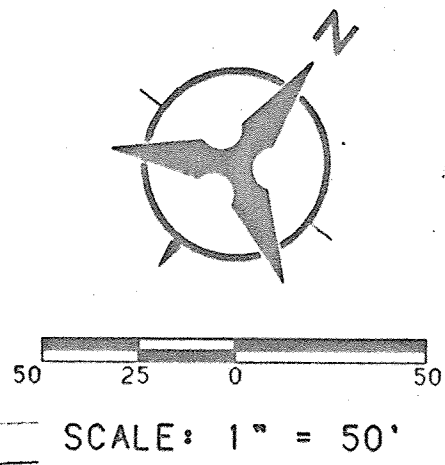


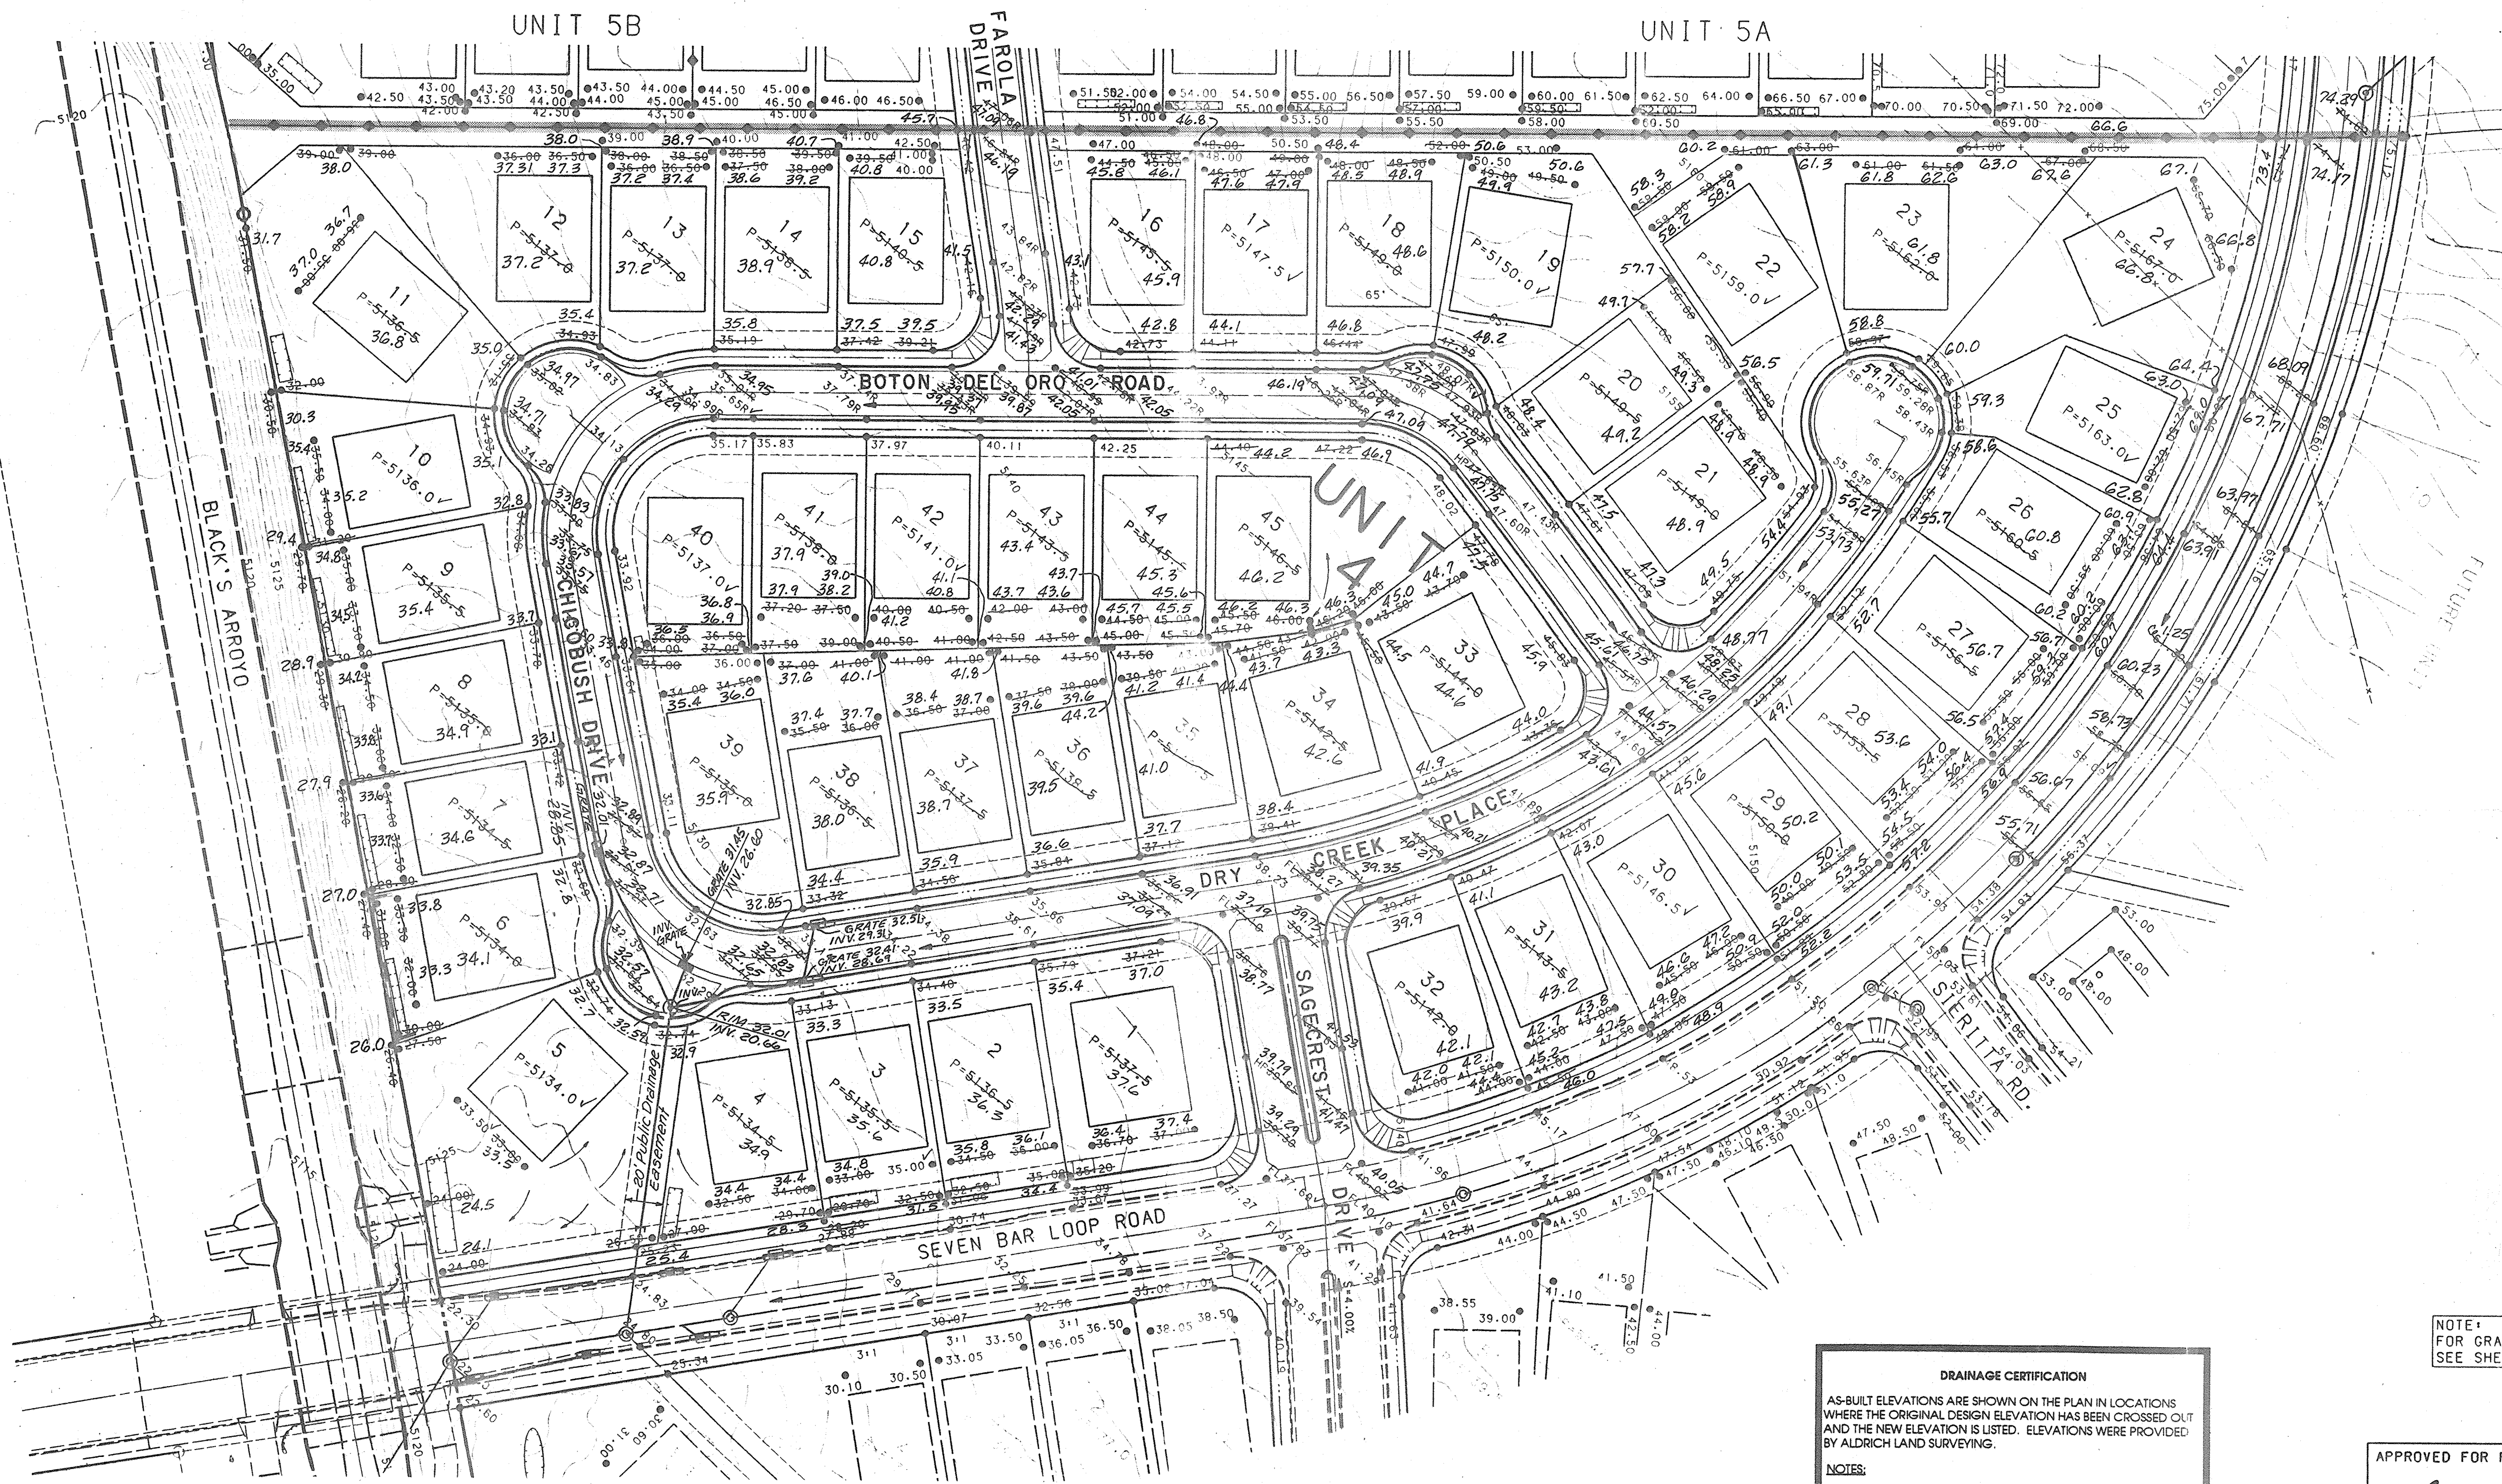


DRAINAGE CERTIFICATION

AS-BUILT ELEVATIONS ARE SHOWN ON THE PLAN IN LOCATIONS WHERE THE ORIGINAL DESIGN ELEVATION HAS BEEN CROSSED OUT AND THE NEW ELEVATION IS LISTED. ELEVATIONS WERE PROVIDED BY ALDRICH LAND SURVEYING.

NOTES:

I, JAMES R. TOPMILLER, OF BOHANNAN-HUSTON, INC., A REGISTERED PROFESSIONAL ENGINEER IN THE STATE OF NEW MEXICO, DO HEREBY CERTIFY THAT THE EXISTING AND PROPOSED DRAINAGE CONDITIONS OF THIS SITE ARE IN SUBSTANTIAL COMPLIANCE WITH PREVIOUSLY APPROVED PLANS, TO THE BEST OF MY KNOWLEDGE AND BELIEF.

JAMES R. TOPMILLER, P.E.
N.M.P.E. No. 9354
DATE: 11/2/95

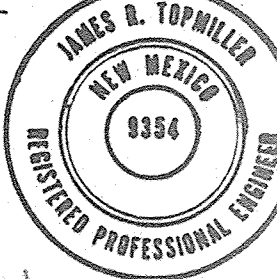

NOTE:
FOR GRADING DETAILS
SEE SHEET 30 OF 18

APPROVED FOR ROUGH GRADING (± 1')					
		1-20-95		DATE	
HYDROLOGY ENGINEER					
CITY OF ALBUQUERQUE PUBLIC WORKS DEPARTMENT ENGINEERING GROUP					
SEVEN BAR NORTH - UNIT 4, 5, 6 PRELIMINARY GRADING PLAN					
APPROVALS	ENGINEER	DATE	APPROVALS	ENGINEER	DATE
DRC CHAIRMAN			WATER		
TRANSPORTATION			WASTE WATER		
HYDROLOGY					
DRAWING NO.	4982.92	MAP NO. A-13	SHEET 3A	OF 18	

ENGINEER'S SEAL			SURVEY INFORMATION			BENCH MARKS			AS-BUILT INFORMATION		
 <i>James R. Topmiller</i> 1/13/95			NO.			FIELD NOTES			TBM NO. 205		
			BY			DATE			CHISEL "X" LOCATED APPROXIMATELY 459 FEET DOWN BY		
NO. DATE			REMARKS			BY			SOUTH OF THE BLACK'S DIVERSION INLET		
			REVISIONS						INSPECTOR'S		
			DESIGN						ACCEPTANCE BY		
DESIGNED BY			PR. DF			DATE 10/94			DATE		
DRAWN BY			TSG			DATE 10/94			DATE		
CHECKED BY			JRT			DATE 10/94			DATE		
									NO.		
SHEET 3A OF 18									MICRO-FILM INFORMATION		
RECORDED BY									DATE		
DATE									NO.		
Banner-Houston, Inc. 1994											

Unit 4 Cert