



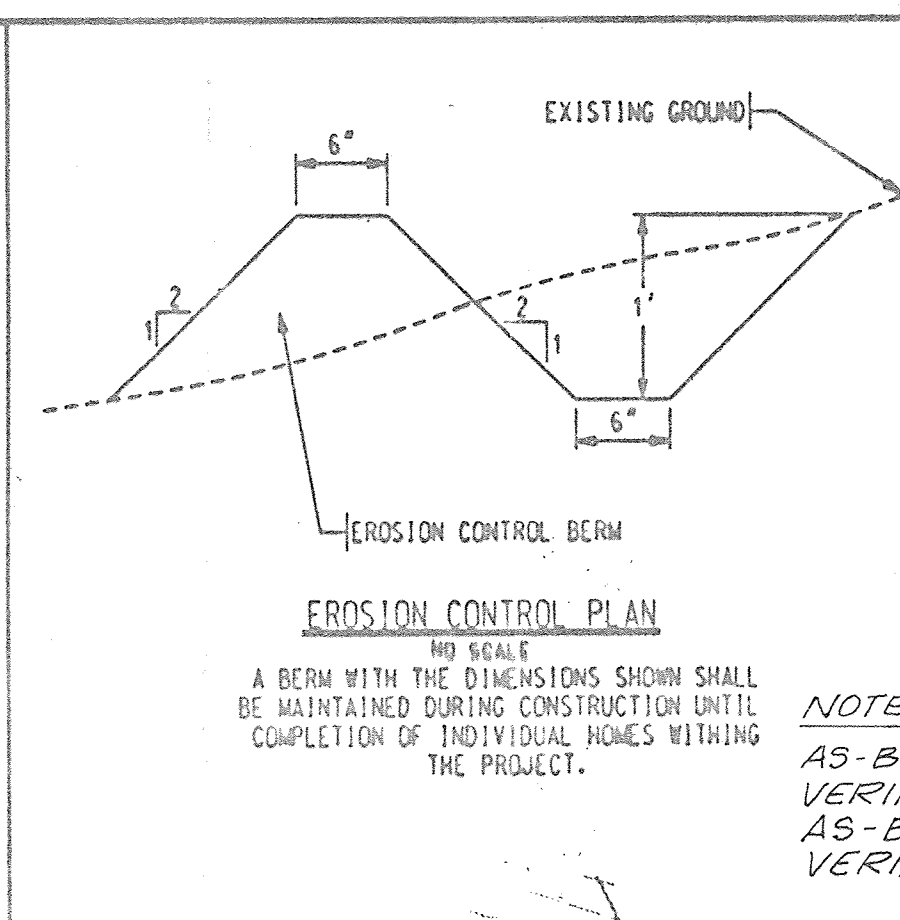



DRAINAGE CERTIFICATION

I, **JAMES R. TOPMILLER** of BOHANNAN
HUSTON, N.M.P.E. # **9354**, HEREBY CERTIFY THAT THE
AS-BUILT DRAINAGE CONDITIONS OF THE SITE ARE IN
SUBSTANTIAL COMPLIANCE WITH THE APPROVED GRADING AND
DRAINAGE PLAN, TO THE BEST OF MY KNOWLEDGE AND BELIEF.
AS-BUILT ELEVATIONS ARE SHOWN ON THE PLAN WHERE THE
ORIGINAL DESIGN ELEVATION HAS BEEN CROSSED OUT AND THE
AS-BUILT ELEVATION IS GIVEN. DRAIN ELEVATIONS WERE
VERIFIED BY **WALKER & ALDRICH SURVEYING, S. #**
6401. THIS STATEMENT DOES NOT REPRESENT
CERTIFICATION OF CONTRACTORS METHODS OR MATERIALS.

Walker
NAME _____
2/18/00
DATE _____


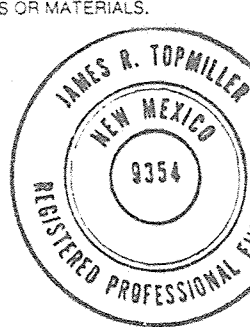


**MILT PAD & YARD ELEVATIONS
VERIFIED BY WALKER SURVEYING.
MILT WALL ELEVATIONS
VERIFIED BY ALDRICH SURVEYING.**

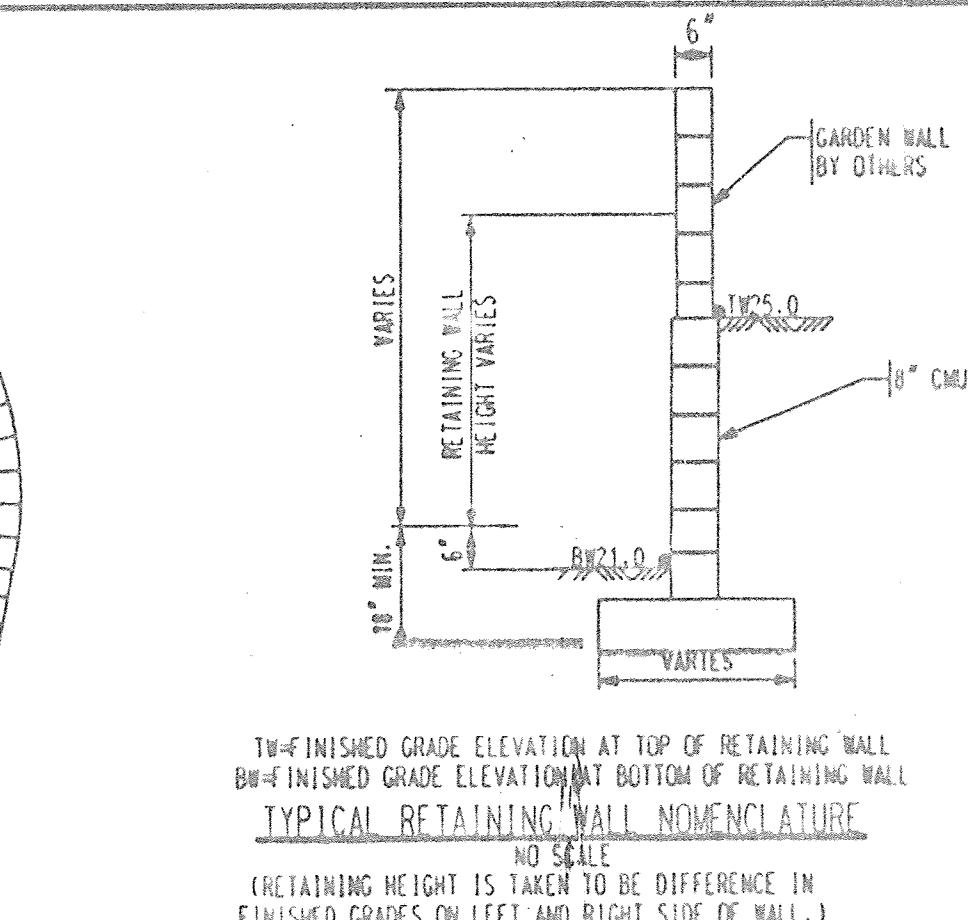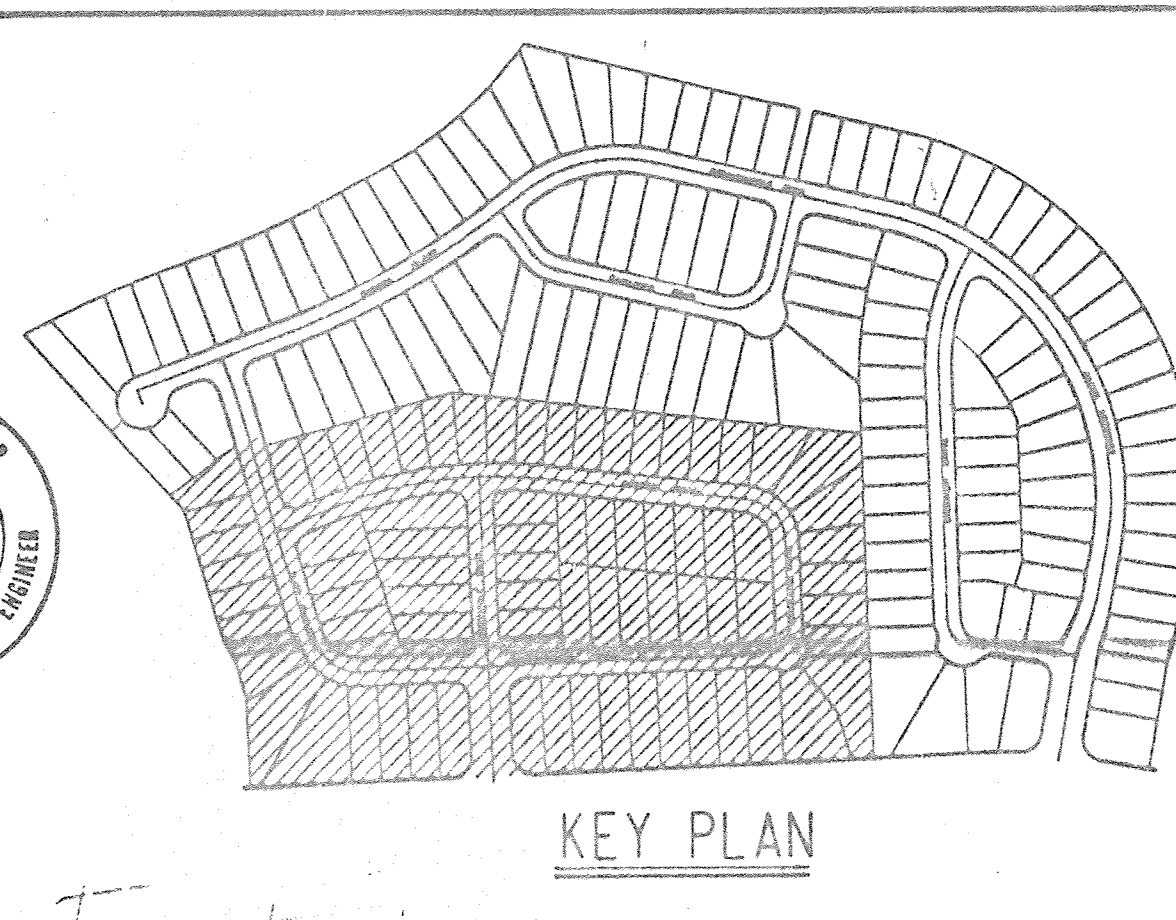

GENERAL NOTES

1. CONTRACTOR MUST OBTAIN A TOPSOIL DISTURBANCE PERMIT FROM THE ENVIRONMENTAL HEALTH DIVISION PRIOR TO CONSTRUCTION.
2. THE CONTRACTOR IS TO REFER TO EARTHWORK SPECIFICATION AS NOTED IN THE SOILS REPORT.
3. THE CONTRACTOR SHALL CONFORM TO ALL CITY, COUNTY, STATE, AND FEDERAL DUST CONTROL MEASURES AND REQUIREMENTS AND WILL BE RESPONSIBLE FOR PREPARING AND OBTAINING ALL NECESSARY APPLICATIONS AND APPROVALS.
4. THE CONTRACTOR SHALL ENSURE THAT NO SOIL ERODES FROM THE LOTS INTO PUBLIC RIGHT-OF-WAY. THIS CAN BE ACHIEVED BY CONSTRUCTING TEMPORARY BEAMS AS PER THE DETAIL ON THIS SHEET AND WETTING THE SOIL TO KEEP IT FROM BLOWING AS PER THE EROSION CONTROL DETAIL ON THIS SHEET.
5. ALL STREET SURFACE ELEVATIONS ARE TO TOP OF CURB UNLESS OTHERWISE NOTED. VALLEY GUTTER ELEVATIONS ARE SHOWN AT FLOORLINE ELEVATION.

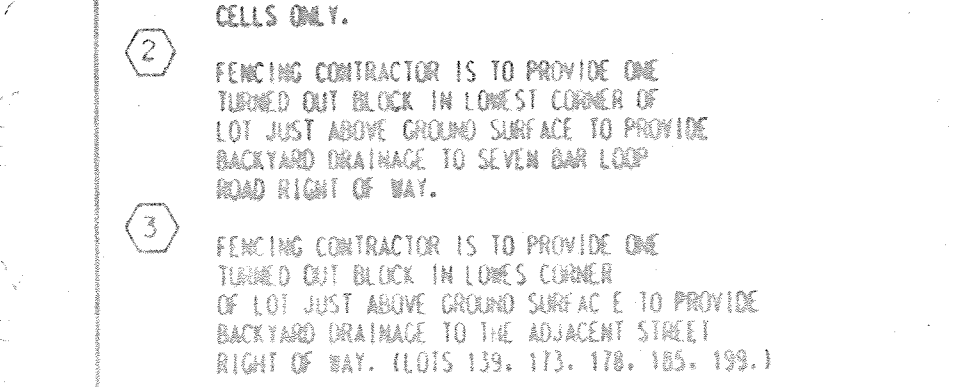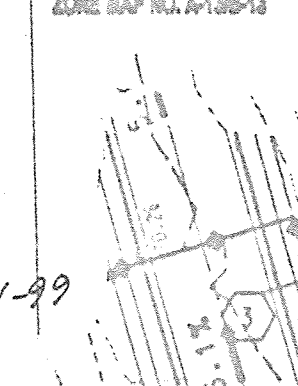

LEGEND

PROPOSED SPOT ELEVATION	• 5235.25
TOP OF HOLE CLUD ELEVATION	• 5235.25M
EXISTING SPOT ELEVATION	• 5235.25
FUTURE SPOT ELEVATION	• 5235.25
PROPOSED RETAINING WALL	
EXISTING CONTOUR	
DIRECTION OF FLOW	
EXISTING STORM DRAIN LINE	
EXISTING STORM DRAIN MANHOLE	
PROPOSED STORM DRAIN INLET	
PROPOSED STORM DRAIN LINE	
PROPOSED STORM DRAIN MANHOLE	
PROPOSED WATER BLOCK	
PROPOSED BACKWATER POND	
EXISTING SAS MANHOLE	
POASING BOUNDARY	

Bohannon • Huston

 Courtyard One 7500 JEFFERSON NE Albuquerque NEW MEXICO 87105
 ENGINEERS PLANNERS PHOTOGRAMMETRISTS SURVEYORS SOFTWARE DEVELOPERS



CITY OF ALBUQUERQUE
PUBLIC WORKS DEPARTMENT
ENGINEERING DEVELOPMENT GROUP

MIRADOR SANDIAS SUBDIVISION
GRADING AND DRAINAGE PLAN

DEVELOPMENT REVIEW BOARD		DNB APPROVAL DATE		  	
DNR / /				RECEIVED MAR 17 2000 HYDROLOGY SECTION	
ENR#	98-138	ZONE MAP NO. 809181	A-13/B-13	SHEET 3	OF 11

[illegible]