


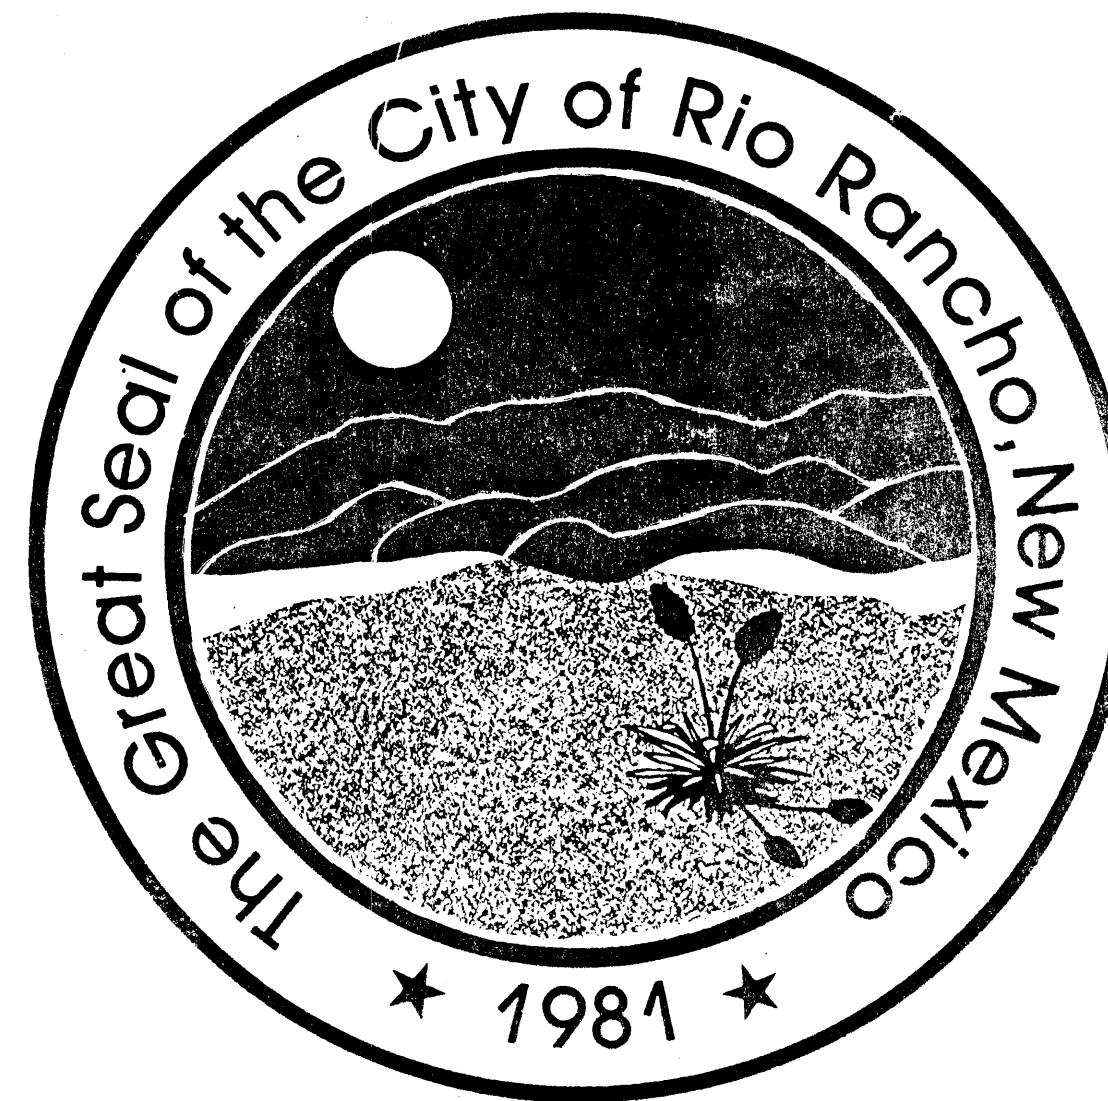

CITY OF RIO RANCHO, NEW MEXICO

ASSESSMENT DISTRICT NO. 1

STREET IMPROVEMENTS

INDEX

COVER SHEET	1
LOCATION MAP, INDEX OF STREETS & LEGEND	2
TYPICAL SECTIONS	3 & 4
PLAN & PROFILE SHEETS (PAVING)	5 / 27
DRAINAGE PLAN LAYOUT & PROFILE	28 / 30
MISCELLANEOUS UTILITY DETAILS	31
DROP INLET DETAILS	32 & 33
19th AVE. POND PUMP DETAILS	34

CITY ENGINEER LOWELL D. LESTER

MOUNTAIN BELL DAVE REYMORE

PUBLIC SERVICE CO. OF N.M. DALE SMYTH

RIO RANCHO CABLE CO. JULIAN SCHULTZ

GAS COMPANY OF N.M. TOM DOLES

ALBUQUERQUE UTILITIES (water) BILL POLLAY RAYMOND E. LUCERO,

**CONDORE'S
SERVICES
AS-BUILT
& FIELD NOTES**



SE
NOT FC

WIL
ENG'G
ALBUQU




BENCHMARK
TBM 86-507-17, Elevation 5368.40
4" Cut on NNW Cap Bolt of Fire
Hydrant on SE Corner of Golf Course
Road & Jane Circle.

Curve Data
 $\Delta = 45^\circ 00' 00''$ LT.
 $R = 1626.72'$
 $L = 1277.62'$
 $T = 673.81'$
 $O = 03^\circ 31' 20''$




BLUE STAKES 1523 & 1524

6" Water Main
has 2' Cover


Tol
TOTAL 7

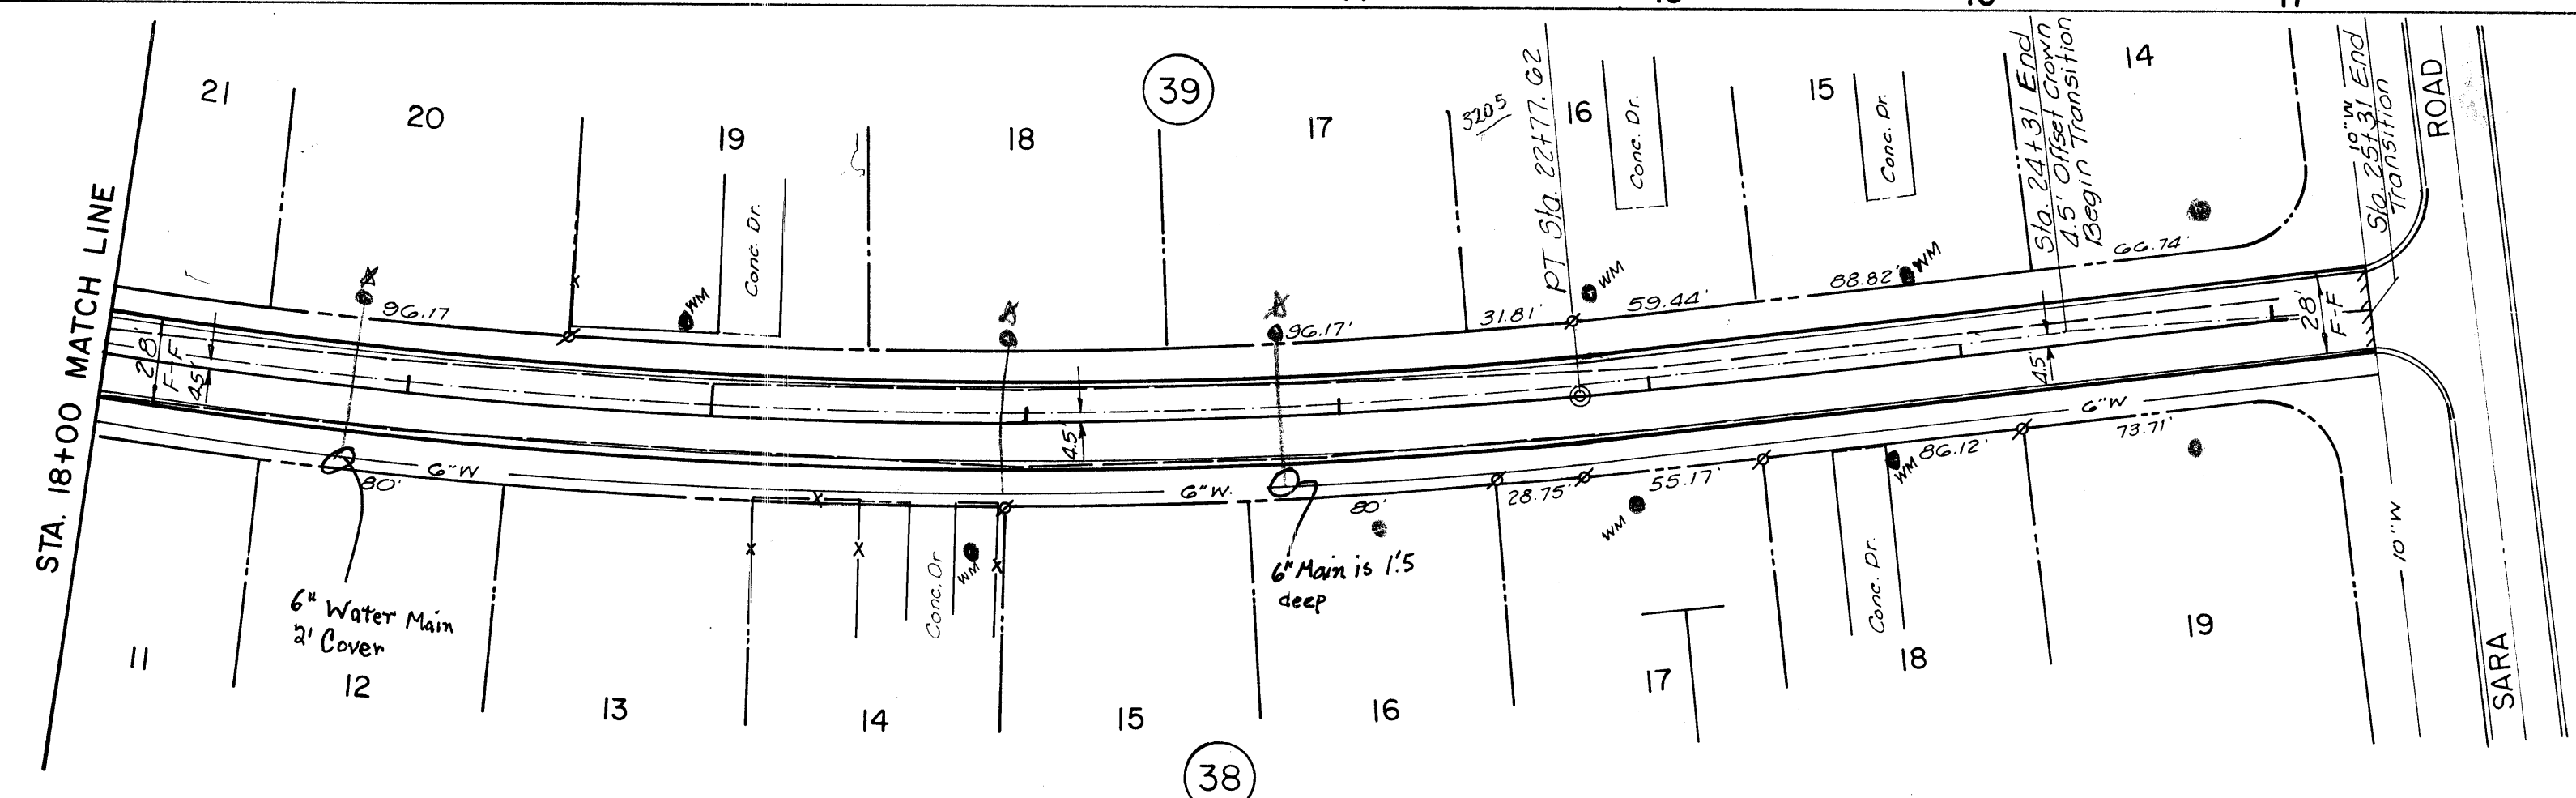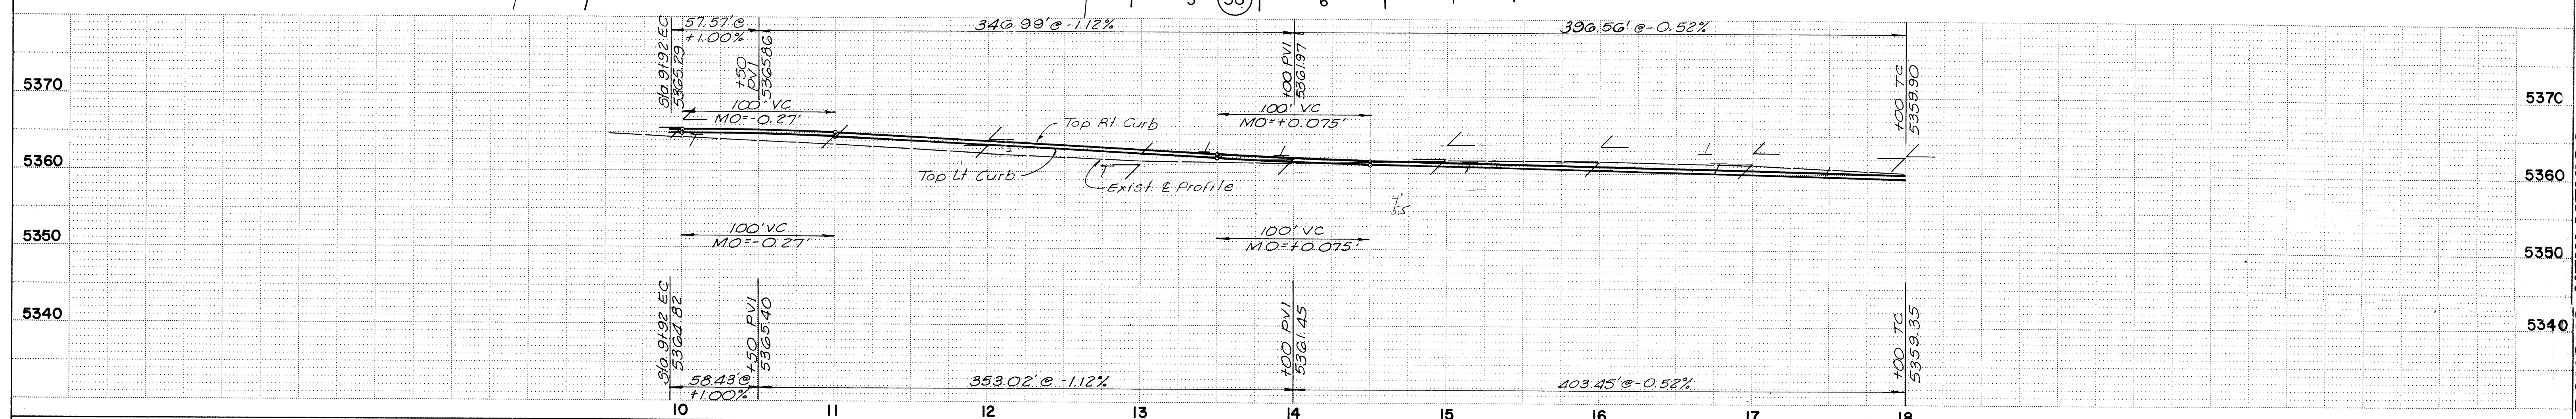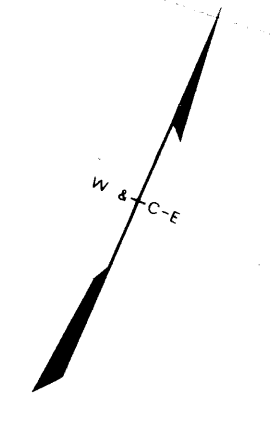


*NOTE
1. Length of curb is measured
along face of curb.
2. All stations are E stations.

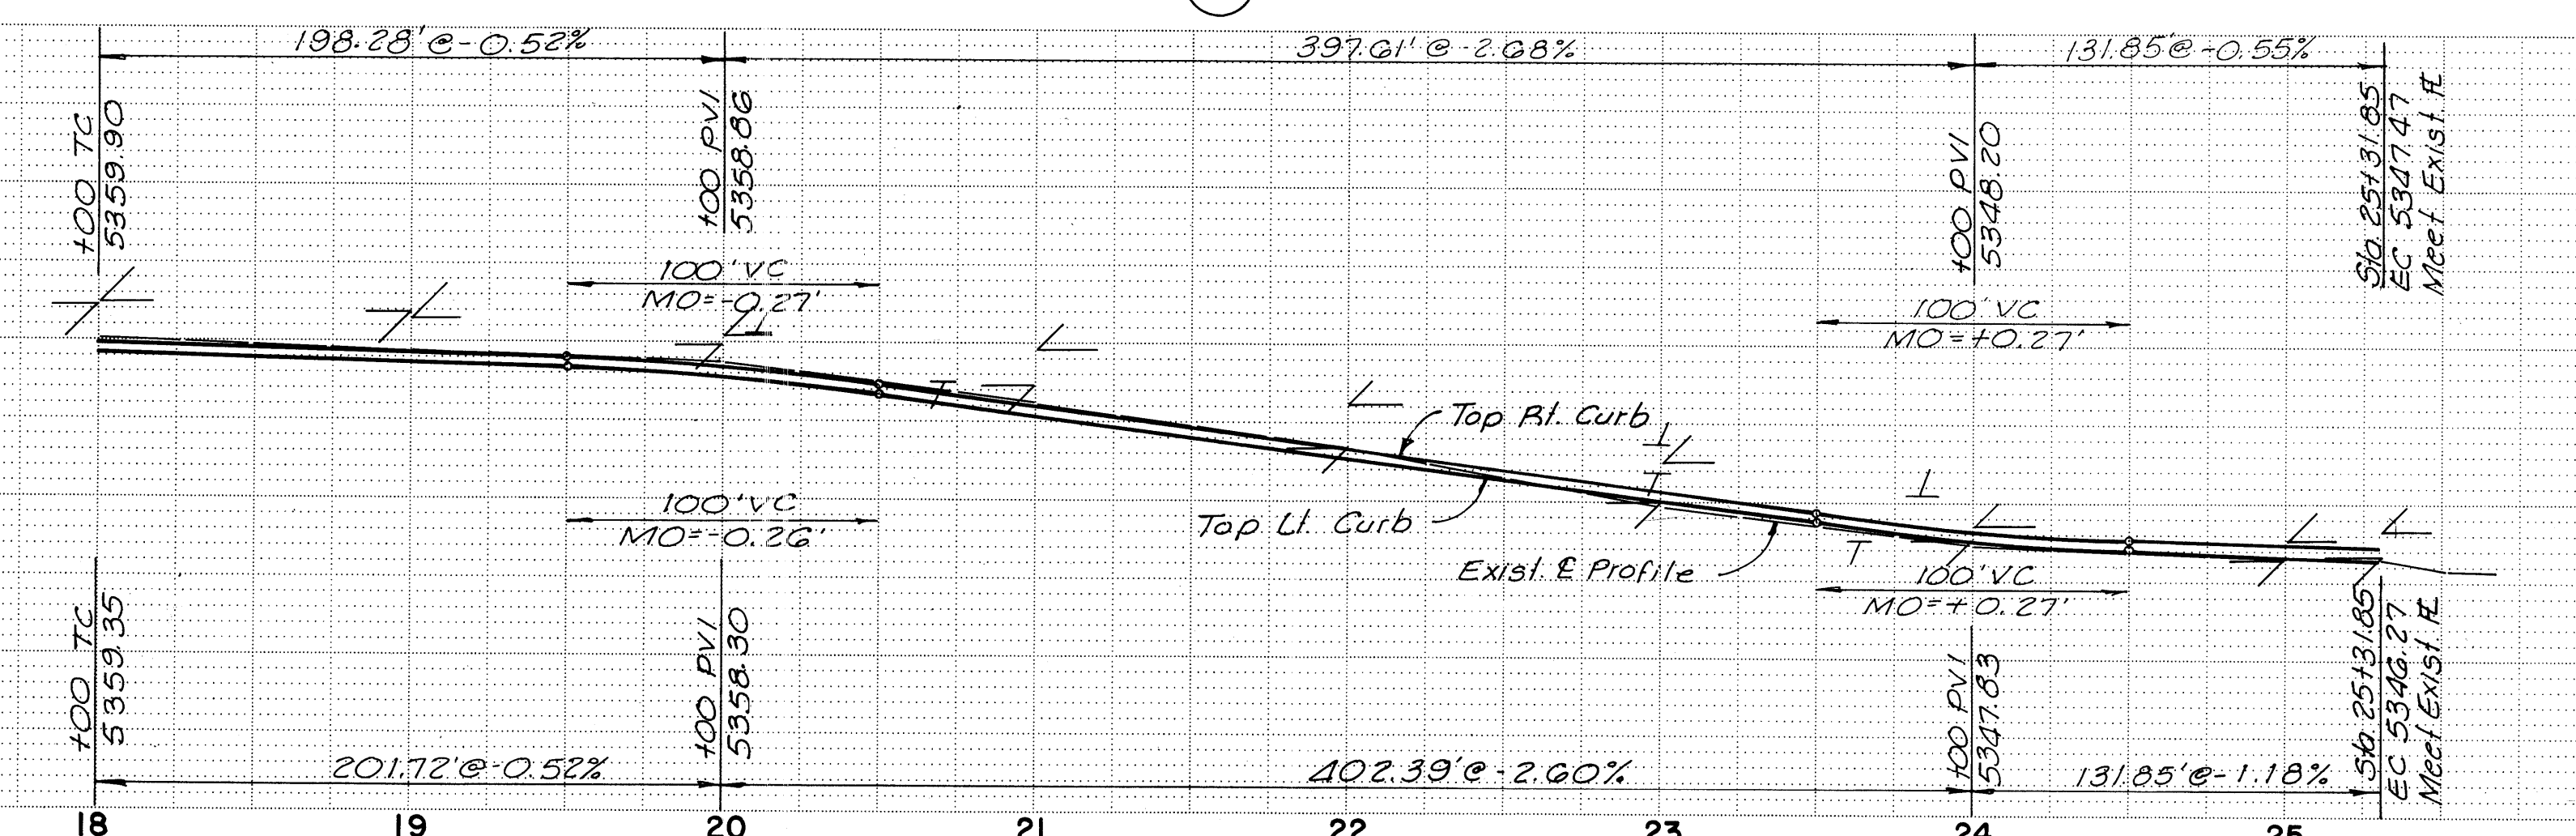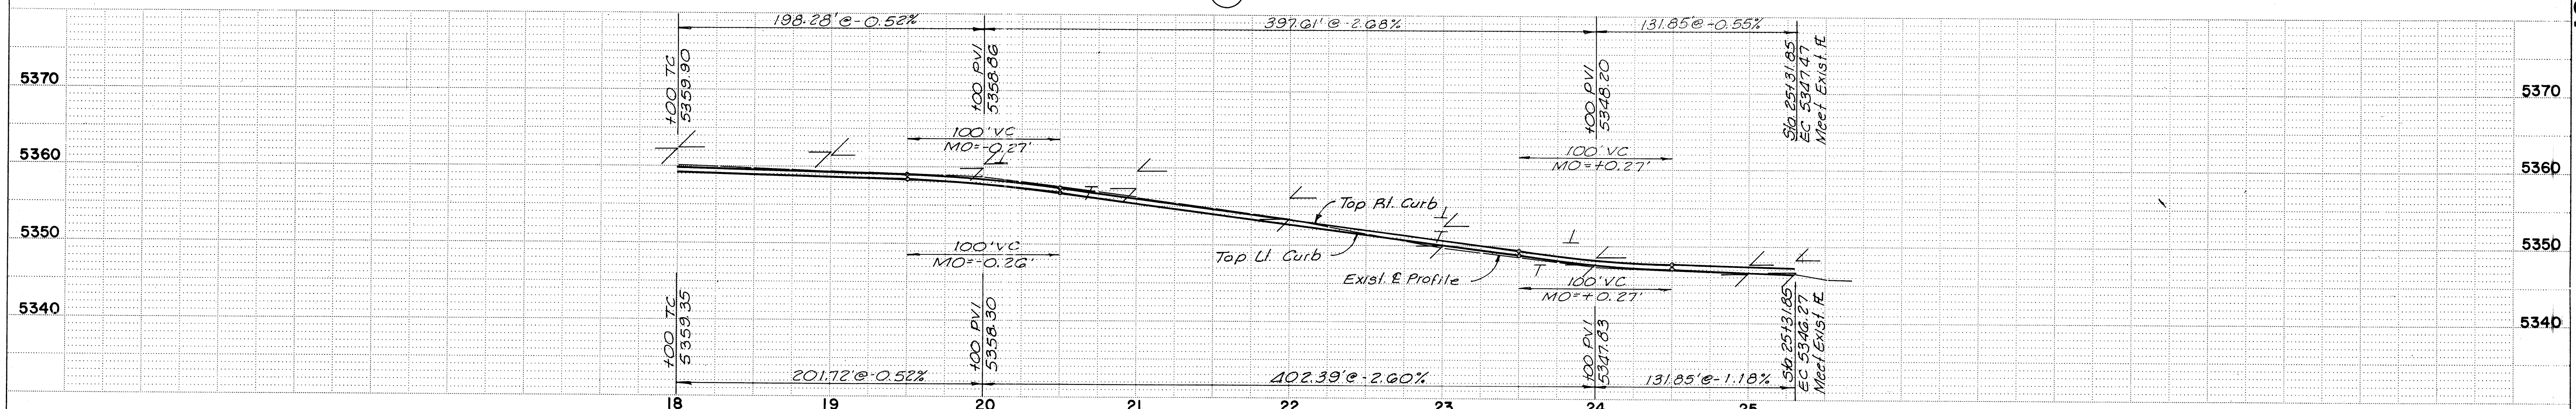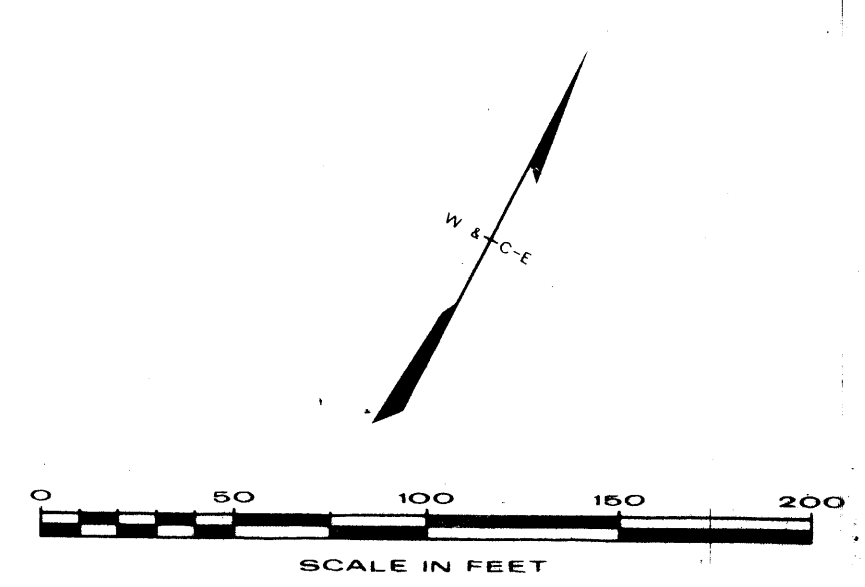


JANE CIRCLE

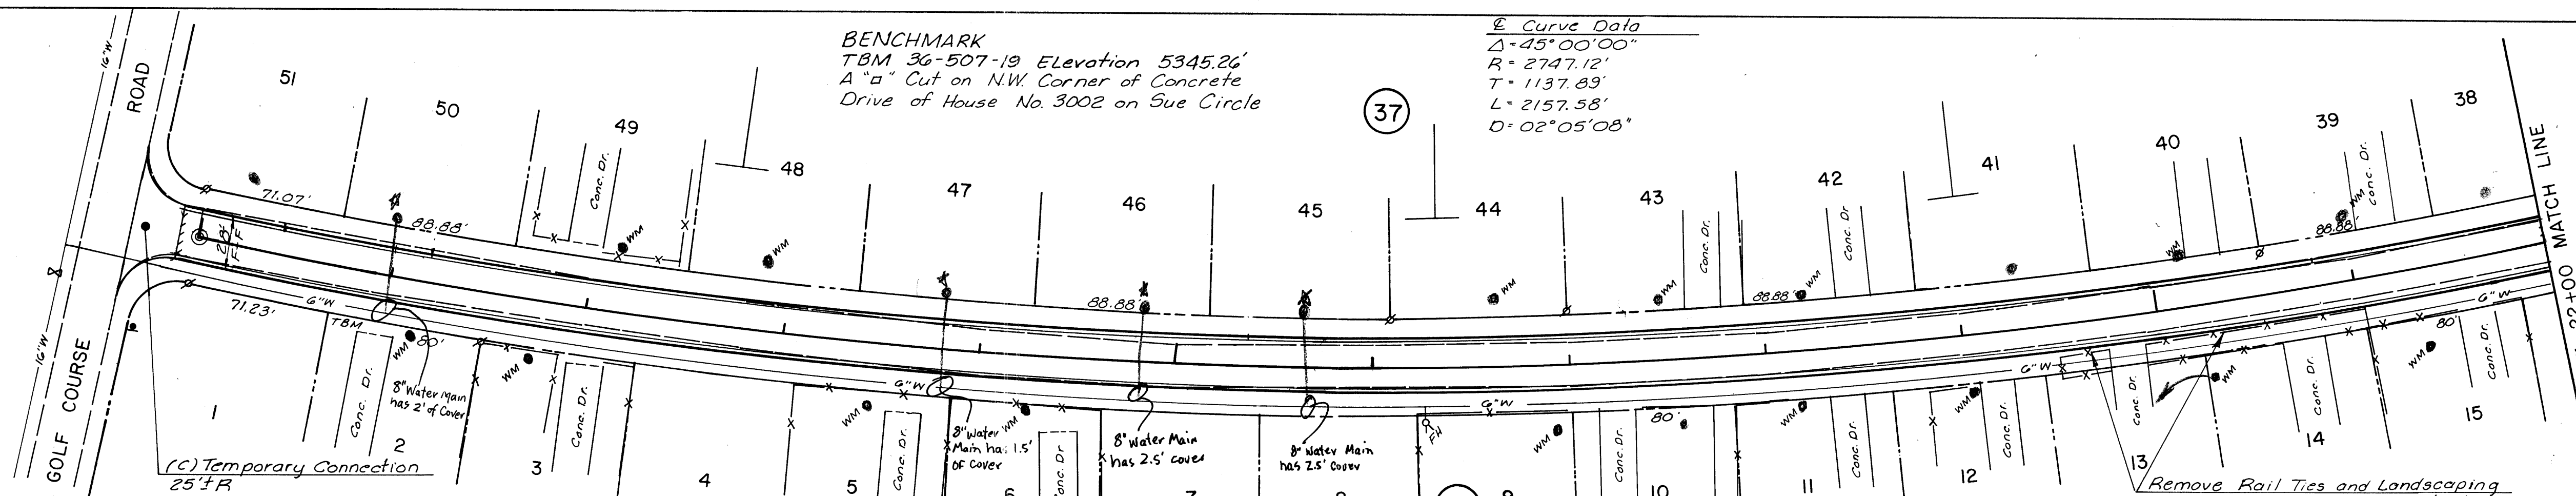


TOTAL 8

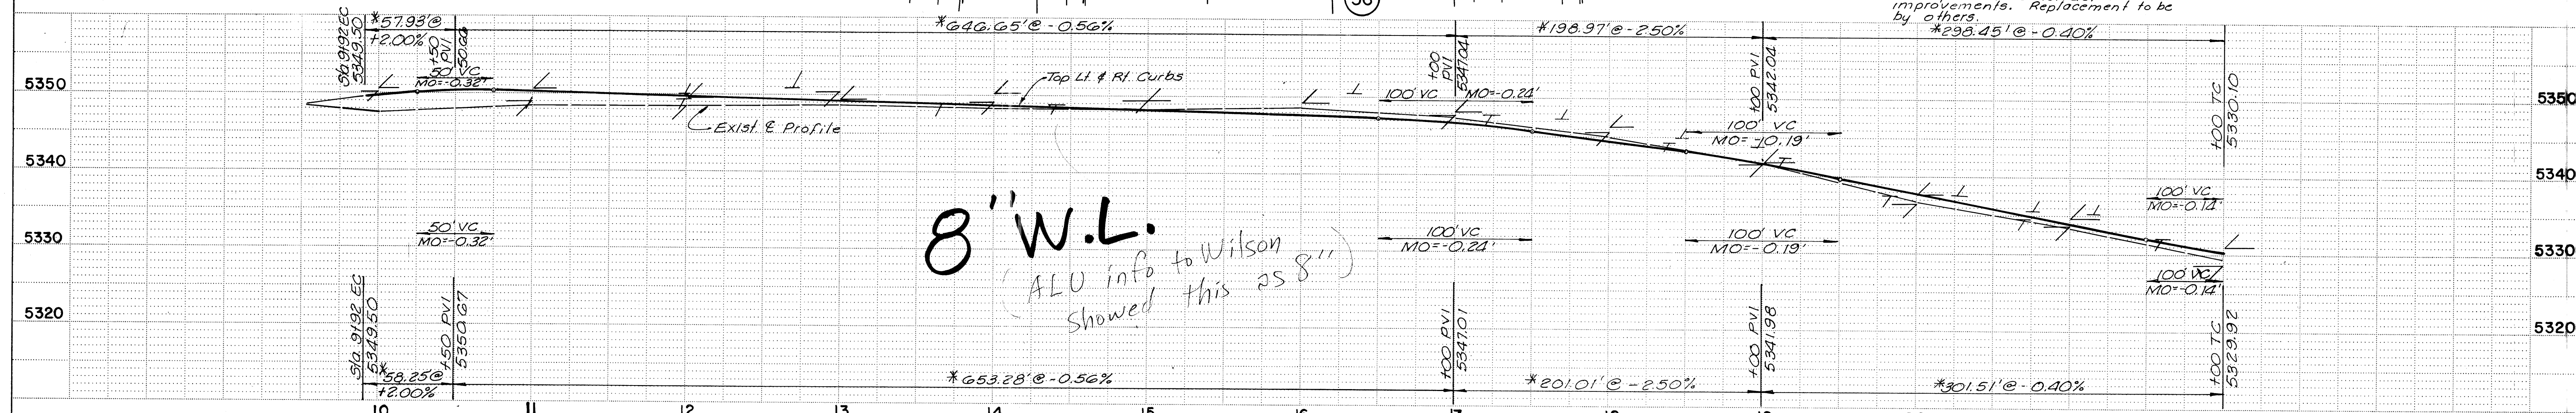

8" W.L.
 (ALU info to Wilson
 showed this as 8")

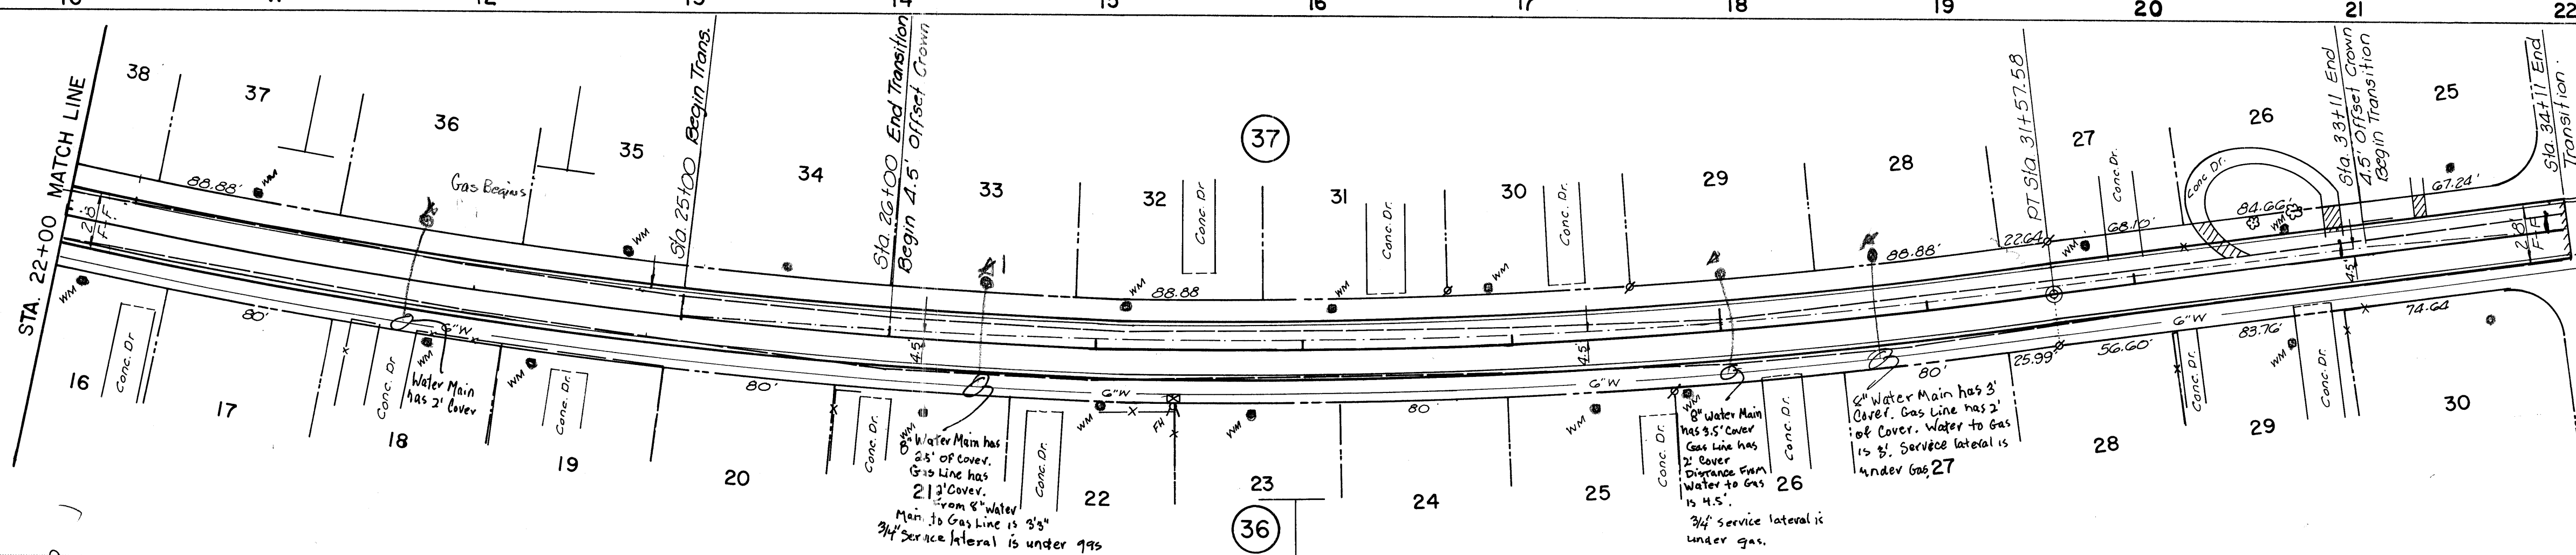

*NOTE
 1. Length of curb is measured along face of curb.
 2. All stations are E stations.

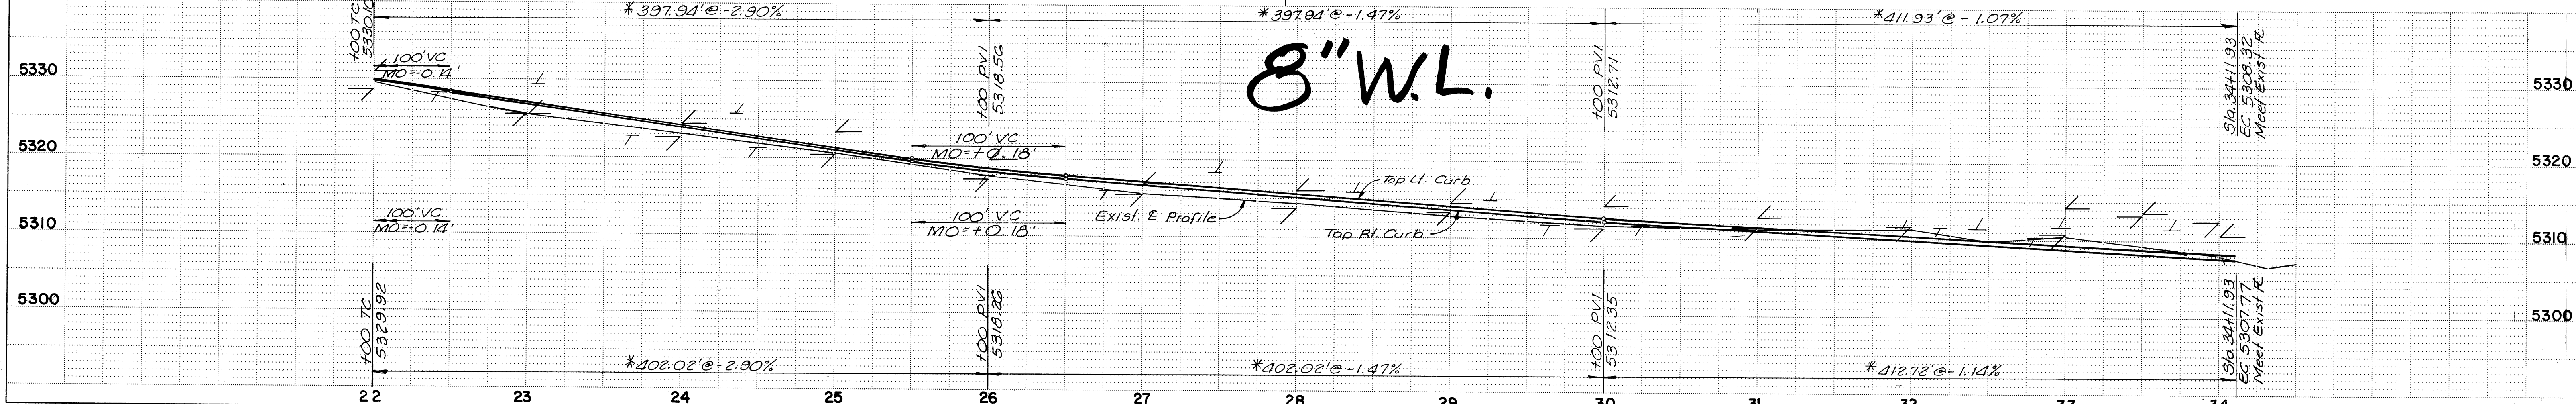

8" W.L.


SUE CIRCLE

86-507





WILSON & COMPANY
 ENGINEERS & ARCHITECTS
 ALBUQUERQUE, NEW MEX.

SHEET 7 OF 34 SHEETS

ASSFSCMNT DISTRICT - RIO RANCHO, NEW MEXICO

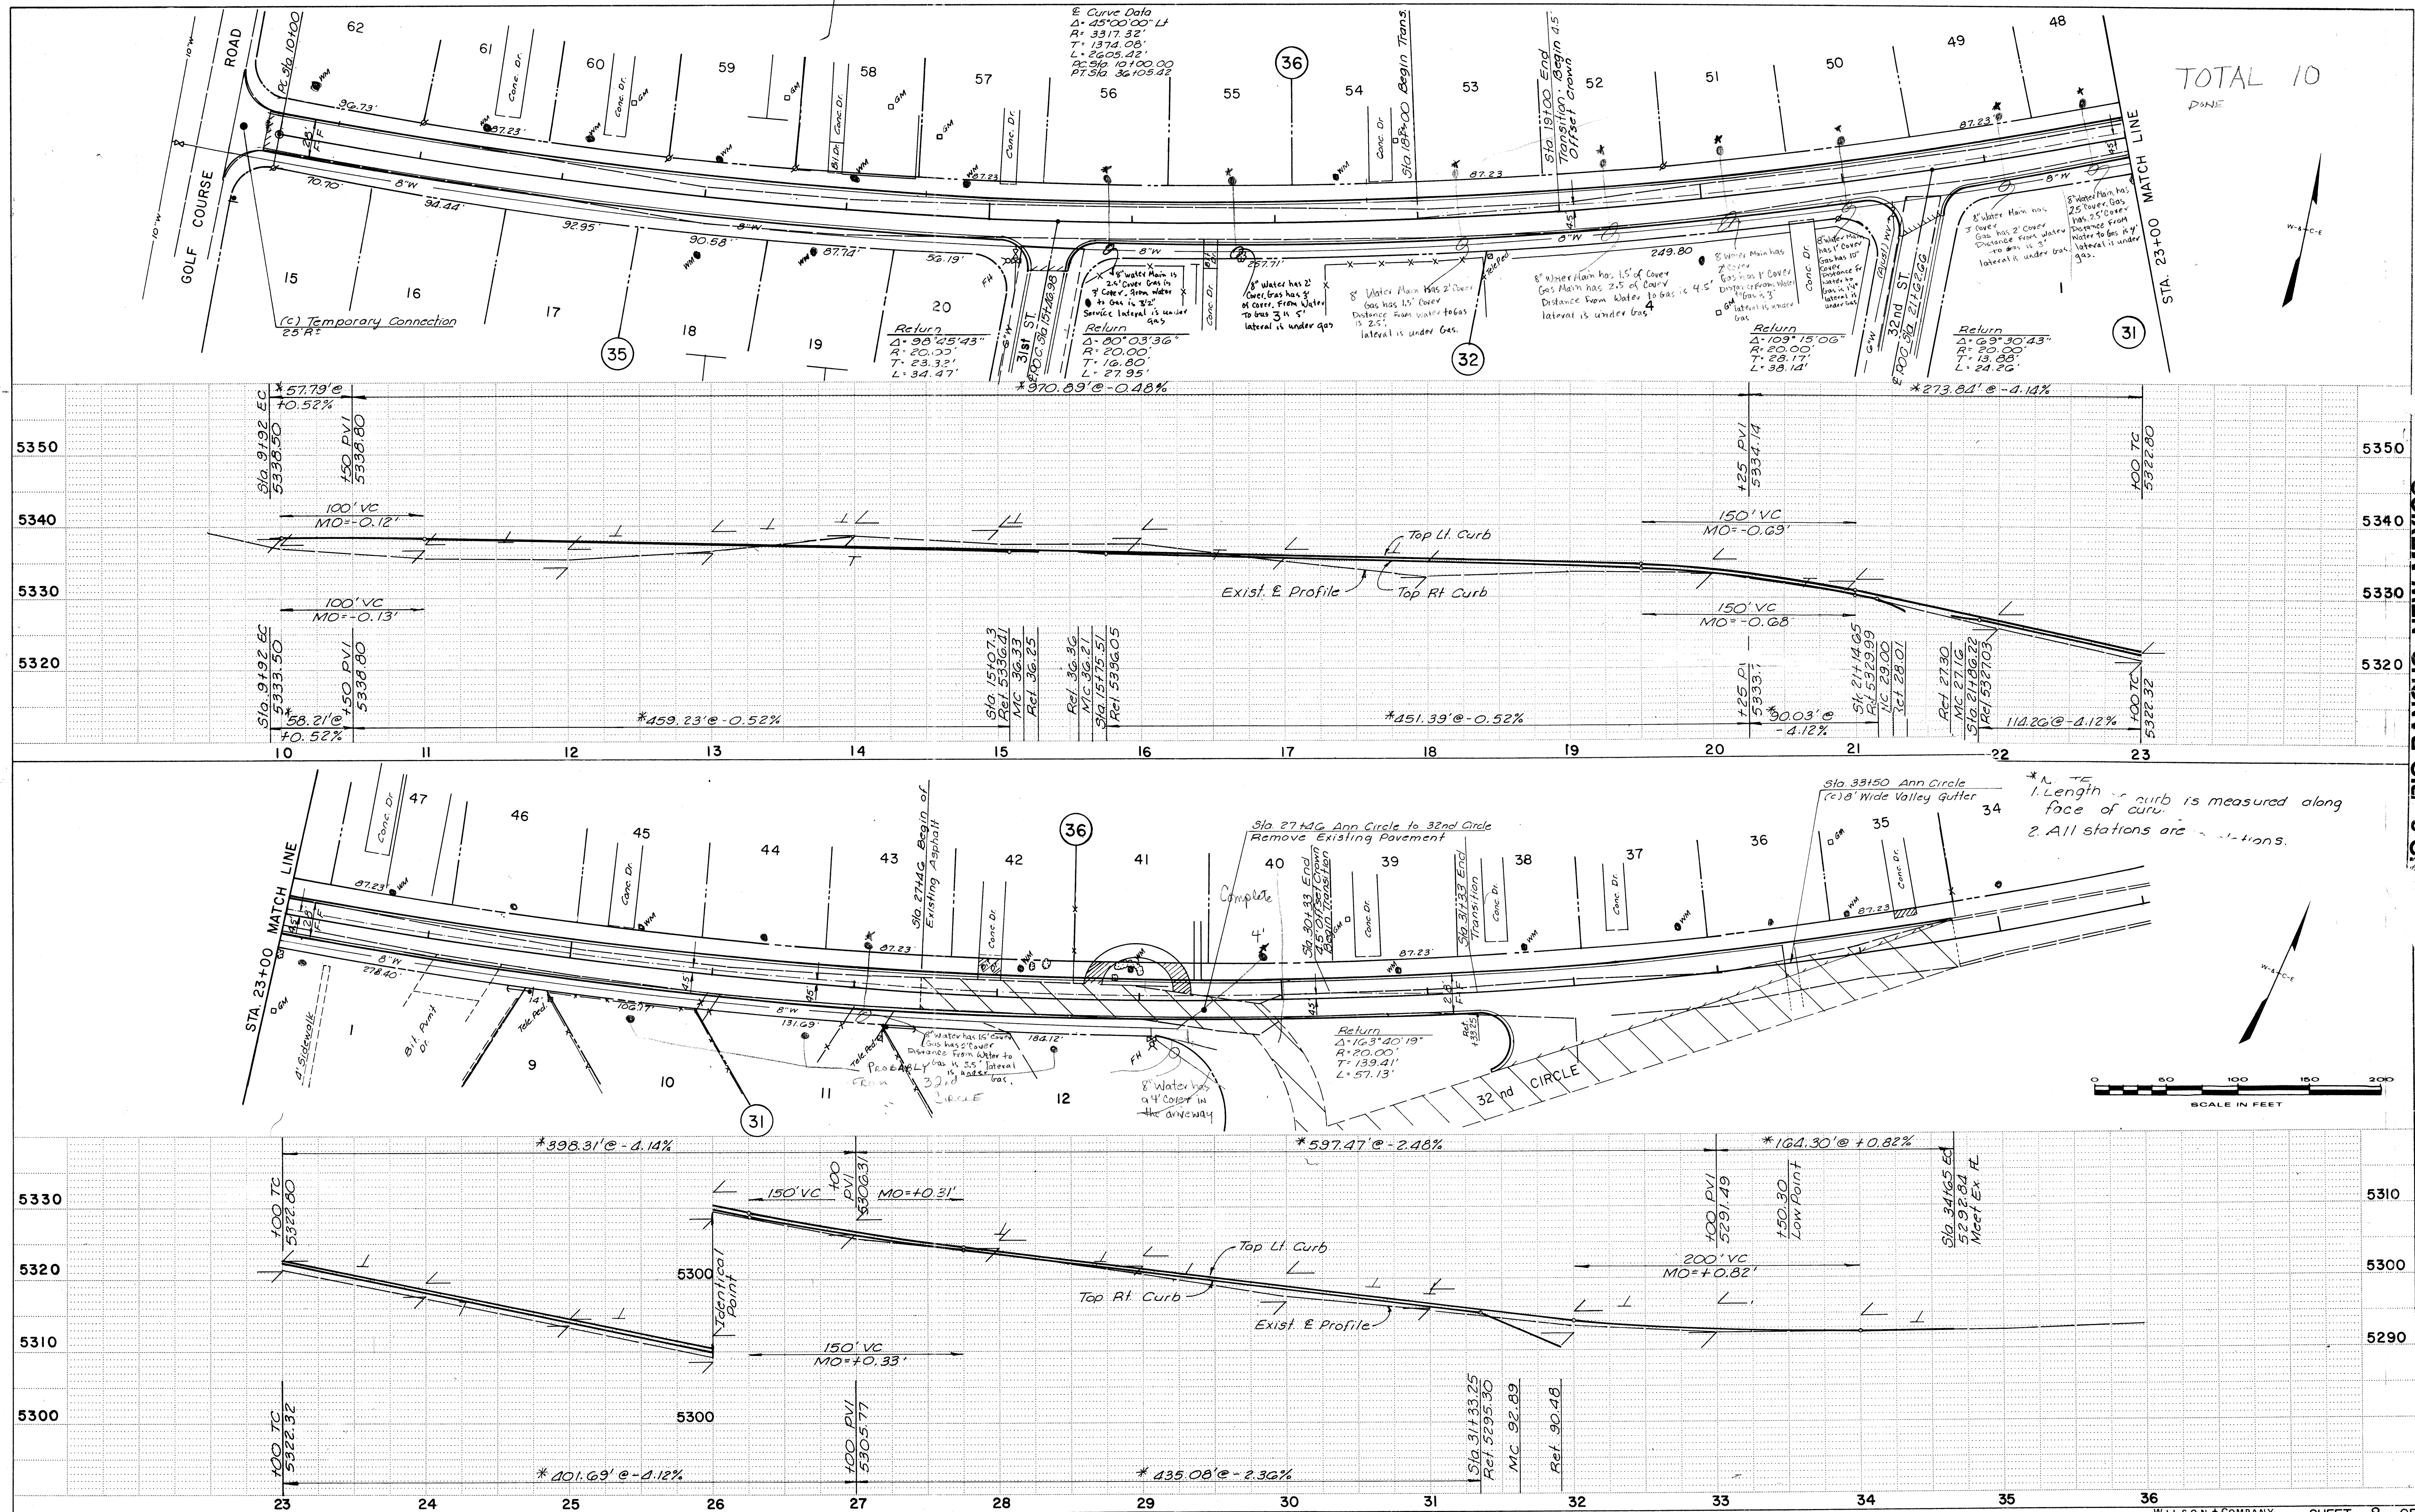

BENCHMARK ~ TBM 86-507-G
Elevation 5313.33 NE Corner
Golf Course Rd & 16th St. G.O.D. spike
in west side of power pole 1.5' above
ground. Marked as TBM#9

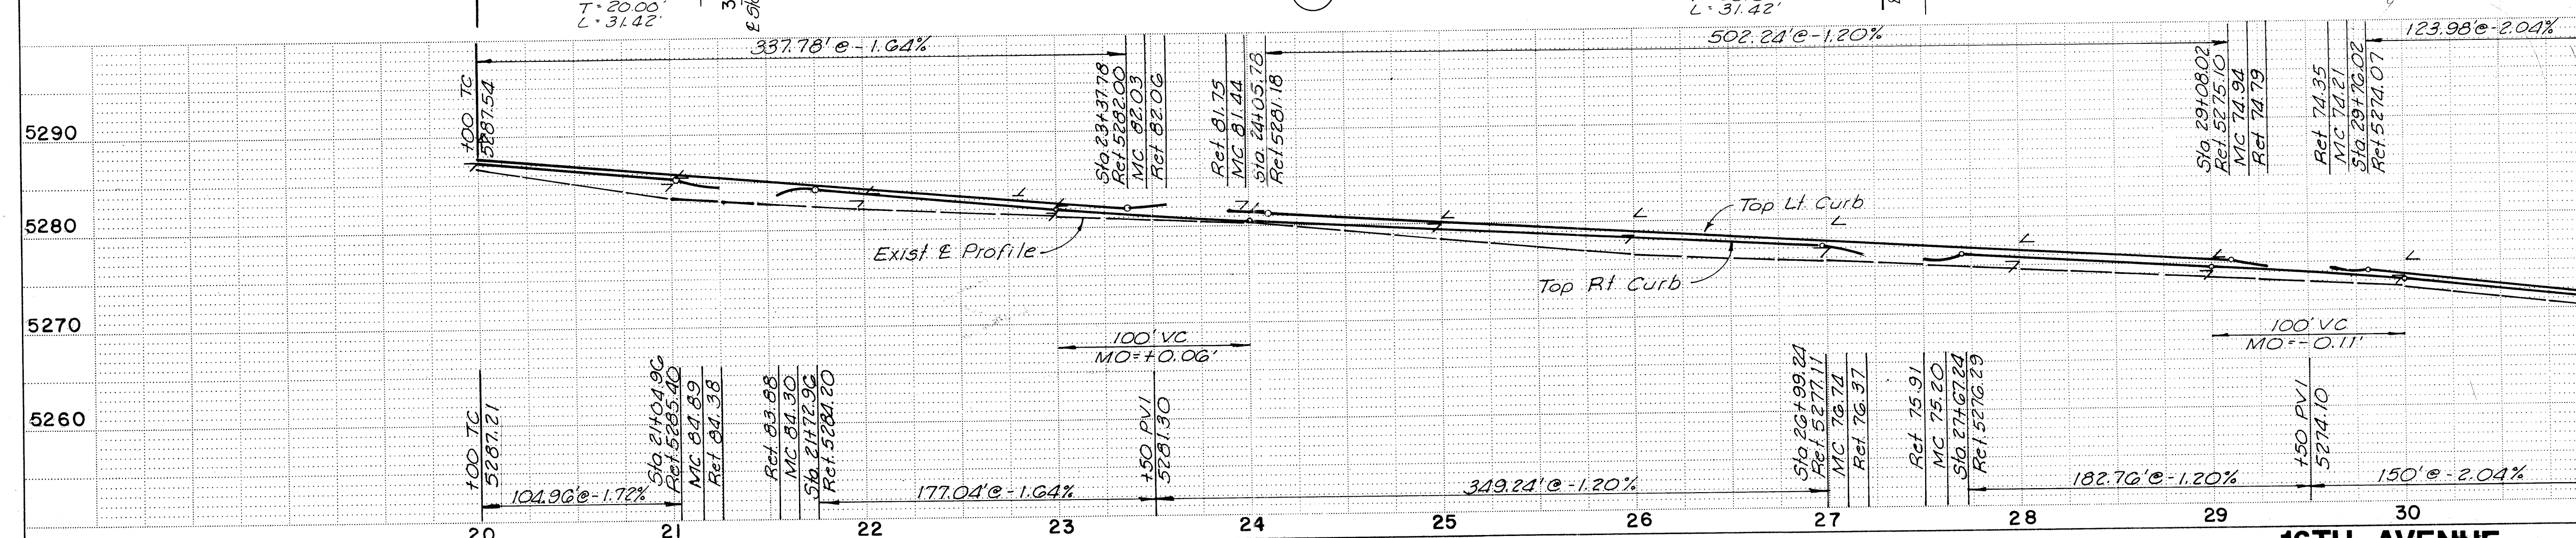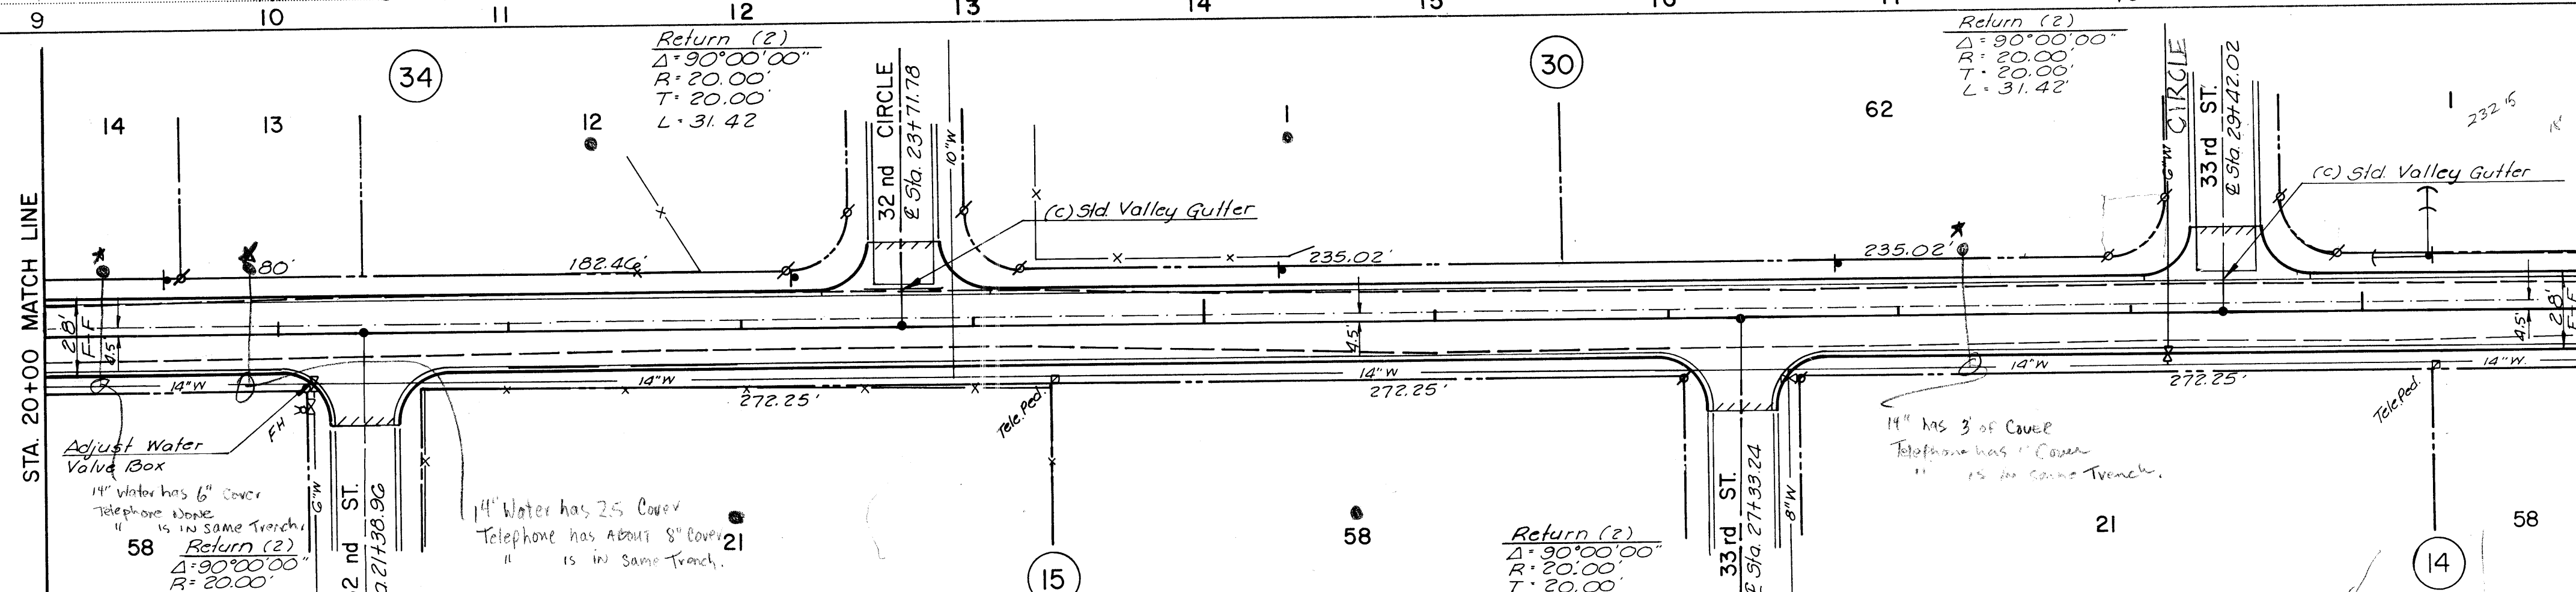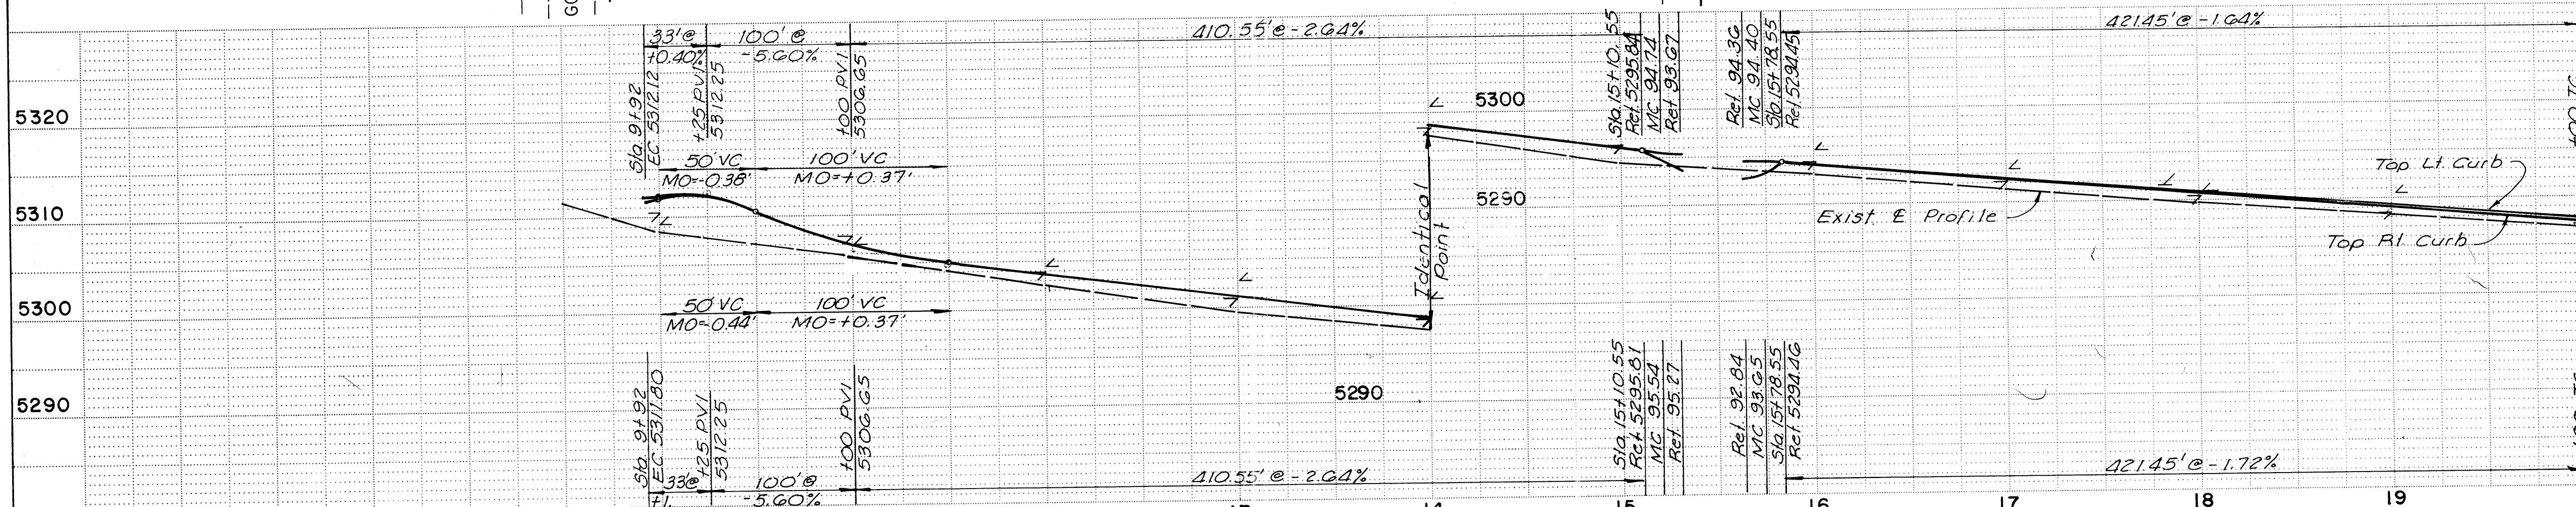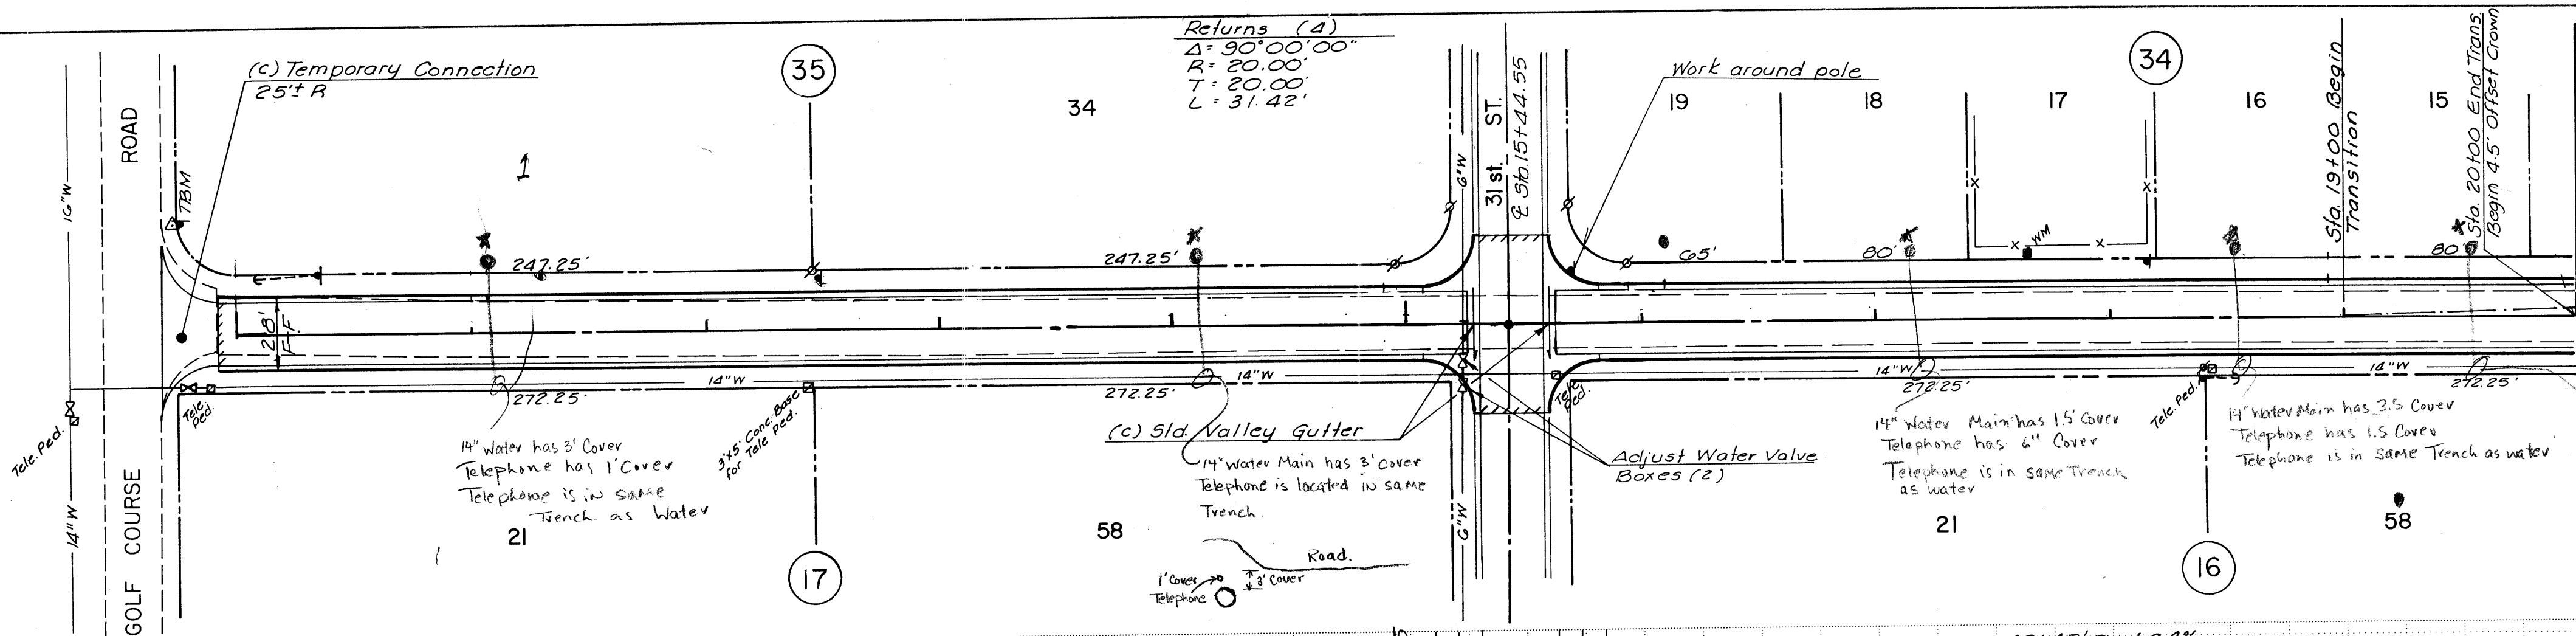

16TH. AVENUE

86-507

WILSON & COMPANY
ENGINEERS & ARCHITECTS
ALBUQUERQUE NEW MEXICO

SHEET 10 OF 34 SHEETS


ASSESSMENT DISTRICT NO. 3 RIO RANCHO, NEW

BENCHMARK
TBM-86-507-5, Elevation 5257.56'
S.E. Corner Golf Course Road & 19th
Street N.E. Cap Bolt of Fire Hydrant.


TOTAL 2







19TH. AVENUE

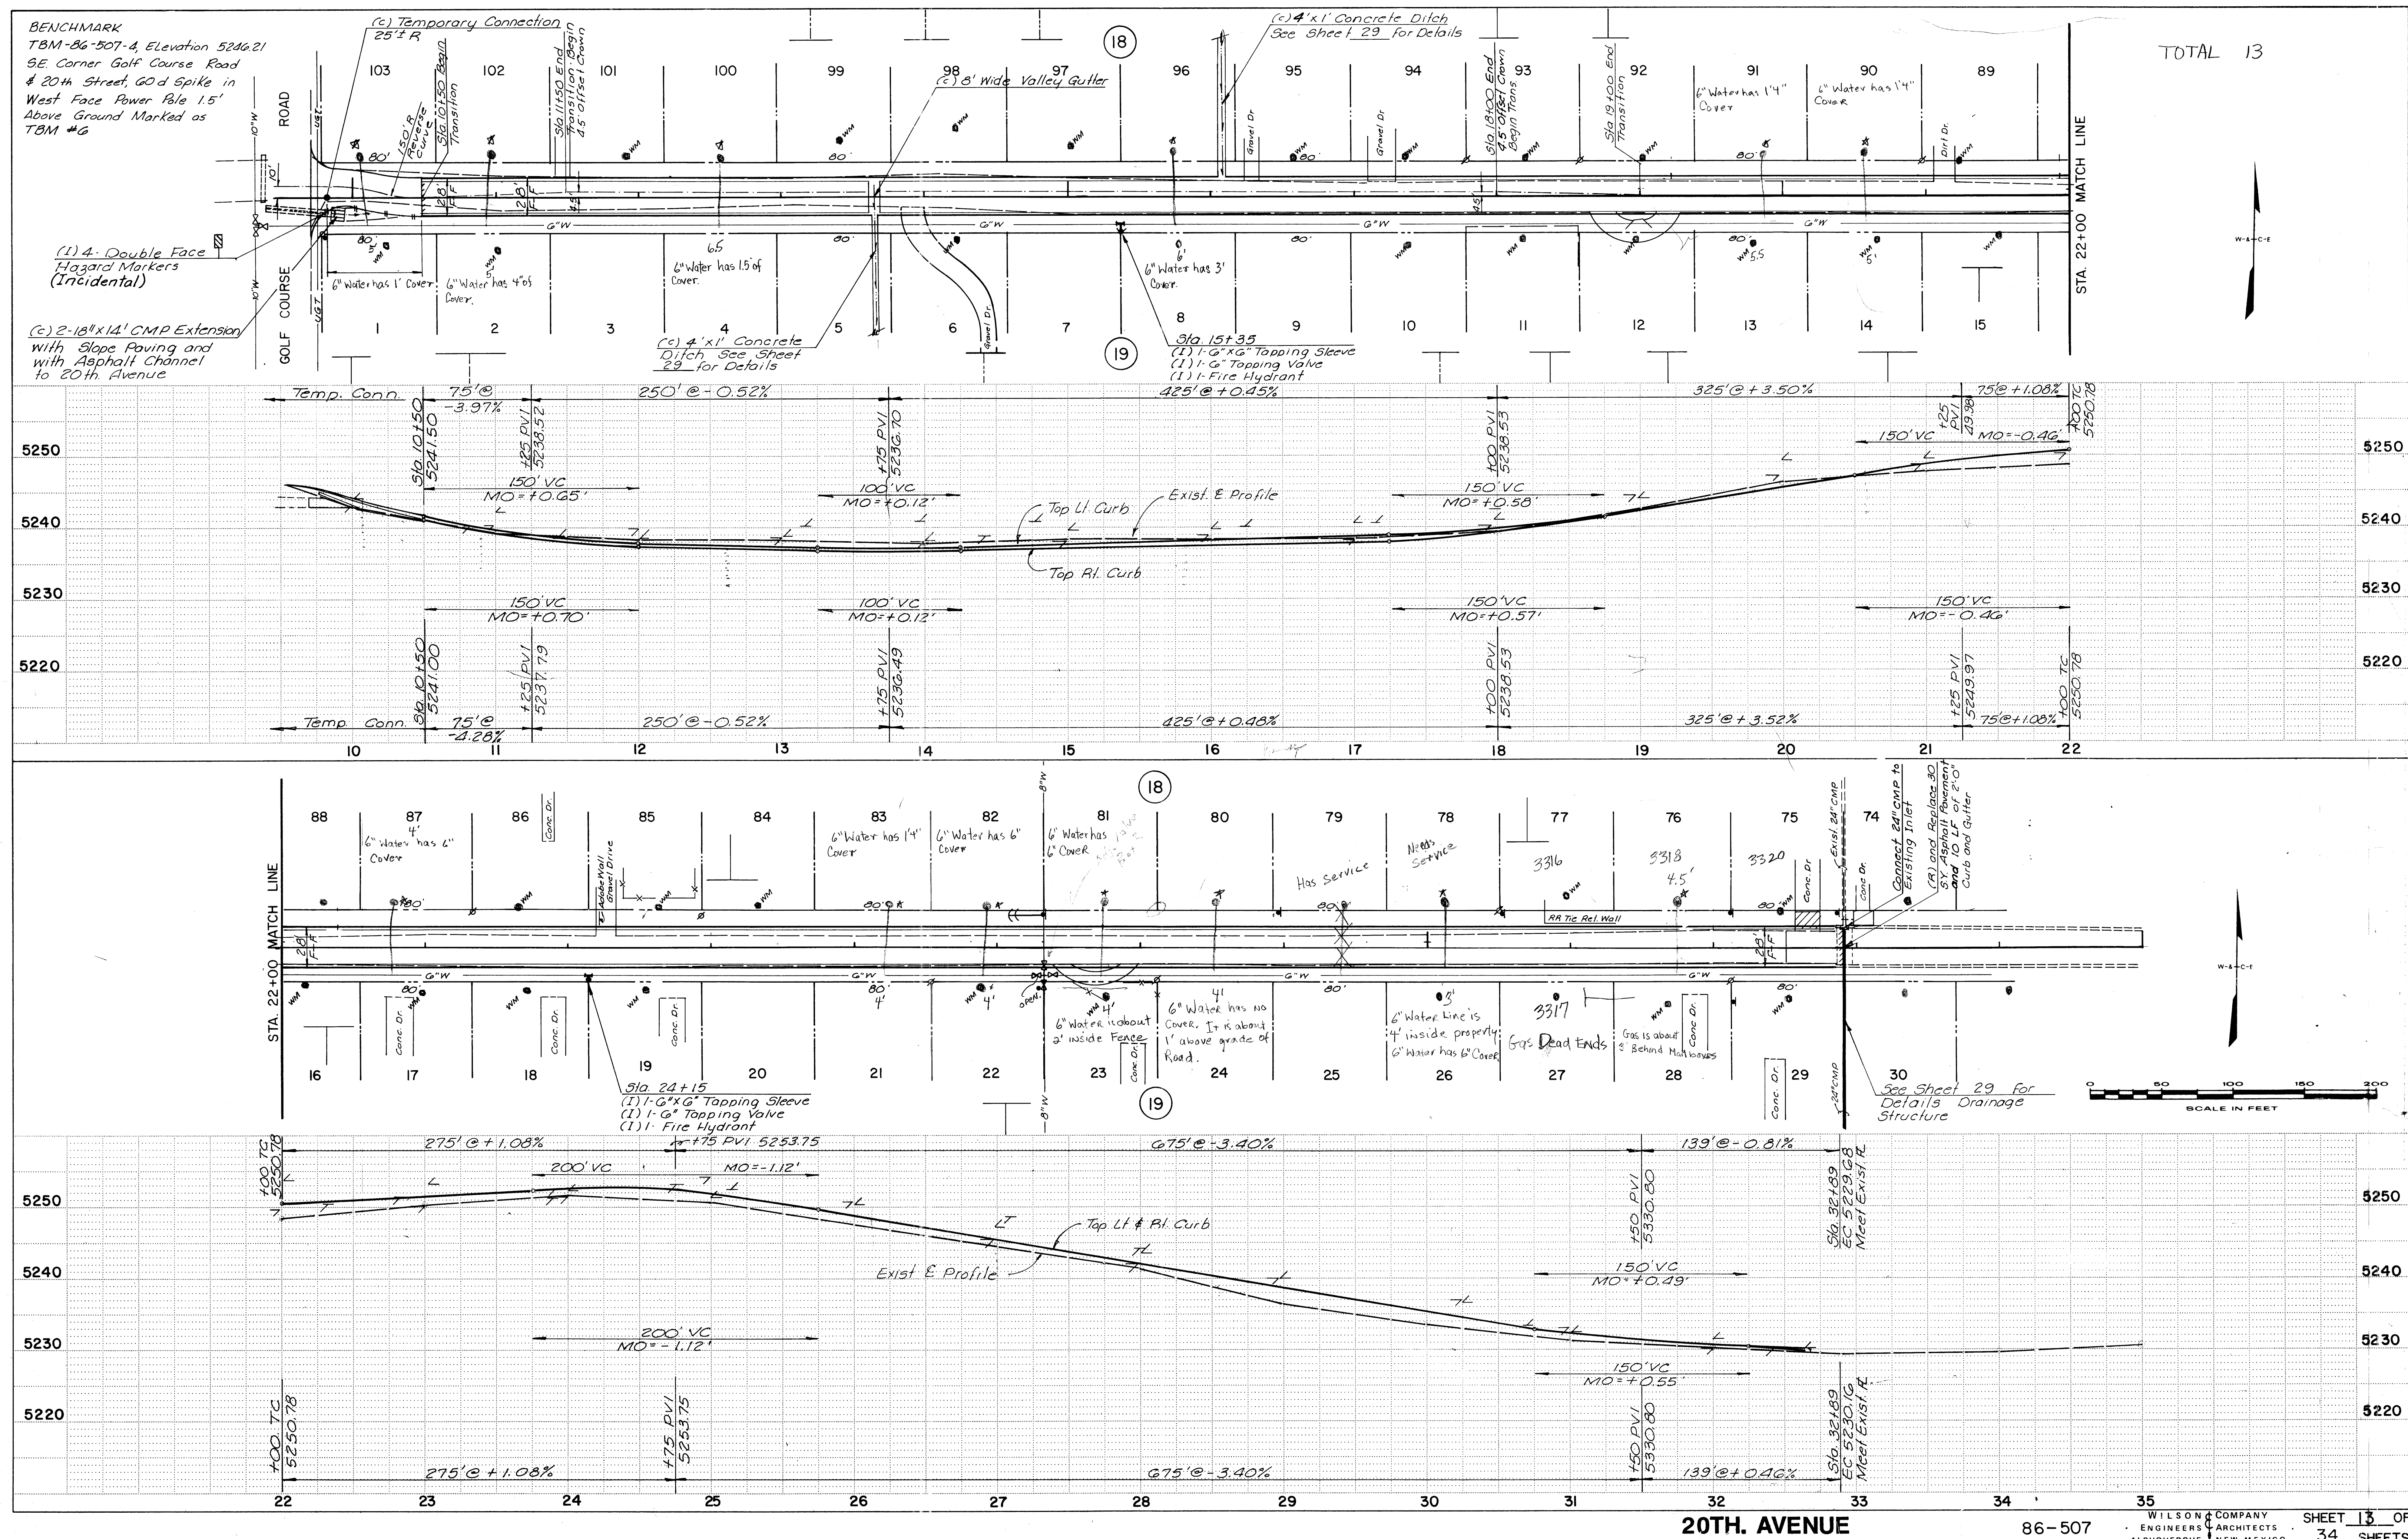


BENCHMARK
TBM-86-507-3,
Elevation 5244.47
N.E. Corner Golf
Course Road & 21st
Street 60' d Spike
in West Face Power
Pole 15' Above
Ground. Marked as
TBM #5

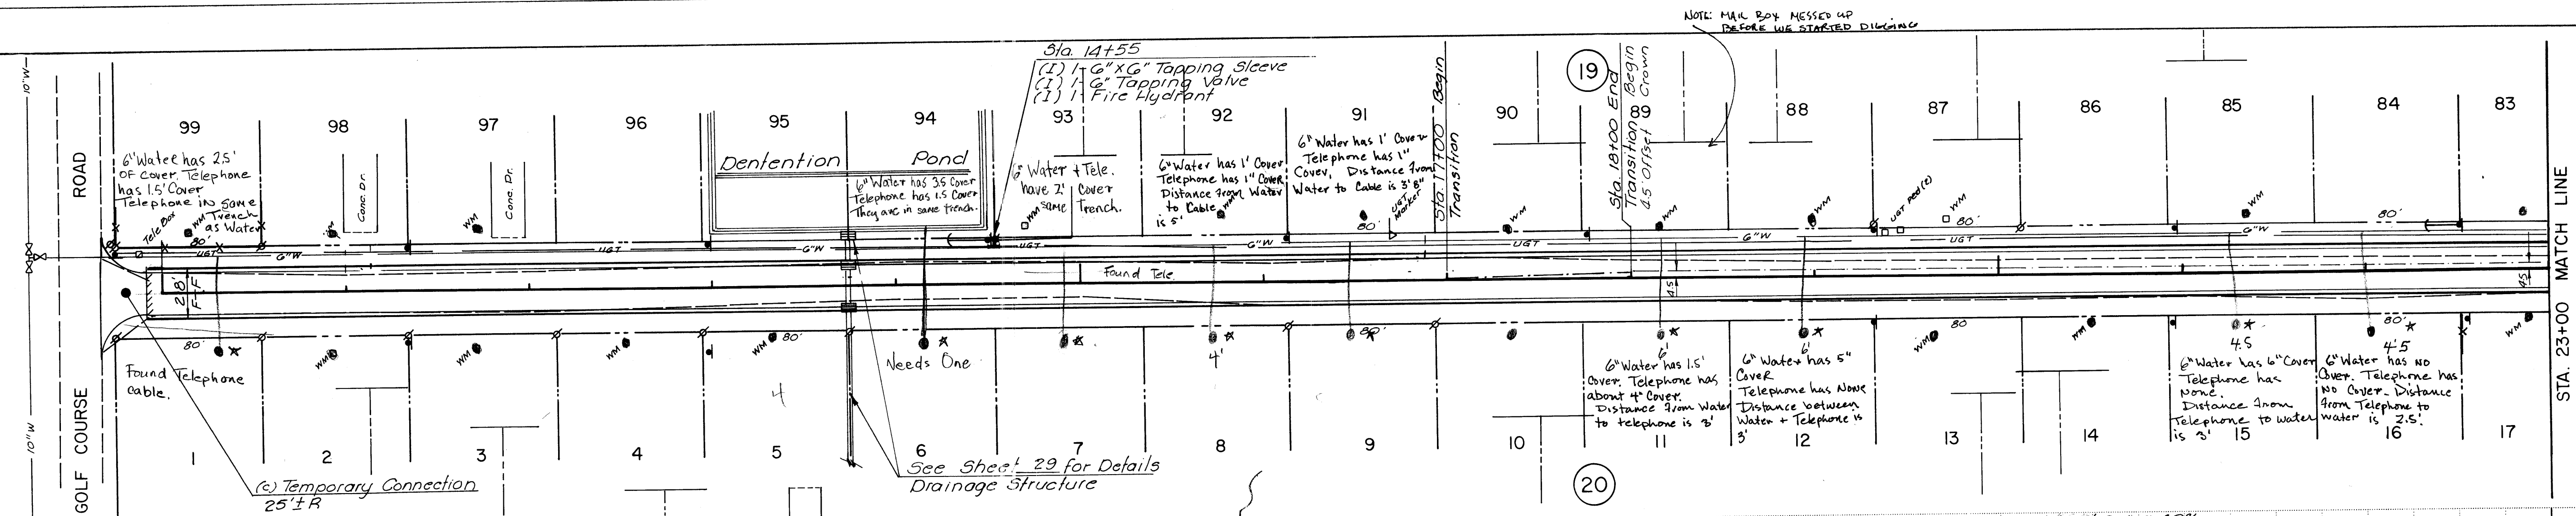





TOTAL 12

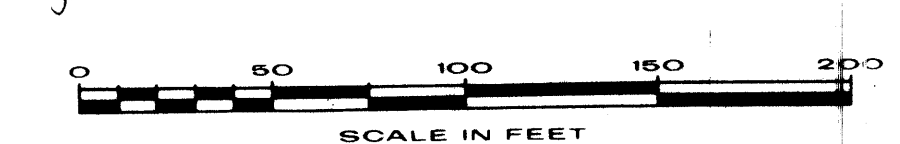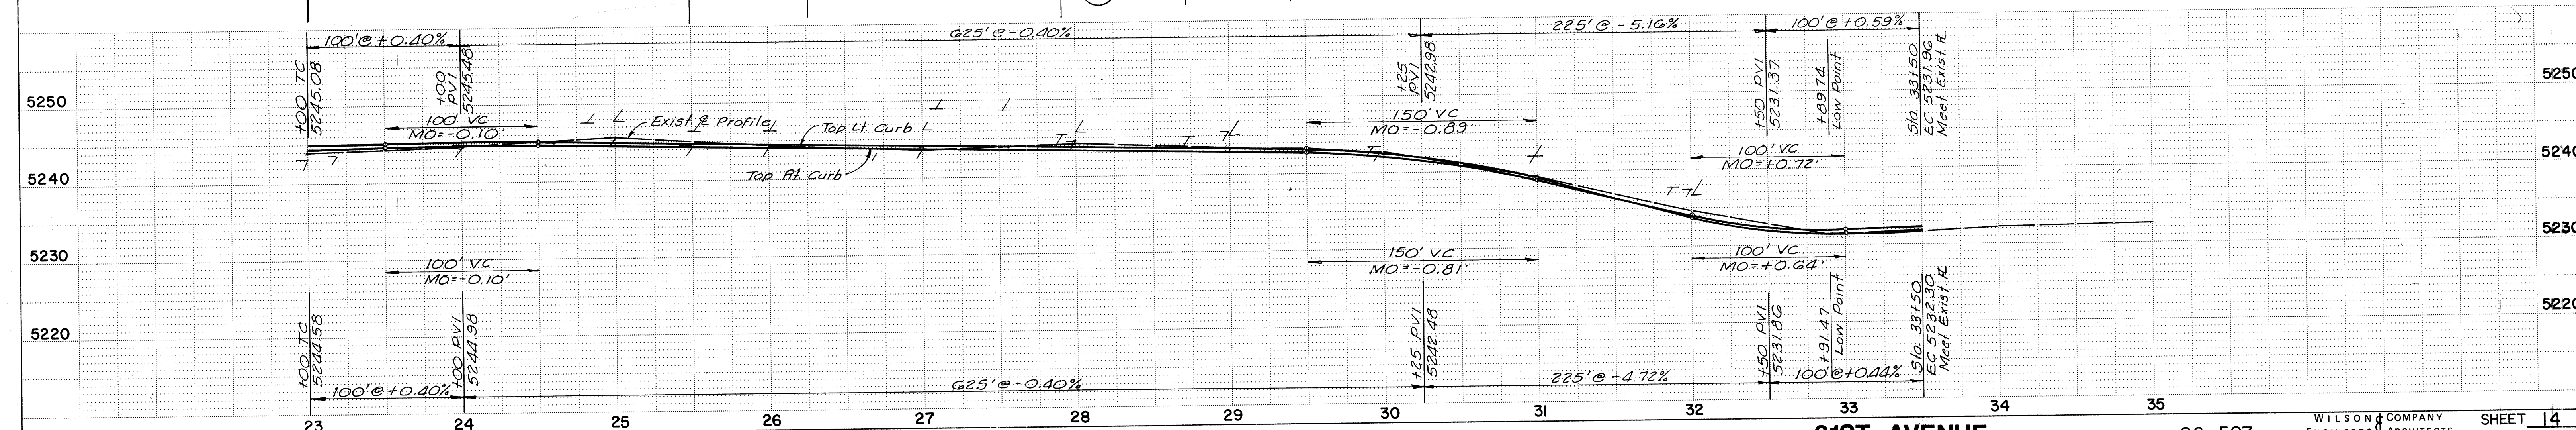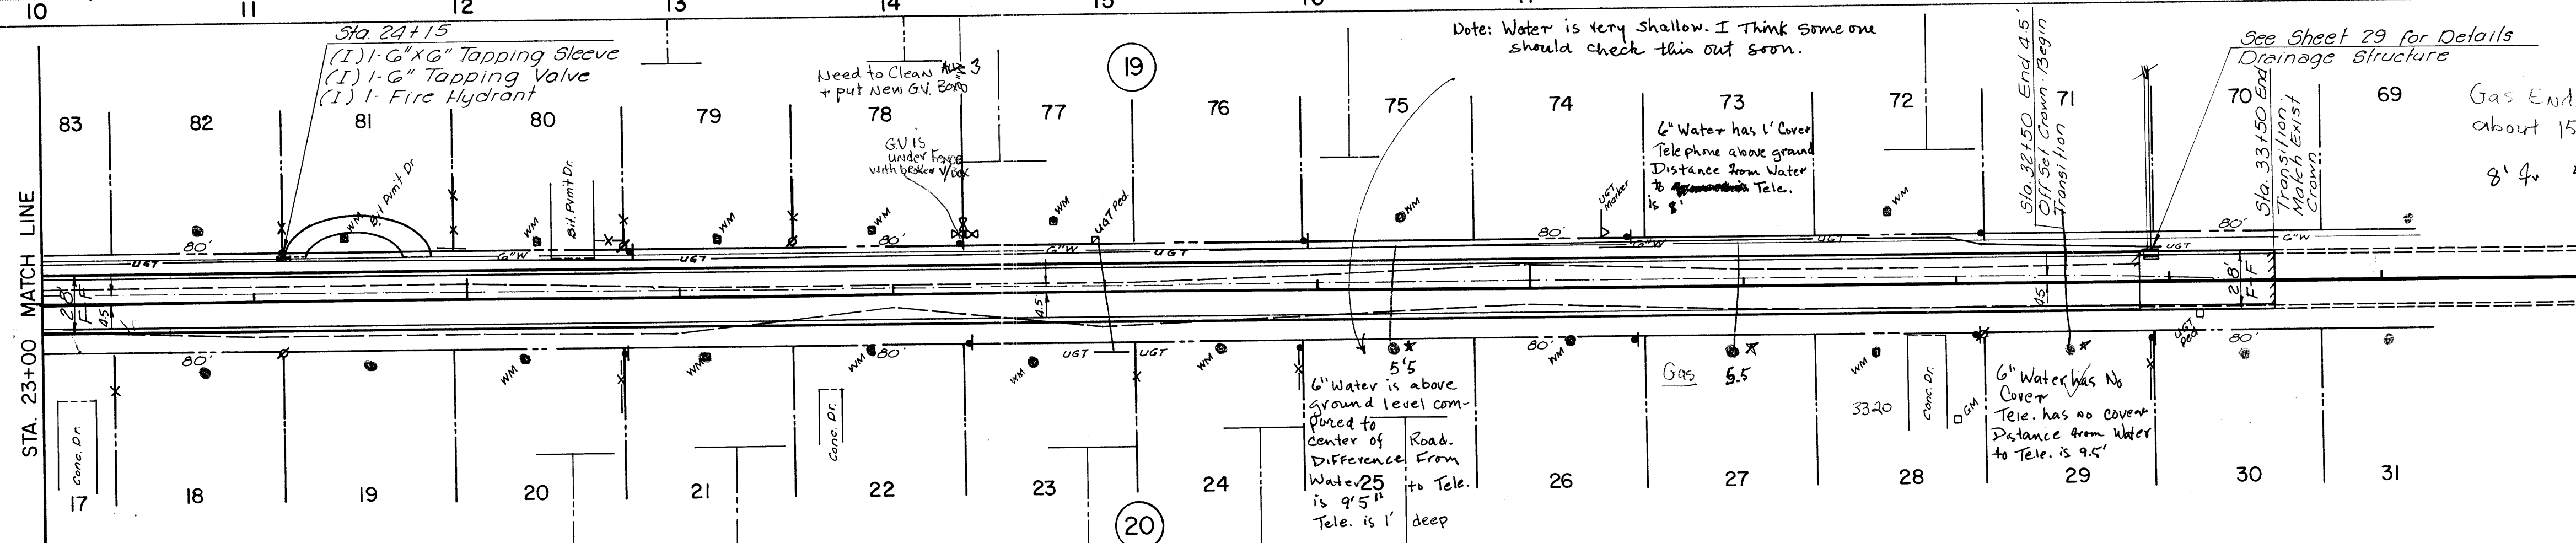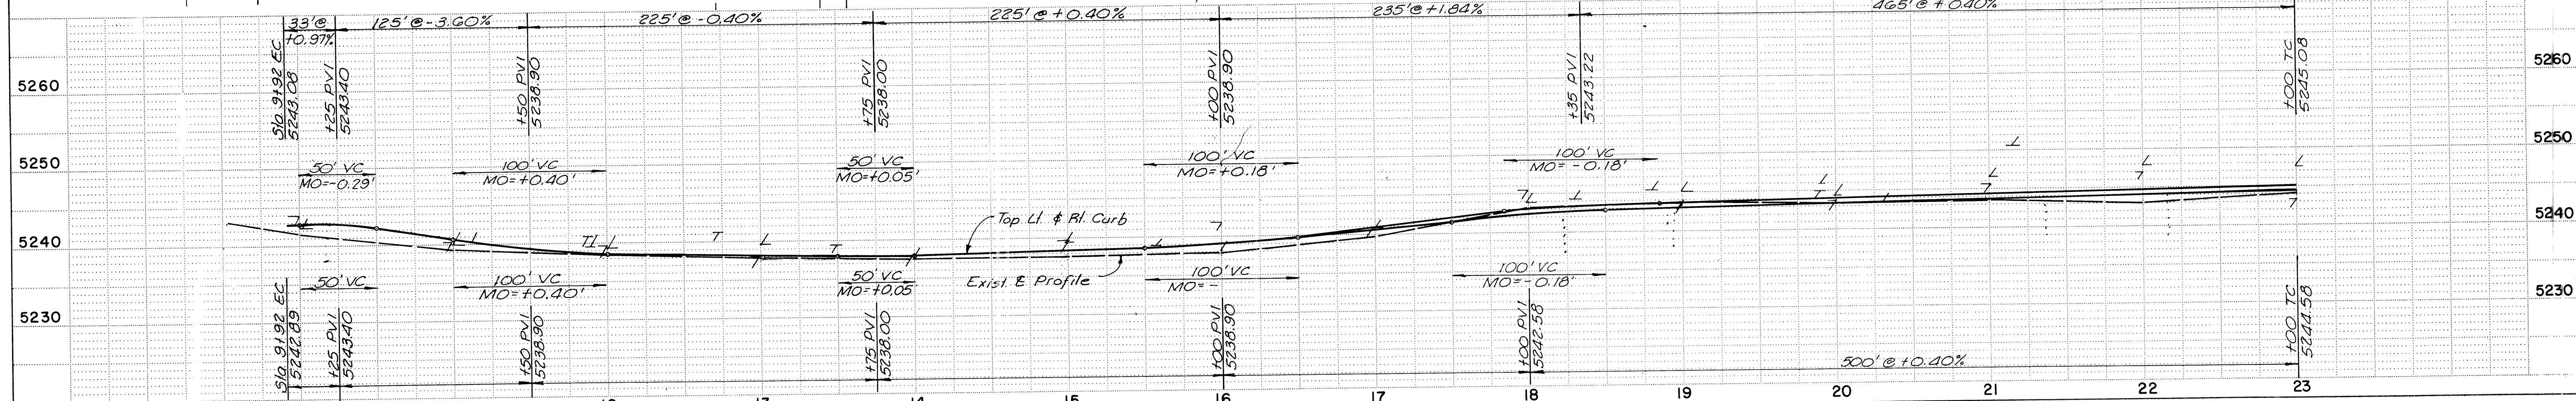

BENCHMARK
TBM 86-507-2, Elevation
5235.03 NE Corner Golf
Course Road & 22nd Street
60 d Spike in West Face of
Power Pole 1.5' Above Ground
Marked TBM #4

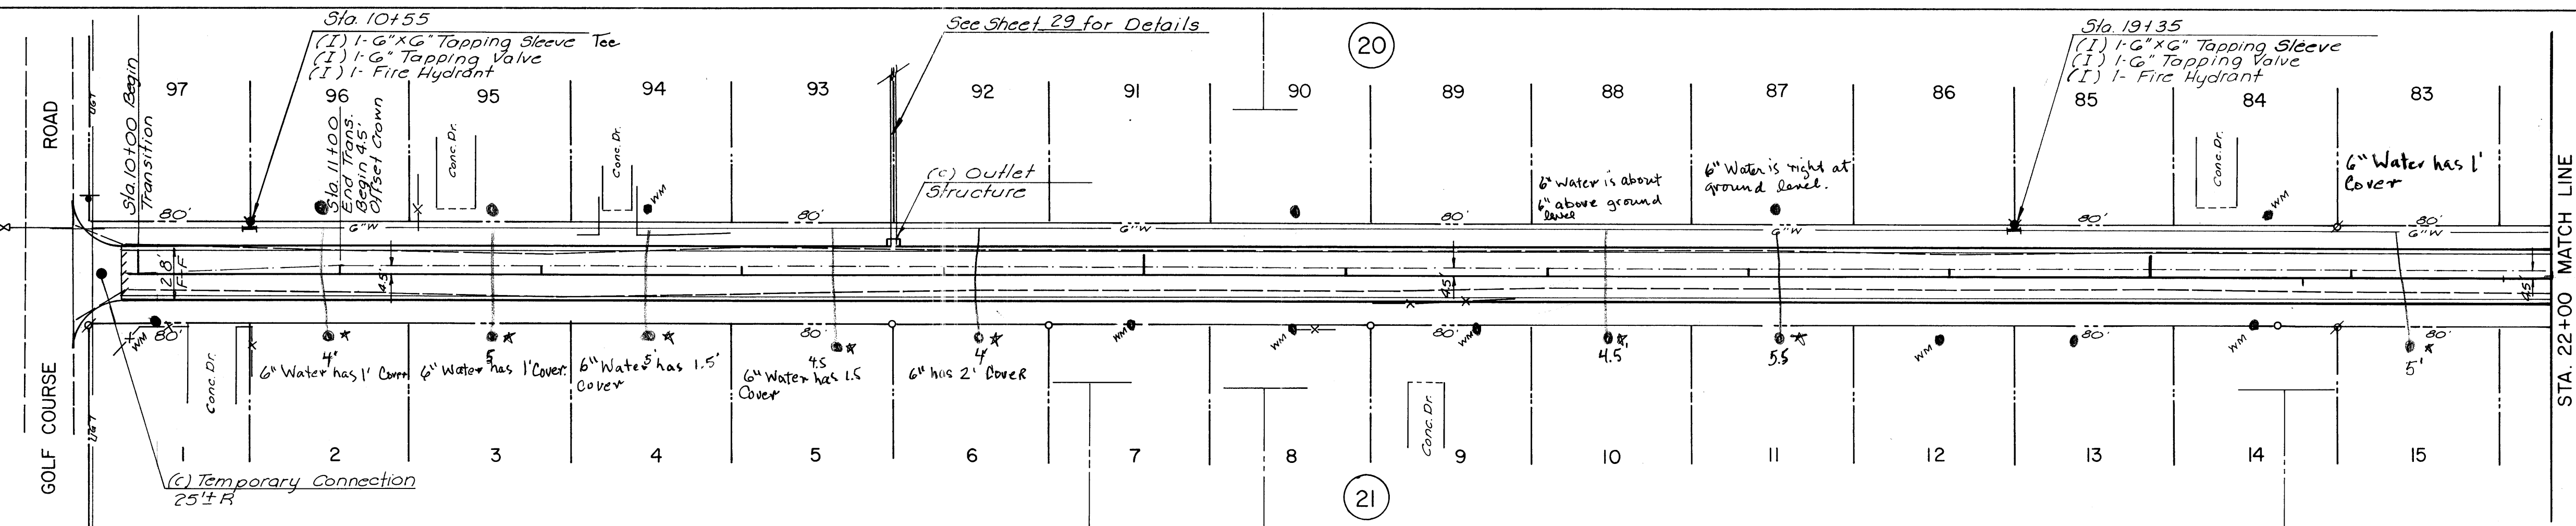

TOTAL 10

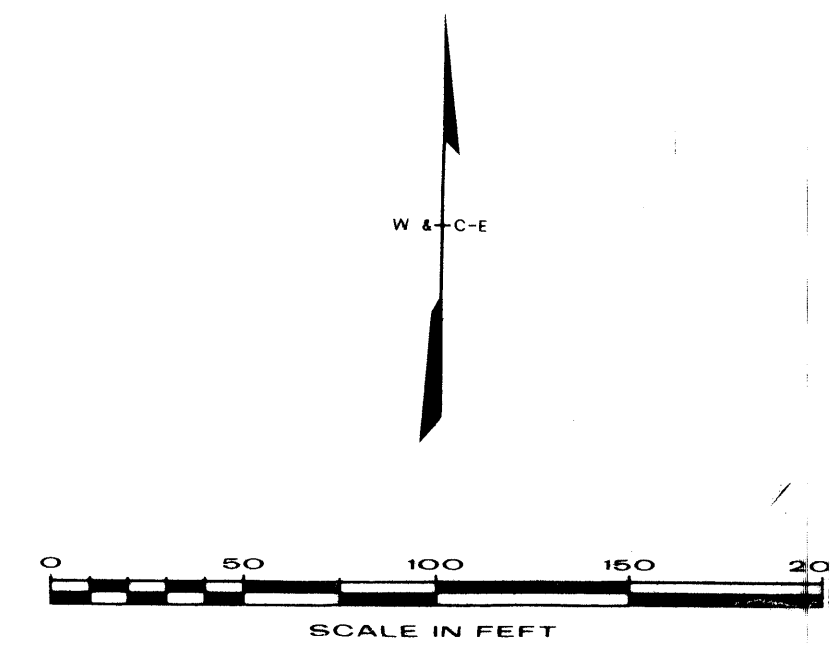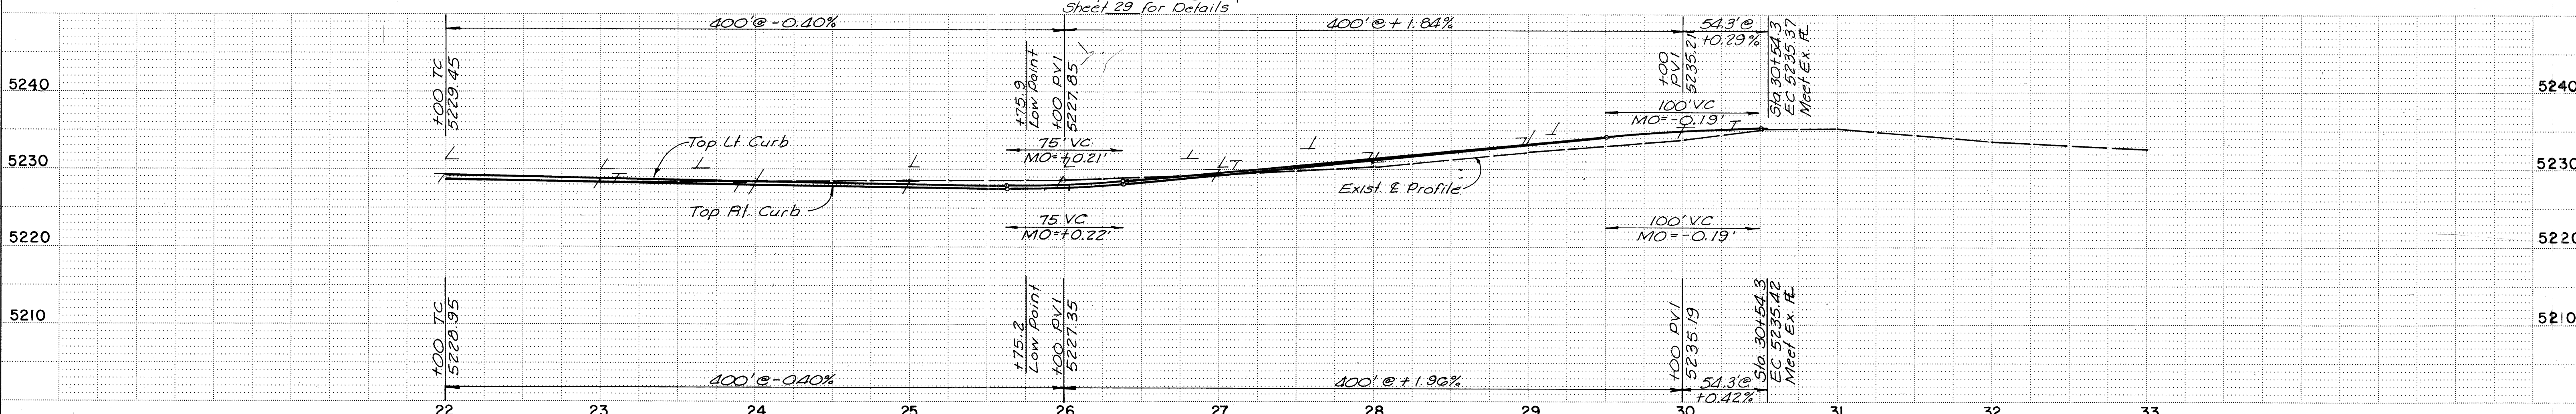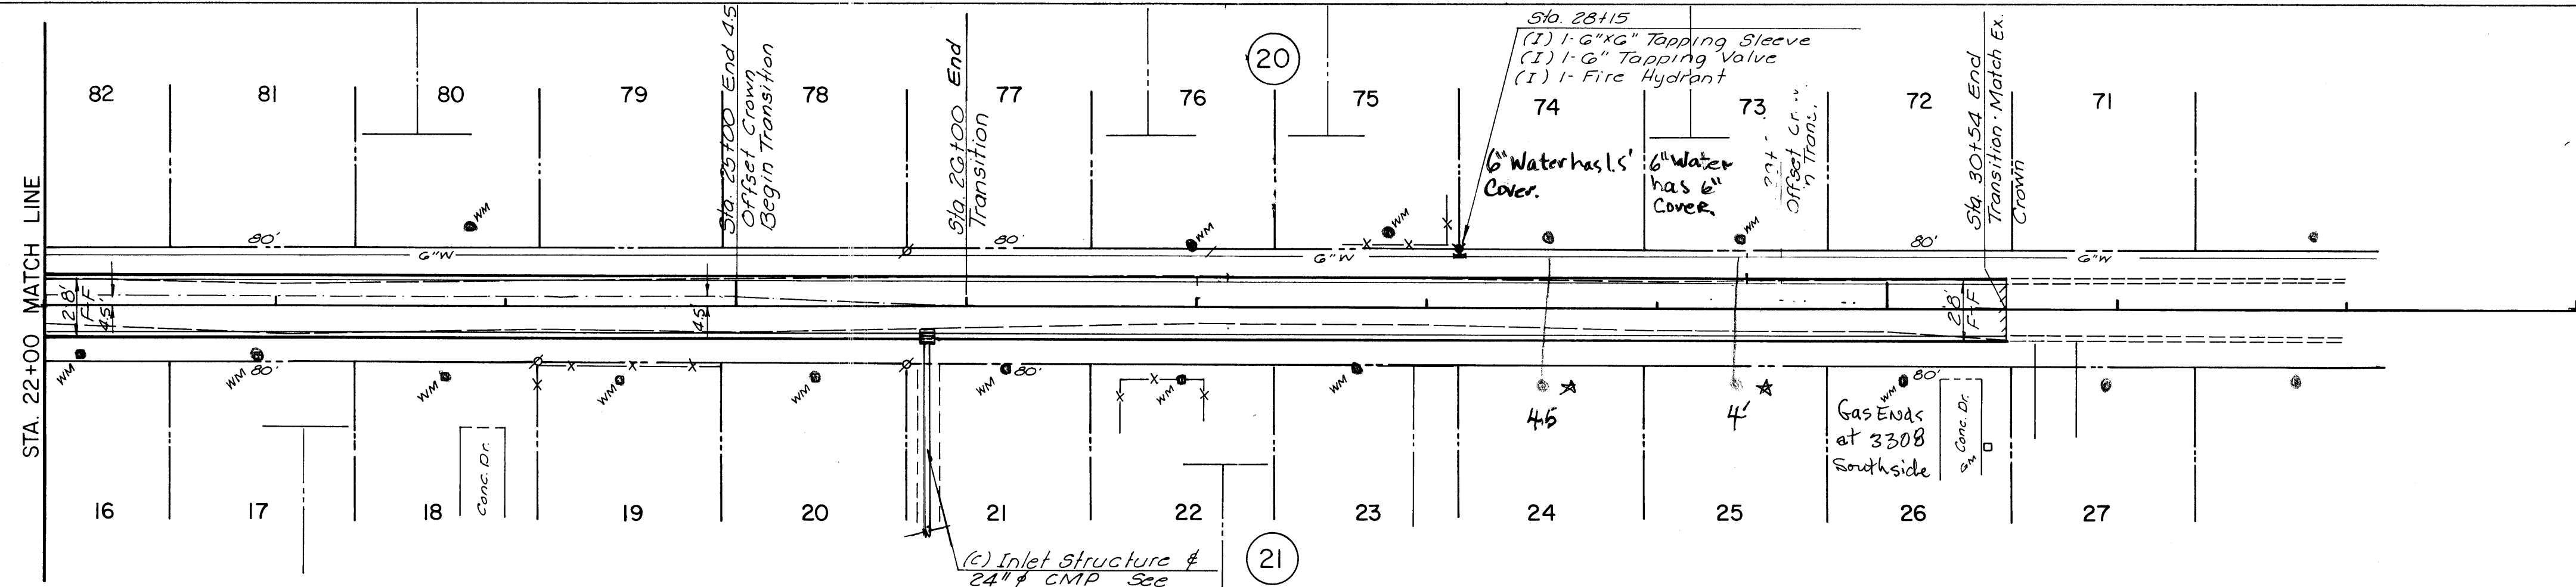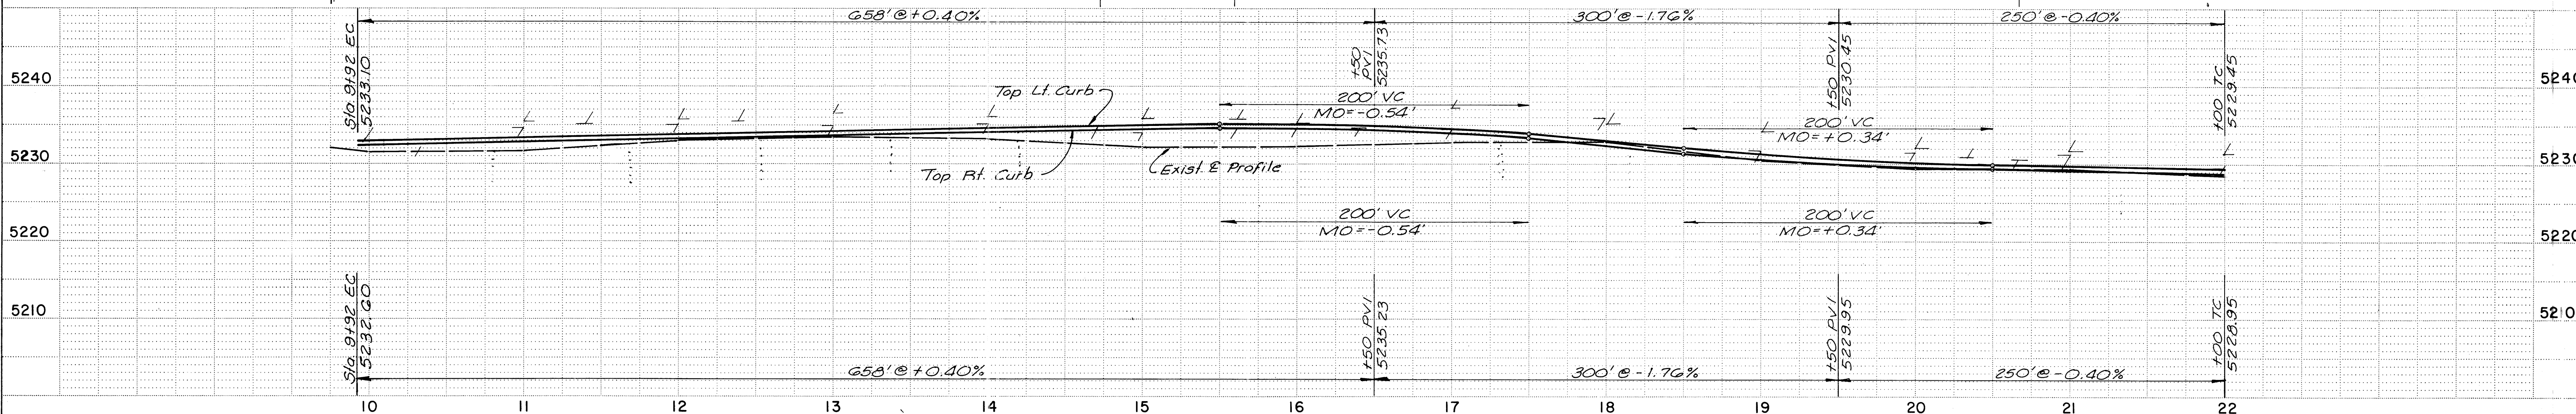

22ND. AVENUE


86-507

WILSON & COMPANY
ENGINEERS & ARCHITECTS
ALBUQUERQUE, NEW MEXICO


SHEET 15 OF 34 SHEETS

1 install c

2 installed

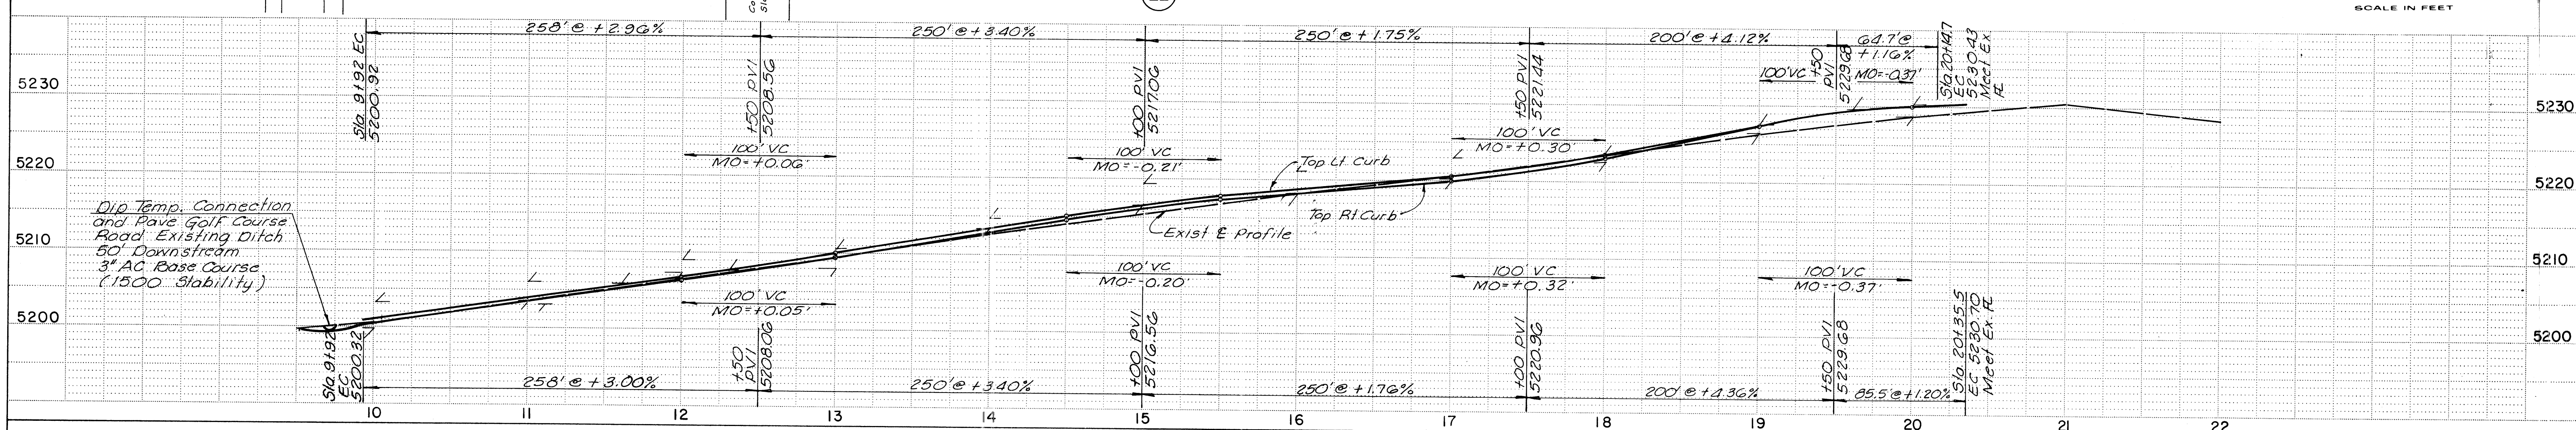

34

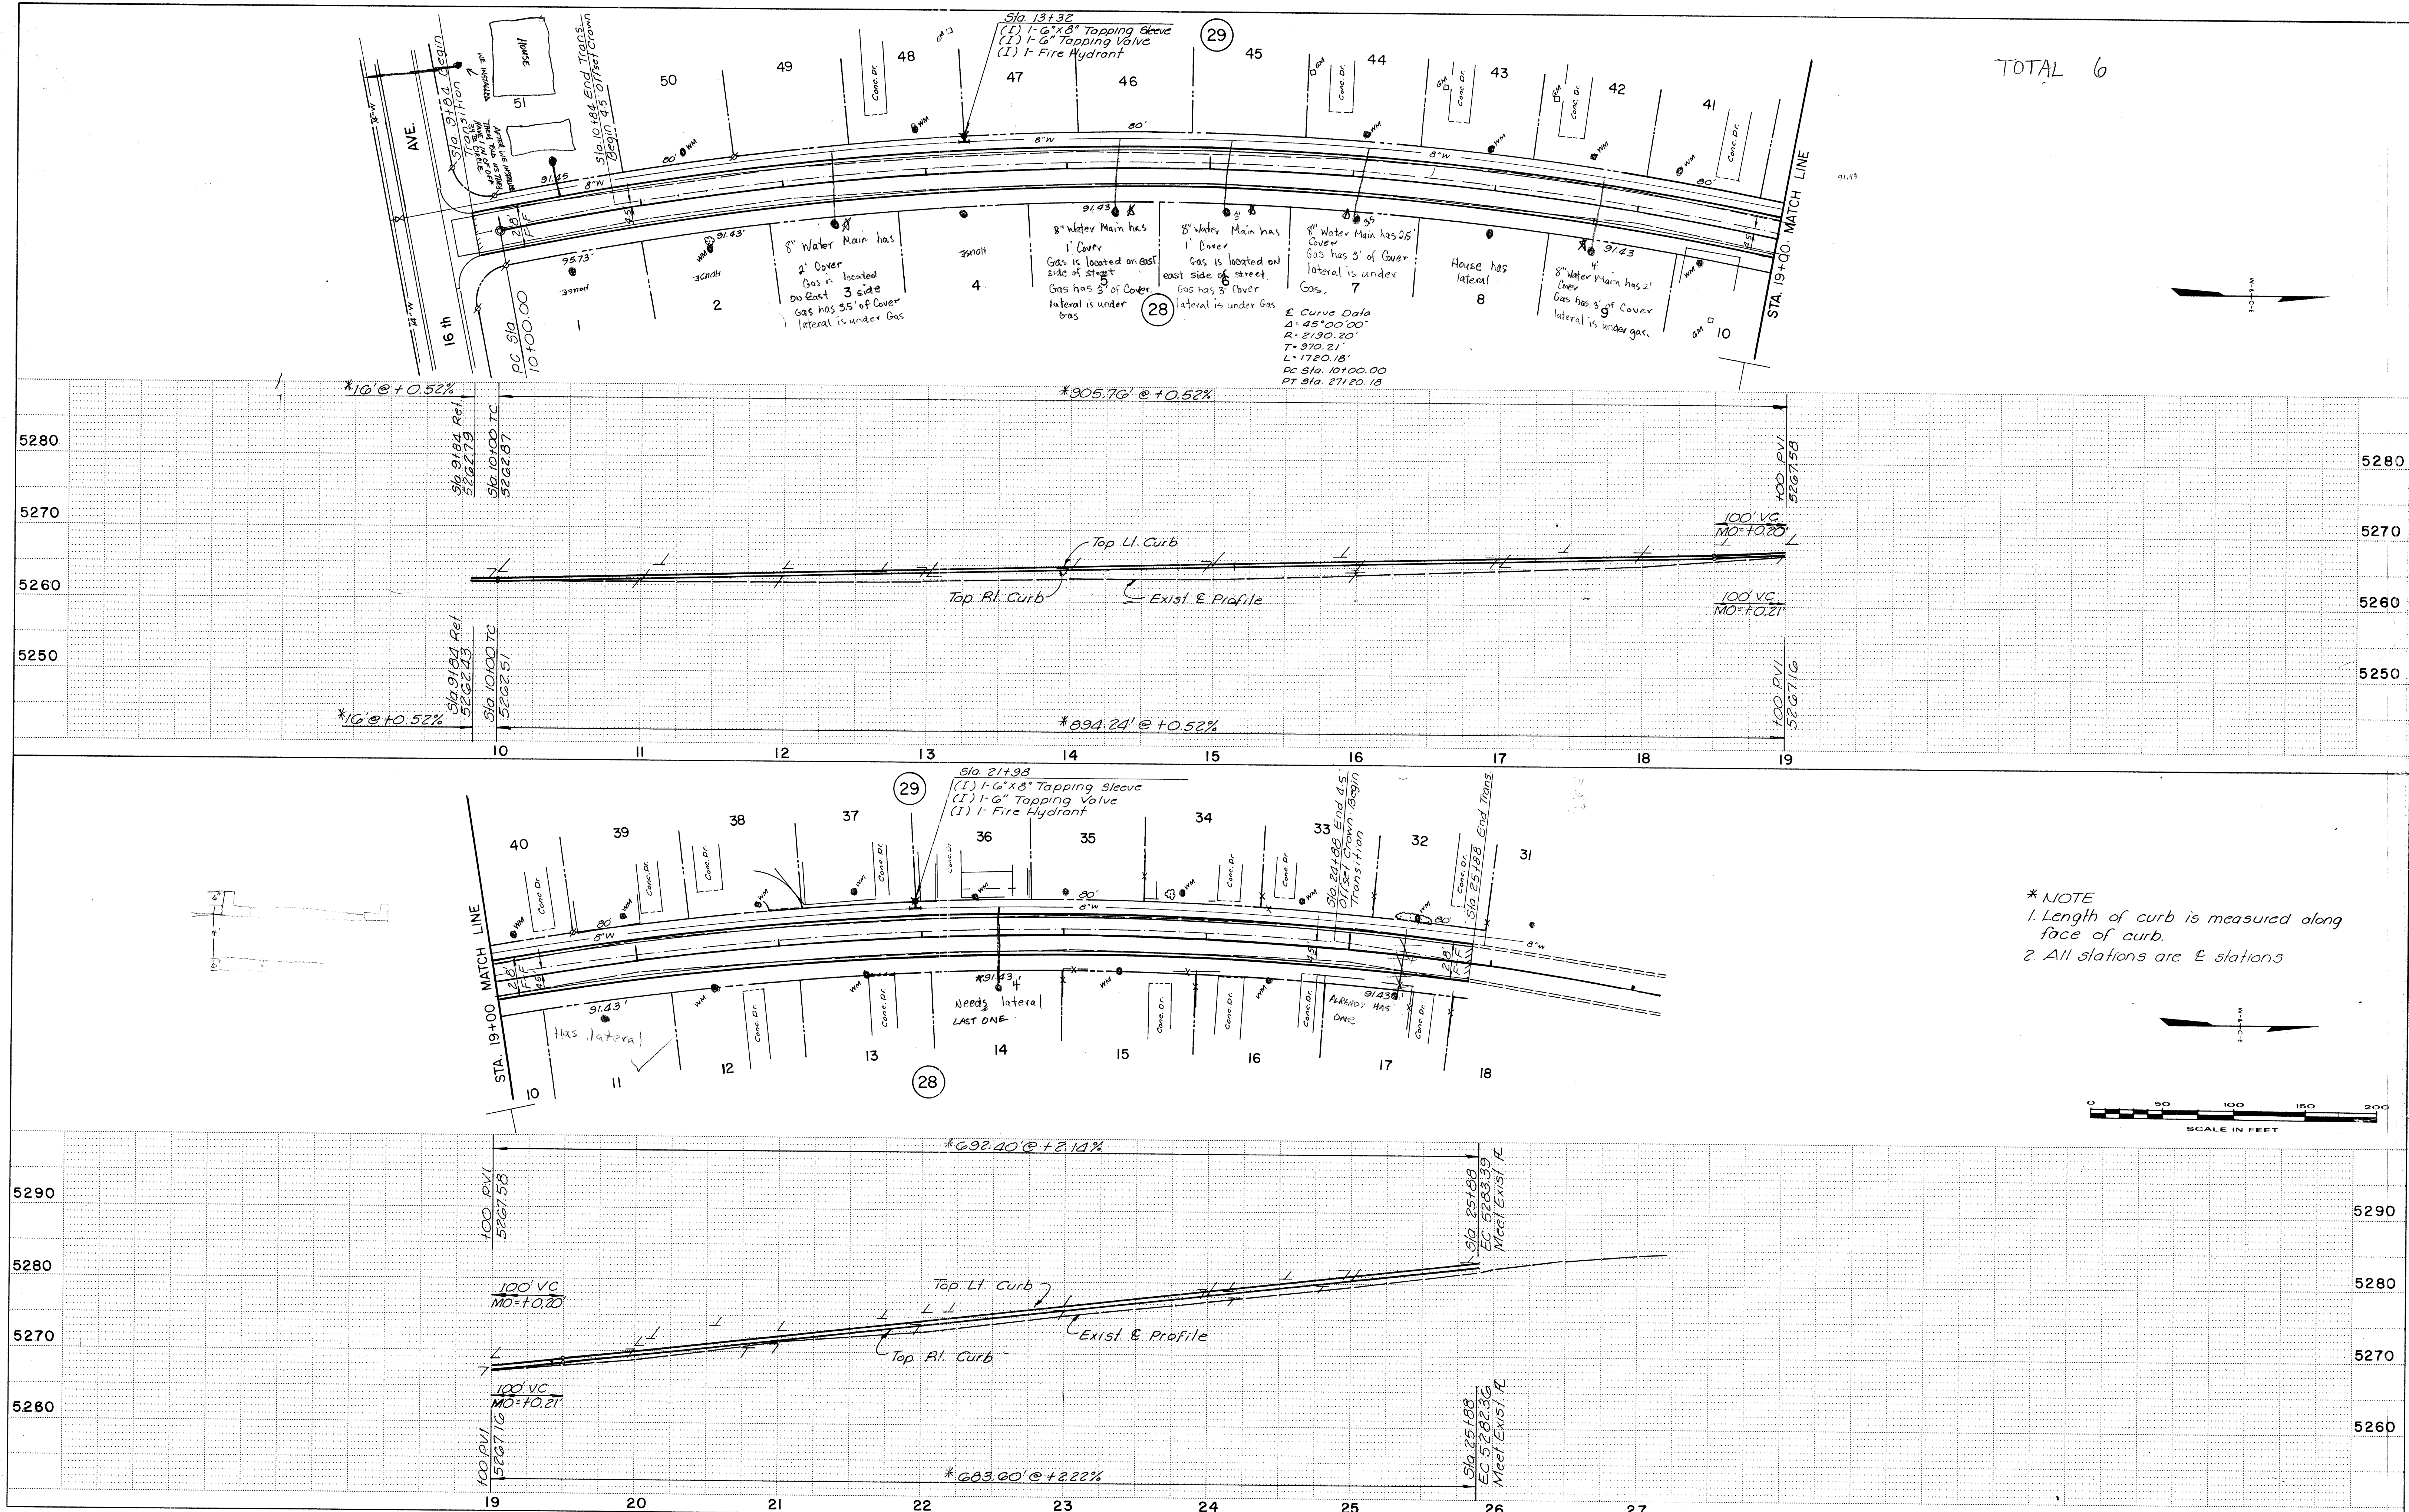


TOTAL 6



* NOTE
1. Length of curb is measured along face of curb.
2. All stations are E stations

34TH. CIRCLE

35th
35th


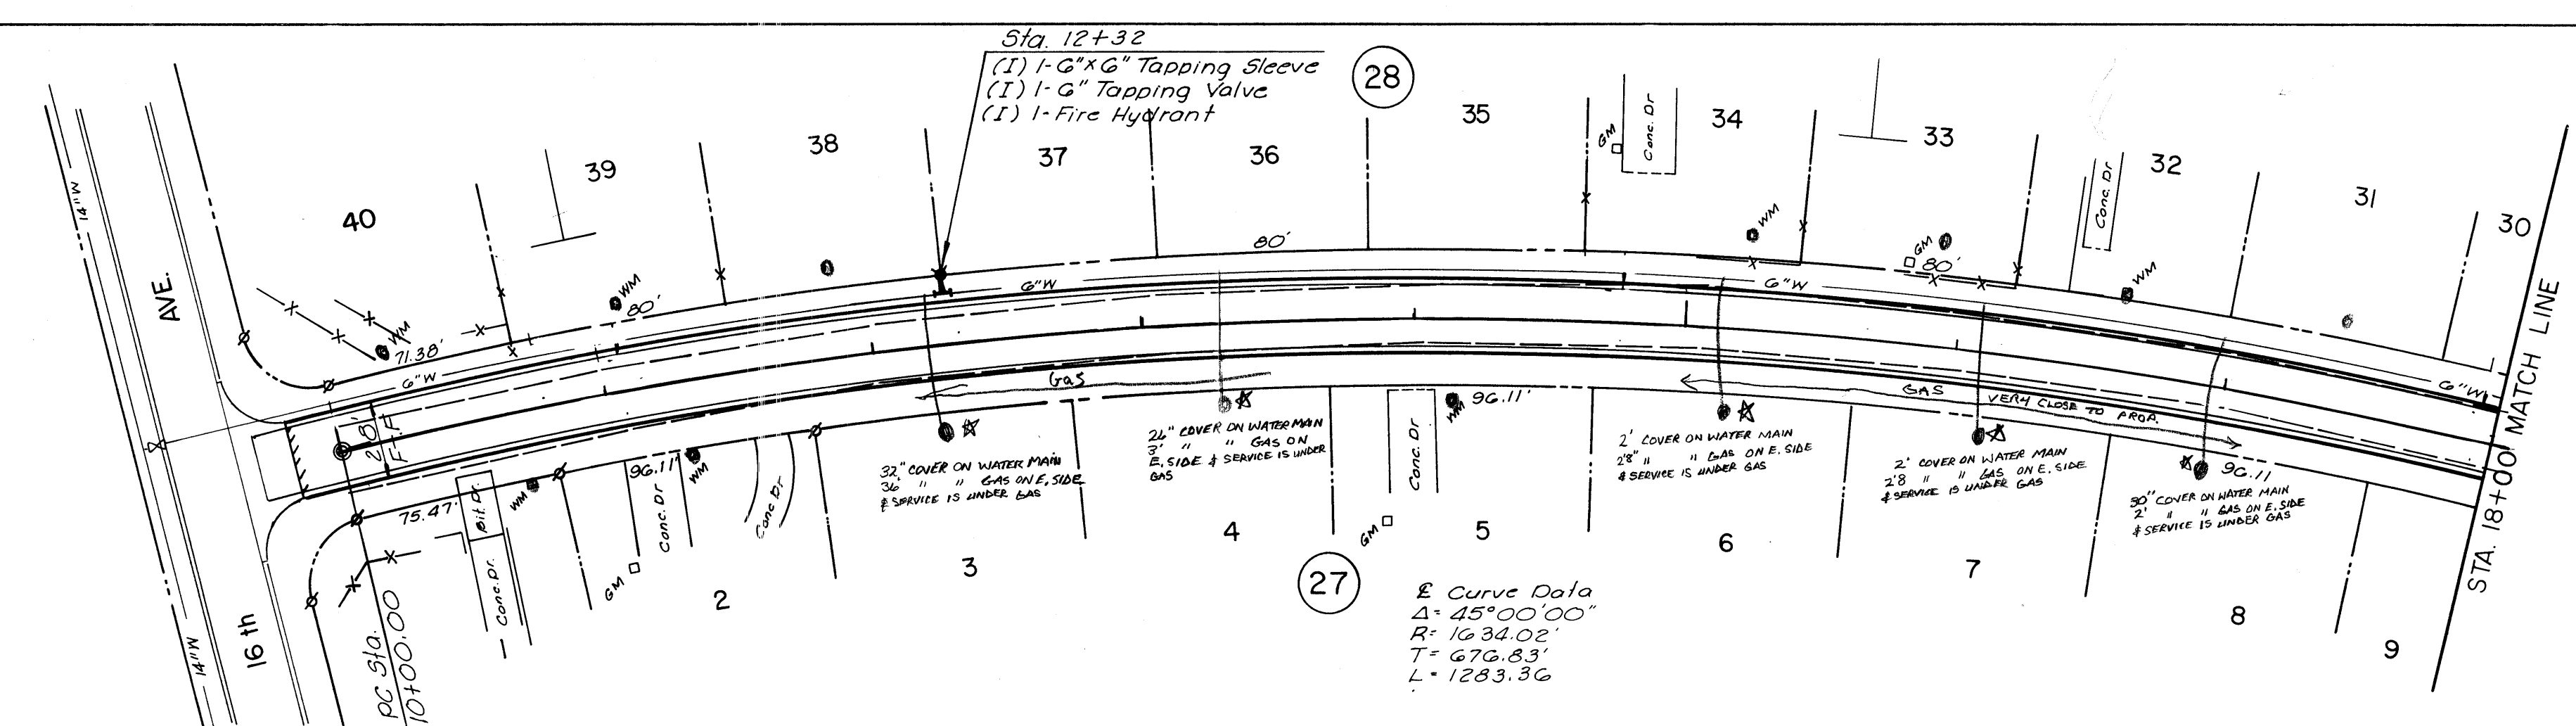


TOTAL 8

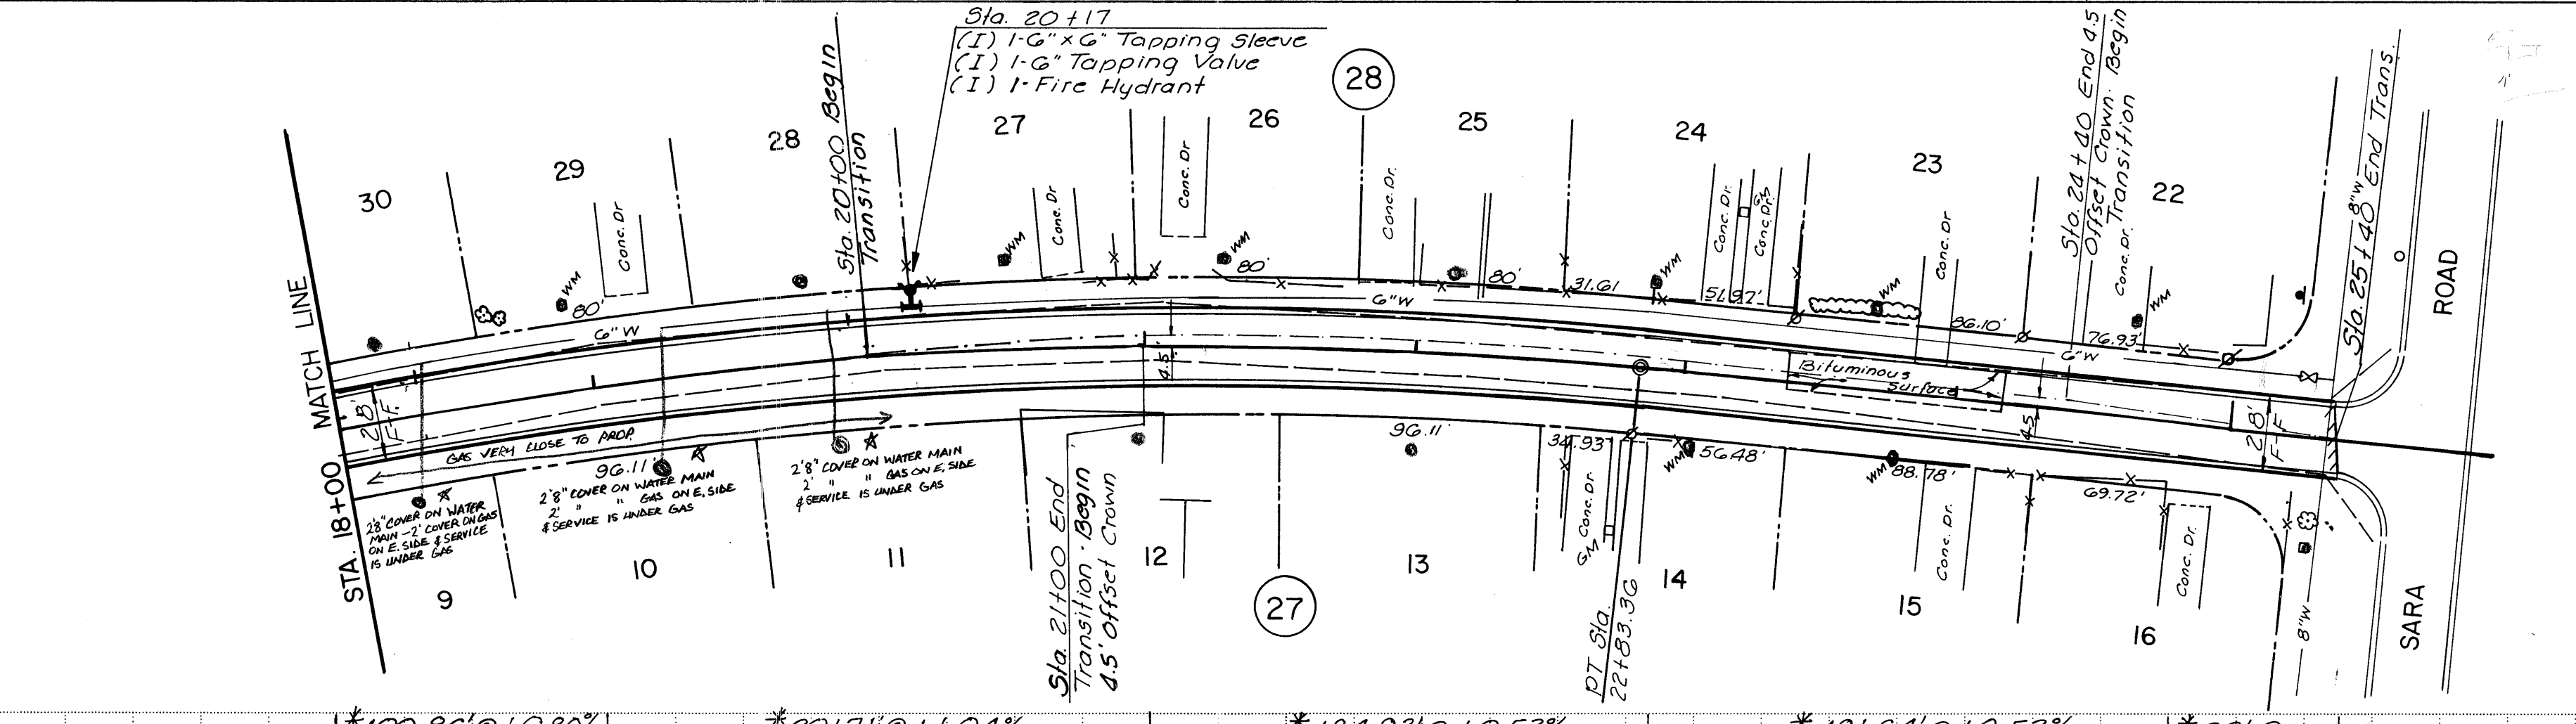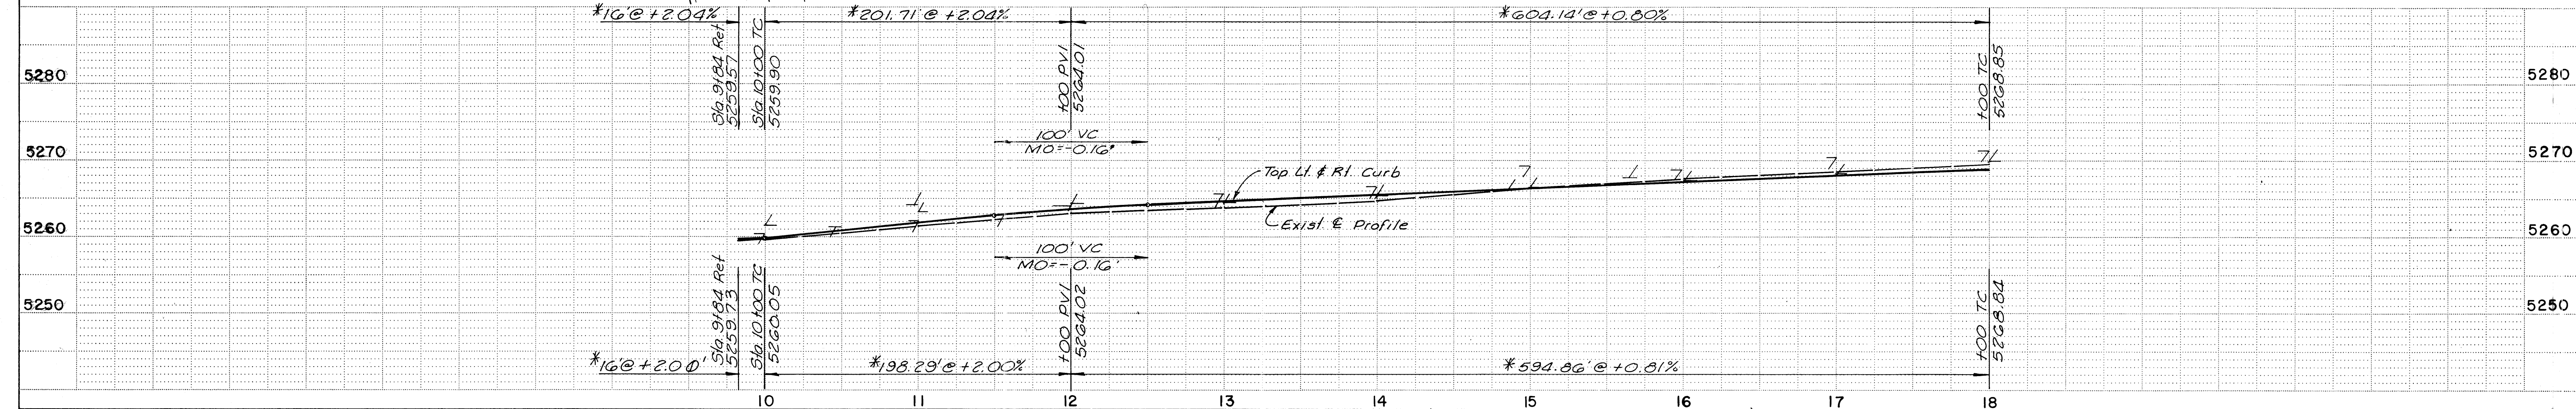


BENCHMARK
TBM 86-507-10, Elevation 5276.44
A "a" Cut on top of South Curb of
Sara Road 35' West of the N.W.
Curb return of 35th Circle.



* NOTE
1. Length of curb is measured along
face of curb.
2. All stations are @ stations.

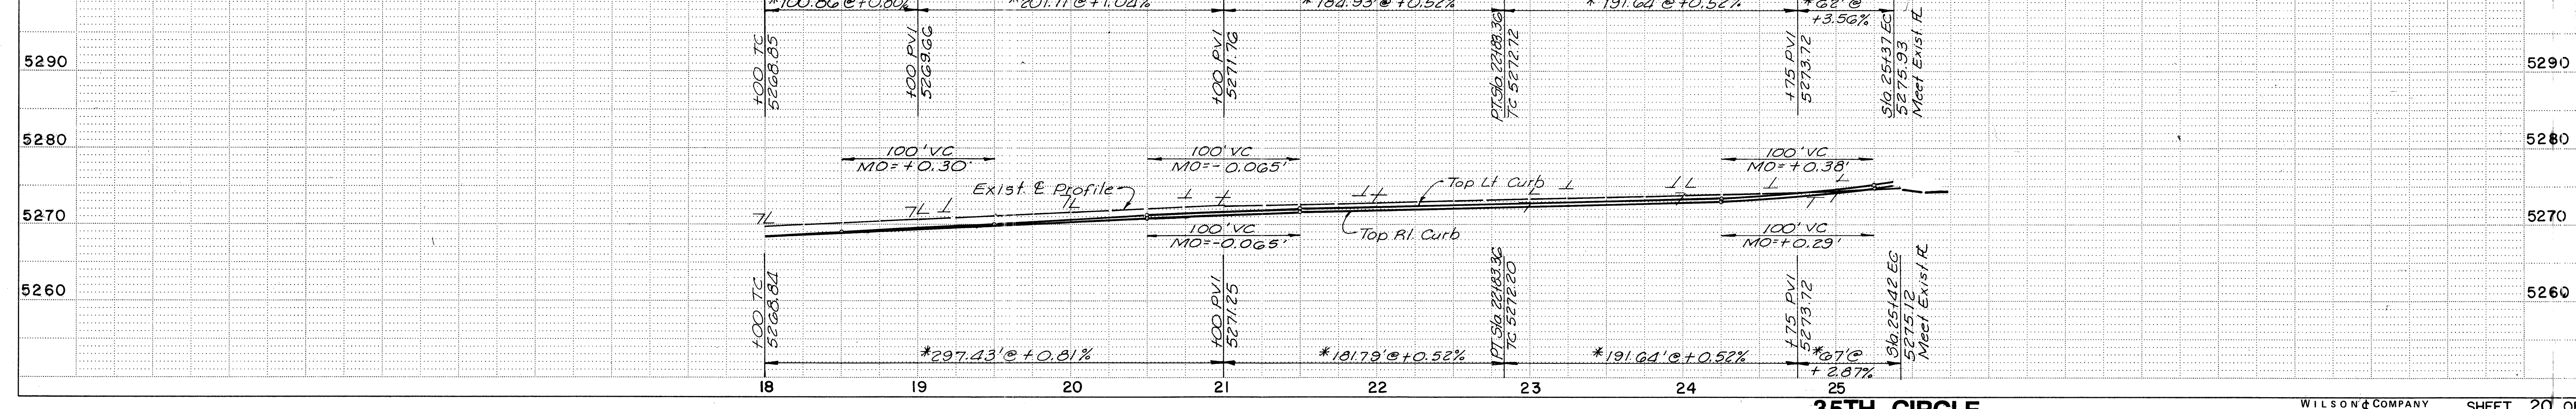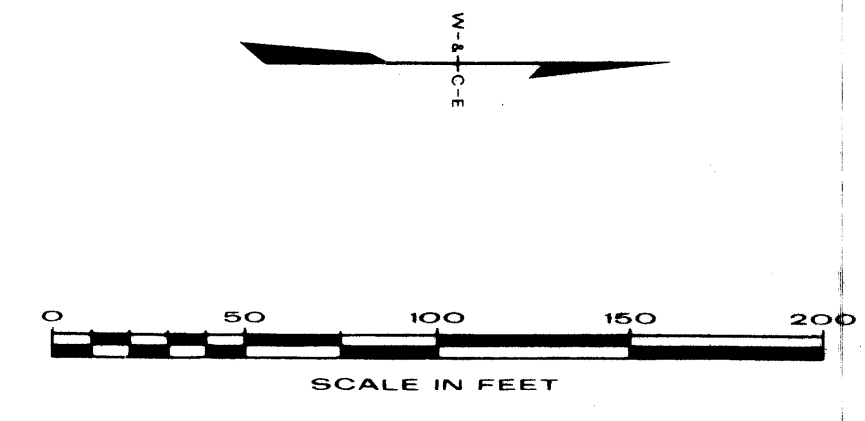



35TH. CIRCLE


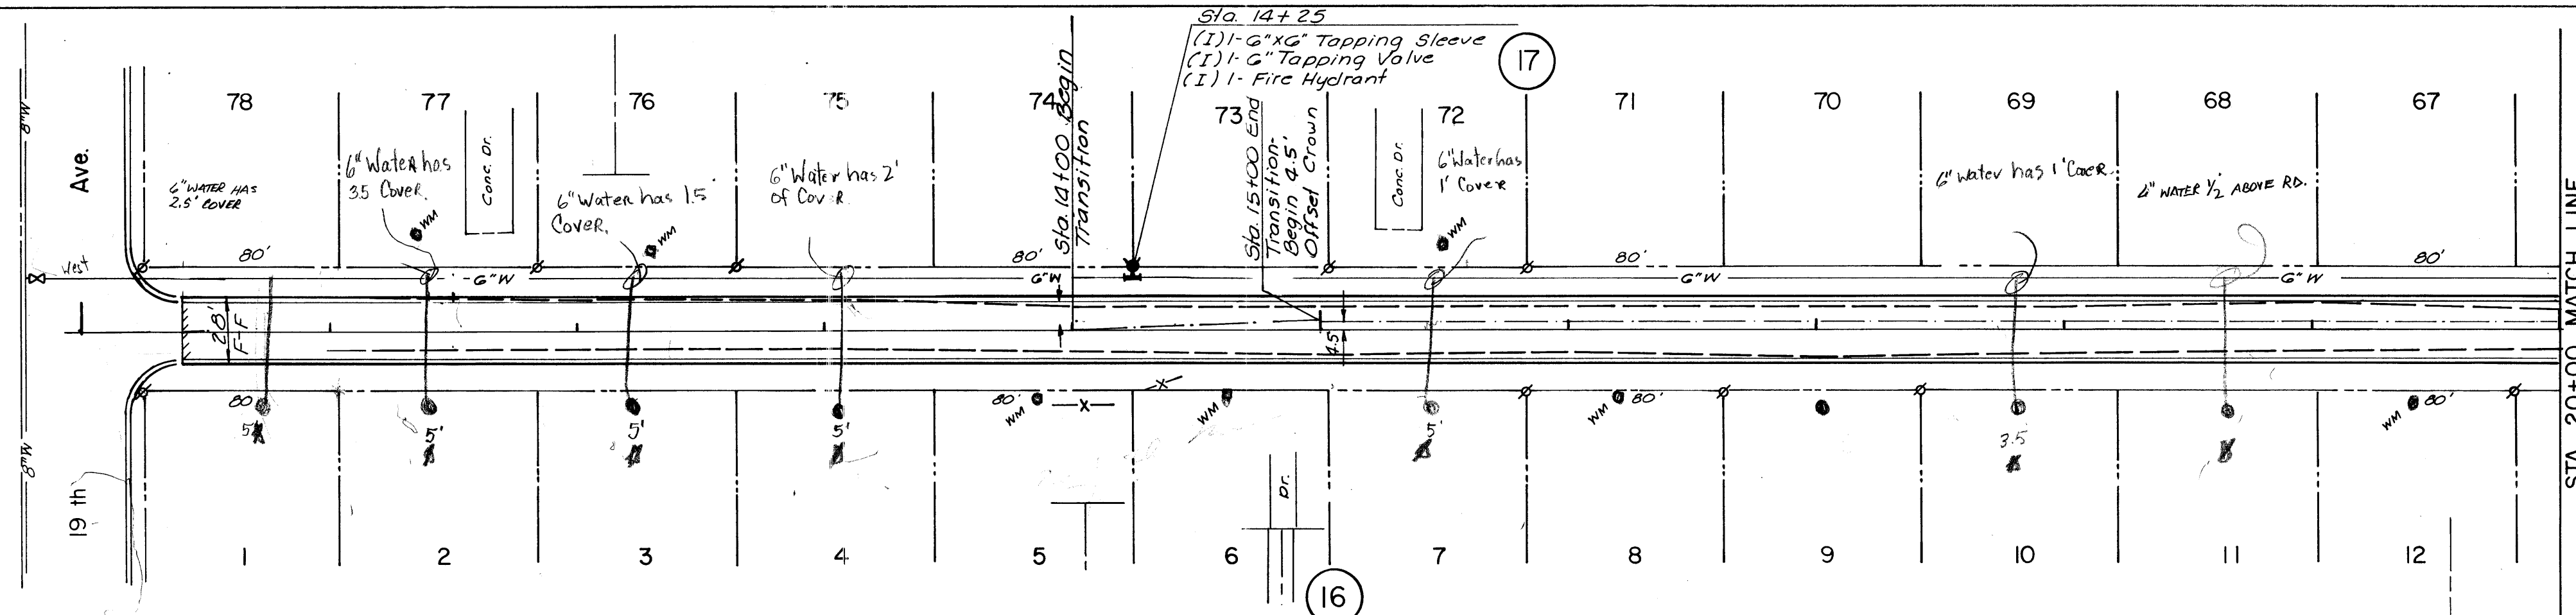


TOTAL 11

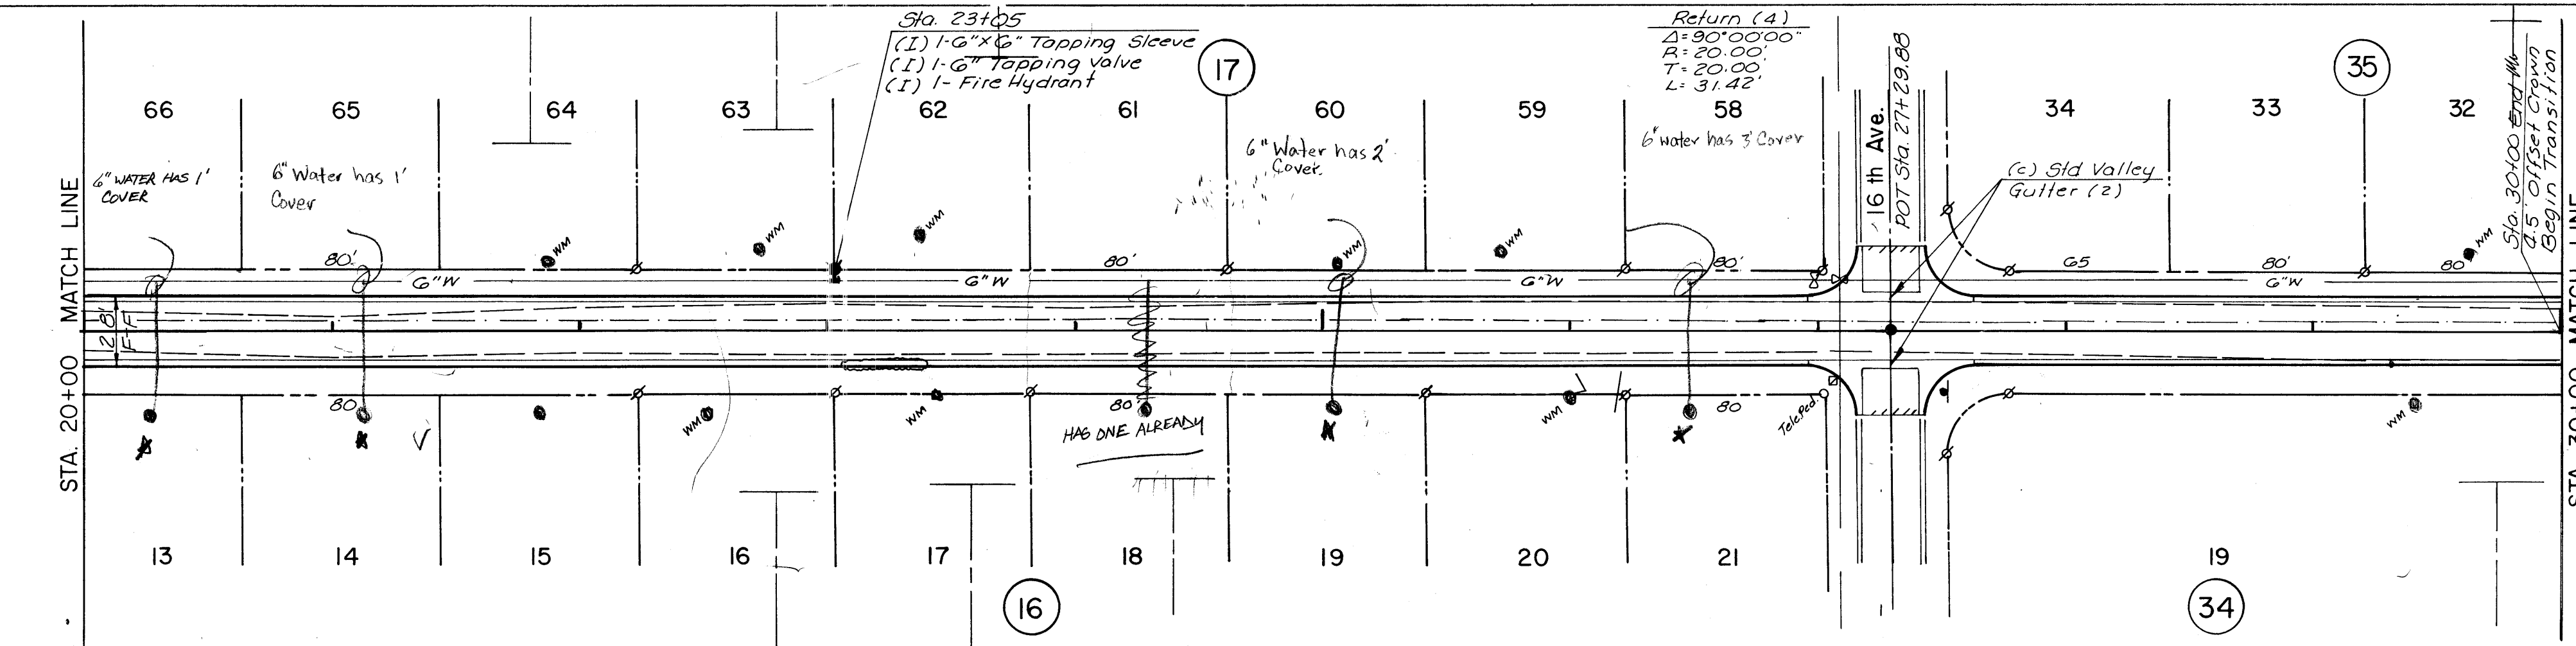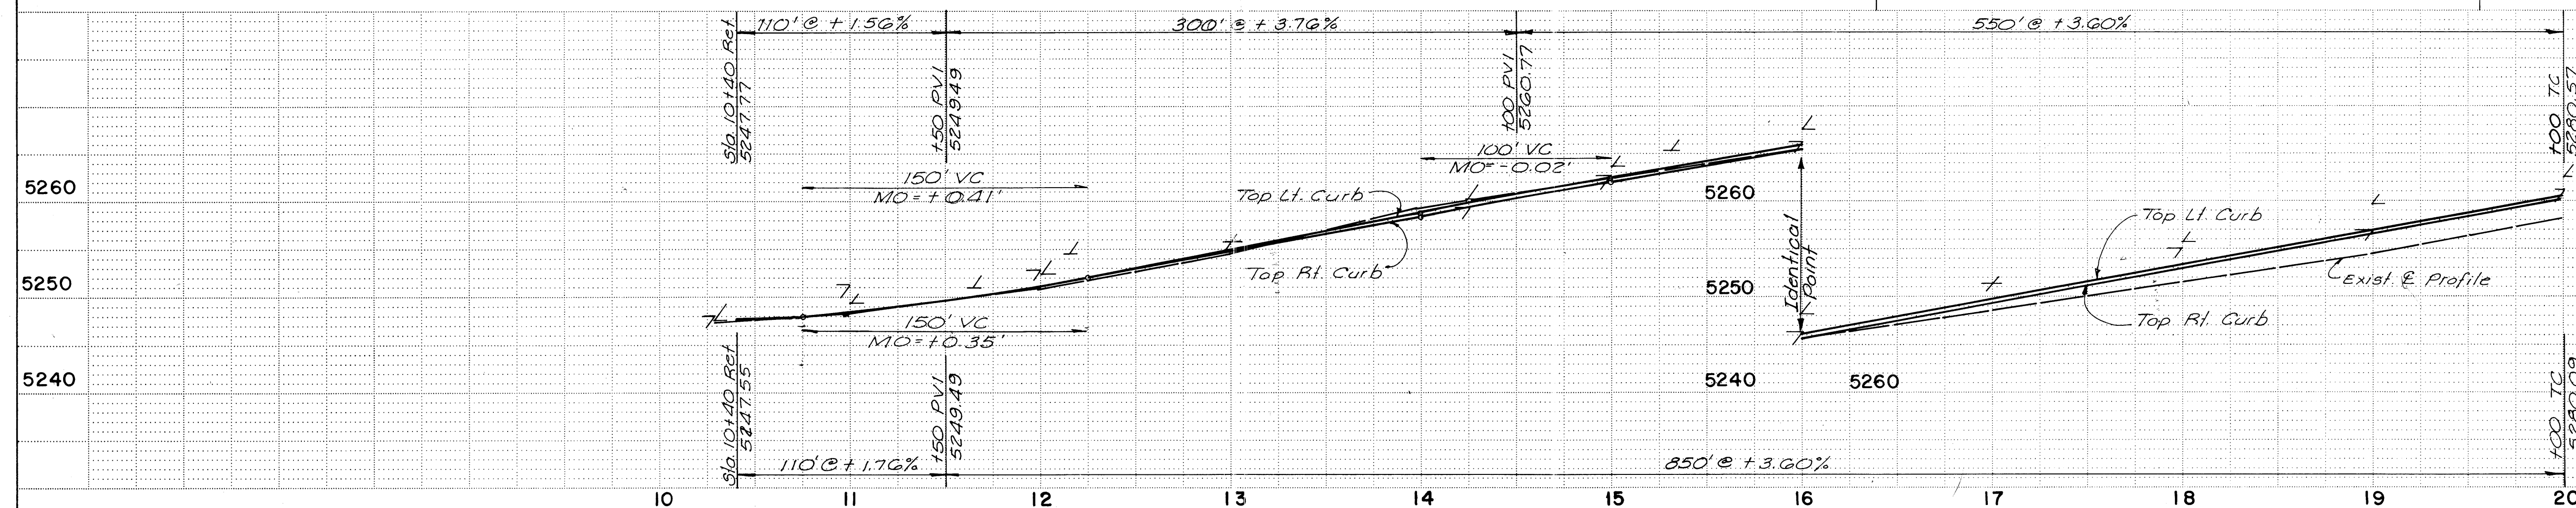


31st St. is All Clear on bus, all the way to 19th st.
CLEAR ED ON TELE - JARVIS

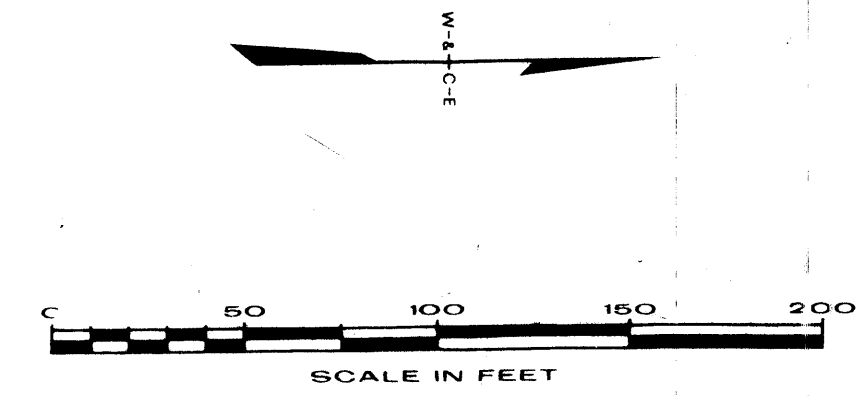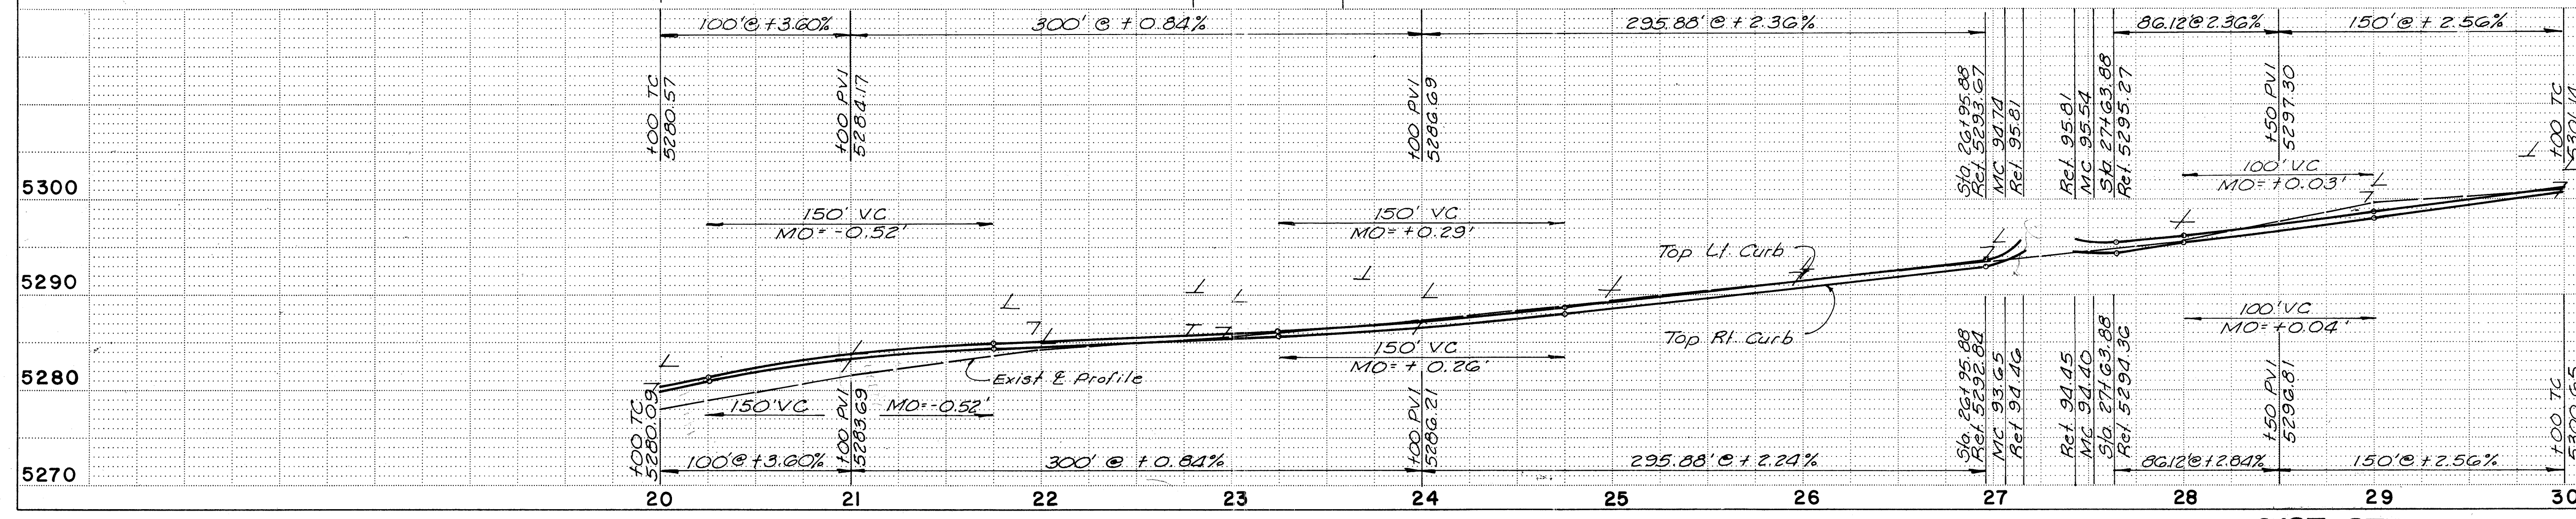

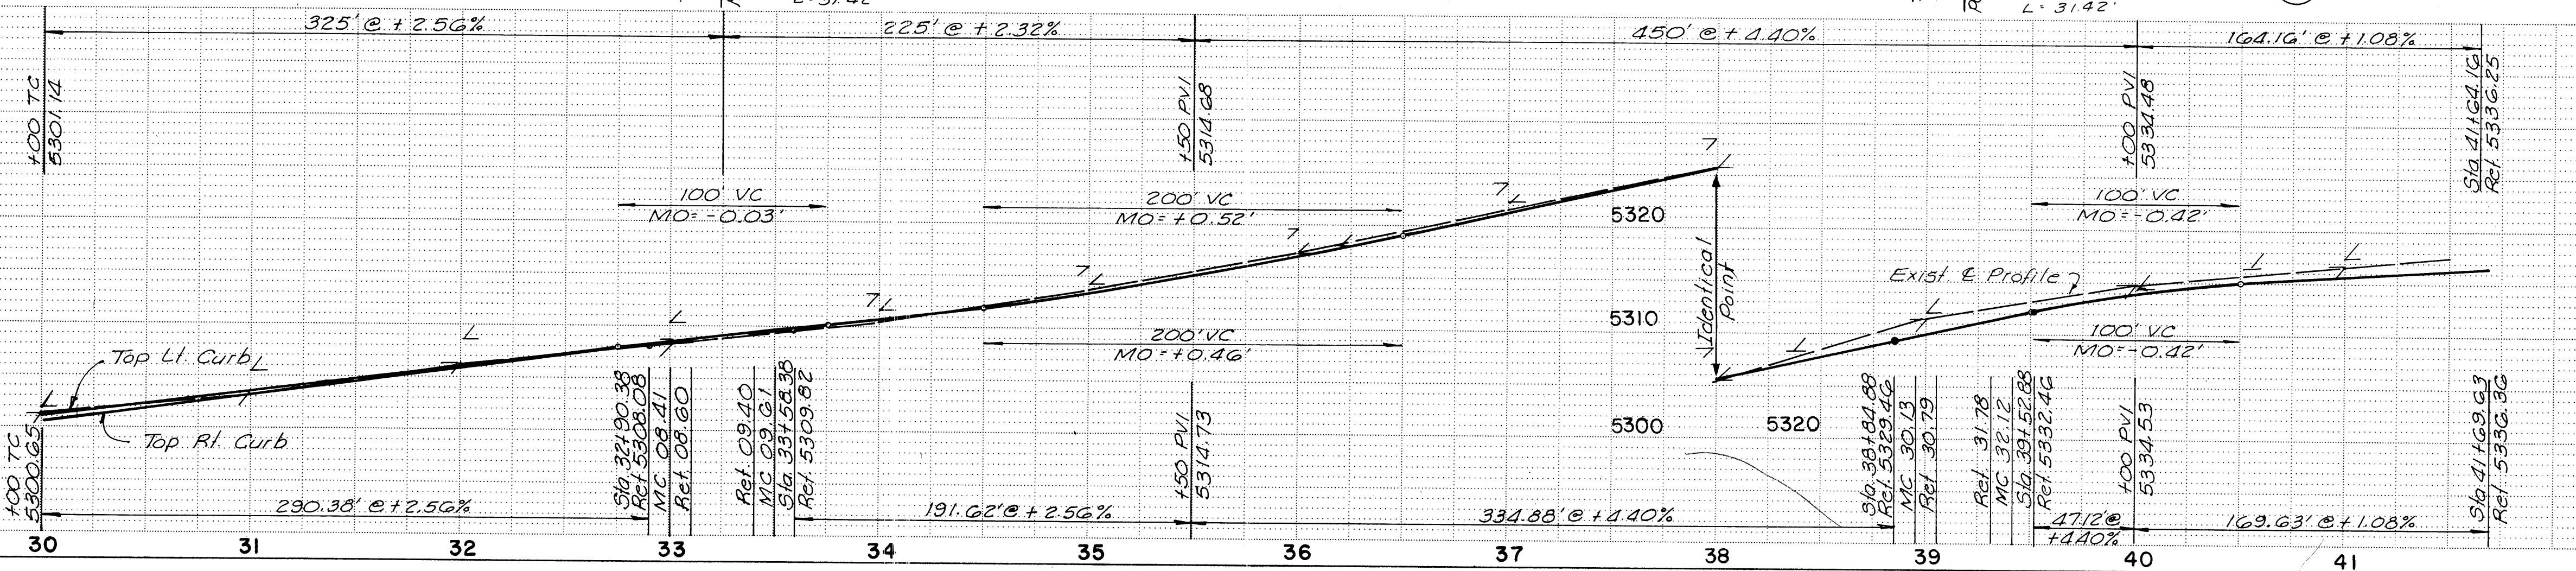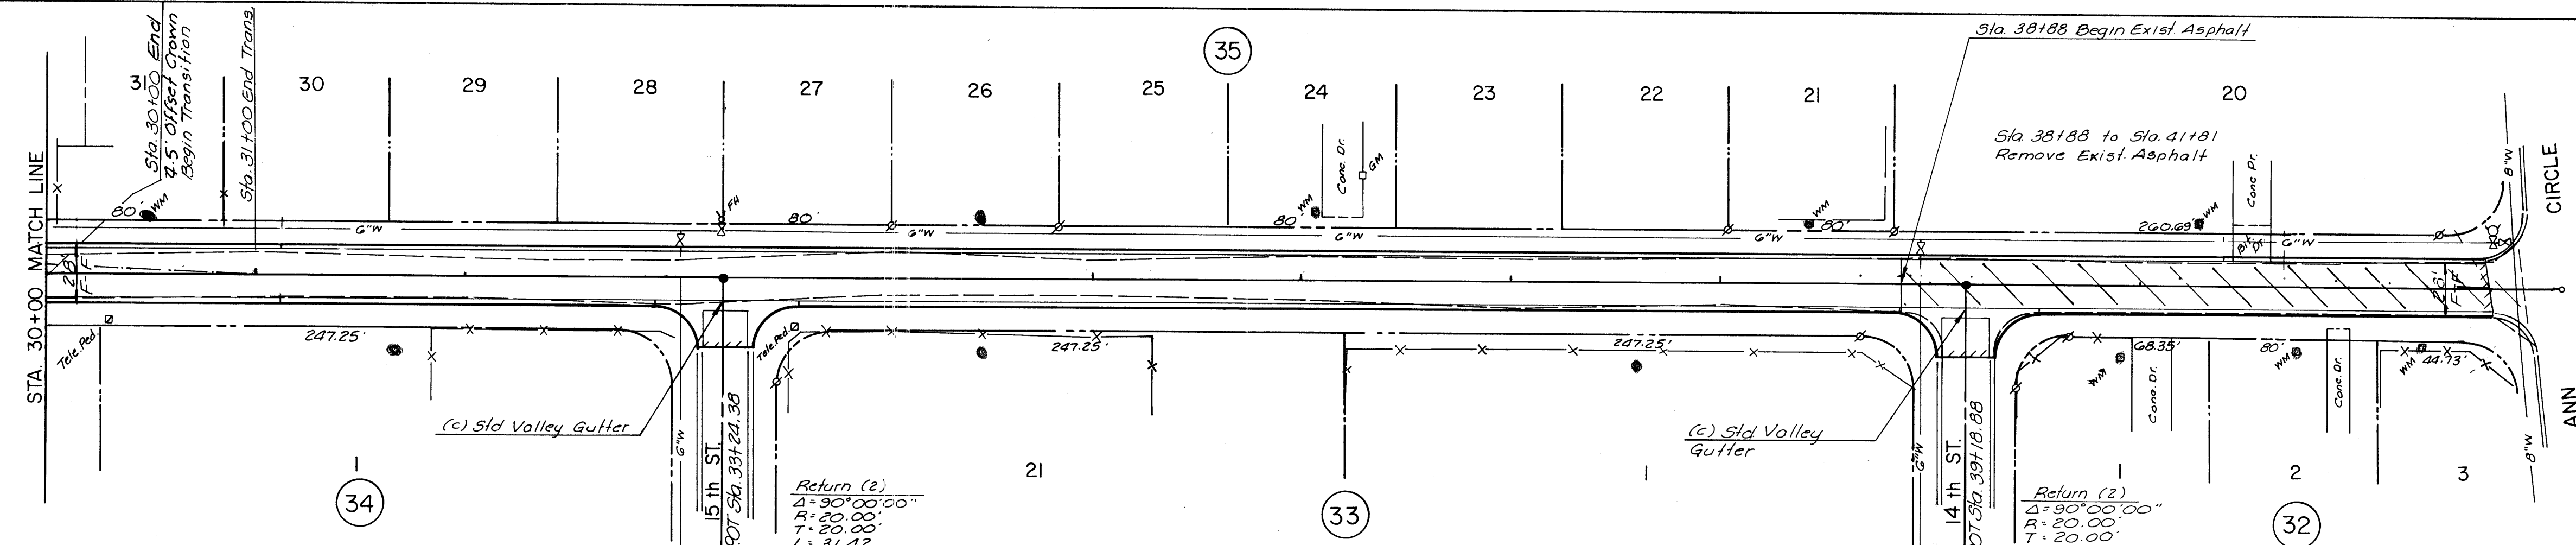


11 TOTAL

ASSESSMENT DISTRICT NO. 3 RIO RANCHO, NEW MEXICO

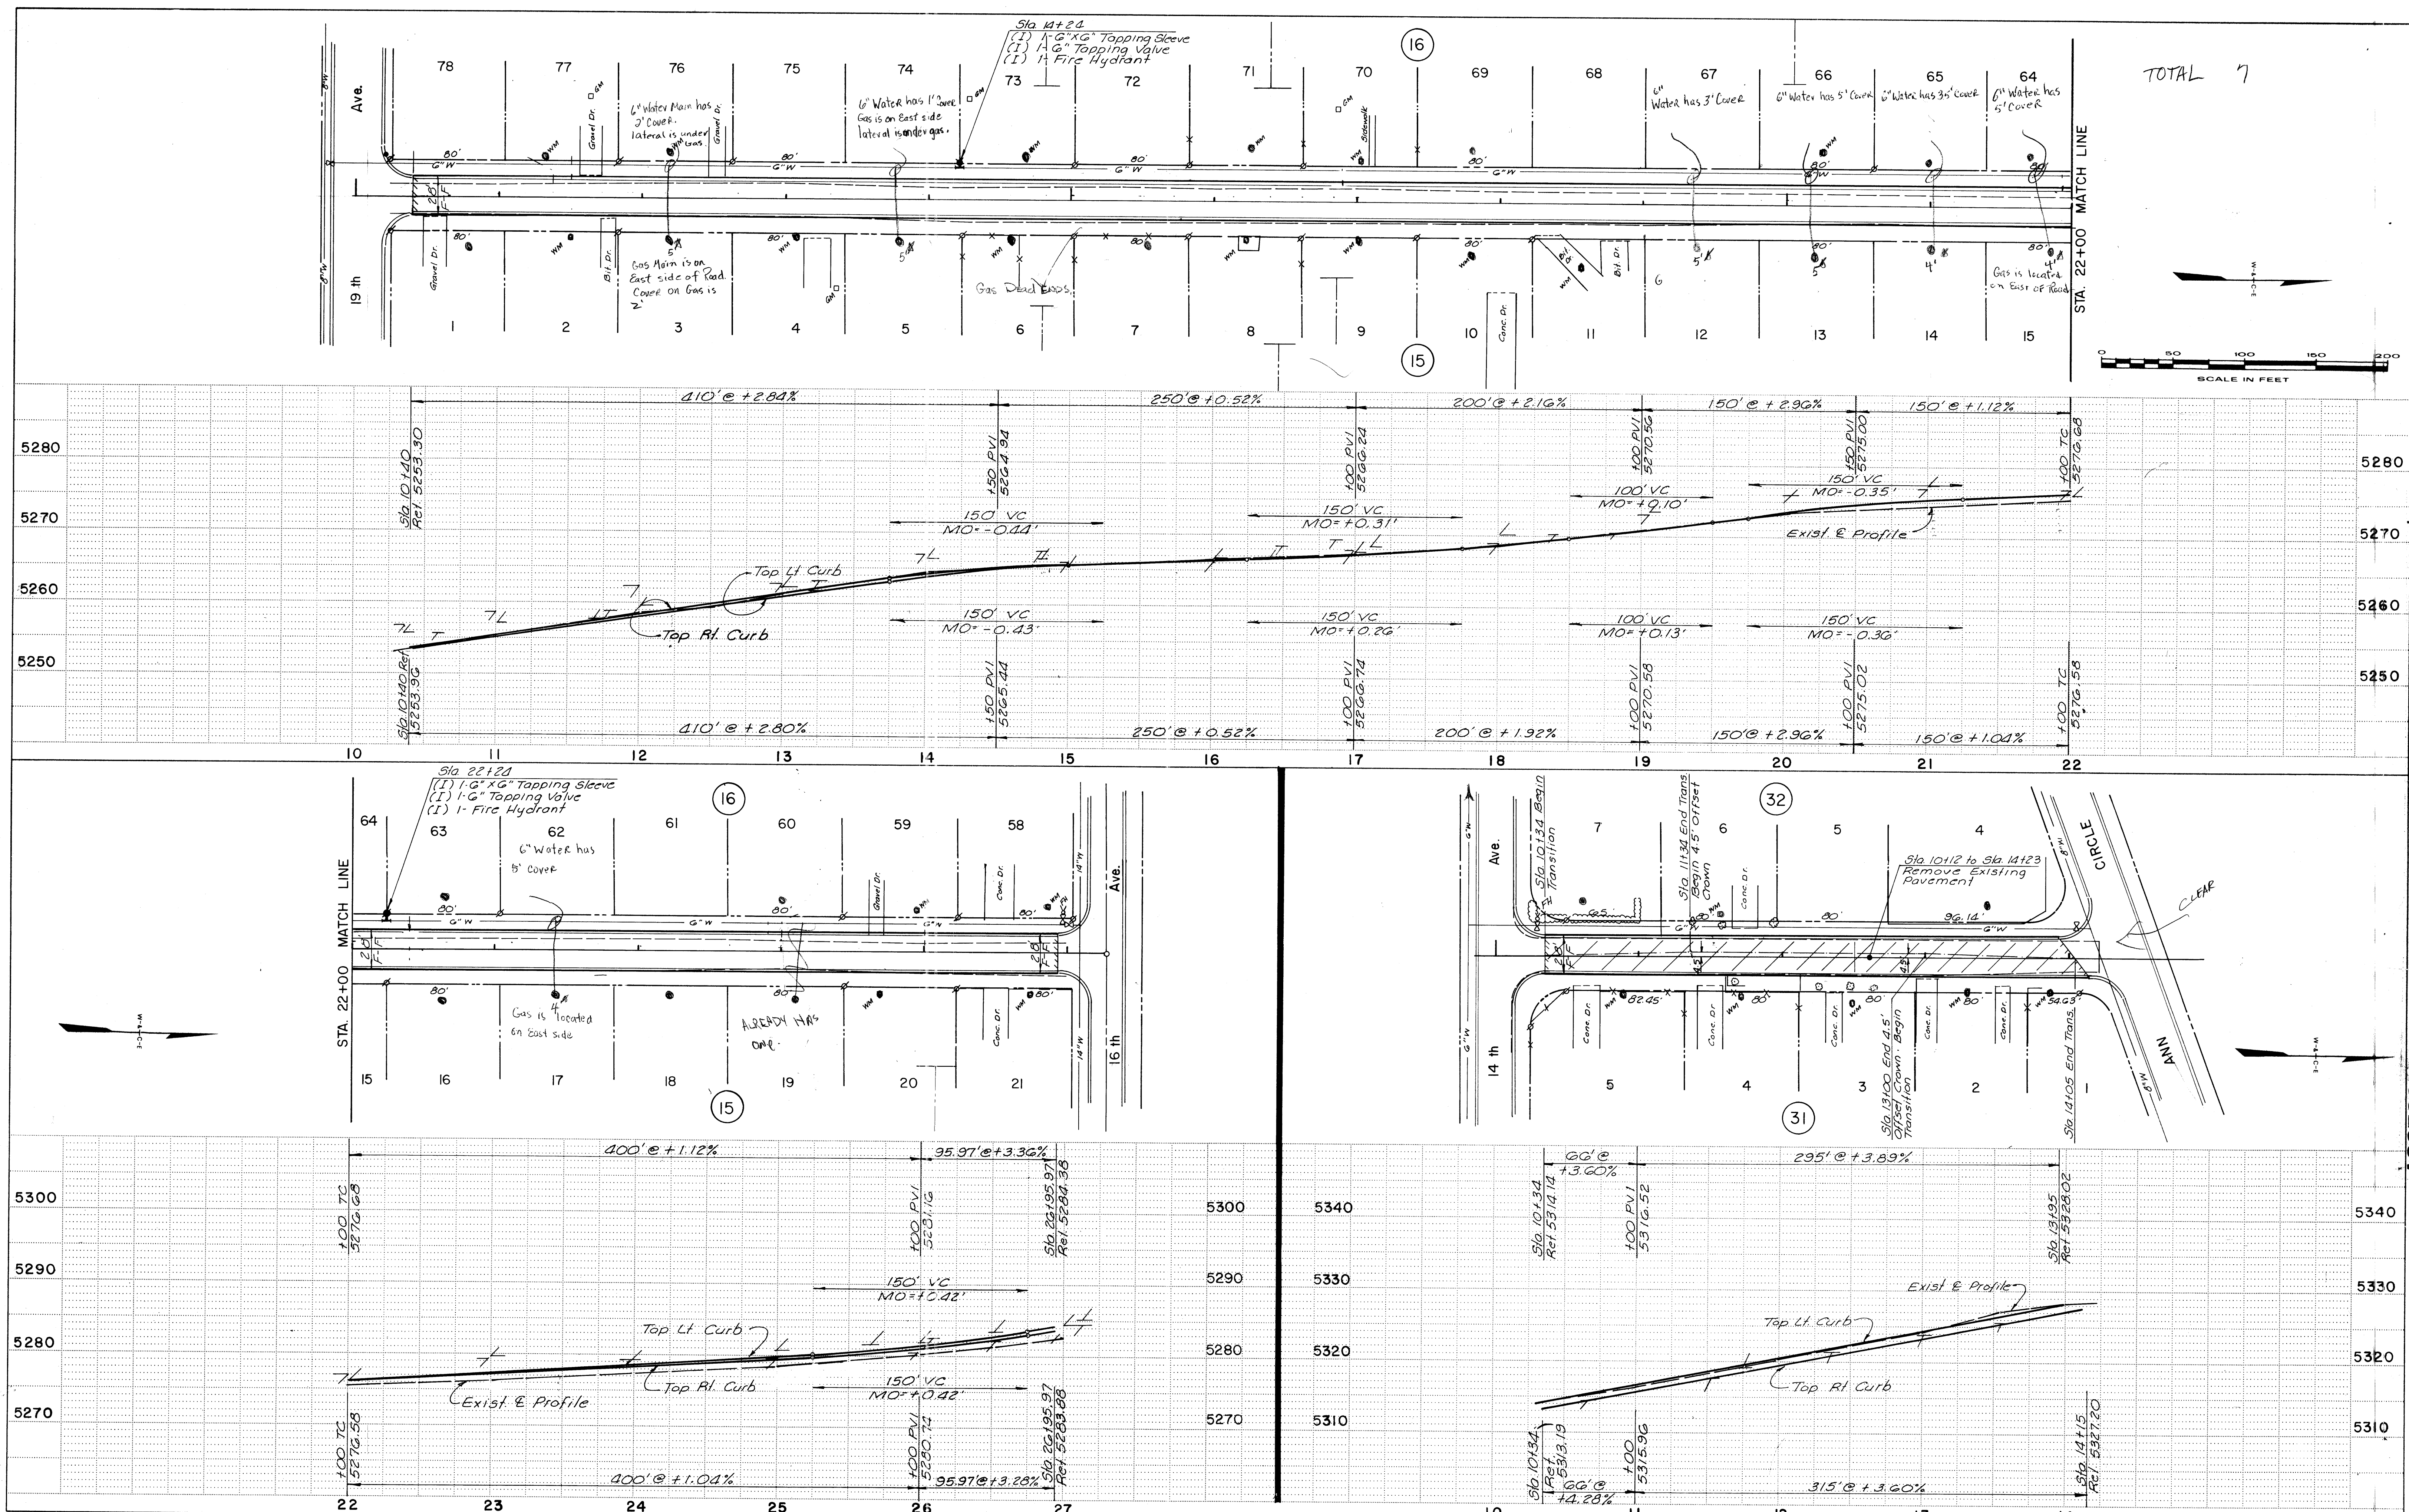


TOTAL 7

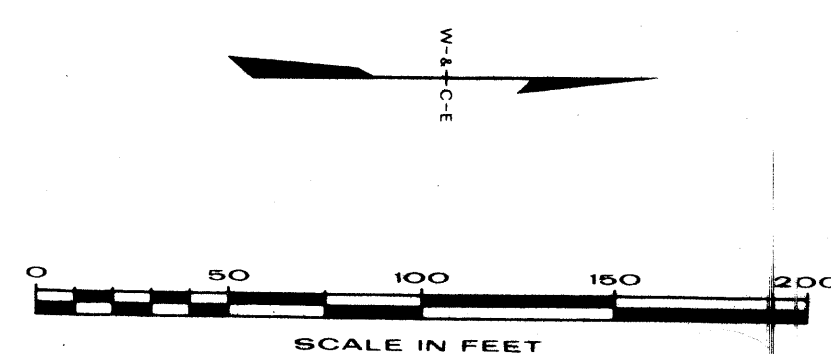

32ND. STREET

32ND. STREET

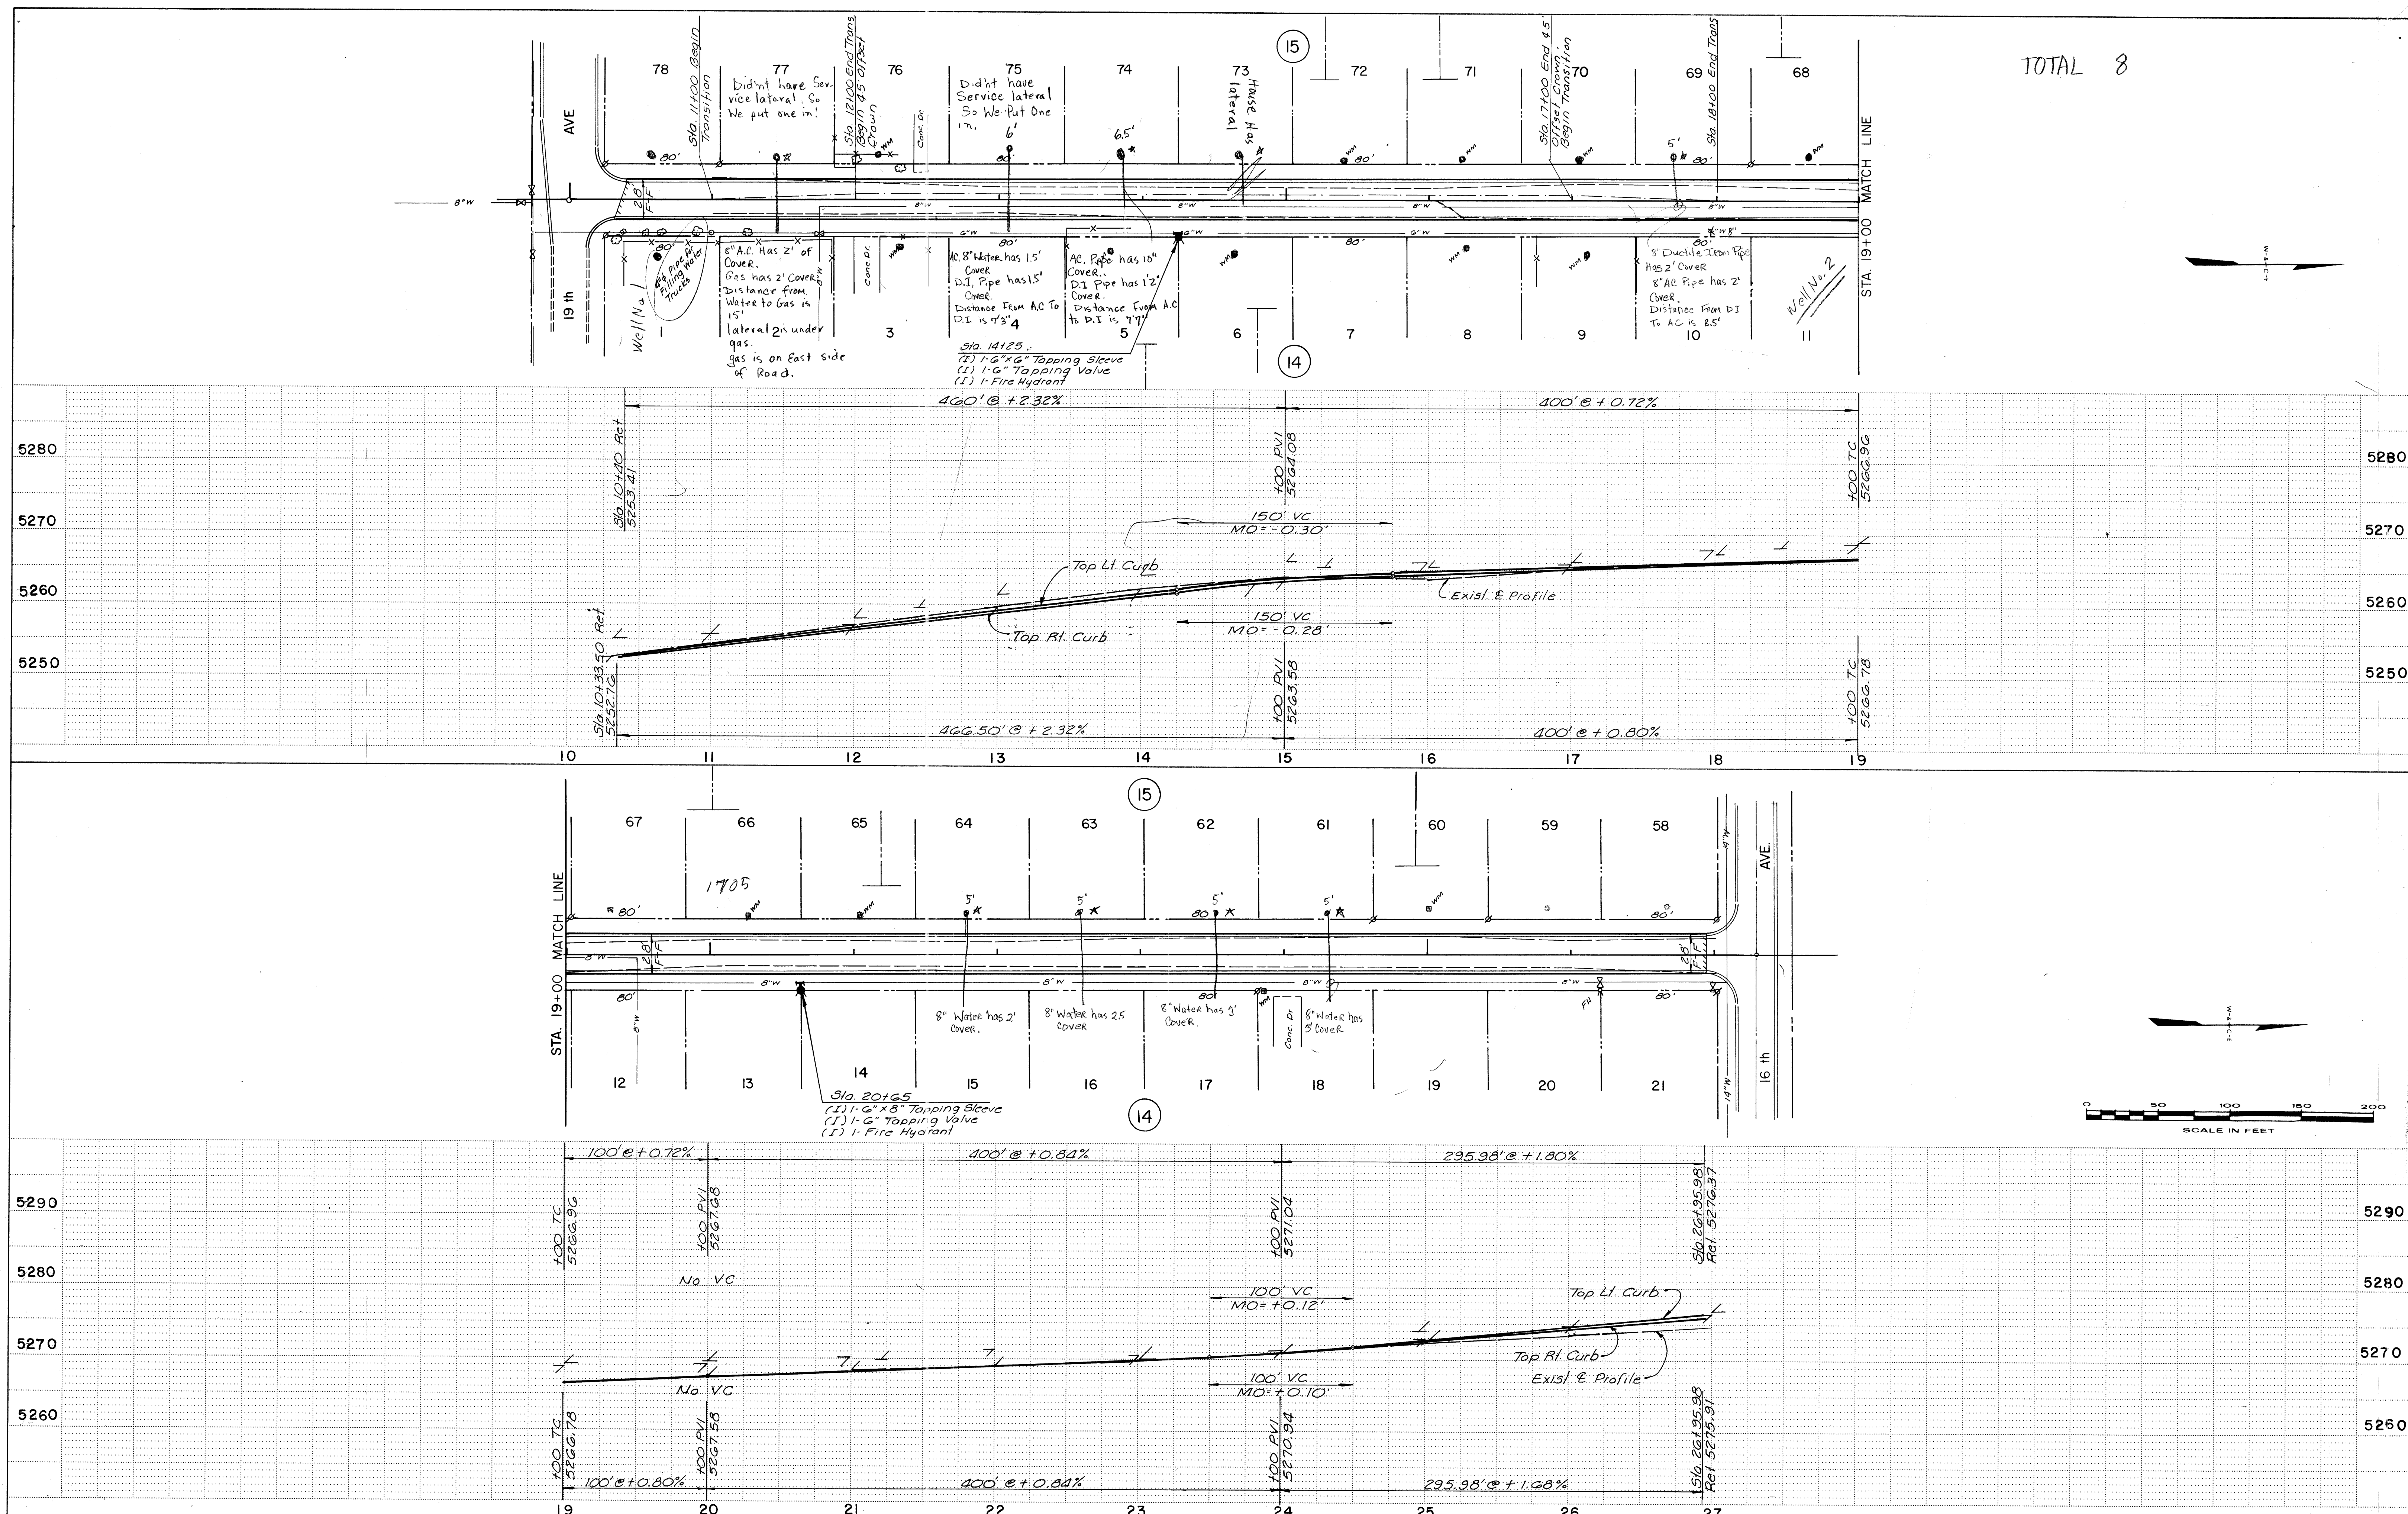


TOTAL 8

33RD. STREET




86-507

WILSON & COMPANY
ENGINEERS & ARCHITECTS
ALBUQUERQUE NEW MEXICO

SHEET 24 OF 34 SHEETS

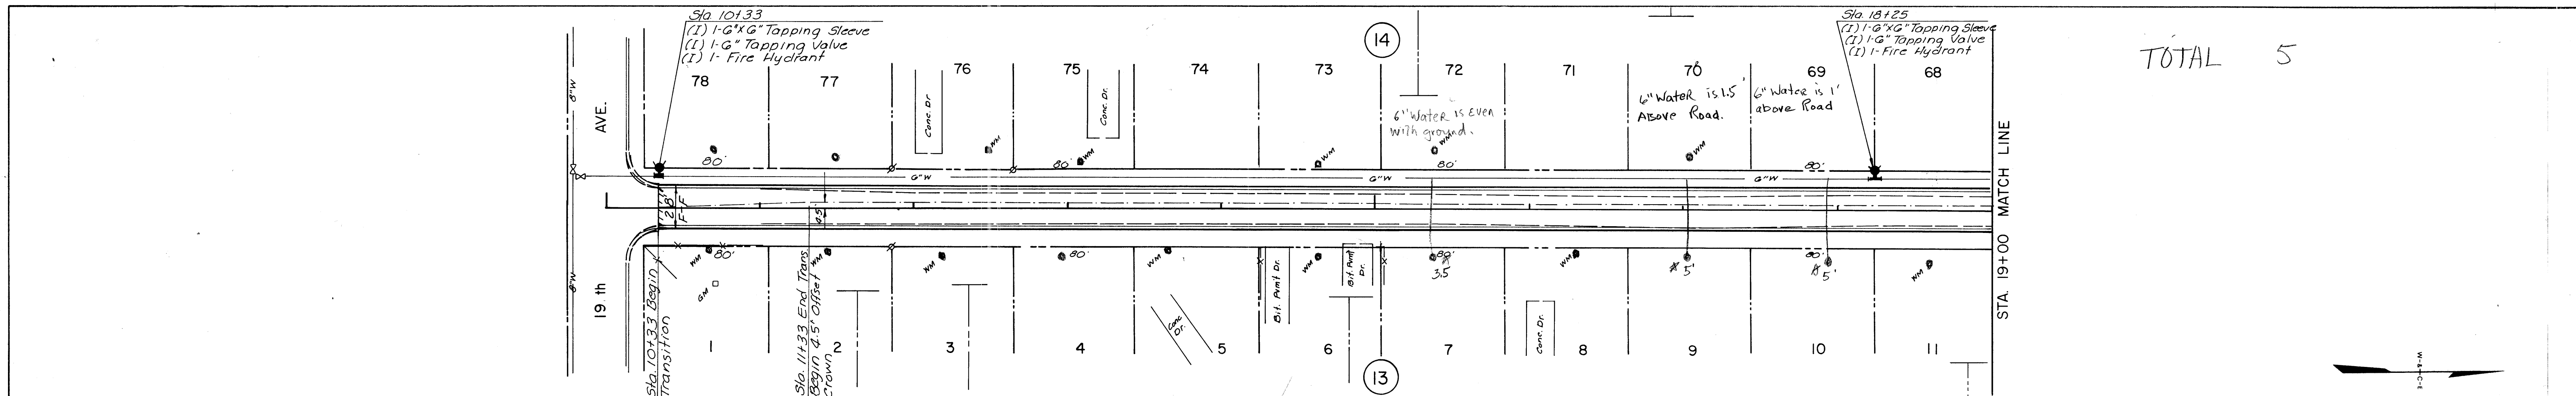


TOTAL 5

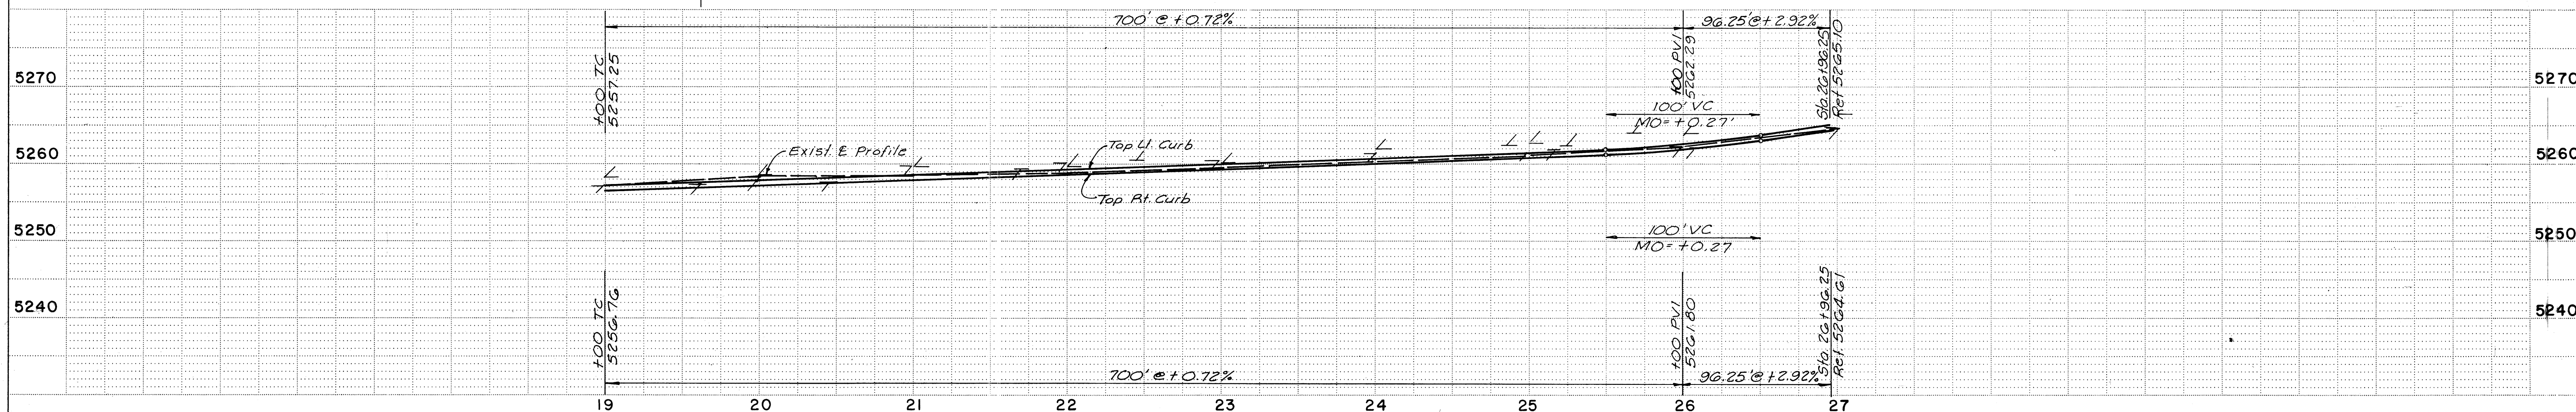
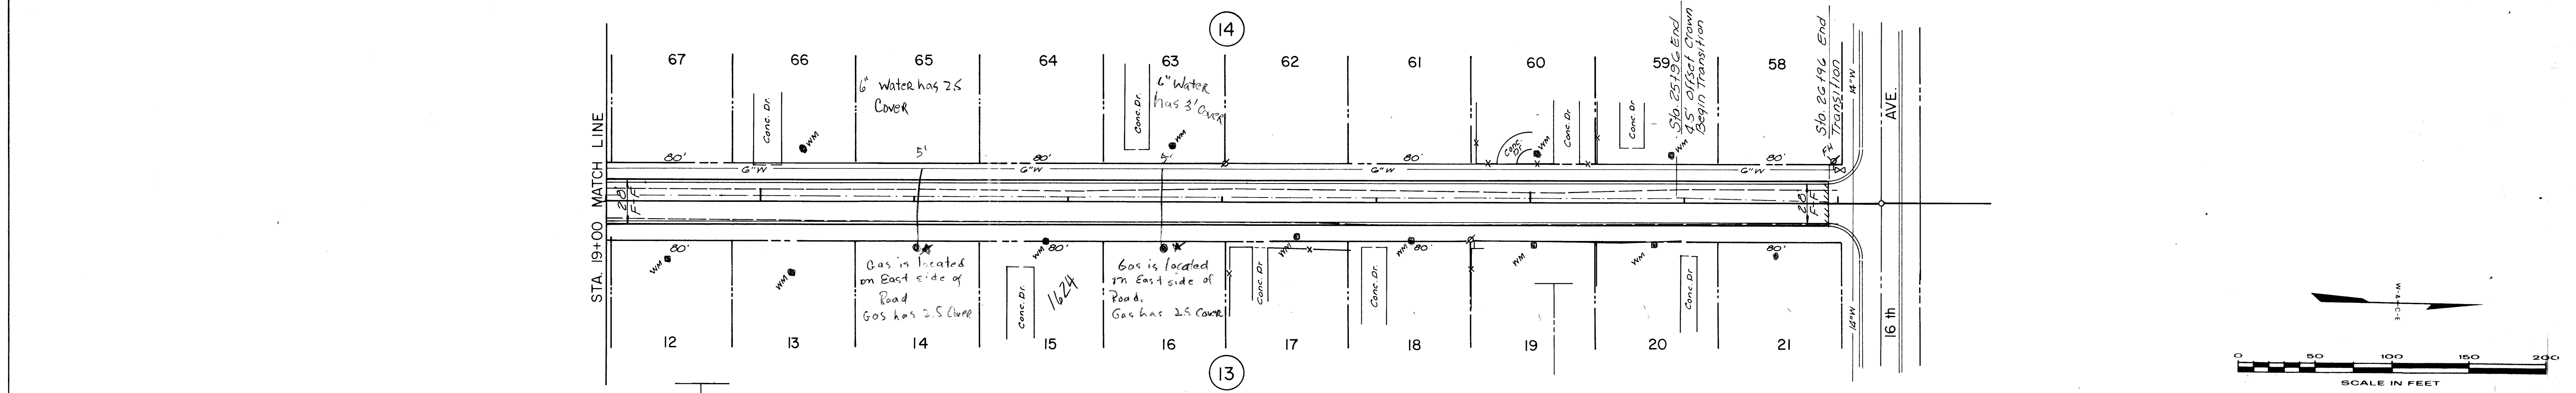
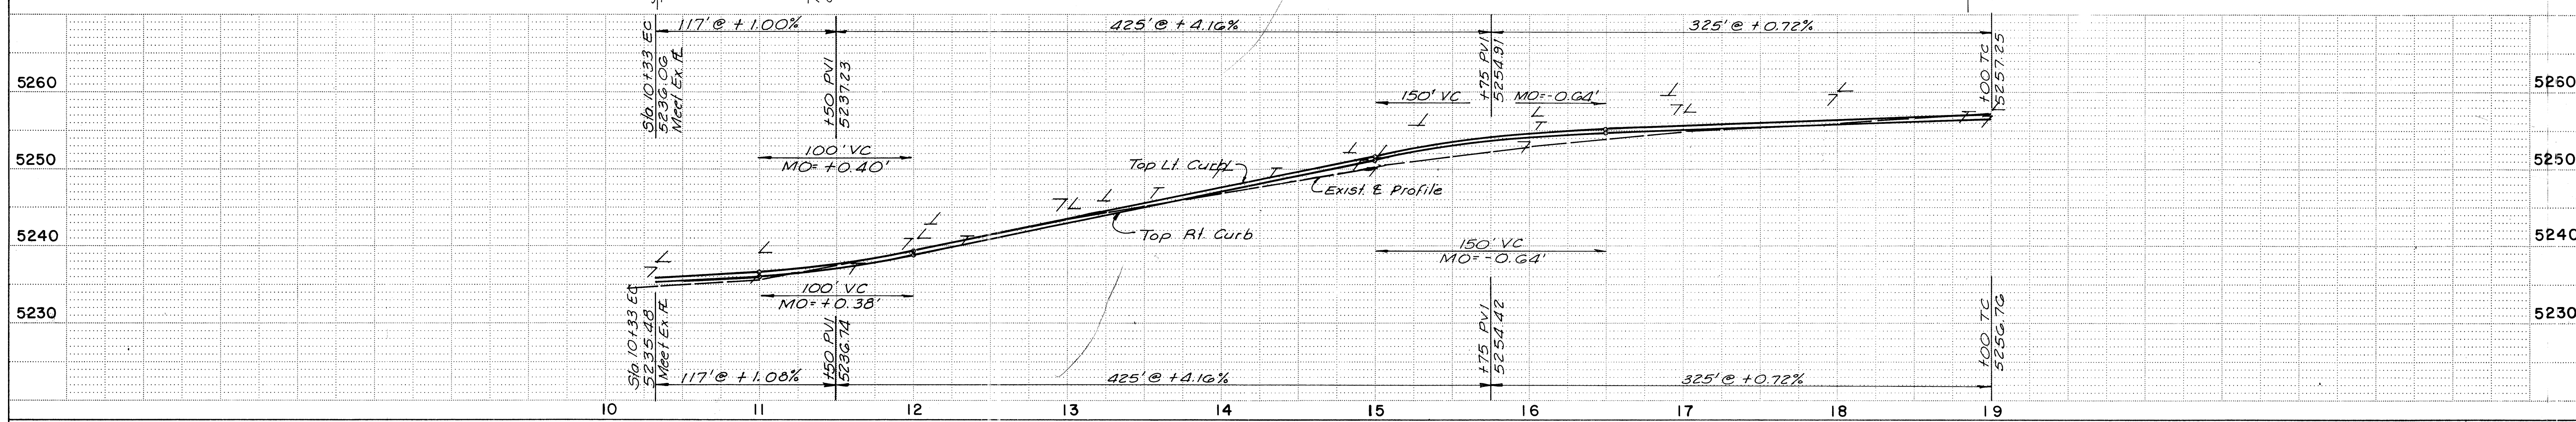


34TH. STREET

5/6

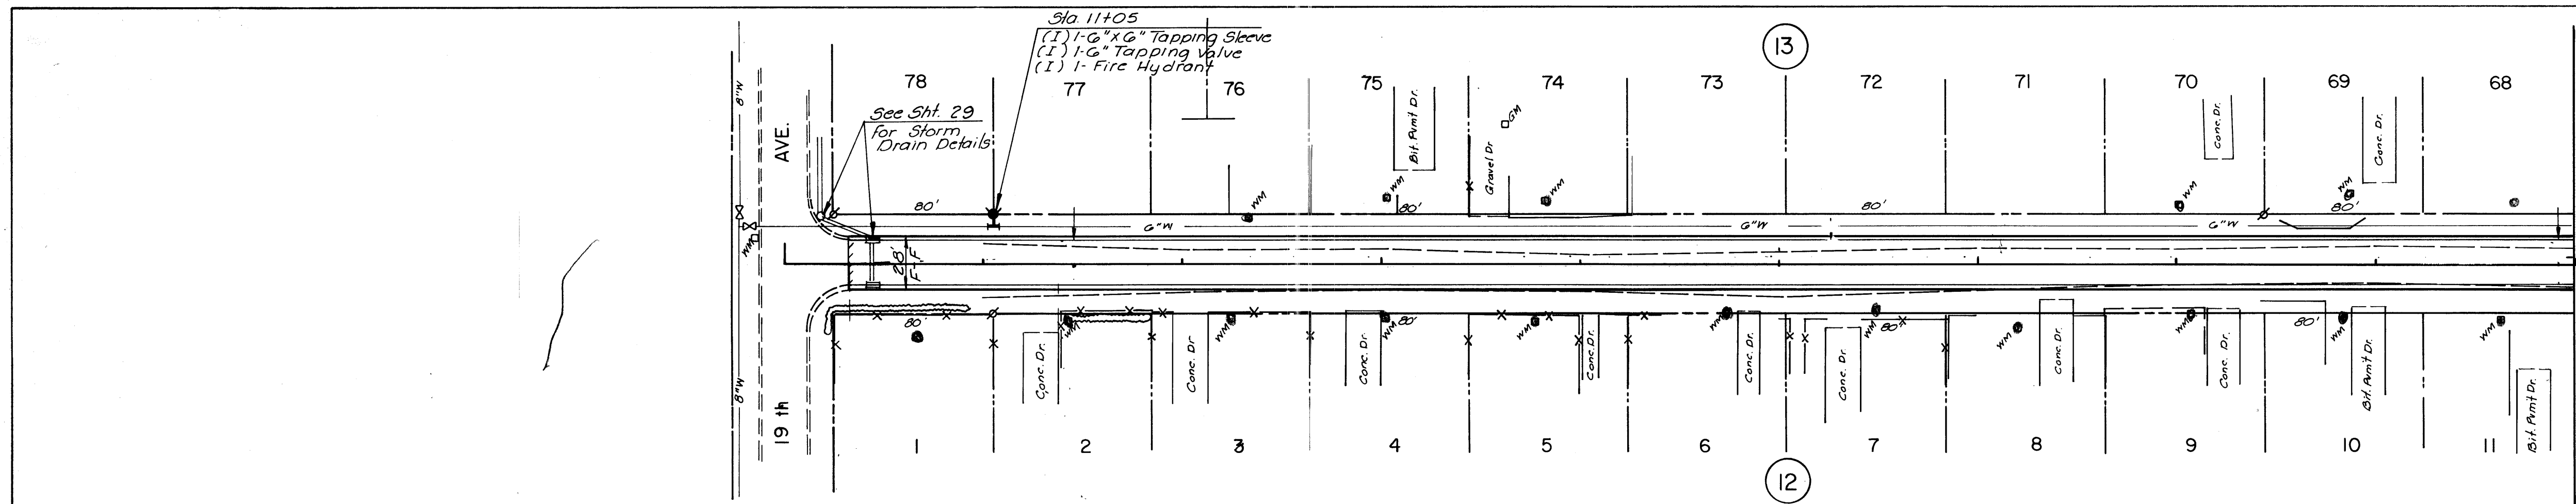

TOTAL 8

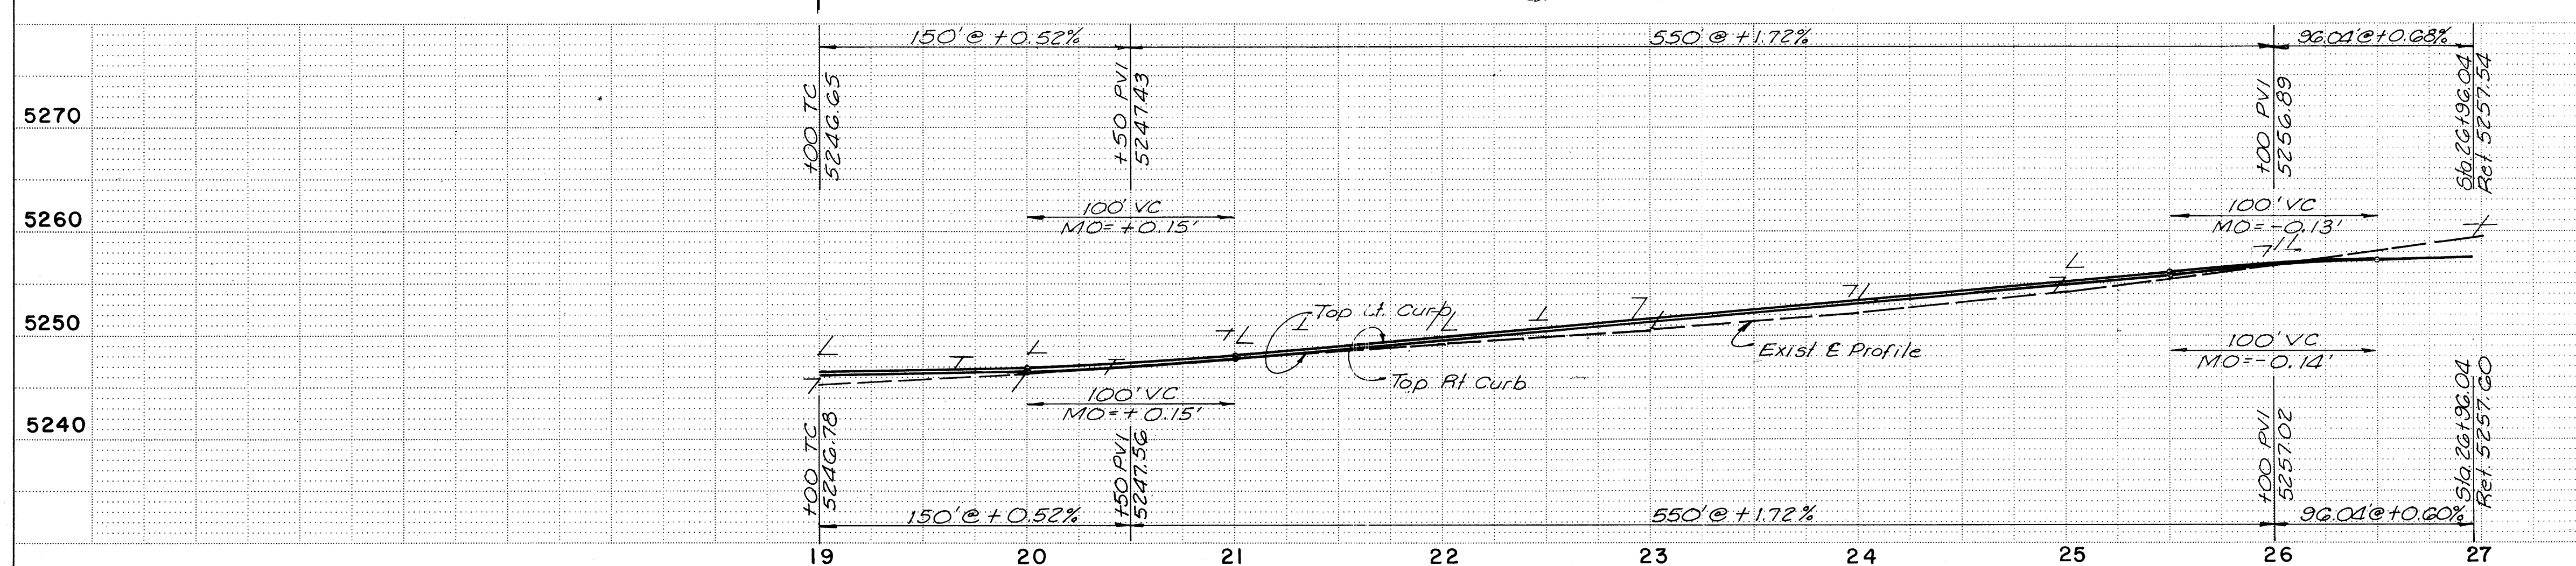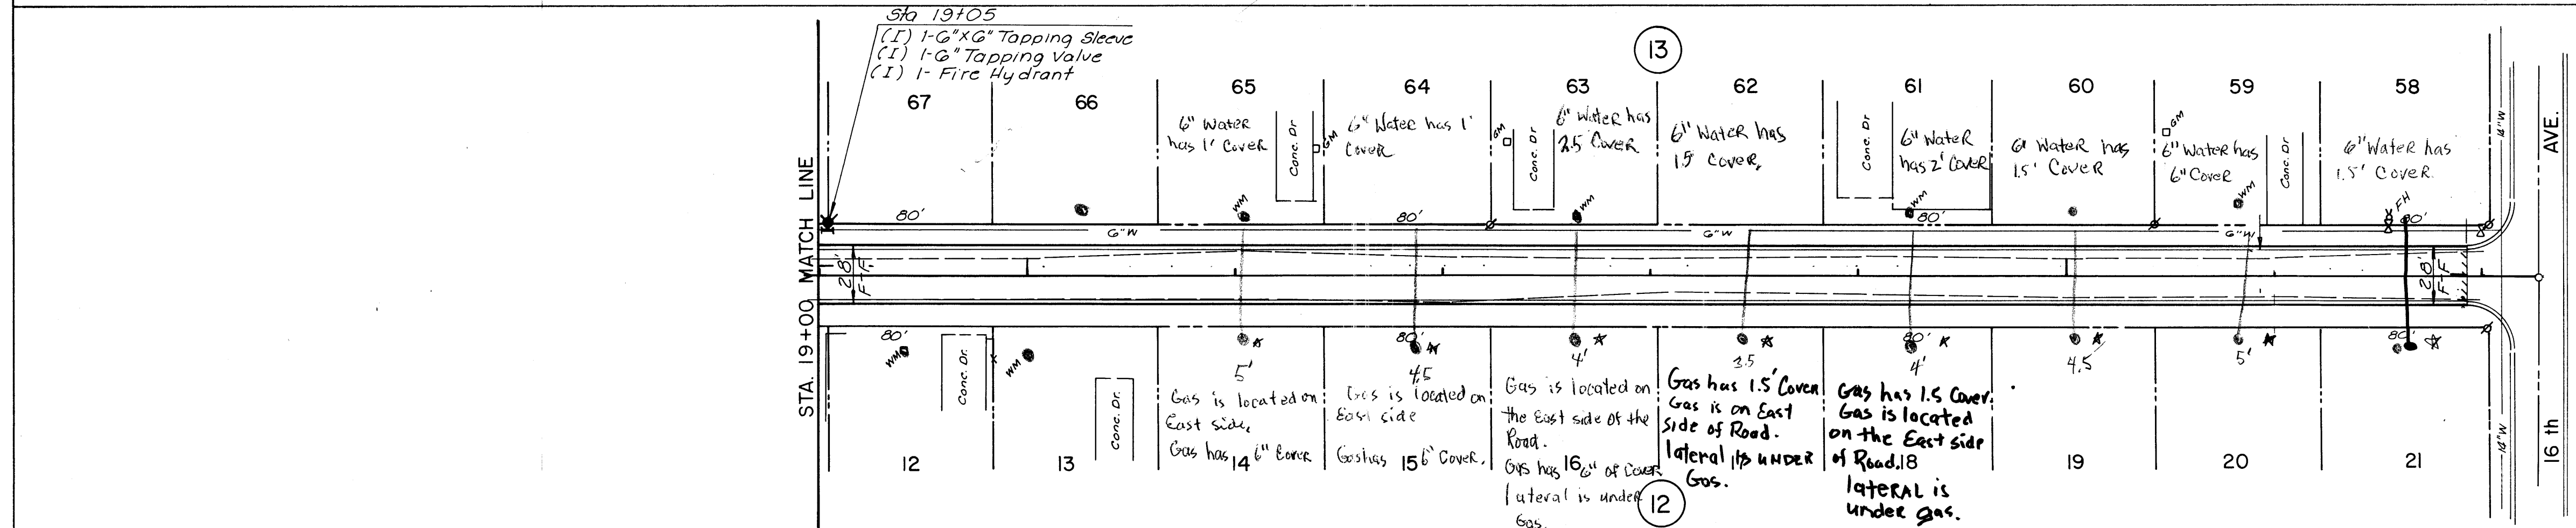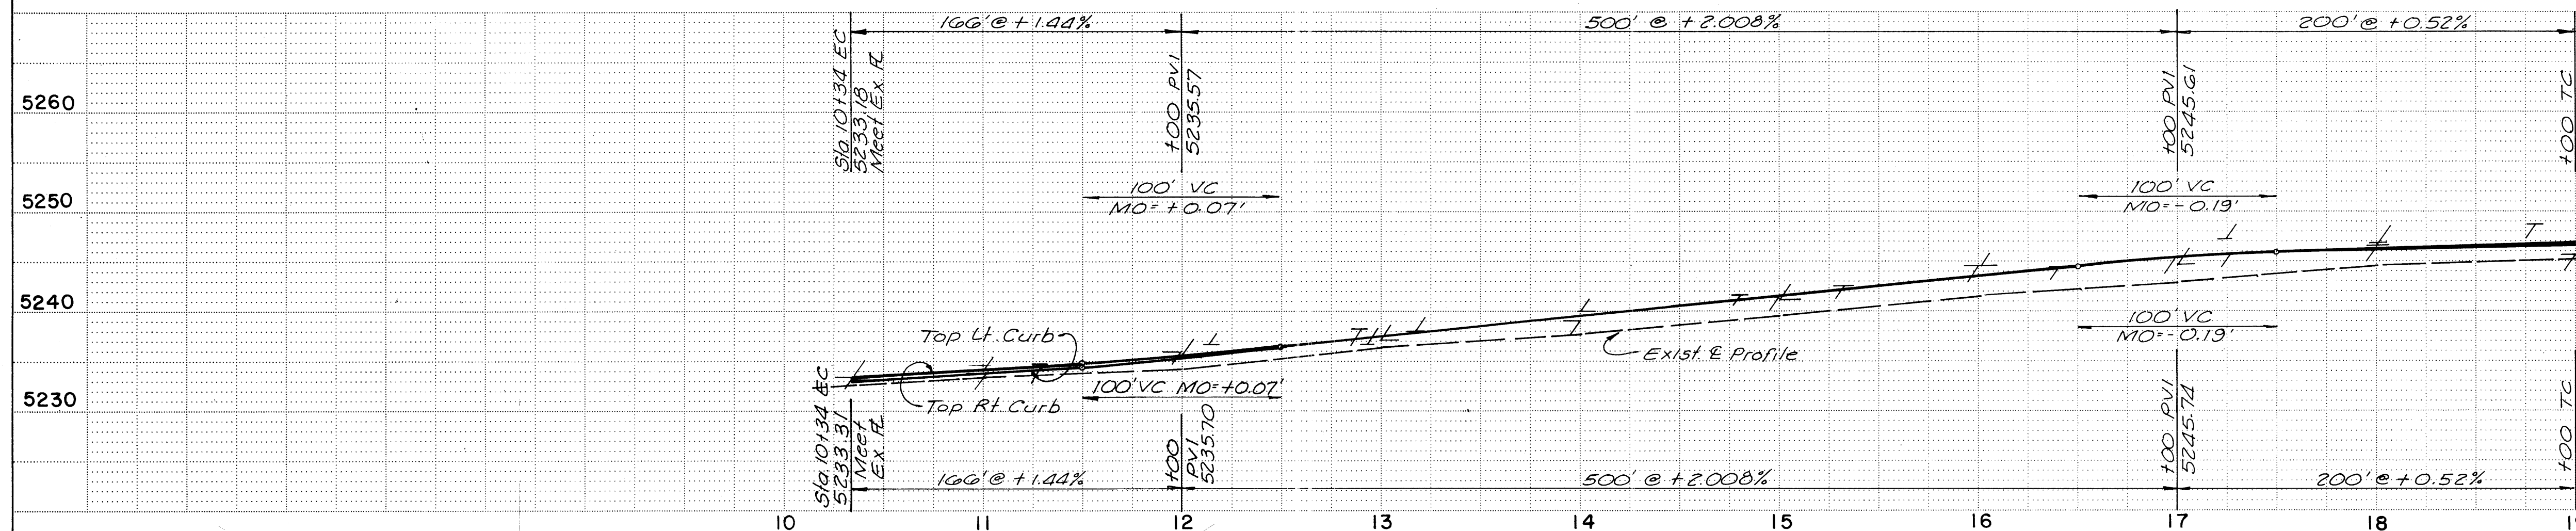

35TH. STREET

86-507

WILSON COMPANY
ENGINEERS ARCHITECTS
ALBUQUERQUE NEW MEXICO

SHEET 26 OF
34 SHEETS

ASSESSMENT DISTRICT NO. 3 RIO RANCHO, NEW MEXICO

