

**RIO RANCHO ESTATES**

**ALBUQUERQUE UTILITIES INC.**

**PLANS FOR CONSTRUCTION OF**

**WATER SYSTEM IMPROVEMENTS**

**PHASE -**

**PROJECT 1965-1966**

| 1965      |                                                                        |
|-----------|------------------------------------------------------------------------|
| SHEET NO. | DESCRIPTION                                                            |
| A.        | LOCATION PLAN                                                          |
| 1.        | 19TH AVE., 20TH AVE., 21ST AVE., & 22ND AVE.                           |
| 2.        | 33RD ST., 32ND ST., 31ST ST., & 30TH ST.                               |
| 3.        | 16TH AVE., 30TH CIRCLE, 37TH ST., & GRANDE BLVD.                       |
| 4.        | 23RD AVE., 30TH ST., 36TH ST., 35TH ST., & 34TH ST.                    |
| 5.        | 15TH ST., 31ST ST., 32ND ST., 32ND CIRCLE, 33RD CIRCLE, & 34TH CIRCLE. |
| 6.        | JANE CIRCLE, HAY CIRCLE, 14TH AVE., SUN CIRCLE, & ANN CIRCLE.          |
| 7.        | 35TH CIRCLE, 11TH AVE., 13TH AVE., 14TH AVE., 17TH AVE., & 18TH AVE.   |
| 8.        | SARA ROAD, SOUTHERN BLVD., & GAY CIRCLE.                               |
| 9.        | 28TH COURT, WALSH STREET, & 29TH ST.                                   |
| 10.       | 27TH ST., & 28TH STREET.                                               |
| 11.       | 25TH ST., & 26TH STREET.                                               |
| 12.       | WISCONSIN AVENUE                                                       |
| 13.       | PUMP HOUSE                                                             |
| 14.       | STEEL WATER TANK                                                       |

APPROVED BY:


ALBUQUERQUE UTILITIES INC. DATE

ENGINEER DATE




**D. F. MOLZEN & ASSOCIATES**  
Consulting Engineers  
ALBUQUERQUE NEW MEXICO

B7-C7

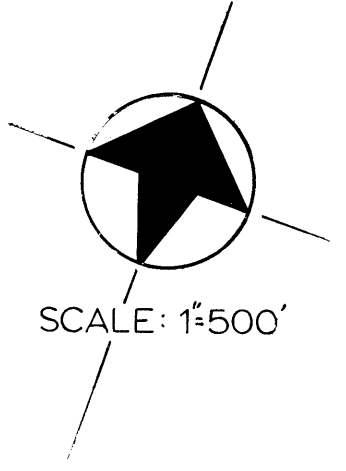

SCALE: 1"=500'

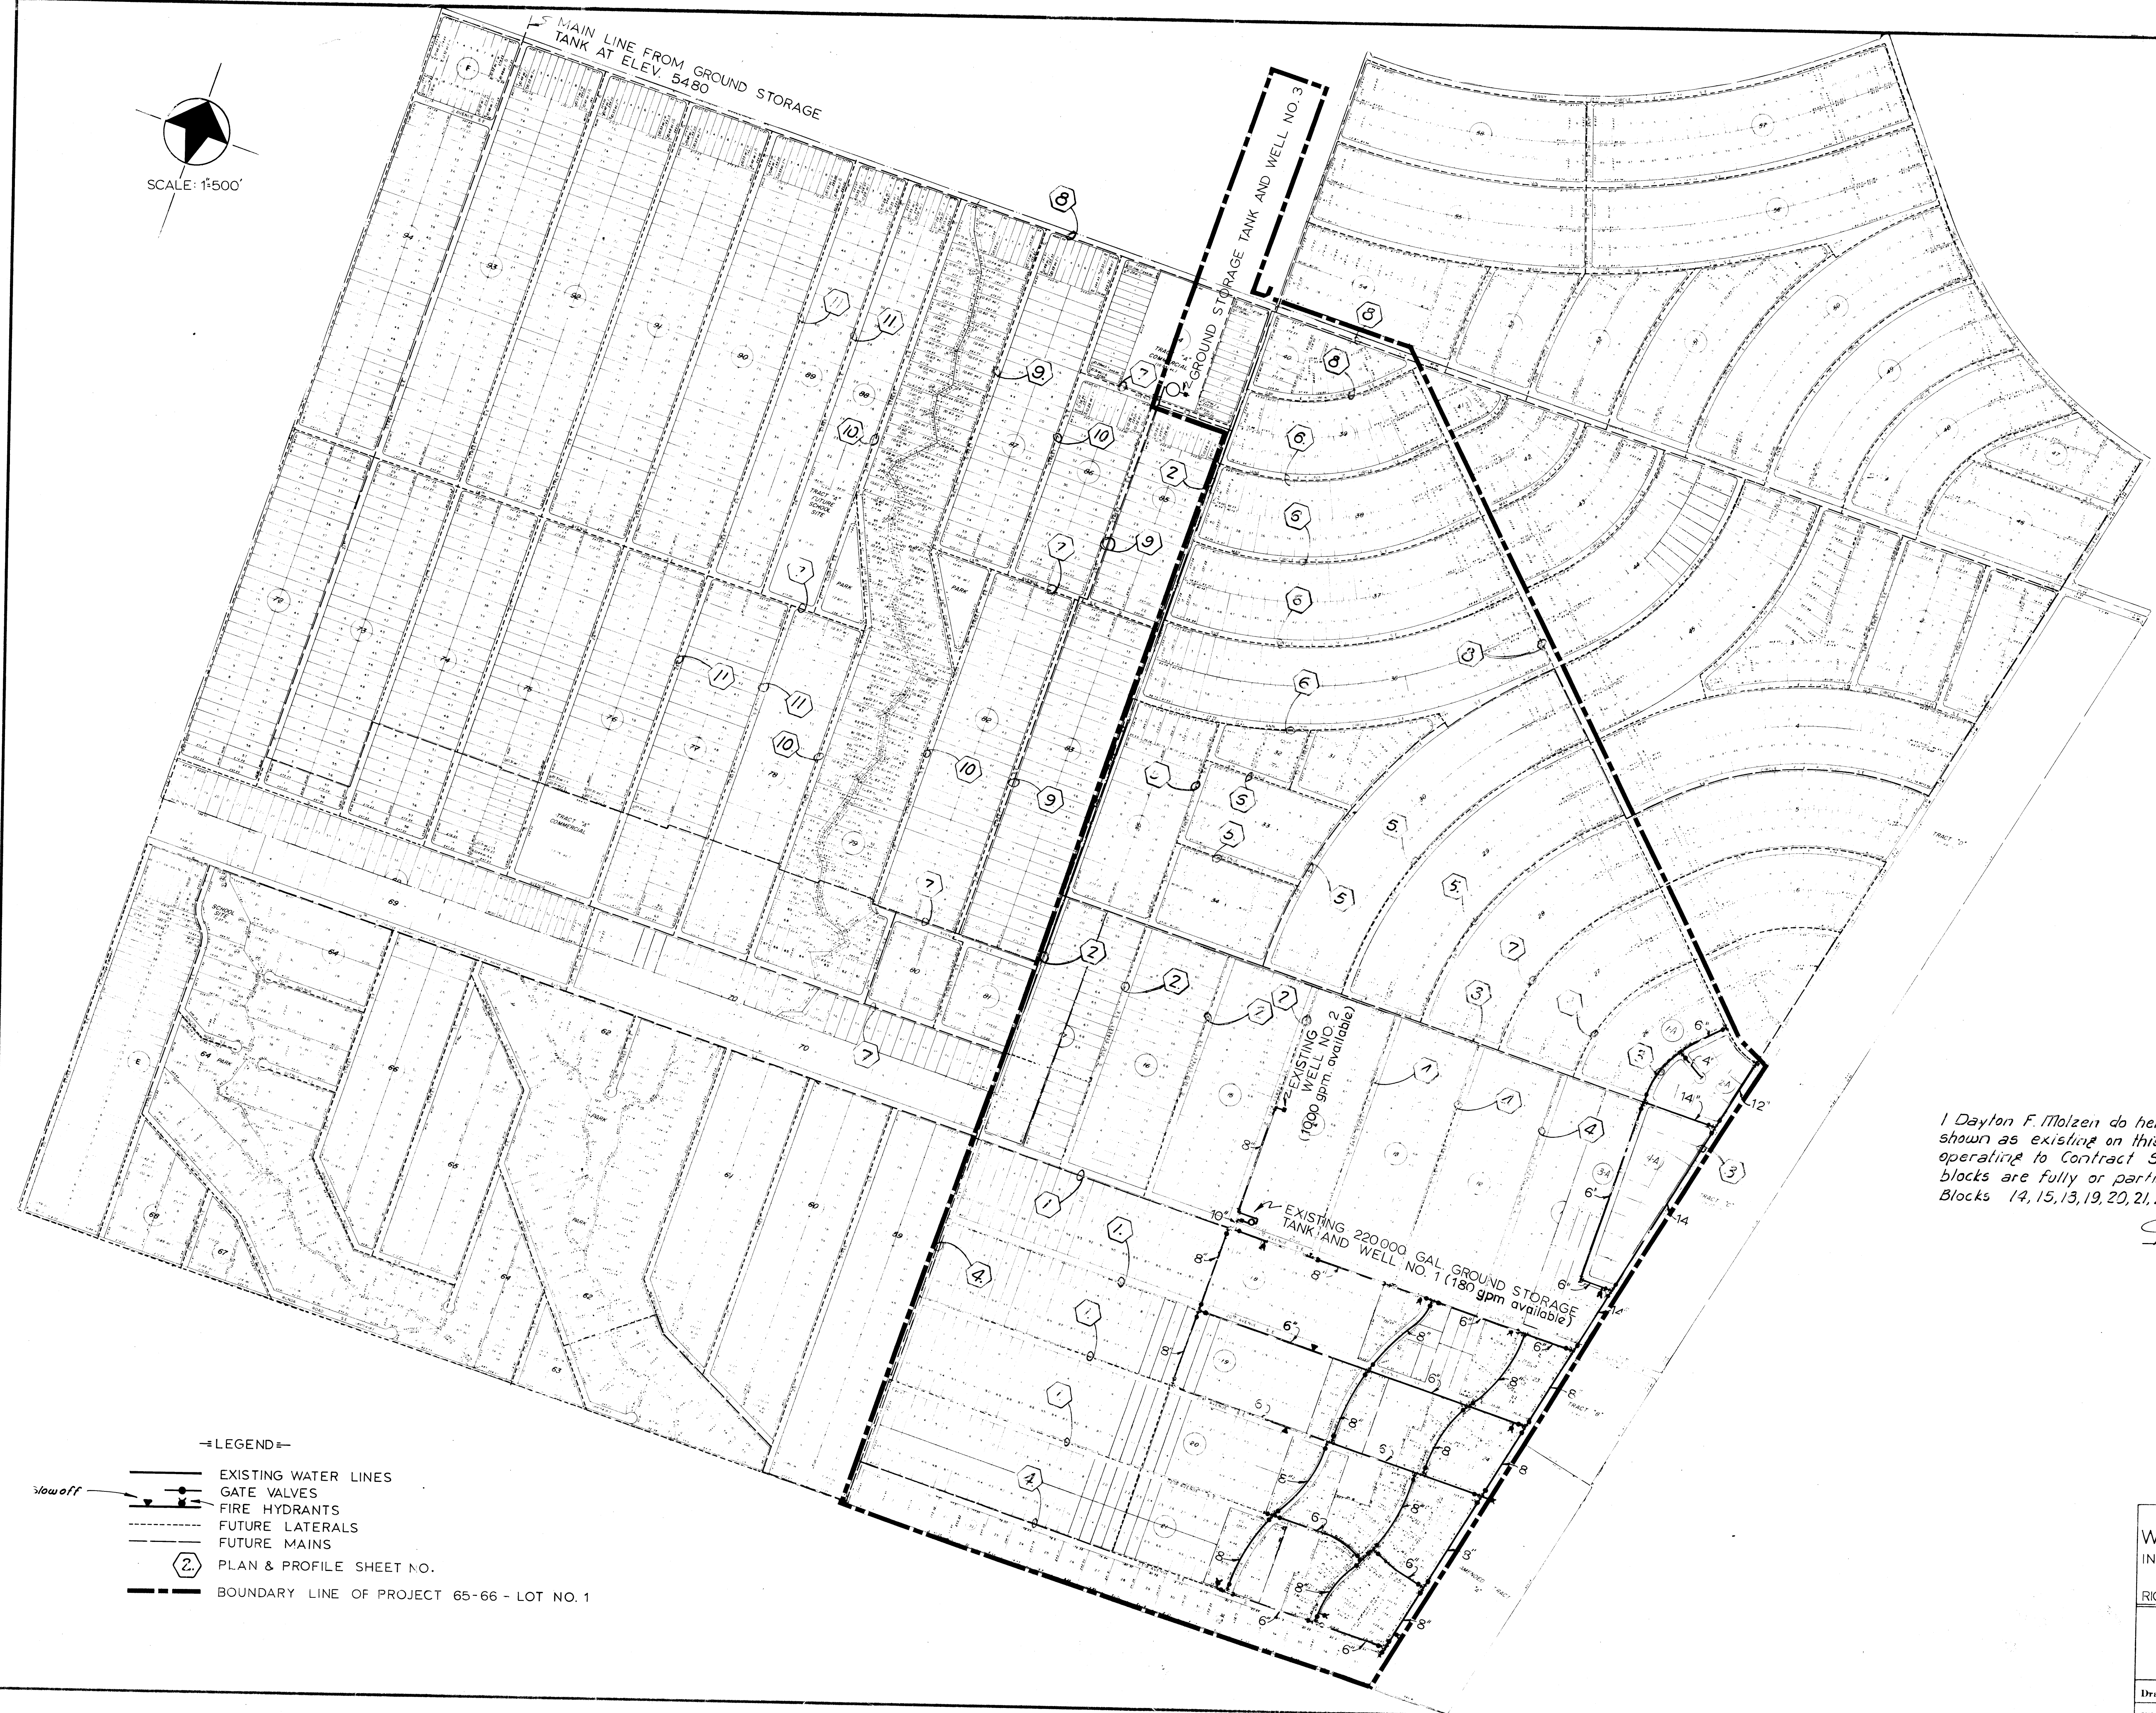

I Dayton F. Molzen do hereby certify that all water lines shown as existing on this drawing are installed and operating to Contract Specifications and the following blocks are fully or partially serviced by these lines: Blocks 14, 15, 13, 19, 20, 21, 22, 23, 24, 25, and 3a, 4a, 2a, & 1a

*Dayton F. Molzen* 6/10/65  
Dayton F. Molzen RE&LS Date  
178 180°

—LEGEND—

- EXISTING WATER LINES
- GATE VALVES
- FIRE HYDRANTS
- FUTURE LATERALS
- FUTURE MAINS
- ② PLAN & PROFILE SHEET NO.
- BOUNDARY LINE OF PROJECT 65-66 - LOT NO. 1



LOCATION PLAN

ALBUQUERQUE UTILITIES INC.  
WATER SYSTEM-MASTER PLAN  
IN SOUTHWESTERLY & WESTERLY PORTIONS  
OF UNIT 16  
RIO RANCHO ESTATES



**D. F. MOLZEN & ASSOCIATES**  
Consulting Engineers  
ALBUQUERQUE NEW MEXICO

|                |              |       |
|----------------|--------------|-------|
| Drawn Spinello | Checked DFM. | Sheet |
| File 62-14     | Date 12-64   | 1     |

|                  |                                |          |            |
|------------------|--------------------------------|----------|------------|
| <b>PROFILE</b>   | SURVEYED _____                 | BY _____ | DATE _____ |
| <b>NOTE BOOK</b> | PLOTTED _____                  |          |            |
|                  | GRADES CHECKED _____           |          |            |
|                  | B, M : NOTED _____             |          |            |
| <b>NO.</b> _____ | STRUCTURE NOTATION SHOWN _____ |          |            |

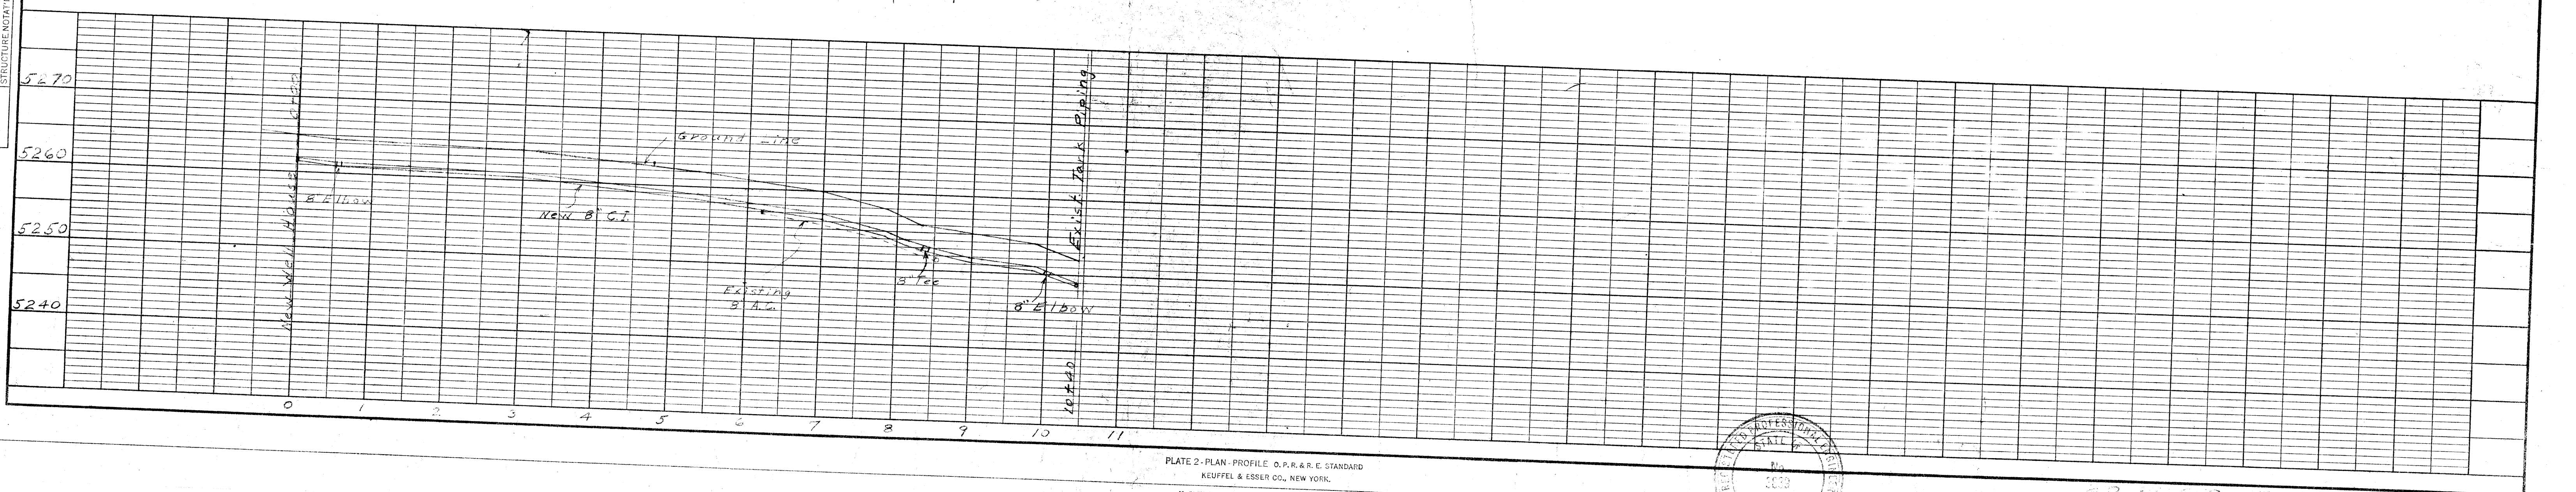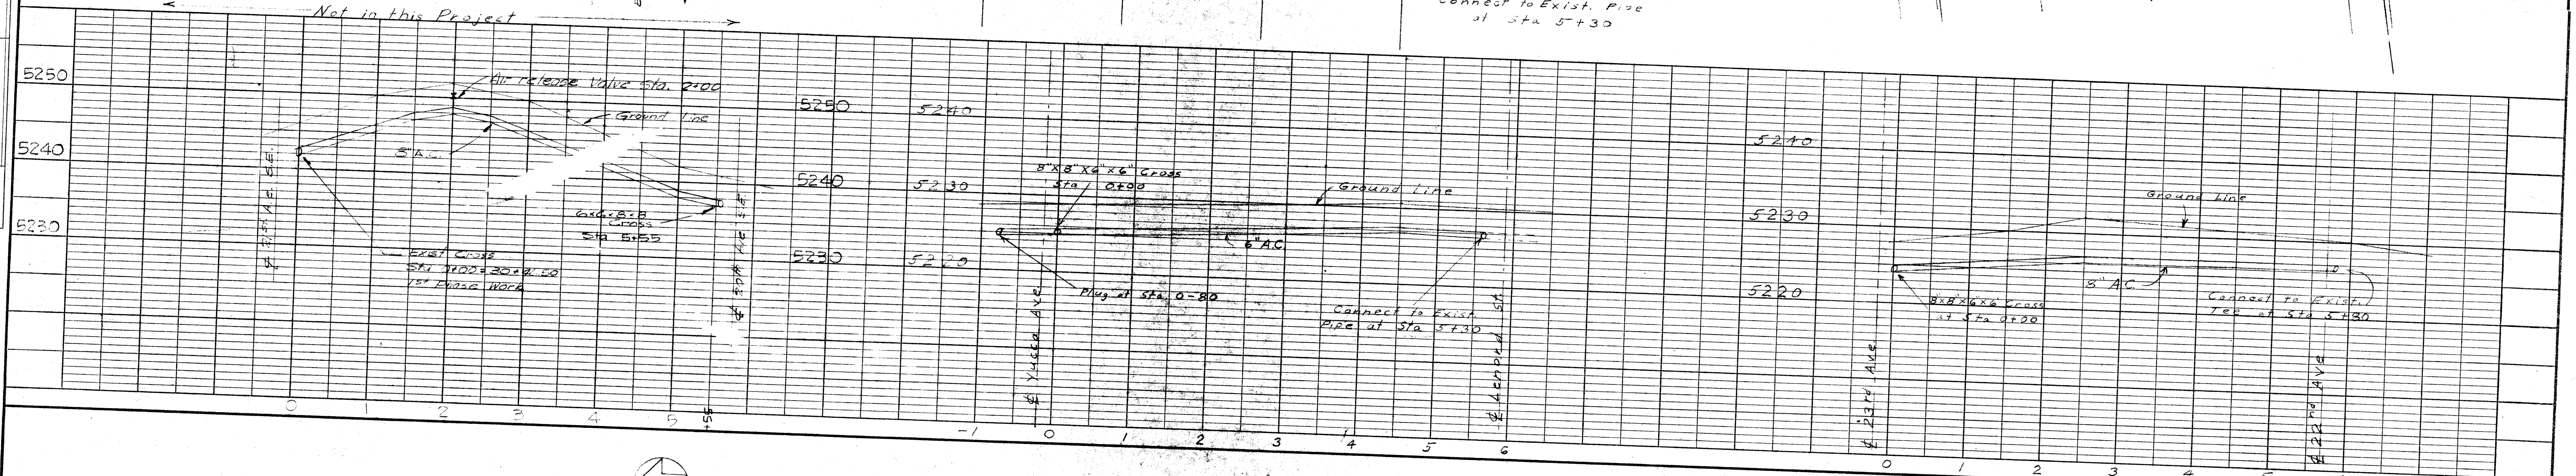

| PROFILE        |                          | BY | DATE |
|----------------|--------------------------|----|------|
| SURVIVED       |                          |    |      |
| PLOTTED        |                          |    |      |
| NOTE BOOK      |                          |    |      |
| GRADES CHECKED |                          |    |      |
| B. M.s NOTED   |                          |    |      |
| NO.            | STRUCTURE NOTAT'NS CHKD. |    |      |

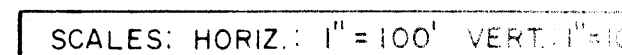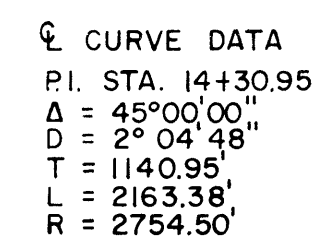


PRINTED 9/17/70  
FOR MR. BRYANT

|                  |                               |
|------------------|-------------------------------|
| DATE JAN 87      | RIO RANCHO ESTATES            |
| PROJECT NO. 69-1 | PAVEMENT IMPROVEMENT          |
| SHEET            | FROM SARA ROAD TO 16TH AVENUE |
|                  | 33RD CIRCLE                   |

|      |                    |      |
|------|--------------------|------|
| PLAN | SURVEYED           | DATE |
|      | PLOTTED            | BY   |
|      | ALIGNMENT CHECKED  |      |
|      | RT. OF WAY CHECKED |      |
| NO.  |                    |      |

|         |                           |      |
|---------|---------------------------|------|
| PROFILE | SURVEYED                  | DATE |
|         | PLOTTED                   | BY   |
|         | GRADES CHECKED            |      |
|         | STRUCTURE NOTATIONS CHKD. |      |
| NO.     |                           |      |

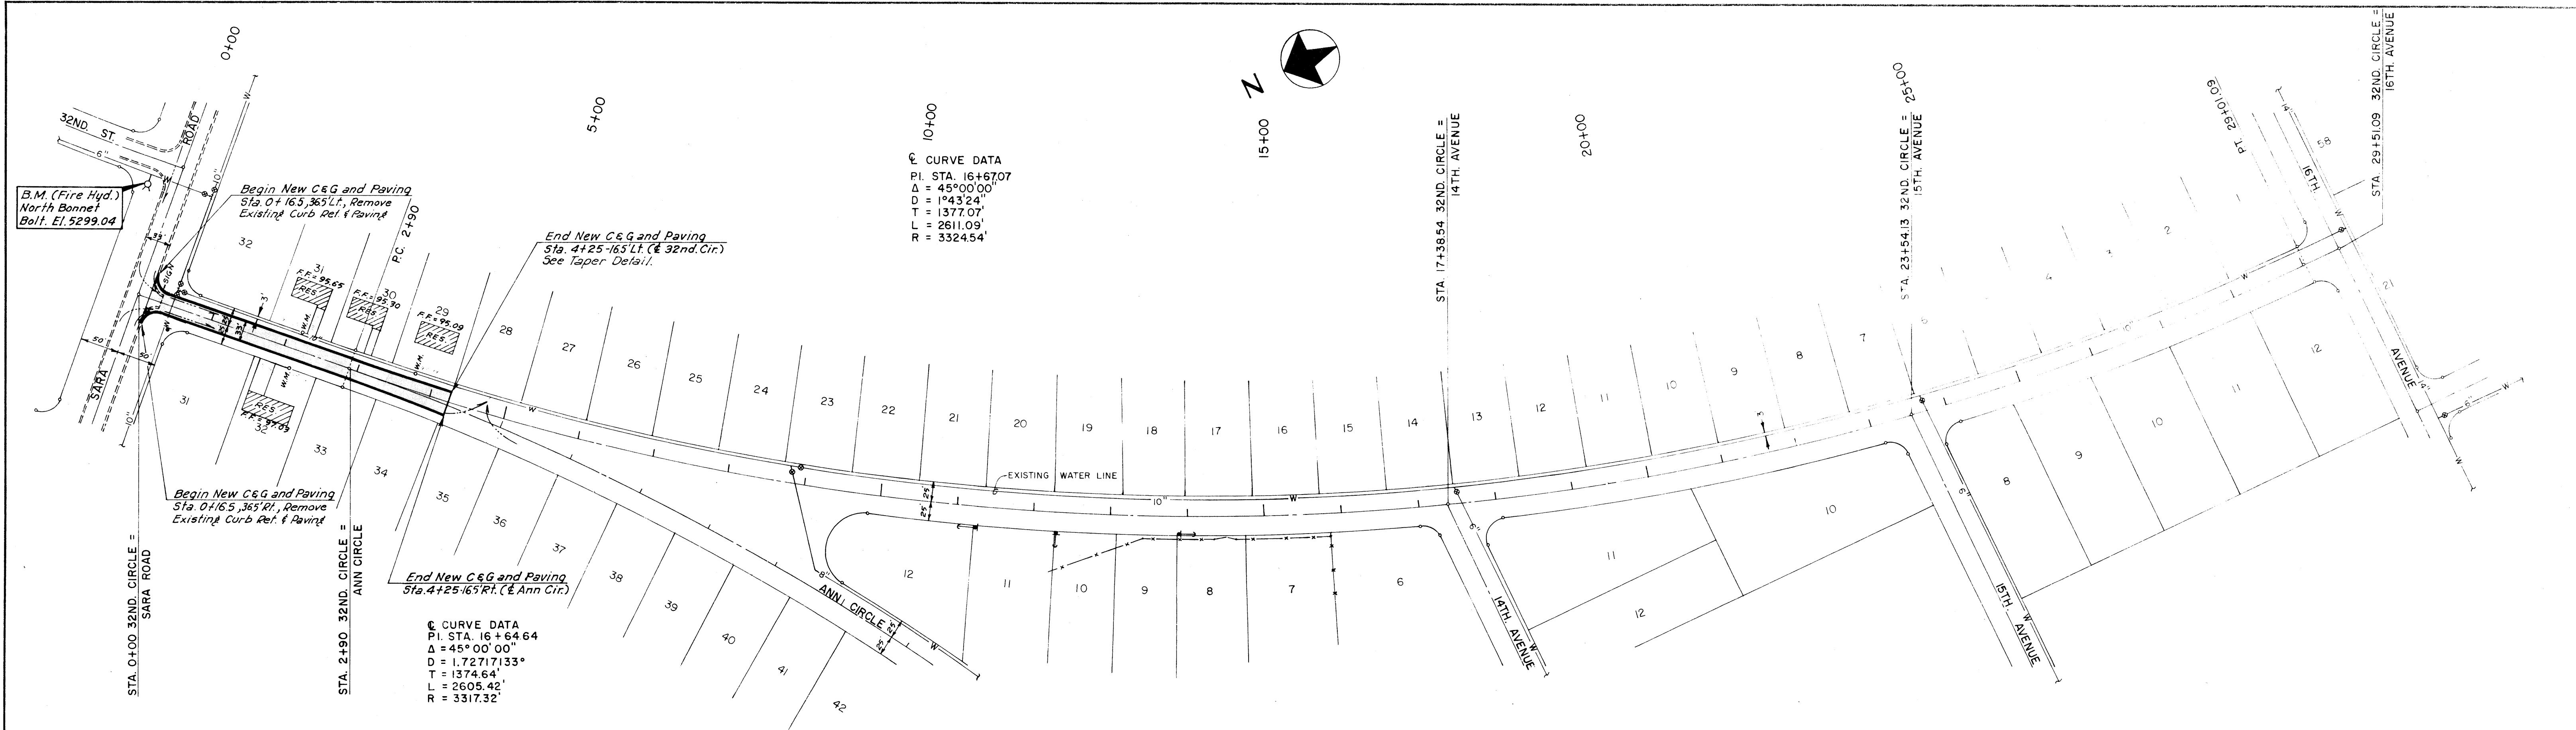

### 32ND CIRCLE

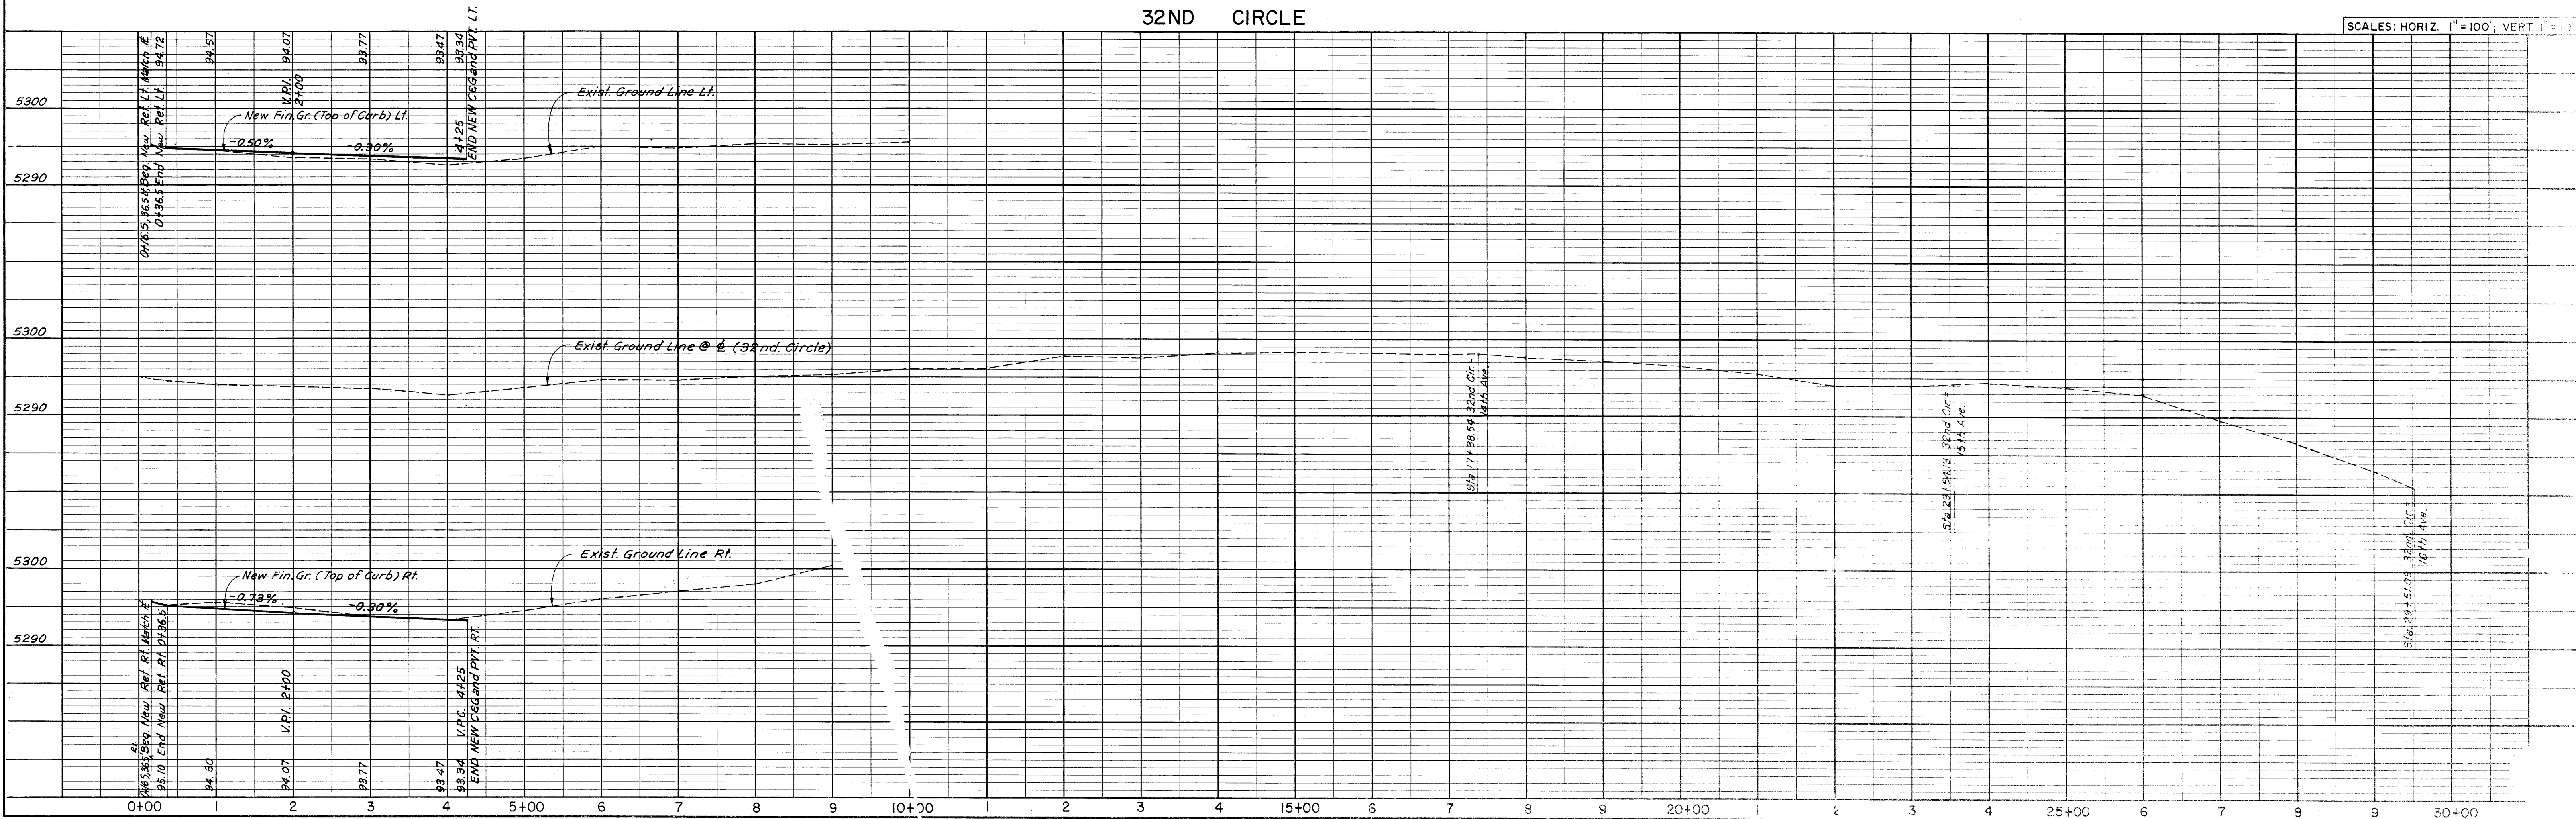


PLATE 1-PLAN-PROFILE O. P. R. R. E.  
 MADE AND PRINTED IN U.S.A.  
 CHARLES BEIRING COMPANY

PRINTED FOR  
 MR BA - 9/17/70

DATE: JAN 1970  
 PROJ. NO. 69-3  
 SHEET  
 RIO RANCHO ESTATES  
 PAVEMENT IMPROVEMENT  
 FROM SARA ROAD TO 16TH AVE