
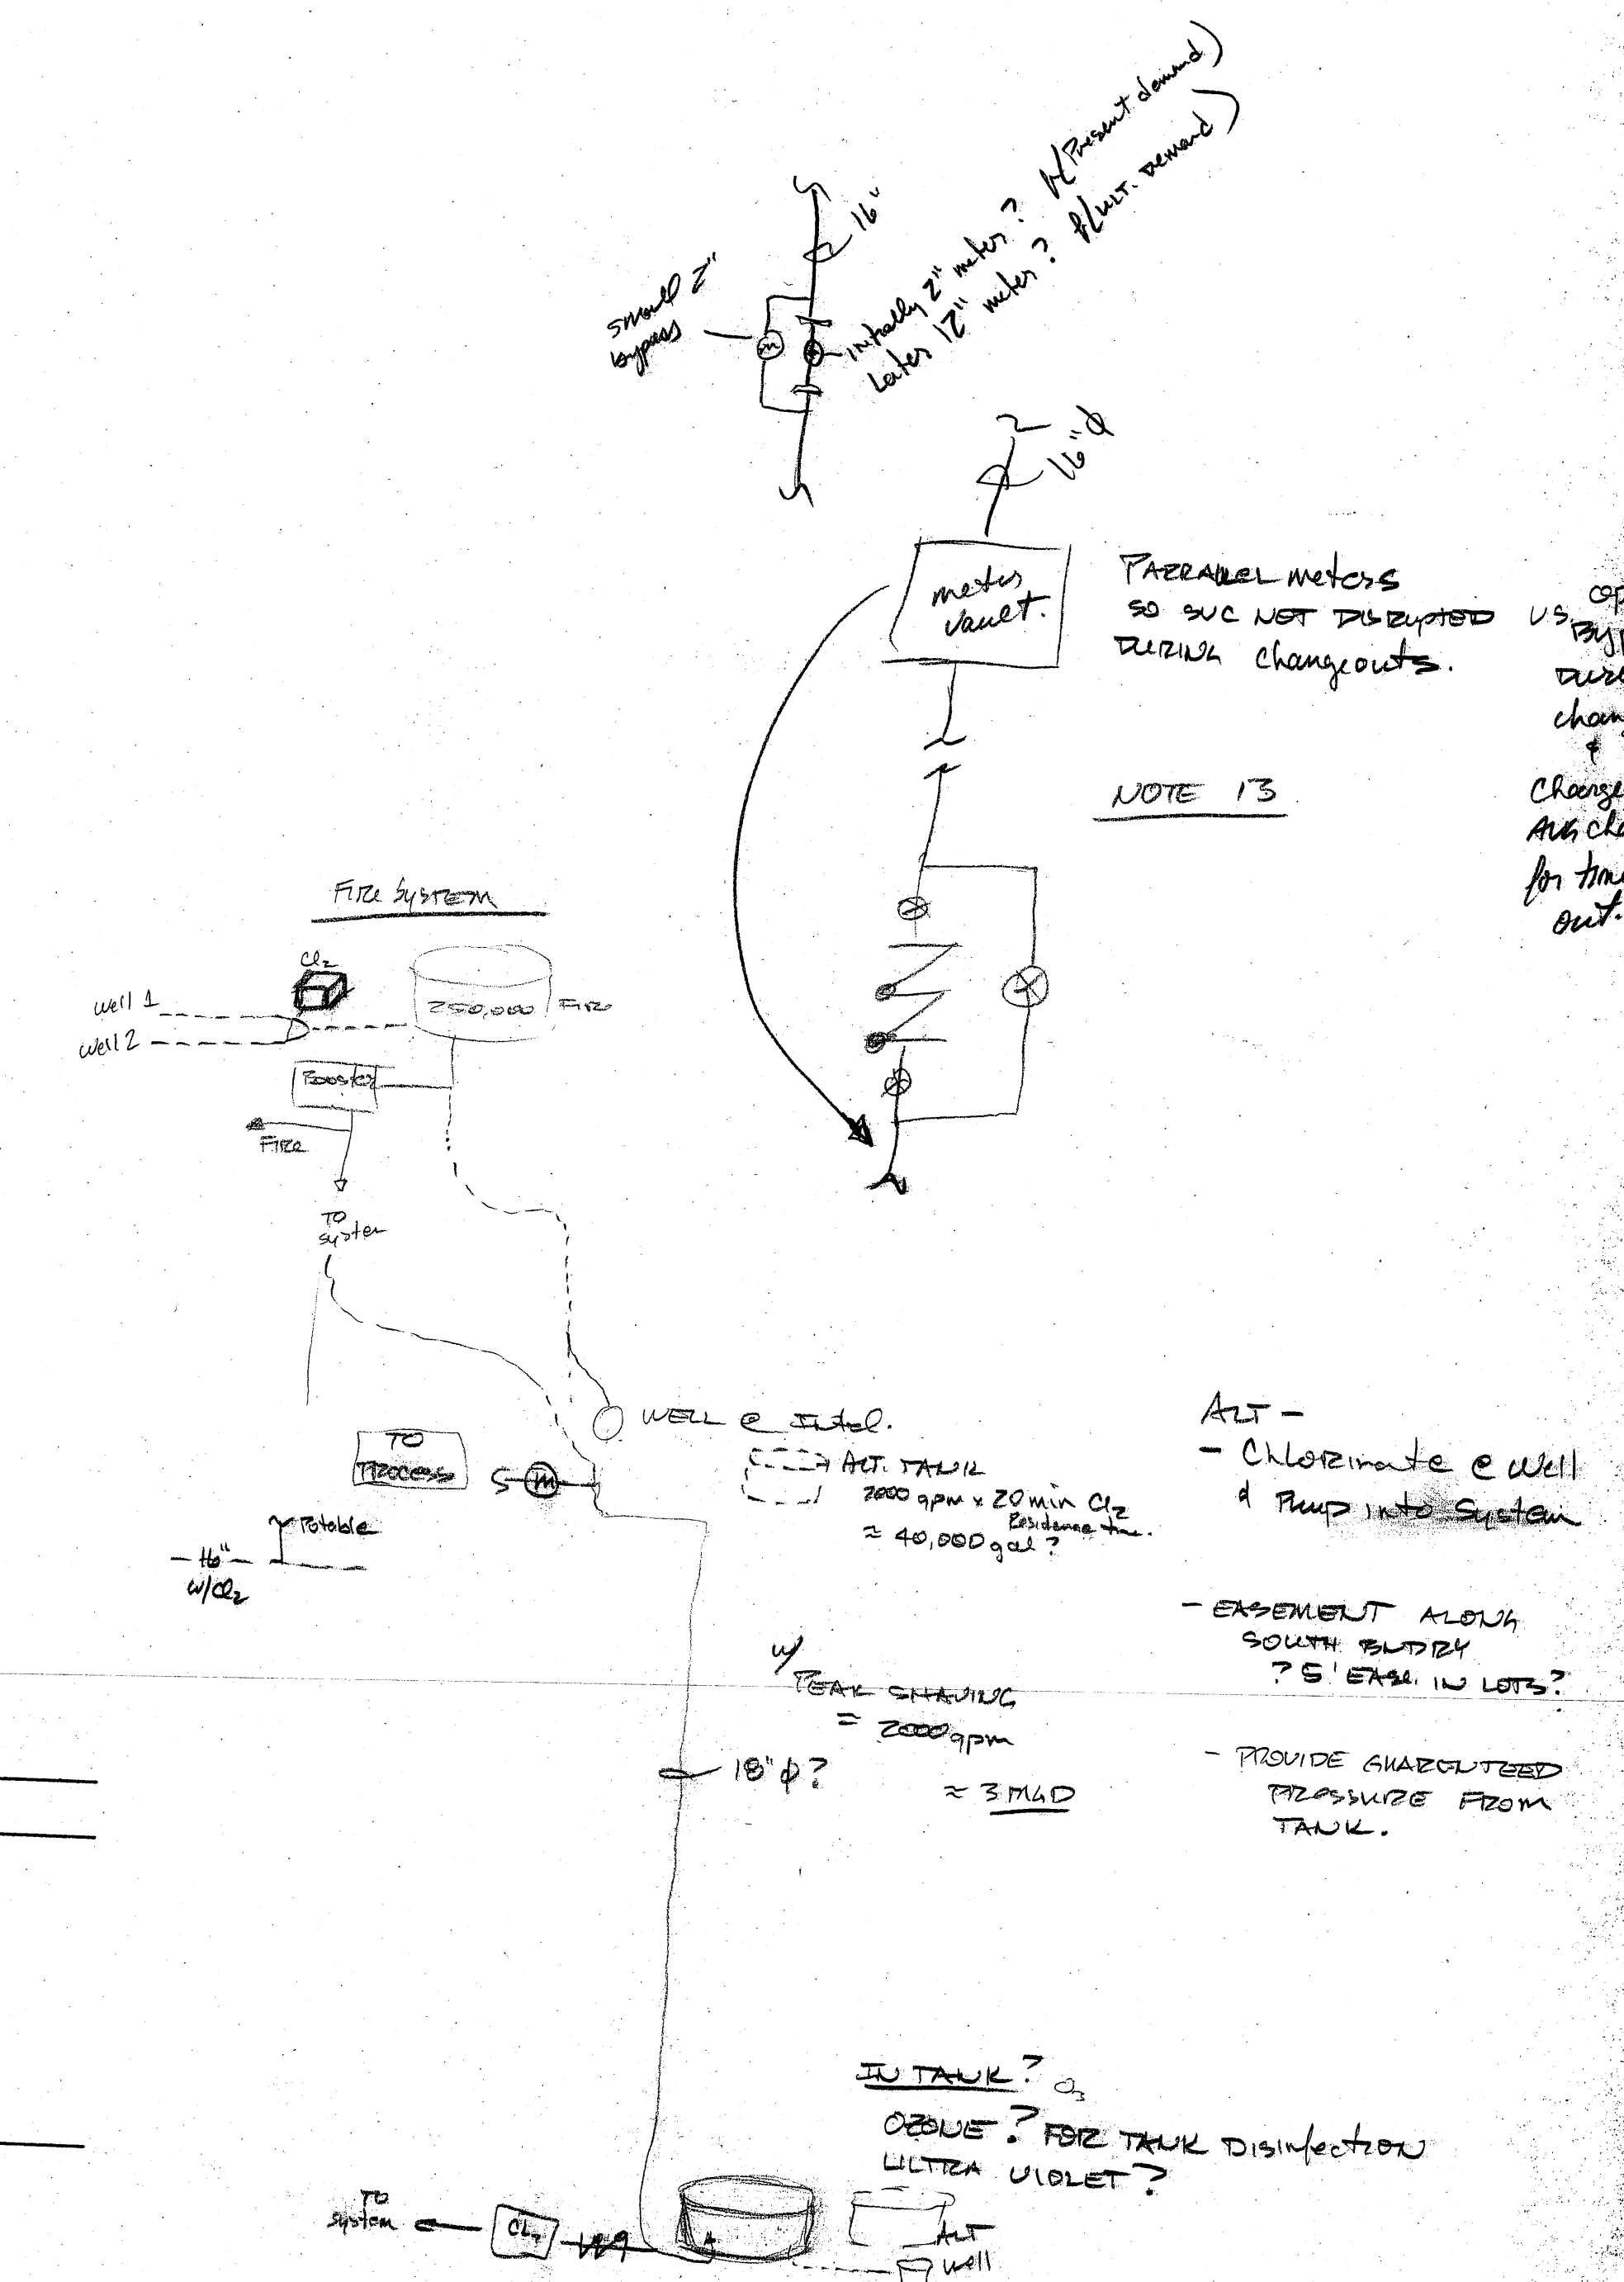


LEGEND

EXISTING POTABLE WATER LINE	---	CW
NEW POTABLE WATER LINE	---	CW
EXISTING SAN. SEWER LINE	---	SAN
NEW SAN. LINE	---	SAN
EXISTING STORM SEWER	---	SS
NEW STORM SEWER	---	SS
EXISTING COMM. LINE	---	COMM
NEW COMM. LINE	---	COMM
EXISTING ELECTRICAL LINE	---	E
NEW ELECTRICAL LINE	---	E
EXISTING ELECTRICAL LINE	---	IRR
EXISTING SAN. SEWER MANHOLE	●	
NEW SAN. SEWER MANHOLE	●	

KEYED NOTES

1. CONNECT TO EXISTING 16" POTABLE WATER LINE.
2. INSTALL 16" PVC.
3. CONTRACTOR SHALL JACK AND BORE UNDER ROADWAY TO INSTALL WATERLINE. SEE DETAIL SHEET.
4. INSTALL 16" x 4" TEE, 4" GATE VALVE WITH VALVE BOX.
5. CONNECT TO EXISTING SANITARY SEWER MANHOLE.
6. INSTALL 16" x 16" x 16" TEE.
7. INSTALL 6" PVC SAN. SEWER LATERAL.
8. REFER TO ELECTRICAL PLAN, SHEET TSE1.00 FOR COMMUNICATION LINE.
9. REFER TO ELECTRICAL PLAN, SHEET TSE1.00 FOR OVERHEAD POWER-LINE.
10. INSTALL 4" SANITARY MANHOLE PER DETAIL.
11. INSTALL 16" BUTTERFLY VALVE WITH VALVE BOX AND CONCRETE BLOCKING.
12. REFER TO SITE LAYOUT PLAN SHEET TSC300 FOR PAVEMENT PATCHING DETAIL.
13. CONCRETE BUNKER WITH 16" AIMES STAINLESS STEEL BACKFLOW PREVENTOR AND 16" BUTTERFLY VALVE.
14. INSTALL 16" CAP AND CONCRETE BLOCKING FOR FUTURE CONNECTION.
15. INSTALL 8" PVC SANITARY SEWER MAIN.

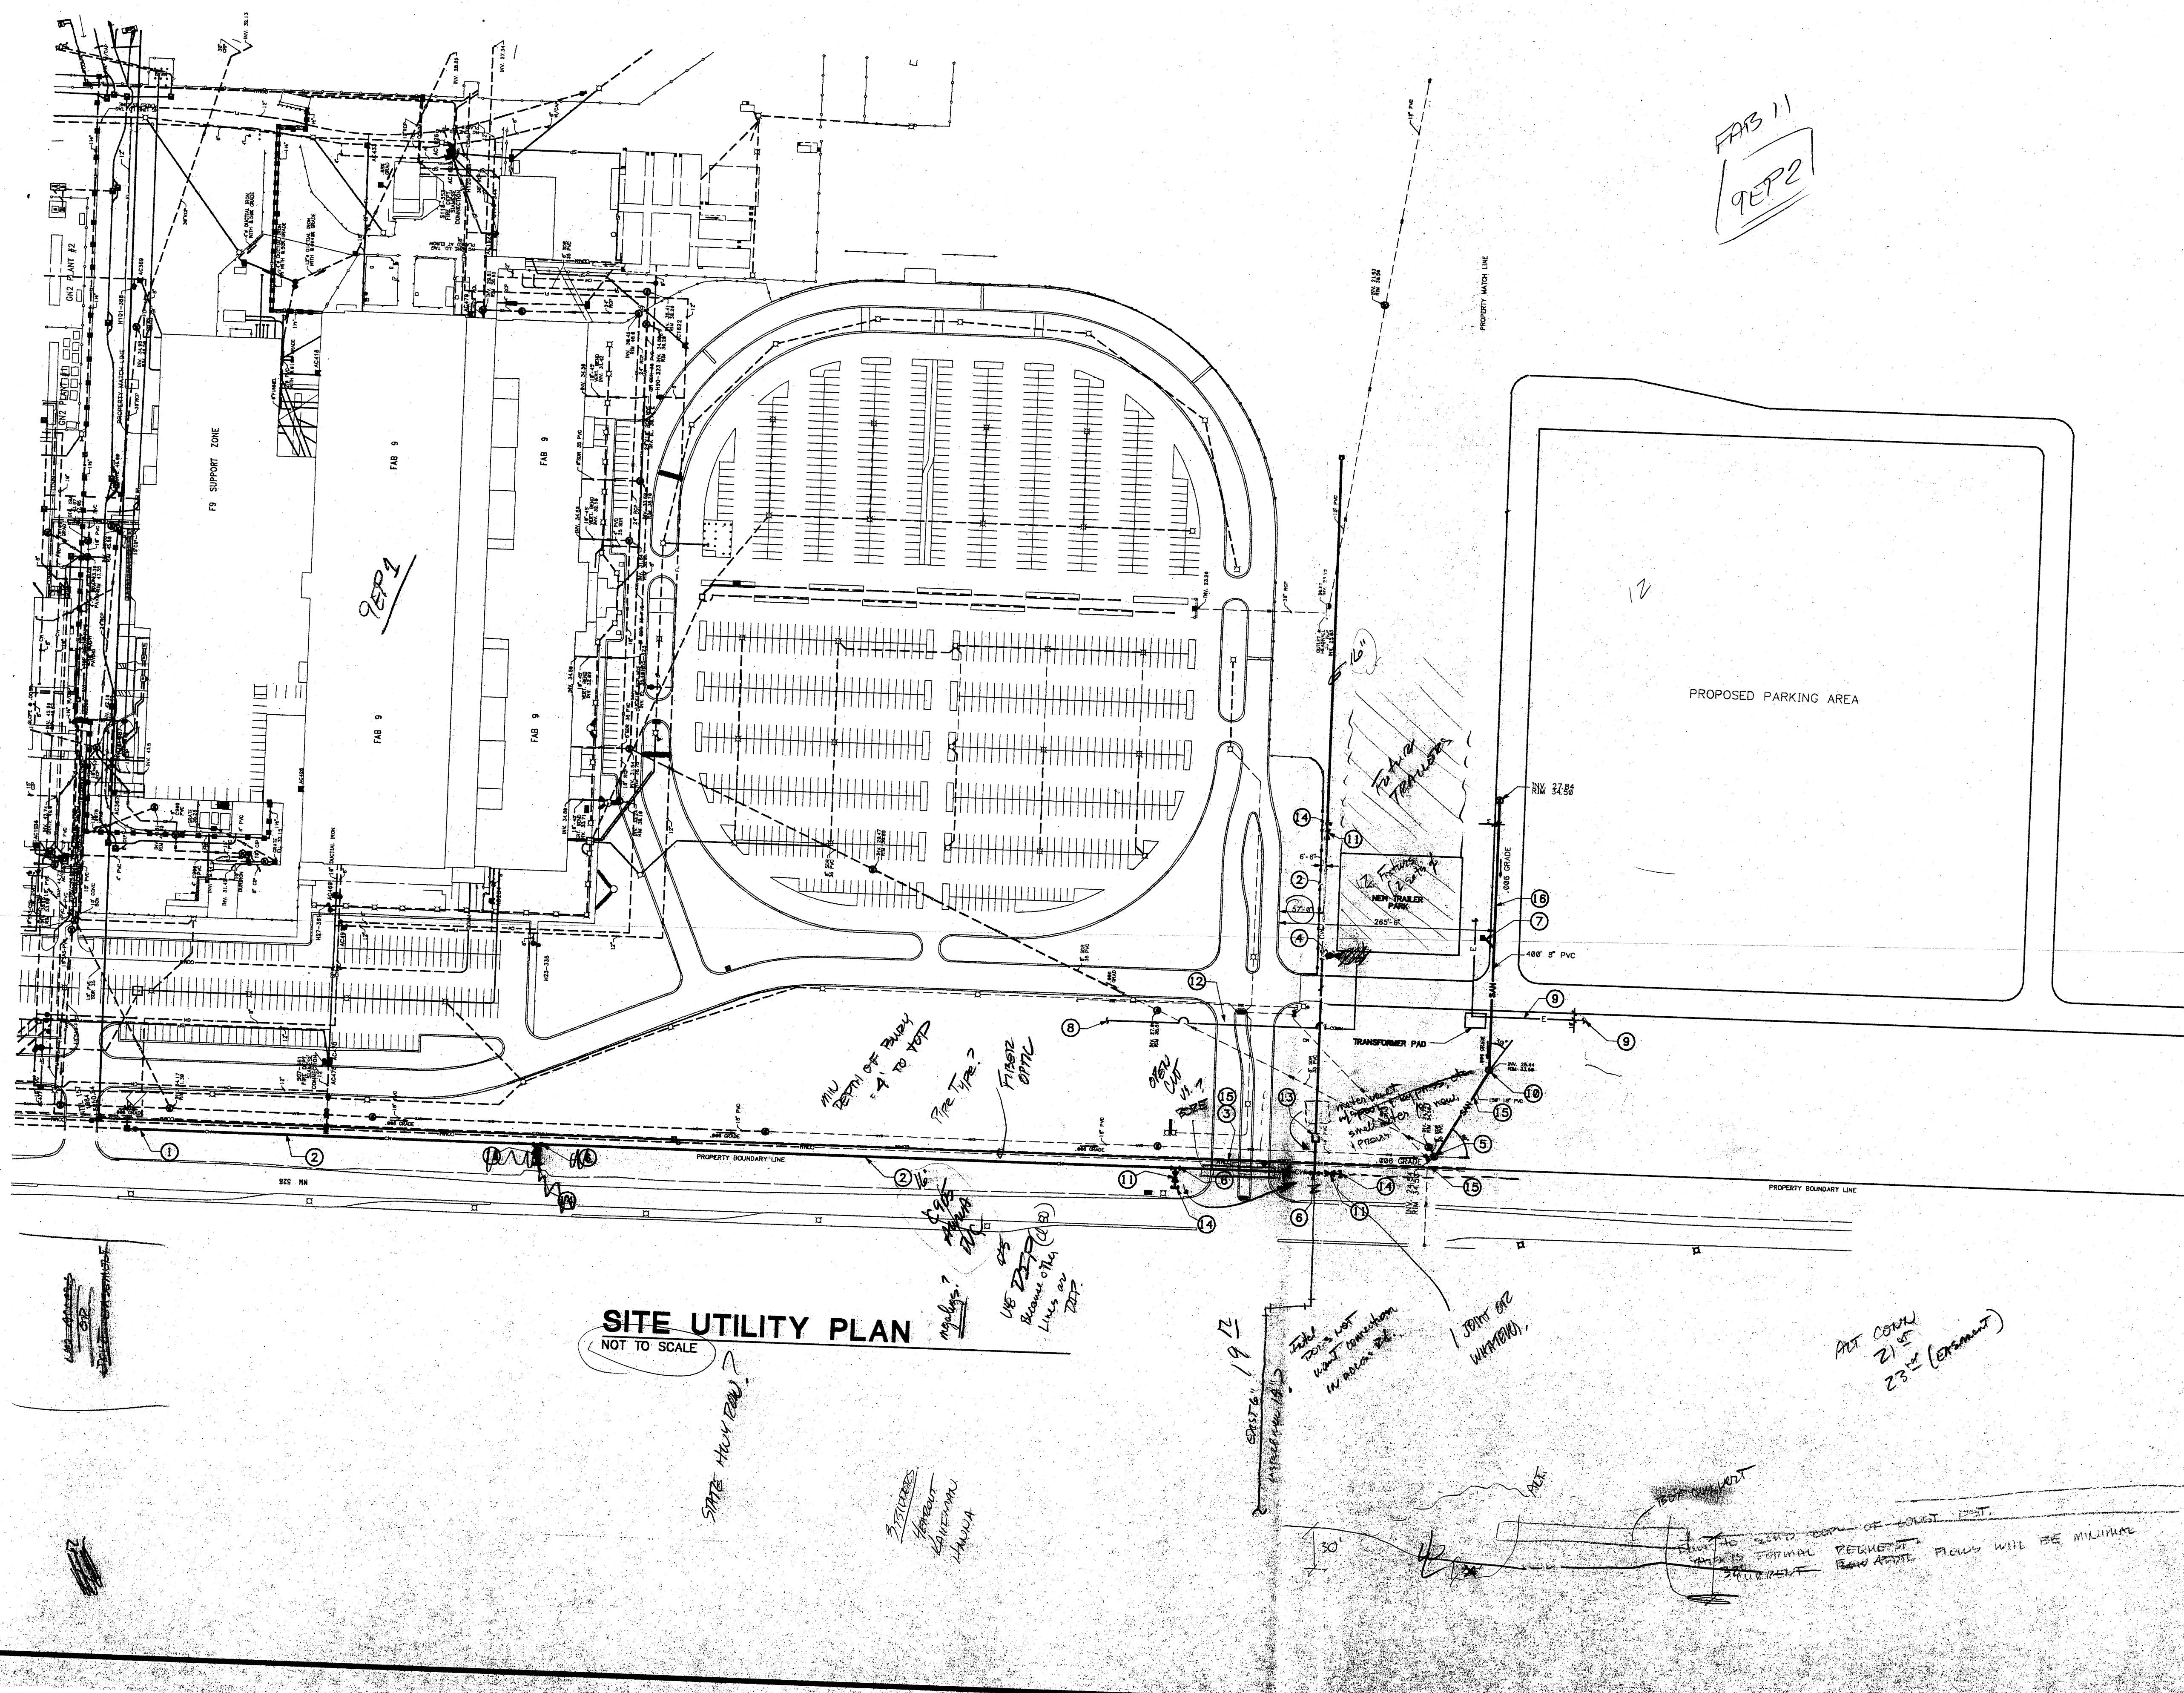

SITE UTILITY PLAN

(NOT TO SCALE)

CHAVEZ / GRIEVES / CONSULTING ENGINEERS INC. 4600 MONTGOMERY N.E., BLDG. C, #101 ALBUQUERQUE, N.M. 87109 (505) 881-7376 FAX (505) 883-7119		02-10-93 DATE
NEW MEXICO FACILITIES CONSTRUCTION INTEL, New Mexico CORPORATION 4180 San Jose SE Rio Rancho, New Mexico 87124 505 833-7000 Fax 505 833-7000		
UTILITY PLAN		
TSC4.00		
NOT TO SCALE		

Alc

