




12/20/68, C. SPINELLO
 WATER LINES ADDED SERVING BLK. 5A, 9A, 10A, 11A, 12A, 24A,
 25A, 26A, 27A, 28A, 29A, 30A & 14" EXT. TO GRANDE ELVD. 6/69 R.G.G.

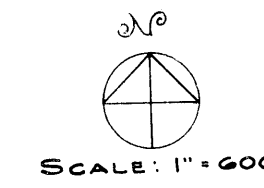

COMPOSITE MAP
 UNIT SIXTEEN
RIO RANCHO ESTATES
 SANDOVAL COUNTY, NEW MEXICO

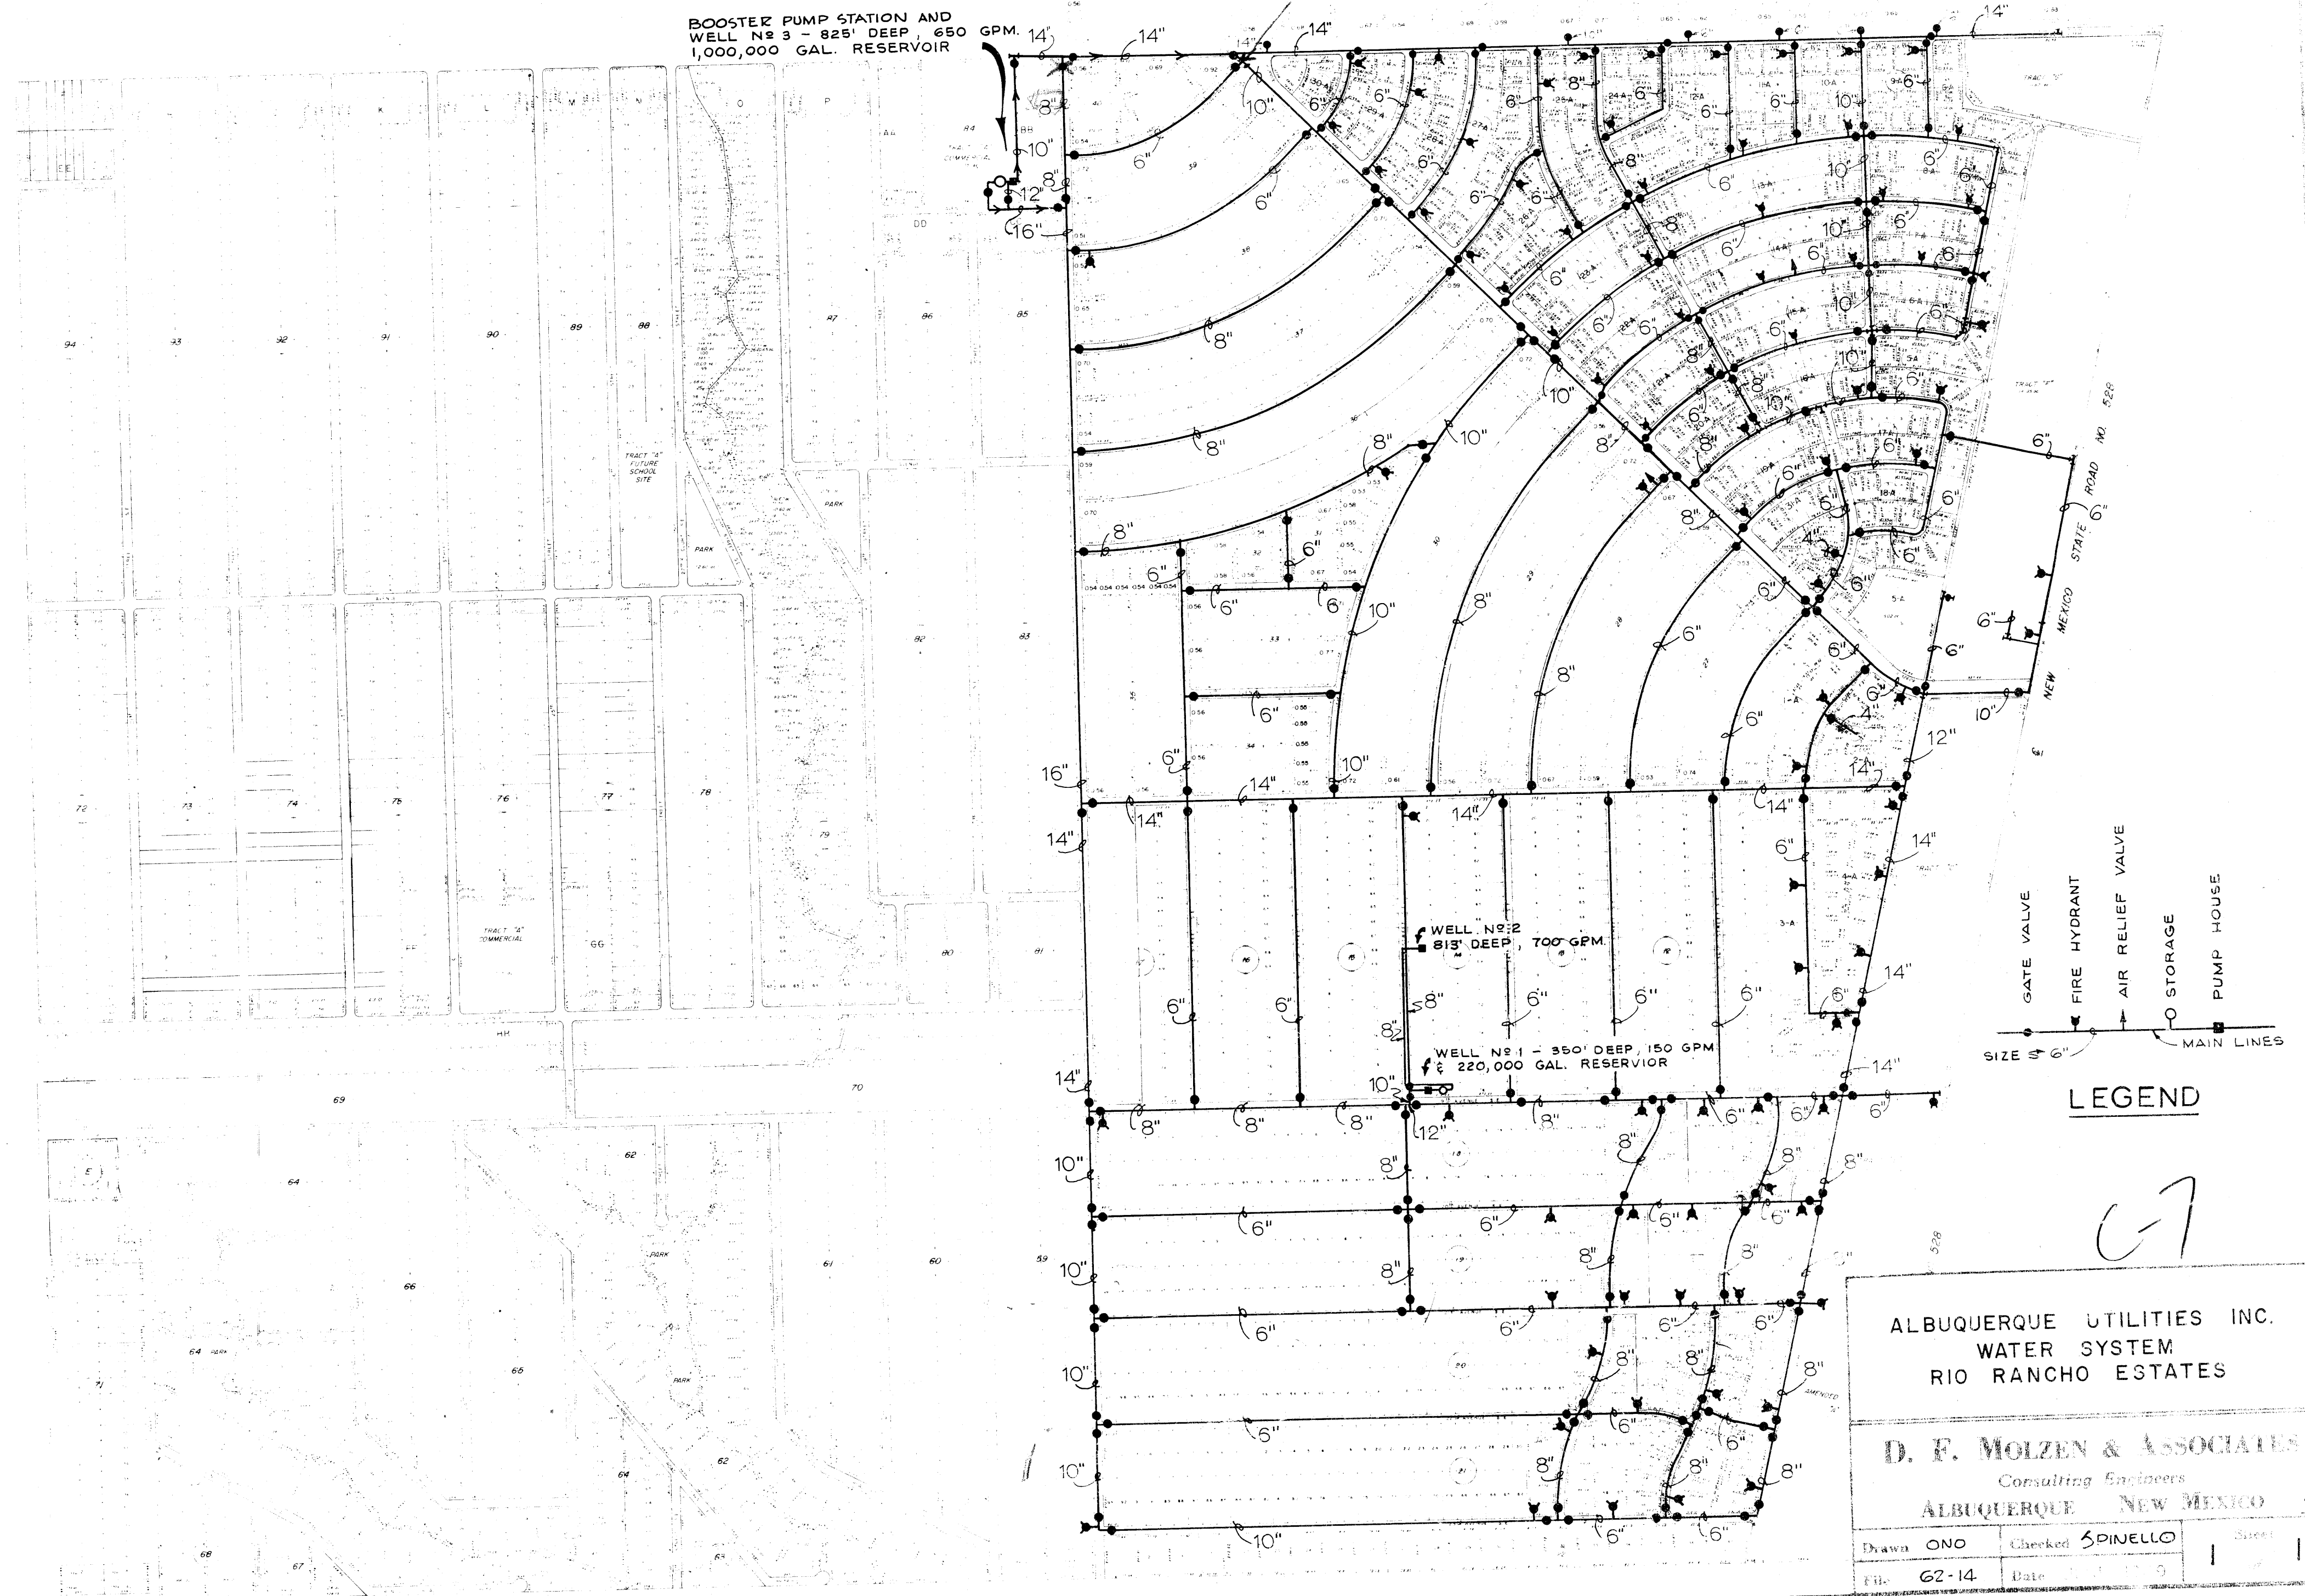

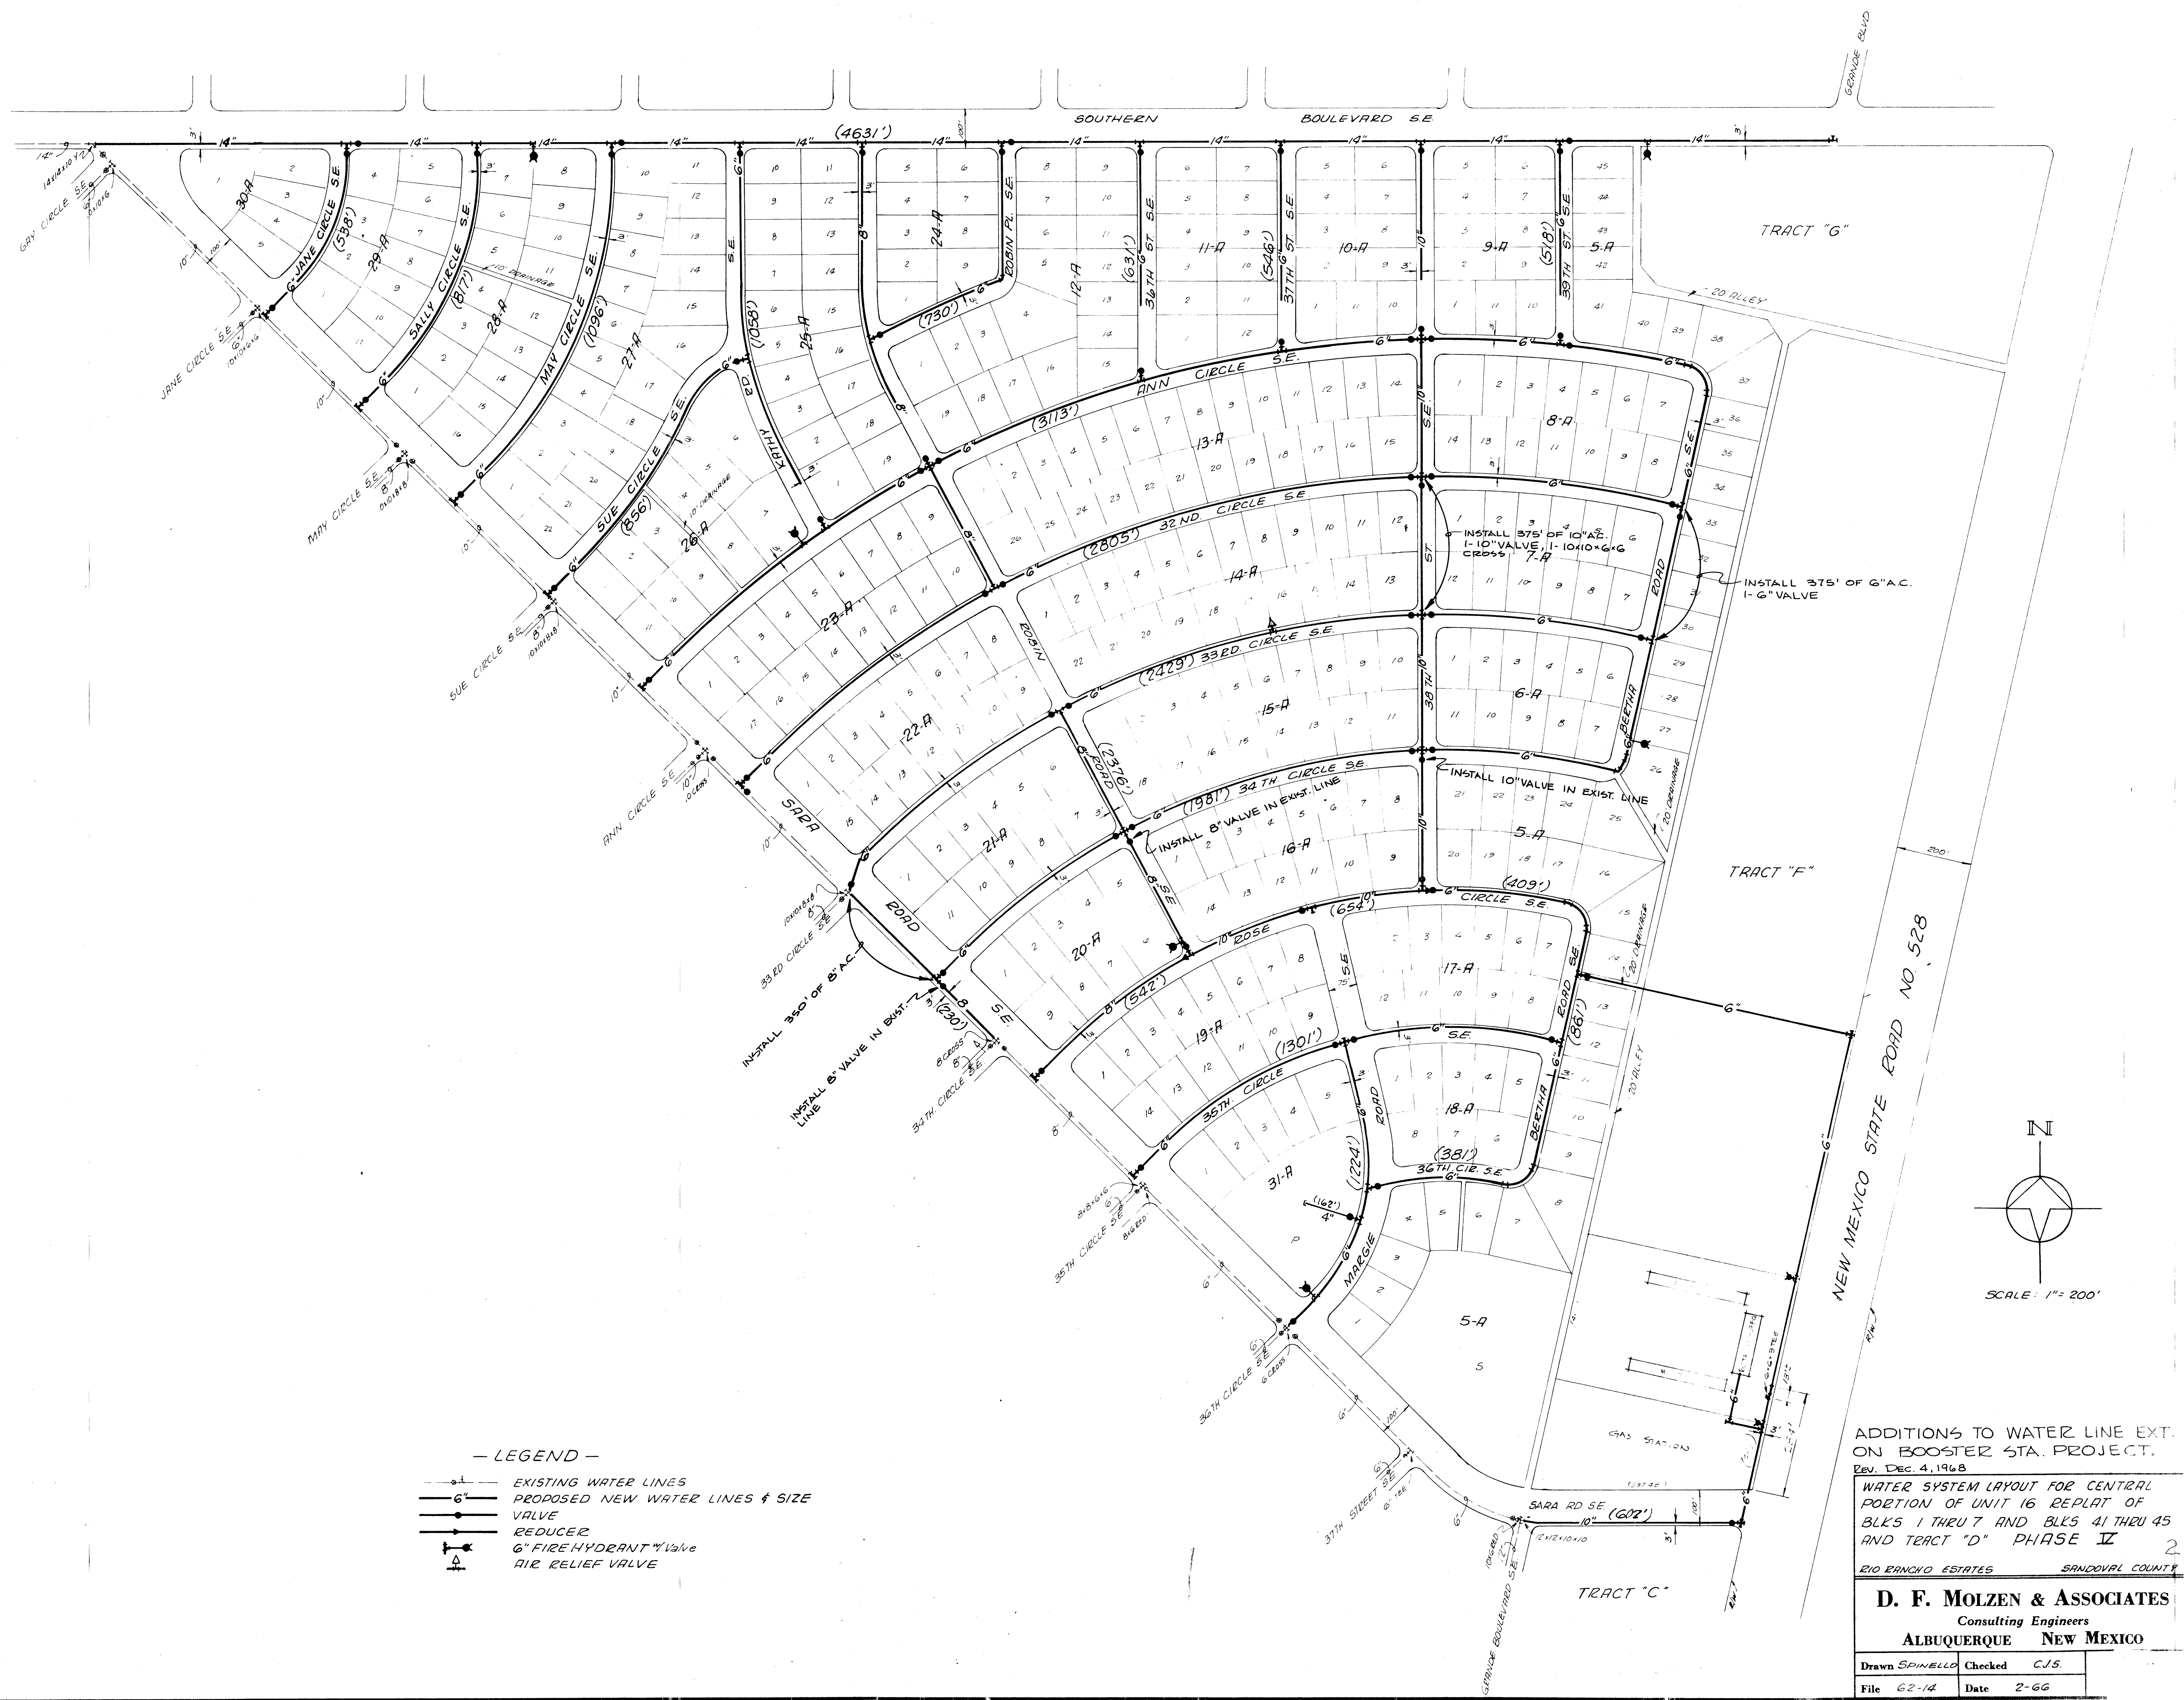

NOTES:

- LEGEND —
- EXISTING WATER LINES
 - PROPOSED NEW WATER LINES & SIZE
 - VALVE
 - REDUCER
 - 6" FIRE HYDRANT VALVE
 - AIR RELIEF VALVE


ADDITIONS TO WATER LINE EXT.
ON BOOSTER STA. PROJECT.
REV. DEC. 4, 1968

WATER SYSTEM LAYOUT FOR CENTRAL
PORTION OF UNIT 16 REPLAT OF
BLKS 1 THRU 7 AND BLKS 41 THRU 45
AND TRACT "D" PHASE II

RIO RANCHO ESTATES SANDOVAL COUNTY


D. F. MOLZEN & ASSOCIATES
Consulting Engineers
ALBUQUERQUE NEW MEXICO

Drawn SPINELLO	Checked C.V.S.
File 62-14	Date 2-66

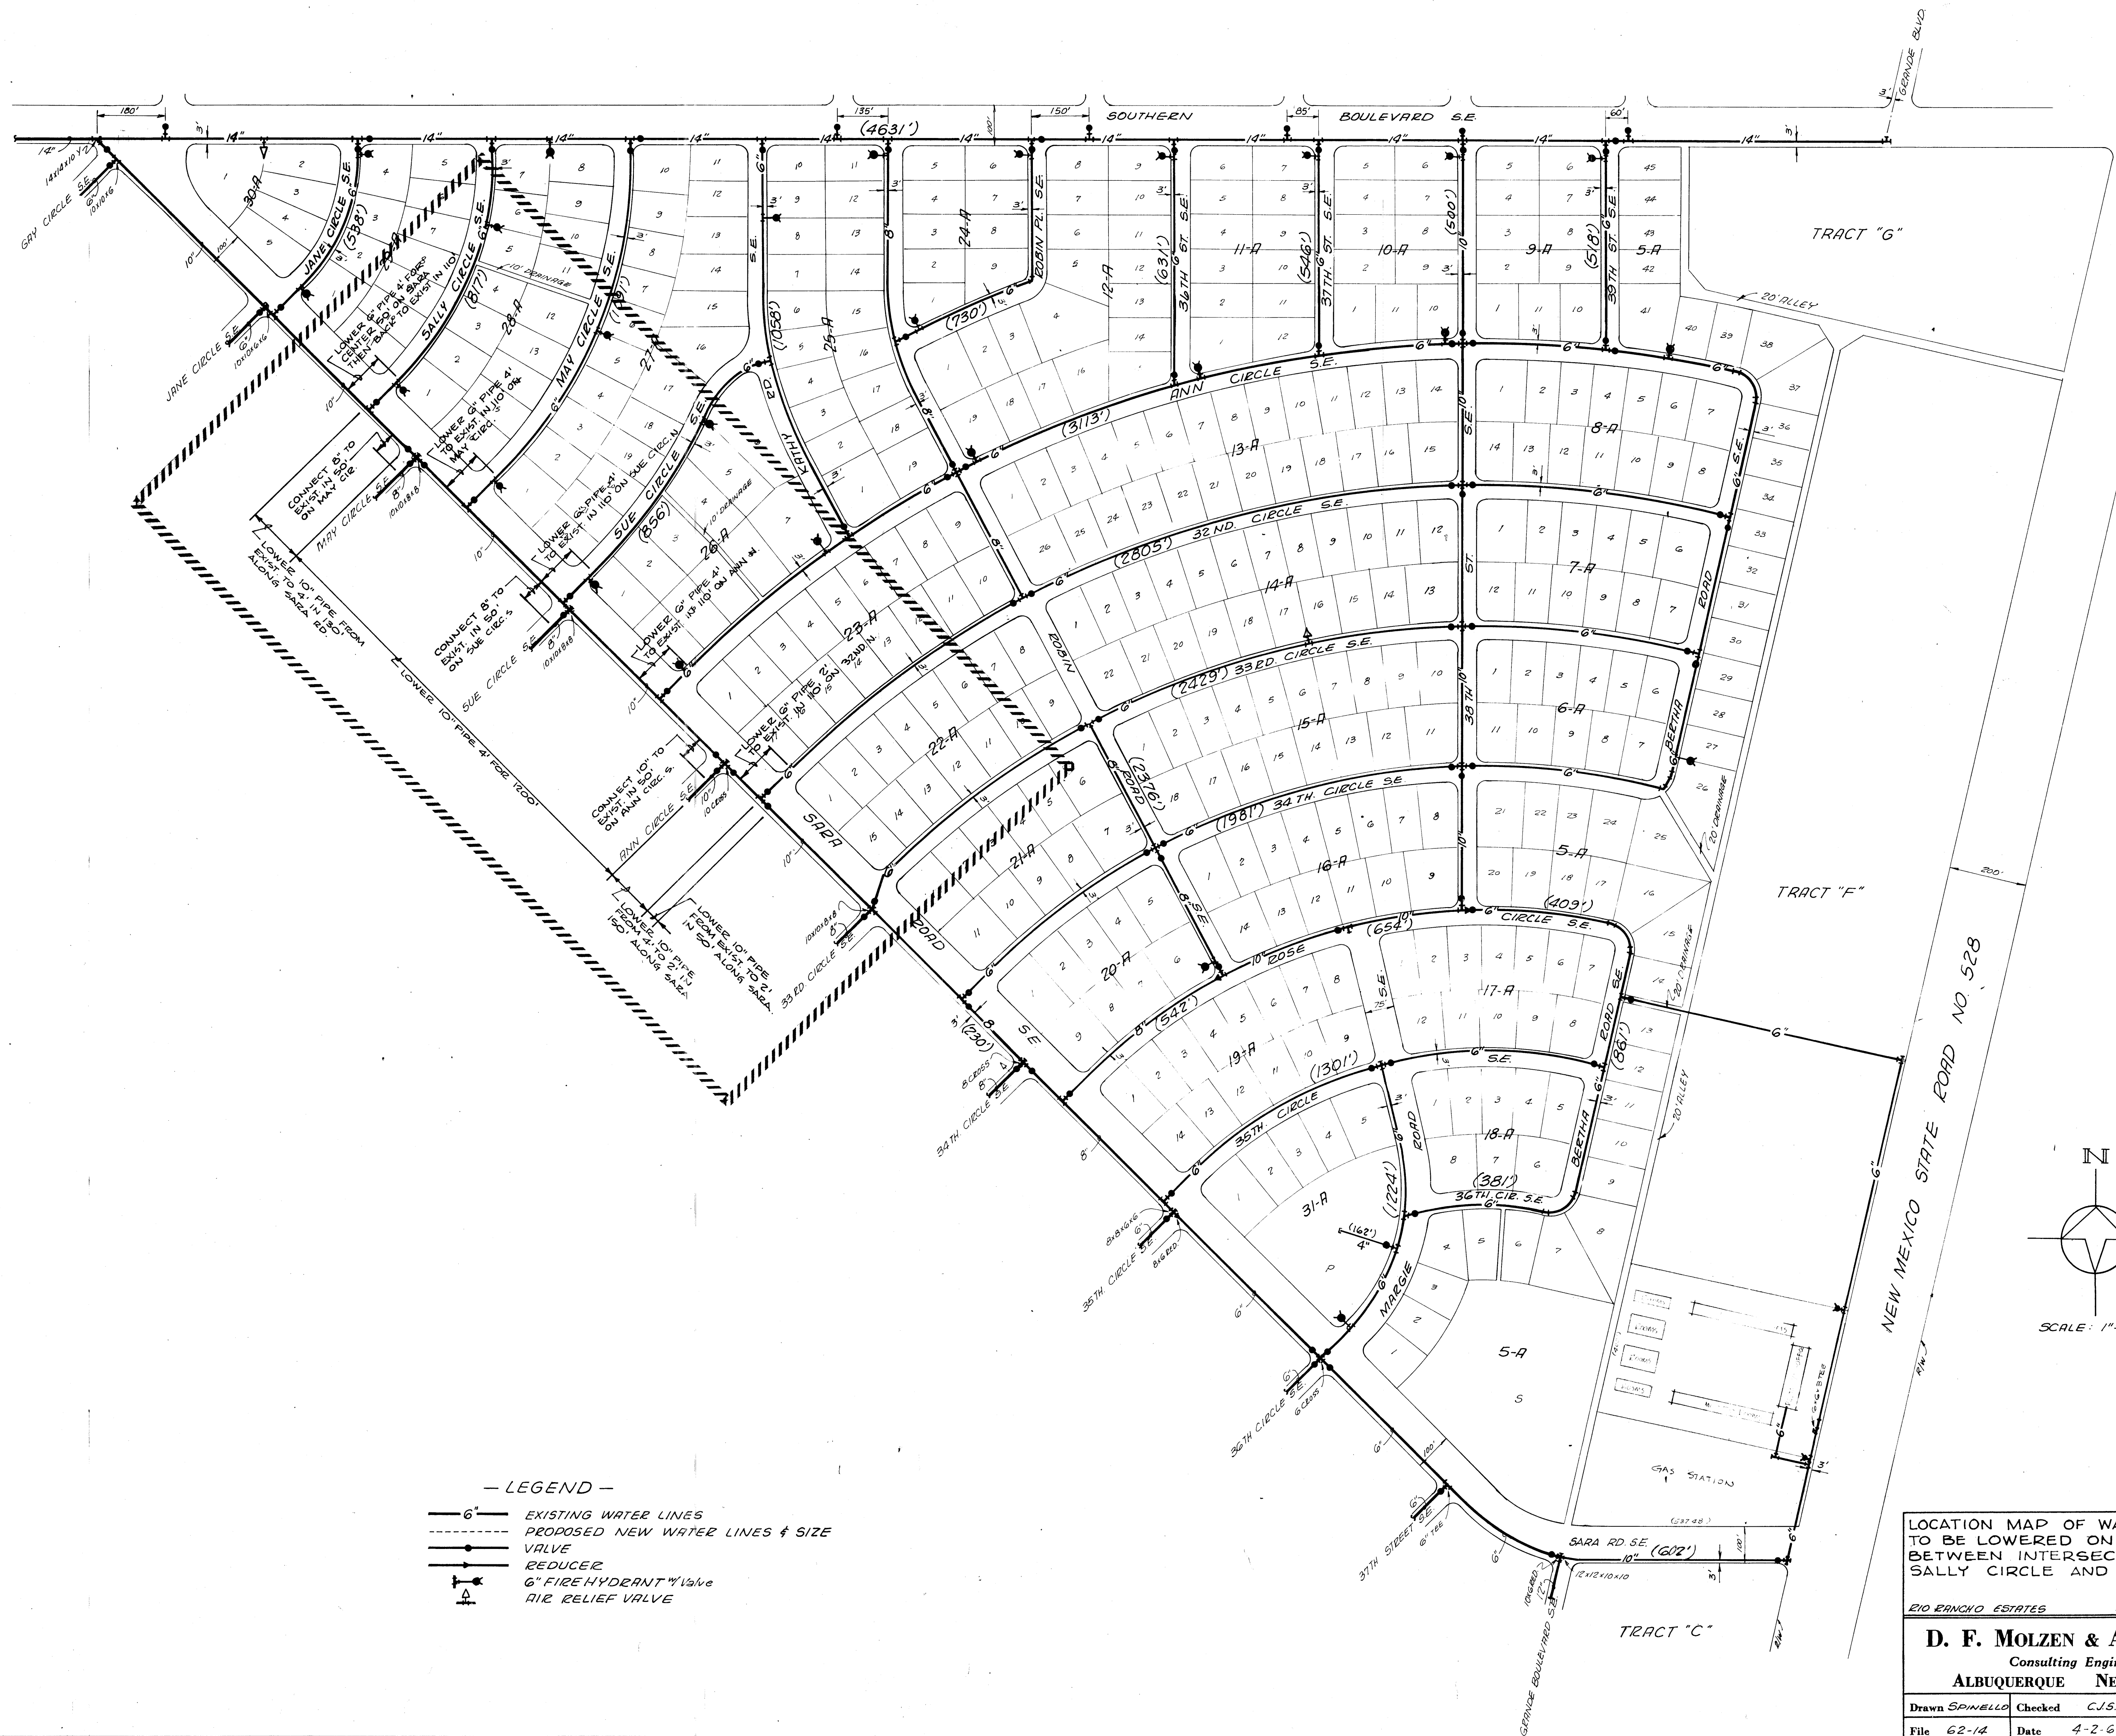

NOTES:

- LEGEND —
- 6" — EXISTING WATER LINES
 - - - - - PROPOSED NEW WATER LINES & SIZE
 - VALVE
 - REDUCER
 - 6" FIRE HYDRANT w/ Valve
 - AIR RELIEF VALVE

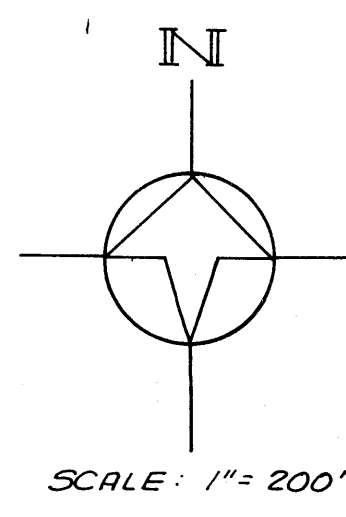



NEW MEXICO STATE ROAD NO. 528

LOCATION MAP OF WATER LINES TO BE LOWERED ON SARA RD BETWEEN INTERSECTIONS OF SALLY CIRCLE AND 32ND CIR.

RIO RANCHO ESTATES SANDOVAL COUNTY

D. F. MOLZEN & ASSOCIATES
Consulting Engineers
ALBUQUERQUE NEW MEXICO

Drawn SPINELLO	Checked C.J.S.	Sheet 1
File 62-14	Date 4-2-69	

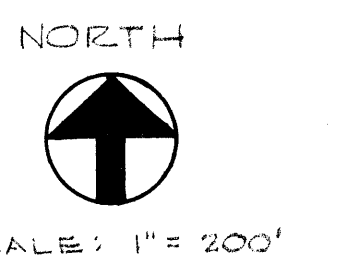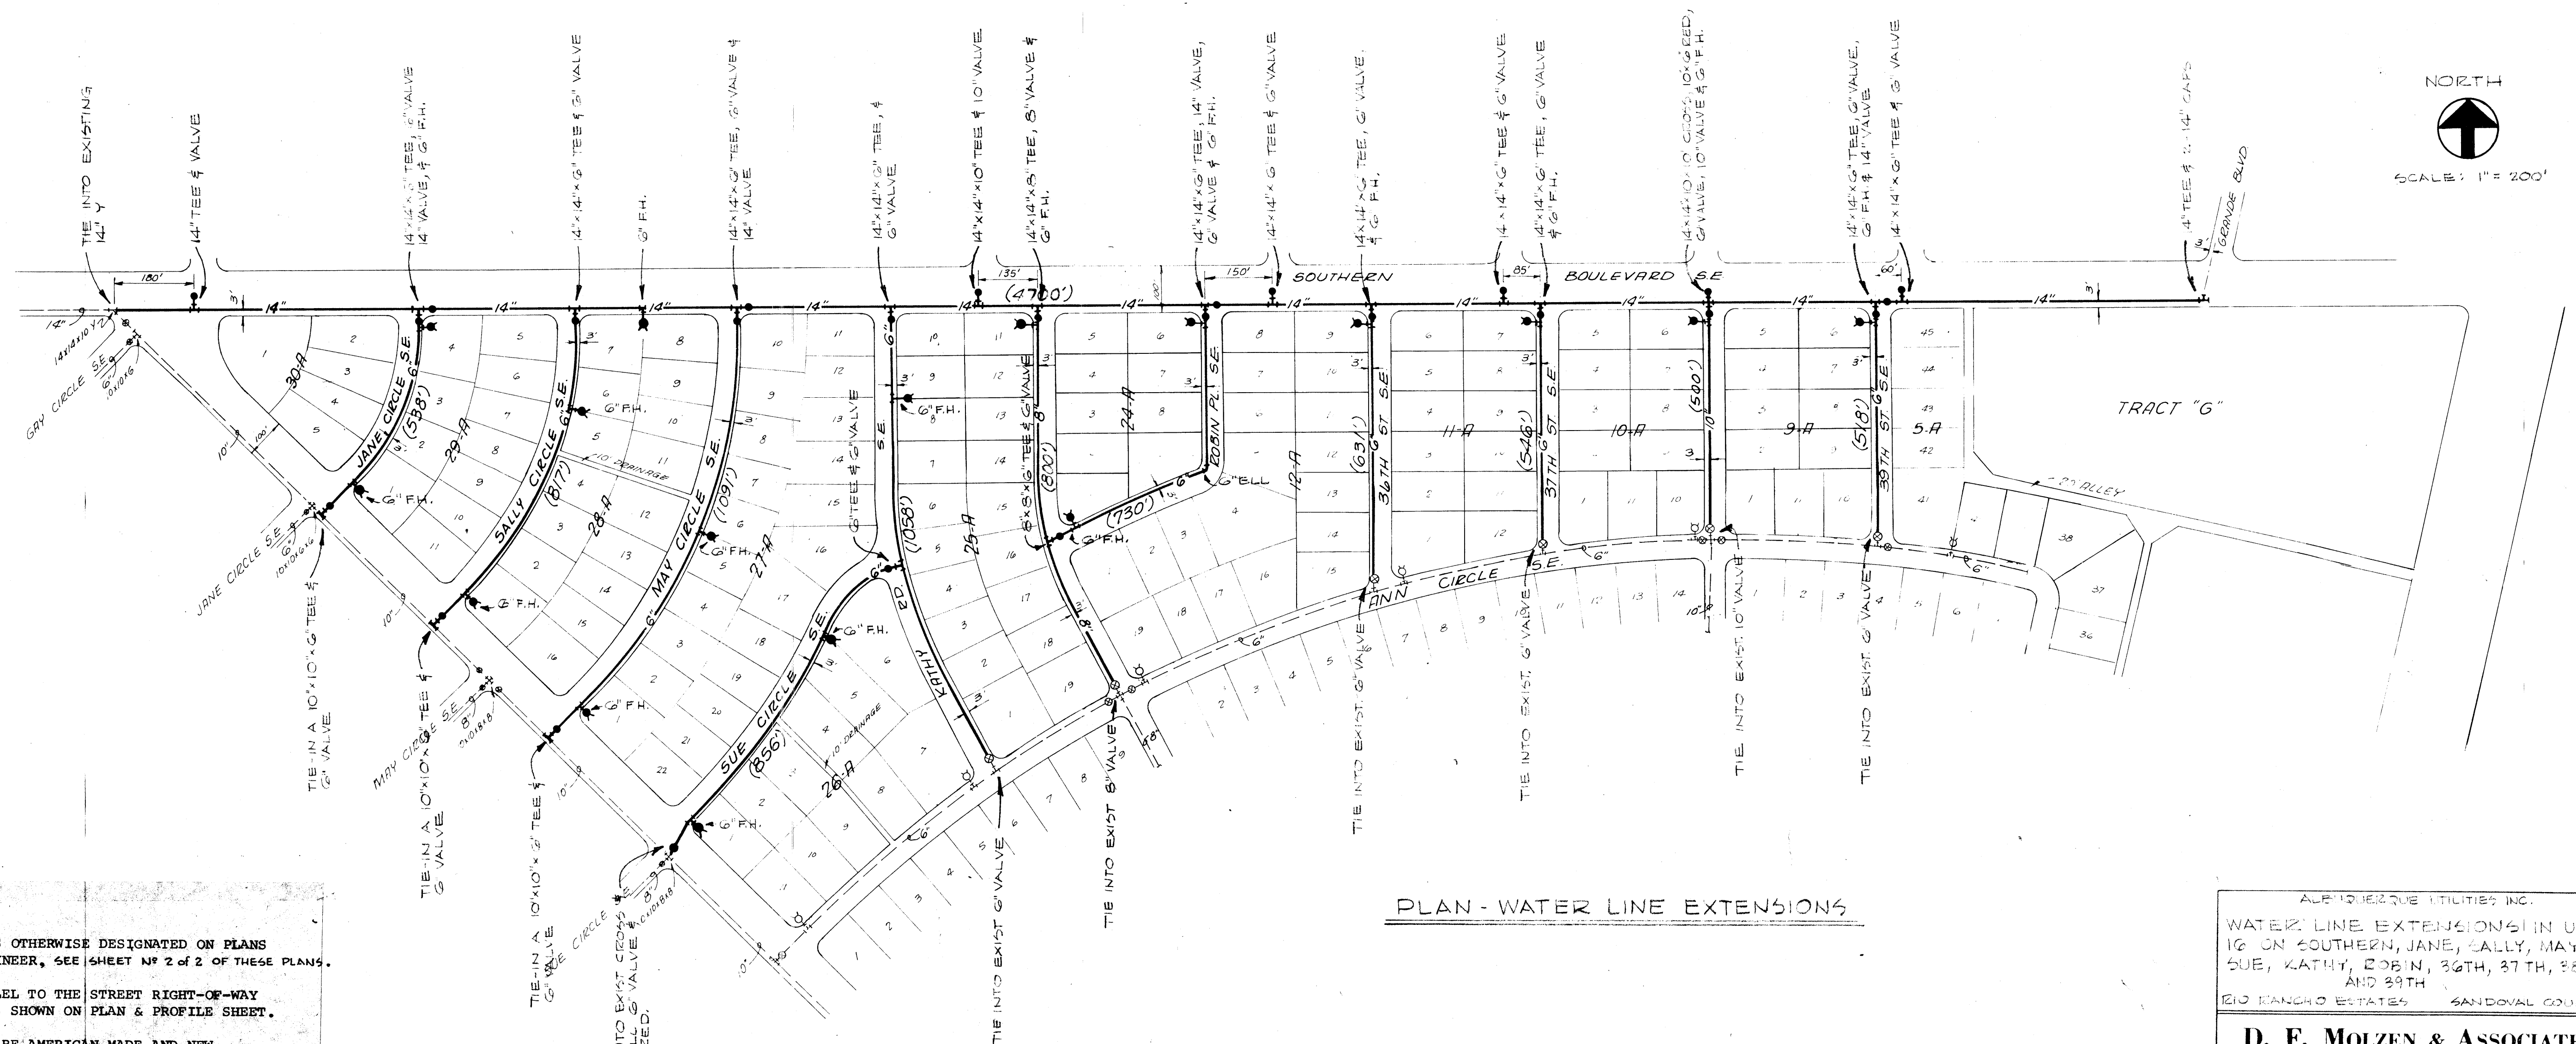

3. MISCELLANEOUS REQUIREMENTS:
- A. MINIMUM COVER SHALL BE 36" UNLESS OTHERWISE DESIGNATED ON PLANS OR BY WRITTEN ORDER FROM THE ENGINEER, SEE SHEET NO. 2 OF 2 OF THESE PLANS.
 - B. PIPE CENTER LINE SHALL RUN PARALLEL TO THE STREET RIGHT-OF-WAY AND 3 FEET INSIDE RIGHT-OF-WAY AS SHOWN ON PLAN & PROFILE SHEET.
 - C. ALL PIPE AND FITTINGS USED SHALL BE AMERICAN MADE AND NEW.
 - D. IT SHALL BE THE CONTRACTOR'S RESPONSIBILITY TO INFORM THE ENGINEER WHEN LINE PRESSURE TESTS ARE TO BE MADE. THE CONTRACTOR SHALL NOT COVER UP PIPE UNTIL THE ENGINEER INSPECTS JOB AND APPROVES BACKFILL AFTER TESTING.

PLAN - WATER LINE EXTENSIONS

ALBUQUERQUE UTILITIES INC.
 WATER LINE EXTENSIONS IN UNIT
 12 ON SOUTHERN, JANE, SALLY, MAY,
 SUE, KATHY, ROBIN, 36TH, 37TH, 38TH,
 AND 39TH
 RIO RANCHO ESTATES SANDOVAL COUNTY



D. F. MOLZEN & ASSOCIATES
 Consulting Engineers
 ALBUQUERQUE NEW MEXICO

Drawn: [Signature]	Checked: [Signature]	She: [Signature]
Date: 05-14	Date: 05-14	Date: 05-14

Bill
Lopez, File



SKETCH OF CHANGE
ON WATER & SEWER
LINES IN 20' ALLEY
WEST OF MOTEL
AS PER INSTRUCTED
BY MR LEWIS
THIS DATE

Spinnello
12/5/69

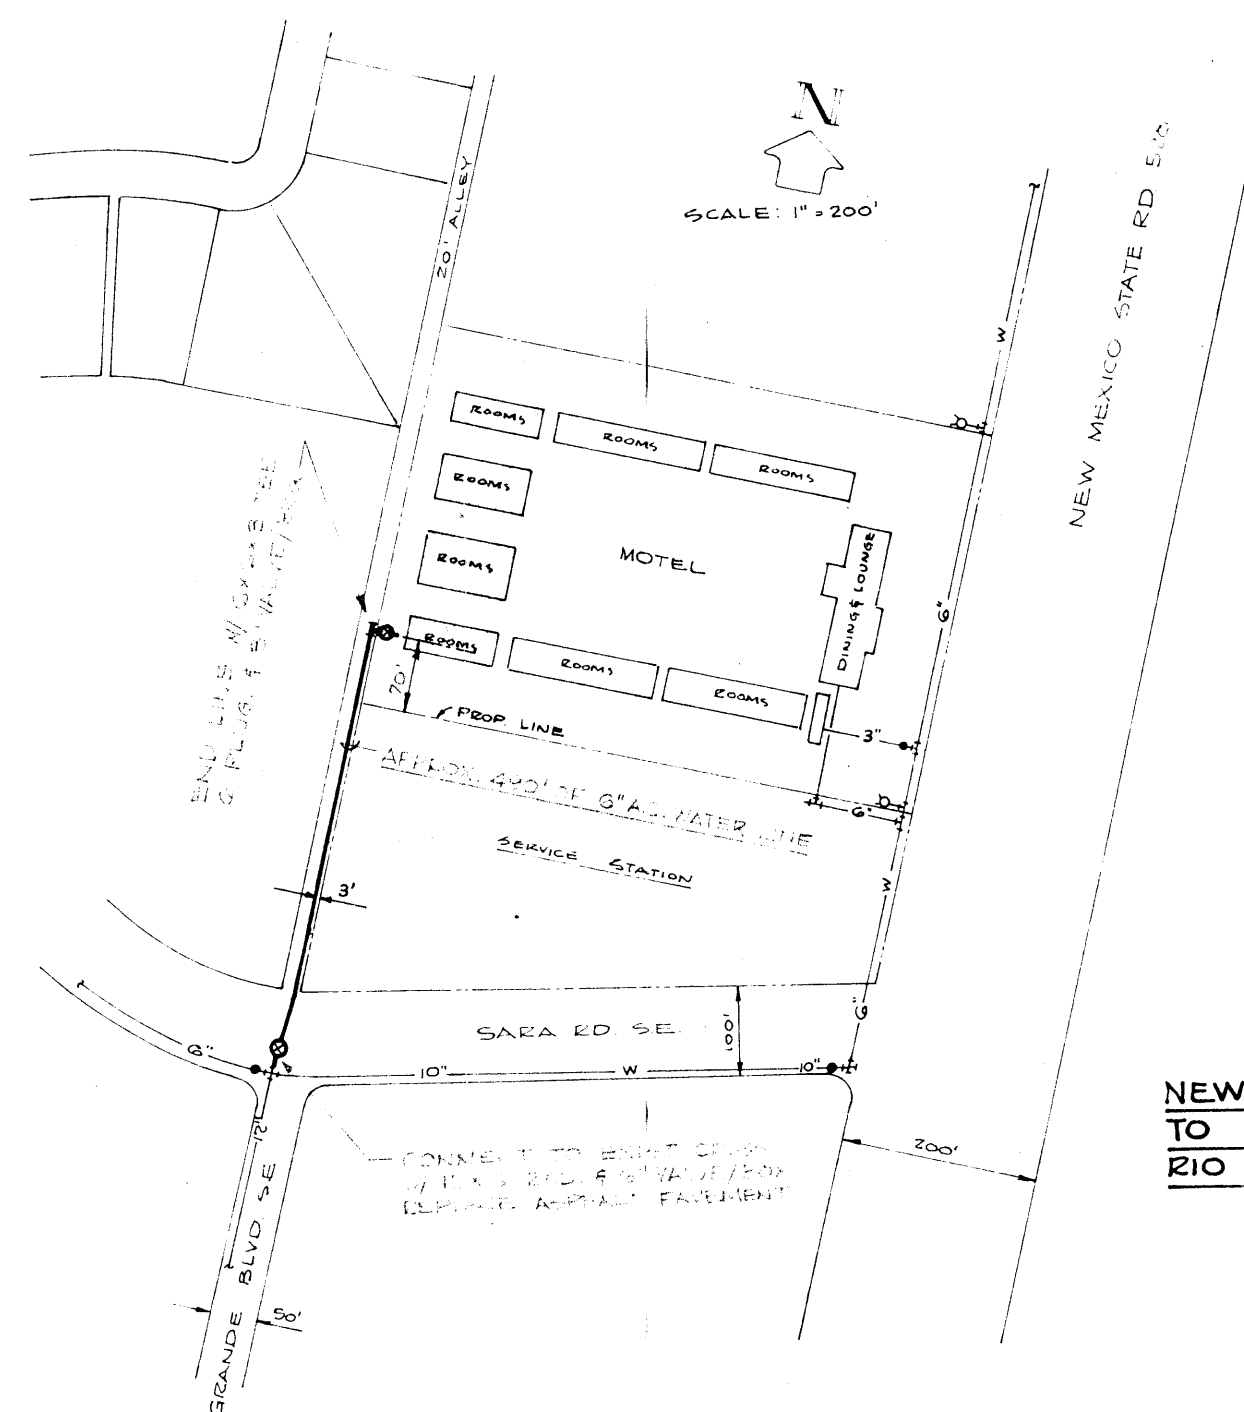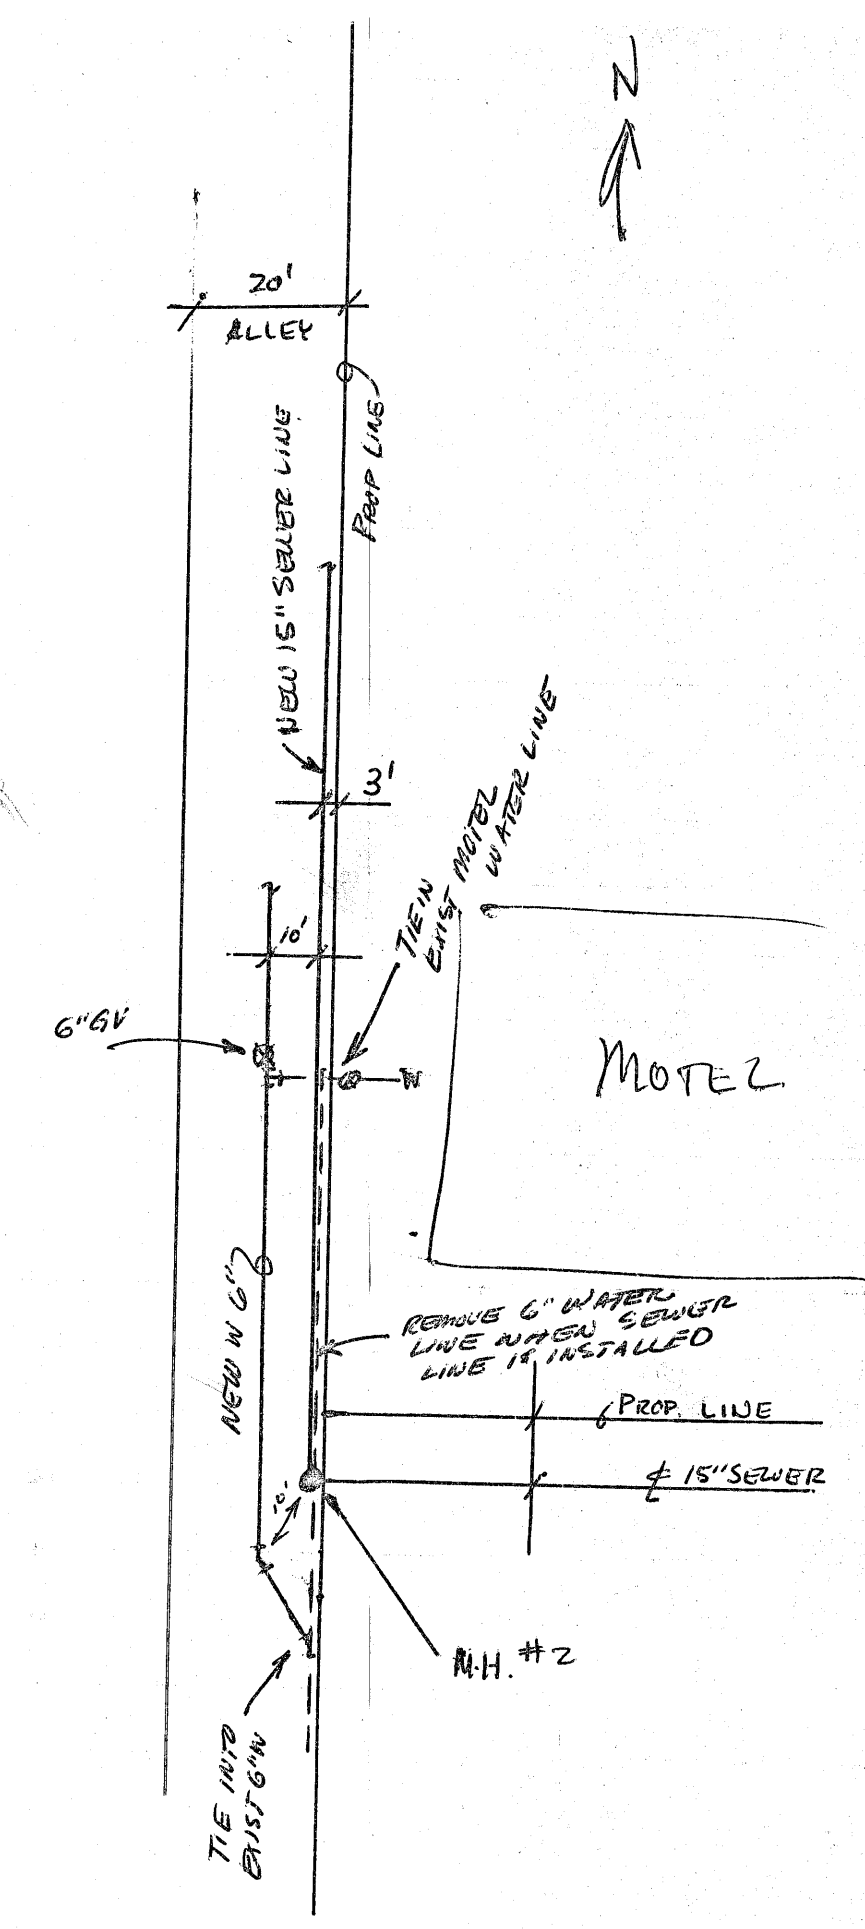

NEW WATER LINE EXTENSION
TO PANORAMA INN
RIO RANCHO ESTATES

D.F. MOLZEN & ASSOCIATES BY: SPINELLO DATE: MAR. 1969

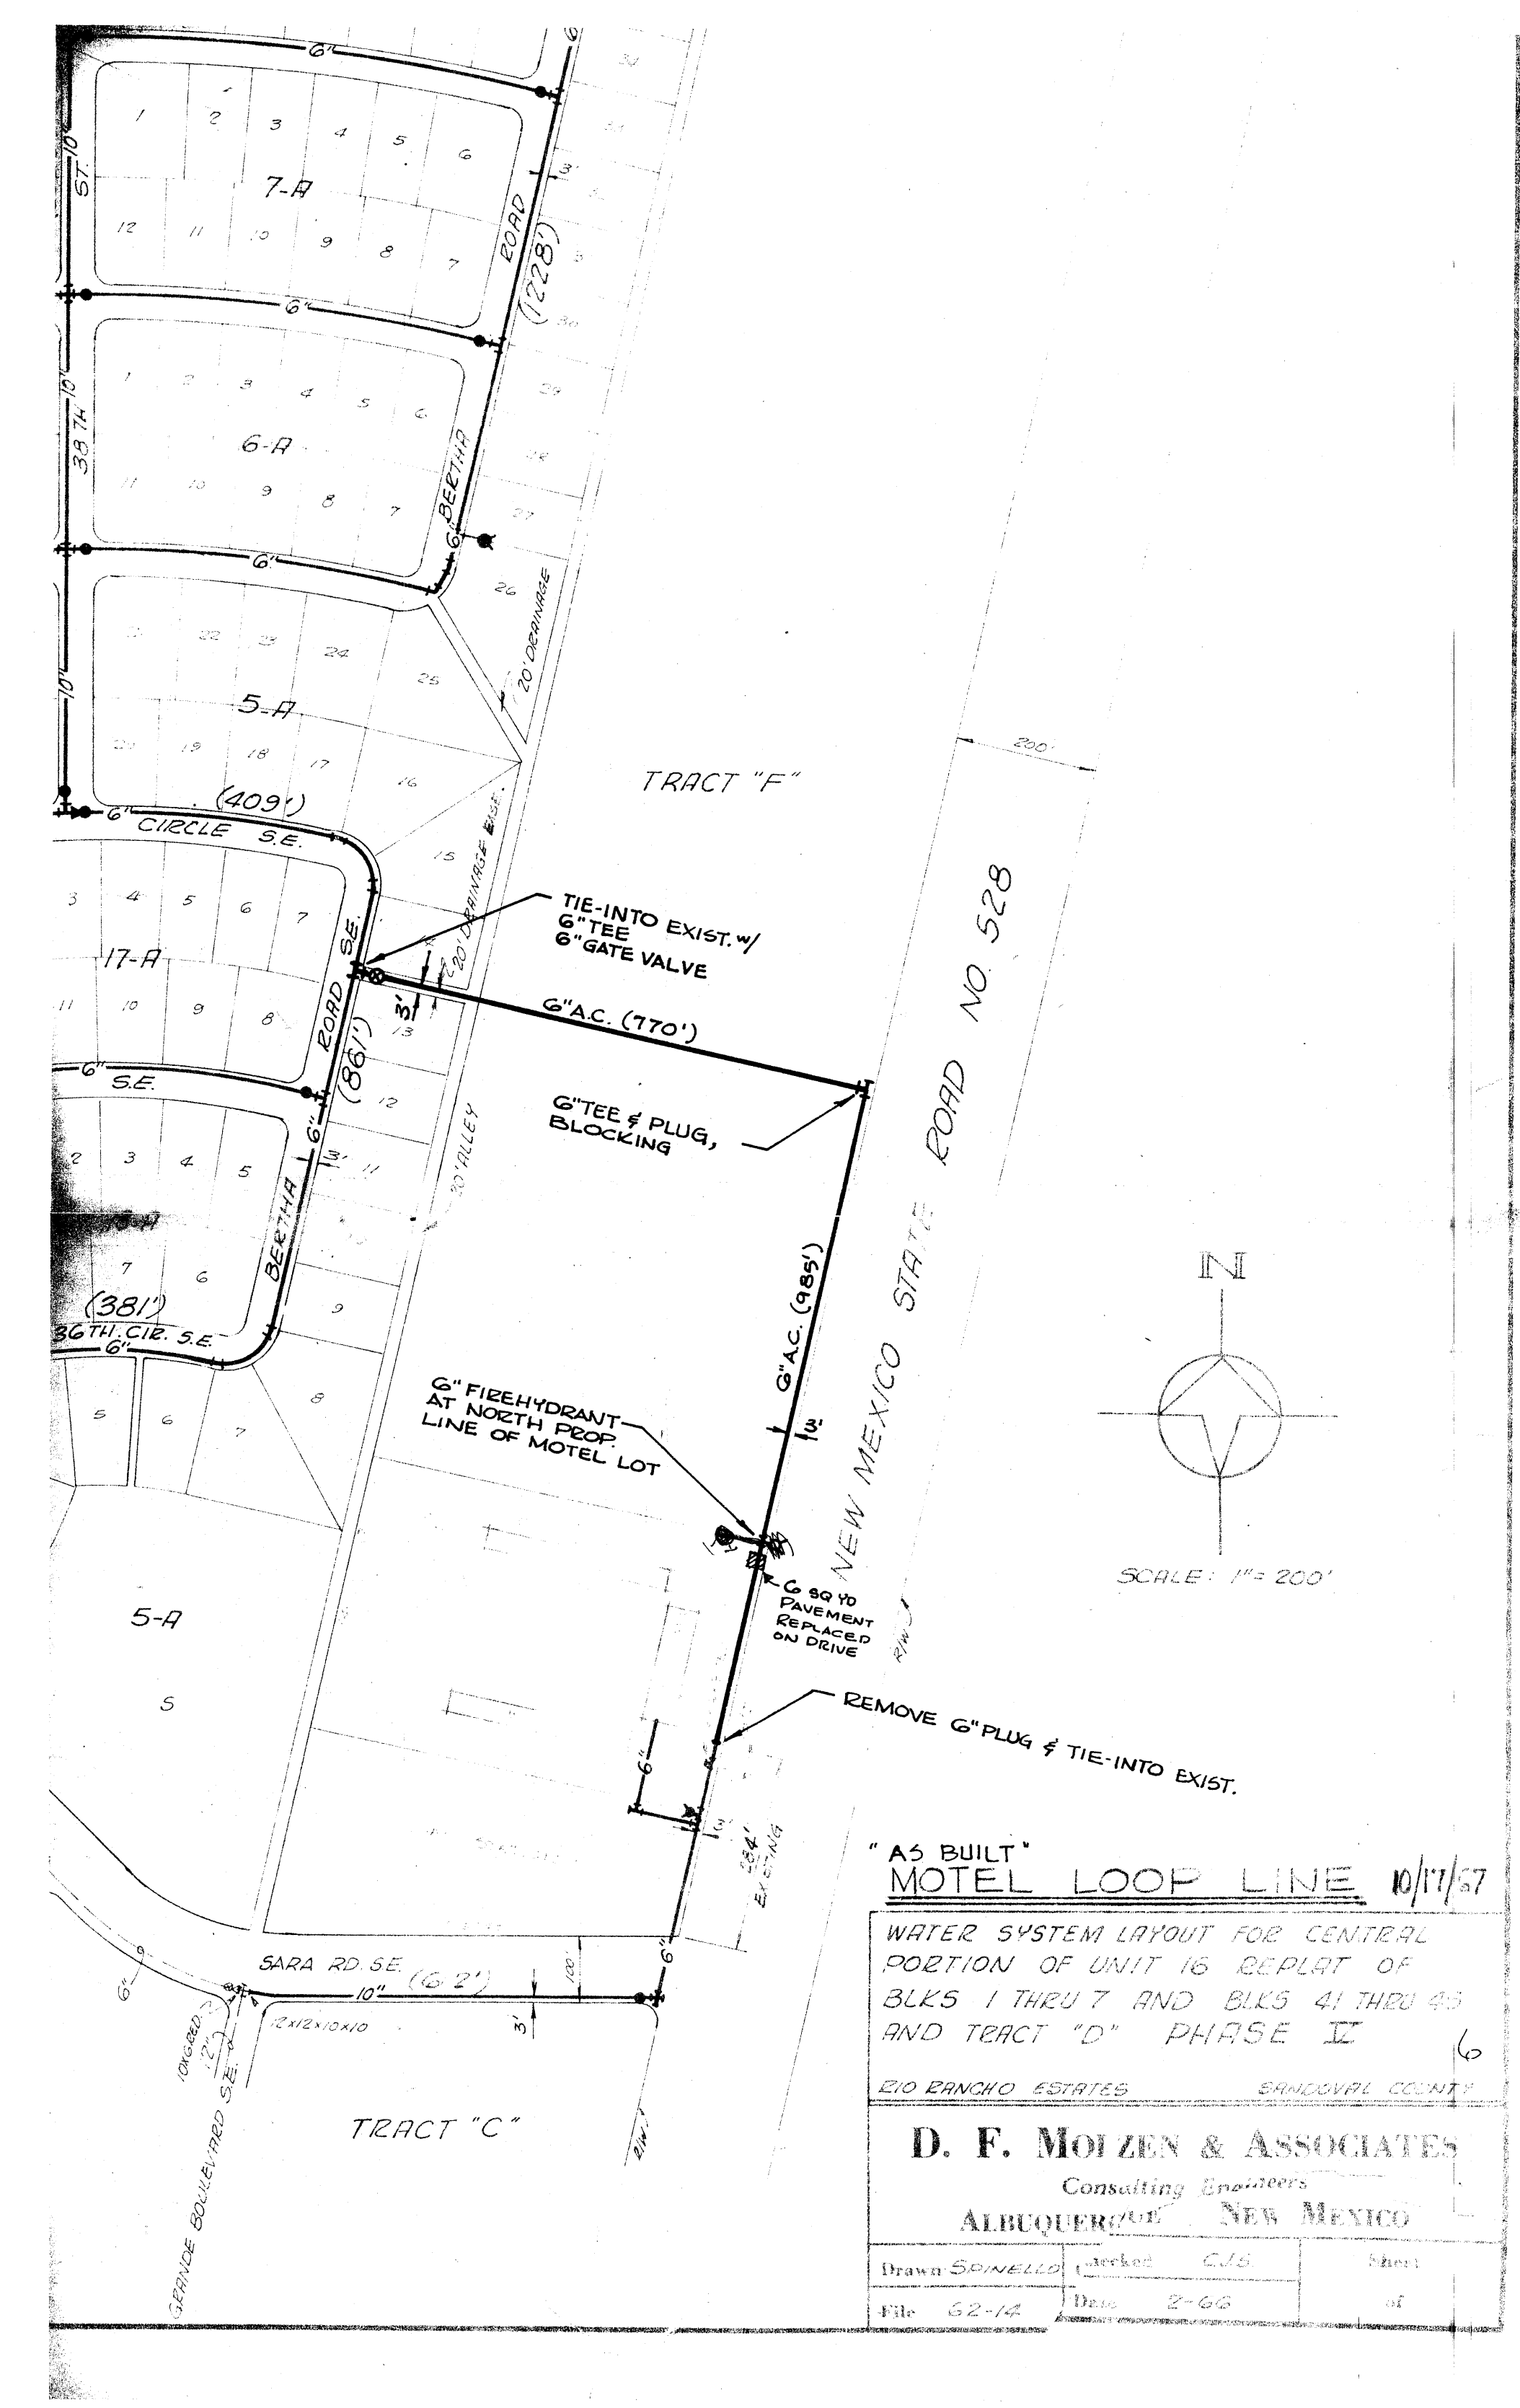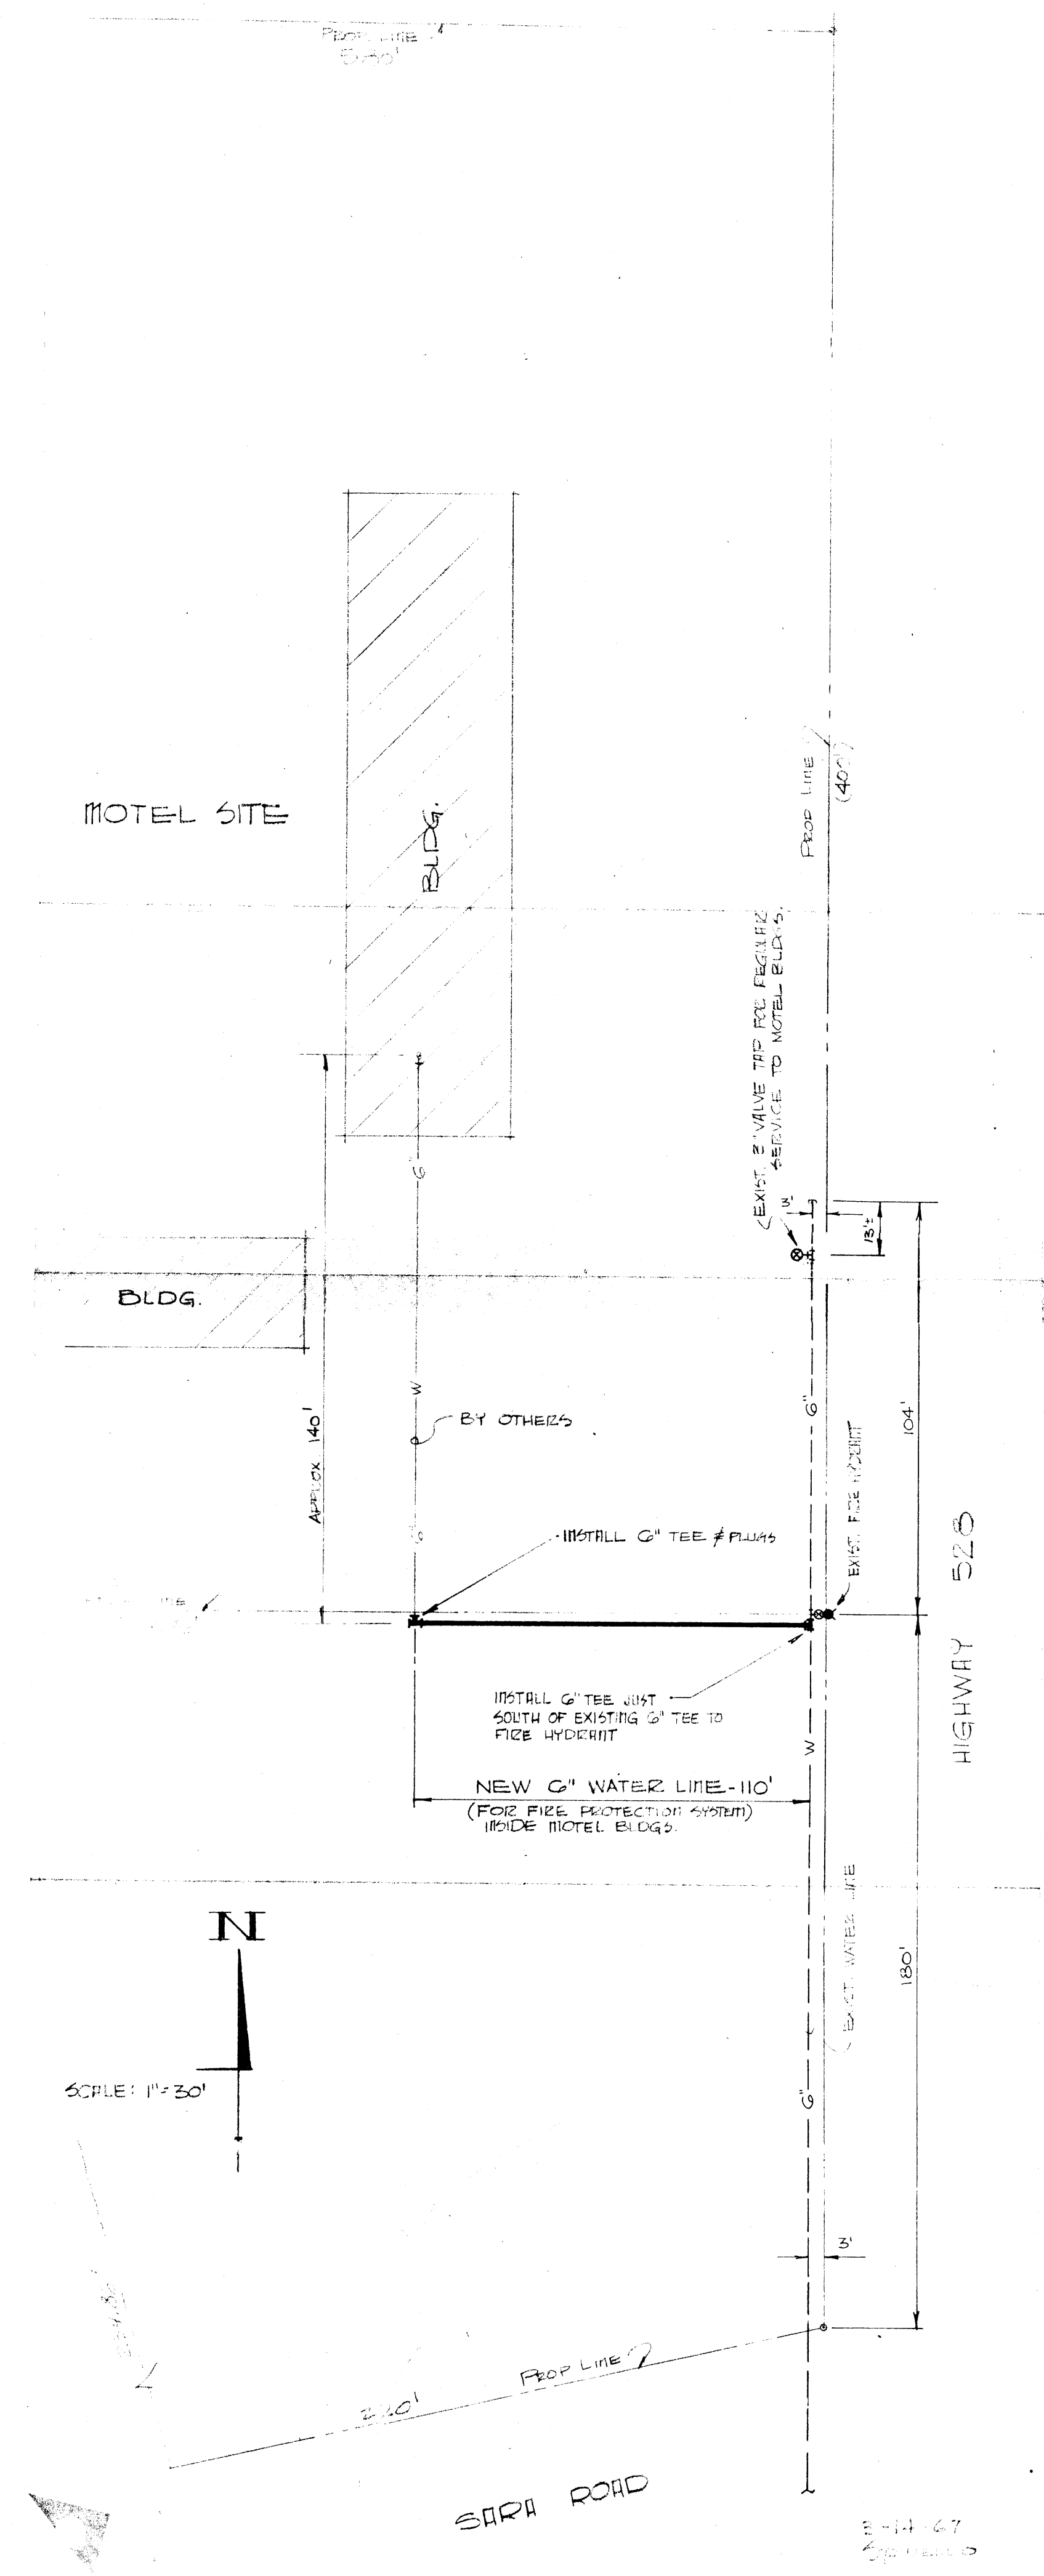

"AS BUILT"
MOTEL LOOP LINE 10/17/67
WATER SYSTEM LAYOUT FOR CENTRAL
PORTION OF UNIT 16 REPLAT OF
BLKS 1 THRU 7 AND BLKS 4 THRU 6
AND TRACT "D" PHASE II
RIO RANCHO ESTATES SANCIAL COUNTY
D. F. MOLZEN & ASSOCIATES
Consulting Engineers
ALBUQUERQUE NEW MEXICO
Drawn SPINELLO Checked CFB Sheet
File 52-12 Date 2-6-68 of