


CITY OF ALBUQUERQUE

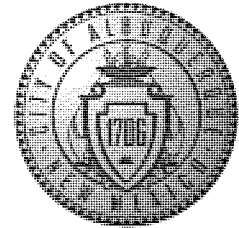

September 14, 2012

Fred C. Arfman, P.E. freda@iacivil.com
Isacson & Arfman, P.A.
128 Monroe Street N.E.
Albuquerque, NM 87108

**Re: Lowe's Subdivision Phase I, 3400 NM 528,
 Request for Permanent C.O. –Accepted
 Engineer's Stamp dated: 02-08-12, (A14/D006B)
 Certification dated: 09-13-12**


Dear Mr. Arfman,

Based upon the information provided in the Certification received 09-13-12, the above referenced Certification is acceptable for a release of a Permanent Certificate of Occupancy by Hydrology.

Hydrology is asking for an electronic copy, in .pdf format, of this certification for our records. This certification can be e-mailed to me at: tsims@cabq.gov.

If you have any questions, you can contact me at 924-3982.

Sincerely,

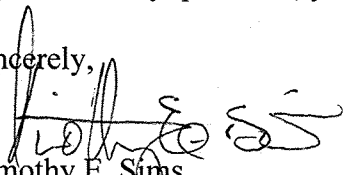
Timothy E. Sims,
Plan Checker—Hydrology Section
Development and Building Services

C: CO Clerk—Katrina Sigala
 File

PO Box 1293

Albuquerque

NM 87103

www.cabq.gov

DRAINAGE AND TRANSPORTATION INFORMATION SHEET
(Rev. 12/05)

PROJECT TITLE: Lowe's Subdivision, Lot 3 ZONE MAP/DRG. FILE # A-14 / D006B
DRB#: _____ EPC#: _____ WORK ORDER#: _____

LEGAL DESCRIPTION: Lowe's Subdivision, Lot 3, Albuquerque, New Mexico
CITY ADDRESS: 3400 NW 528

ENGINEERING FIRM: ISAACSON & ARFMAN, PA
ADDRESS: 128 MONROE NE
CITY, STATE: ALBUQUERQUE, NM

CONTACT: Fred Arfman
PHONE: 268-8828
ZIP CODE: 87108

OWNER: _____
ADDRESS: _____
CITY, STATE: _____

CONTACT: _____
PHONE: _____
ZIP CODE: _____

ARCHITECT: Modulus Architects
ADDRESS: _____
CITY, STATE: _____

CONTACT: Stephen Dunbar
PHONE: 338-1499
ZIP CODE: _____

SURVEYOR: Surv-Tek, Inc.
ADDRESS: 9384 Valley View Drive, NW
CITY, STATE: Albuquerque, NM

CONTACT: _____
PHONE: _____
ZIP CODE: 87114

CONTRACTOR: _____
ADDRESS: _____
CITY, STATE: _____

CONTACT: _____
PHONE: _____
ZIP CODE: _____

TYPE OF SUBMITTAL:
 DRAINAGE REPORT
 DRAINAGE PLAN 1st SUBMITTAL
 DRAINAGE PLAN RESUBMITTAL
 CONCEPTUAL G & D PLAN
 GRADING PLAN
 EROSION CONTROL PLAN
 ENGINEER'S CERT (HYDROLOGY)
 CLOMR/LOMR
 TRAFFIC CIRCULATION LAYOUT
 ENGINEER/ARCHITECT CERT (TCL)
 ENGINEER/ARCHITECT CERT (DRB S.P.)
 ENGINEER/ARCHITECT CERT (AA)
 OTHER (SPECIFY)

CHECK TYPE OF APPROVAL SOUGHT:
 SIA/FINANCIAL GUARANTEE RELEASE
 PRELIMINARY PLAT APPROVAL
 S. DEV. PLAN FOR SUB'D APPROVAL
 S. DEV. FOR BLDG. PERMIT APPROVAL
 SECTOR PLAN APPROVAL
 FINAL PLAT APPROVAL
 FOUNDATION PERMIT APPROVAL
 BUILDING PERMIT APPROVAL
 CERTIFICATE OF OCCUPANCY (PERM)
 CERTIFICATE OF OCCUPANCY (TEMP)
 GRADING PERMIT APPROVAL
 PAVING PERMIT APPROVAL
 WORK ORDER APPROVAL
 OTHER (SPECIFY)

WAS A PRE-DESIGN CONFERENCE ATTENDED:
 YES
 NO
 COPY PROVIDED

9-13-12

SUBMITTED BY: Fred Arfman DATE: 9/13/2012
Isaacson & Arfman, P.A.

Requests for approvals of Site Development Plans and/or Subdivision Plats shall be accompanied by a drainage submittal. The particular nature, location and scope to the proposed development define the degree of drainage detail. One or more of the following levels of submittal may be required based on the following:


1. **Conceptual Grading and Drainage Plan:** Required for approval of Site Development Plans greater than five (5) acres and Sector Plans.
2. **Drainage Plans:** Required for building permits, grading permits, paving permits and site plans less than five (5) acres.
3. **Drainage Report:** Required for subdivision containing more than ten (10) lots or constituting five (5) acres or more.

DRAINAGE CERTIFICATION

I, Fred C. Arfman, N.M.P.E. 7322, of the firm Isaacson & Arfman, P.A., hereby certify that this project has been graded and will drain in substantial compliance with and in accordance with the approved plan filed. The record information edited on the original plan and in accordance with the approved plan filed. I have personally visited the site on September 7, 2012 and have determined by visual inspection that the survey data provided is representative of actual site conditions and is true and correct to the best of my knowledge and belief. This certification is submitted in support of a request for Permanent Certification of Occupancy.

The shown walls along the western property line were not constructed. The Owner negotiated a "Temporary License Agreement" with the adjacent property owner to make the grade transition happen by regarding along the common property line. Therefore, this certification / plan represents the as-built condition.

The record information presented herein is not necessarily complete and intended only to verify substantial compliance of the grading aspects of this project. Those relying on this record document are advised to obtain independent verification of its accuracy before using it for any other purpose.

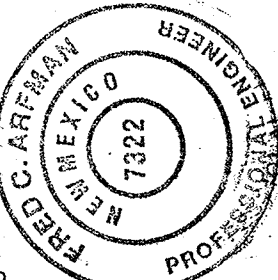


Fred C. Arfman
 N.M.P.E. 7322
 09-13-12
 Date

OFF-SITE GRADING

TRANSITION GRADE WITHIN LANDSCAPING BETWEEN LOTS 1 AND 2:

- PRIOR TO GRADING ON LOT 2, PROVIDE A LETTER FROM ADJACENT PROPERTY OWNER GRANTING PERMISSION TO GRADE TO ENGINEER FOR INCLUSION IN C.O.A. HYDROLOGY FILES.
- NO DEVELOPED DISCHARGE IS TO BE RELEASED INTO THE LANDSCAPED AREA (OTHER THAN WHAT FALLS ON IT).
- PROVIDE SHALLOW WATER HARVESTING BASIN AT THE LOW POINT OF EACH LANDSCAPED SECTION (NORTH AND SOUTH OF THE PASS THROUGH DRIVE).
- PROVIDE EROSION PROTECTION FROM EAST WATER HARVESTING BASIN OVERFLOW TO BOTTOM OF POND. SEE SHEET CG-101 AND CG-501 FOR ADDITIONAL INFORMATION.

Temporary Bench Mark
 PK Nail with aluminum
 disk stamped "LS 14733"
 Elevation = 5029.57'

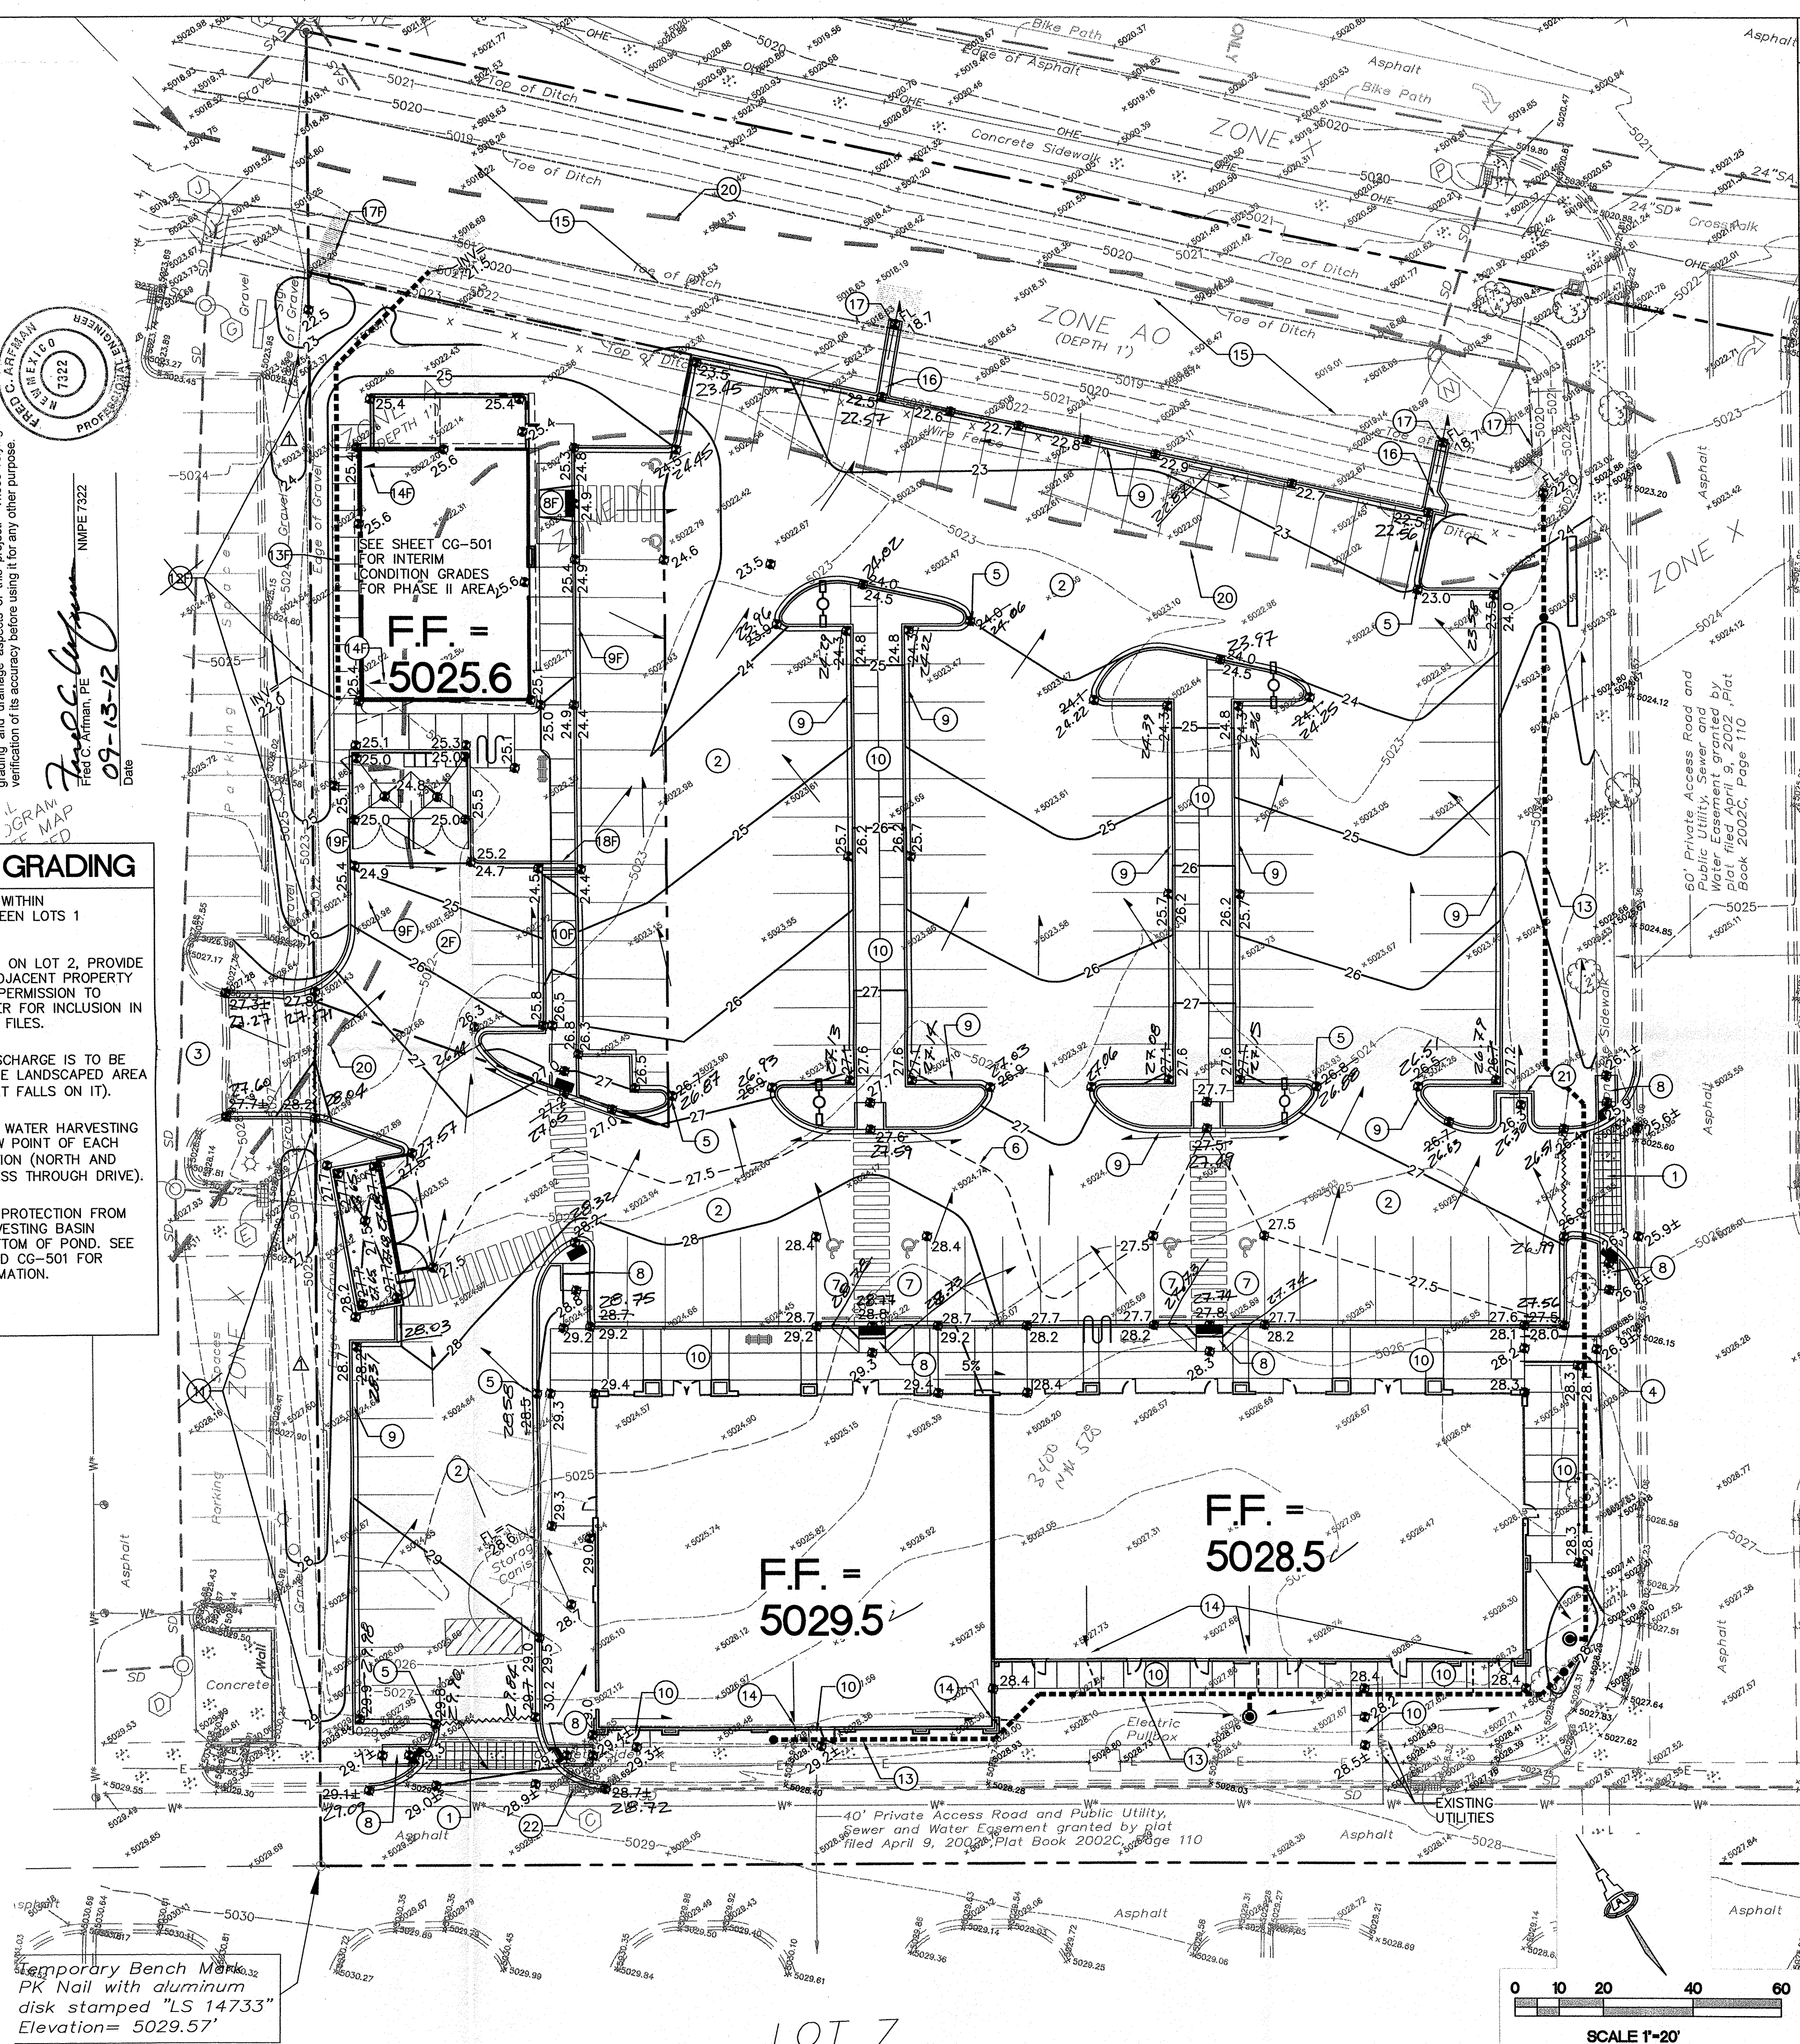


KEYED NOTES

- KEYED NOTES "##" REPRESENT FUTURE PHASE II CONSTRUCTION. SEE SHEET CG-501 FOR INTERIM GRADING.
1. CONSTRUCT NEW SITE ACCESS WITH WATERBLOCK TO ELEVATIONS SHOWN. PROVIDE SMOOTH RIDING TRANSITION TO EXISTING. SEE ARCHITECTURAL FOR DETAILS.
 2. CONSTRUCT NEW PAVING AT ELEVATIONS SHOWN. SEE ARCHITECTURAL FOR EXTENTS AND PAVING DETAILS.
 3. EXISTING PAVING TO REMAIN.
 4. CONSTRUCT RAMP WITH GUARDRAILS TO TRANSITION TO EXISTING CONCRETE WALK AT 1:12 MAX. SLOPE. SEE ARCHITECTURAL FOR DETAILS.
 5. SPOT ELEVATIONS WITHIN FLOWLINE REPRESENT FLOWLINE UNLESS NOTED. ADD 0.5' TYPICAL FOR TOP OF ADJACENT CURB OR WALK ELEVATIONS.
 6. ONE-HALF FOOT DESIGN CONTOURS (0.5') SHOWN DASHED THIS AREA TO CLARIFY GRADING CONCEPT.
 7. CONSTRUCT HANDICAP PARKING AREA AT ELEVATIONS SHOWN. SLOPE WITHIN HANDICAP PARKING AREA TO MEET ADA REQUIREMENTS. MAX. SLOPE = 2% IN ANY DIRECTION.
 8. CONSTRUCT 1:12 (MAX.) RAMP TO ADA STANDARDS. SEE ARCHITECTURAL FOR DETAILS.
 9. CONSTRUCT CONCRETE MEDIAN CURB AND GUTTER. SEE SHEET CG-501 FOR DETAIL.
 10. CONSTRUCT CONCRETE PEDESTRIAN WALKS AND PATIOS AT ELEVATIONS SHOWN.
 11. CONSTRUCT GARDEN WALL (MAXIMUM RETAINING = 30") WITHIN PROPERTY TO ACHIEVE GRADES SHOWN. TOP OF WALL VARIES Δ - SEE PLAN. (DESIGN BY OTHERS).
 12. CONSTRUCT GARDEN WALL (MAXIMUM RETAINING = 30") WITHIN PROPERTY TO ACHIEVE GRADES SHOWN. TOP OF WALL ELEVATION = 5024.9 TYPICAL. (DESIGN BY OTHERS).
 13. CONSTRUCT NEW STORM DRAIN SYSTEM. SEE CG-501 DETAILS.
 14. ALL ROOF DISCHARGE TO BE PIPED DIRECTLY TO STORM DRAIN SYSTEM. SEE ARCHITECTURAL AND PLUMBING PLAN(S) FOR ROOF DRAIN LOCATIONS AND SIZES. EXTEND ROOF DRAINS TO STORM DRAIN USING WATERTIGHT FITTINGS.
 15. EXISTING DETENTION POND WITH CONTROLLED DISCHARGE TO ALAMEDA PUBLIC STORM DRAIN SYSTEM. TOP OF LANDSCAPE MATERIAL TO BE AT 5018.7 PER ORIGINAL DESIGN. REESTABLISH ALL SLOPES AND RESEED ALL DISTURBED AREAS.
 16. CONSTRUCT 2' WIDE (BOTTOM WIDTH) CONCRETE RUNDOWN. SEE CG-501 FOR DETAIL.
 17. CONSTRUCT 4.0' WIDE F.F. ROCK SWALE AT PIPE OUTLET (2 LOCATIONS) AND 10' WIDE X 10' LONG X 12" DEEP F.F. ROCK PAD AT BOTTOM OF CONCRETE RUNDOWN (2 LOCATIONS). SEE GENERAL NOTE 'I' AND SHEET CG-501.
 18. INSTALL THREE (3) 4" DIA. PIPES THROUGH WALK TO PASS FLOW. SLOPE @ 2%. SEE CG-501 FOR DETAIL.
 19. PROVIDE SHALLOW WATER HARVESTING AREA (12" MAX.) TO COLLECT MINOR FLOW, UTILIZE FOR LANDSCAPING AND RELEASE EXCESS TO PAVEMENT.
 20. EXISTING FLOODPLAIN LIMIT (ZONE AO 1' DEPTH). ELEVATION CERTIFICATE REQUIRED FOR PHASE II BUILDING.
 21. PROVIDE 12" WIDE OPENING IN CURB TO PASS MINOR FLOW TO LANDSCAPE.
 22. MODIFY EXISTING STORM DRAIN INLET TO C.O.A. TYPE 'D' PER C.O.A. STD. DWG. 2208. MATCH RIM ELEVATION.

GENERAL NOTES

- A. COORDINATE WORK WITH SITE PLAN AND UTILITY PLAN.
- B. ALL TRASH, DEBRIS, & SURFACE VEGETATION SHALL BE CLEARED AND LEGALLY DISPOSED OF OFFSITE.
- C. FINAL GRADES SHOWN REPRESENT TOP OF FINISH MATERIAL (I.E. TOP OF CONCRETE, TOP OF CONCRETE BUILDING PAD, TOP OF PAVEMENT MATERIAL, TOP OF LANDSCAPING MATERIAL, ETC.). CONTRACTOR SHALL GRADE, COMPACT SUBGRADE AND DETERMINE EARTHWORK ESTIMATES BASED ON ELEVATIONS SHOWN MINUS FINISH MATERIAL THICKNESSES.
- D. MINIMUM SLOPES SHALL BE 1% UNLESS OTHERWISE NOTED.
- E. EXISTING UTILITY LINES ARE SHOWN IN AN APPROXIMATE MANNER ONLY AND MAY BE INCOMPLETE OR OBSOLETE. SUCH LINES MAY OR MAY NOT EXIST WHERE SHOWN OR NOT SHOWN. ALL UTILITIES SHOULD BE FIELD VERIFIED AND LOCATED BY THE CONTRACTOR PRIOR TO COMMENCEMENT OF ANY CONSTRUCTION. THE CONTRACTOR IS FULLY RESPONSIBLE FOR ANY AND ALL DAMAGE CAUSED BY ITS FAILURE TO LOCATE, IDENTIFY AND PRESERVE ANY AND ALL EXISTING UTILITIES, PIPELINES, AND UNDERGROUND UTILITY LINES.
- F. THE ENVIRONMENTAL PROTECTION AGENCY REQUIRES A STORM WATER POLLUTION PREVENTION PLAN (SWPPP) FOR PROJECTS WHERE CONSTRUCTION ACTIVITIES (INCLUDING OTHER LAND-DISTURBING ACTIVITIES) DISTURB ONE ACRE OR MORE (BY OTHERS).
- G. ADJUST RIMS OF EXISTING UTILITY FEATURES AS NECESSARY TO MATCH NEW GRADES, TYPICAL.
- H. WHERE NEW GRADES ARE SHOWN AS 'MATCH' OR '±', TRANSITIONS TO EXISTING INFRASTRUCTURE SHALL BE SMOOTH, SHALL ALLOW FOR POSITIVE DRAINAGE AS INTENDED ON PLAN AND SHALL MEET ADA REQUIREMENTS.
- I. ALL PERMANENT EROSION PROTECTION TO BE 12" DEPTH OF 6" AVG. DIA. FRACTURED FACED ROCK (F.F. ROCK) OVER GEOTEX 50 NON-WOVEN GEOTEXTILE.
- J. OWNER SHALL MAINTAIN EROSION PROTECTION ELEMENTS. ENGINEER RECOMMENDS THAT OWNER INSPECT SITE YEARLY AND AFTER EACH RAINFALL TO MAINTAIN GRADES, IDENTIFY NEW AREAS OF EROSION AND INSTALL ADDITIONAL EROSION PROTECTION AS NEEDED BASED ON ACTUAL OCCURRENCES.
- K. LANDSCAPED AREAS SHALL BE DEPRESSED TO RETAIN MOISTURE THAT FALLS ON THEM FOR INFILTRATION. DO NOT DEPRESS LANDSCAPING WITHIN 10' OF BUILDING.

GENERAL NOTES

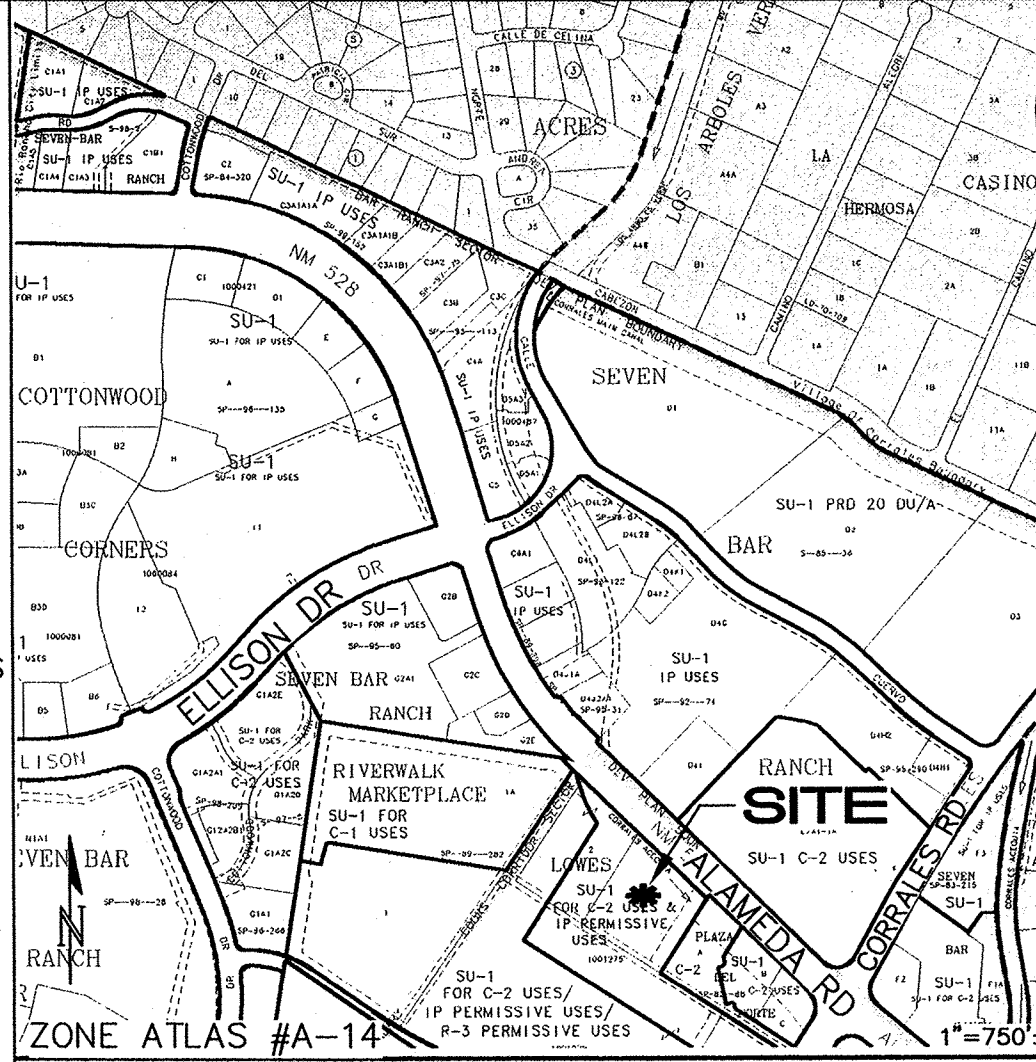

PROJECT INFORMATION

PROPERTY: THE SITE IS AN UNDEVELOPED PROPERTY ZONED 'SU-1 FOR C-2 USES & IP PERMISSIVE USES' LOCATED WITHIN C.O.A. VICINITY MAP A-14. THE SITE IS BOUND TO THE NORTH BY N.M. STATE HIGHWAY 528, AND TO THE WEST, SOUTH AND EAST BY DEVELOPED COMMERCIAL PROPERTY.

PROPOSED IMPROVEMENTS: THE PROPOSED IMPROVEMENTS INCLUDE A 14,000 SF(±) MULTI TENANT BUILDING AND A 2200 SF(±) RESTAURANT WITH ASSOCIATED ASPHALT PAVED ACCESS, PARKING AND LANDSCAPING.

LEGAL: LOT 3, LOWES SUBDIVISION, ALBUQUERQUE, NM

BENCHMARK: VERTICAL DATUM IS BASED UPON THE ALBUQUERQUE CONTROL STATION MONUMENT "NM-448-N12", ELEVATION = 5,026.132 FEET (NAVD 1988) AS PUBLISHED.

OFF-SITE: NO OFF-SITE DRAINAGE AFFECTS THIS PROPERTY.

FLOOD HAZARD: PER BERNALILLO COUNTY FIRM MAP #35001C0109G DATED SEPTEMBER 26, 2008, THE MAJORITY OF THE SITE IS LOCATED WITHIN FLOODZONE 'X' DESIGNATED AS AREAS DETERMINED TO BE OUTSIDE THE 0.2-PERCENT-ANNUAL-CHANCE FLOODPLAIN. A PORTION OF THE NORTH AND WEST ENDS OF THE PROPERTY FALLS WITHIN FLOODZONE AO (DEPTH 1') DESIGNATED AS AREAS OF SHEET-FLOW SHALLOW FLOODING TO A DEPTH OF 1'.

DRAINAGE PLAN CONCEPT: A PRIVATE STORM DRAIN SYSTEM WILL BE INSTALLED TO COLLECT ROOF DISCHARGE AND ROUTE TO THE EXISTING MASTER PLANNED DETENTION POND. THE REMAINDER OF THE SITE WILL SURFACE FLOW TO THE MASTER PLANNED DETENTION POND. CONTROLLED RUNOFF FROM THE POND IS PASSED TO THE EXISTING ALAMEDA STORM SEWER AT THE ALLOWABLE RATE.

LEGEND

- 27— PROPOSED CONTOUR - 1' INCREMENT
- - -27.5- - - PROPOSED CONTOUR - 0.5' INCREMENT
- ◆78.3 PROPOSED SPOT ELEVATION
- FLOW ARROW
- F.F.=XXXXXX FINISH FLOOR ELEVATION
- ◆78.3± EXISTING ELEVATION (±) TO MATCH. PROVIDE SMOOTH TRANSITION.
- PROPOSED RETAINING WALL
- ~~~~~ GRADE BREAK


ISAACSON & ARFMAN, P.A.
 Consulting Engineering Associates
 128 Monroe Street N.E.
 Albuquerque, New Mexico 87108
 Ph. 505-268-8828 www.isaiv.com
 1899 CG-101.dwg Apr 24, 2012

This design, calculations, and concepts are owned by and remain the property of Isaacson & Arfman, P.A. and no part thereof shall be utilized by any person, firm or corporation for any purpose whatsoever except with the written permission of Isaacson & Arfman, P.A. ©


LOWE'S SUBDIVISION, LOT 3

GRADING AND DRAINAGE PLAN


Date:	No. Revision:	Date:	Job No.:
01.24.12	1	4/23/12	1899
Drawn By:	Title:		CG-101
BUB	STORM DRAIN REVISED		SH OF
Ckd By:	Date:		
FCA	4/23/12		

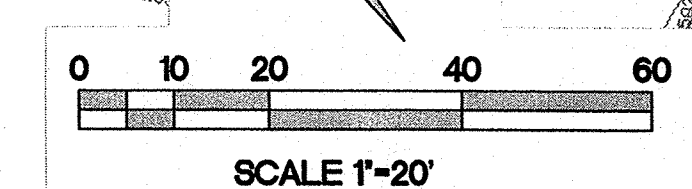

LOT 7

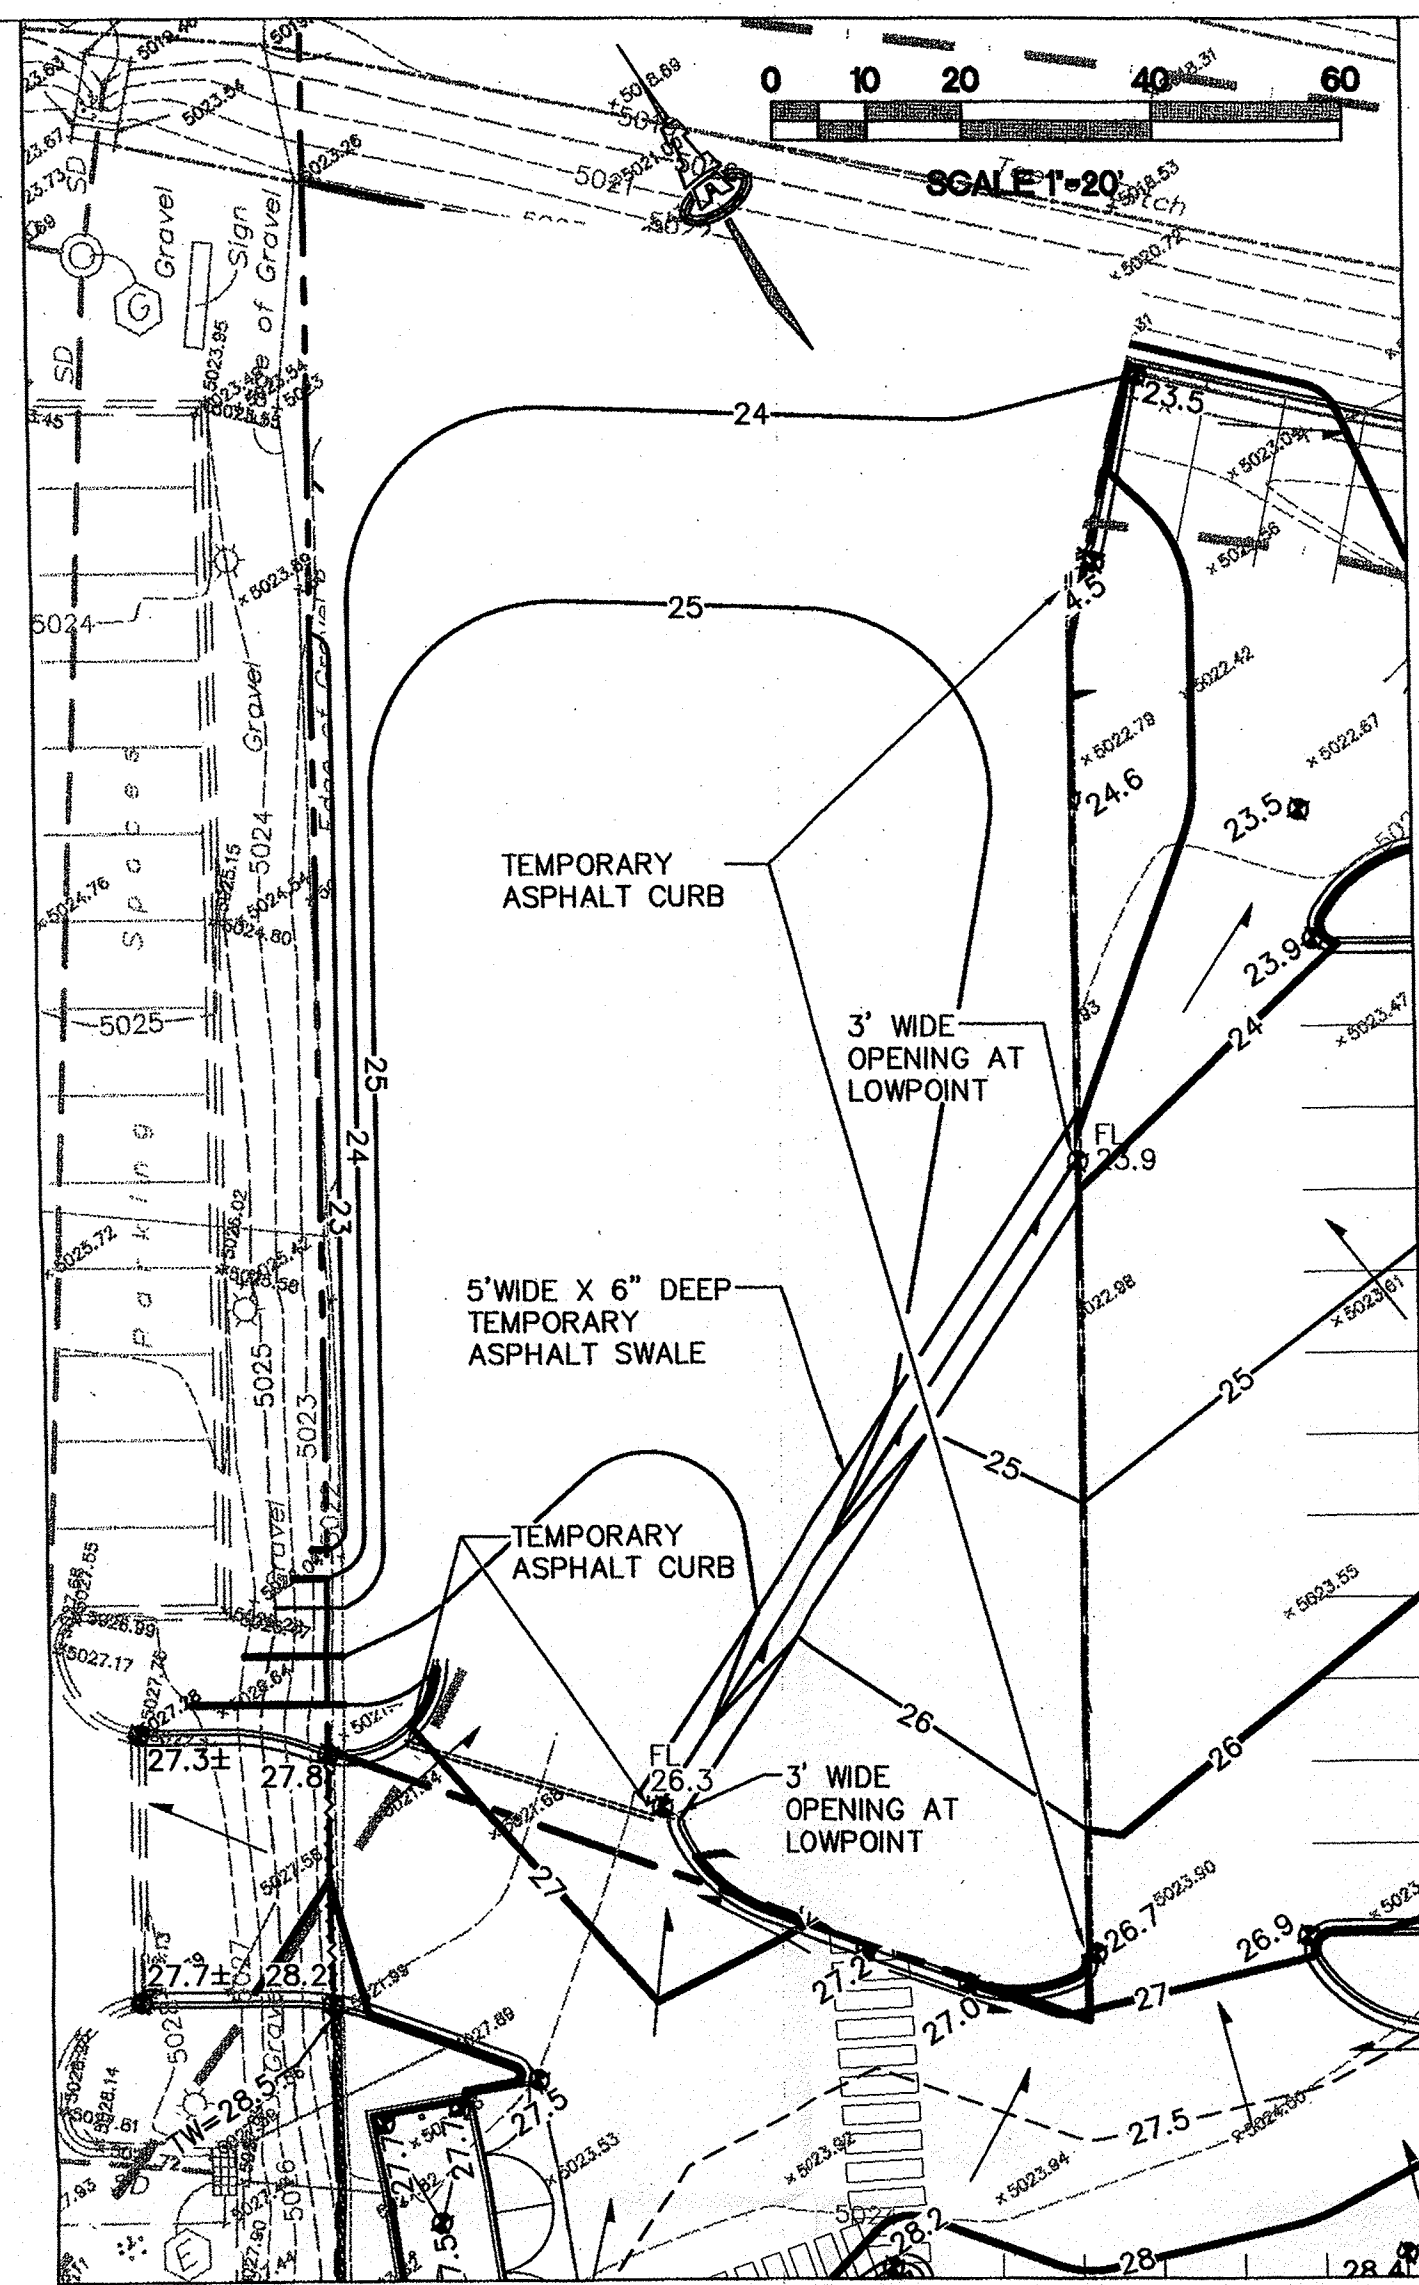


1 PHASE II AREA: INTERIM GRADES
Scale: 1"=20'

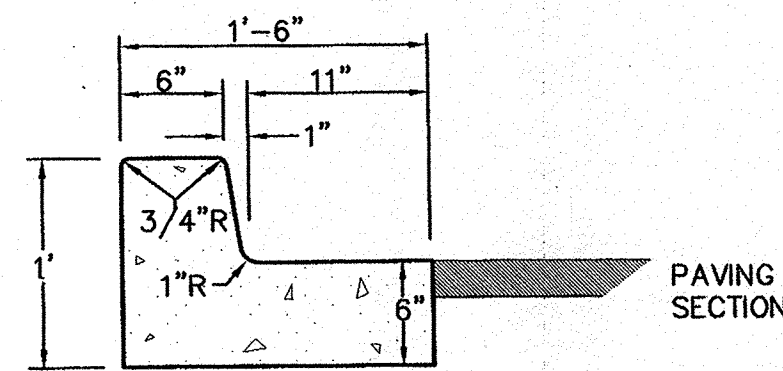


GENERAL NOTES

1. PROVIDE CONST. CONTROL JOINTS @ 6' O.C. MAX. AND 1/2" EXPANSION JOINTS @ 48' O.C. MAX
2. EDGES SHOULD BE REMOVED WITH 3/8" EDGING TOOL
3. MEDIAN C & G REQUIRE FULL FORM ON ALL FACES


3 MEDIAN CURB AND GUTTER
Scale: N.T.S.

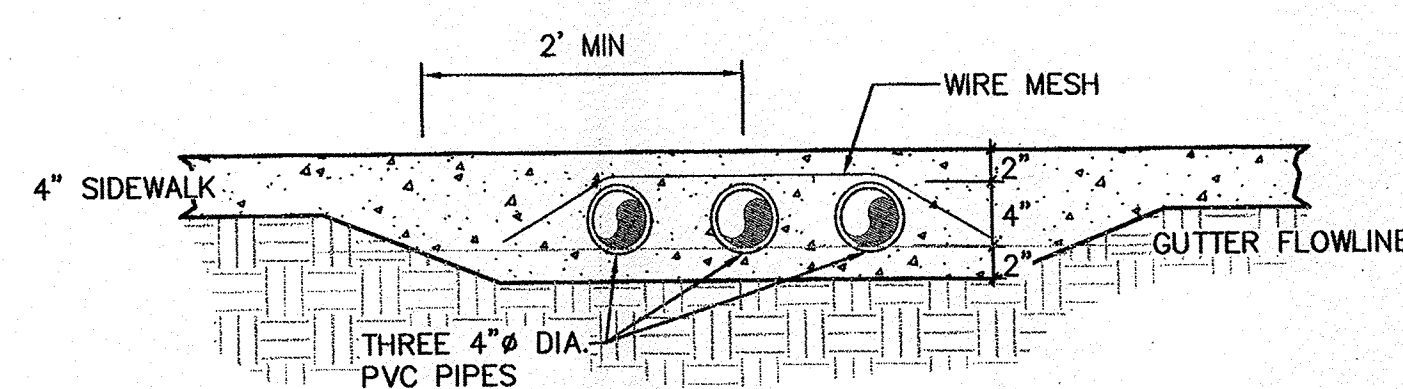


6 UNDERWALK PIPE DRAINS
Scale: N.T.S.

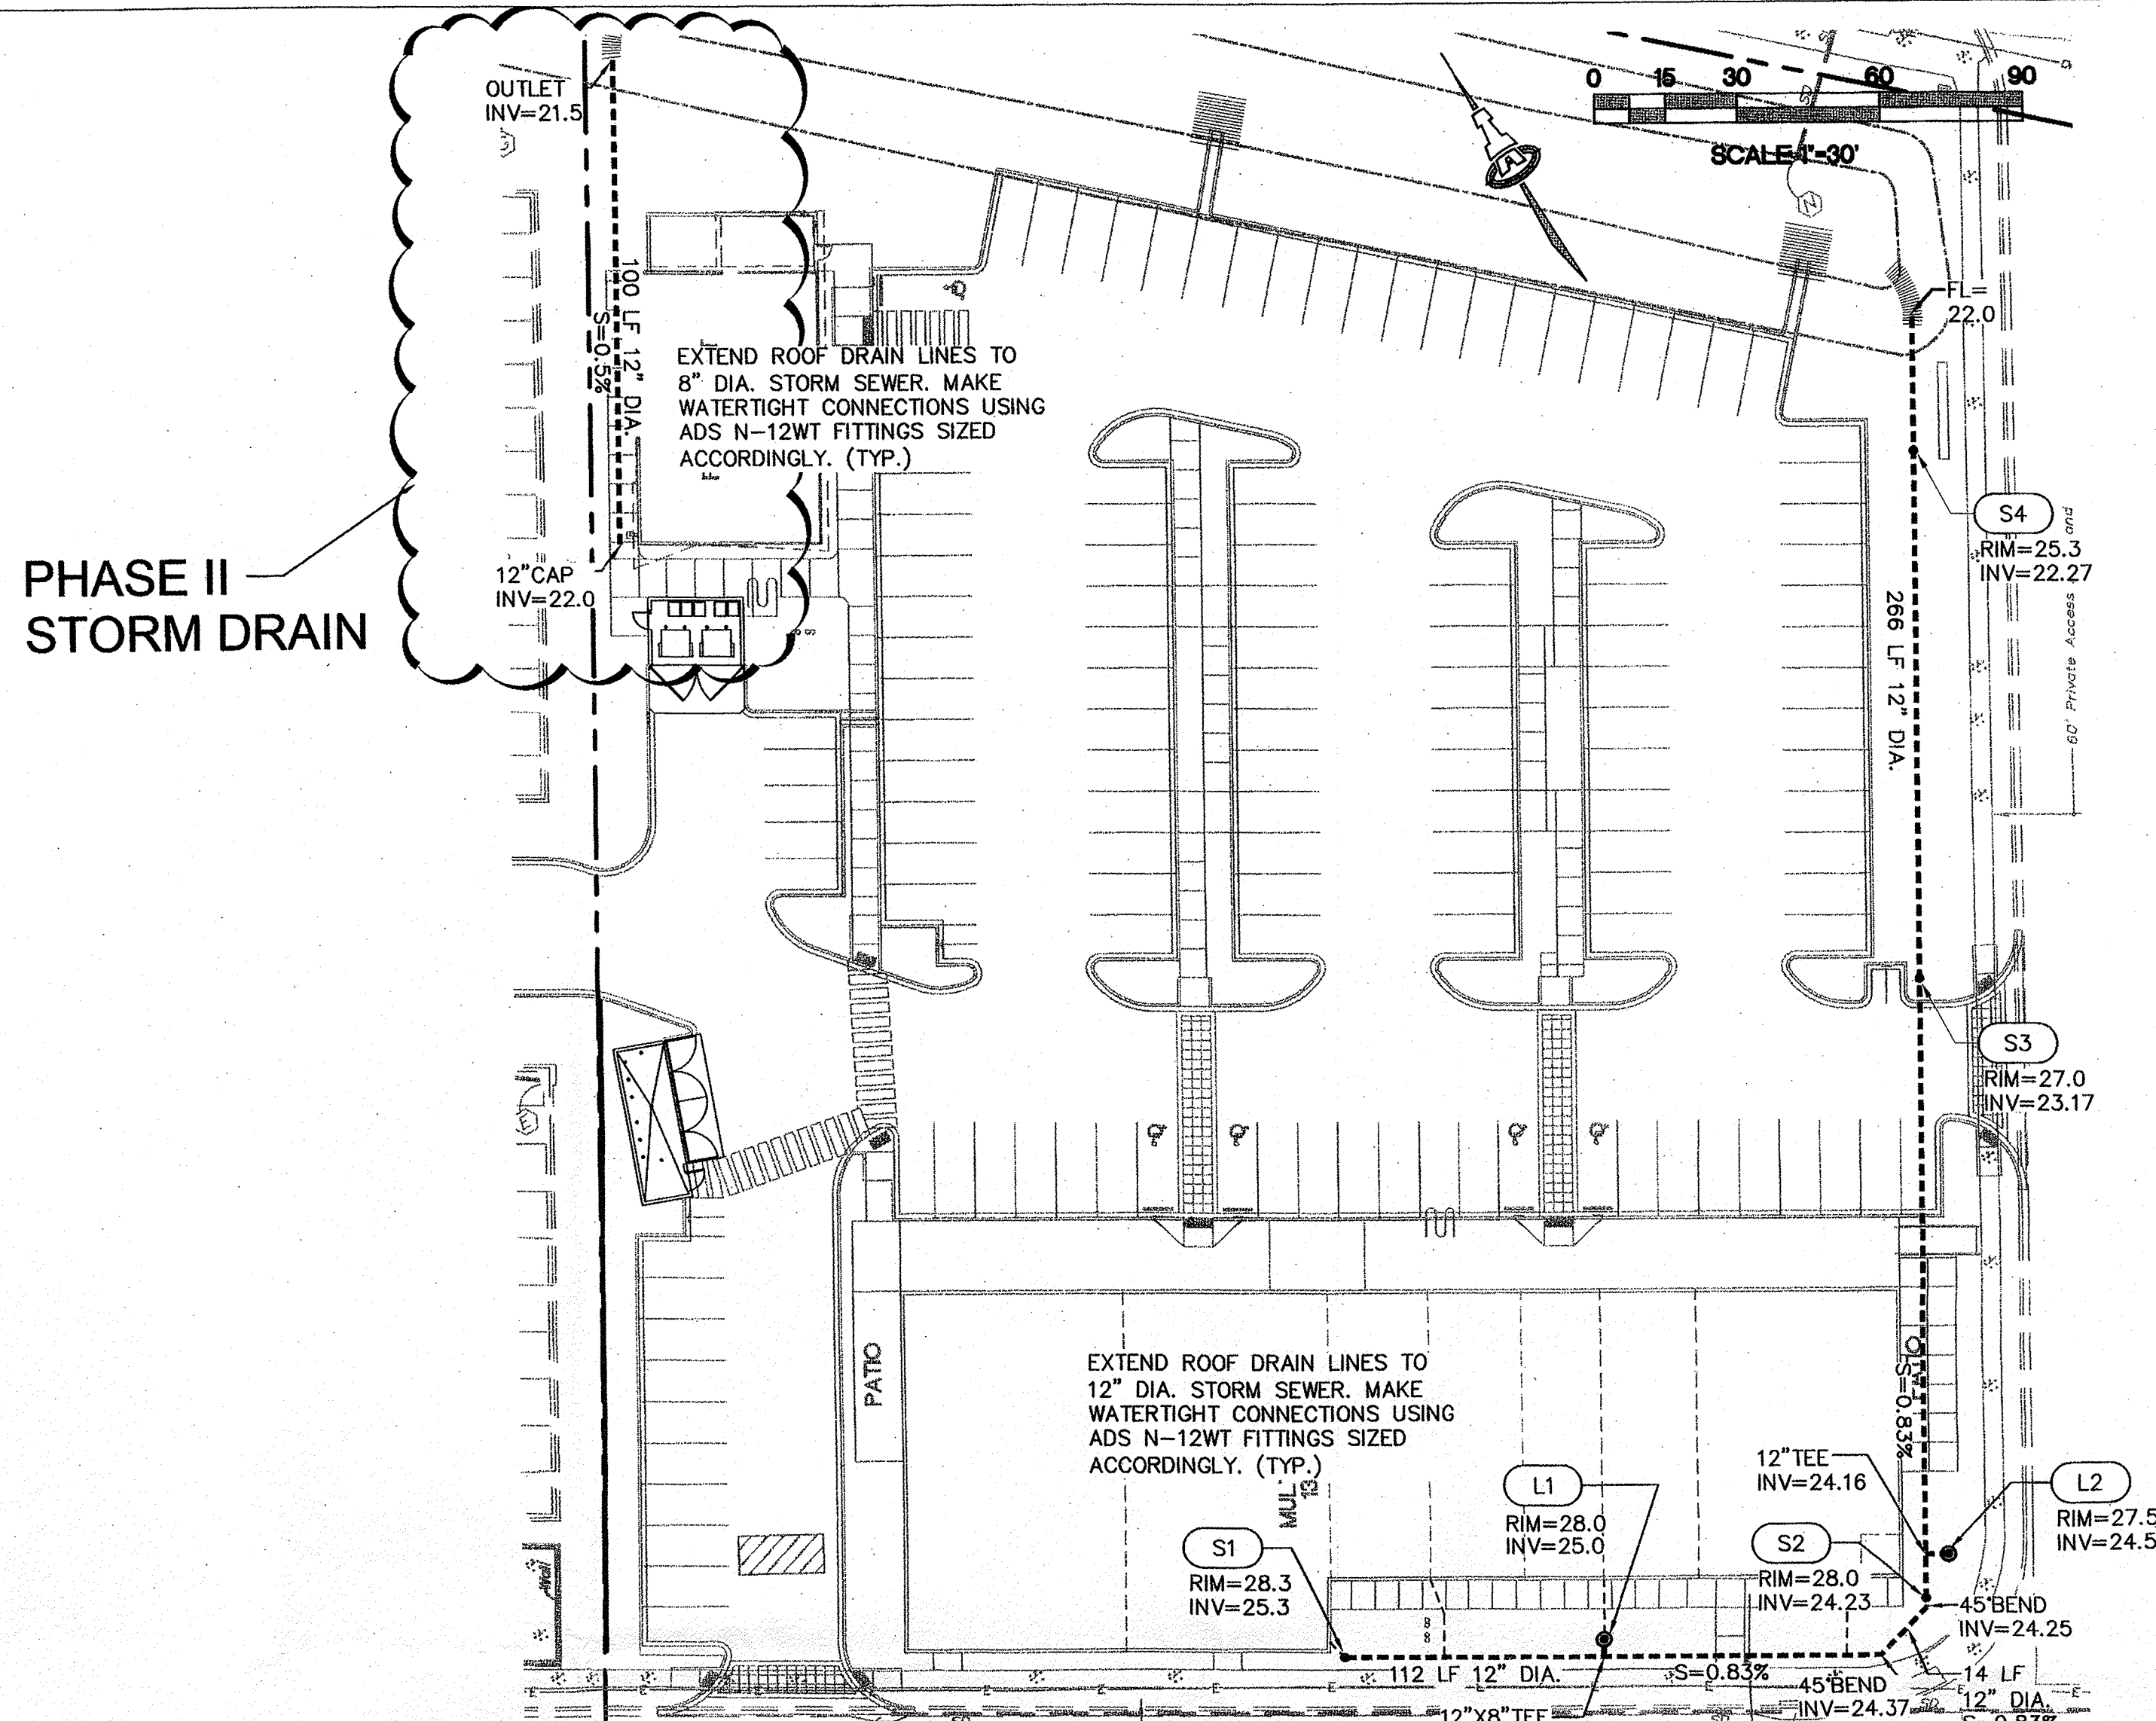


2 STORM DRAIN EXHIBIT
Scale: 1"=30'

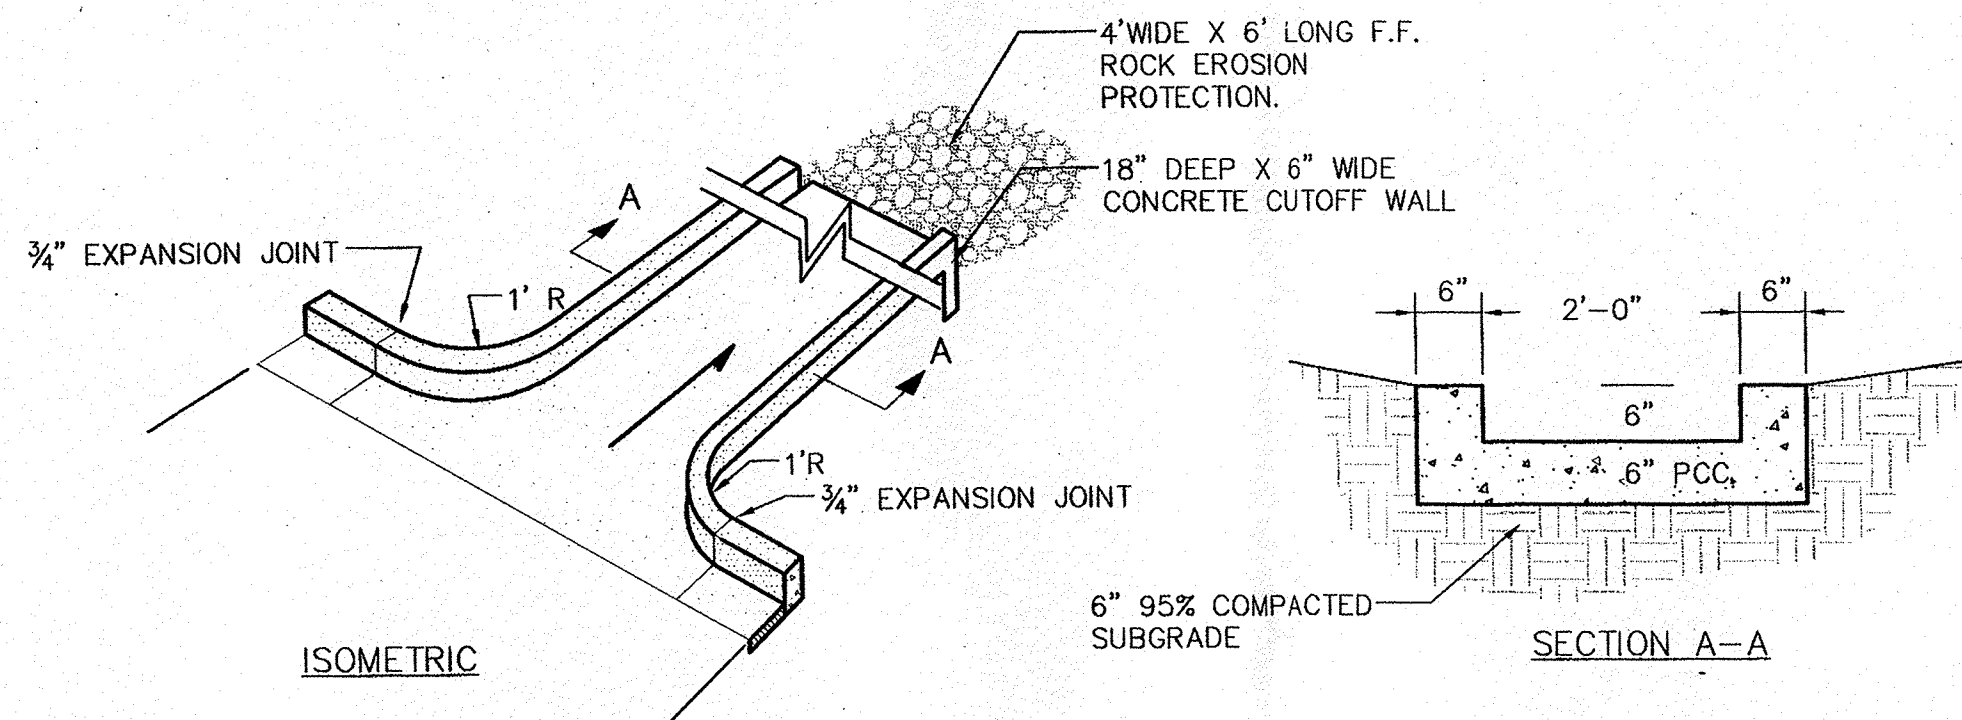


4 CONCRETE RUNDOWN
Scale: N.T.S.

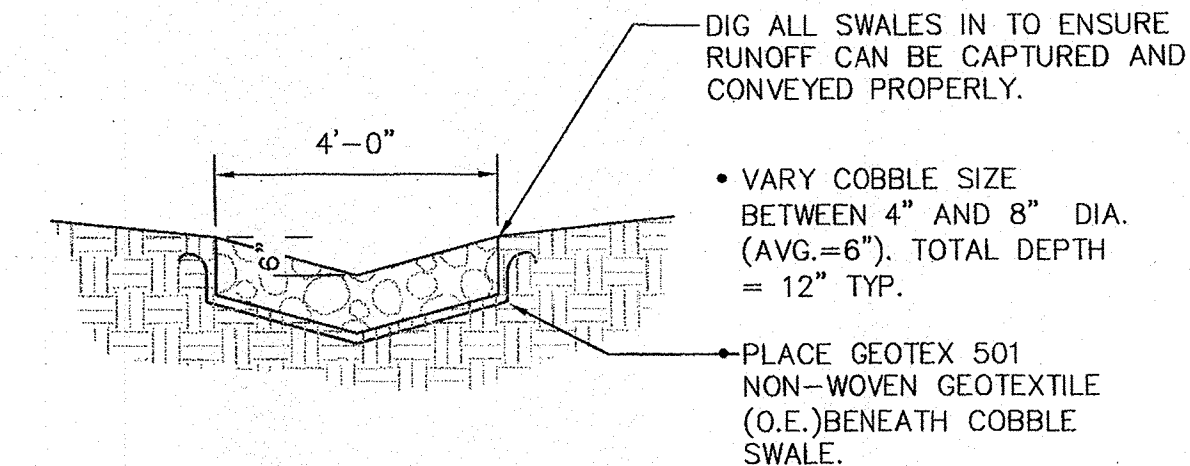

5 FRACTURED FACE ROCK SWALE
Scale: N.T.S.

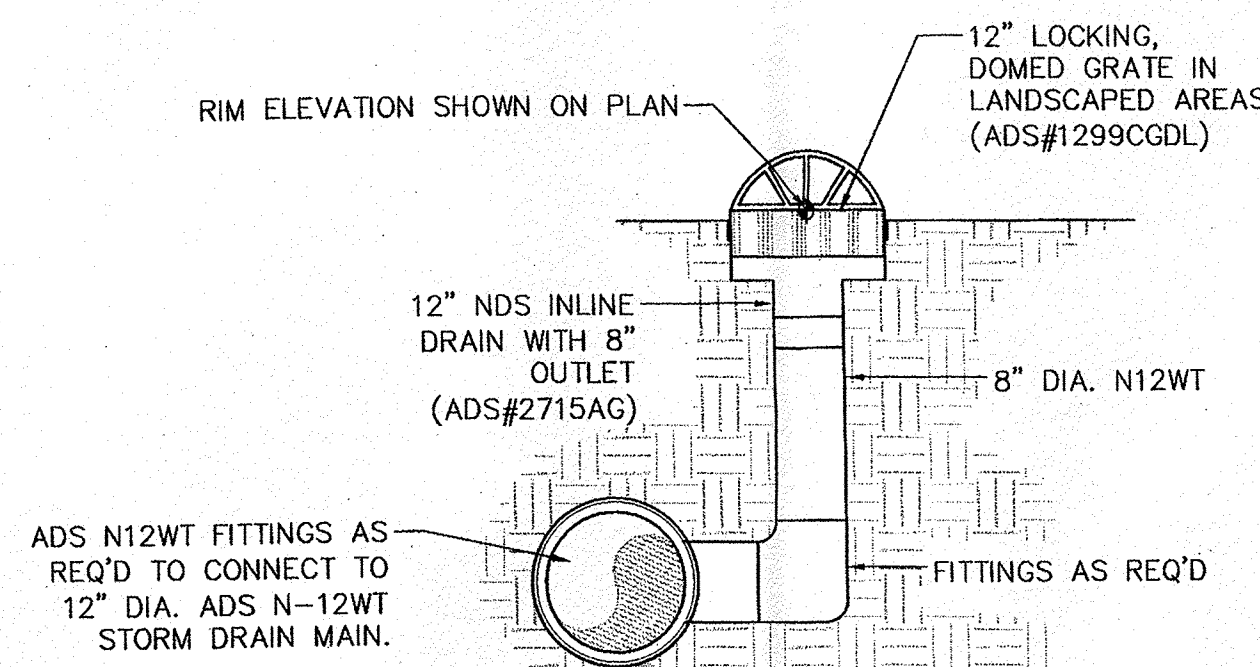


7 IN-LINE DRAIN: DOMED GRATE
Scale: N.T.S. SEE STORM DRAIN EXHIBIT L#

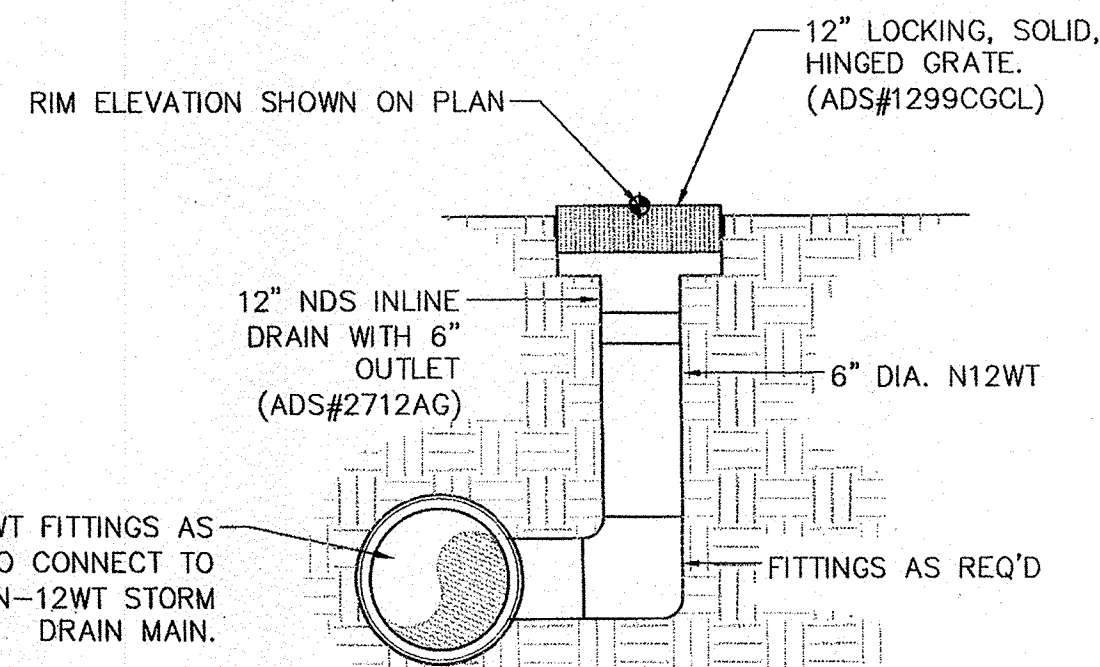

8 IN-LINE DRAIN CLEANOUT: SOLID LID
Scale: N.T.S. SEE STORM DRAIN EXHIBIT S#

LEGEND

- L# IN-LINE DRAIN: DOMED GRATE. SEE DETAIL THIS SHEET.
- S# IN-LINE DRAIN CLEANOUT: SOLID LID. SEE DETAIL THIS SHEET.

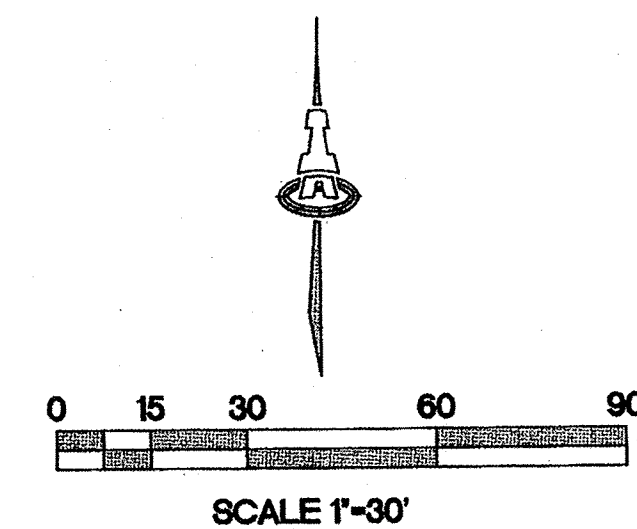

STORM DRAIN NOTES

- INSTALL ALL STORM DRAIN INLETS AND PIPE PER MANUFACTURER'S SPECIFICATIONS.
- ALL STORM DRAIN LINES AND FITTINGS TO BE ADS N-12WT WATERTIGHT O.A.E. UNLESS OTHERWISE NOTED.
- STORM DRAIN SYSTEM WILL REQUIRE REGULAR MAINTENANCE TO ENSURE PROPER FUNCTIONING DURING STORM EVENTS. ENGINEER RECOMMENDS THAT PROPERTY OWNER PUT IN PLACE INSPECTION AND MAINTENANCE CRITERIA SCHEDULED TO OCCUR MONTHLY AND AFTER EACH STORM EVENT.

ISAACSON & ARFMAN, P.A.
Consulting Engineering Associates
128 Monroe Street N.E.
Albuquerque, New Mexico 87108
Ph. 505-268-8828 www.isaacson.com

This design, calculations, and concepts are owned by and remain the property of Isaacson & Arfman, P.A. and no part thereof shall be utilized by any person, firm or corporation for any purpose whatsoever except with the written permission of Isaacson & Arfman, P.A. ©

LOWE'S SUBDMISION, LOT 3

PAVING AND DRAINAGE DETAILS

Date:	No.	Revised	Date	Job No.
01.24.12				1899
Drawn By:				CG-501
Ckd By:				SH OF