

CITY OF ALBUQUERQUE

Planning Department
Alan Varela, Interim Director



Mayor Timothy M. Keller

January 14, 2022


Mark H. Burak, P.E.
1512 Sagebrush Trail SE
Albuquerque, NM 87123

**RE: Paradise Subdivision
Grading and Drainage Plan
Engineer's Stamp Date: 11/17/21
Hydrology File: B11D014**

Dear Mr. Burak:

Based upon the information provided in your submittal received 11/24/2021, the Grading & Drainage Plan **is not** approved for Grading Permit and for action by the DRB on Preliminary Plat. The following comments need to be addressed for approval of the above referenced project:

1. It is unclear what is being constructed and what is existing. The line work for the existing is the same line weight as proposed. Also, what is the hatching on some of the lots? Please clean this up.

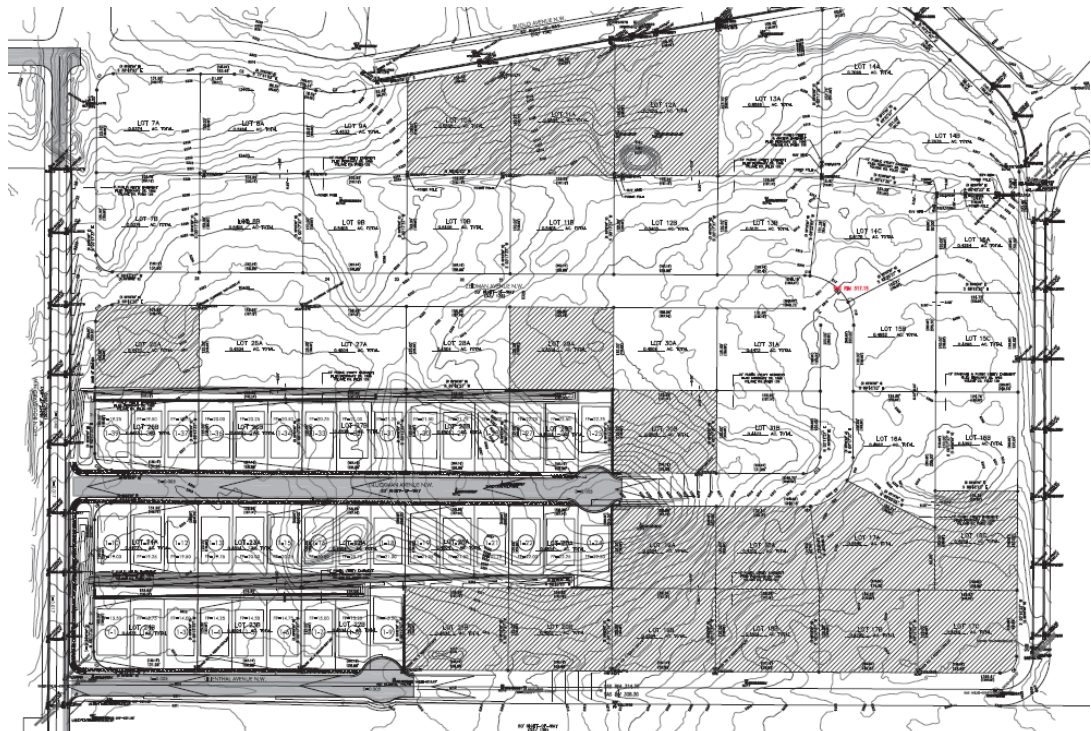

CITY OF ALBUQUERQUE

Planning Department
Alan Varela, Interim Director



Mayor Timothy M. Keller

- Please provide for a Legend. Here are some examples.

LEGEND		LEGEND	
---	EXISTING CONTOUR	• 5235.25	PROPOSED SPOT ELEVATION
• 5233.34'	EXISTING SPOT ELEVATION	• EX 5235.25	EXISTING SPOT ELEVATION
---	PROPOSED CONTOUR	---	PROPOSED CONTOUR
• 30.63	PROPOSED SPOT ELEVATION	---	EXISTING STORM DRAIN LINE
PG= 5240.5	PAD GRADE ELEVATION	---	PROPOSED STORM DRAIN INLET
→	FLOW ARROW	---	PROPOSED STORM DRAIN LINE
---	STORM DRAIN	---	PROPOSED STORM DRAIN MANHOLE
---	STORM INLET	---	PROPOSED WATER BLOCK
---	RETAINING WALL	---	RETAINING WALL
---	DRIVEWAY LOCATION DESIGNATED TO AVOID CONFLICT WITH STORM INLETS	---	PAD
		---	TURNED BLOCK
		---	STREET SLOPE


- Your Grading Plan is missing typical grades that are needed in order to review and approve this project.

PO Box 1293

Albuquerque

NM 87103

www.cabq.gov

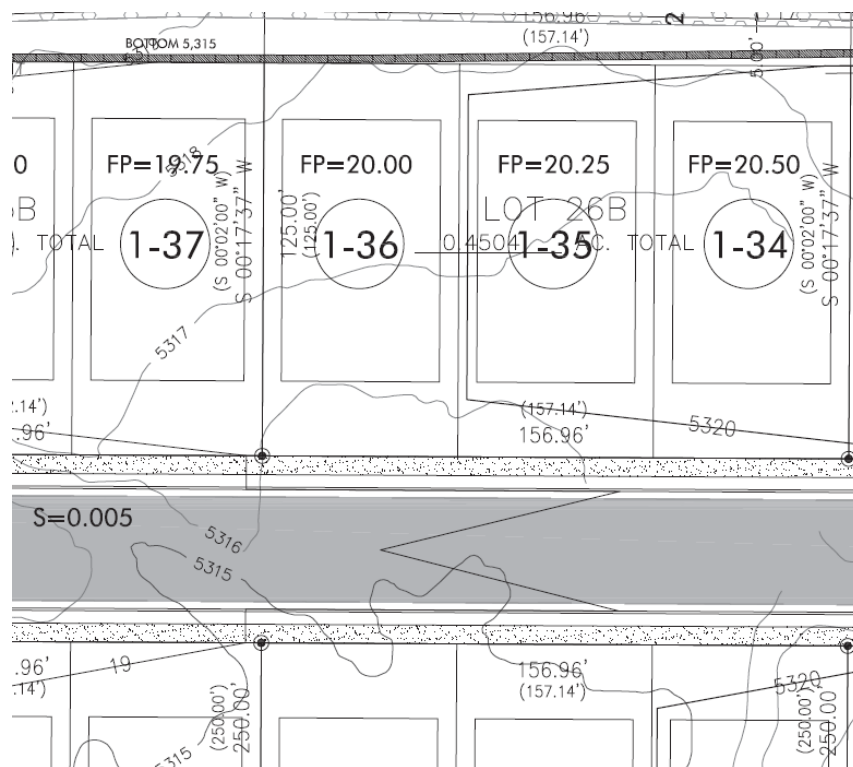


Also, here are two subdivision grading plans.

CITY OF ALBUQUERQUE

Planning Department
Alan Varela, Interim Director



Mayor Timothy M. Keller

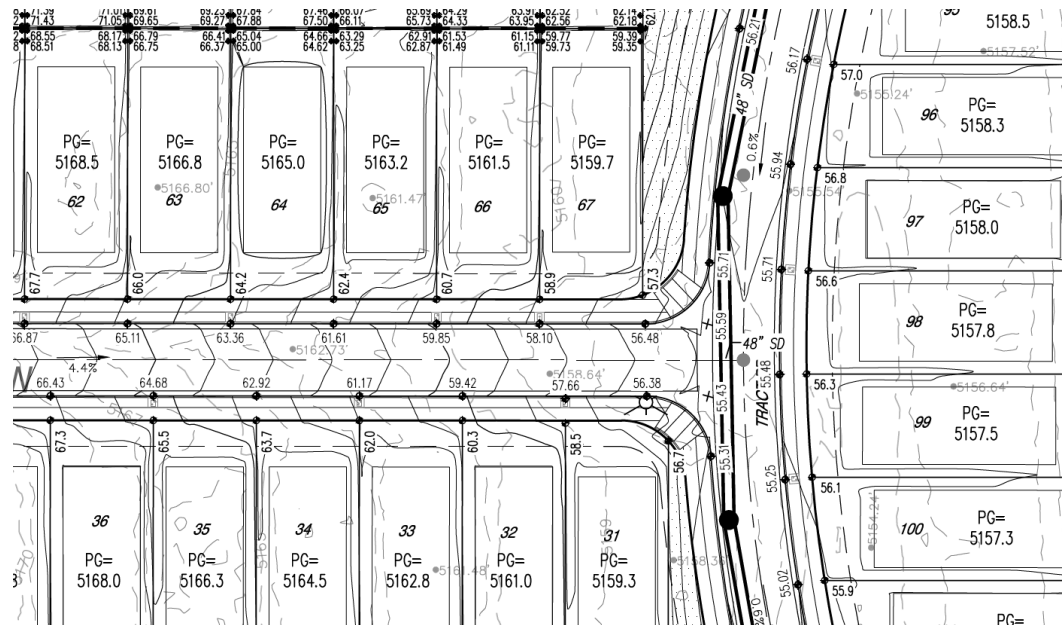


PO Box 1293

Albuquerque

NM 87103

www.cabq.gov

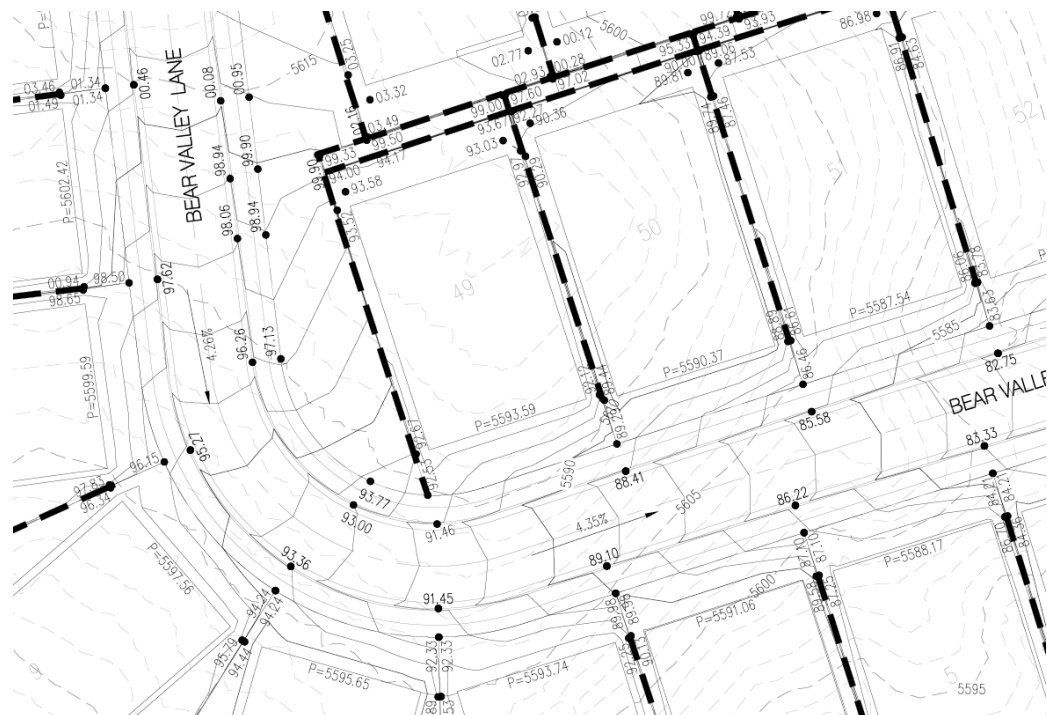


CITY OF ALBUQUERQUE

Planning Department
Alan Varela, Interim Director



Mayor Timothy M. Keller

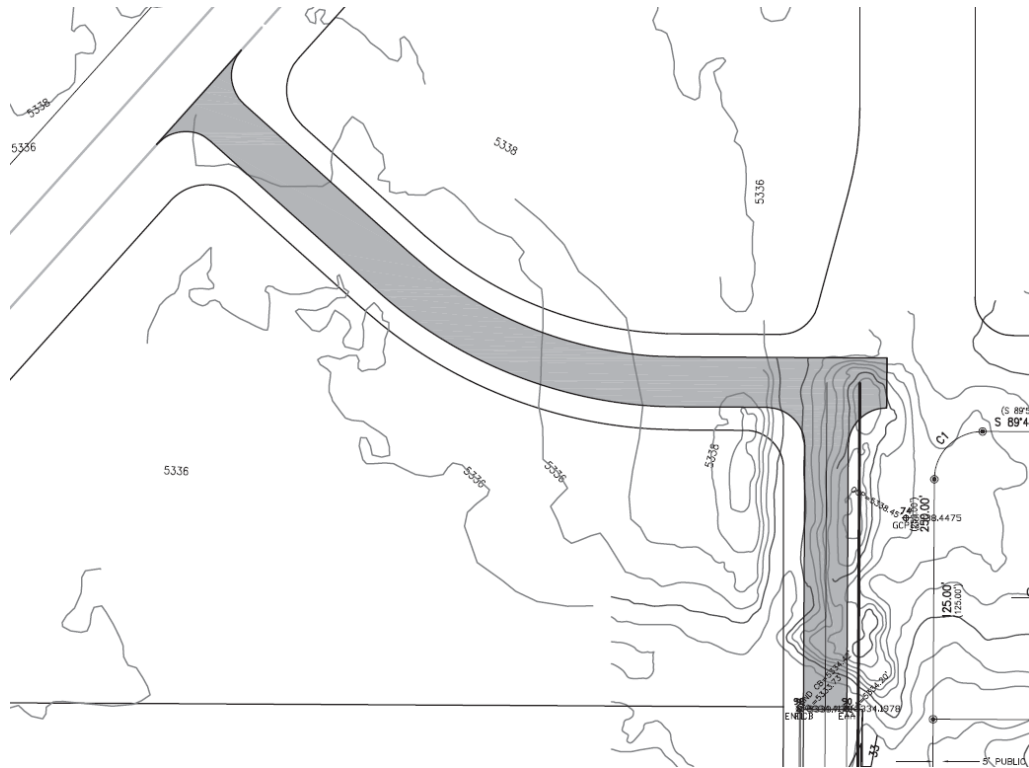


PO Box 1293

Albuquerque

Typically, the existing subdivision only paves half the street and this project will pave the other half, along with curb & gutter, and sidewalk.

NM 87103

www.cabq.gov

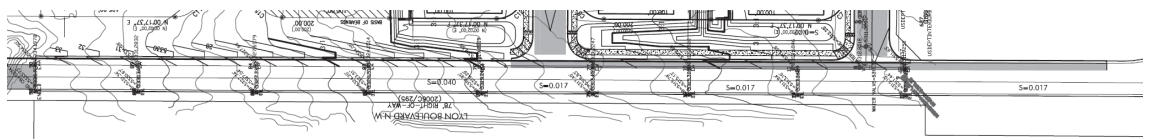


CITY OF ALBUQUERQUE

Planning Department
Alan Varela, Interim Director



Mayor Timothy M. Keller

5. For Subdivisions and especially for this one, please provide a Drainage Repot. Within this report, I will need Drainage Basin for the project and the off-site drainage. I will also need street capacity calculation for all public R.O.W. being constructed.
6. All drainage from the public R.O.W. and single family lots will have to drain into a public retention pond (100 year – 10 day volume) on a HOA owned tract. This pond will also need to provided for a maintenance ramp, gate, and an Agreement & Covenant will also need to be filled for the pond. This retention pond cannot be placed on the single-family lots. There is a current drainage basin on Blue Feather & Lyon. However, this retention pond was only sized for the following drainage basin.

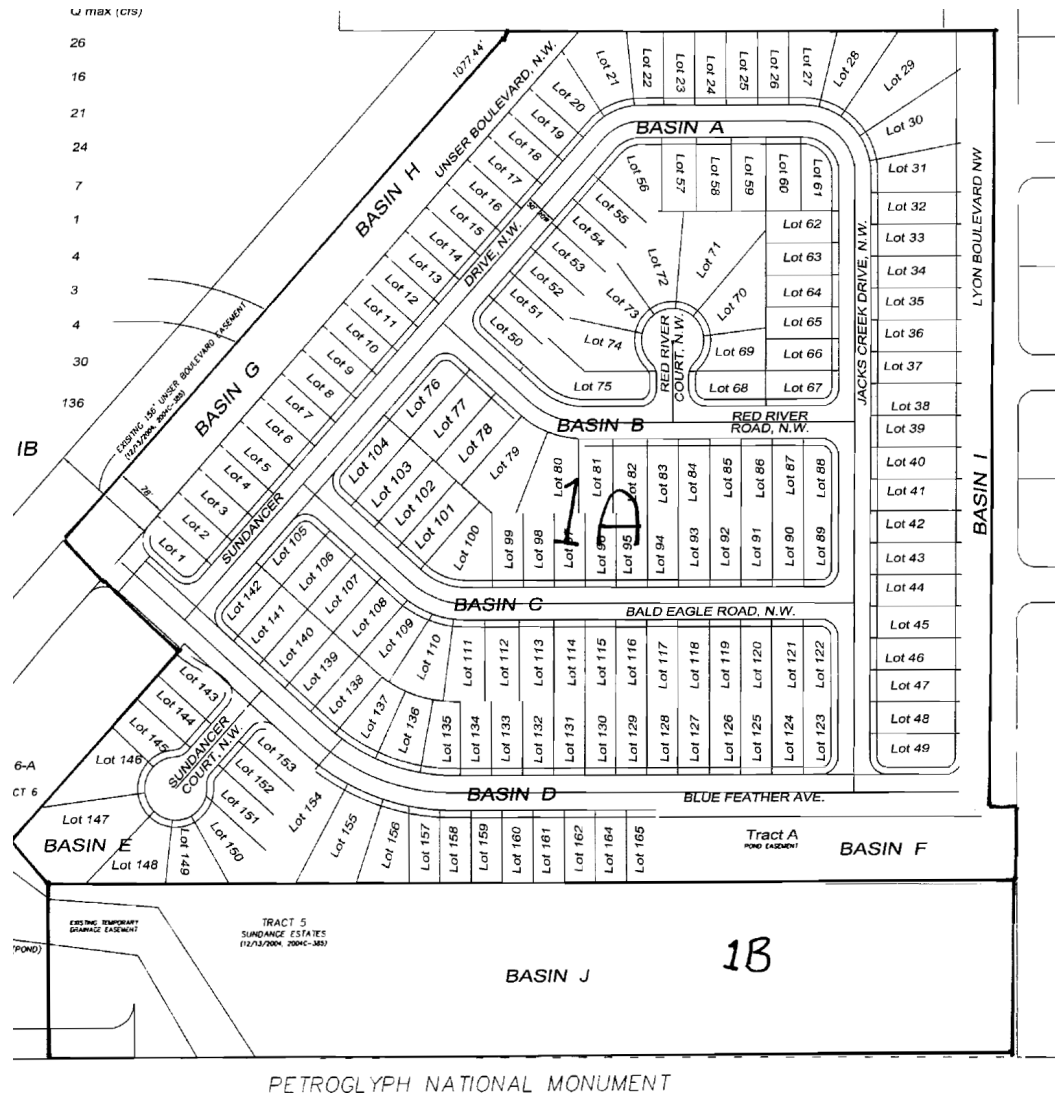

The Proposed drainage needs to be directed as shown into proposed inlets & pipe into a retention pond on an HOA Tracts as shown. The blue drainage arrows are areas that may


CITY OF ALBUQUERQUE

Planning Department
Alan Varela, Interim Director



Mayor Timothy M. Keller

discharge into the existing retention pond if the current HOA that owns and maintains it agrees to accept the minimal increase in drainage.

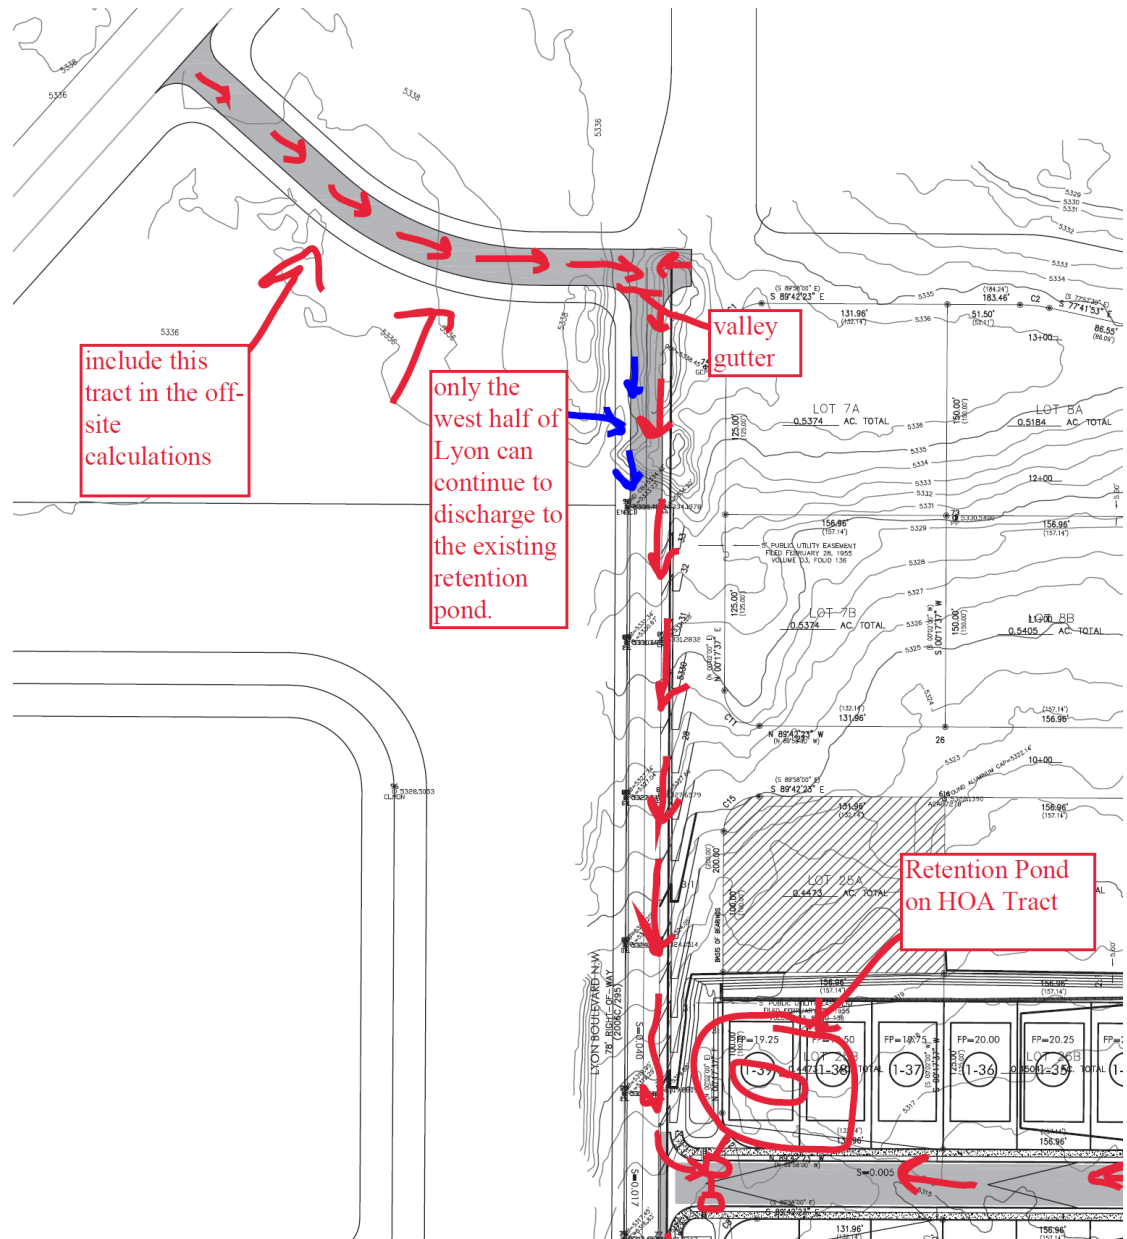

PO Box 1293

Albuquerque

NM 87103


www.cabq.gov

CITY OF ALBUQUERQUE

Planning Department
Alan Varela, Interim Director



Mayor Timothy M. Keller

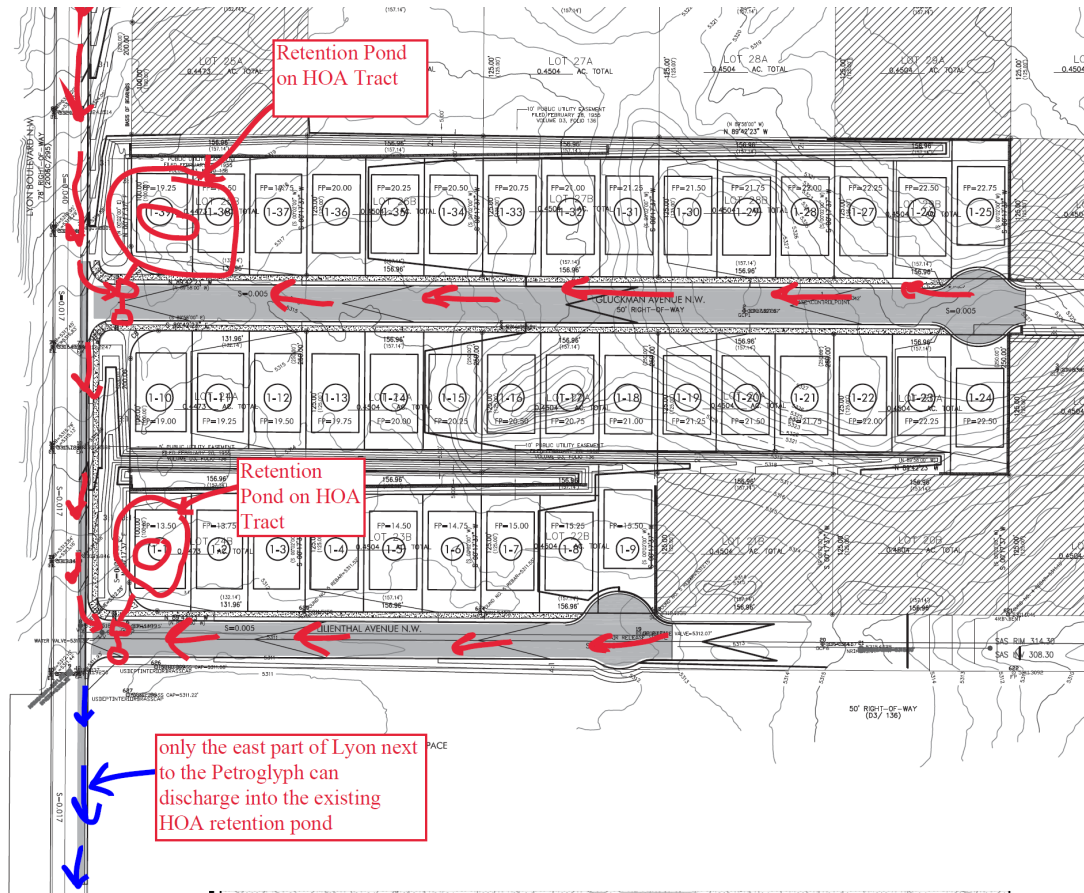


PO Box 1293

Albuquerque

NM 87103

www.cabq.gov

7. It appears that both temporary cul-de-sacs are not designed to City standards. Please verify.
8. Also, the temporary turn-a-rounds are placed as shown so that once the subdivision's roadway continues the temporary turn-a-round will be removed.

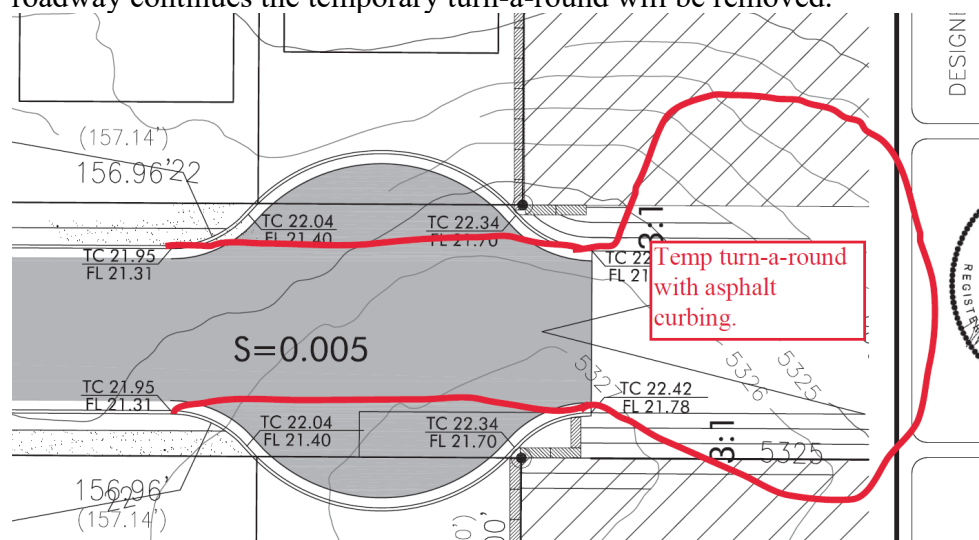


CITY OF ALBUQUERQUE

Planning Department
Alan Varela, Interim Director



Mayor Timothy M. Keller

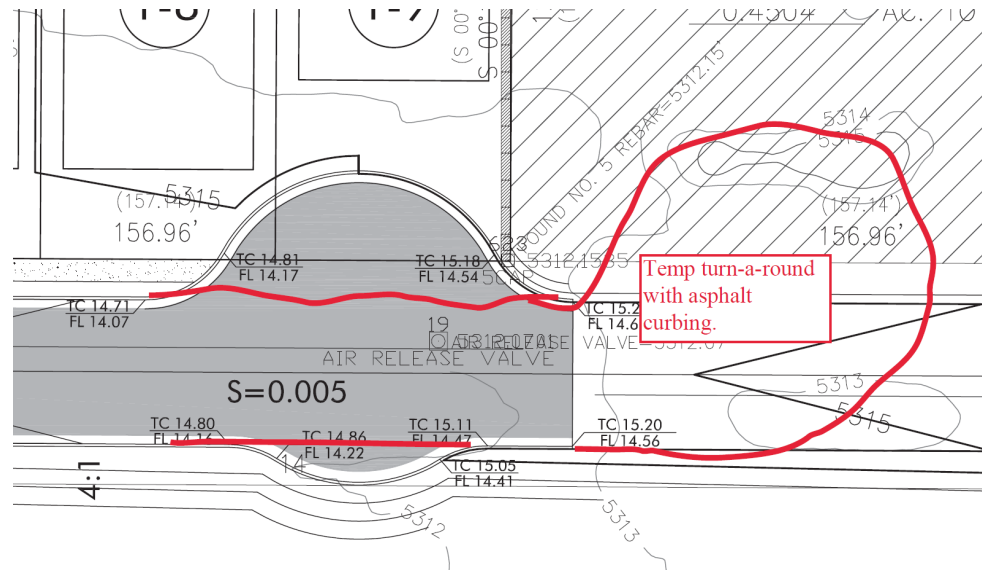


9. There will be **no grading** on City of Albuquerque Open Space (Petroglyphs).

PO Box 1293

Albuquerque

NM 87103

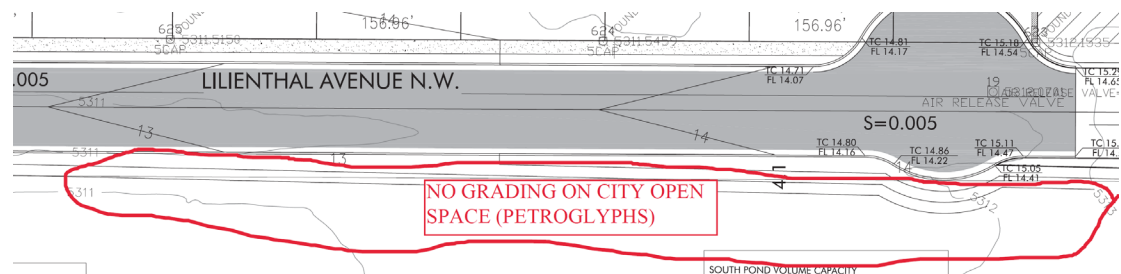

www.cabq.gov

As a reminder, if the project total area of disturbance (including the staging area and any work within the adjacent Right-of-Way) is 1 acre or more, then an Erosion and Sediment Control (ESC) Plan and Owner's certified Notice of Intent (NOI) is required to be submitted to the Stormwater Quality Engineer (Dough Hughes, PE, jhughes@cabq.gov, 924-3420) 14 days prior to any earth disturbance.

If you have any questions, please contact me at 924-3995 or rbrissette@cabq.gov.

Sincerely,

Renée C. Brissette

Renée C. Brissette, P.E. CFM
Senior Engineer, Hydrology
Planning Department



City of Albuquerque

Planning Department
Development & Building Services Division

DRAINAGE AND TRANSPORTATION INFORMATION SHEET (REV 6/2018)

Project Title: Paradise Subdivision **Building Permit#:** _____ **Hydrology File#:** _____
DRB#: PR-2020-004443 **EPC#:** _____ **Work Order#:** _____
Legal Description: Lots 20A-24A, 22B-24B, 25B-29B, Paradise Hills Investment Properties, Unit 1
City Address: Lyon / Lilienthal / Gluckman

Applicant: Burak Consulting **Contact:** Mark Burak, PE
Address: 1512 Sagebrush Tr SE, 87123
Phone#: (505) 235-2256 **Fax#:** _____ **E-mail:** mburak@comcast.net

Other Contact: Desert Fox, LLC **Contact:** Mohamad Tahat
Address: Felix Rabadi
Phone#: (575) 650-0380 (505) 440-6443 **Fax#:** _____ **E-mail:** _____

TYPE OF DEVELOPMENT : 39 PLAT (# of lots) _____ RESIDENCE _____ DRB SITE _____ ADMIN SITE _____

IS THIS A RESUBMITTAL? _____ Yes X No

DEPARTMENT _____ TRANSPORTATION X HYDROLOGY/DRAINAGE

Check all that Apply:

TYPE OF SUBMITTAL:

- ☐ ENGINEER/ARCHITECT CERTIFICATION
- ☐ PAD CERTIFICATION
- ☐ CONCEPTUAL G & D PLAN
- ☒ GRADING PLAN
- ☐ DRAINAGE REPORT
- ☐ DRAINAGE MASTER PLAN
- ☐ FLOODPLAIN DEVELOPMENT PERMIT APPLICATION
- ☐ ELEVATION CERTIFICATE
- ☐ CLOMR/LOMR
- ☐ TRAFFIC CIRCULATION LAYOUT (TCL)
- ☐ TRAFFIC IMPACT STUDY (TIS)
- ☐ STREET LIGHT LAYOUT
- ☐ OTHER (SPECIFY) _____
- ☐ PRE-DESIGN MEETING?

TYPE OF APPROVAL/ACCEPTANCE SOUGHT:


- ☐ BUILDING PERMIT APPROVAL
- ☐ CERTIFICATE OF OCCUPANCY
- ☒ PRELIMINARY PLAT APPROVAL
- ☐ SITE PLAN FOR SUB'D APPROVAL
- ☐ SITE PLAN FOR BLDG. PERMIT APPROVAL
- ☐ FINAL PLAT APPROVAL
- ☐ SIA/ RELEASE OF FINANCIAL GUARANTEE
- ☐ FOUNDATION PERMIT APPROVAL
- ☒ GRADING PERMIT APPROVAL
- ☐ SO-19 APPROVAL
- ☐ PAVING PERMIT APPROVAL
- ☐ GRADING/ PAD CERTIFICATION
- ☐ WORK ORDER APPROVAL
- ☐ CLOMR/LOMR
- ☐ FLOODPLAIN DEVELOPMENT PERMIT
- ☐ OTHER (SPECIFY) _____

DATE SUBMITTED: November 17, 2021 **By:** Mark Burak


COA STAFF:

ELECTRONIC SUBMITTAL RECEIVED: _____

FEE PAID: _____

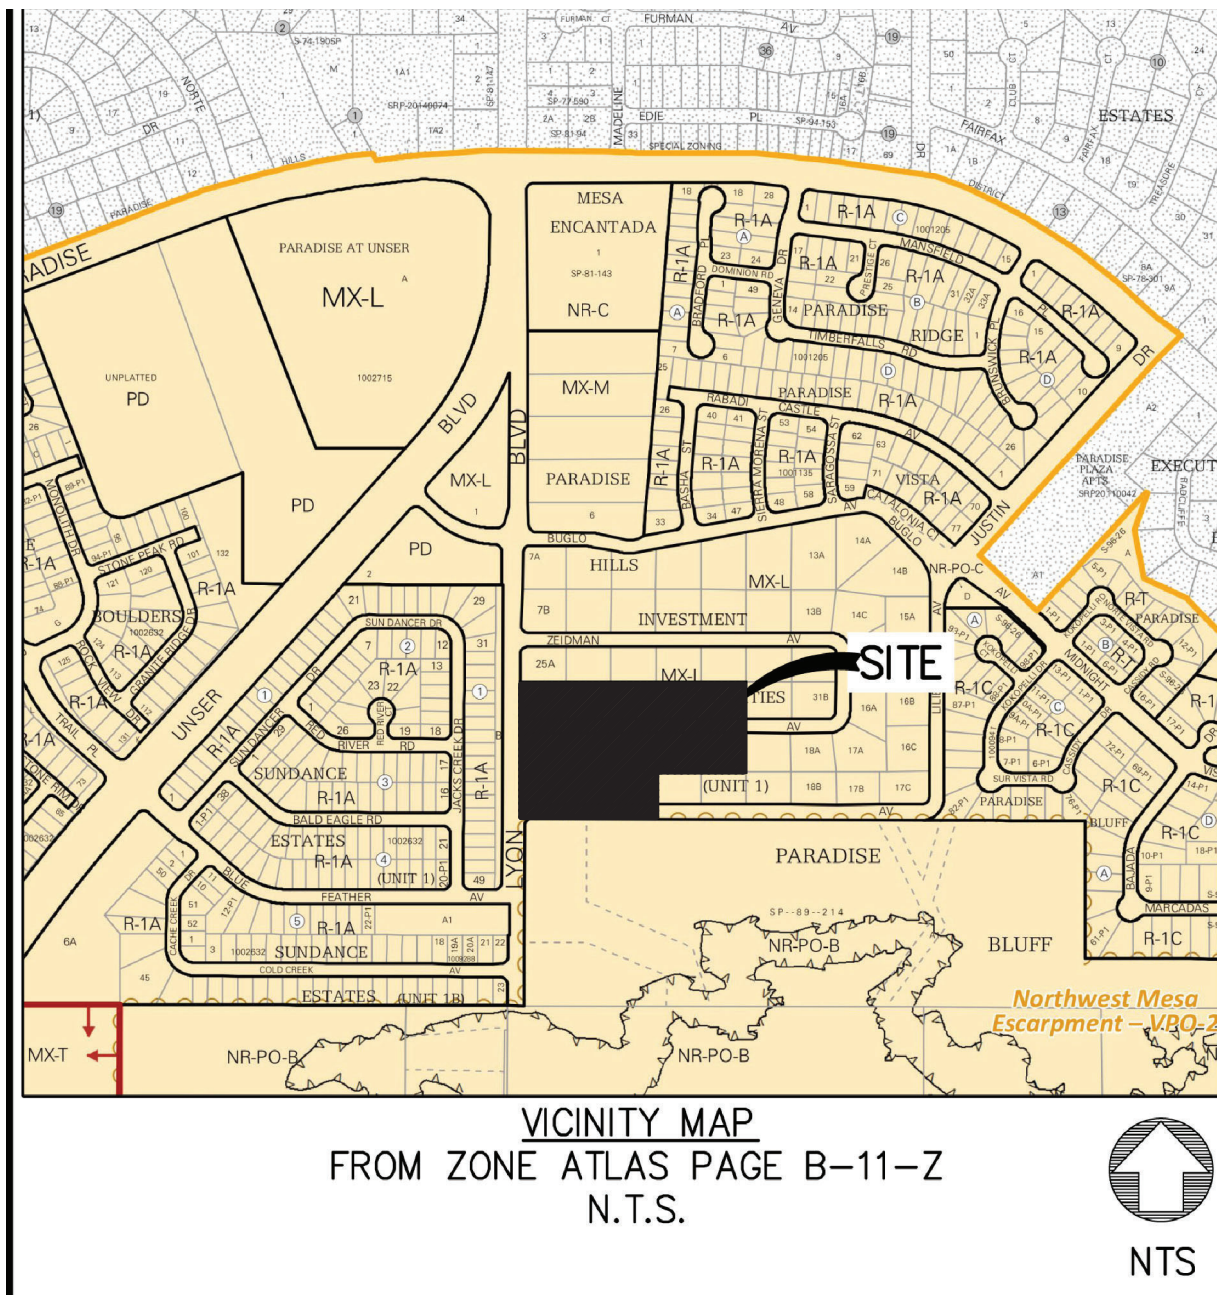

NTS

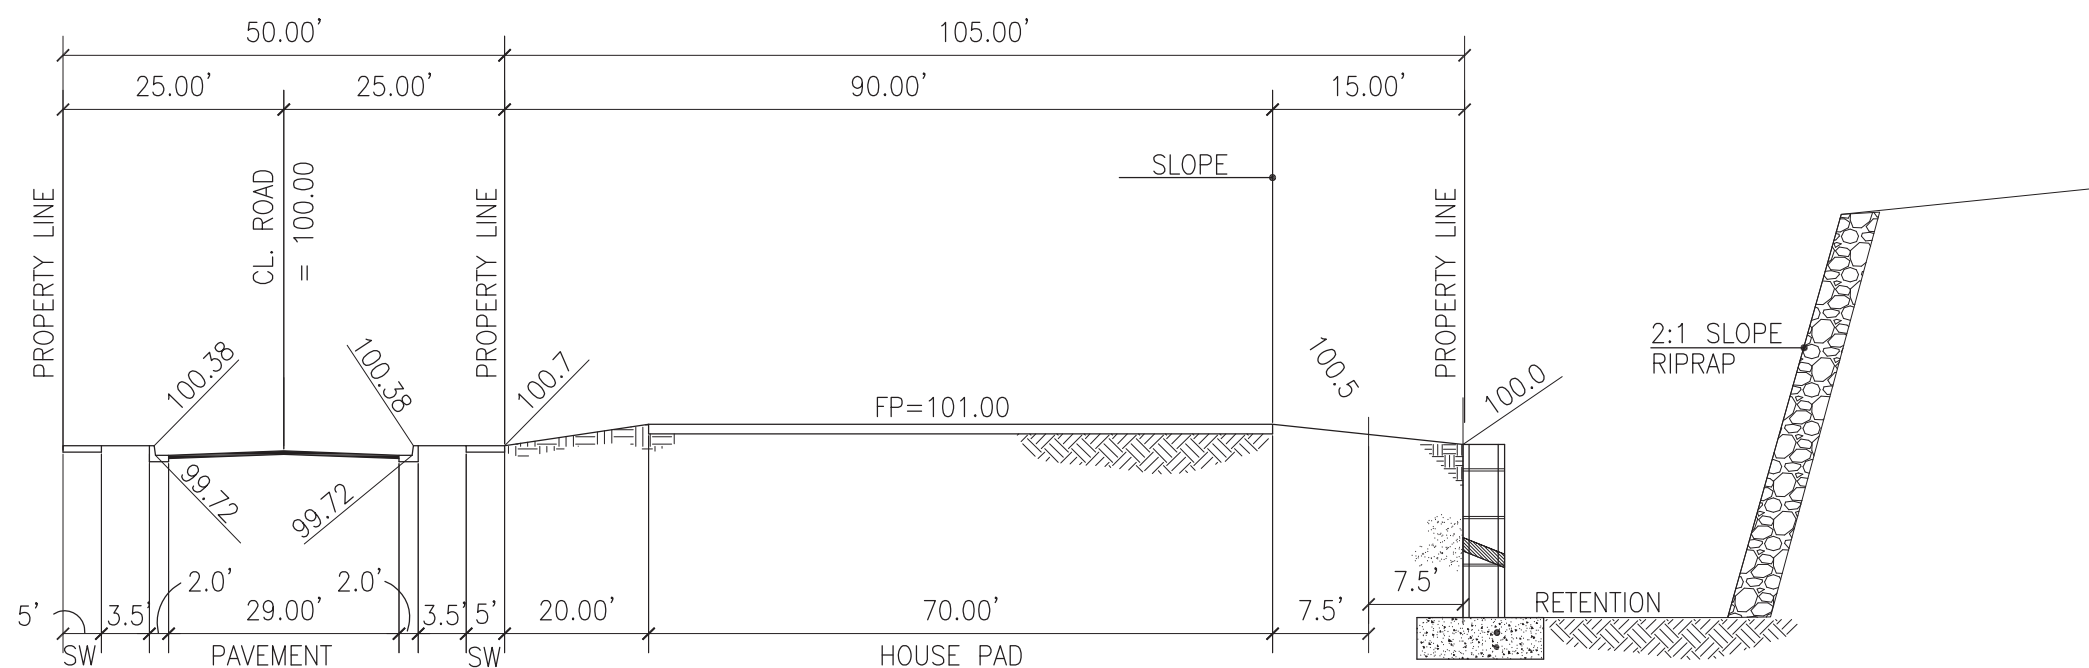




SECTION

STREET FLOWS			
Note: Manning's <i>n</i> for flow capacity in a street section.			
Lilienthal - North Side of Roadway Capacity (full section 12-ft curb to curb)			
Input variables:		Output Parameters:	
Depth of flow	0.40 ft	Capacity at d	12.5 cfs
Width (back of curb)	33.0 ft	at top of curb	25.0 cfs
Crown height	0.32 ft	at back of walk	37.0 cfs
Street slope	0.50 ft	Velocity at d	2.0 fps
Sidewalk width	5.0 ft	Hydraulic jump	0.48 ft
Curb height	6.0 ft	Scutter width	1.5 ft
Median width	0.0 ft	Gutter depression	1.5 in
Rt back of walk	100.0 ft	Asphalt lip	0 in
Lt back of walk	100.0 ft	Manning's n	0.017
Note: Manning's 2.24 ft/s back of curb, depth of flow would exceed		1.195 ft/s BURAK	
Note: Input 100% slope of side of back of curb for vertical walls.			

STREET FLOWS			
Manning's Equation for flow capacity in a street section			
Gluckman - capacity (full section 11.5-cfs)			
Input variables:		Output Parameters:	
Depth of flow	0.39 ft	Capacity at d	11.4 cfs
Width (back of curb)	3.32 ft	@ top of curb	25.0 cfs
Crown height	0.30 ft	@ back of walk	37.0 cfs
Street slope	0.50 %	Velocity at d	2.0 fps
Sidewalk width	5.0 ft	Hydraulic Jump	0.45 ft
Curb height	6.00 in	Sutter weir	1.45 ft
Median width	0.0 ft	Gutter depression	1.5 in
RT back of walk	100.0 ft	Asphalt lip	0 in
LT back of walk	125.0 ft	Manning's n	0.017
Note: Manning's 2.48 cfs/sq ft		0.185 sec	
Note: Input 100% slope at back of walk for verticalized		BURAK	

90% Compensatory Volume Management – The first flush has been mitigated based on the impervious areas listed on the attached spreadsheet. This equates to the total impervious area of the site multiplied by 0.615-inches or about 3,000 cubic feet for the northern retention pond and 5,000 cubic feet for the southern ponding areas. This storage has been provided on the plan by the retention basins as shown.

DRAWING NUMBER	C1		1 OF 3
PARADISE SUBDIVISION	GRADING & DRAINAGE PLAN		COVER
<div style="display: flex; justify-content: space-between; align-items: center;"> <div style="text-align: center;">  <p>Civil Engineering BURAK Consulting Incorporated and Licensed in the State of California</p> </div> <div style="text-align: center;"> <p>Mark H. Burak, P.E. 1512 Sagebrush Trail SE Albuquerque, New Mexico, 87123 (505) 235-2256 mburak@comcast.net</p> </div> </div>			
<div style="display: flex; justify-content: space-between; align-items: center;"> <div style="text-align: center;">  <p>11/17/2021</p> </div> <div style="text-align: center;"> <p>DESIGNED BY: M.H.B.</p> <p>DRAWN BY: T.D.S.</p> <p>CHECKED BY:</p> </div> </div>			
		REVISION	BY DATE MARK

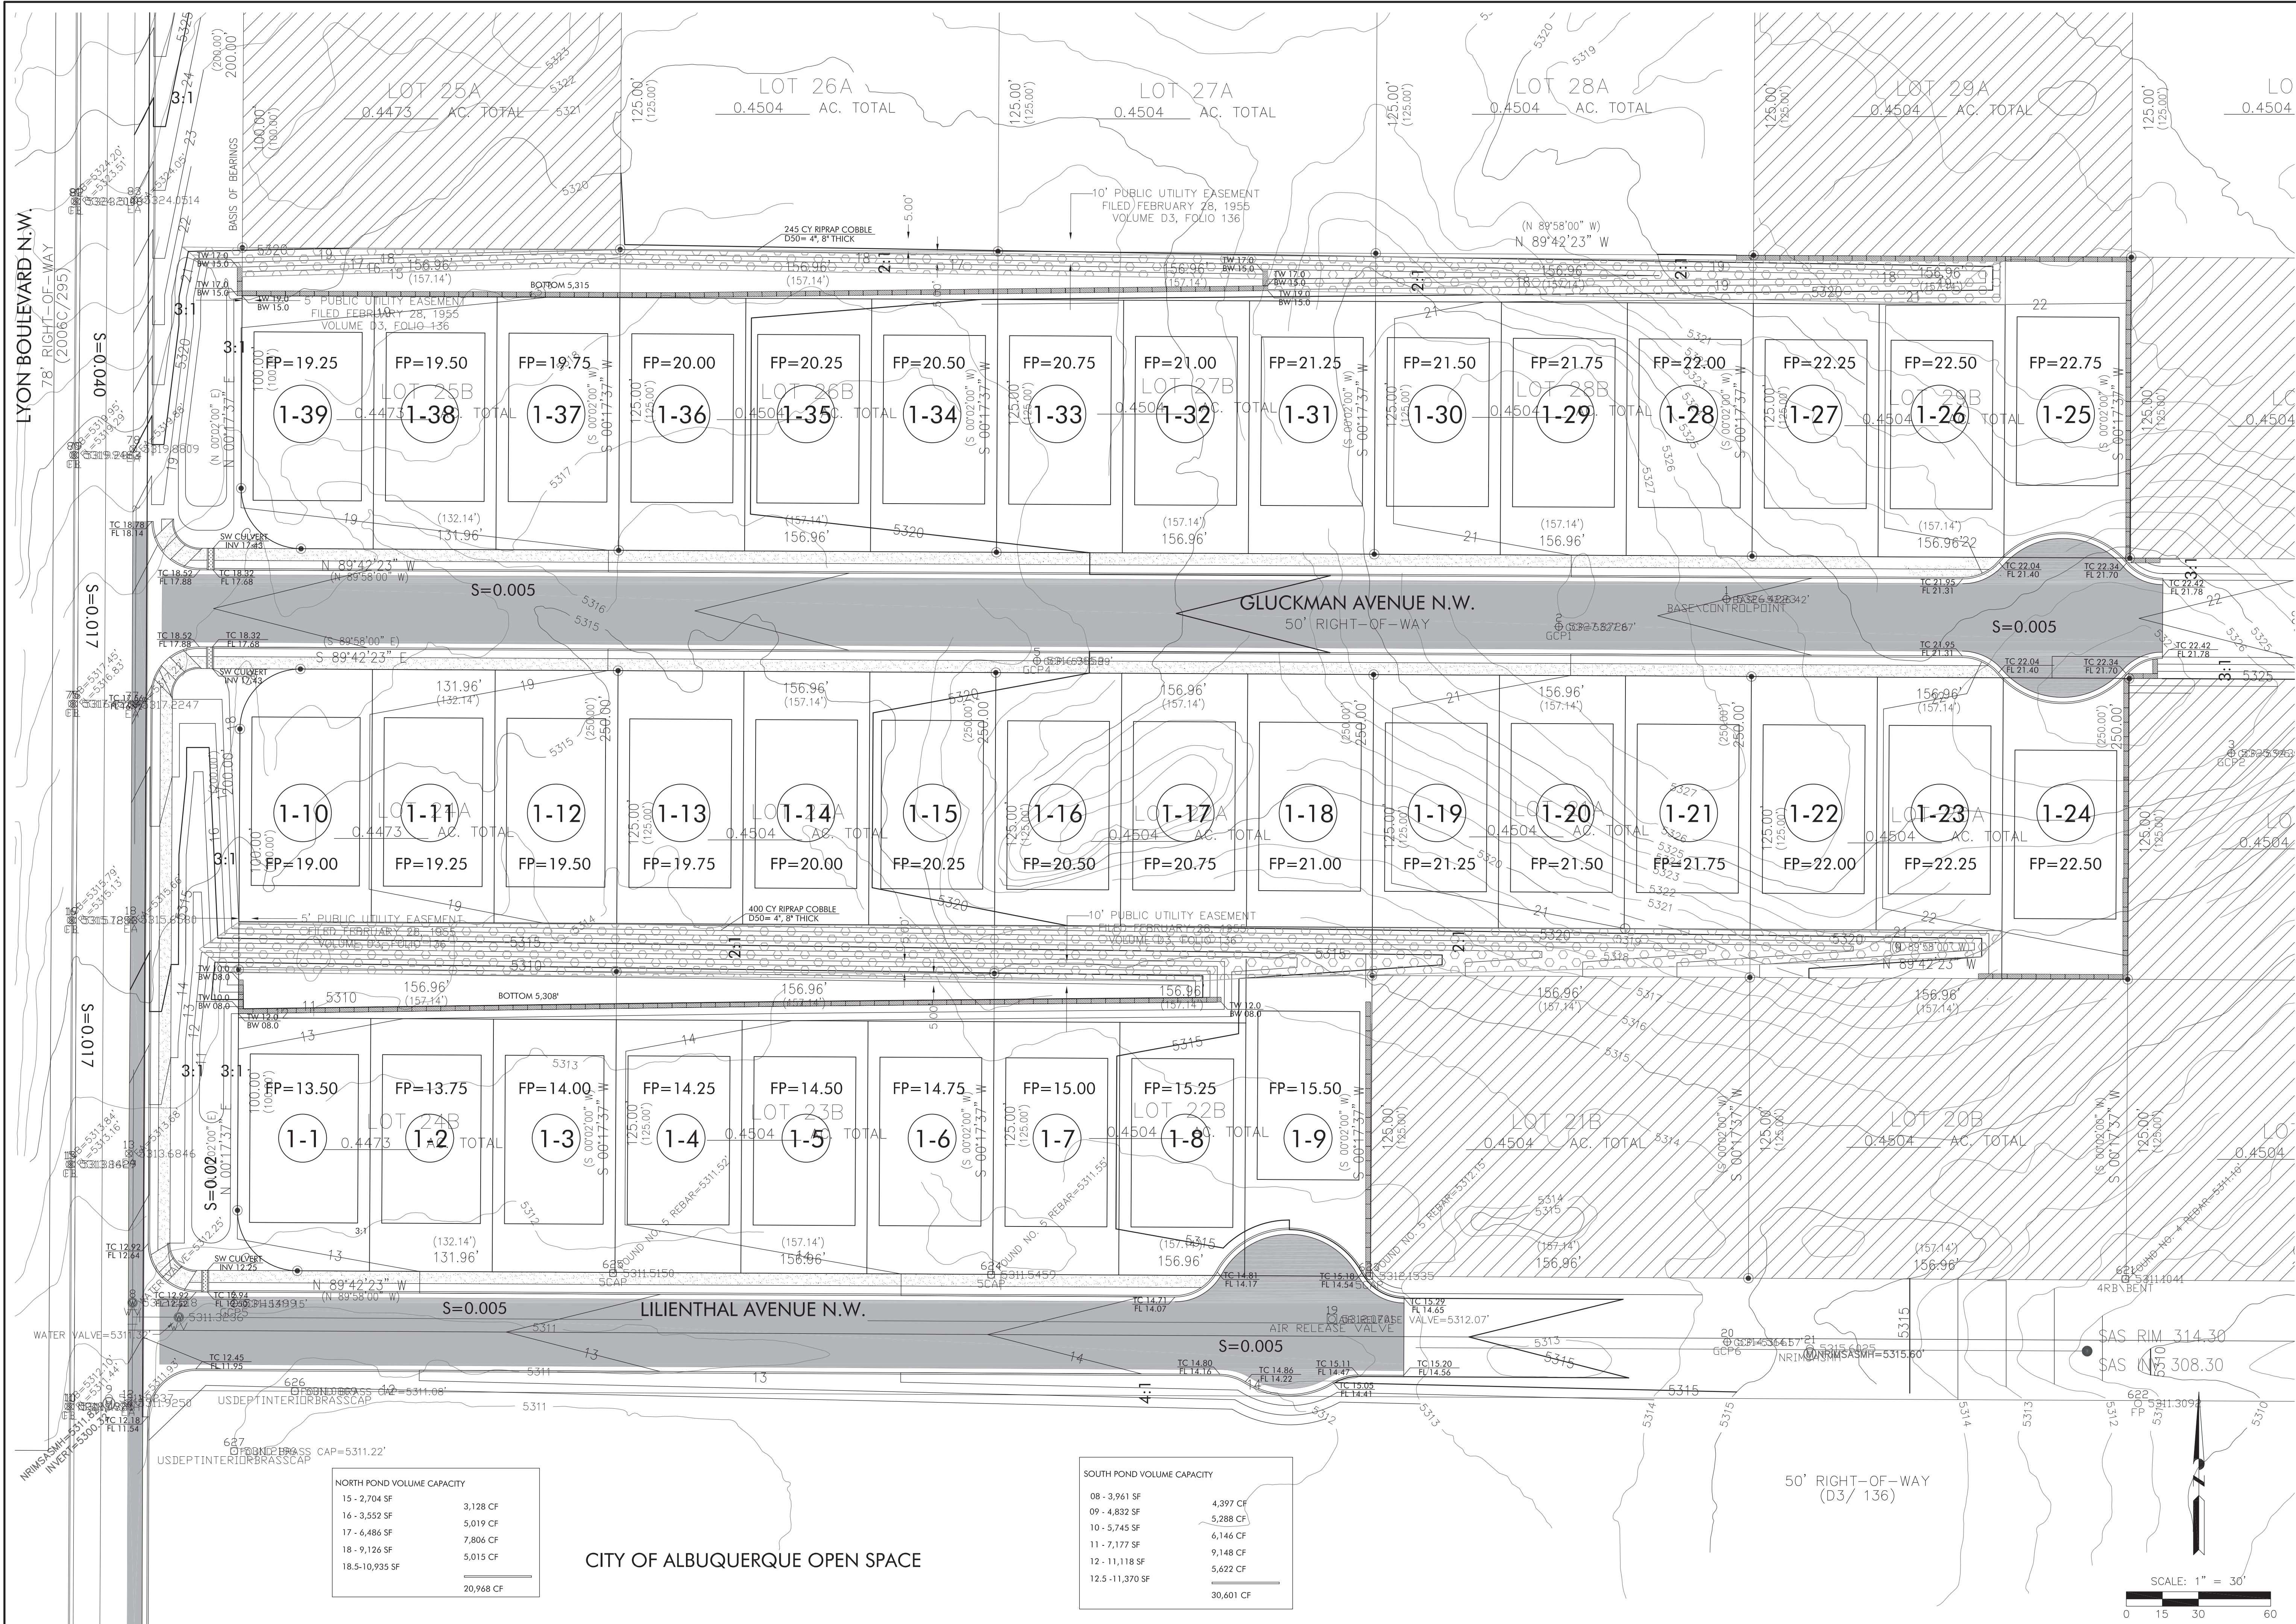

NORTH POND VOLUME CAPACITY	
15 - 2,704 SF	3,128 CF
16 - 3,552 SF	5,019 CF
17 - 6,486 SF	7,806 CF
18 - 9,126 SF	5,015 CF
18.5-10,935 SF	20,968 CF

SOUTH POND VOLUME CAPACITY	
08 - 3,961 SF	4,397 CF
09 - 4,832 SF	5,288 CF
10 - 5,745 SF	6,146 CF
11 - 7,177 SF	9,148 CF
12 - 11,118 SF	5,622 CF
12.5 - 11,370 SF	30,601 CF

CITY OF ALBUQUERQUE OPEN SPACE

DESIGNED BY: M.H.B.

DRAWN BY: T.D.S.

CHECKED BY:

MARK H. BURAK
STATE OF NEW MEXICO
PROFESSIONAL ENGINEER
No. 10987
11/17/2021

PARADISE SUBDIVISION

GRADING PLAN

C2

2 OF 3


Mark H. Burak, P.E.
1512 Sagebrush Trail SE
Albuquerque, New Mexico, 87123
(505) 235-2256
mburak@comcast.net

REVISION

BY


DATE

MARK

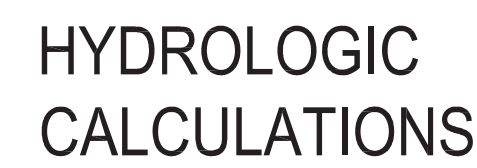[illegible]

Runoff Volume - Existing Conditions					Runoff Volume - Developed Conditions					Runoff Volume - Developed Conditions					Runoff Volume - Developed Conditions									
Six Hour Storm Event					Six Hour Storm Event					Six Hour Storm Event					Six Hour Storm Event									
100 yr 10 day V (cu ft)					100 yr 10 day V (cu ft)					100 yr 10 day V (cu ft)					100 yr 10 day V (cu ft)									
Basin A	1,536	0	0	0	1,536	1,459	0	133	0	1,536	Basin A	1,536	0	0	0	1,536	Basin A	1,536	0	0	0			
Basin B	7,155	0	0	0	7,155	7,155	0	0	0	7,155	Basin B	7,155	0	0	0	7,155	Basin B	7,155	0	0	0			
Basin C	398	0	0	0	397	516	0	119	0	1,420	Basin C	398	0	0	0	2,336	Basin C	398	0	0	0			
Basin D	1,163	0	0	0	1,163	0	540	0	3,078	0	3,078	Basin D	1,163	0	0	0	3,078	Basin D	1,163	0	0	0		
Basin E	1,861	0	0	0	1,861	244	0	1,617	0	1,617	Basin E	1,861	0	0	0	5,495	Basin E	1,861	0	0	0			
Basin F	1,612	0	0	0	1,612	0	535	1,114	0	2,258	Basin F	1,612	0	0	0	3,547	Basin F	1,612	0	0	0			
										Gluckman Northern Paving Area-----										25,213				
Basin G	1,184	0	0	0	1,184	0	555	0	3,192	0	3,192	Basin G	1,184	0	0	0	3,192	Basin G	1,184	0	0	0		
Basin H	2,015	0	0	0	2,015	0	870	0	4,113	0	4,113	Basin H	2,015	0	0	0	5,818	Basin H	2,015	0	0	0		
Basin I	976	0	0	0	976	0	399	505	1,590	0	2,494	Basin I	976	0	0	0	2,494	Basin I	976	0	0	0		
Basin J	1,403	0	0	0	1,403	0	452	3,599	0	2,072	Basin J	1,403	0	0	0	3,599	Basin J	1,403	0	0	0			
Basin K	2,031	0	0	0	2,031	0	639	877	4,546	0	5,994	Basin K	2,031	0	0	0	5,994	Basin K	2,031	0	0	0		
Basin L	1,613	0	0	0	1,613	0	535	1,114	0	2,258	Basin L	1,613	0	0	0	3,548	Basin L	1,613	0	0	0			
										Gluckman Southern Paving Area-----										25,248				
Basin M	390	0	674	0	1,064	0	0	289	2,541	0	2,811	Basin M	390	0	674	0	2,811	Basin M	390	0	674	0		
Basin N	810	0	2,035	0	3,728	0	0	2,439	0	2,74	Basin N	810	0	2,035	0	3,849	Basin N	810	0	2,035	0			
										South on Lyons -----										11,660				
Basin O	1,161	0	0	0	1,161	0	0	0	1,161	0	1,161	Basin O	1,161	0	0	0	1,161	Basin O	1,161	0	0	0		
Basin P	8,800	0	0	0	8,800	8,800	0	0	0	0	8,800	Basin P	8,800	0	0	0	8,800	Basin P	8,800	0	0	0		
Basin Q	6,544	0	0	0	6,544	544	0	0	0	0	6,544	Basin Q	6,544	0	0	0	6,544	Basin Q	6,544	0	0	0		
Basin R	1,455	0	0	0	1,455	0	8,225	0	0	0	8,225	Basin R	1,455	0	0	0	8,225	Basin R	1,455	0	0	0		
Basin S	11,904	0	0	0	11,904	11,904	0	0	0	0	11,904	Basin S	11,904	0	0	0	11,904	Basin S	11,904	0	0	0		
										Localized Depression, No Outlet-----										23,379				
																				11,904				
																				123,504				
										Cubic Feet										163,343				
																				Cubic Feet				

Runoff Volume - Existing Conditions					Runoff Volume - Developed Conditions					Runoff Volume - Developed Conditions					Runoff Volume - Developed Conditions														
Ten Day Storm Event					Ten Day Storm Event					Ten Day Storm Event					Ten Day Storm Event														
100 yr 10 day V (cu ft)					100 yr 10 day V (cu ft)					100 yr 10 day V (cu ft)					100 yr 10 day V (cu ft)														
Ponding Volume					Ponding Volume					Ponding Volume					Ponding Volume														
Existing					Developed					Delta					Delta														
Basin A	1,536	1,562	56	0	1,536	1,536	1,562	56	0	1,536	Basin A	1,536	1,562	56	0	1,536	Basin A	1,536	1,562	56	0								
Basin B	7,155	7,155	0	0	7,155	7,155	7,155	0	0	7,155	Basin B	7,155	7,155	0	0	7,155	Basin B	7,155	7,155	0	0								
Basin C	950	950	0	0	950	950	2,790	0	0	1,940	Basin C	950	2,209	1,259	0	990	Basin C	950	2,209	1,259	0								
Basin D	1,163	596	4,633	0	1,163	1,163	3,618	2,456	0	945	Basin D	1,163	3,618	2,456	0	945	Basin D	1,163	3,618	2,456	0								
Basin E	1,861	6,861	5,000	0	1,861	5,824	3,963	0	0	1,144	Basin E	1,861	5,462	3,601	0	1,144	Basin E	1,861	5,462	3,601	0								
Basin F	1,612	5,721	4,109	0	1,612	3,947	2,335	0	0	631	Basin F	1,612	3,947	2,335	0	631	Basin F	1,612	3,947	2,335	0								
										16,416										3,686									
Basin G	1,184	1,184	0	0	1,184	1,184	1,184	0	0	0	Basin G	1,184	1,184	1,184	0	0	Basin G	1,184	1,184	1,184	0								
Basin H	2,015	6,420	4,405	0	2,015	5,918	3,903	0	0	898	Basin H	2,015	5,918	3,903	0	898	Basin H	2,015	5,918	3,903	0								
Basin I	976	3,712	2,736	0	976	976	2,484	1,508	0	437	Basin I	976	2,484	1,508	0	437	Basin I	976	2,484	1,508	0								
Basin J	1,403	4,108	2,705	0	1,403	4,463	3,060	1,657	0	1,255	Basin J	1,403	3,069	1,666	0	1,643	Basin J	1,403	3,069	1,666	0								
Basin K	2,031	9,477	7,447	0	2,031	9,477	7,447	0	0	1,249	Basin K	2,031	9,477	7,447	0	1,249	Basin K	2,031	9,477	7,447	0								
Basin L	1,613	5,724	4,111	0	1,613	5,724	4,111	0	0	631	Basin L	1,613	3,948	2,335	0	631	Basin L	1,613	3,948	2,335	0								
										16,326										16,326									
										1,954										4,779									
										9,683										13,648									
Basin M	1,161	1,161	0	0	1,161	1,161	1,161	0	0	0	Basin M	1,161	1,161	1,161	0	0	Basin M	1,161	1,161	1,161	0								
Basin N	8,800	8,800	0	0	8,800	8,800	8,800	0	0	0	Basin N	8,800	8,800	8,800	0	0	Basin N	8,800	8,800	8,800	0								
Basin O	6,544	6,544	0	0	6,544	6,544	6,544	0	0	0	Basin O	6,544	6,544	6,544	0	0	Basin O	6,544	6,544	6,544	0								
Basin P	8,225	8,225	0	0	8,225	8,225	8,225	0	0	0	Basin P	8,225	8,225	8,225	0	0	Basin P	8,225	8,225	8,225	0								
Basin Q	23,379	23,379	0	0	23,379	23,379	23,379	0	0	0	Basin Q	23,379	23,379	23,379	0	0	Basin Q	23,379	23,379	23,379	0								
Basin S	11,904	11,904	0	0	11,904	11,904	11,904	0	0	0	Basin S	11,904	11,904	11,904	0	0	Basin S	11,904	11,904	11,904	0								
										36,315										46,781									
										Cubic Feet										46,781									

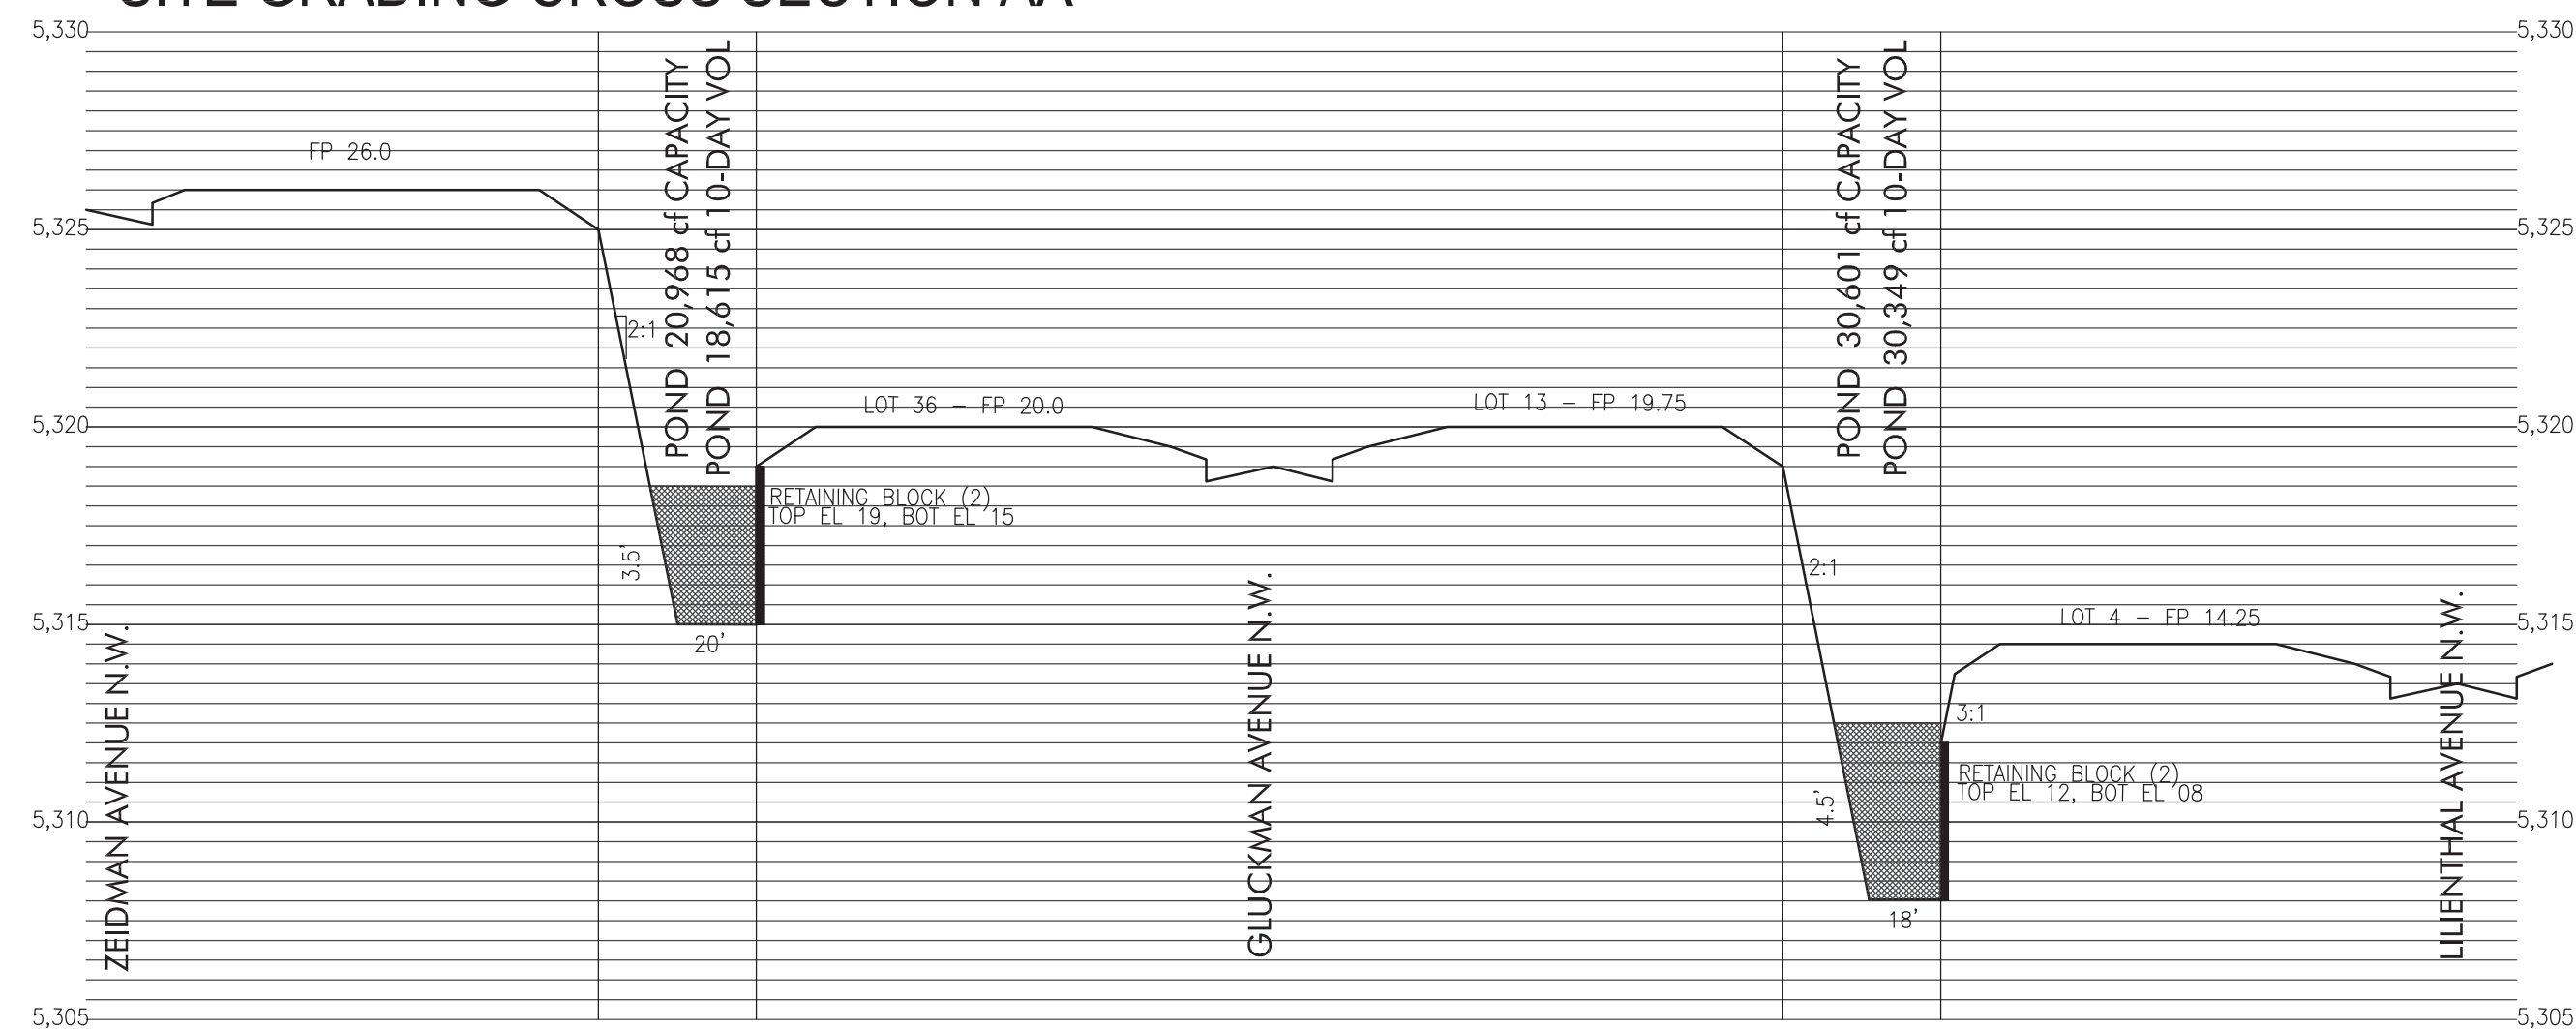

OF 3

REVISION	BY	DATE	MARK
----------	----	------	------