


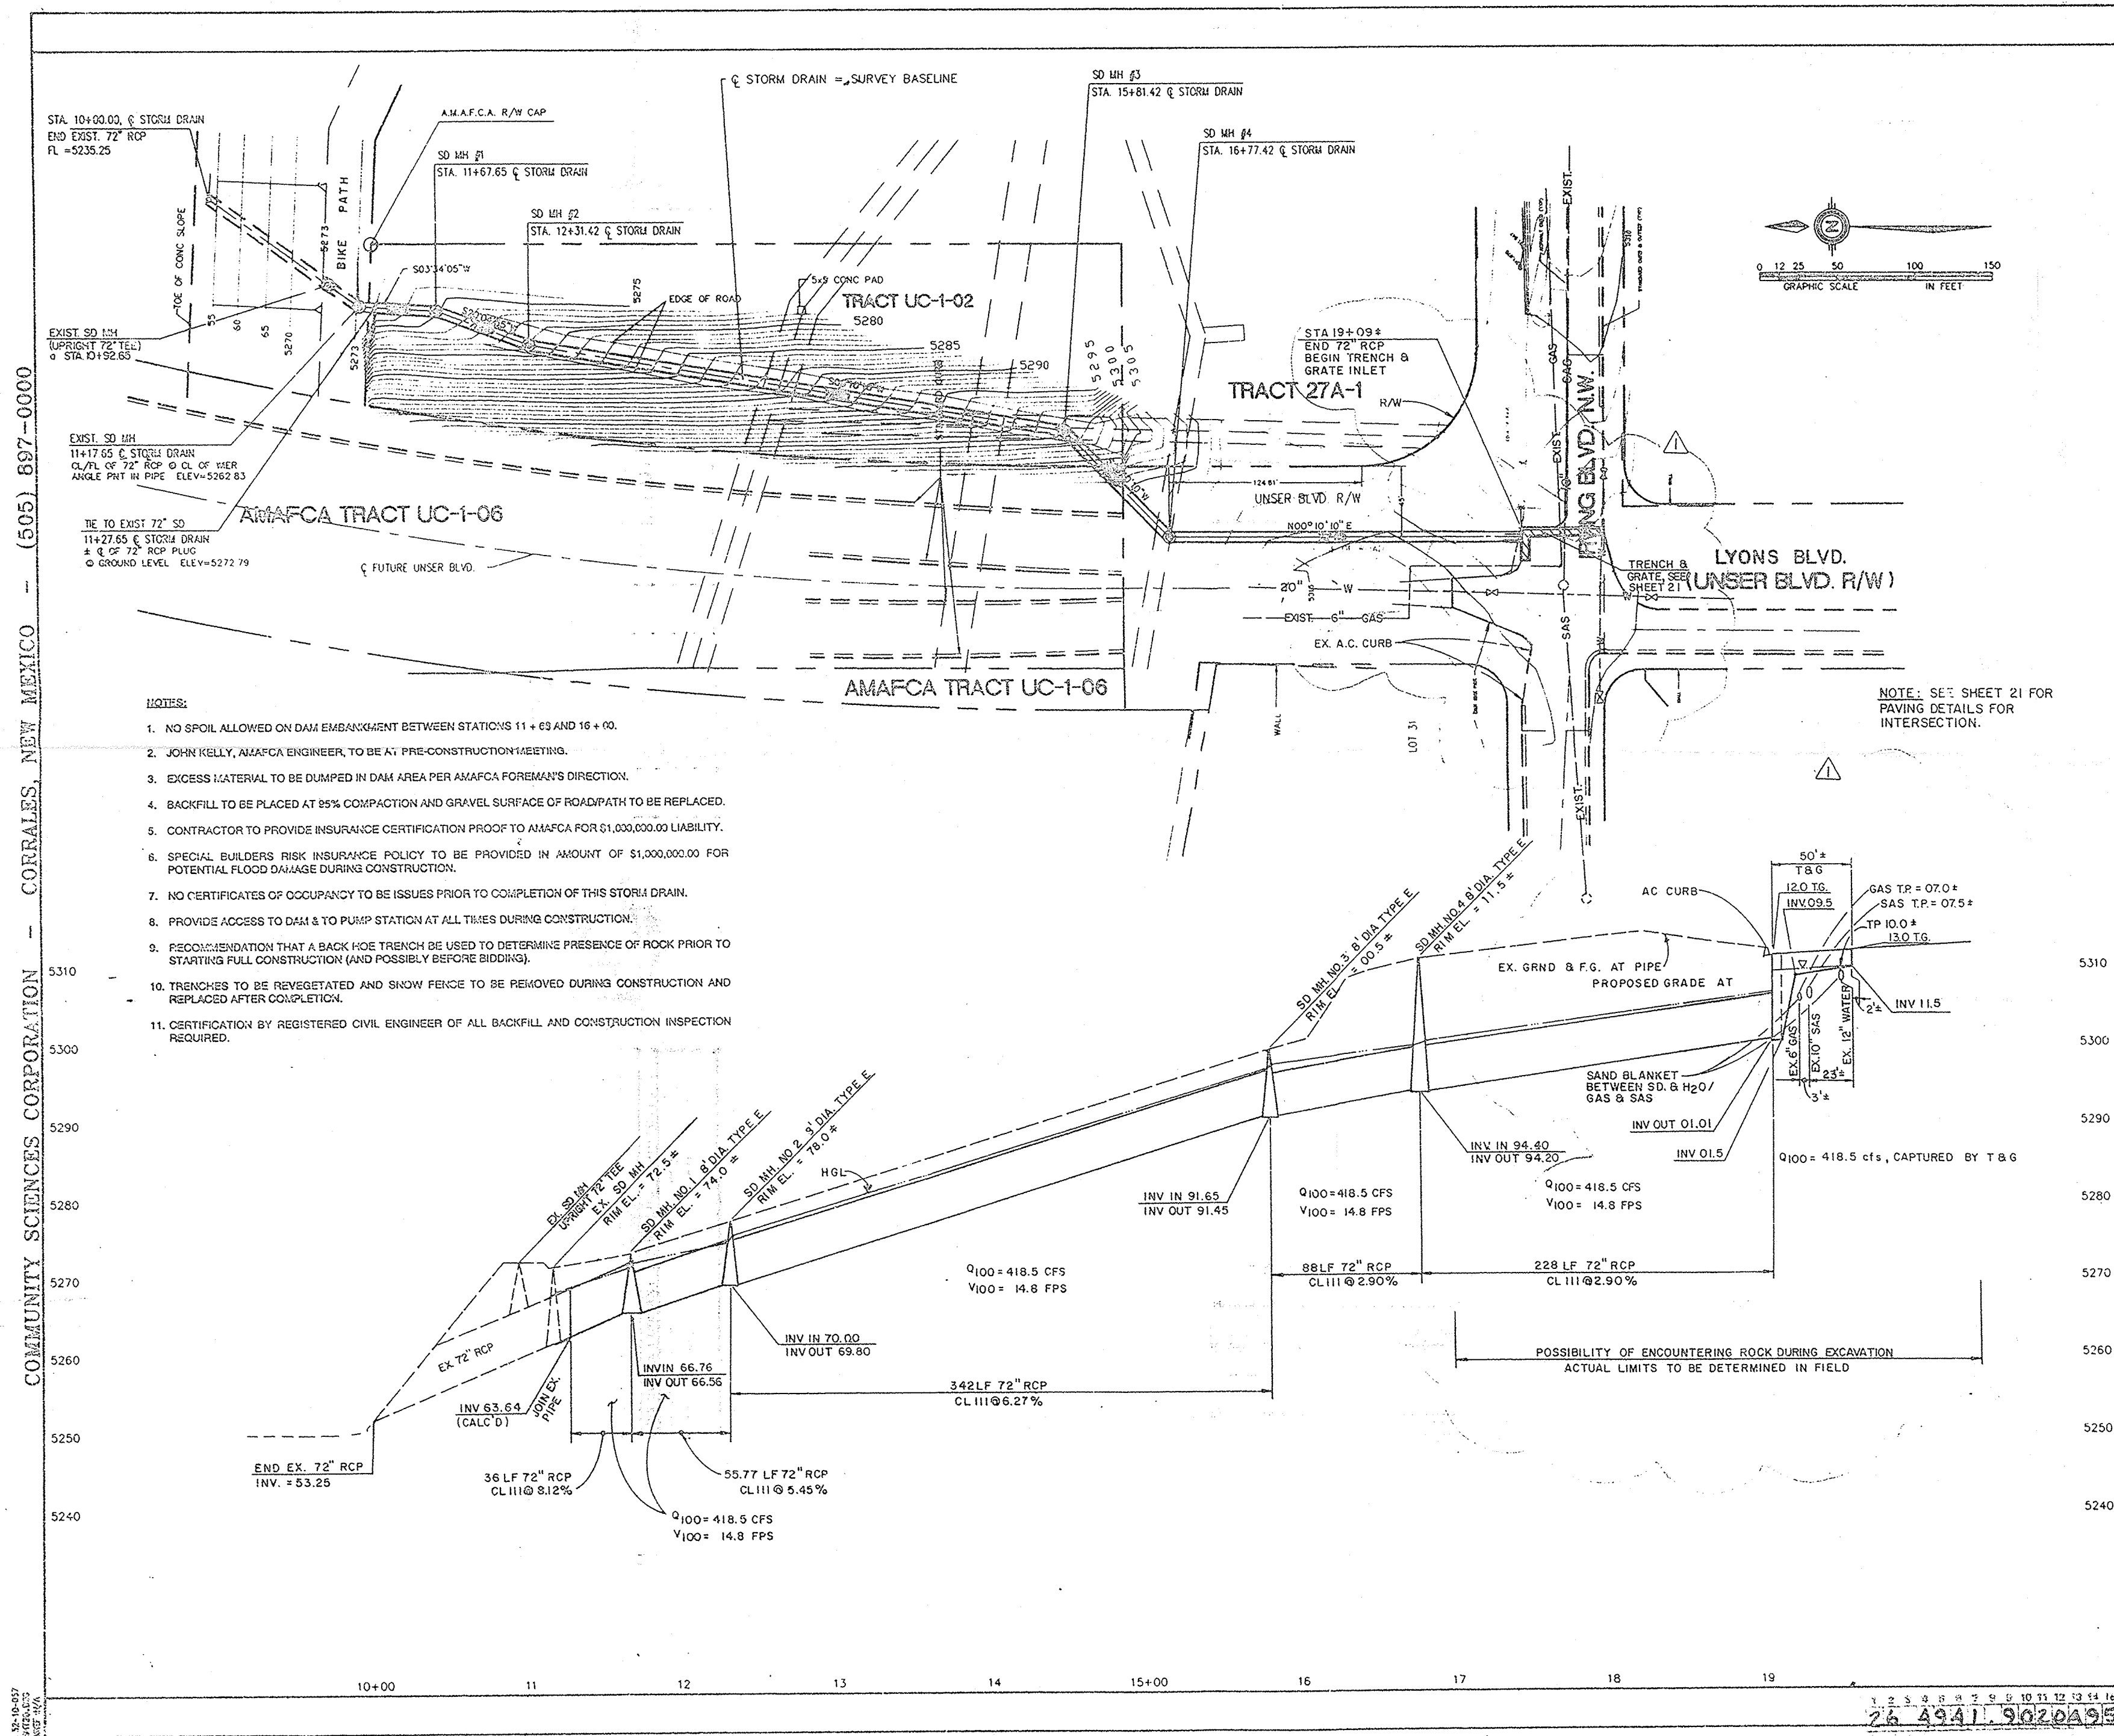

UTILITY LOCATIONS

UTILITY	LOCATION	DATE
WATER	11+63.00	11/94
SEWER	11+63.00	11/94
GAS	11+63.00	11/94
TELEPHONE	11+63.00	11/94
POWER	11+63.00	11/94

AS BUILT INFORMATION

NO.	DATE	BY	REVISIONS
1	11/94	J.K.	AS BUILT

ENGINEER'S SEAL

community sciences corporation


CITY OF ALBUQUERQUE PUBLIC WORKS DEPARTMENT ENGINEERING GROUP



TITLE: PARADISE MEADOWS UNIT 1 STORM DRAIN PLAN & PROFILE UNSEEN STORM DRAIN (IRVING TO CALABACILLAS)

APPROVALS	ENGINEER	DATE	APPROVALS	ENGINEER	DATE
DR. CHAIRMAN	J.A. Kelly	3-8-94	WATER	J.A. Kelly	3-8-94
TRANSPORTATION	J.A. Kelly	3-8-94	WASTE WATER	J.A. Kelly	3-8-94
HYDROLOGY	J.A. Kelly	3-8-94	A.M.A.F.C.A.	J.A. Kelly	3-8-94

PROJECT NO. 4941.90 MAP NO. A-11


AS BUILT DRAWING

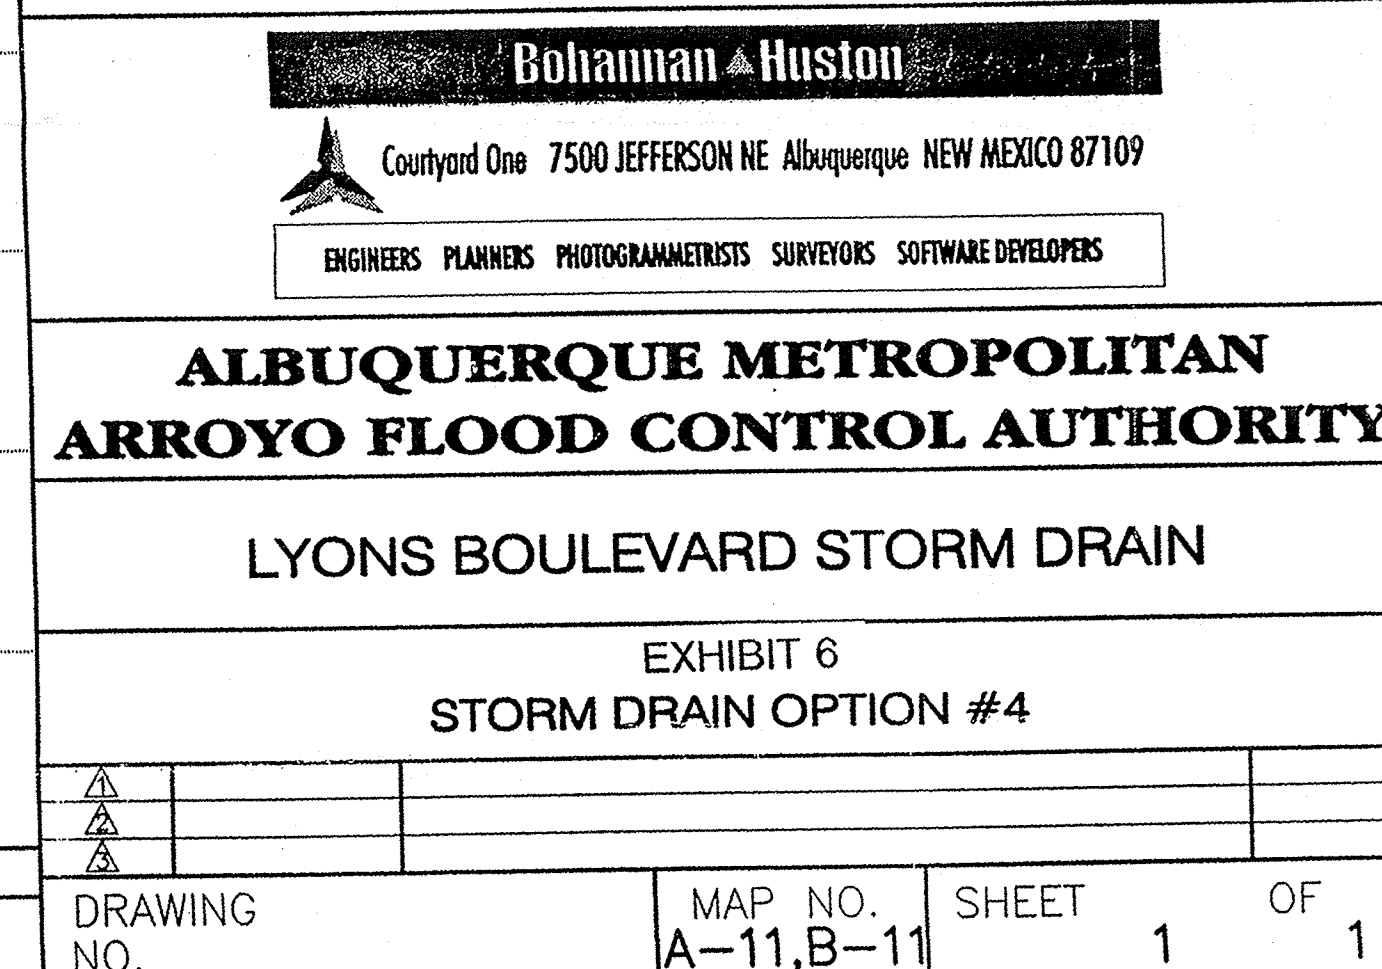

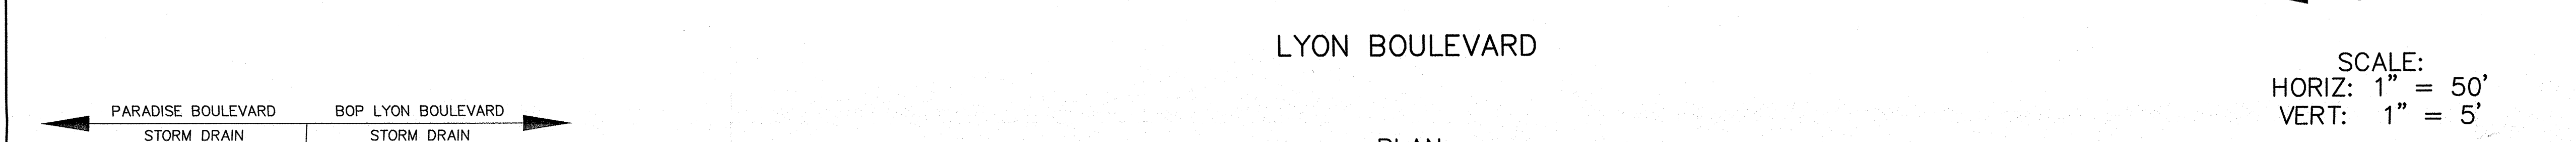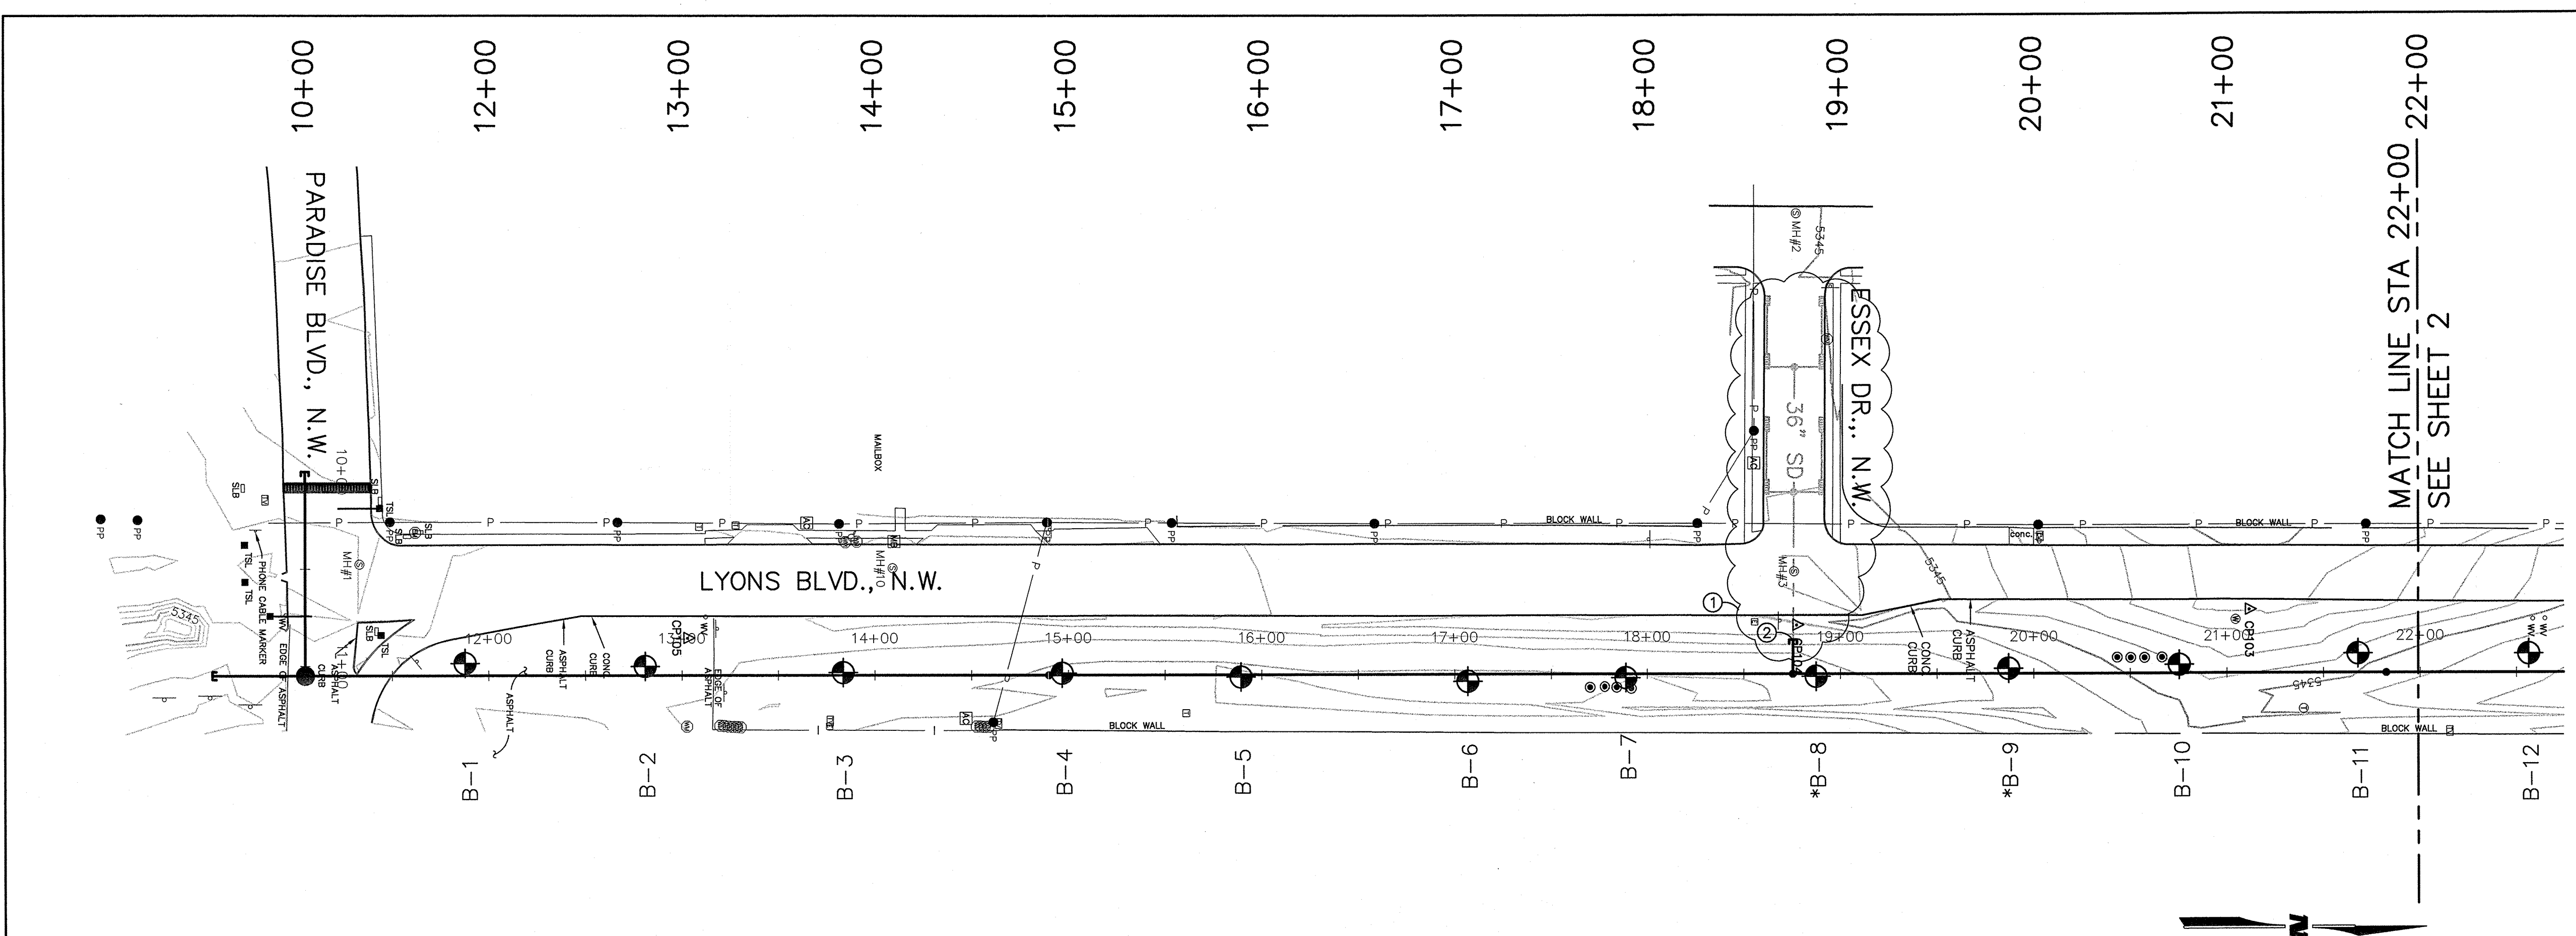

- LEGEND**
- BASALT
 - SILTY SAND
 - BORE NUMBER BASED ON SUPPLEMENT OF AMEC
 - BORE NUMBER BASED ON SUPPLEMENT OF WCEA
 - TOP OF BASALT BASED ON SUPPLEMENT OF AMEC
 - TOP OF BASALT BASED ON SUPPLEMENT OF WCEA
 - ADDITIVE ALTERNATIVE
 - LYON BOULEVARD FINISHED GRADE
 - LYON BOULEVARD HYDRAULIC GRADE LINE (HGL)

- KEYED NOTES**
- ESSEX DR. N.W. STORM DRAIN MAY BE CONSTRUCTED AT FUTURE DATE, INDEPENDENT OF LYON BOULEVARD STORM DRAIN
 - STUB-OUT WITH PLUG, MINIMUM SLOPE SHALL BE 1%. INSTALL 1-PIPE JOINT MINIMUM.

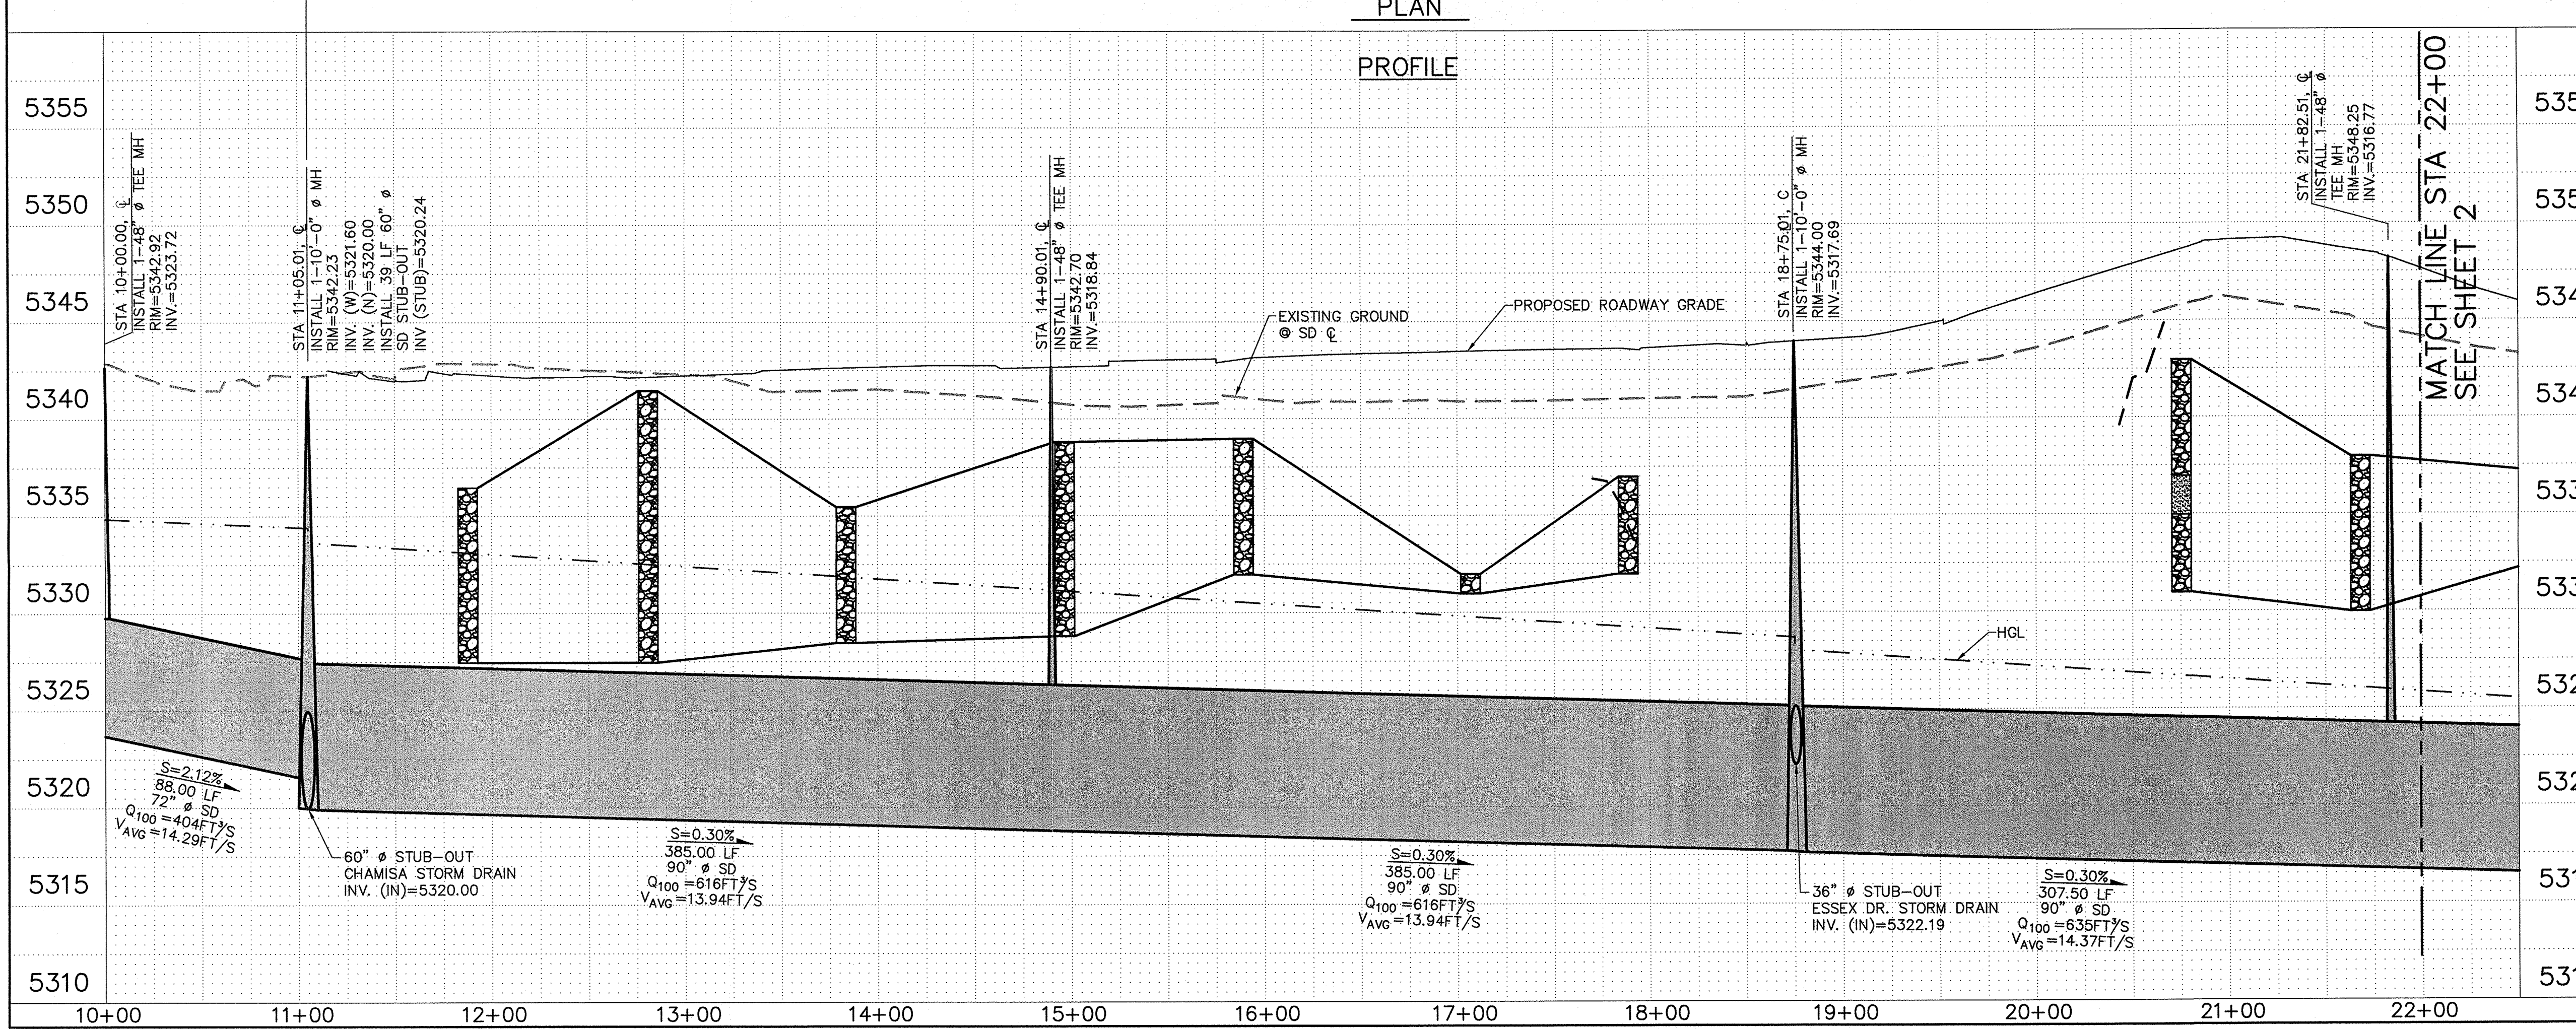

AS-BUILT INFORMATION

CONTRACTOR	NO.	DATE
INSPECTOR'S ACCEPTANCE BY	NO.	DATE
CONNECTION BY	NO.	DATE

BENCH MARKS

ACS 11-B11	DATE
ELEVATION=5348.50 (NAV88)	

SURVEY INFORMATION

NO.	BY	DATE
-----	----	------

REVISIONS


NO.	DATE	REMARKS	BY
DESIGN	MJI	WCEA NO. X4218037	DATE AUG 2004
DRAWN	JEL	PROJECT NO.	SHEET NO.
CHECK	DSA	N/A	1 3

ALBUQUERQUE METROPOLITAN ARROYO FLOOD CONTROL AUTHORITY

WILSON & COMPANY
2600 THE AMERICAN ROAD S.E.
SUITE 100
RIO RANCHO, NEW MEXICO 87124
(505) 898-8021


LYON BOULEVARD STORM DRAIN
STORM DRAIN PLAN & PROFILE
LYON BOULEVARD

MARIO G. JIAREZ-Infante
NEW MEXICO
15340
REGISTERED PROFESSIONAL ENGINEER

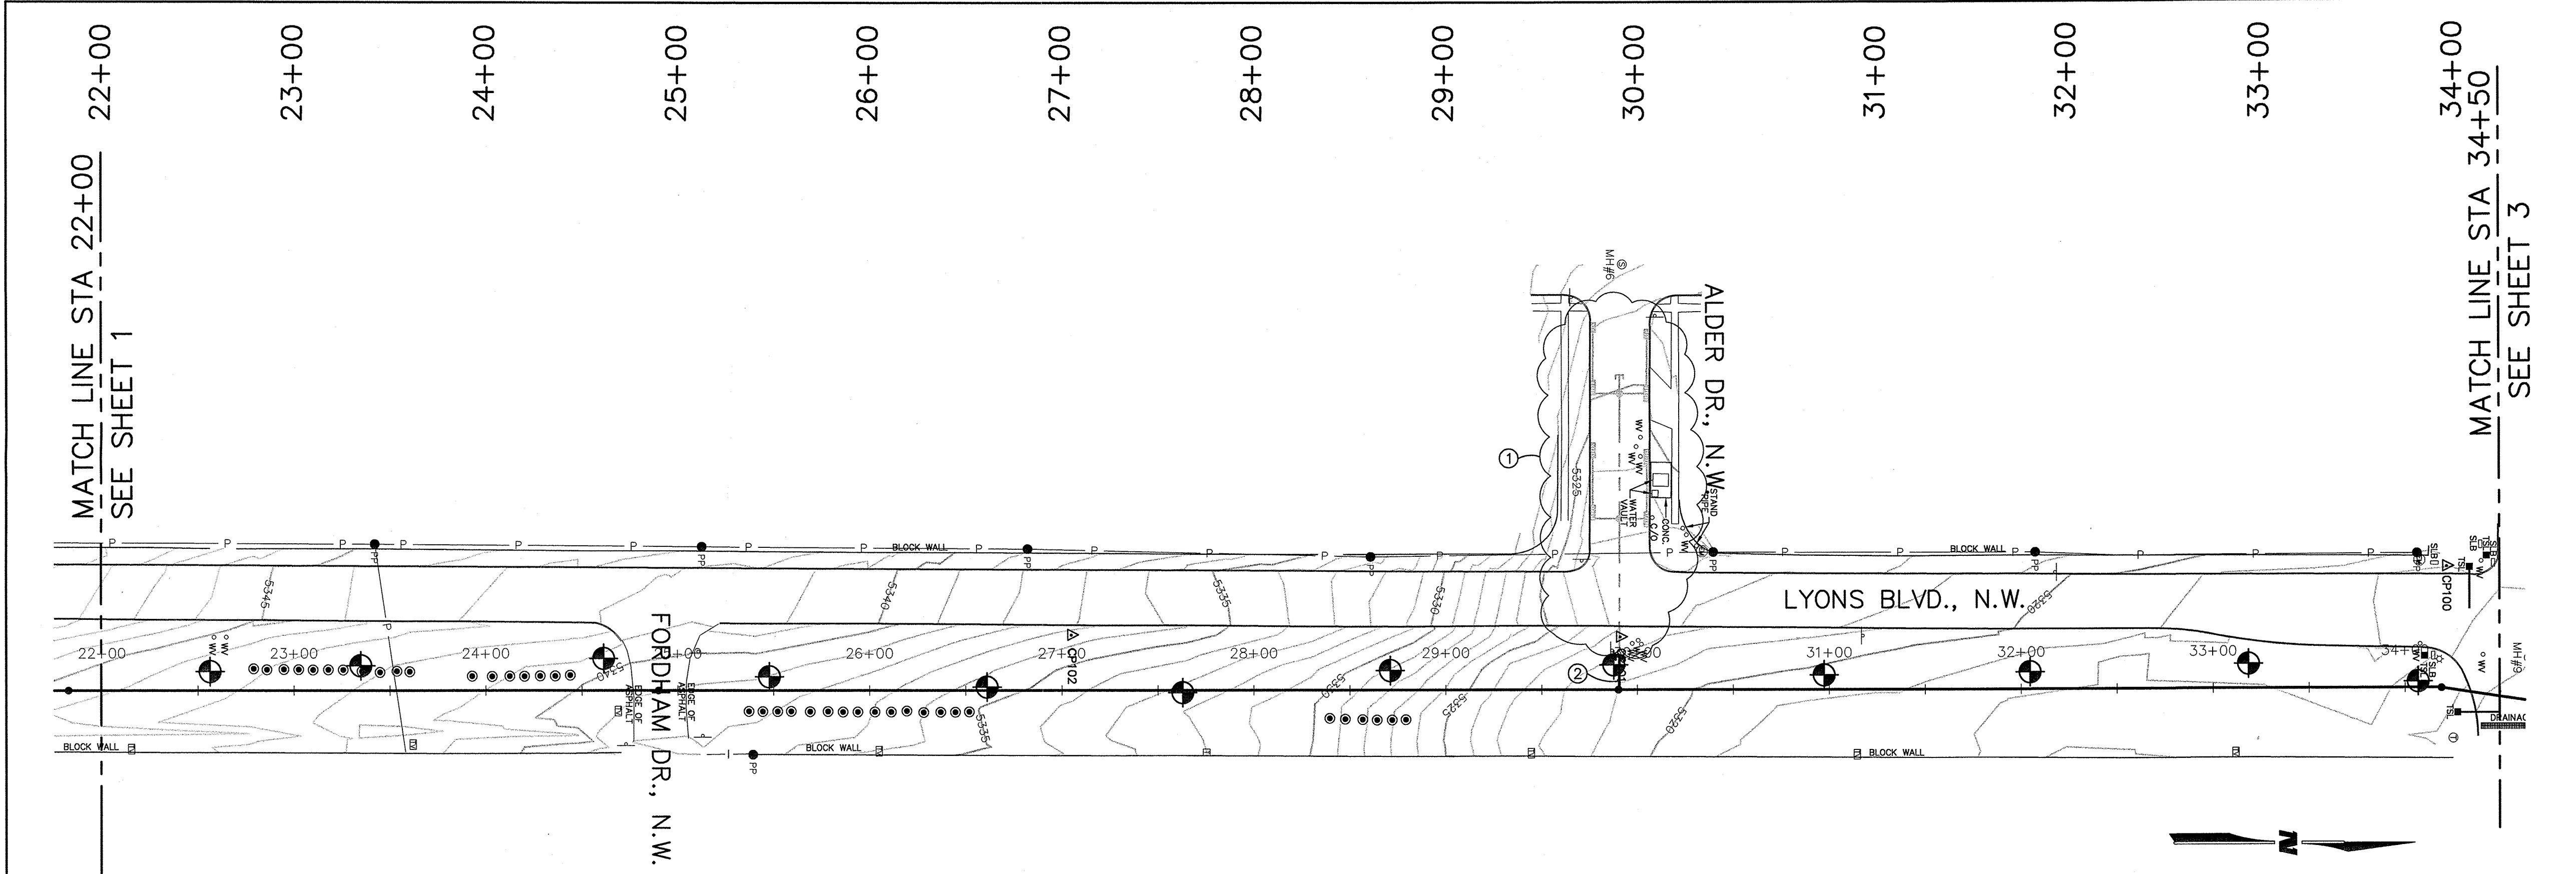

LYON BOULEVARD
PLAN

SCALE:
HORIZ: 1" = 50'
VERT: 1" = 5'

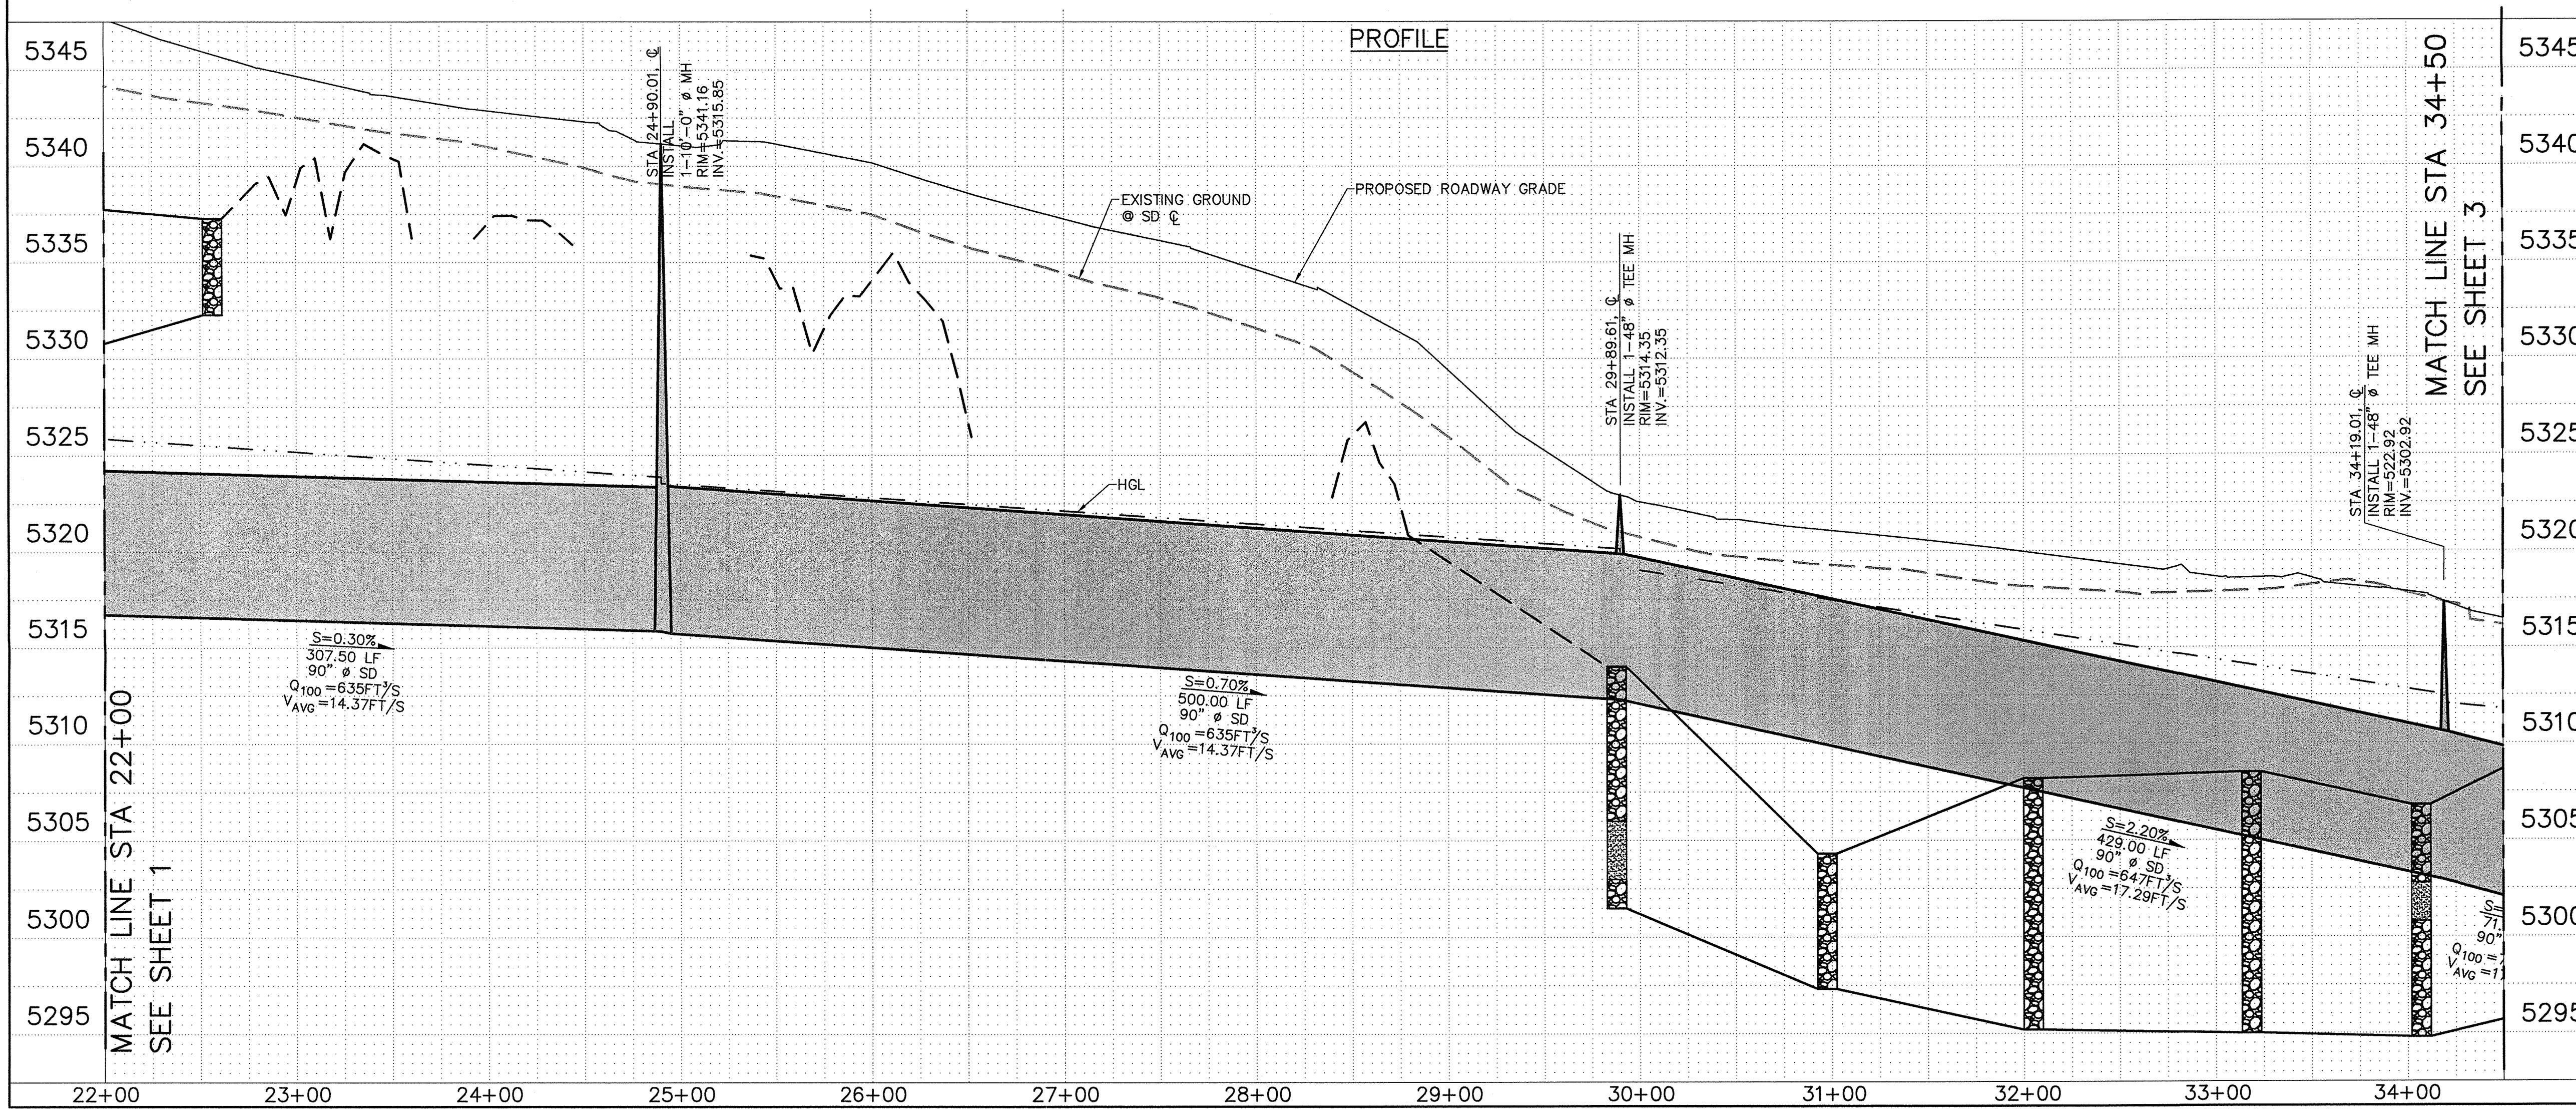

LYON BOULEVARD
PROFILE

LEGEND

- BASALT
- SILTY SAND
- BORE NUMBER BASED ON SUPPLEMENT OF AMEC
- BORE NUMBER BASED ON SUPPLEMENT OF WCEA
- TOP OF BASALT BASED ON SUPPLEMENT OF AMEC
- TOP OF BASALT BASED ON SUPPLEMENT OF WCEA
- ADDITIVE ALTERNATIVE
- LYON BOULEVARD FINISHED GRADE
- LYON BOULEVARD HYDRAULIC GRADE LINE (HGL)

- KEYED NOTES**
- ALDER DR., N.W. STORM DRAIN MAY BE CONSTRUCTED AT FUTURE DATE, INDEPENDENT OF LYON BOULEVARD STORM DRAIN.
 - STUB-OUT WITH PLUG, MINIMUM SLOPE SHALL BE 1%. INSTALL 1-PIPE JOINT MINIMUM.

SURVEY INFORMATION		BENCH MARKS		AS-BUILT INFORMATION		MICRO-FILM INFORMATION	
NO.	BY	DATE	ACCS 11-B11	CONTRACTOR	RECORDED BY	NO.	DATE
			ELEVATION=5348.50 (NAVD88)	WCEA	DATE		

ALBUQUERQUE METROPOLITAN
ARROYO FLOOD CONTROL
AUTHORITY

WILSON & COMPANY
2600 THE AMERICAN ROAD S.E.
SUITE 100
RIO RANCHO, NEW MEXICO
87124
(505) 898-8021



LYON BOULEVARD

**STORM DRAIN
PLAN & PROFILE
LYON BOULEVARD**

REVISIONS	NO.	DATE	REMARKS	BY
DESIGN	MJI	WCEA NO. X4218037	DATE	AUG 2004
DRAWN	JEL	PROJECT NO.	SHEET NO.	
CHECK	DSA	N/A	2	3




SCALE:
HORIZ: 1" = 50'
VERT: 1" = 5'

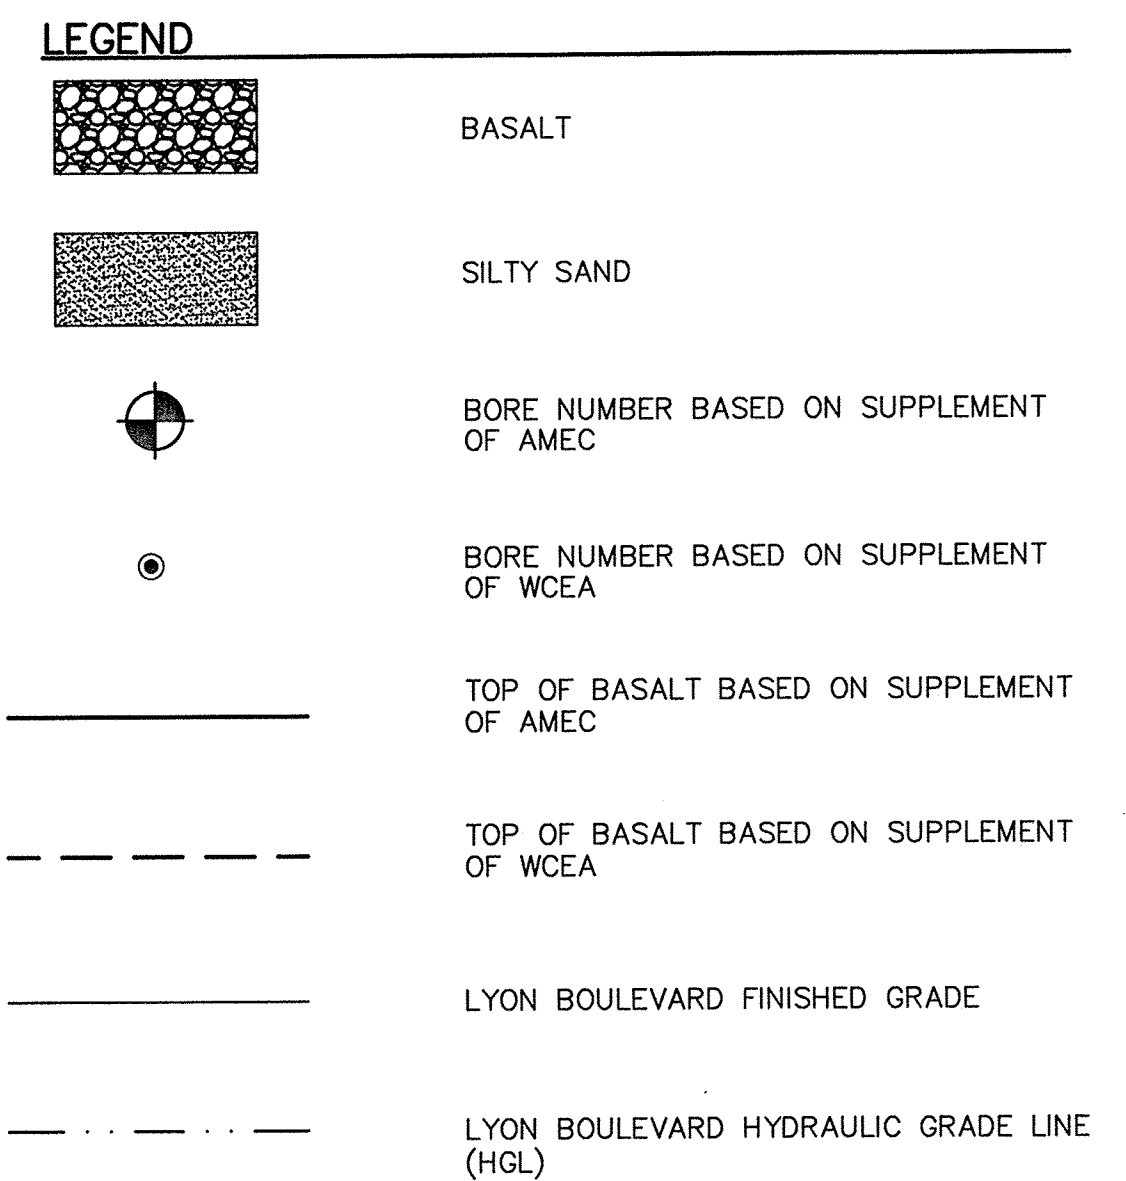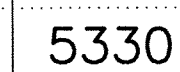


KEYED NOTES

- ① IRVING BLVD. N.W. STORM DRAIN MAY BE CONSTRUCTED AT FUTURE DATE, INDEPENDENT OF LYON BOULEVARD STORM DRAIN.

SURVEY INFORMATION		BENCH MARKS		AS-BUILT INFORMATION		MICRO-FILM INFORMATION	
NO.	BY	DATE	ACS 11-B11	CONTRACTOR		RECORDED BY	DATE
			ELEVATION=5348.50 (NAV88)	WORK PERFORMED BY	DATE	NO.	
				FIELD	DATE	INSPECTOR'S APPROVAL BY	
				VERIFICATION BY	DATE	DRAWINGS	DATE
						CORRECTED BY	

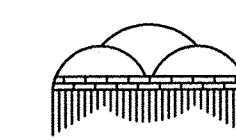

ALBUQUERQUE METROPOLITAN
ARROYO FLOOD CONTROL
AUTHORITY

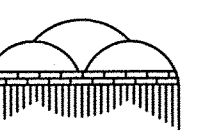

**WILSON
& COMPANY**
2600 THE AMERICAN ROAD S
SUITE 100
RIO RANCHO, NEW MEXICO
87124
(505) 898-8021

LYON BOULEVARD
STORM DRAIN

STORM DRAIN
PLAN & PROFILE
LYON BOULEVARD



REVISIONS	NO.	DATE	REMARKS		BY
DESIGN		MJL	WCEA NO. X4218037	DATE	AUG 2004
DRAWN		JEL	PROJECT NO.	SHEET NO.	
CHECK		DSA	N/A	3	3