



City of Albuquerque

P.O. BOX 1293 ALBUQUERQUE, NEW MEXICO 87103

February 27, 2003

Pat Conley, PE
Smith Engineering Co.
6400 Uptown Blvd. Ste 500E
Albuquerque, NM 87110

**Re: Irving/Golf Course Transportation Improvements Drainage Report
Engineer's Stamp dated 1-15-03, (B12/D11)**

Dear Mr. Conley,

Based on your information provided in **your** submittal dated 1-16-03, the above referenced Drainage Report is approved for **Work Order**. Any minor comments can be addressed at DRC.

If you have any questions, you can contact me at 924-3986.

Sincerely,


Bradley L. Bingham, PE
Sr. Engineer, Planning Dept.
Development and Building Services

C: file

DRAINAGE REPORT
for the
IRVING/GOLF COURSE TRANSPORTATION
IMPROVEMENTS, COA PROJECT #5894.91

Prepared for:
CITY OF ALBUQUERQUE
TRANSPORTATION DEPARTMENT

January, 2003

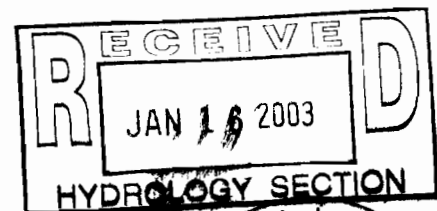

Prepared by:

Smith Engineering Company
6400 Uptown Blvd. NE, Suite 500E
Albuquerque, New Mexico 87110



TABLE OF CONTENTS

I. INTRODUCTION	1
II. DRAINAGE AREA BOUNDARIES.....	1
III. DRAINAGE BASIN CHARACTERISTICS.....	1
IV. EXISTING DRAINAGE FACILITIES	4
V. HYDROLOGY.....	4
VI. HYDRAULIC ANALYSIS OF PROPOSED STORM DRAIN	5
VII. REFERENCES	7

FIGURES

Figure No. 1 Project Location Map	2
---	---

APPENDICIES

Appendix A	Drainage Basin Maps
Appendix B	Existing Irving/Golf Course Storm Drain
Appendix C	Existing Cactus Pointe Storm Drain
Appendix D	Proposed Irving/ Golf Course and Irving/Chantilly Storm Drain
Appendix E	Proposed Irving/Golf Course HGL Calculations and Profile
Appendix F	Proposed Irving/Chantilly HGL Calculations and Profile
Appendix G	Hydraulic Capacity of Bryan Avenue

TABLE OF CONTENTS

I. INTRODUCTION	1
II. DRAINAGE AREA BOUNDARIES	1
III. DRAINAGE BASIN CHARACTERISTICS.....	1
IV. EXISTING DRAINAGE FACILITIES	4
V. HYDROLOGY	4
VI. HYDRAULIC ANALYSIS OF PROPOSED STORM DRAIN	5
VII. REFERENCES	7

FIGURES

Figure No. 1 Project Location Map	2
---	---

APPENDICIES

Appendix A	Drainage Basin Maps
Appendix B	Existing Irving/Golf Course Storm Drain
Appendix C	Existing Cactus Pointe Storm Drain
Appendix D	Proposed Irving/ Golf Course and Irving/Chantilly Storm Drain
Appendix E	Proposed Irving/Golf Course HGL Calculations and Profile
Appendix F	Proposed Irving/Chantilly HGL Calculations and Profile
Appendix G	Hydraulic Capacity of Bryan Avenue

I. INTRODUCTION

The City of Albuquerque Transportation Department is planning to construct a four lane facility on Irving Boulevard from Chantilly to just west of the intersection of Golf Course Road and a four lane facility on Golf Course Road from the Bernalillo county line on the south to the south side of the Calabacillas Arroyo. A vicinity map showing the location of the project area is shown in Figure 1, page 2.

Smith Engineering Company (SEC) has been retained by the COA PWD to provide civil engineering services for the proposed Irving Boulevard/Golf Course Improvements. Included in the civil engineering scope of work is to provide a drainage analysis for the project and design an storm drain system to convey the flows to the Calabacillas Arroyo.

This drainage report will analyze the hydrology assuming fully developed conditions and provide a hydraulic analysis of a storm drain system to be constructed as part of the project.

II. DRAINAGE AREA BOUNDARIES

The drainage basin boundary for the project is bounded by Chantilly on the east, the right-of-way on the north and south sides of Irving Boulevard, several tracts of vacant land at the southeast quadrant of the intersection of Golf Course and Irving Boulevard, and the east and west sides of Golf Course Road. The drainage areas are shown on Plates 1 and 2 contained in Appendix A of this report.

III. DRAINAGE BASIN CHARACTERISTICS

This report concerns itself only with developed conditions and the planned storm drain system as the existing drainage conditions do not have an impact on the design of the final facilities.

A. Drainage Basins

Irving Boulevard:

There is a grade break on Irving Boulevard near Green Street that creates two major drainage basins for Irving Boulevard. These are the area west of Green Street and the area east of Green Street. There are existing neighborhoods on each side of Irving Boulevard along the length of the improvement with walls on the right-of-way line. This report assumes that, due to the walls, the drainage in the backyards of the lots will not get to the Irving Boulevard right-of-way but will remain on the lots.


East of Green Street:

The major drainage basin east of Green Street is from the break-line at Green Street east to Chantilly Road. This basin drains to a proposed storm drain system in Irving Boulevard and Chantilly Road that connects to an existing storm drain system in Bryan

MAP NO.

B-12-Z

B-13-Z

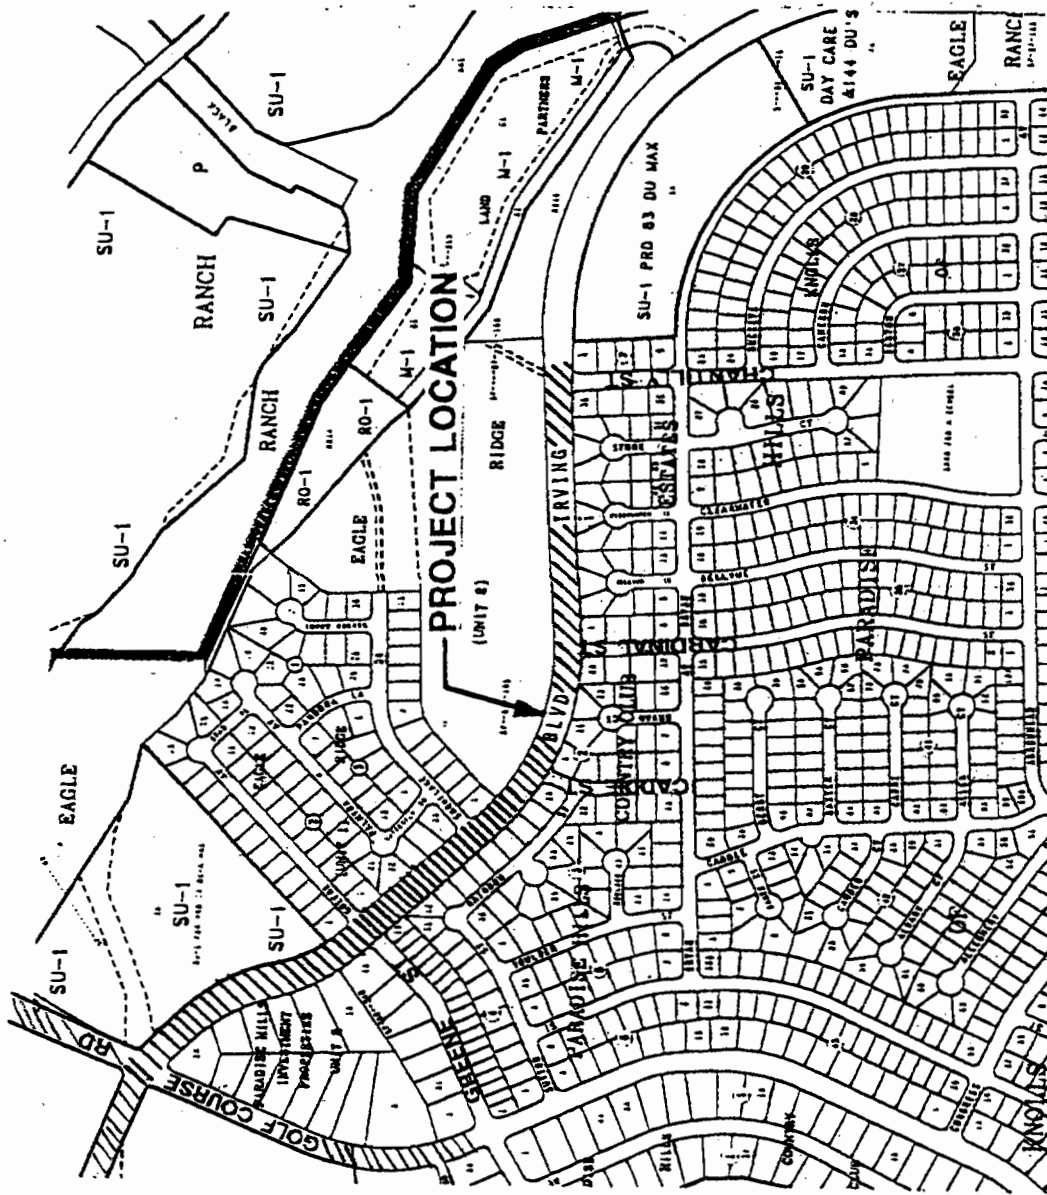

GRAPHIC SCALE

Figure No. 1 – Project Location Map

Road. The existing system is referred to as the Cactus Pointe system in this report. The Cactus Pointe system discharges to the Calabacillas Arroyo.

Off-site drainage basins flow to the existing Cactus Pointe storm drain system to which the proposed Irving Boulevard storm drain system connects. This system has to accommodate the existing flows as well as the proposed flows from the Irving system.

West of Green Street:

The major drainage basin west of Green Street to Irving Boulevard is collected in the proposed storm drain system via inlets. This new storm drain system connects to an existing storm drain system at the intersection of Irving Boulevard and Golf Course Road. The proposed system conveys flows to the Calabacillas Arroyo. There are four undeveloped lots that drain to Irving Boulevard. These are designated as Basins E.2 and E.3 on the basin map. There are currently no development plans for the lots designated as E.2. The basin E.3 is currently under design by Mark Goodwin and Associates and is planned as a gas station and convenience store. Runoff from this tract will drain directly into the planned storm drain system using a connector pipe that will be constructed as part of this project. Basin E.2 will drain directly onto Irving Boulevard and, for this analysis, it has been assumed that the lots are fully developed.

There are two major off-site basins that drain to the existing storm drain system in Irving and Golf Course. These are the Paradise Greens, Unit II Subdivision at the southwest quadrant of the intersection of Golf Course and Irving, the Arroyo Villas Apartments, and the Eagle Ranch development at the northeast quadrant of the intersection. These basins currently drain into the existing storm drain system that outfall to the Calabacillas Arroyo and do not impact the drainage basin for the project. However, they do drain to the existing storm drain system and this system has to accommodate the existing developed conditions flows as well as the flows from the construction of the project and flows from the developed lots within the project area.

Golf Course Road:

The portion of Golf Course Road in this project drains overland from approximately the Bernalillo County line (just south of the Paradise Hills Golf Course) north to the intersection of Irving Boulevard and Golf Course Road. The runoff is collected in the proposed storm drain system via inlets just south of the intersection. The proposed storm drain system connects to the existing storm drain system at the intersection of Golf Course Road and Irving Boulevard. This existing system then conveys flows to the Calabacillas Arroyo. There are no off-site drainage basins impacting the Golf Course system.

The existing storm drain systems that the proposed storm drain systems connect to are described in Section IV, Existing Drainage Facilities.

B. Existing Vegetation

Existing vegetation is relatively sparse throughout the area and consists of open-type desert grassland (Drainage Basins E.1, E.2 and E.3). Under developed conditions, it is

anticipated that the area will be covered with hard impervious surfaces and various types of landscaping.

C. Land Use

Developed condition land uses were determined from the proposed roadway improvements and the potential development of the vacant lots. This report assumed the roadway as 100% "D" and the vacant lots as 30% "B" and 70% "D".

IV. EXISTING DRAINAGE FACILITIES

There are two existing storm drain systems to which the proposed storm drain will connect. The proposed storm drain for Irving Boulevard west of Green Street will connect to the Arroyo Villas Apartments system (contained in Appendix B). This system was constructed to provide drainage for the Paradise Greens, Phase II, Subdivision (southwest quadrant), the Arroyo Villas Apartments (northwest quadrants), and the Eagle Ranch Development (northeast quadrant). The existing system consists of pipes ranging from 18-inch diameter to 42-inches in diameter at the outfall. The proposed storm drain system in Irving Boulevard will connect to the existing system at MH #4. The as-built drawings for this system are located in the pocket at the back of the report.

The proposed storm drain system for Irving Boulevard east of Green Street will connect to the Cactus Pointe Subdivision storm drain (contained in Appendix C). This system begins at the intersection of Chantilly Street and Bryan Road and consists of 18-inch pipe up to 60-inch pipe at the outfall. The system winds through existing neighborhoods and outfalls to the Calabacillas Arroyo. The proposed storm drain for Irving Boulevard will connect to the existing storm drain at the beginning of the system at Bryan Street just east of Chantilly.

V. HYDROLOGY

The hydrology for the project was developed using Section 22.2 Hydrology of the Development Process Manual, Design Criteria for the City of Albuquerque, New Mexico. The design storm is the 100-Year, 6-Hour storm. The procedure used for the analysis was the Part A Procedure for 40-acre area and smaller drainage basins. The following information was taken from the DPM for the analysis:

Precipitation zone:	1
Peak discharge/acre:	2.03 cfs (land use B)
	4.37 cfs (land use D)

Mapping for this study (shown on Plates 1 and 2) utilized the ortho-photography and vector contour composite images (part of the Bernalillo County Digital Mapping). The mapping was obtained from the Albuquerque Metropolitan Arroyo and Flood Control Authority (AMAFCA).

The drainage basins were determined based on two criteria: existing right-of-way and anticipated or proposed patting actions. The basins for the roadway improvements are

taken to be the right-of-way of the road as the lots adjacent to the right-of-way will not drain to the road and the land use was assumed to be 100% "D". These basins are designated as A, C, D, E and F.

The lots that are at the southeast quadrant of Irving Boulevard and Golf Course Road were assumed to develop as 30% "B" and 70% "D". The basin designated as B.3 is the proposed gas station and convenience store that is currently being designed by Mark Goodwin and Associates. This development will drain to an on-site system that will connect to the proposed storm drain in Irving Boulevard. The other lots, designated as B.1 and B.2 were assumed to overland flow to either Irving Boulevard or Golf Course Road based on frontage, and the runoff is intercepted by the proposed system catch basins.

The basin designations and hydrology calculations are as follows:

BASIN #	TOTAL AREA	LANDUSE 'D' AREA	LANDUSE 'B' AREA	Q₁₀₀ FLOW
	(acres)	(acres)	(acres)	(cfs)
A1	0.77	0.616	0.154	3.00
A2	0.67	0.536	0.134	2.61
B1	2.72	2.176	0.544	10.61
B2	2.22	1.776	0.444	8.66
B3	2.36	1.888	0.472	9.21
C1	1.98	1.584	0.396	7.73
C2	0.23	0.184	0.046	0.90
C3	0.78	0.624	0.156	3.04
C4	0.63	0.504	0.126	2.46
C5	0.42	0.336	0.084	1.64
C6	0.47	0.376	0.094	1.83
D	1.96	1.568	0.392	7.65
E1	0.52	0.416	0.104	2.03
E2	0.53	0.424	0.106	2.07
F1	0.11	0.088	0.022	0.43
F2	0.92	0.736	0.184	3.59
F3	0.84	0.672	0.168	3.28
F4	0.39	0.312	0.078	1.52
F5	0.41	0.328	0.082	1.60
Total	18.93	15.14	3.79	73.86

VI. HYDRAULICS

The hydraulics of the proposed storm drain system are based on utilizing the following system parts:

- Streets which act as open channels to convey storm water runoff the drop inlets.
- Underground piping which convey storm water runoff from the drop inlets to the final outfall at the Calabacillas Arroyo.

Street capacities were determined using "Flow Master", a computer program that utilizes Manning's Equation to determine hydraulic capacities of the roadways and the interception capacity of the inlets. Hydraulic grade lines for storm drain pipes were calculated using "Storm Cad", a computer program used to perform hydraulic analyses on storm drain pipe systems. "Storm Cad" utilizes Manning's Equation for open channel flow as well as pressurized flow incorporating friction head loss and other minor head losses within the storm drain system.

The results of the HGL calculations are shown in Appendix E and F and the hydraulic capacity of the roads in Appendix G.

PROPOSED STORM DRAIN

Two storm drain systems are proposed for the project, the Irving/Golf Course system and the Irving/Chantilly system. The plan-and-profile sheets for the proposed system is contained in Appendix D.

Irving/Golf Course System:

This system consists of RCP storm drain ranging in size from 18-inch to 36-inch and has two "legs"; one that proceeds up Irving Boulevard to the east from the existing MH 4 and one that proceeds south up Golf Course Road from the Irving Boulevard system at Station 9+93.

The system for Irving Boulevard collects flows generated west of Green Street as well as the on-site system from the future gas station/convenience store site. Catch basins will be constructed along the length of the system to collect street flows. The HGL analysis of the system shows that the system will function well and the HGL stays below the road surface and in some instances, the HGL stays within the pipe.

The Golf Course "leg" begins at the manhole at Station 9+93 in the Irving system and proceeds south up Golf Course for two pipe segments, each being 24-inch pipes. This system collects street flows in catch basins prior to the intersection. The HGL analysis of the system shows that the system will function well and the HGL stays below the road surface.

Irving/Chantilly System:

This system consists of RCP storm drain ranging in size from 18-inch to 24-inch. The system begins in Irving Boulevard at Station 29+04 and proceeds east to Chantilly. At Chantilly, the system turns south to Bryan Street and then east again to connect to the existing Cactus Pointe storm drain system. Catch basins will be constructed along the length of the system in Irving Boulevard to collect street flows. No catch basins will be constructed in Chantilly Street as they are not required. The flow that will be added to the existing system due to the proposed improvements in Irving Boulevard is 22 cfs. The proposed system and the existing system were analyzed to determine the effect of the additional flows on the combined system. The HGL analysis shows that the existing system cannot carry the additional flows from the proposed system due to an under-

sized storm drain for the first 95 feet of the existing system. This part of the existing system would have to be up-sized to a 30-inch pipe to keep the HGL in the ground. The HGL was re-calculated assuming that 22 cfs would get to the Cactus Pointe system from the Irving system while 11 cfs of the historic flow to the Cactus Pointe system from Bryan Avenue west of Chantilly would by-pass the system for the first two sets of catch basins. If 11 cfs of street flow is intercepted by the Cactus Pointe system at Station 5+20, the combined system would operate with the HGL below the street surface in Bryan Avenue and just above the street surface in Chantilly. Street flow calculations show that the 11 cfs of by-pass will be 0.31 feet deep at the curb and will be confined within the street section due to the street slopes (1.31 %) in that area (the street flow calculation is contained in Appendix G). Therefore, it is economically not feasible to up-size the existing system for only 95 feet when the by-pass flow can easily be accommodated within the street and intercepted not far from the original interception point.

VII. REFERENCES


City of Albuquerque, July 1997, "Development Process Manual, Section 22.2, Hydrology".

Haestad Methods Inc., August 2000, "FlowMaster PE Version 6.0 Computer Software".

Haestad Methods Inc., November 2000, "CulvertMaster Computer Software".

Haestad Methods Inc., December 1999, "StormCad Computer Software".


IR = IRVING BLVD STATIONING
GC = GOLF COURSE STATIONING
MH = MANHOLE DESIGNATIONS FOR EXISTING SYSTEM FROM PREVIOUS P & P DRAWINGS
P-22 = PIPE DESIGNATION BETWEEN MANHOLES

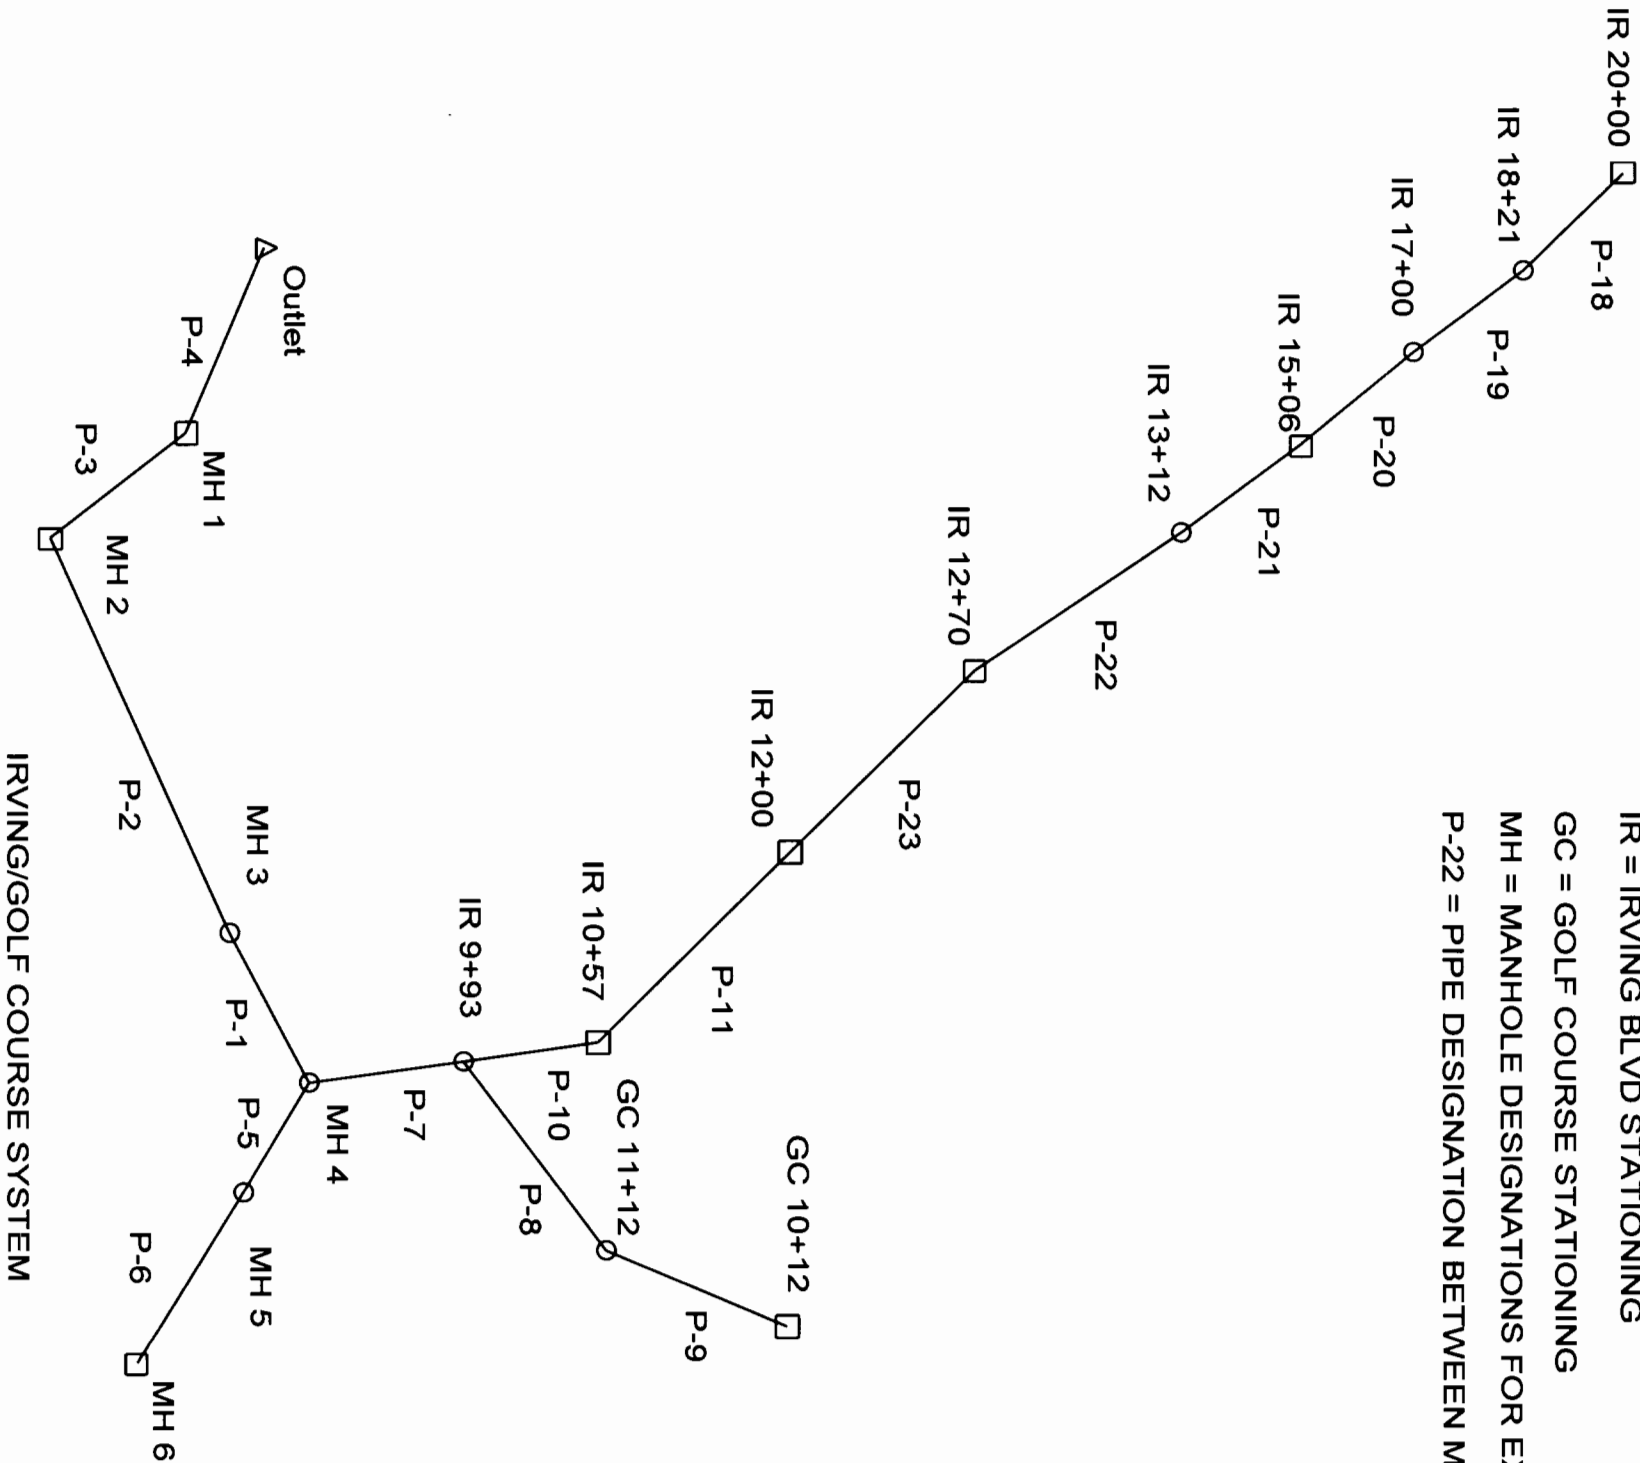

Combined Pipe/Node Report

Pipe	Upstream Node	Downstream Node	Length (ft)	Section Size	Capacity (cfs)	Discharge (cfs)	Average Velocity (ft/s)	Upstream Invert Elevation (ft)	Downstream Invert Elevation (ft)	Constructed Slope (ft/ft)	Downstream Cover (ft)	Downstream Ground Elevation (ft)	Downstream HGL (ft)	Downstream Rim Elevation (ft)	Downstream Sump Elevation (ft)	Upstream Cover (ft)	Upstream Depth (ft)	Upstream Ground Elevation (ft)	Upstream HGL (ft)	Upstream Rim Elevation (ft)	Upstream Sump Elevation (ft)
P-18	IR 20+00	IR 18+21	182.00	18 inch	10.96	8.65	6.44	105.56	103.58	0.010879	7.77	112.85	104.59	112.85	103.48	6.79	1.14	113.85	106.70	113.85	105.56
P-19	IR 18+21	IR 17+00	182.00	18 inch	9.34	8.65	6.01	103.48	102.04	0.007912	7.46	111.00	103.18	111.00	101.94	7.87	1.14	112.85	104.62	112.85	103.48
P-20	IR 17+00	IR 15+06	194.00	18 inch	18.58	8.65	5.45	101.94	95.87	0.031289	7.13	104.50	97.77	104.50	95.87	7.56	1.14	111.00	103.08	111.00	101.94
P-21	IR 15+06	IR 13+12	192.00	24 inch	53.82	22.82	12.22	95.87	85.00	0.056615	7.00	94.00	85.91	94.00	85.00	6.63	1.70	104.50	97.57	104.50	95.87
P-22	IR 13+12	IR 12+70	42.00	30 inch	60.04	22.82	5.95	85.00	84.10	0.021429	6.40	93.00	86.22	93.00	84.10	6.50	1.63	94.00	86.63	94.00	85.00
P-23	IR 12+70	IR 12+00	69.00	30 inch	60.47	32.03	7.47	84.10	82.60	0.021739	5.90	91.00	84.78	91.00	82.60	6.40	1.93	93.00	86.03	93.00	84.10
P-11	IR 12+00	IR 10+57	141.00	30 inch	58.62	33.68	8.04	82.60	79.72	0.020426	6.28	88.50	81.73	88.50	79.62	5.90	1.97	91.00	84.57	91.00	82.60
P-9	GC 10+12	GC 11+12	82.00	24 inch	27.37	16.22	7.78	84.00	82.80	0.014634	5.20	90.00	83.92	90.00	82.59	9.00	1.45	95.00	85.45	95.00	84.00
P-6	MH 6	MH 5	60.00	36 inch	134.50	93.00	13.27	78.62	76.18	0.040667	7.32	87.00	80.25	86.50	76.18	6.88	2.86	88.50	81.48	88.50	78.62
P-10	IR 10+57	IR 9+93	71.50	36 inch	116.19	35.51	6.32	79.62	77.45	0.030350	6.55	87.00	80.16	87.00	77.35	5.88	1.94	88.50	81.56	88.50	79.62
P-8	GC 11+12	IR 9+93	117.00	24 inch	47.87	16.22	5.90	82.59	77.35	0.044786	7.65	87.00	80.16	87.00	77.35	5.41	1.45	90.00	84.04	90.00	82.59
P-5	MH 5	MH 4	57.00	36 inch	115.86	93.00	13.16	76.18	74.46	0.030175	7.54	85.00	79.14	85.00	74.21	7.32	4.07	86.50	80.25	86.50	76.18
P-7	IR 9+93	MH 4	82.80	36 inch	124.17	51.73	8.03	77.35	74.48	0.034662	7.52	85.00	79.14	85.00	74.21	6.65	2.34	87.00	79.69	87.00	77.35
P-1	MH 4	MH 3	196.00	36 inch	153.48	144.73	22.10	74.21	63.83	0.052959	11.17	78.00	66.25	78.00	63.83	7.79	2.98	85.00	77.19	85.00	74.21
P-2	MH 3	MH 2	335.00	36 inch	152.09	144.73	20.49	63.83	46.41	0.052000	8.59	58.00	49.88	58.00	46.41	11.17	2.98	78.00	66.81	78.00	63.83
P-3	MH 2	MH 1	126.00	42 inch	246.92	207.73	21.62	46.41	38.82	0.060238	6.68	49.00	42.30	49.00	38.82	8.09	3.47	58.00	49.88	58.00	46.41
P-4	MH 1	Outlet	67.00	42 inch	269.84	222.93	24.74	38.82	34.00	0.071940	-0.50	37.00	36.88	37.00	34.00	6.68	3.48	49.00	42.30	49.00	38.82

IR = IRVING BLVD STATIONING
CH = CHANTILLY STATIONING
P-7 = PIPE DESIGNATION BETWEEN MANHOLES
OUTLET = CONNECTION TO EXISTING CACTUS POINT STORM DRAIN

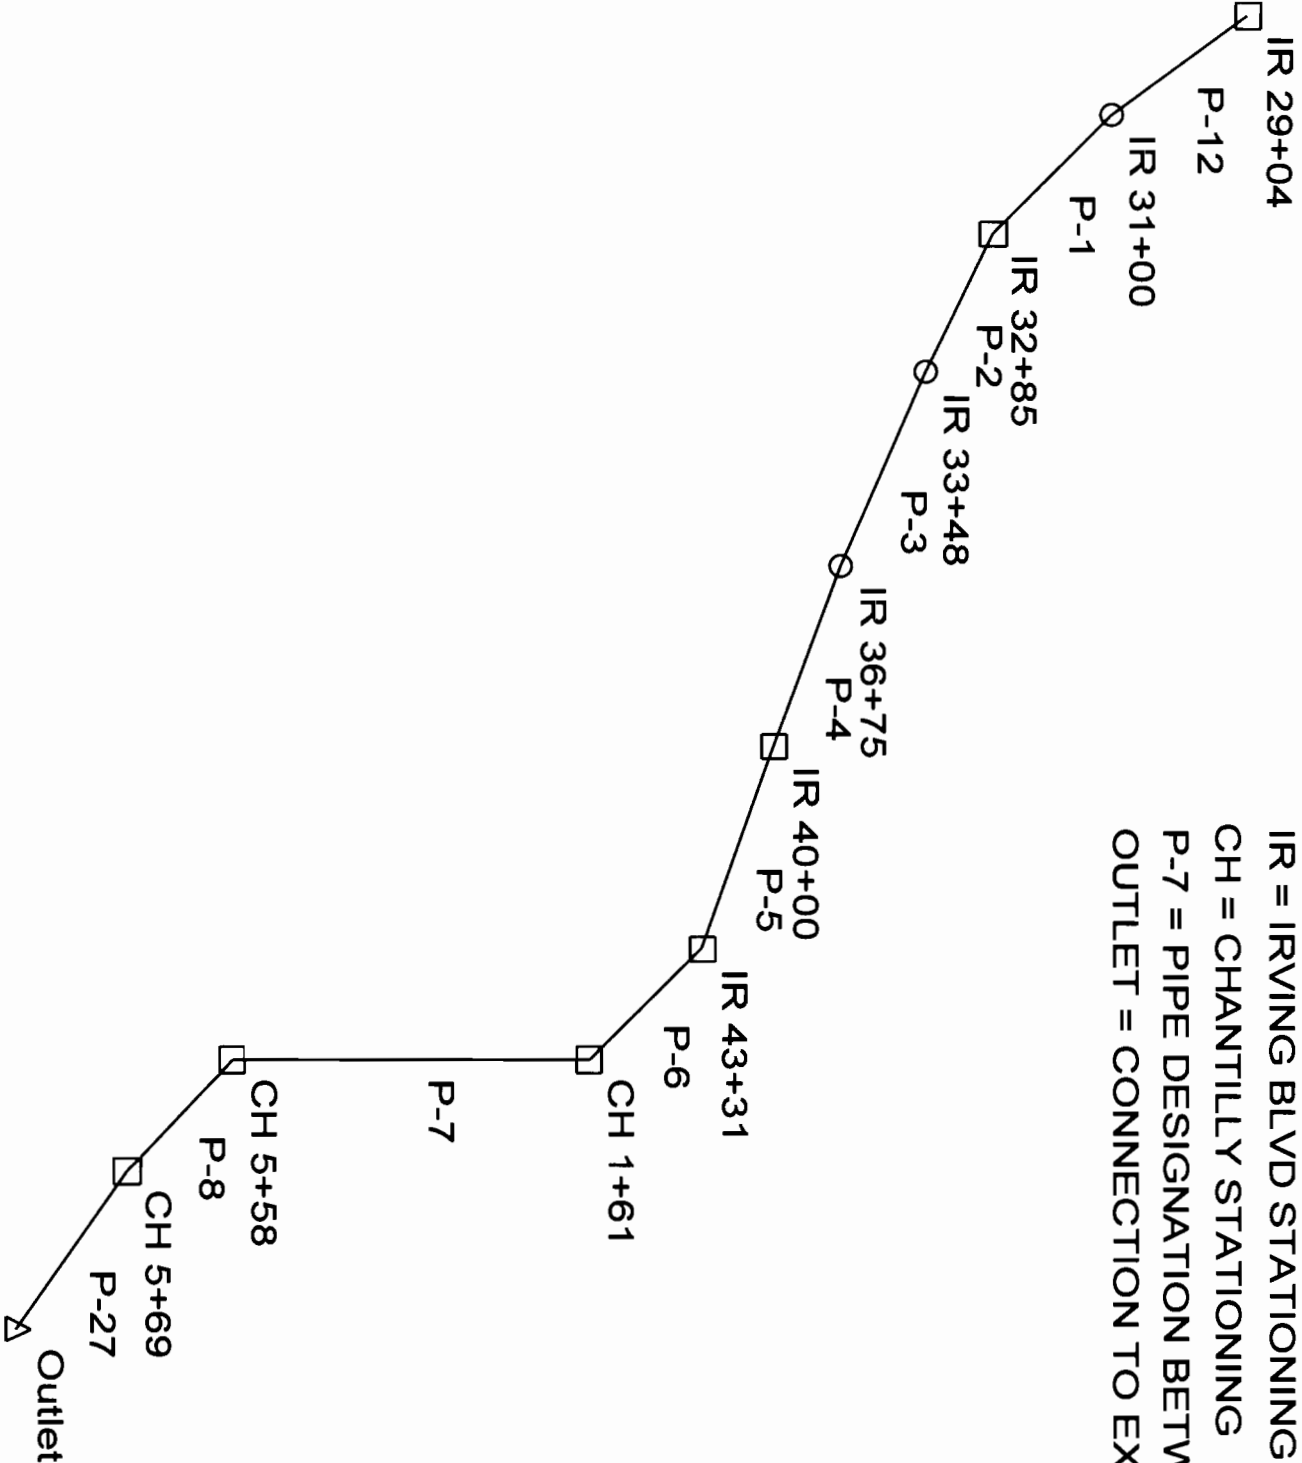


IRVING/CHANTILLY SYSTEM: FROM THE CONNECTION TO THE EXISTING CACTUS POINT SYSTEM
NORTH ON CHANTILLY AND WEST ON IRVING BLVD

Combined Pipe/Node Report

Pipe	Upstream Node	Downstream Node	Length (ft)	Section Size	Capacity (cfs)	Discharge (cfs)	Average Velocity (ft/s)	Upstream Invert Elevation (ft)	Downstream Invert Elevation (ft)	Constructed Slope (ft/ft)	Downstream Cover (ft)	Downstream Ground Elevation (ft)	Downstream HGL (ft)	Downstream Rim Elevation (ft)	Downstream Sump Elevation (ft)	Upstream Cover (ft)	Upstream Depth (ft)	Upstream Ground Elevation (ft)	Upstream HGL (ft)	Upstream Rim Elevation (ft)	Upstream Sump Elevation (ft)
P-12	IR 29+04	IR 31+00	199.00	18 inch	14.87	7.64	5.36	101.60	97.61	0.020050	7.32	106.43	98.81	106.43	97.61	6.40	1.07	109.50	102.67	109.50	101.60
P-1	IR 31+00	IR 32+85	188.00	18 inch	14.43	7.64	5.10	97.61	94.06	0.018883	5.27	100.83	95.42	100.83	94.06	7.32	1.07	106.43	98.68	106.43	97.61
P-2	IR 32+85	IR 33+48	65.00	18 inch	14.33	9.66	6.32	94.06	92.85	0.018615	4.36	98.71	94.07	98.71	92.85	5.27	1.20	100.83	95.26	100.83	94.06
P-3	IR 33+48	IR 36+75	327.00	24 inch	46.97	9.66	5.04	92.85	78.75	0.043119	6.20	86.95	80.00	86.95	78.75	3.86	1.11	98.71	93.96	98.71	92.85
P-4	IR 36+75	IR 40+00	325.00	24 inch	47.12	9.66	4.31	78.75	64.65	0.043385	6.11	60.67 72.76	66.46	Actual 72.76	64.65	6.20	1.11	86.95	79.86	86.95	78.75
P-5	IR 40+00	IR 43+31	332.00	24 inch	38.57	19.05	6.63	64.65	55.00	0.029066	8.67	60.67 65.67	61.64	60.67 65.67	55.00	6.11	1.57	Actual 72.76	66.22	Actual 72.76	64.65
P-6	IR 43+31	CH 1+61	70.00	24 inch	24.18	22.14	7.05	55.00	54.20	0.011429	7.55	58.75	60.73	58.75	54.20	8.67	6.40	Actual 65.67	61.40	Actual 65.67	55.00
P-7	CH 1+61	CH 5+58	398.00	24 inch	18.97	22.14	7.05	54.20	51.40	0.007035	7.60	50.00 61.00	56.69	50.00 61.00	51.40	7.55	6.30	58.75	60.50	58.75	54.20
P-8	CH 5+58	CH 5+69	64.00	24 inch	19.99	22.14	7.05	51.40	50.90	0.007813	7.15	55.00 60.05	55.84	55.00 60.05	50.90	7.60	5.06	50.00 61.00	56.46	50.00 61.00	51.40
P-27	CH 5+69	Outlet	64.00	24 inch	13.56	22.14	7.05	50.90	50.67	0.003594	2.33	55.00	55.00	55.00	50.67	7.15	4.71	55.00 60.05	55.61	55.00 60.05	50.90

NOTE: RIM/GROUND ELEVATIONS FOR MANHOLES AT IR 43+31, CH 1+61, CH 5+58 AND CH 5+59 ARE SET AT ARTIFICIAL ELEVATION IN ANALYSIS TO ALLOW THAT FLOW IS NOT "LOST" FROM THE SYSTEM DUE TO SLEWARKING. ACTUAL RIM/GROUND ELEVATIONS ARE SHOWN NEXT TO ARTIFICIAL RIM ELEVATIONS.

THE PROPOSED IRVING/CHANTILLY SYSTEM CONNECTS TO THE EXISTING
CACTUS POINT SYSTEM AT STA. 2+03.3

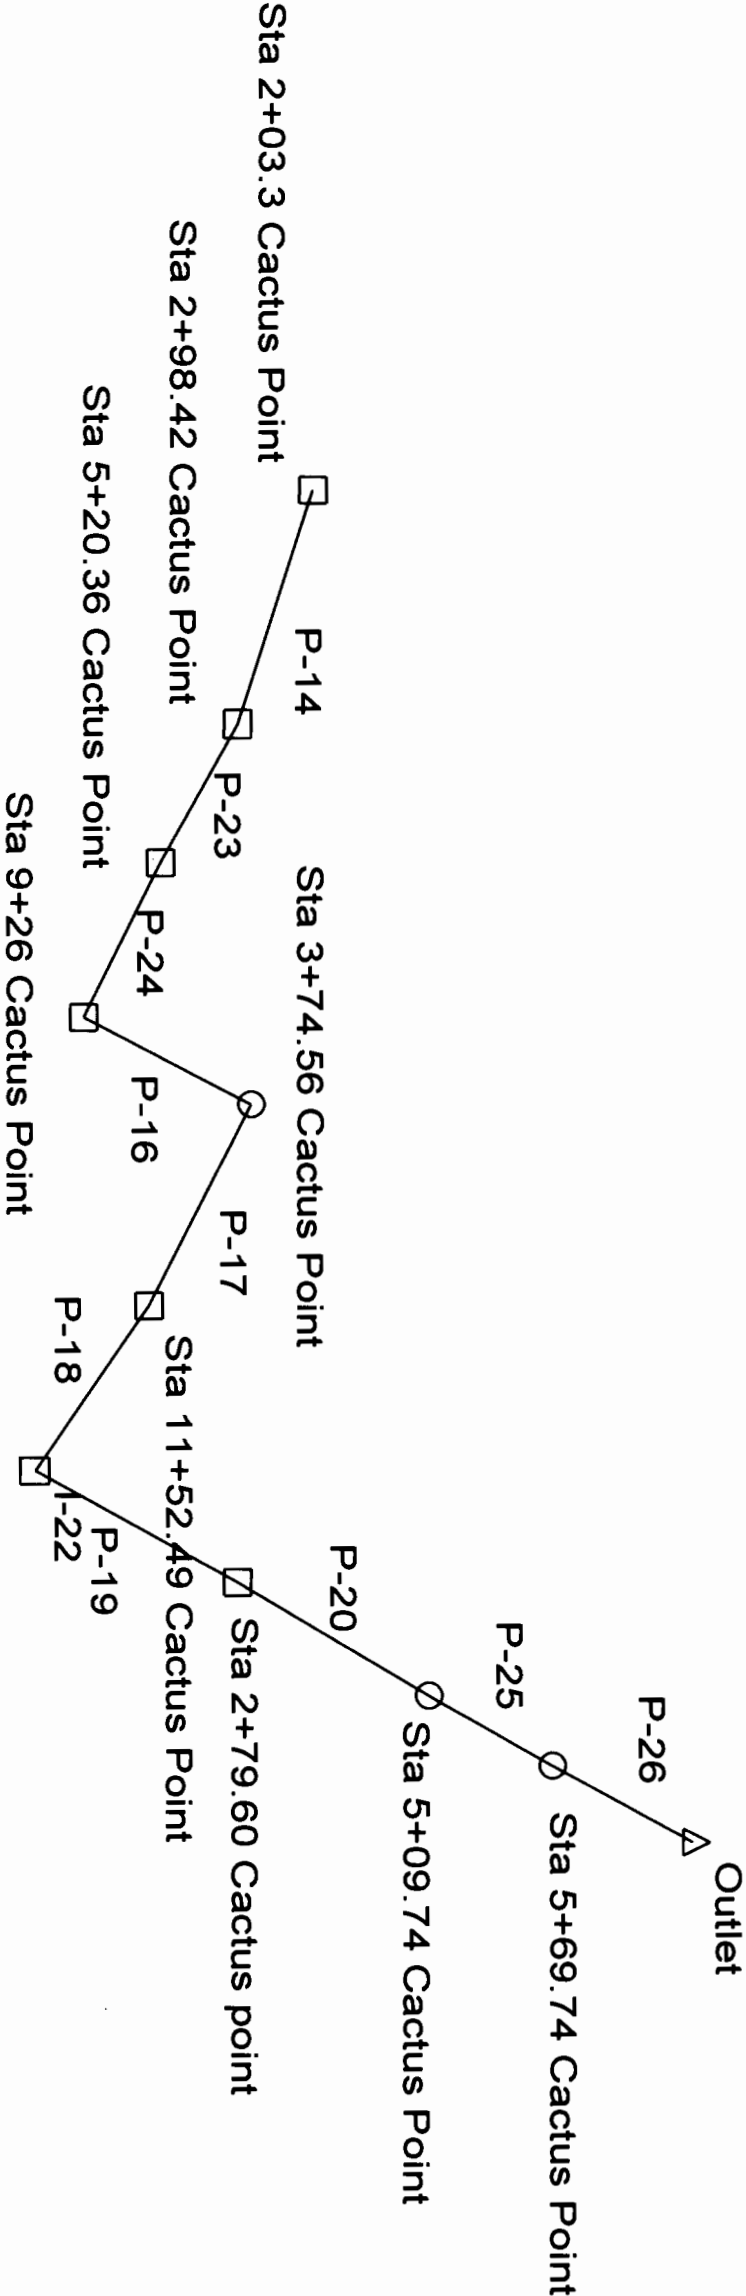

EXISTING CACTUS POINT SYSTEM

Combined Pipe/Node Report

Pipe	Upstream Node	Downstream Node	Length (ft)	Section Size	Capacity (cfs)	Discharge (cfs)	Average Velocity (ft/s)	Upstream Invert Elevation (ft)	Downstream Invert Elevation (ft)	Constructed Slope (ft/ft)	Downstream Cover (ft)	Downstream Ground Elevation (ft)	Downstream HGL (ft)	Downstream Rim Elevation (ft)	Downstream Sump Elevation (ft)	Upstream Cover (ft)	Upstream Depth (ft)	Upstream Ground Elevation (ft)	Upstream HGL (ft)	Upstream Rim Elevation (ft)	Upstream Sump Elevation (ft)
P-14	Sta 2+03.3 Cactus Point	Sta 2+98.42 Cactus Point	95.00	24 inch	47.85	50.00	15.92	150.67	146.42	0.044737	4.58	153.00	150.56	153.00	146.42	2.33	4.53	155.00	155.20	155.00	150.67
P-23	Sta 2+98.42 Cactus Point	Sta 5+20.36 Cactus Point	232.00	30 inch	83.65	87.40	17.80	146.42	136.77	0.041595	2.73	142.00	139.53	142.00	136.28	4.08	3.64	153.00	150.06	153.00	146.42
P-24	Sta 5+20.36 Cactus Point	Sta 9+26 Cactus Point	395.00	36 inch	119.35	103.60	16.90	136.28	123.63	0.032025	4.37	131.00	125.79	131.00	122.83	2.72	2.91	142.00	139.19	142.00	136.28
P-16	Sta 9+26 Cactus Point	Sta 3+74.56 Cactus Point	285.00	48 inch	181.09	154.60	14.43	122.83	118.30	0.015895	3.70	126.00	121.18	126.00	118.30	4.17	3.63	131.00	126.46	131.00	122.83
P-17	Sta 3+74.56 Cactus Point	Sta 11+52.49 Cactus Point	135.00	48 inch	180.84	154.60	12.81	118.30	116.16	0.015852	2.84	123.00	119.87	123.00	116.07	3.70	3.63	126.00	121.93	126.00	118.30
P-18	Sta 11+52.49 Cactus Point	I-22	172.00	48 inch	175.58	184.90	15.32	116.07	113.50	0.014942	3.50	121.00	117.06	121.00	113.00	2.93	3.80	123.00	119.87	123.00	116.07
P-19	I-22	Sta 2+79.60 Cactus point	184.00	48 inch	562.41	208.90	16.71	113.30	85.09	0.153315	14.91	104.00	89.66	104.00	85.09	3.70	3.87	121.00	117.17	121.00	113.00
P-20	Sta 2+79.60 Cactus point	Sta 5+09.74 Cactus Point	227.00	60 inch	271.66	275.90	15.15	85.09	82.62	0.010881	12.38	100.00	86.83	100.00	82.62	13.91	4.57	104.00	89.66	104.00	85.09
P-25	Sta 5+09.74 Cactus Point	Sta 5+69.74 Cactus Point	62.00	60 inch	600.10	275.90	20.58	82.62	71.40	0.180968	1.60	78.00	74.02	78.00	71.40	12.38	4.57	100.00	87.19	100.00	82.62
P-26	Sta 5+69.74 Cactus Point	Outlet	40.00	60 inch	263.91	275.90	14.91	71.40	70.00	0.035000	0.00	75.00	74.37	75.00	70.00	1.60	4.57	78.00	75.97	78.00	71.40

Worksheet

Worksheet for Irregular Channel

Project Description	
Worksheet	Bryan Street
Flow Element	Irregular Channel
Method	Manning's Formula
Solve For	Channel Depth

Input Data	
Slope	0.013300 ft/ft
Discharge	11.00 cfs

Options	
Current Roughness Method	Improved Lotter's Method
Open Channel Weighting Method	Improved Lotter's Method
Closed Channel Weighting Method	Horton's Method

Results	
Mannings Coefficient	0.017
Water Surface Elevation	0.31 ft
Elevation Range	0.00 to 0.83
Flow Area	3.8 ft ²
Wetted Perimeter	25.38 ft
Top Width	24.84 ft
Actual Depth	0.31 ft
Critical Elevation	0.34 ft
Critical Slope	0.007810 ft/ft
Velocity	2.86 ft/s
Velocity Head	0.13 ft
Specific Energy	0.44 ft
Froude Number	1.28
Flow Type	Supercritical

Calculation Messages:
Flow is divided.


Roughness Segments		
Start Station	End Station	Mannings Coefficient
0+00	0+42	0.017

Natural Channel Points	
Station (ft)	Elevation (ft)
0+00	0.83
0+05	0.67
0+05	0.00
0+21	0.40
0+37	0.00
0+37	0.67
0+42	0.83


Cross Section Cross Section for Irregular Channel

Project Description	
Worksheet	Bryan Street
Flow Element	Irregular Channel
Method	Manning's Formula
Solve For	Channel Depth

Section Data	
Mannings Coefficient	0.017
Slope	0.013300 ft/ft
Water Surface Elevation	0.31 ft
Elevation Range	0.00 to 0.83
Discharge	11.00 cfs

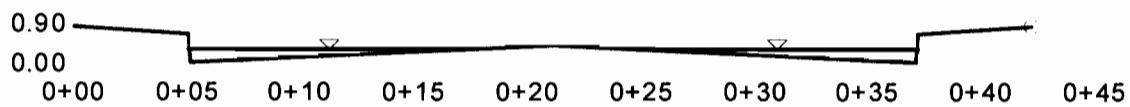


V:2.0
H:1
NTS

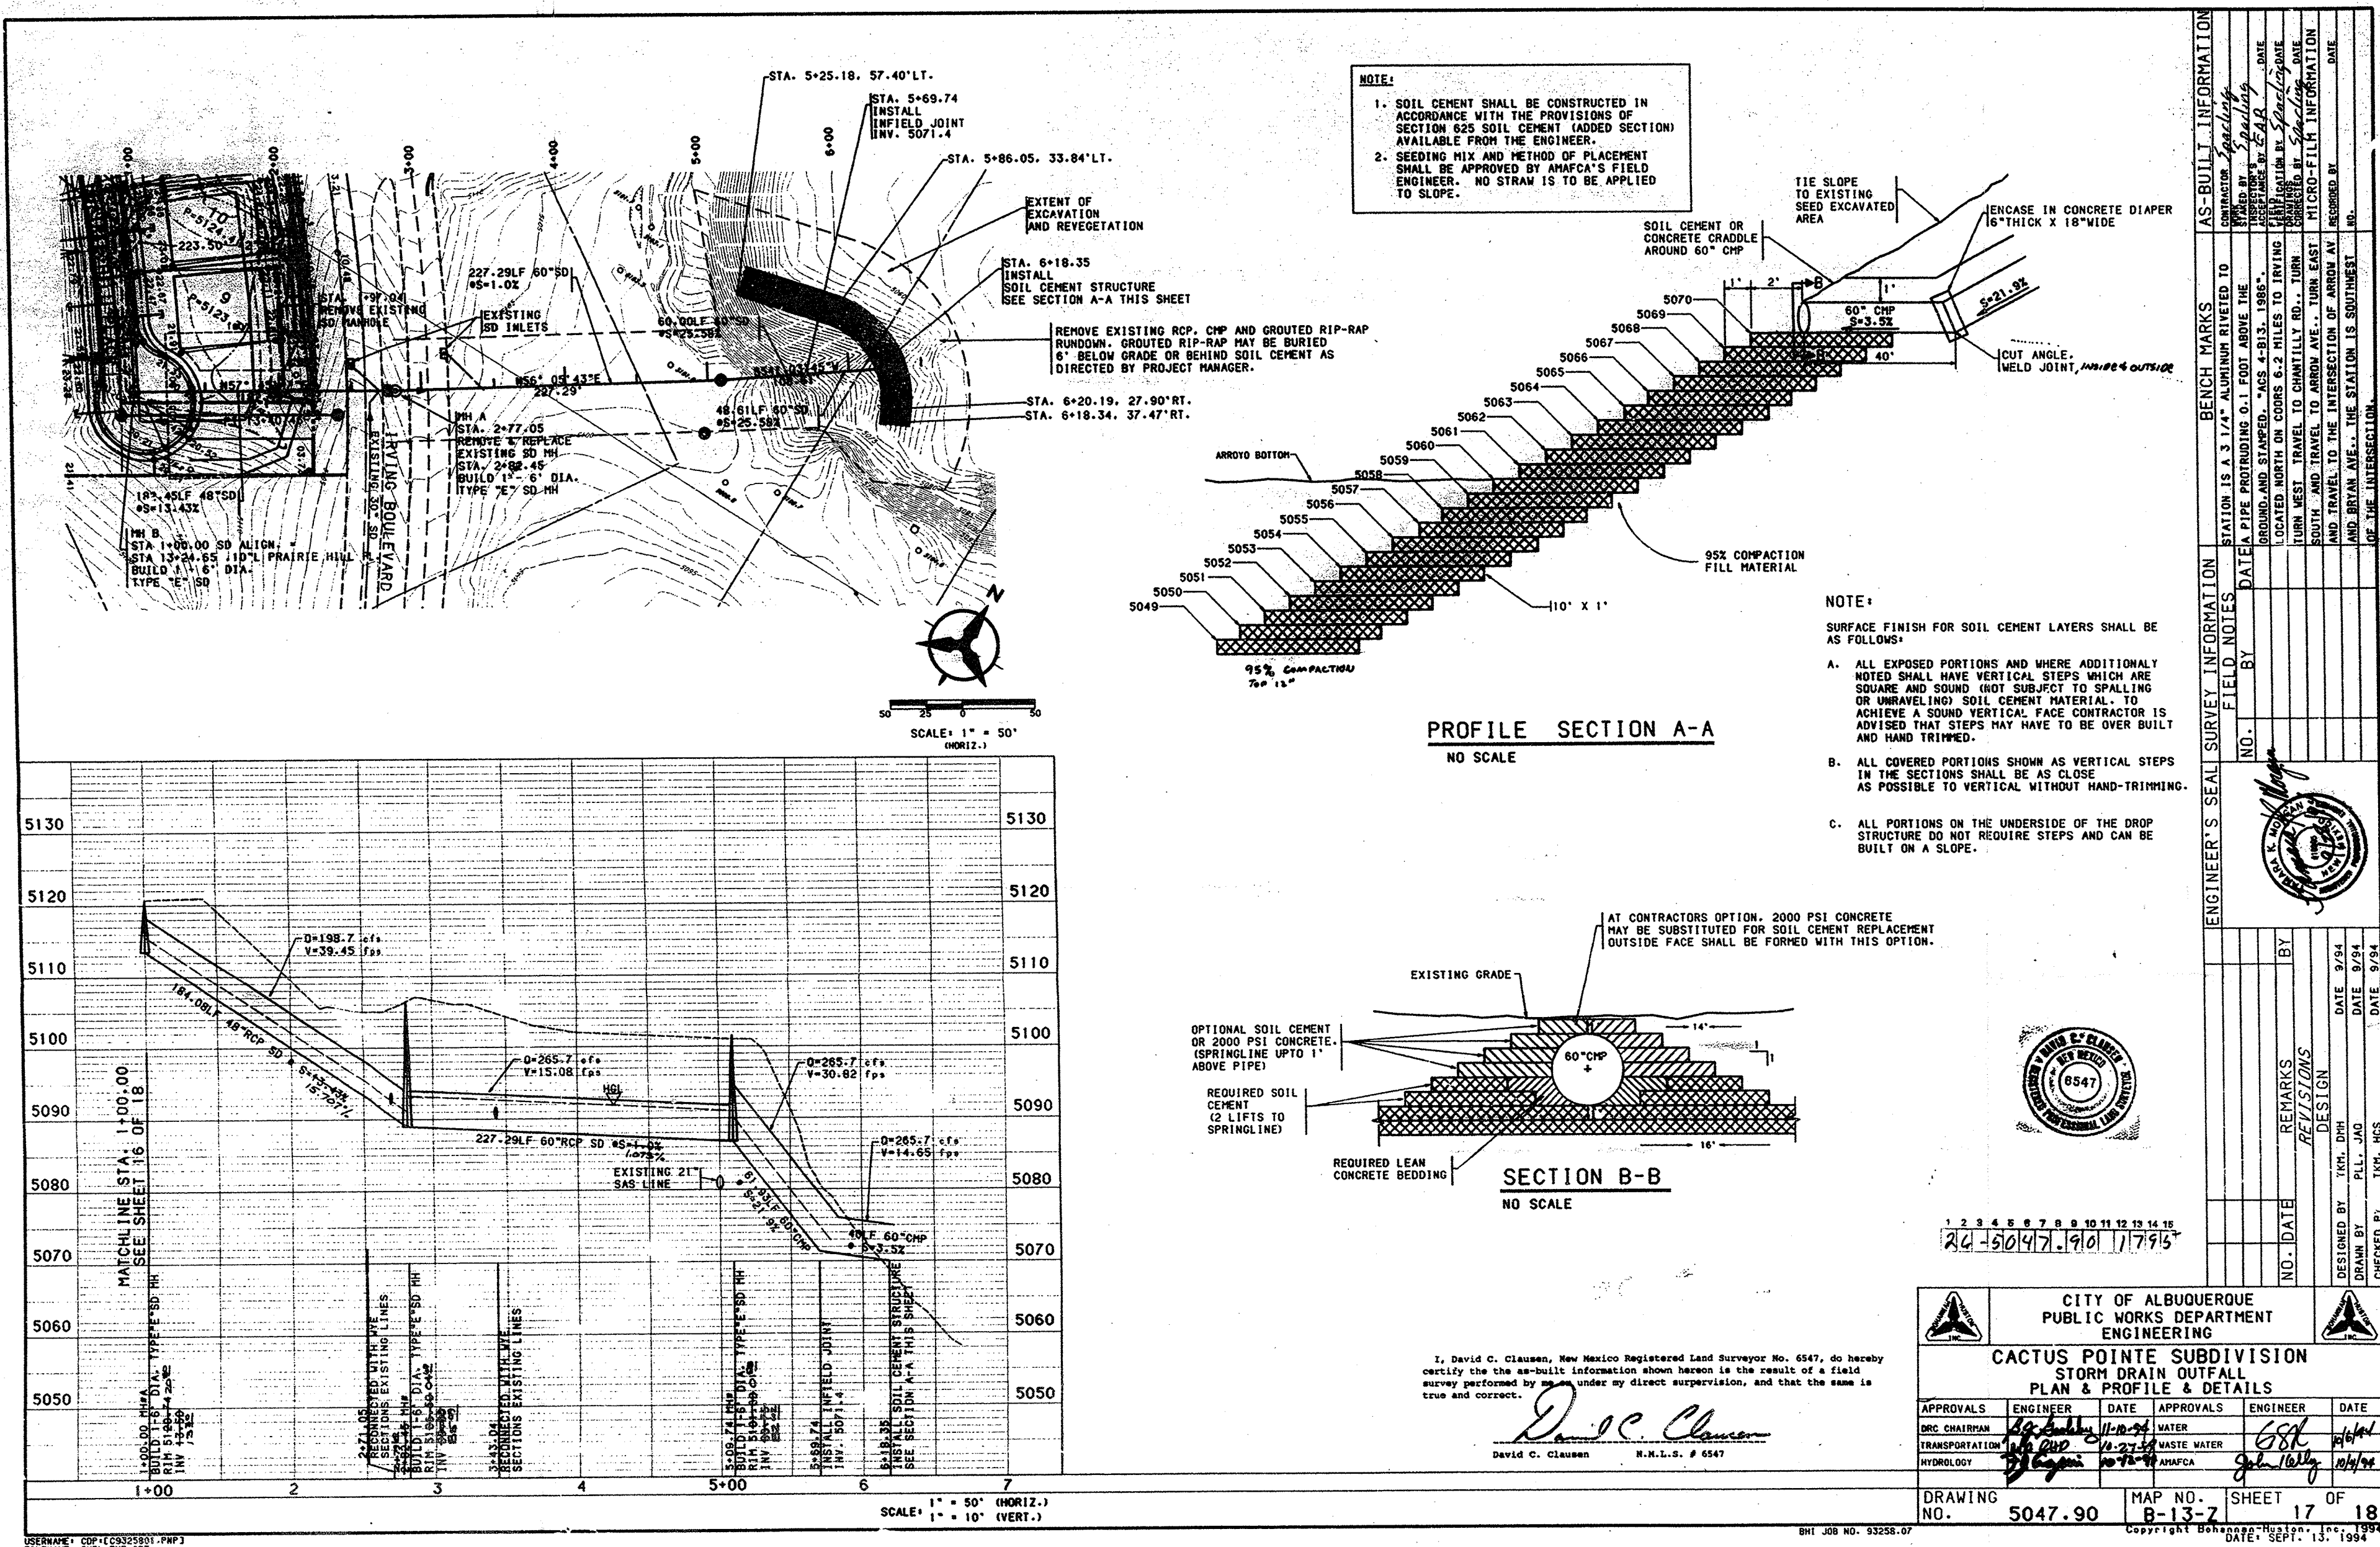

CITY OF ALBUQUERQUE

RECEIVED
JAN 16 2003
HYDROLOGY SECTION

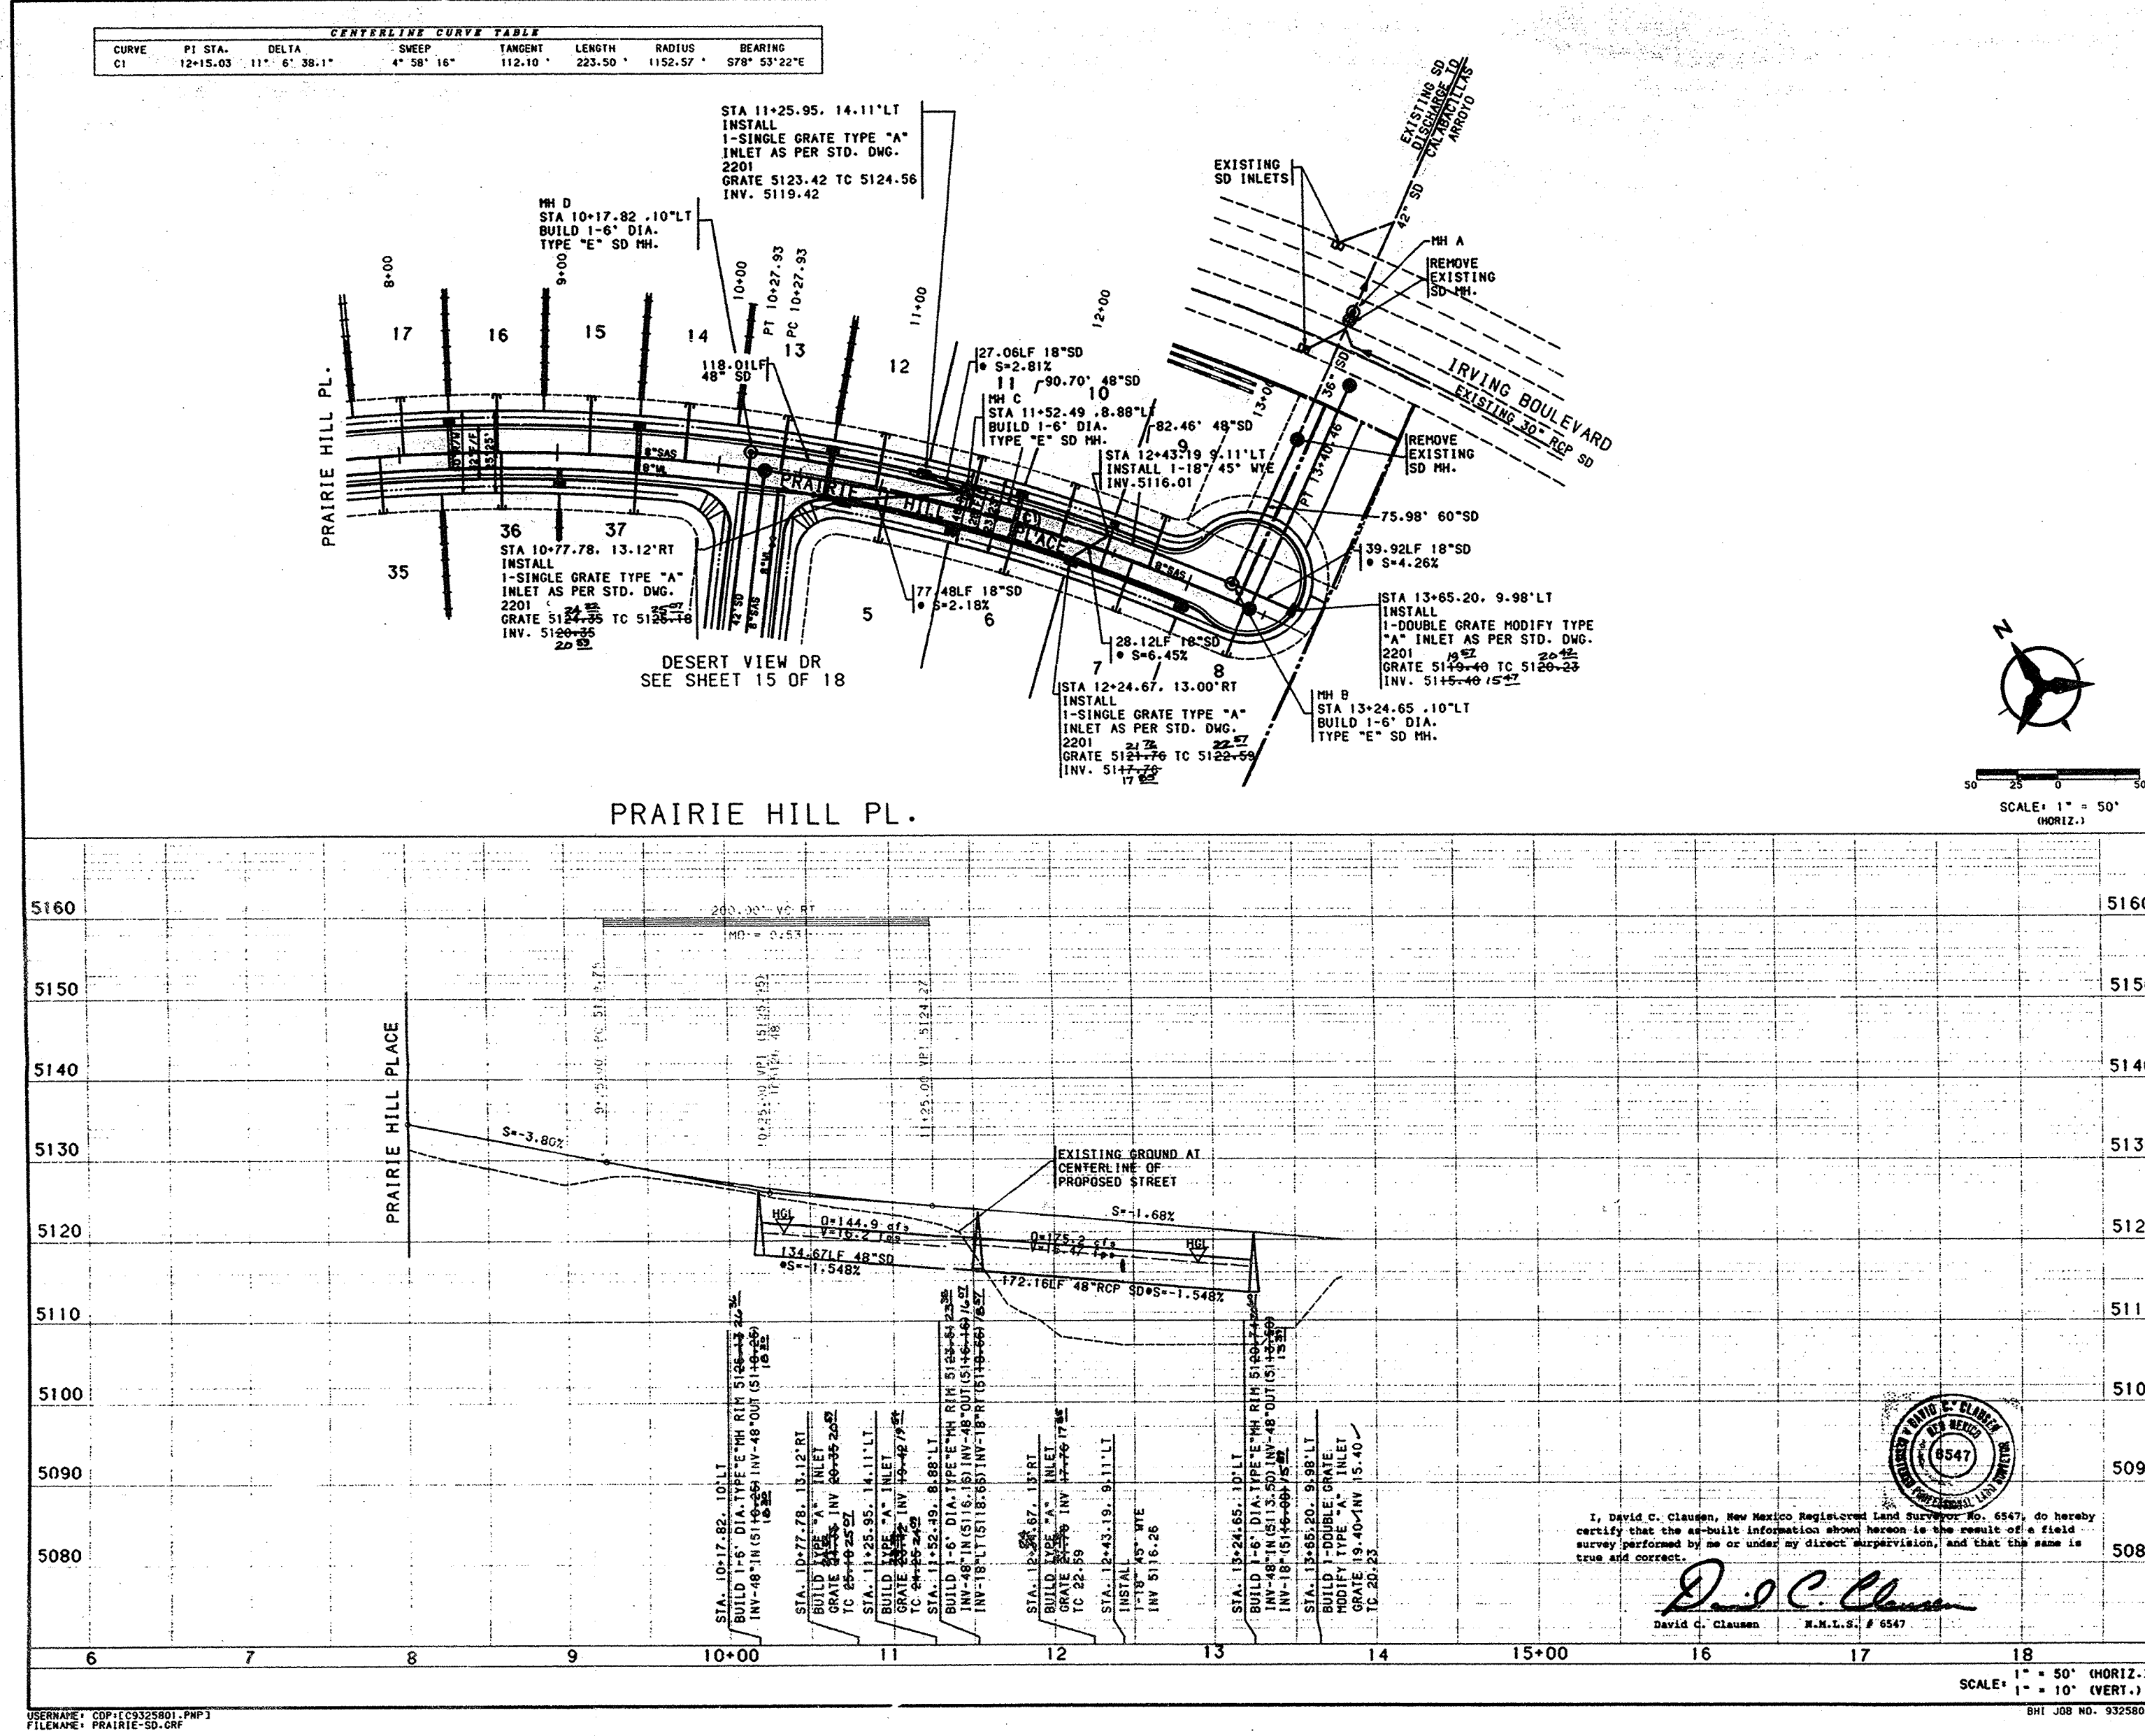

NOTES

1. THE CONTRACTOR SHALL FIELD VERIFY ALL EXISTING UTILITY LOCATIONS AND NOTIFY THE ENGINEER IMMEDIATELY OF ANY DISCREPANCIES.
2. ALL CURB RETURN RADII SHALL BE 25' TO FACE OF CURB UNLESS OTHERWISE SPECIFIED.
3. ALL CURVE DATA AND DIMENSIONS REFER TO FACE OF CURB UNLESS OTHERWISE SPECIFIED.
4. GRADE ELEVATIONS, WHERE NOTED, ARE FOR TOP OF STANDARD CURB UNLESS OTHERWISE SPECIFIED.
5. CONTRACTOR IS TO INSTALL A 4"x4"x5" POST AND END AT THE END OF EACH SANITARY SEWER SERVICE.
6. CONTRACTOR IS RESPONSIBLE FOR REPAIR AND/OR REPLACEMENT OF ALL UTILITY CONDUITS AND EXISTING LINES.
7. ANY ADDITIONAL GRADING REQUIRED TO MATCH PROPOSED STREET GRADES SHALL BE INCIDENTAL TO PAVING ITEMS.
8. CONTRACTOR SHALL PROVIDE THE INSPECTORS (CITY AND PRIVATE) WITH THE PROPOSED HYDROSTATIC TESTING PLAN. THE PLAN MUST BE APPROVED BEFORE TESTING OPERATIONS BEGIN.
9. CONTRACTOR SHALL PARK EQUIPMENT AND VEHICLES AS NOT TO INTERFERE WITH NORMAL ACTIVITIES OF RESIDENTS OR OTHER CONTRACTORS ON SITE.
10. ANY DAMAGE TO THE EXISTING FACILITIES (CURB AND GUTTER, PAVEMENT, CONDUITS, LANDSCAPING, UTILITY LINES, ETC.) DURING CONSTRUCTION SHALL BE REPLACED AT THE CONTRACTORS EXPENSE.
11. REMOVAL OF THE EXISTING CURB AND GUTTER SHALL BE AS PER COA STD. DWG. 2415 (SAMCUT ONLY).
12. WHEEL CHAIR RAMPS SHALL BE CONSTRUCTED PRIOR TO ACCEPTANCE OF CURB AND GUTTER.

ENGINEER'S SEAL SURVEY INFORMATION

DATE: 9/94
DESIGNED BY: TMM
DRAWN BY: BS, JMD, PLL
CHECKED BY: TMM

**CITY OF ALBUQUERQUE
PUBLIC WORKS DEPARTMENT
ENGINEERING**

**CACTUS POINTE SUBDIVISION
STORM DRAIN PLAN & PROFILE
PRAIRIE HILL PL. STA 8+00.0-13+78.66**

APPROVALS


ENGINEER	DATE	APPROVALS	ENGINEER	DATE
DR. CHAIRMAN	11/11/94	WATER		
TRANSPORTATION	11/11/94	WASTE WATER		
HYDROLOGY	11/11/94			

DRAWING NO. 5047.90

MAP NO. B-13-7

SHEET 16 OF 18

DATE: SEPT. 13, 1994

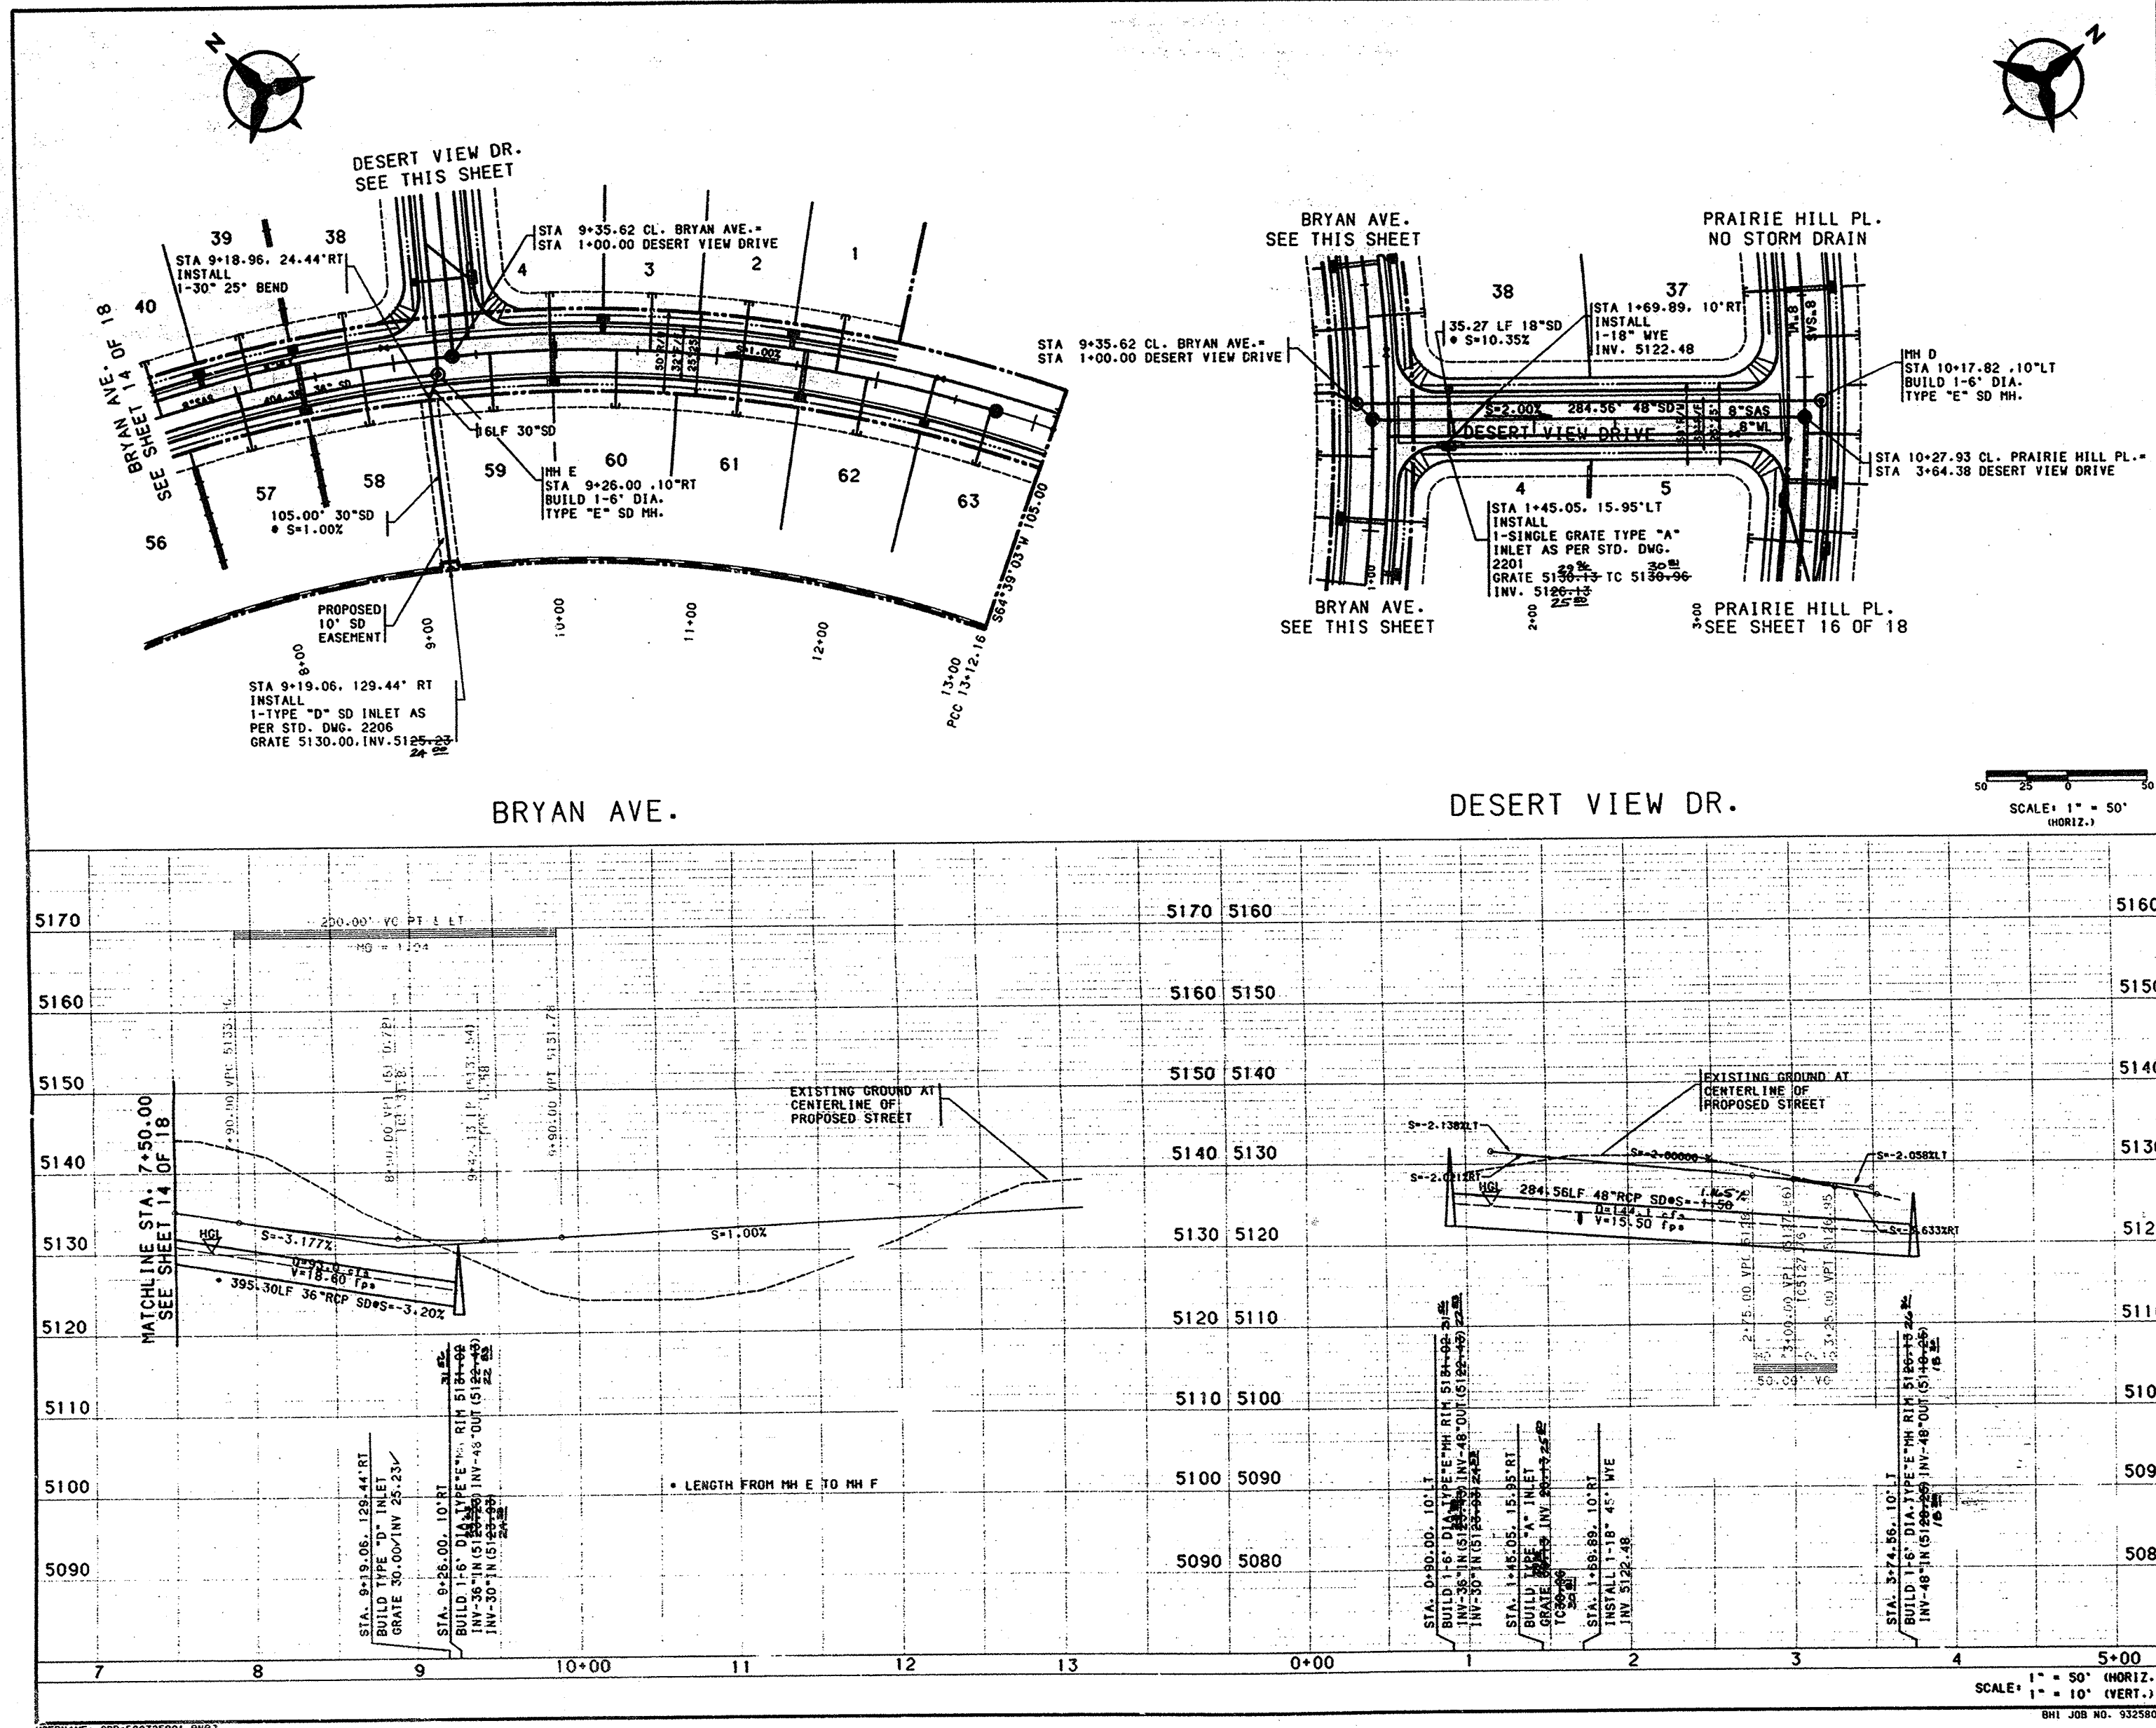

NOTES

1. THE CONTRACTOR SHALL FIELD VERIFY ALL EXISTING UTILITY LOCATIONS AND NOTIFY THE ENGINEER IMMEDIATELY OF ANY DISCREPANCIES.
2. ALL CURB RETURN RADII SHALL BE 25' TO FACE OF CURB UNLESS OTHERWISE SPECIFIED.
3. ALL CURVE DATA AND DIMENSIONS REFER TO FACE OF CURB UNLESS OTHERWISE SPECIFIED.
4. GRADE ELEVATIONS, WHERE NOTED, ARE FOR TOP OF STANDARD CURB UNLESS OTHERWISE SPECIFIED.
5. CONTRACTOR IS TO INSTALL A 4"x4"x5" POST AND END AT THE END OF EACH SANITARY SEWER SERVICE.
6. CONTRACTOR IS RESPONSIBLE FOR REPAIR AND/OR REPLACEMENT OF ALL UTILITY CONDUITS AND EXISTING LINES.
7. ANY ADDITIONAL GRADING REQUIRED TO MATCH PROPOSED STREET GRADES SHALL BE INCIDENTAL TO PAVING ITEMS.
8. CONTRACTOR SHALL PROVIDE THE INSPECTORS (CITY AND PRIVATE) WITH THE PROPOSED HYDROSTATIC TESTING PLAN. THE PLAN MUST BE APPROVED BEFORE TESTING OPERATIONS BEGIN.
9. CONTRACTOR SHALL PARK EQUIPMENT AND VEHICLES AS NOT TO INTERFERE WITH NORMAL ACTIVITIES OF RESIDENTS OR OTHER CONTRACTORS ON SITE.
10. ANY DAMAGE TO THE EXISTING FACILITIES (CURB AND GUTTER, PAVEMENT, CONDUITS, LANDSCAPING, UTILITY LINES, ETC.) DURING CONSTRUCTION SHALL BE REPLACED AT THE CONTRACTORS EXPENSE.
11. REMOVAL OF THE EXISTING CURB AND GUTTER SHALL BE AS PER CDA STD. DWG. 2415 (SAWCUT ONLY).
12. WHEEL CHAIR RAMPS SHALL BE CONSTRUCTED PRIOR TO ACCEPTANCE OF CURB AND GUTTER.

AS-BUILT INFORMATION

NO.	DATE	BY	REMARKS
1	9/94	TCM	DESIGN
2	9/94	TCM	REVISIONS

ENGINEER'S SEAL

David C. Glavin
Professional Engineer No. 6447
State of New Mexico
City of Albuquerque
Public Works Department
Engineering

CITY OF ALBUQUERQUE
PUBLIC WORKS DEPARTMENT
ENGINEERING

CACTUS POINTE SUBDIVISION
STORM DRAIN PLAN & PROFILE
BRYAN AVENUE & DESERT VIEW DRIVE

APPROVALS	ENGINEER	DATE	APPROVALS	ENGINEER	DATE
DRG CHAIRMAN	10/94	10/94	WATER	10/94	10/94
TRANSPORTATION	10/94	10/94	WASTE WATER	10/94	10/94
HYDROLOGY	10/94	10/94			

DRAWING NO. 5047.90 MAP NO. B-13-7 SHEET 15 OF 18

D
24


C
20

B
16


A
12

CITY OF ALBUQUERQUE


RECEIVED
JAN 16 2003
HYDROLOGY SECTION

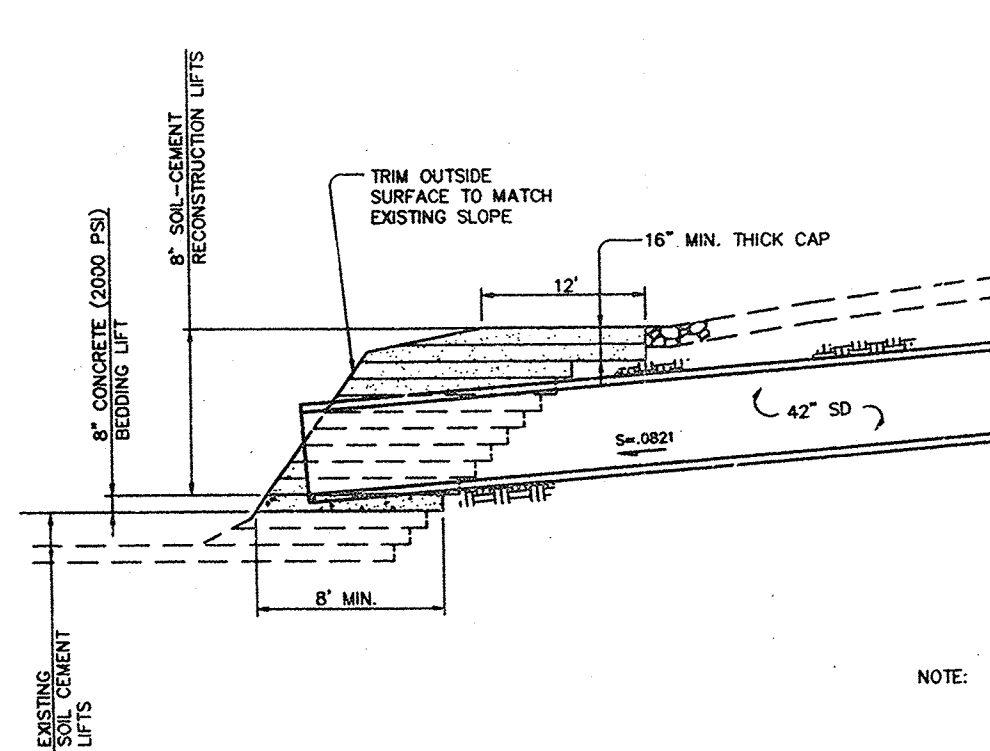

SECTION AT OUTLET
SCALE: 1"=5'

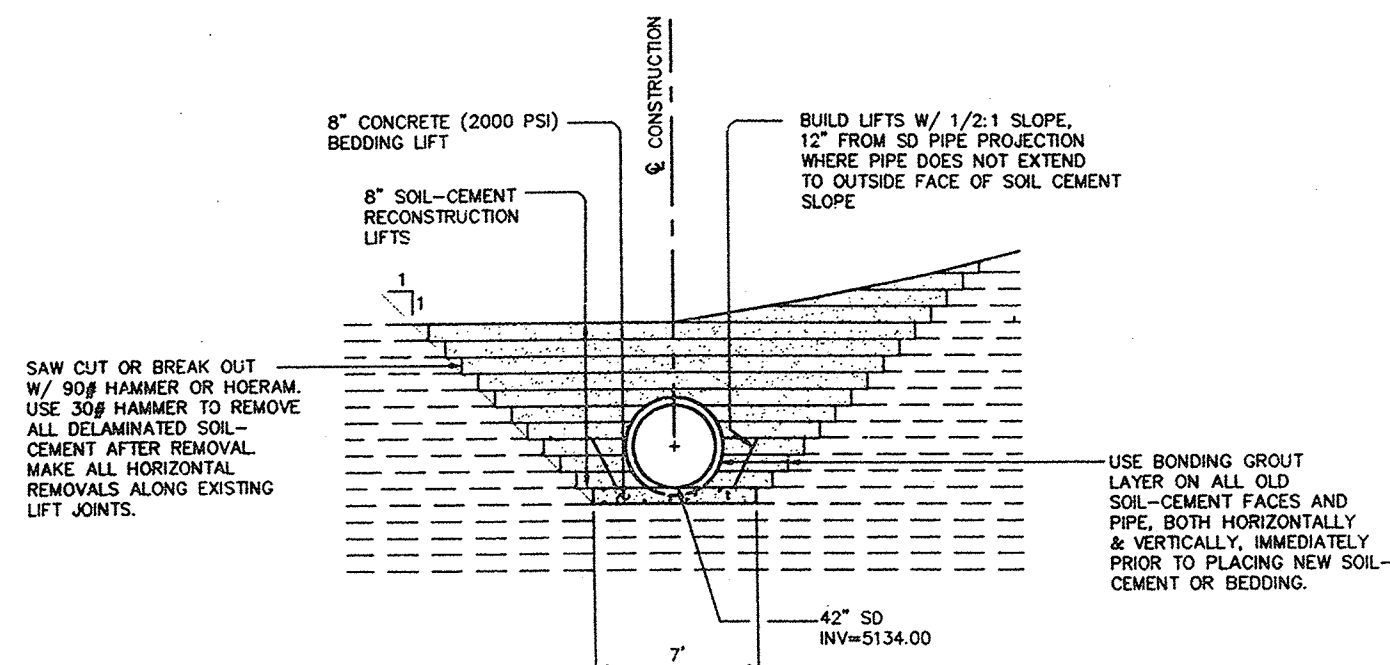

END ELEVATION AT OUTLET
SCALE: 1"=5'

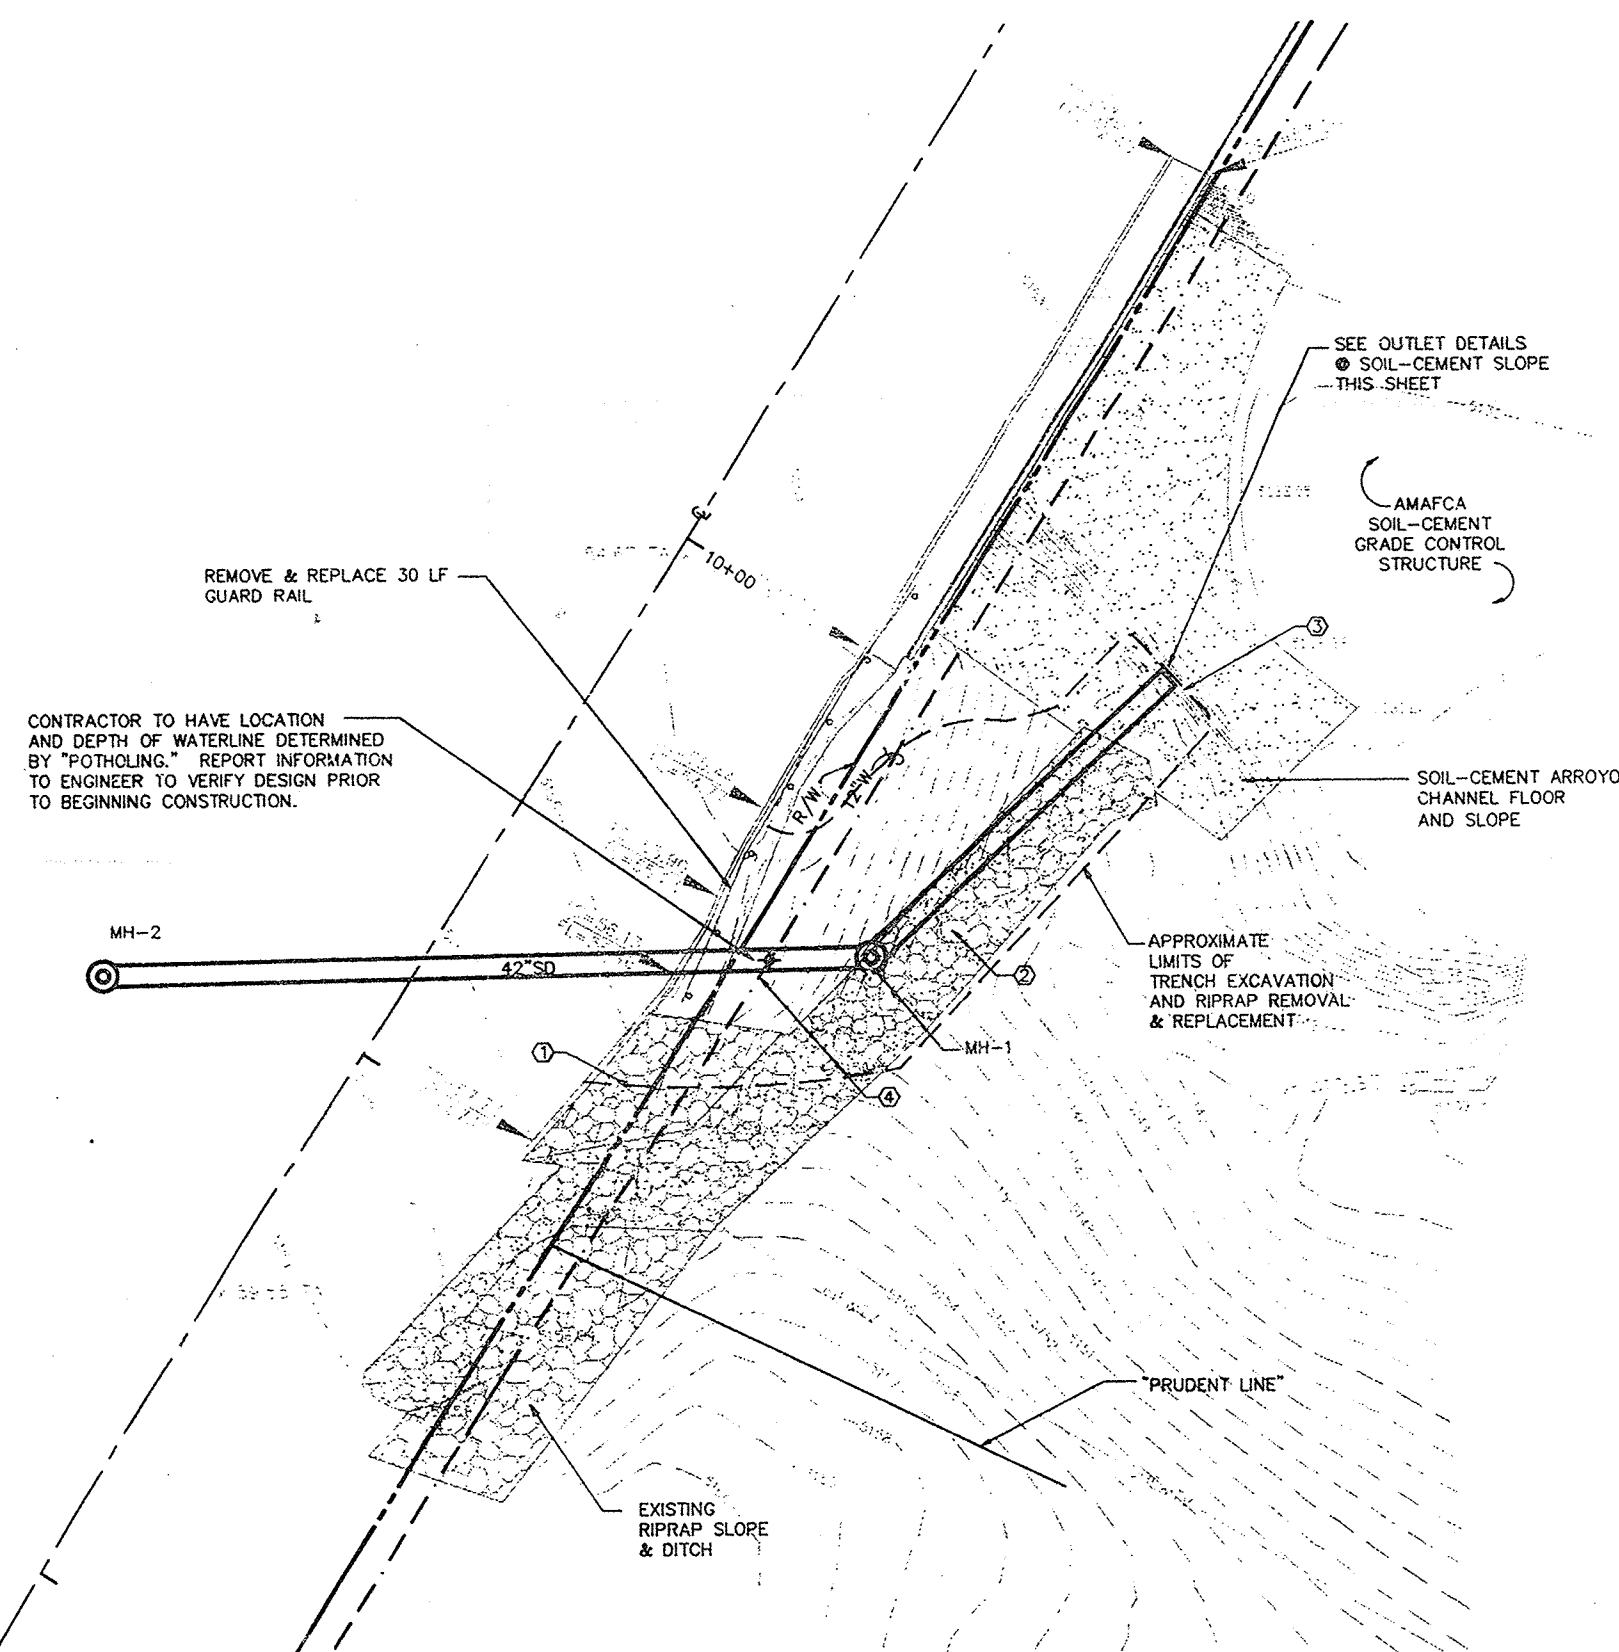

PLAN OF OUTLET
SCALE: 1"=20'

KEYED NOTES


1. REMOVE, STOCKPILE, AND REPLACE 35 SY LOOSE RIPRAP.
2. REMOVE & DISPOSE 150 SY GROUDED RIPRAP. RECONSTRUCT 150 SY GROUDED RIPRAP--SEE DETAIL THIS SHEET.
3. REMOVE 41 CY SOIL-CEMENT. CONSTRUCT 1.5 CY BEDDING CONCRETE LIFT. CONSTRUCT 36 CY SOIL-CEMENT REPLACEMENT LIFTS.
4. CONTRACTOR SHALL SUPPORT AND ANCHOR WATERLINE DURING CONSTRUCTION. NOTIFY BOB GAY, NEW MEXICO UTILITIES (888-266-1) 48 HOURS PRIOR TO EXPOSING WATERLINE.

LEGEND

- SOIL-CEMENT CHANNEL SLOPE
- LOOSE RIPRAP
- GROUDED RIPRAP
- GUARD RAIL

NOTES

1. NOTIFY AMAFCA 2 WORKING DAYS PRIOR TO EACH OCCURRENCE OF GRADING OR CONSTRUCTION IN THE AMAFCA RIGHT-OF-WAY.
2. NO CONSTRUCTION SHALL TAKE PLACE WITHIN THE ARROYO BETWEEN MAY 15 AND SEPTEMBER 15 OF ANY YEAR. ANY WORK STARTED PRIOR TO MAY 15 SHALL BE COMPLETED BY MAY 15.

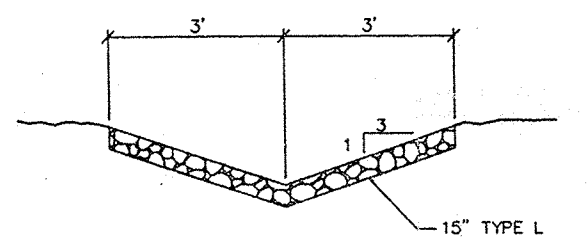

GROUDED RIPRAP DITCH
NO SCALE


24-10222-1701 1712/15

ISAACSON & ARPMAN, P.A. Consulting Engineering Association 1800 Avenue Street, N.E. Albuquerque, New Mexico 87102-1406 505-241-1000					
CITY OF ALBUQUERQUE PUBLIC WORKS DEPARTMENT ENGINEERING GROUP					
TITLE: ARROYO VILLAS APARTMENTS CALABACILLAS ARROYO STORM DRAIN OUTFALL DETAILS					
APPROVALS	ENGINEER	DATE	APPROVALS	ENGINEER	DATE
DRC CHAIRMAN	NA	10-20-99	WATER	NA	10-20-99
TRANSPORTATION	NA	10-20-99	WASTE WATER	NA	10-20-99
HYDROLOGY	NA	10-20-99	AMAFCA	NA	10-20-99
PROJECT NO.	5022.90	MAP NO.	B-12	SHEET	12 OF 20

AS-BUILT INFORMATION CONTRACTOR: T.A. HALE, Inc. DRAWN BY: S. HALE CHECKED BY: S. HALE DATE: 10/20/99		SURVEY INFORMATION FIELD NOTES NO. 1 BY DATE		ENGINEER'S SEAL [Seal]	
BENCH MARKS BLACK NO. 2 ELEV. = 5213.93		REMARKS DESIGN NO. DATE 1 10/20/99		CHECKED BY DATE 10/20/99	

RECEIVED
JAN 16 2003
HYDROLOGY SECTION

CITY OF ALBUQUERQUE

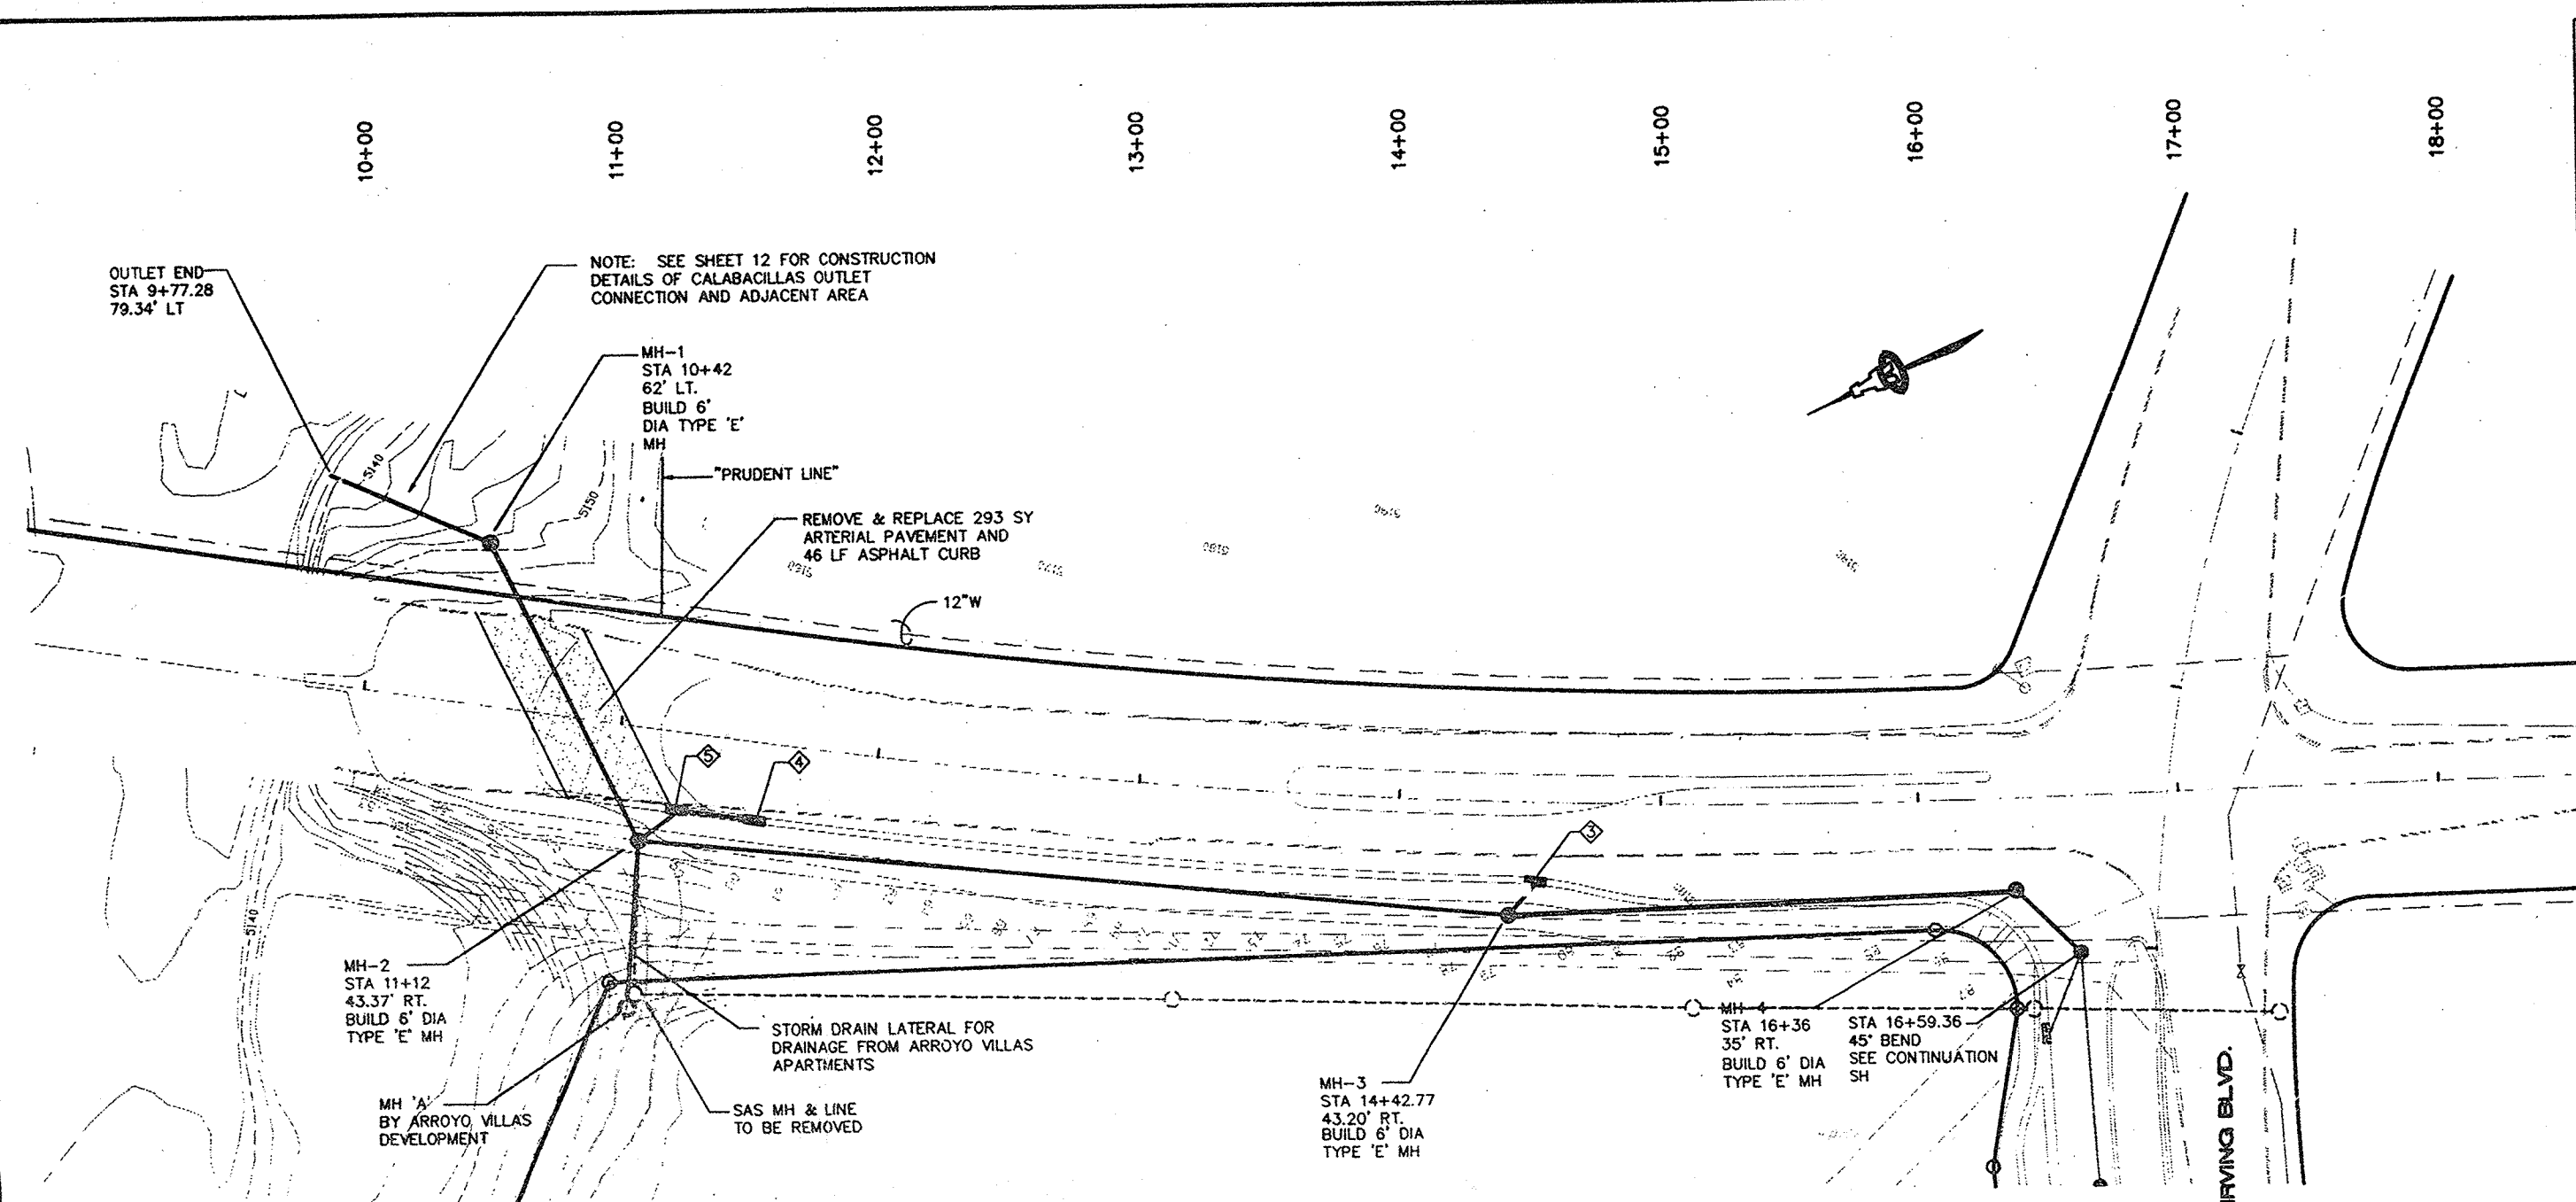


STORM DRAIN INLET INFORMATION						
INLET NO.	STATION	INLET TYPE	TOP CURB ELEVATION	TOP GRATE ELEVATION	INVERT IN	INVERT OUT
3	14+53	'A'	77.22	76.82	76.82	76.82
4	11+49	'A'	53.52	53.22	53.22	53.22
5	11+25	2C	58.22	57.82	54.52	54.52

CONNECTOR PIPE INFORMATION			
FROM INLET NO.	DIA (IN)	LENGTH (FT)	SLOPE
3	18	15	0.030
4	18	21	0.050
5	18	18	0.030

GOLF COURSE RD. STORM DRAIN

SCALES:
1"=40' HOR.
1"=10' VERT.

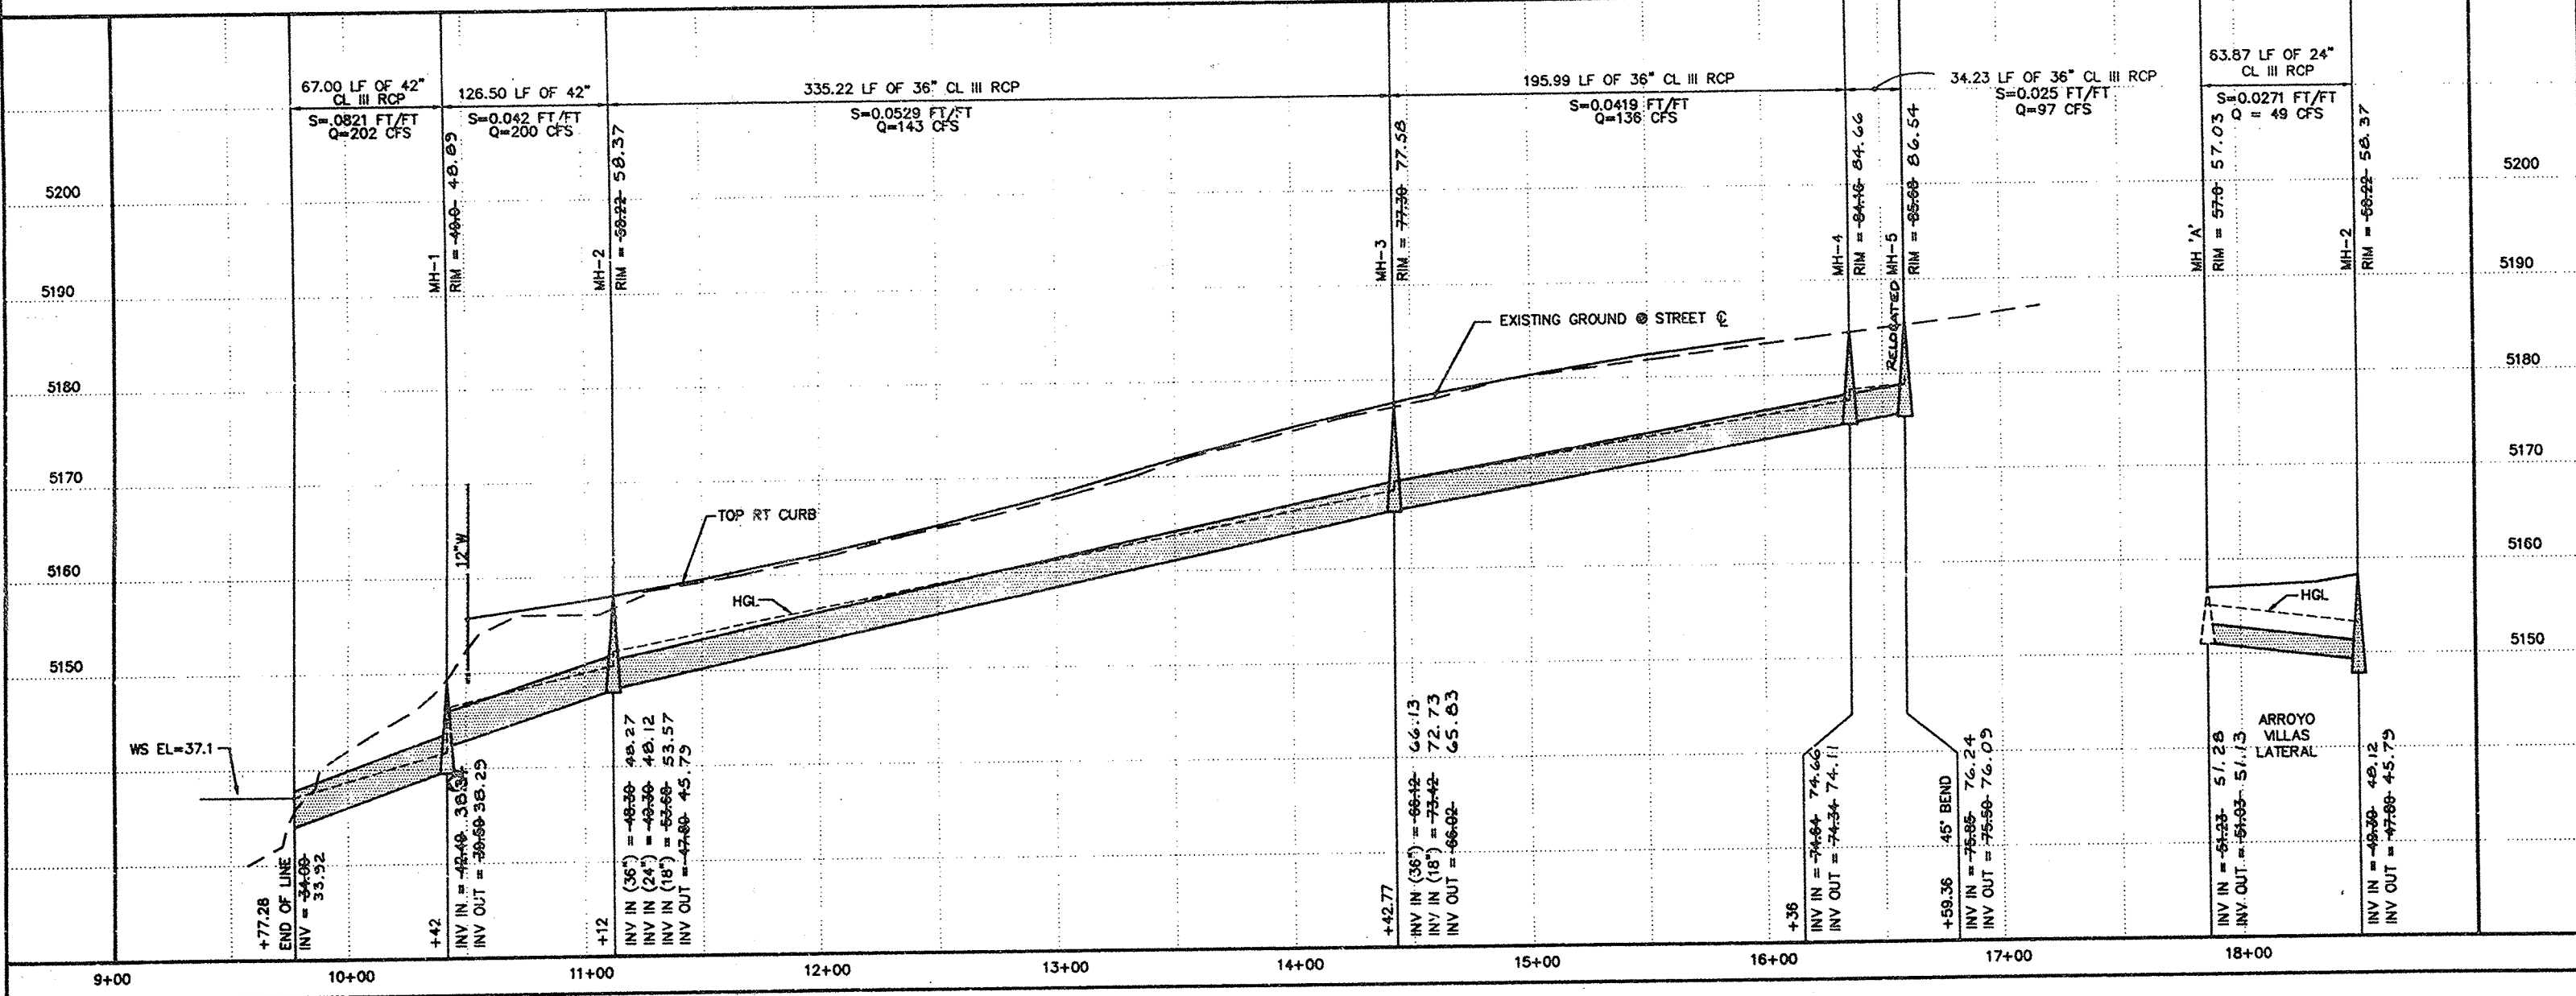

AS-BUILT INFORMATION

DATE: 1/1/93

BY: [Signature]

REVISIONS

NO.	DATE	REVISIONS
1	1/1/93	DESIGN

ENGINEER'S SEAL

ISAACSON & ARFMAN, P.A.
Consulting Engineering Associates
180 Monroe Street N.E.
Albuquerque, New Mexico 87102

CITY OF ALBUQUERQUE
PUBLIC WORKS DEPARTMENT
ENGINEERING GROUP

TITLE: ARROYO VILLAS APARTMENTS
GOLF COURSE RD. STORM DRAIN

APPROVALS	ENGINEER	DATE	APPROVALS	ENGINEER	DATE
DRC CHAIRMAN	[Signature]	1/1/93	WATER	MIA RUIZ	1/1/93
TRANSPORTATION	[Signature]	1/1/93	WASTE WATER	MIA RUIZ	1/1/93
HYDROLOGY	[Signature]	1/1/93			


PROJECT NO. 5022.90

MAP NO. B-12

SHEET 11 OF 20

RECEIVED
JAN 16 2003
HYDROLOGY SECTION

CITY OF ALBUQUERQUE

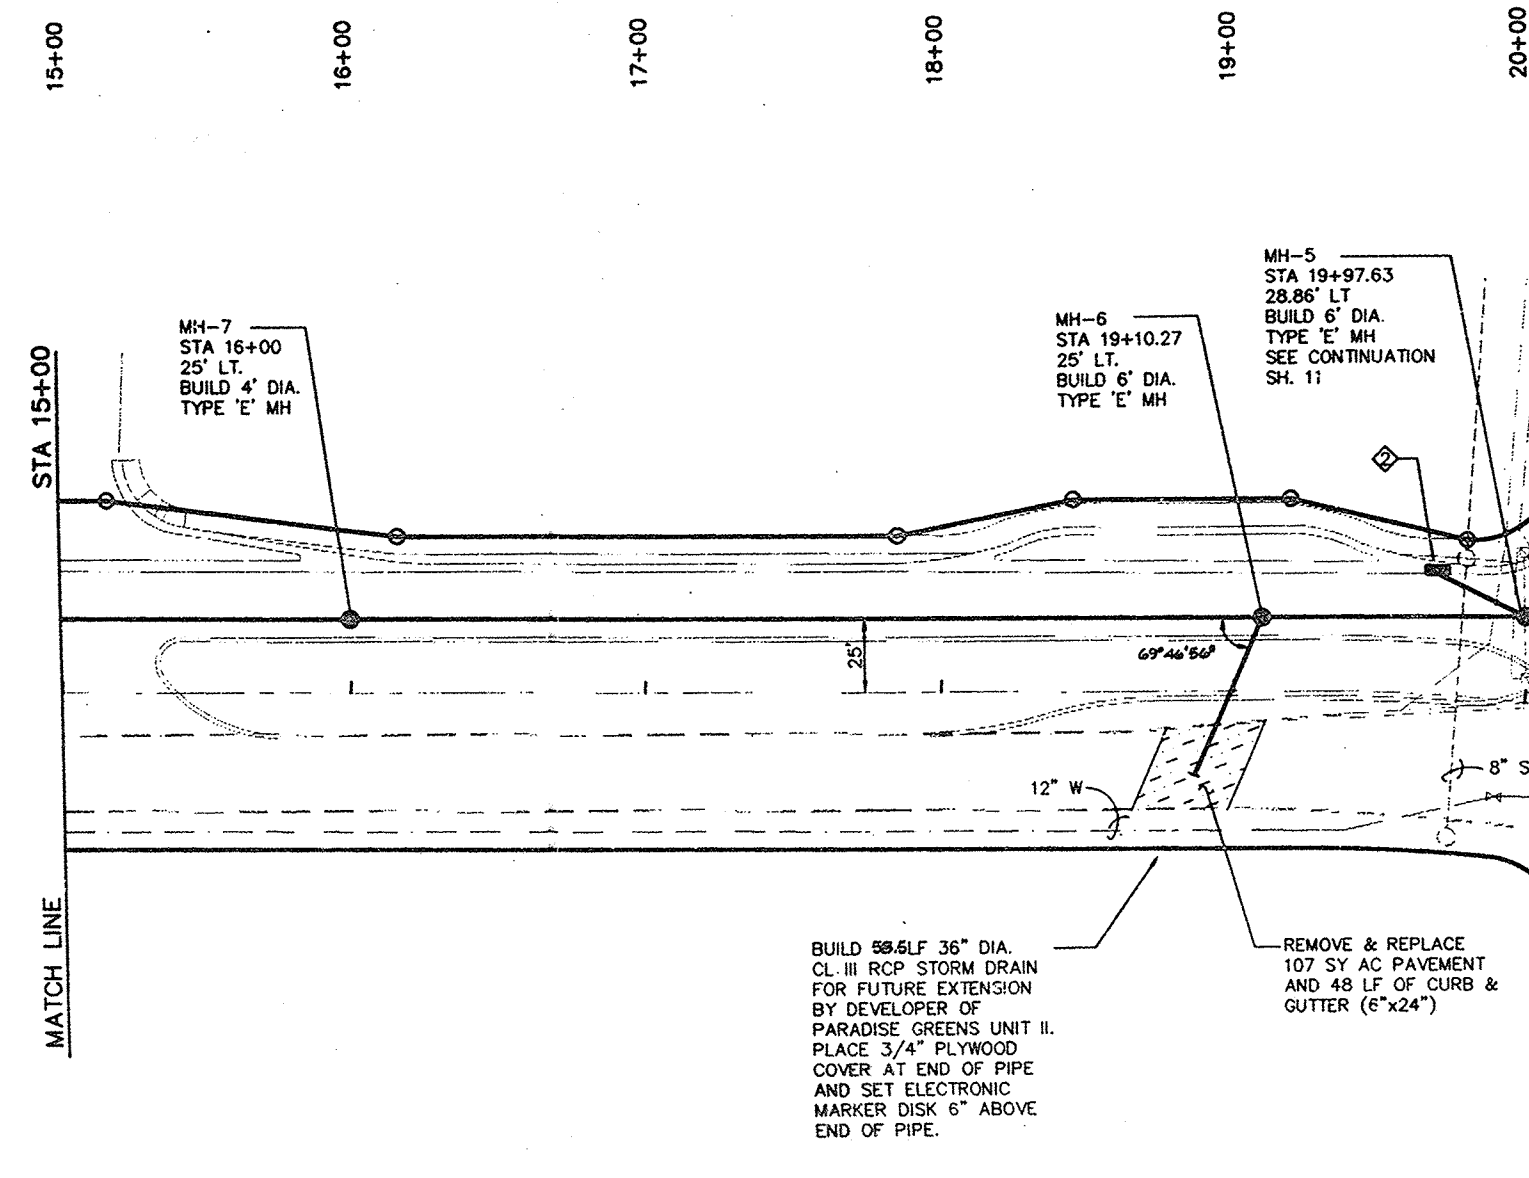


IRVING BLVD. STORM DRAIN

STORM DRAIN INLET INFORMATION						
INLET NO.	STATION	INLET TYPE	TOP CURB ELEVATION	TOP GRATE ELEVATION	INVERT IN	INVERT OUT
2	19+70	'A'	-86.56	-85.66	---	-86.66
			86.45	85.56	82.46	

CONNECTOR PIPE INFORMATION			
FROM INLET NO.	DIA (IN)	LENGTH (FT)	SLOPE (FT/FT)
2	18	30	0.020

SCALES:
1"=40' HOR.
1"=10' VERT.

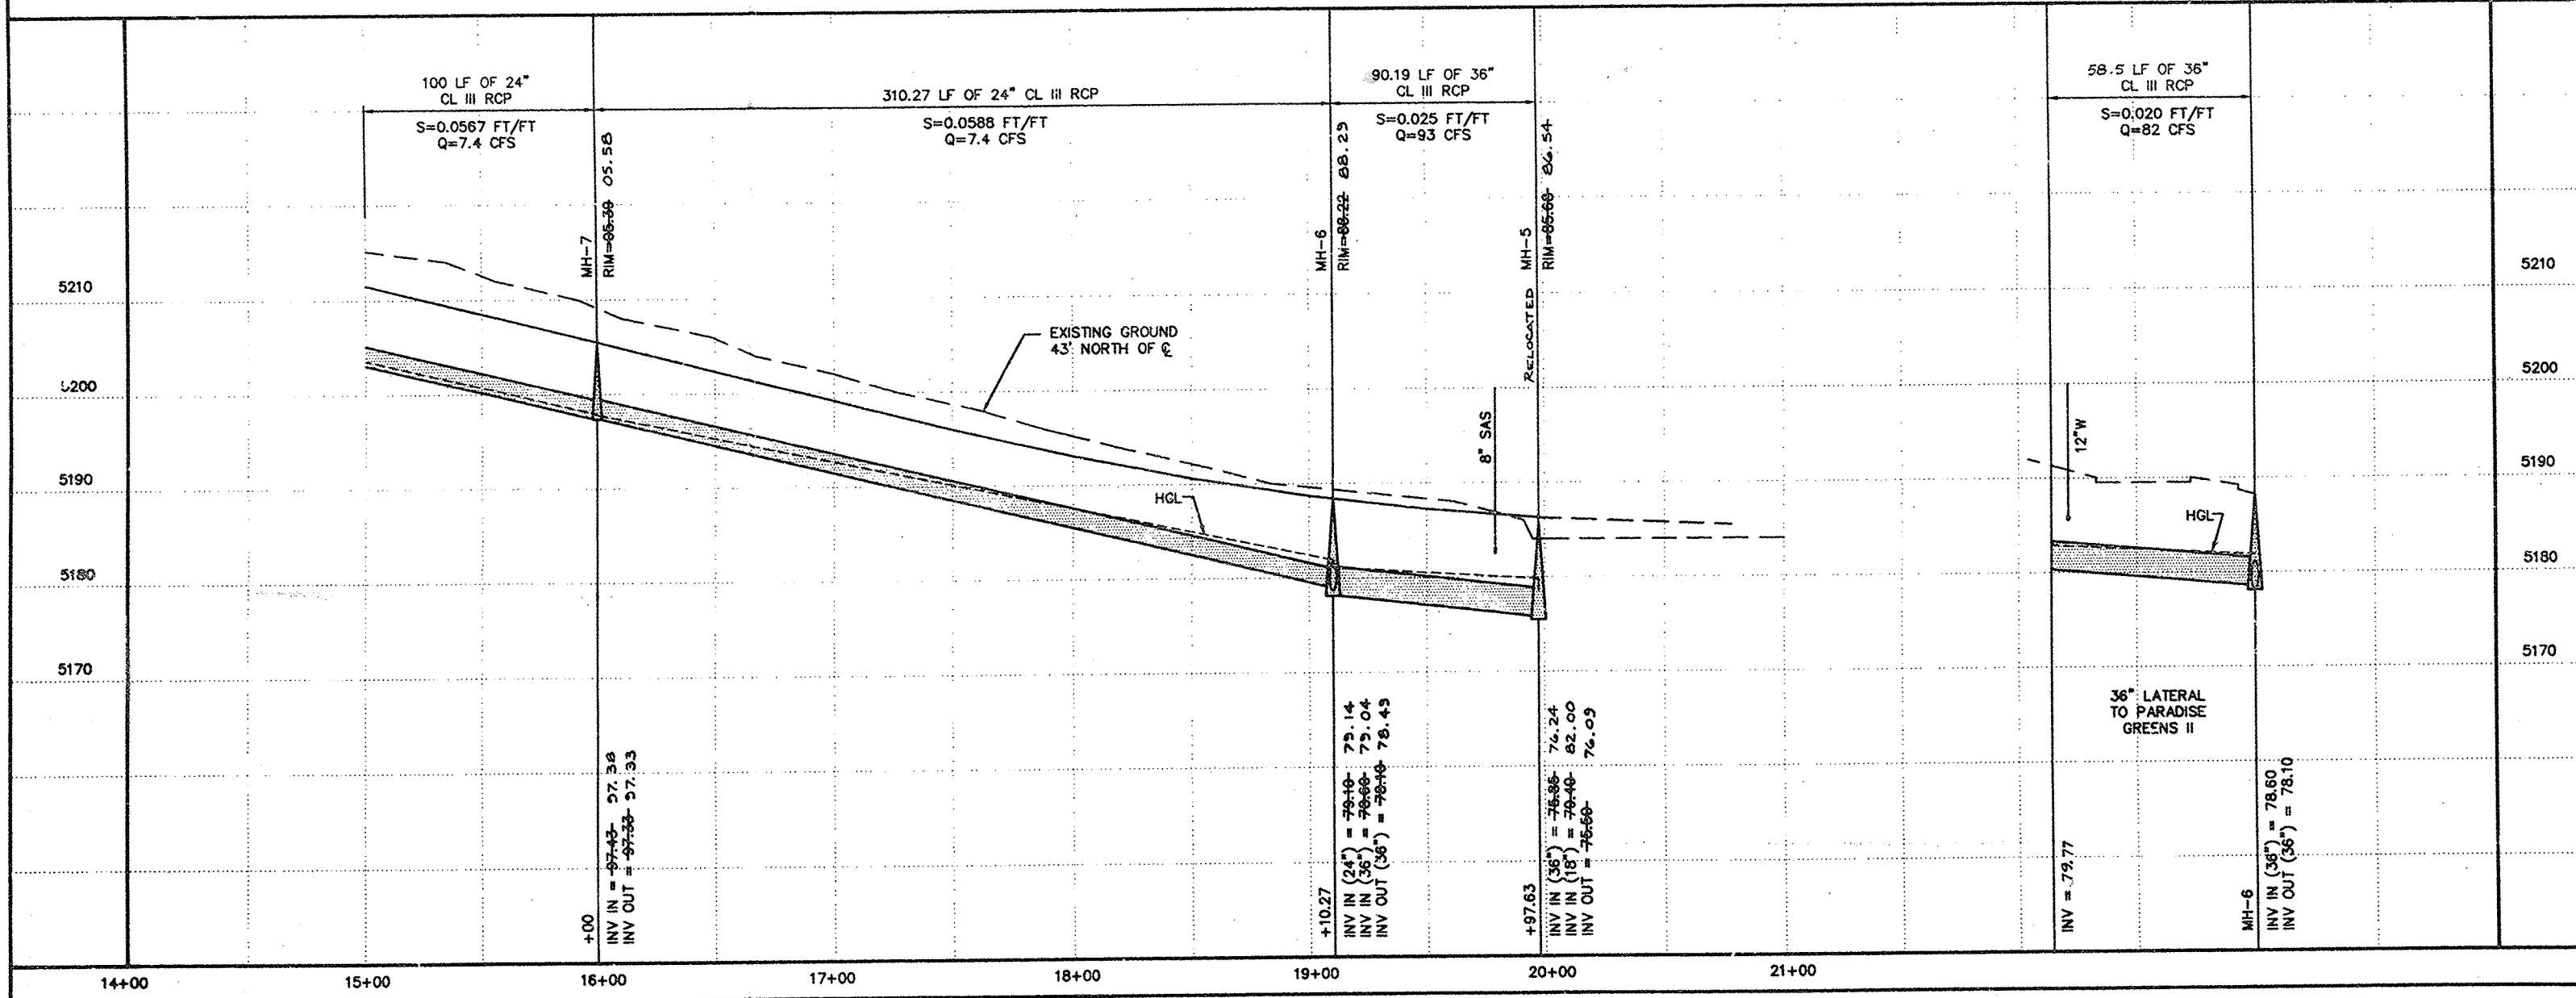

1 2 3 4 5 6 7 8 9 10 11 12 13 14 15
20-5022-10 1/10/95



ISACSON & ARFMAN, P.A.
Consulting Engineering Associates
188 Monroe Street, S.E.
Albuquerque, New Mexico 87102
760/840-0000 FAX 760/840-0001

CITY OF ALBUQUERQUE PUBLIC WORKS DEPARTMENT ENGINEERING GROUP					
TITLE: ARROYO VILLAS APARTMENTS IRVING BLVD. STORM DRAIN					
APPROVALS	ENGINEER	DATE	APPROVALS	ENGINEER	DATE
DRG CHAIRMAN	1/15/95	1/15/95	WATER	VIA RWE	10-18-95
TRANSPORTATION	1/15/95	1/15/95	WASTE WATER	VIA RWE	10-18-95
HYDROLOGY	1/15/95	1/15/95			
PROJECT NO.	502290	MAP NO.	B-12	SHEET	10 OF 20

AS-BUILT INFORMATION	CONTRACT NO.	DATE	BY	DATE
IRVING BLVD. STORM DRAIN	502290	1/15/95	1/15/95	1/15/95
DESIGNED BY	DATE	BY	DATE	BY
1/15/95	1/15/95	1/15/95	1/15/95	1/15/95
CHECKED BY	DATE	BY	DATE	BY
1/15/95	1/15/95	1/15/95	1/15/95	1/15/95
REVISIONS	NO.	DATE	REVISIONS	NO.
1	1/15/95	1/15/95	1	1/15/95
2	1/15/95	1/15/95	2	1/15/95
3	1/15/95	1/15/95	3	1/15/95
4	1/15/95	1/15/95	4	1/15/95
5	1/15/95	1/15/95	5	1/15/95
6	1/15/95	1/15/95	6	1/15/95
7	1/15/95	1/15/95	7	1/15/95
8	1/15/95	1/15/95	8	1/15/95
9	1/15/95	1/15/95	9	1/15/95
10	1/15/95	1/15/95	10	1/15/95
11	1/15/95	1/15/95	11	1/15/95
12	1/15/95	1/15/95	12	1/15/95
13	1/15/95	1/15/95	13	1/15/95
14	1/15/95	1/15/95	14	1/15/95
15	1/15/95	1/15/95	15	1/15/95

RECEIVED
JAN 16 2003
HYDROLOGY SECTION

CITY OF ALBUQUERQUE

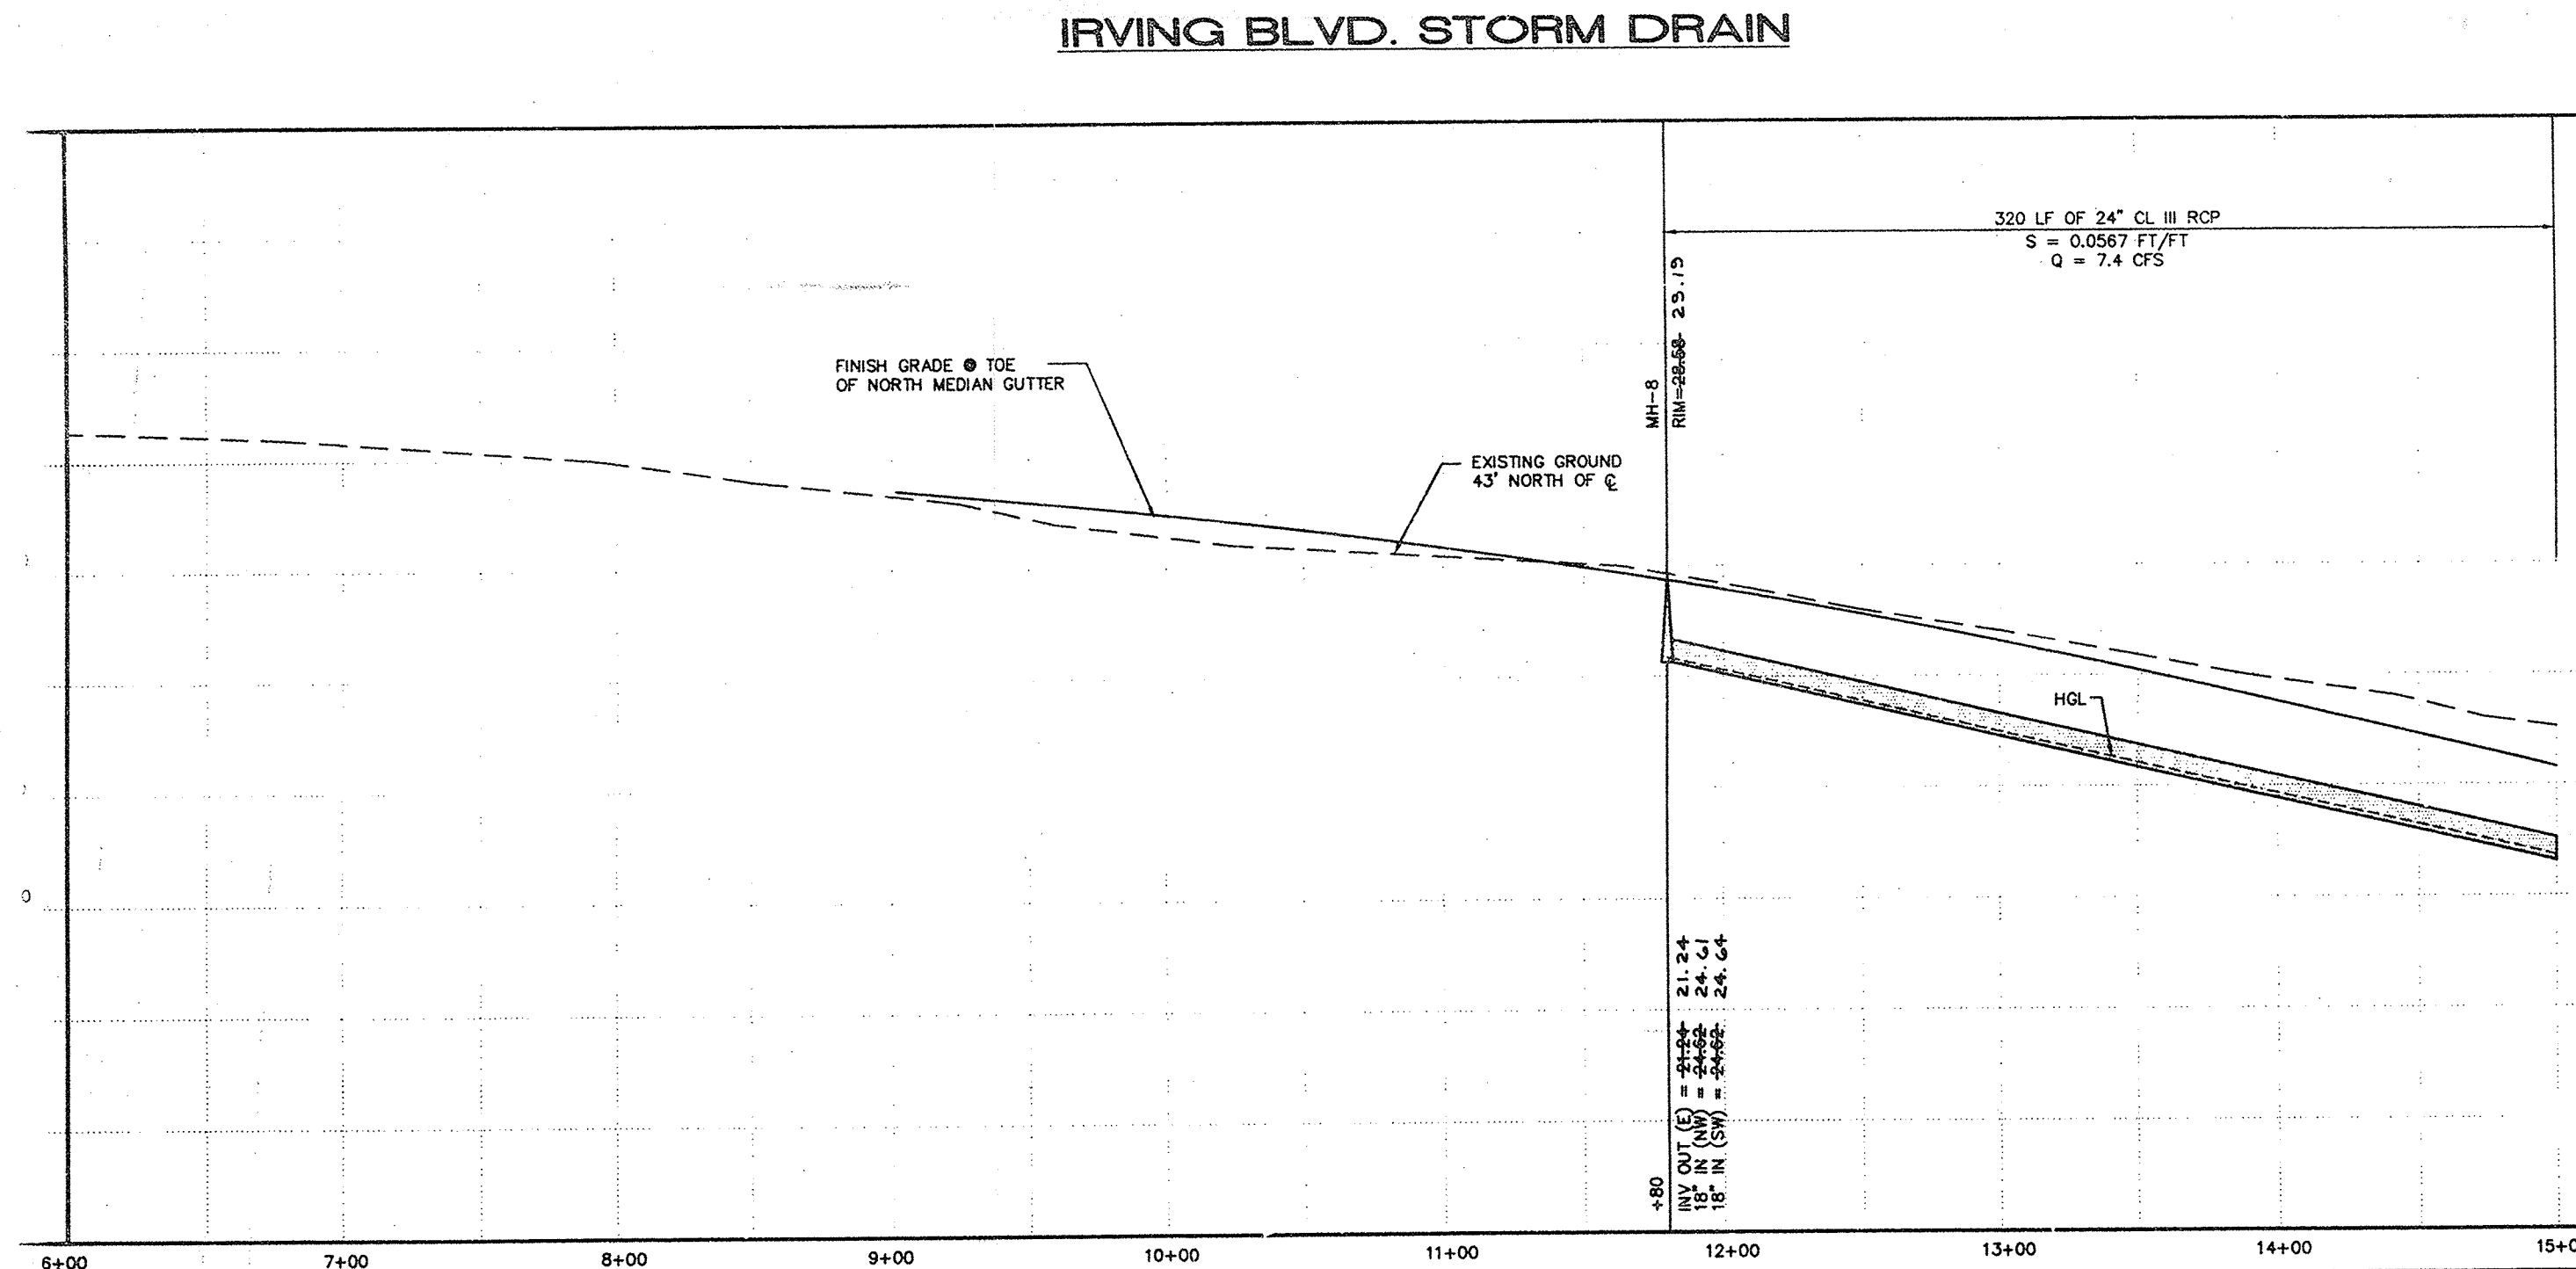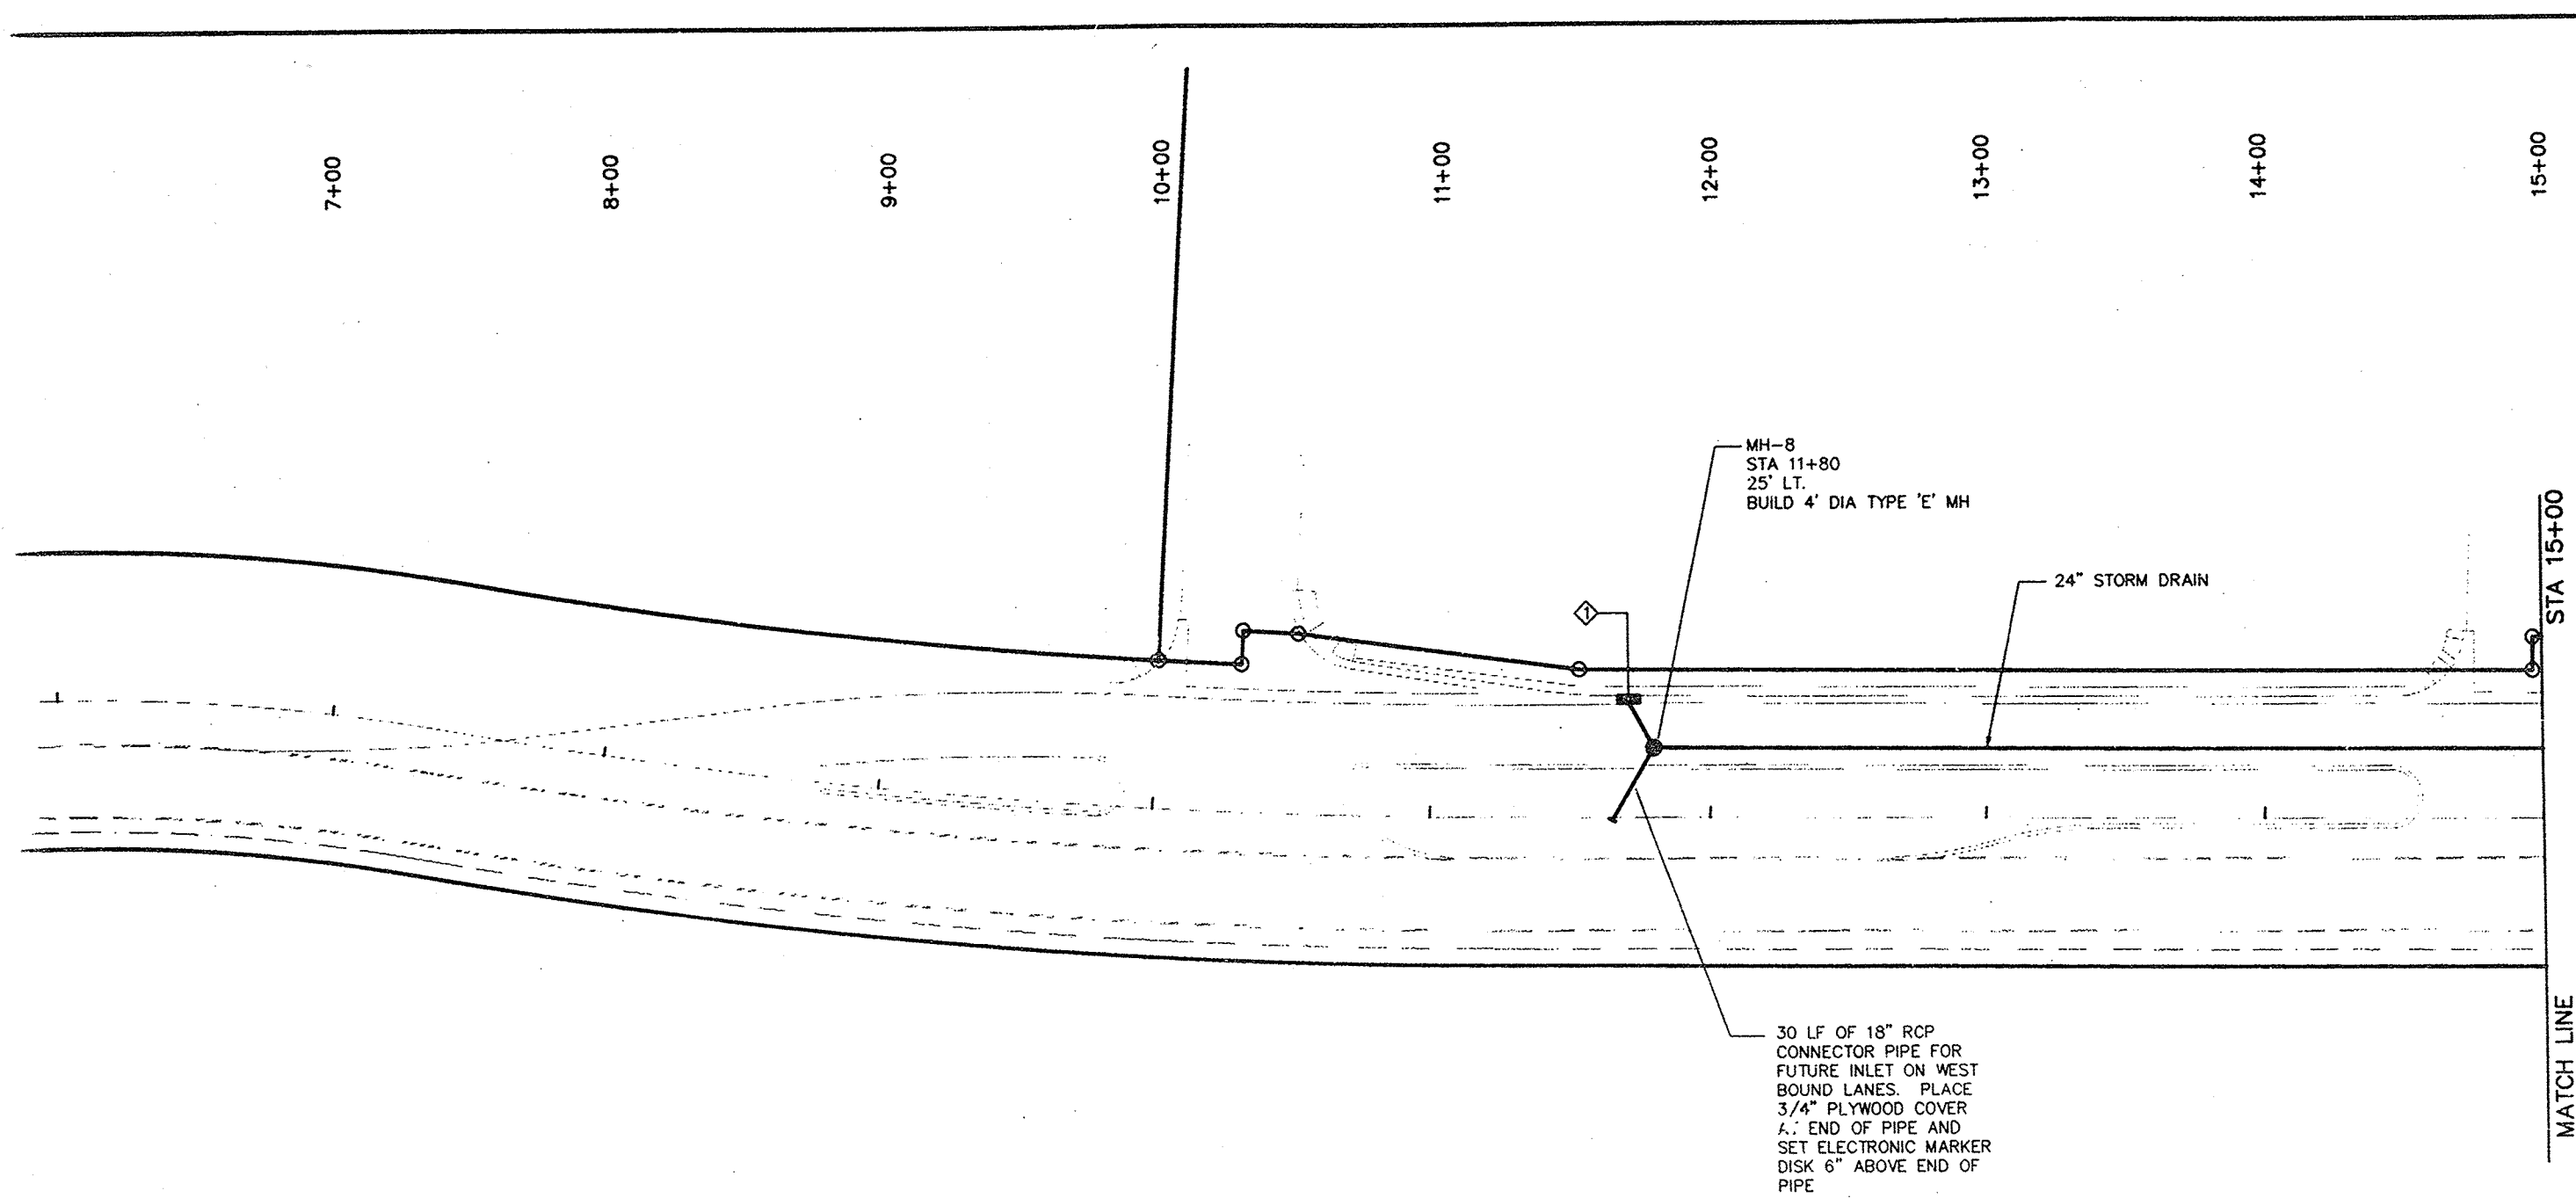

STORM DRAIN INLET INFORMATION						
INLET NO.	STATION	INLET TYPE	TOP CURB ELEVATION	TOP GRATE ELEVATION	INVERT IN	INVERT OUT
1	11+71	'A'	-29+77	-29+27	---	-25+16
			25.80	25.88	25.51	

CONNECTOR PIPE INFORMATION			
FROM INLET NO.	DIA (IN)	LENGTH (FT)	SLOPE (FT/FT)
1	18	18	0.030
*	18	30	0.030

*MH-7

SCALES:
1"=40' HOR.
1"=10' VERT.

GENERAL NOTES
1. ALL BEDDING SHALL BE CLASS C.

1	2	3	4	5	6	7	8	9	10	11	12	13	14	15	16
26	19	22	22	19	0	0	0	0	0	0	0	0	0	0	0

ISAACSON & ARFMAN, P.A.
Consulting Engineering Associates
120 Monroe Street N.E.
Albuquerque, New Mexico
770-714-0200 FAX 770-714-0201

CITY OF ALBUQUERQUE
PUBLIC WORKS DEPARTMENT
ENGINEERING GROUP

TITLE: ARROYO VILLAS APARTMENTS
IRVING BLVD. STORM DRAIN

APPROVALS	ENGINEER	DATE	APPROVALS	ENGINEER	DATE
DRC CHAIRMAN	<i>[Signature]</i>	11-14-94	WATER	MA RWE	10-18-94
TRANSPORTATION	<i>[Signature]</i>	12-22-94	WASTE WATER	MA RWE	10-18-94
HYDROLOGY	<i>[Signature]</i>	12-22-94			

PROJECT NO. 5022.90 MAP NO. B-12 SHEET 9 OF 20

AS-BUILT INFORMATION		SURVEY INFORMATION		ENGINEER'S SEAL	
CONTRACTOR	ITC, N.M.	NO.			
DRAWN BY	Submittal	DATE			
CHECKED BY	MA RWE	DATE		REVISIONS	
APPROVED BY	MA RWE	DATE			
DESIGNED BY	Submittal	DATE		NO.	DATE
RECORDED BY	Submittal	DATE		DESIGNED BY	TO
				DRAWN BY	TO
				CHECKED BY	TO

RECEIVED
JAN 16 2003
HYDROLOGY SECTION