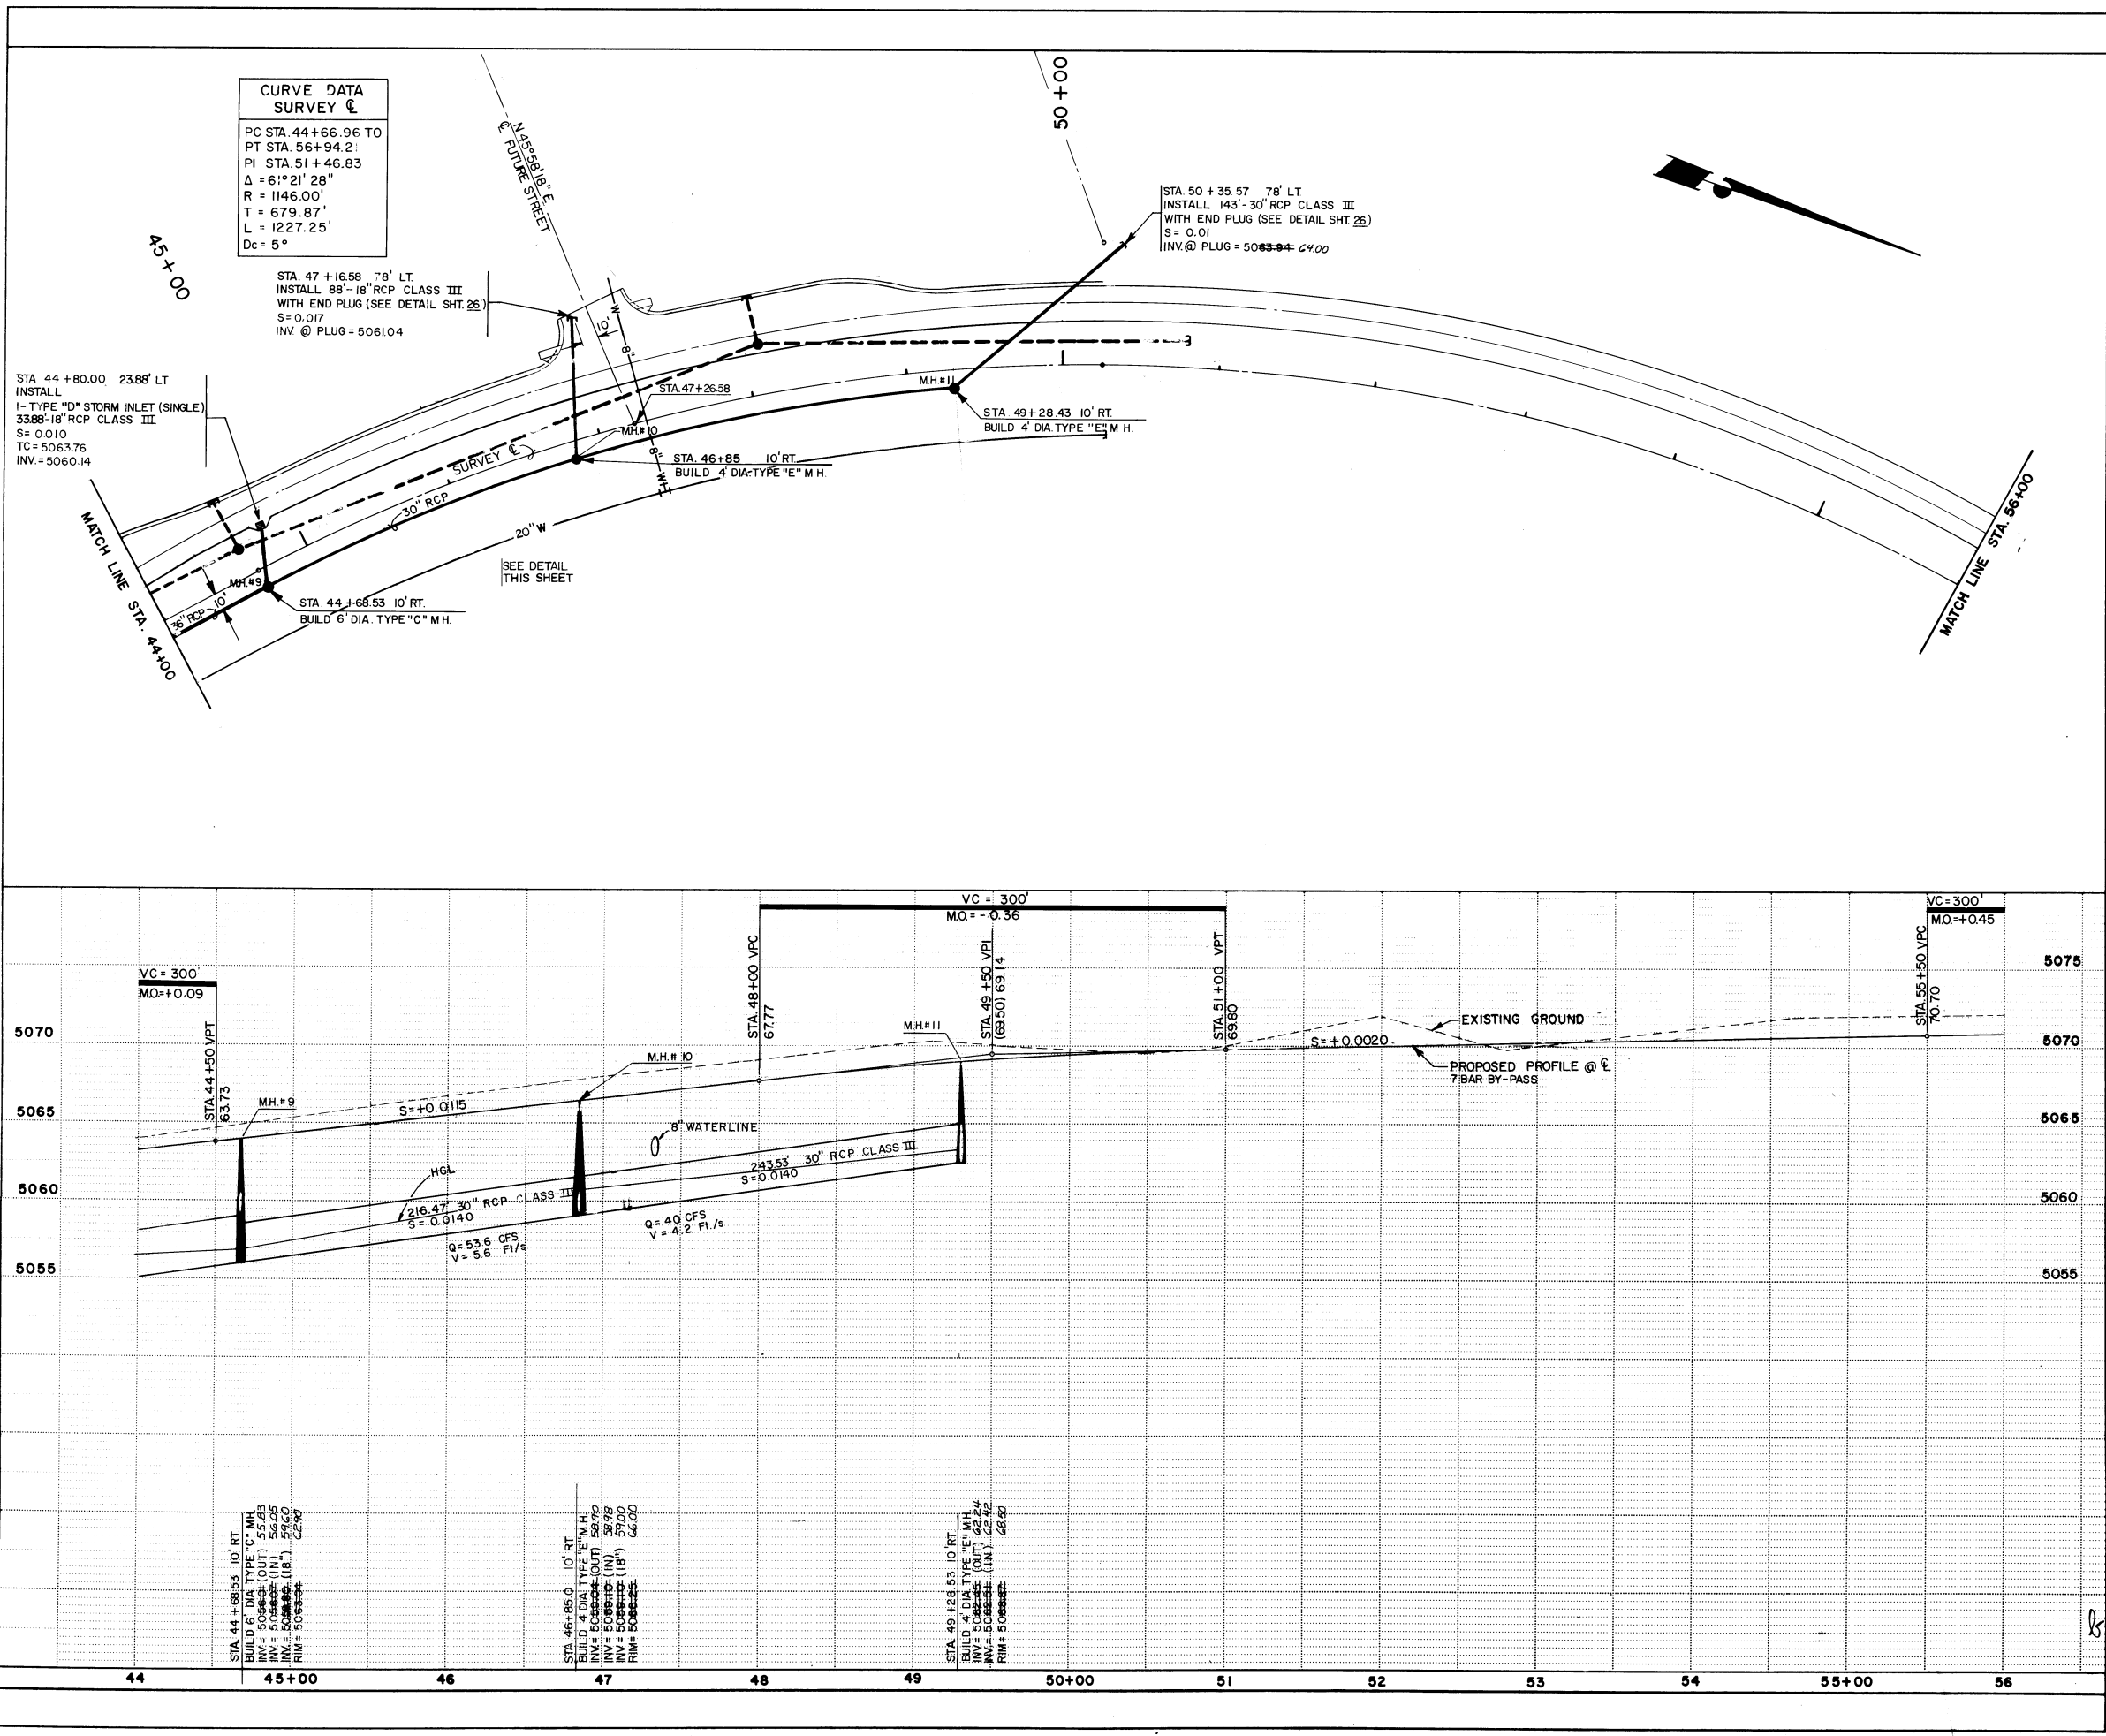


AS BUILT INFORMATION			BENCH MARKS			SURVEY INFORMATION			ENGINEER'S SEAL					
CONTRACTOR	DATE	NO.	ACS STATION	DATE	NO.		REMARKS	BY	DESIGNED BY	DATE	DRAWN BY	DATE	CHECKED BY	
INSPECTOR	DATE	NO.	FIELD NOTES	DATE	NO.									
ACCEPTANCE BY	DATE	NO.	DATE	DATE	DATE									
DATE	DATE	DATE	DATE	DATE	DATE									
TITLE: 7-BAR BY-PASS ROAD STORM DRAIN STA. 44+00 TO 56+00														
APPROVALS			ENGINEER			APPROVALS			ENGINEER			DATE		
City Engineer			[Signature]			City Engineer			[Signature]			2-1-87		
A.C.E. - Design			[Signature]			Traffic			[Signature]			2-1-87		
A.C.E. - Hydrology			[Signature]			Water			[Signature]			2-1-87		
DRAWING NO.			3040			MAP NO.			B-13			SHEET 27 OF 49		

BRUNING 44.132 62236

50
52