

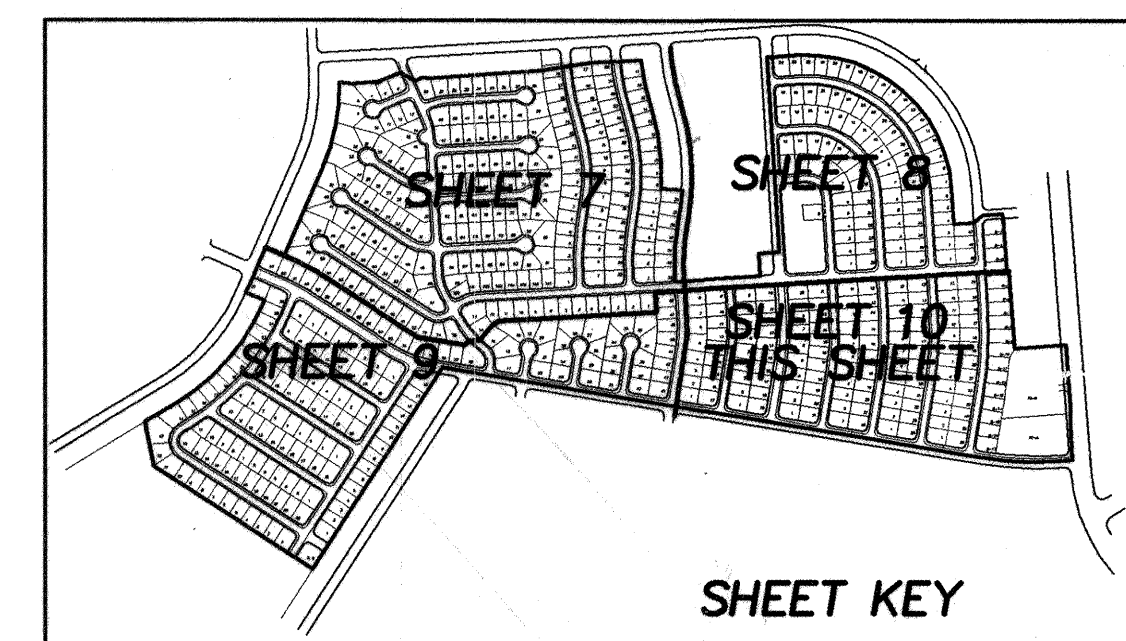


98012.M SHEETS\M812C03.DWG\12-27-99.VLB

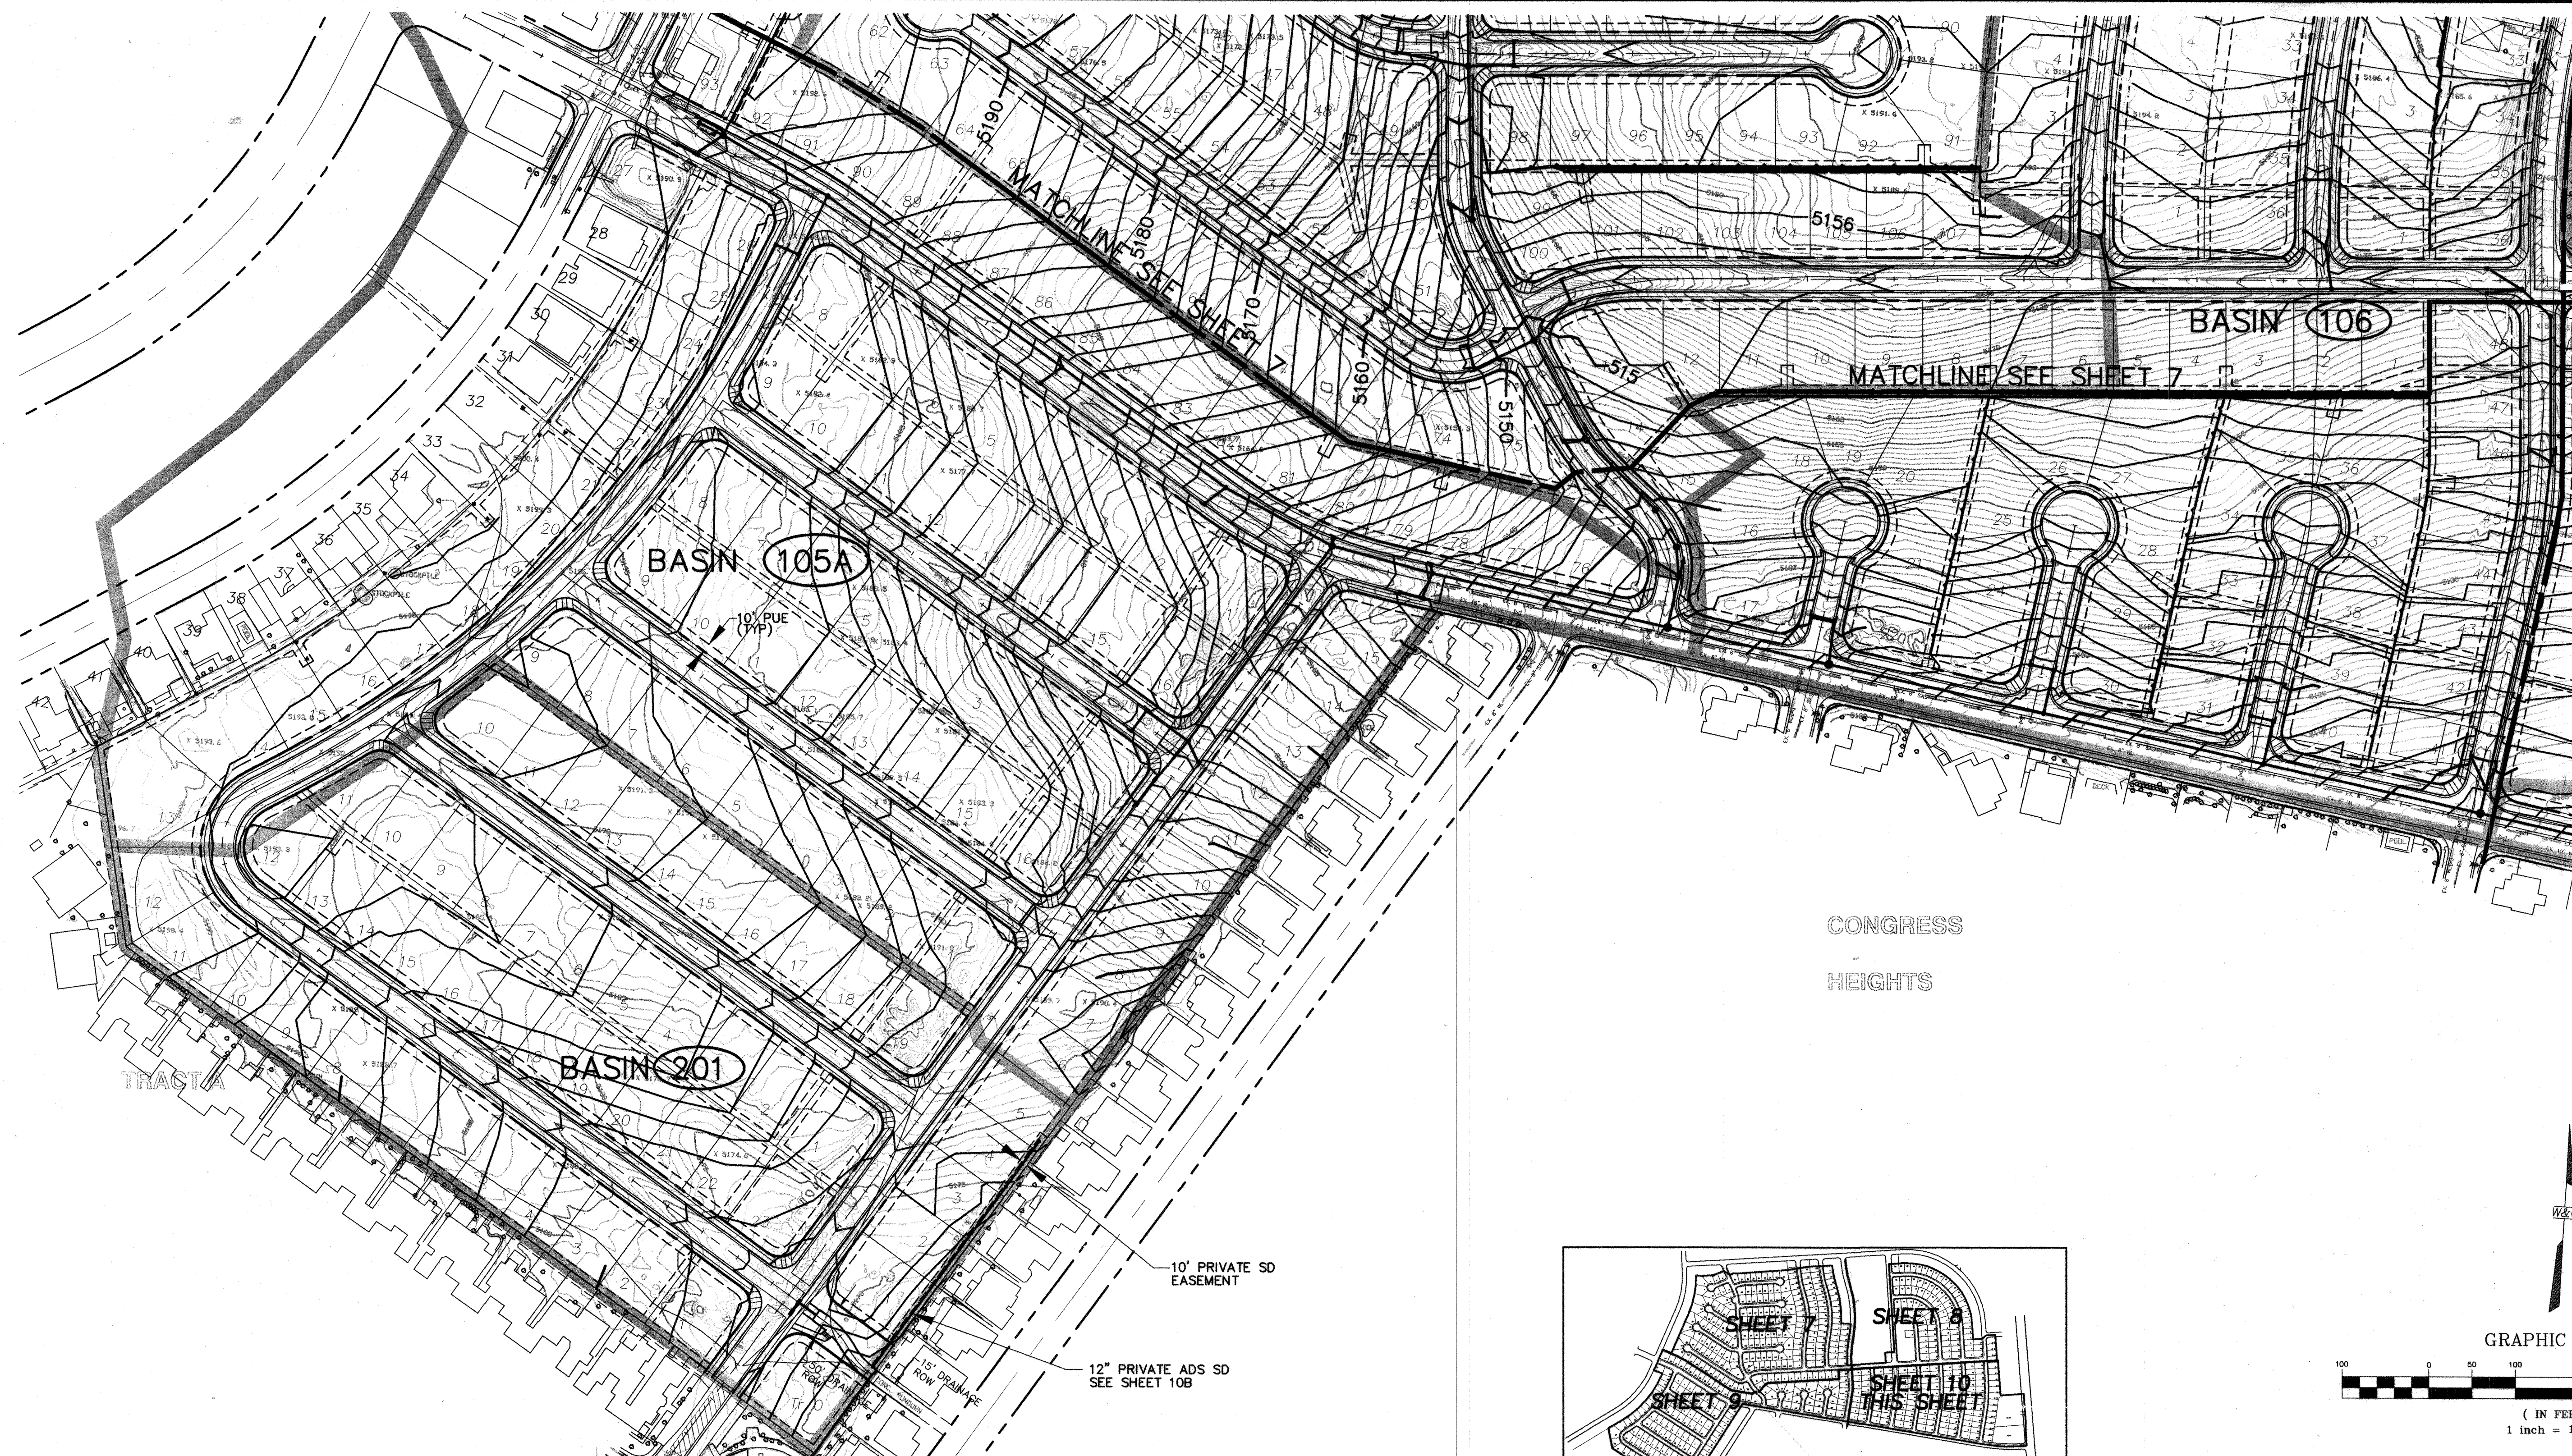

#### LEGEND

- 5070 EXISTING INTERMEDIATE CONTOUR
- 5071 EXISTING INDEX CONTOUR
- 5175 PROPOSED INTERMEDIATE CONTOUR
- 5173 PROPOSED INDEX CONTOUR
- + 5359.15 EXISTING SPOT ELEVATION
- 15.1 PROPOSED SPOT ELEVATION
- BASIN (101) BASIN DESIGNATION
- PROPOSED BASIN BOUNDARY

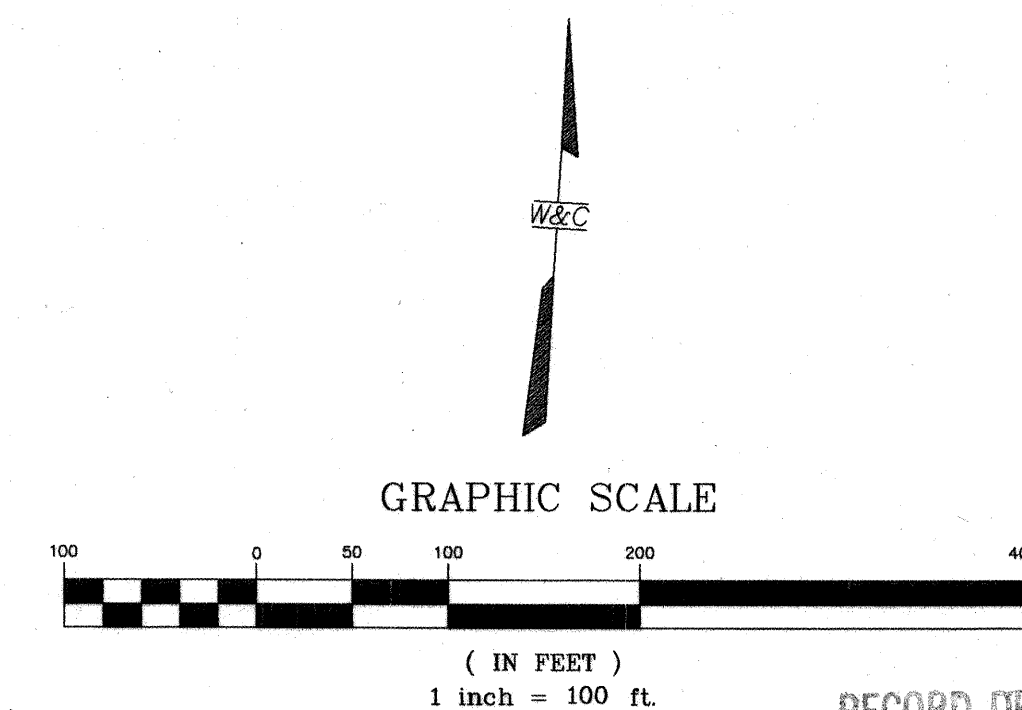

RECORD DRAWING  
DATE 8-14-02

| BASIN | STREET                             | PROPOSED INLETS                           | BASIN              | STREET                   | PROPOSED INLETS               |
|-------|------------------------------------|-------------------------------------------|--------------------|--------------------------|-------------------------------|
| 105A  | BOLDER ST.                         | 2 TYPE "A"; 1 TYPE "C"                    | 106                | BENTLEY CT.              | 2 TYPE "A"                    |
| "     | DAVENPORT ST.                      | 2 TYPE "A"; 1 TYPE "C"                    | "                  | CARDINAL ST.             | 2 TYPE "A"; 2 TYPE "C"        |
| 201   | DAVENPORT ST.                      | 2 DOUBLE TYPE "C"                         | "                  | BELLEVUE ST.             | 2 TYPE "A"; 2 TYPE "C"        |
| 105   | BUTLER AVE.                        | 2 TYPE "A"                                | "                  | CLEARWATER ST.           | 4 TYPE "A"                    |
| "     | CADDIE ST.                         | 10 TYPE "A"                               | "                  | ARROWHEAD AVE.           | 2 TYPE "C"                    |
| "     | CADDIE ST. 100' S. OF CADDIE/BRYAN | 1 CATTLE GUARD INLET                      | 106B               | STONE ST.                | 2 TYPE "A"                    |
| "     | DERBY CT.                          | 2 TYPE "A"                                | "                  | CHANTILLY RD.            | 4 TYPE "A"                    |
| "     | BAXTER CT.                         | 2 TYPE "A"                                | "                  | BENTON ST.               | 2 TYPE "A"                    |
| "     | CAMDEN CT.                         | 2 TYPE "A"                                | 406                | CAMERON ST.              | 6 TYPE "A"; 2 TYPE "C"        |
| "     | CAPRI CT.                          | 2 TYPE "A"                                | "                  | BUCKEYE ST.              | 2 TYPE "A"; 2 TYPE "C"        |
| "     | ALBANY CT.                         | 2 TYPE "A"                                | "                  | BUCKEYE ST.              | 4 DOUBLE TYPE "C"             |
| "     | ALLEN CT.                          | 2 TYPE "A"                                | 407                | CONGRESS AVE. (LOT 10-B) | 1 DOUBLE TYPE "D"             |
| "     | ALLEGHENY AVE.                     | 2 TYPE "A"                                | 407B               | CONGRESS AVE.            | 1 TYPE "A"; 1 DOUBLE TYPE "C" |
| "     | ARROWHEAD AVE.                     | 2 TYPE "A"                                | "                  | BRYAN AVE.               | 2 TYPE "A"; 2 TYPE "C"        |
| 406   | ARROWHEAD AVE.                     | 1 TYPE "A"                                | "                  | ACADEMY/BRYAN AVE.       | 2 CATTLE GUARD INLETS         |
| 105A  | CONGRESS AVE.                      | 8 TYPE "A"; 1 TYPE "C"; 2 DOUBLE TYPE "C" | UPSTREAM OF SAD226 |                          |                               |
| 106   | CODY CT.                           | 2 TYPE "A"                                |                    |                          |                               |
| "     | BRUCE CT.                          | 2 TYPE "A"                                |                    |                          |                               |

**WILSON & COMPANY**  
4900 LANG AVENUE N.E.  
ALBUQUERQUE, NEW MEXICO 87109  
(505) 348-4000

DATE NOV 1999  
FILE NO. 98012  
DESIGN KIS  
DRAWN JMB

CITY OF ALBUQUERQUE  
PUBLIC WORKS DEPARTMENT  
ENGINEERING GROUP


**SPECIAL ASSESSMENT DISTRICT 226  
GRADING & DRAINAGE PLAN**



DESIGN REVIEW COMMITTEE

CITY ENGINEER

Project No. 5828.91  
Zone No. B-12 & 13  
C-12

Sheet 9-1 Of 126  
5 OF 8

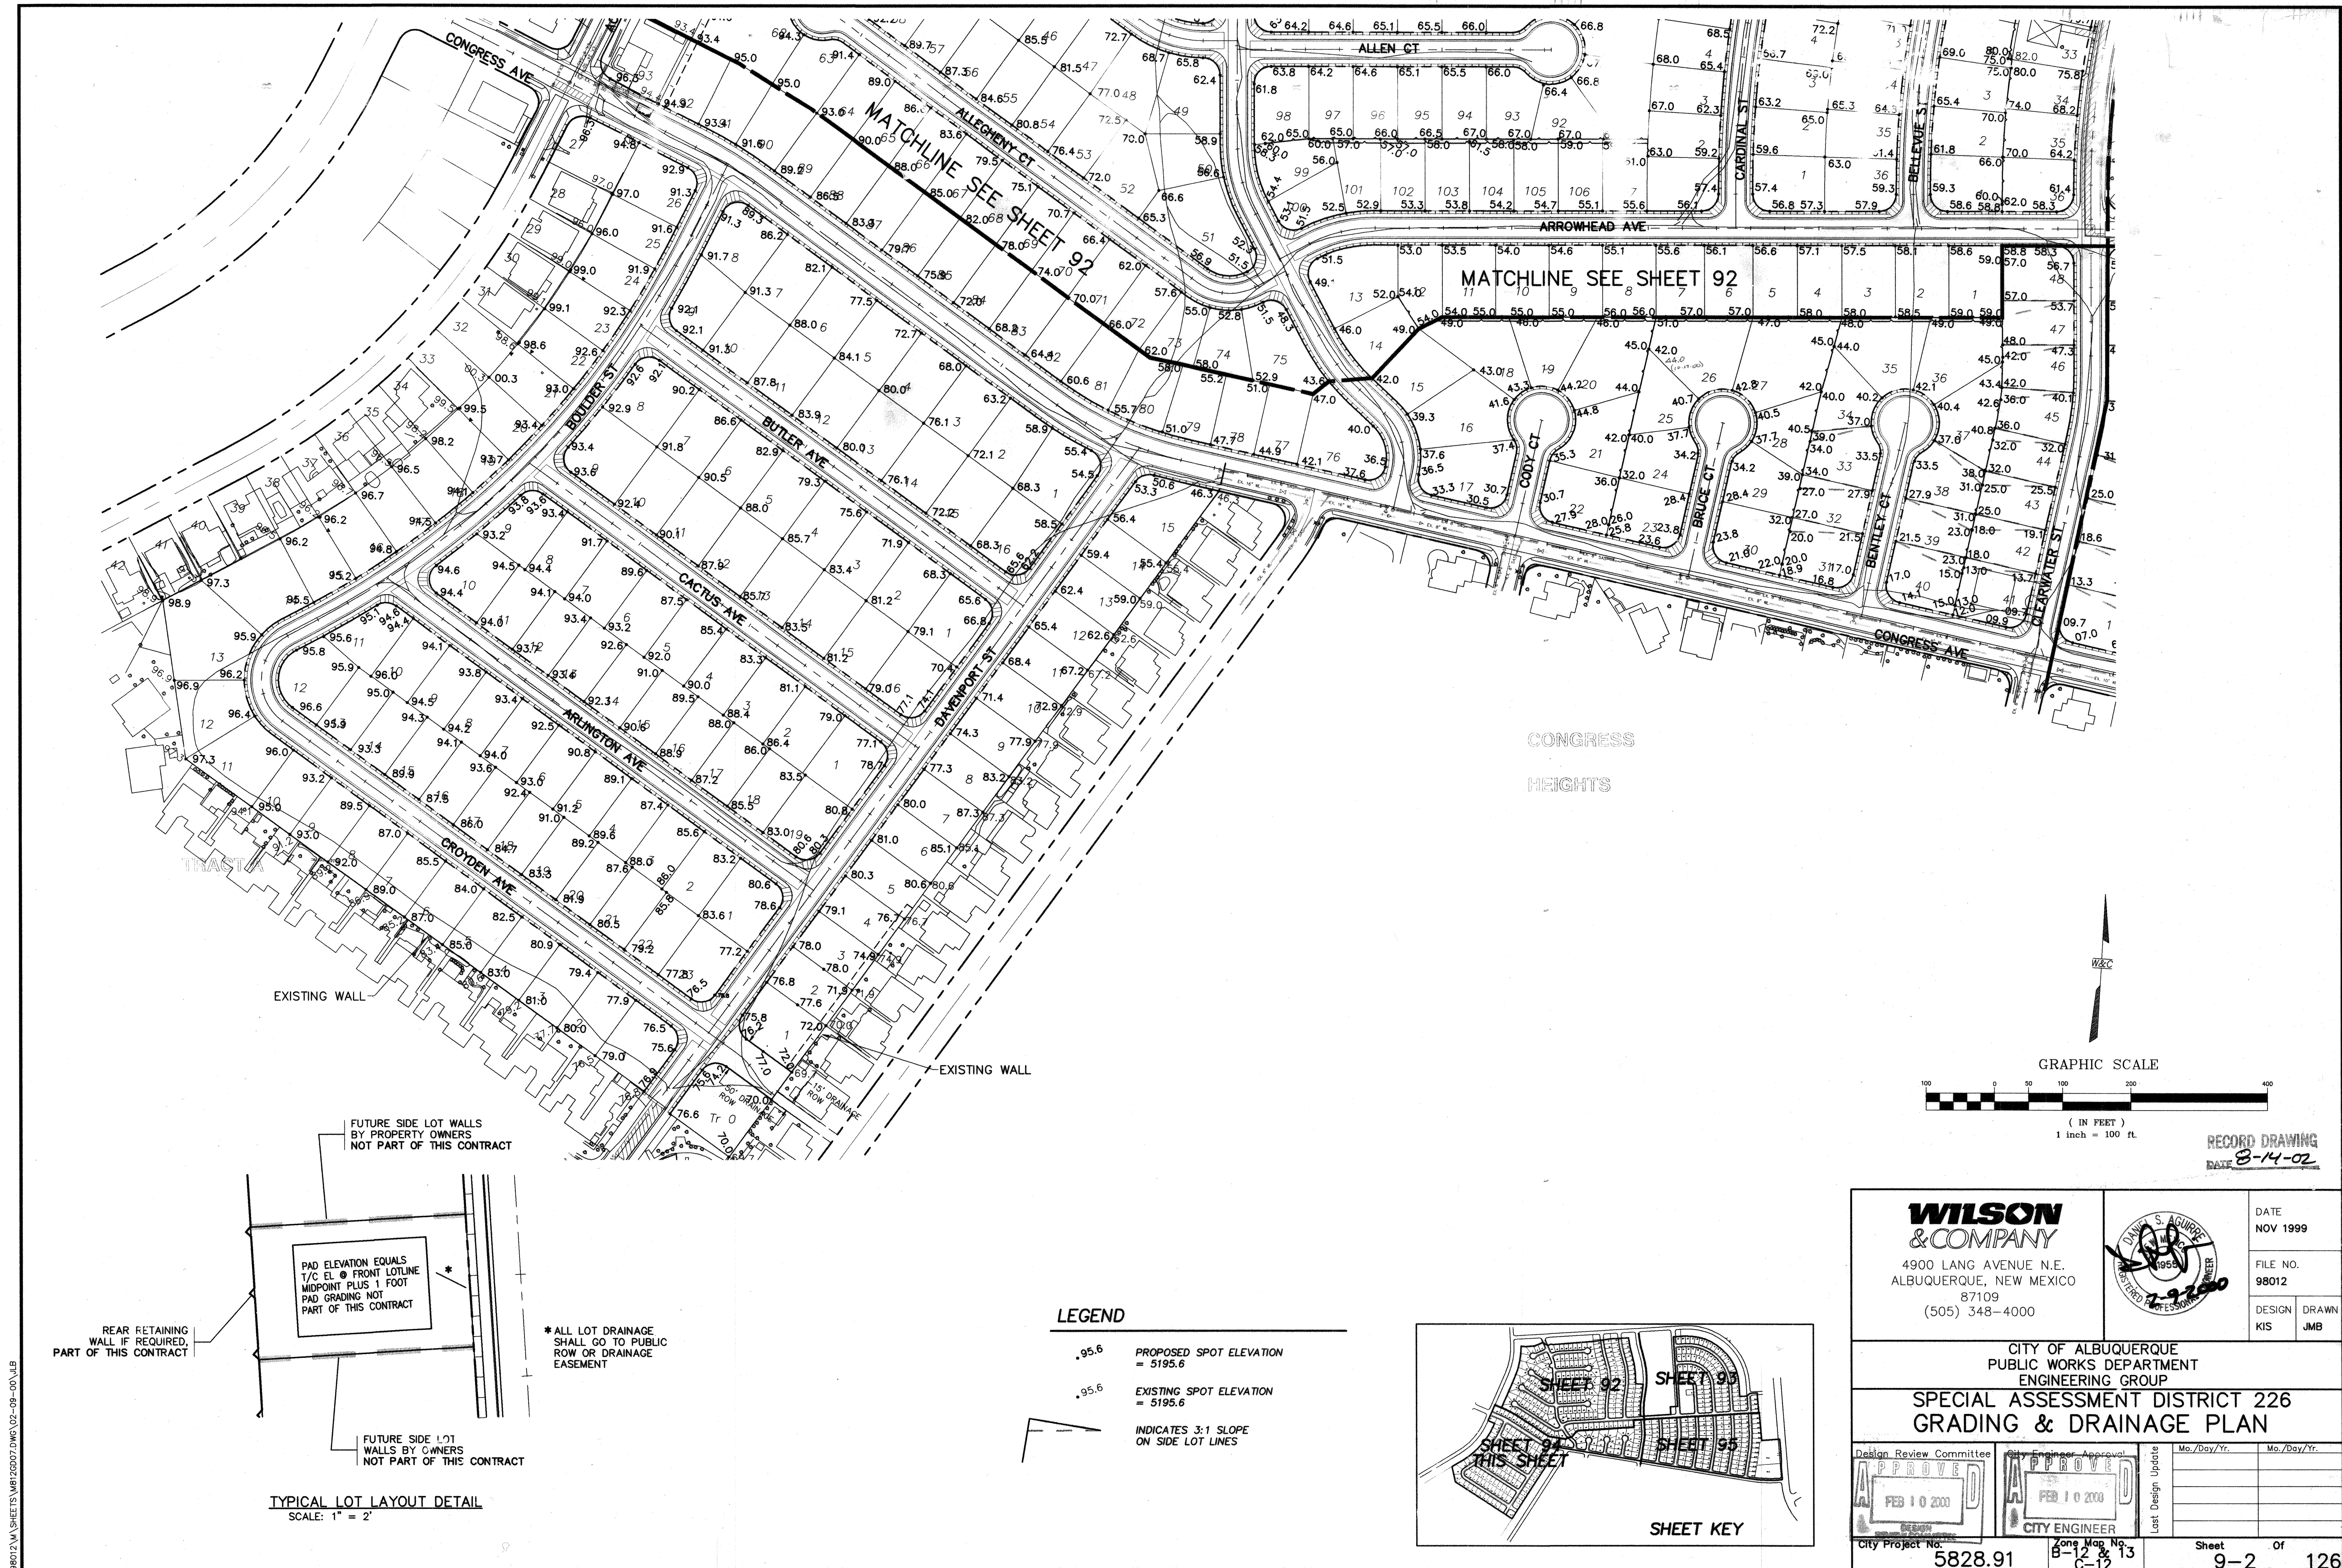

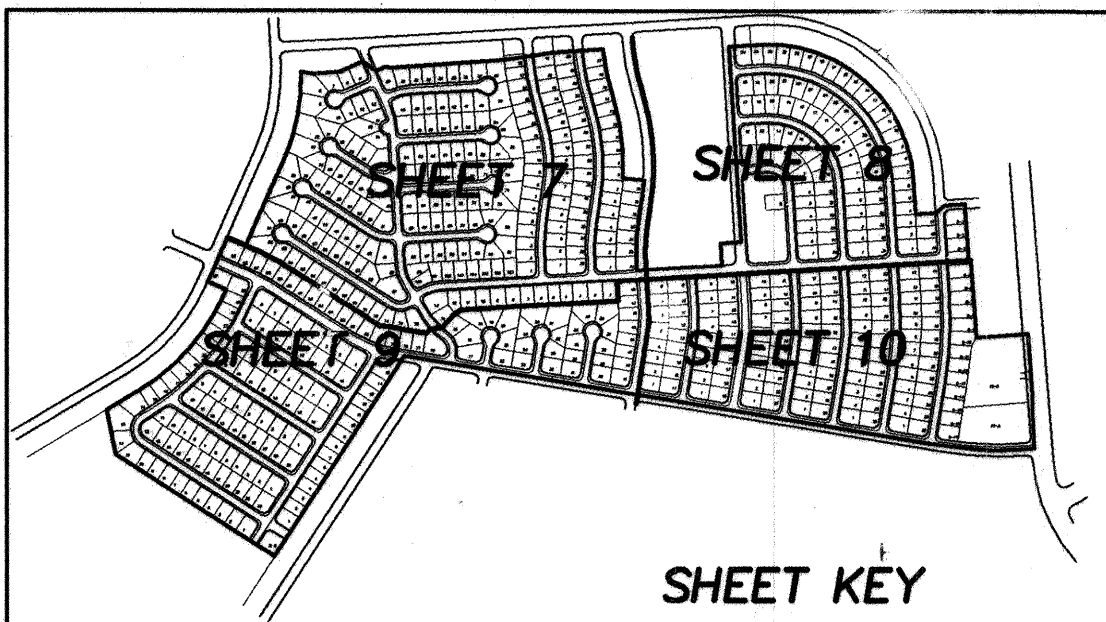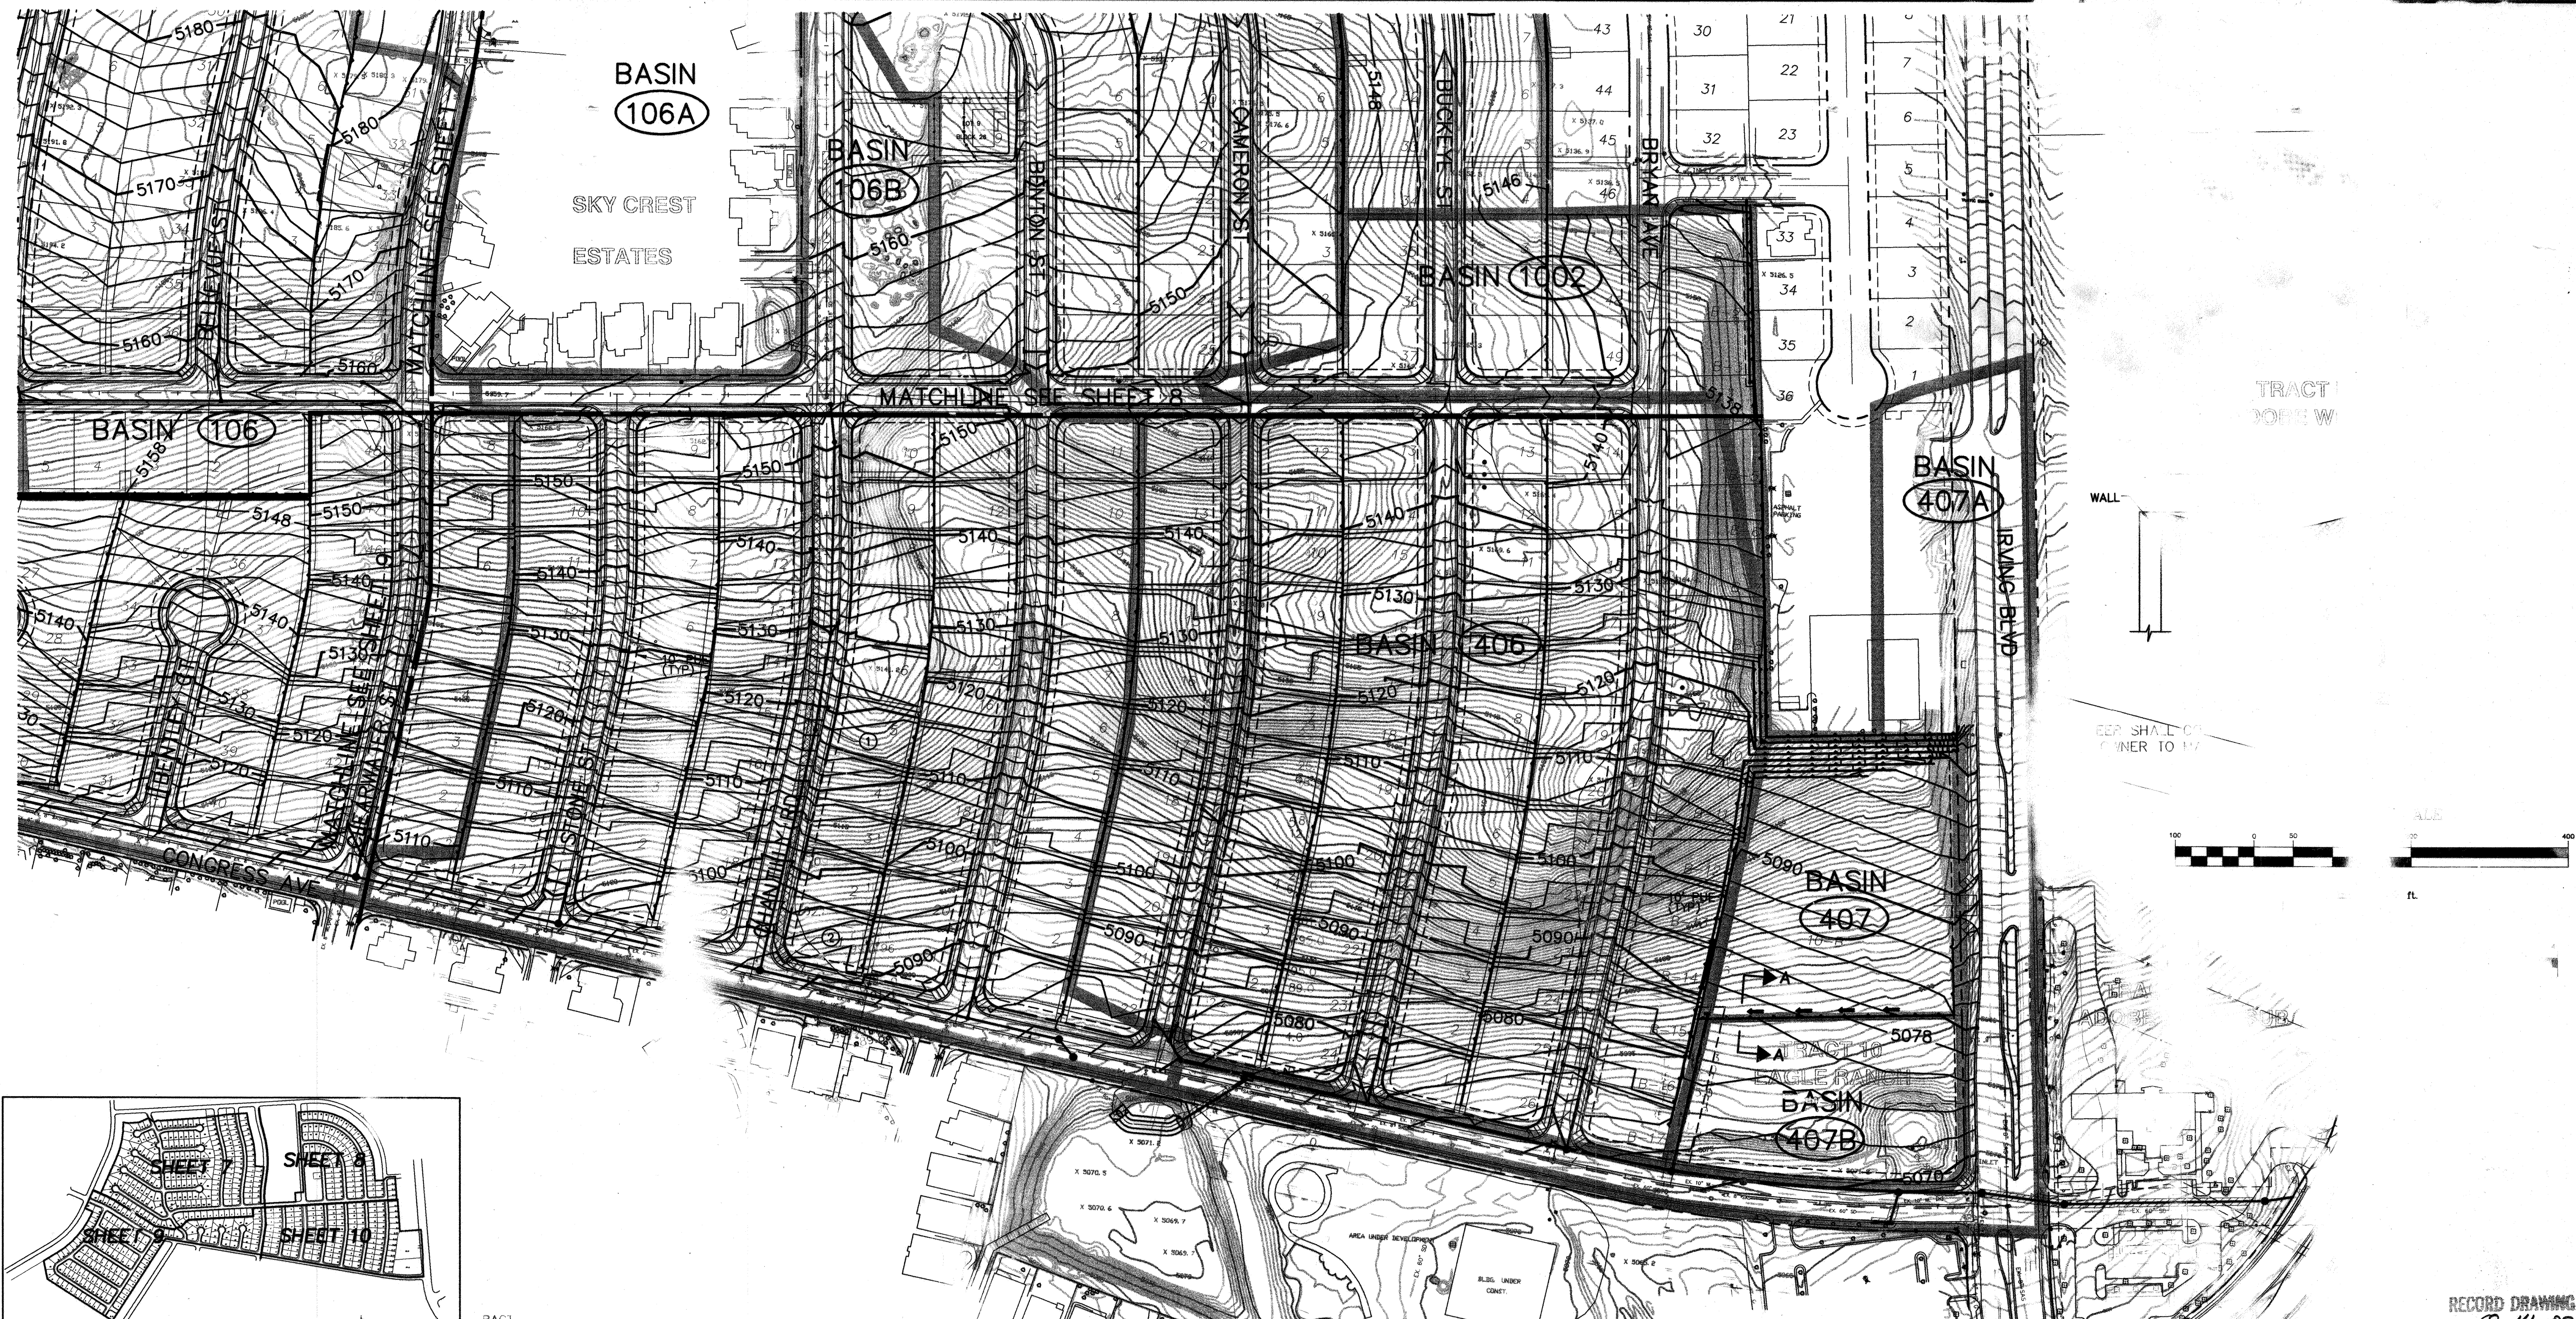

| BASIN | STREET                             | PROPOSED INLETS        | BASIN | STREET         | PROPOSED INLETS        |
|-------|------------------------------------|------------------------|-------|----------------|------------------------|
| 105A  | BOULDER ST.                        | 2 TYPE "A"; 1 TYPE "C" | 106   | BENTLEY CT.    | 2 TYPE "A"             |
| "     | DAVENPORT ST.                      | 2 TYPE "A"; 1 TYPE "C" | "     | CARDINAL ST.   | 2 TYPE "A"; 2 TYPE "C" |
| 201   | DAVENPORT ST.                      | 2 DOUBLE TYPE "C"      | "     | BELLEVUE ST.   | 2 TYPE "A"; 2 TYPE "C" |
| 105   | BUTLER AVE.                        | 2 TYPE "A"             | "     | CLEARWATER ST. | 4 TYPE "A"             |
| "     | CADDIE ST.                         | 10 TYPE "A"            | "     | ARROWHEAD AVE. | 2 TYPE "C"             |
| "     | CADDIE ST. 100' S. OF CADDIE/BRYAN | 1 CATTLE YARD INLET    | 106B  | STONE ST.      | 2 TYPE "A"             |
| "     | DERBY CT.                          | 2 TYPE "A"             | "     | LY RD.         | 4 TYPE "A"             |
| "     | BAXTER CT.                         | 2 TYPE "A"             | "     | ST.            | 2 TYPE "A"             |
| "     | CAMDEN CT.                         | 2 TYPE "A"             | "     | ON ST.         | 6 TYPE "A"; 2 TYPE "C" |
| "     | CAPRI CT.                          | 2 TYPE "A"             | "     | E ST.          | 2 TYPE "A"; 2 TYPE "C" |
| "     | ALBANY CT.                         | 2 TYPE "A"             | "     | E ST.          | 4 DOUBLE TYPE "C"      |
| "     | ALLEN CT.                          | 2 TYPE "A"             | 406   | SS AVE. (-B)   | 1 DOUBLE TYPE "C"      |
| "     | ALLEGHENY AVE.                     | 2 TYPE "A"             | "     | SS AVE.        | 1 TYPE "A"; 1 TYPE "C" |
| "     | ARROWHEAD AVE.                     | 2 TYPE "A"             | 407   | AVE.           | 2 TYPE "A"; 2 TYPE "C" |
| 406   | ARROWHEAD AVE.                     | 1 TYPE "A"             | "     | Y/BRYAN AVE.   | 2 CATTLE GUARD         |
| 105A  | CONGRESS AVE.                      | 8 TYPE "A"; 1 TYPE "C" | 407B  |                |                        |
| 106   | CODY CT.                           | 2 TYPE "A"             |       |                |                        |
| "     | BRUCE CT.                          | 2 TYPE "A"             |       |                |                        |

- NOTES:
- REMOVE & DISPOSE EXISTING ASPHALT RUNDOWN SEE SHEET 66
  - REMOVE & DISPOSE EXISTING CMU WALL AT ASPHALT RUNDOWN SEE SHEET 66

**LEGEND**

- 5070 EXISTING INTERMEDIATE CONTOUR
- 5071 EXISTING INDEX CONTOUR
- 5175 PROPOSED INTERMEDIATE CONTOUR
- 5173 PROPOSED INDEX CONTOUR
- + 5359.15 EXISTING SPOT ELEVATION
- 75.1 PROPOSED SPOT ELEVATION
- BASIN 101 BASIN DESIGNATION
- PROPOSED BASIN BOUNDARY

**WILSON & COMPANY**

4900 LANG AVENUE N.E.  
ALBUQUERQUE, NEW MEXICO 87109  
(505) 348-4000

CITY OF ALBUQUERQUE  
PUBLIC WORKS ENGINEER  
SPECIAL ASSESSMENT  
GRADING & DRAINAGE

APPROVED  
DESIGN REVIEW COMMITTEE  
FEB 10 2000

APPROVED  
CITY ENGINEER  
FEB 10 2000

Project No. 5828.91  
Sheet 10-1 of 126

DATE 12-28-95  
FILE NO. 98012  
DESIGN KIS  
DRAWN JMB

NOV 1999

12-28-95  
12-28-95

98012.MA SHEETS\WB12004.DWG\12-27-99\JLB

