


CITY OF ALBUQUERQUE

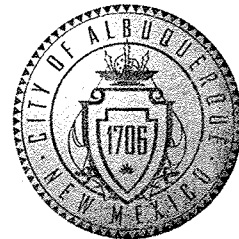

September 4, 2008

Jean J. Bordenave, P.E.
Bordenave Designs
P.O. Box 91194
Albuquerque, NM 87199

**Re: Vista Del Bosque Lot 1, 9798 A-D Coors Blvd. NW,
Request for Permanent Certificate of Occupancy (C.O.)
Engineer's Stamp dated 04/11/06 (B-13/D021C)
Certification dated 08/03/08**

Mr. Bordenave,

PO Box 1293

Based upon the information provided in your submittal received 9/03/08, the above referenced certification is approved for release of Permanent Certificate of Occupancy by Hydrology.

Albuquerque

If you have any questions, you can contact me at 924-3982.


NM 87103

Sincerely,

Timothy Sims
Plan Checker
Development and Building Services

www.cabq.gov

C: CO Clerk
File

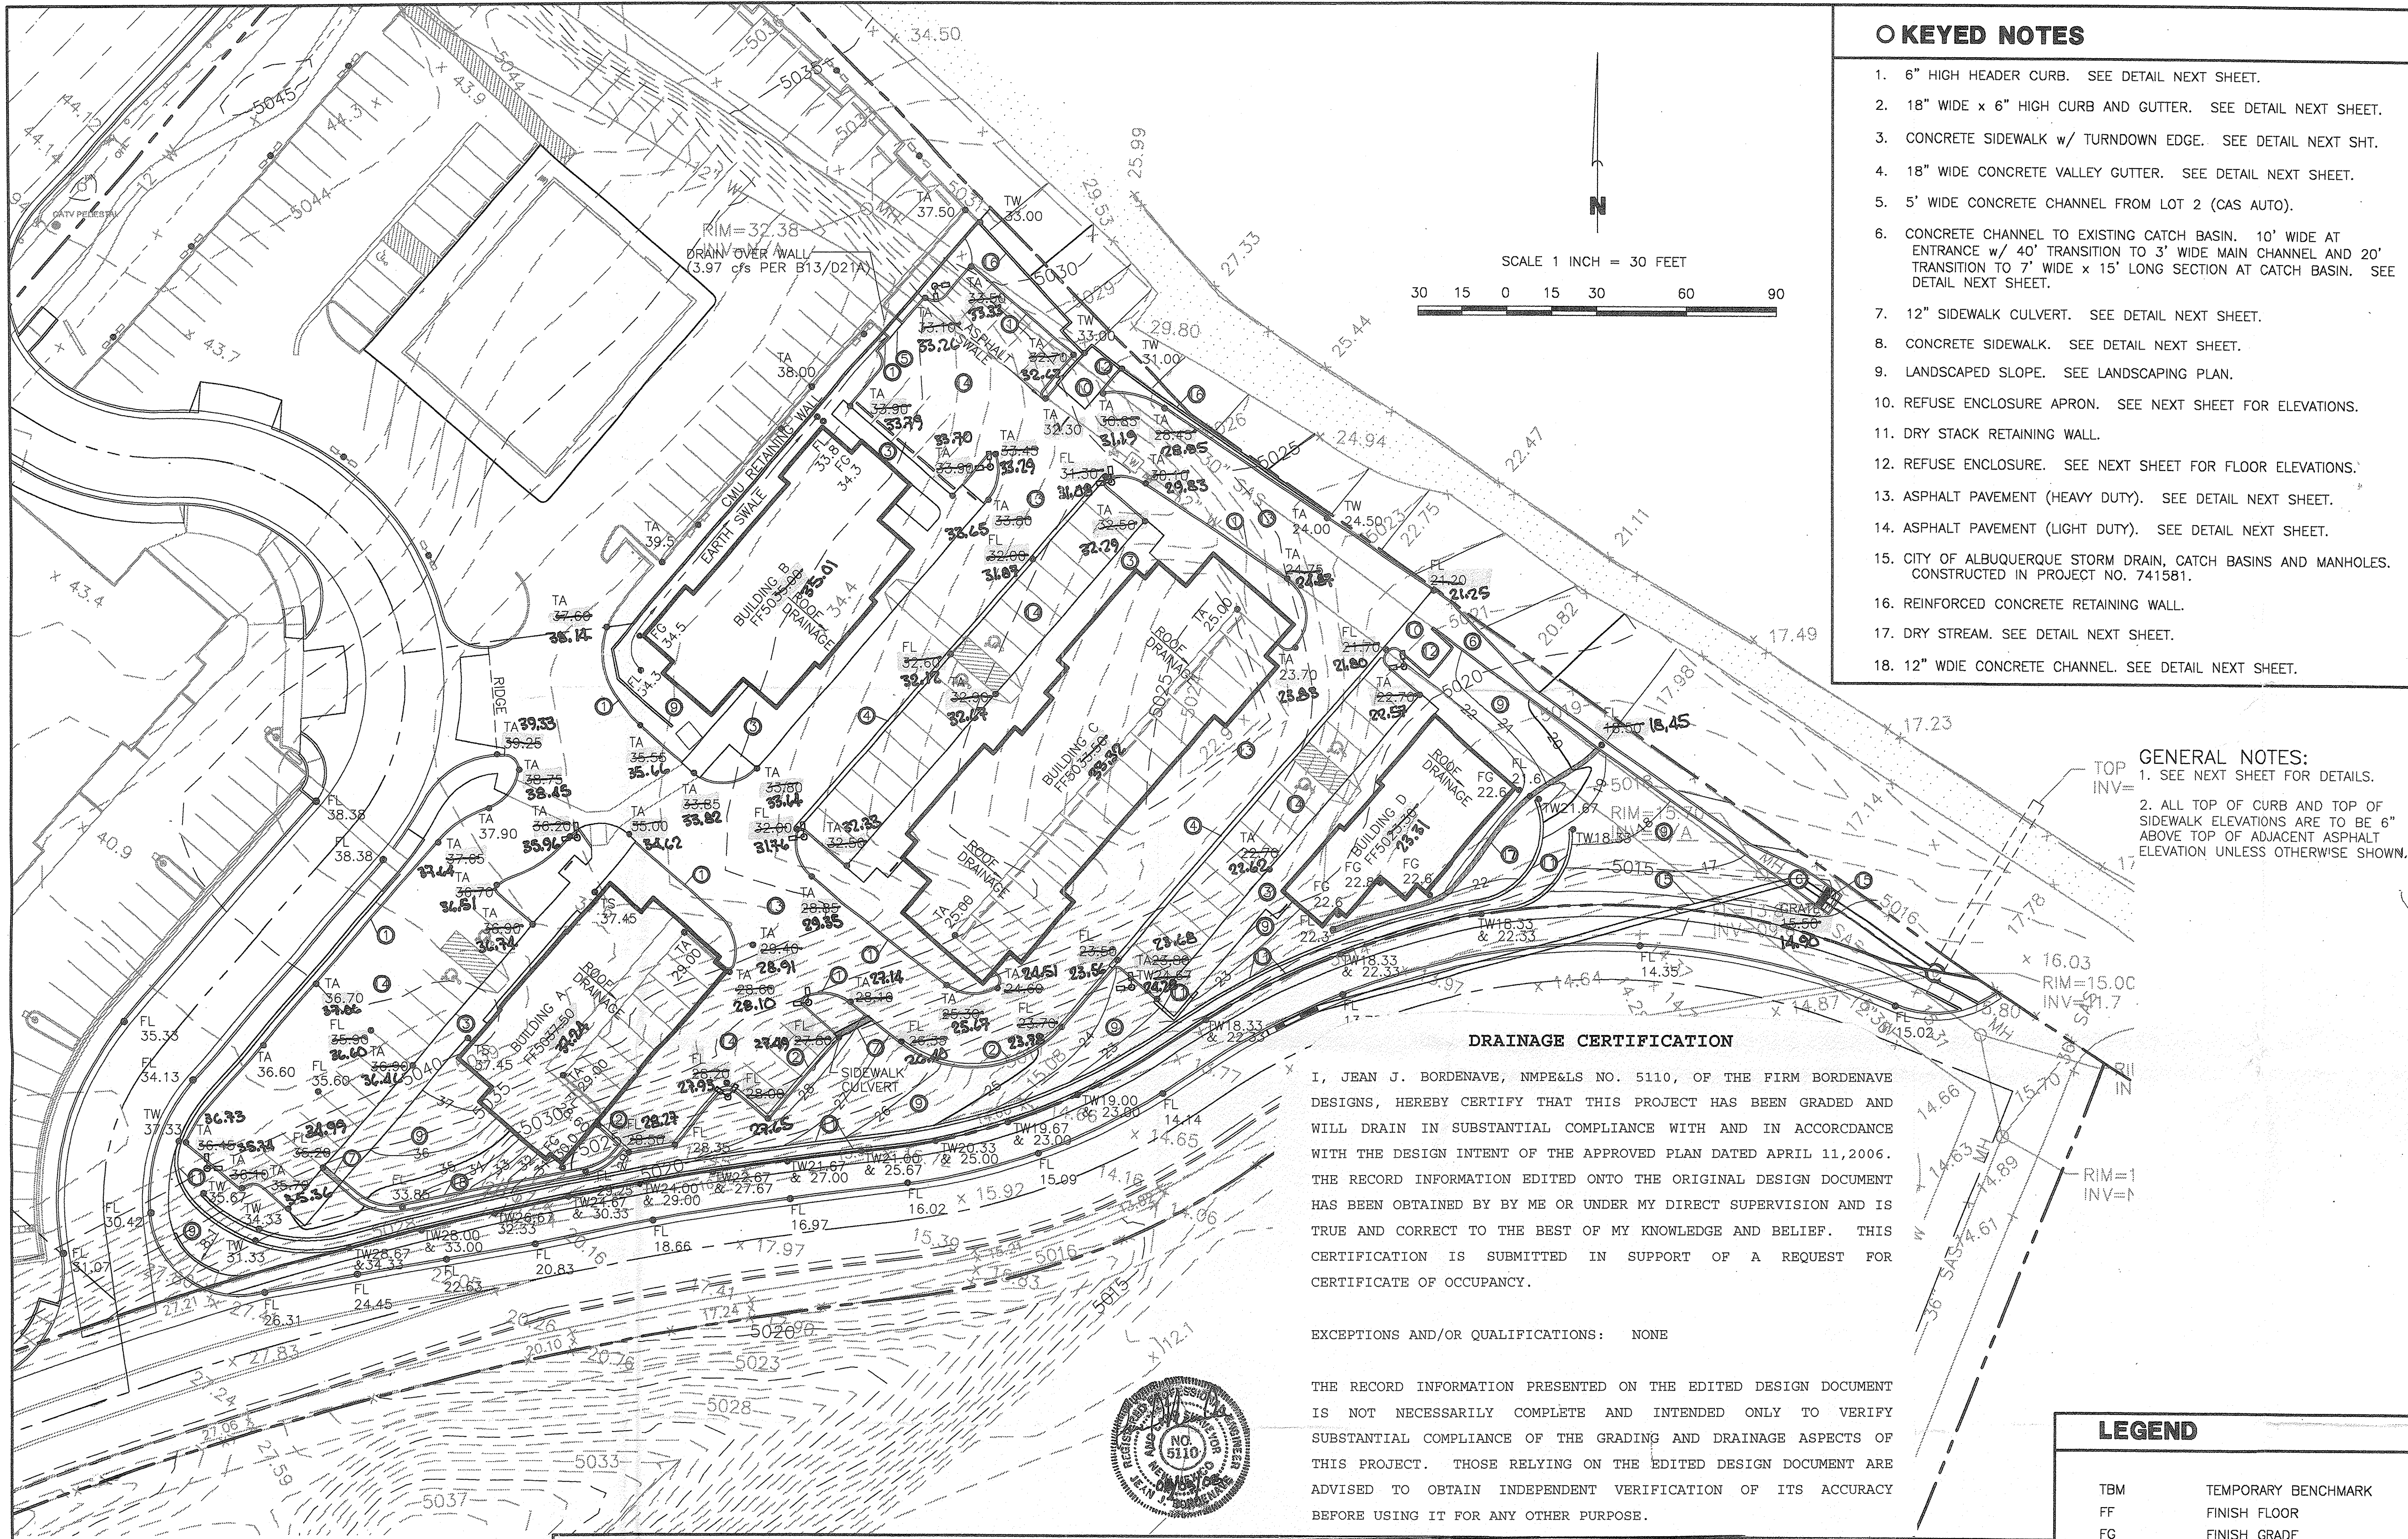

- KEYED NOTES**
- 6" HIGH HEADER CURB. SEE DETAIL NEXT SHEET.
 - 18" WIDE x 6" HIGH CURB AND GUTTER. SEE DETAIL NEXT SHEET.
 - CONCRETE SIDEWALK w/ TURNDOWN EDGE. SEE DETAIL NEXT SHT.
 - 18" WIDE CONCRETE VALLEY GUTTER. SEE DETAIL NEXT SHEET.
 - 5' WIDE CONCRETE CHANNEL FROM LOT 2 (CAS AUTO).
 - CONCRETE CHANNEL TO EXISTING CATCH BASIN. 10' WIDE AT ENTRANCE w/ 40' TRANSITION TO 3' WIDE MAIN CHANNEL AND 20' TRANSITION TO 7' WIDE x 15' LONG SECTION AT CATCH BASIN. SEE DETAIL NEXT SHEET.
 - 12" SIDEWALK CULVERT. SEE DETAIL NEXT SHEET.
 - CONCRETE SIDEWALK. SEE DETAIL NEXT SHEET.
 - LANDSCAPED SLOPE. SEE LANDSCAPING PLAN.
 - REFUSE ENCLOSURE APRON. SEE NEXT SHEET FOR ELEVATIONS.
 - DRY STACK RETAINING WALL.
 - REFUSE ENCLOSURE. SEE NEXT SHEET FOR FLOOR ELEVATIONS.
 - ASPHALT PAVEMENT (HEAVY DUTY). SEE DETAIL NEXT SHEET.
 - ASPHALT PAVEMENT (LIGHT DUTY). SEE DETAIL NEXT SHEET.
 - CITY OF ALBUQUERQUE STORM DRAIN, CATCH BASINS AND MANHOLES. CONSTRUCTED IN PROJECT NO. 741581.
 - REINFORCED CONCRETE RETAINING WALL.
 - DRY STREAM. SEE DETAIL NEXT SHEET.
 - 12" WIDE CONCRETE CHANNEL. SEE DETAIL NEXT SHEET.

GENERAL NOTES:


- SEE NEXT SHEET FOR DETAILS.
- ALL TOP OF CURB AND TOP OF SIDEWALK ELEVATIONS ARE TO BE 6" ABOVE TOP OF ADJACENT ASPHALT ELEVATION UNLESS OTHERWISE SHOWN.

DRAINAGE CERTIFICATION

I, JEAN J. BORDENAVE, NMPE&LS NO. 5110, OF THE FIRM BORDENAVE DESIGNS, HEREBY CERTIFY THAT THIS PROJECT HAS BEEN GRADED AND WILL DRAIN IN SUBSTANTIAL COMPLIANCE WITH AND IN ACCORDANCE WITH THE DESIGN INTENT OF THE APPROVED PLAN DATED APRIL 11, 2006. THE RECORD INFORMATION EDITED ONTO THE ORIGINAL DESIGN DOCUMENT HAS BEEN OBTAINED BY ME OR UNDER MY DIRECT SUPERVISION AND IS TRUE AND CORRECT TO THE BEST OF MY KNOWLEDGE AND BELIEF. THIS CERTIFICATION IS SUBMITTED IN SUPPORT OF A REQUEST FOR CERTIFICATE OF OCCUPANCY.

EXCEPTIONS AND/OR QUALIFICATIONS: NONE

THE RECORD INFORMATION PRESENTED ON THE EDITED DESIGN DOCUMENT IS NOT NECESSARILY COMPLETE AND INTENDED ONLY TO VERIFY SUBSTANTIAL COMPLIANCE OF THE GRADING AND DRAINAGE ASPECTS OF THIS PROJECT. THOSE RELYING ON THE EDITED DESIGN DOCUMENT ARE ADVISED TO OBTAIN INDEPENDENT VERIFICATION OF ITS ACCURACY BEFORE USING IT FOR ANY OTHER PURPOSE.

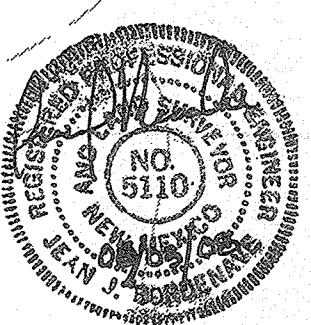

LEGEND

- | | |
|--------|-------------------------|
| TBM | TEMPORARY BENCHMARK |
| FF | FINISH FLOOR |
| FG | FINISH GRADE |
| FL | FLOWLINE |
| TA | TOP OF ASPHALT |
| TOP | TOP OF CONCRETE |
| TC | TOP OF CURB |
| TP | TOP OF EARTH PAD |
| TS | TOP OF SIDEWALK |
| TW | TOP OF WALL |
| FH | FIRE HYDRANT |
| WM | WATER METER |
| MH | MANHOLE |
| CB | CATCH BASIN GRATE |
| LP | LIGHT POLE |
| PP | POWER POLE |
| GW | GUY WIRE |
| PED | ELEC. OR TEL. PEDESTAL |
| RD | ROOF DRAINAGE POINT |
| --- | DRAINAGE BASIN BOUNDARY |
| --- | EXISTING CONTOUR |
| --- | PROPOSED CONTOUR |
| XX.XX | EXISTING SPOT ELEVATION |
| •XX.XX | PROPOSED SPOT ELEVATION |
| XX.XX | RECORD SPOT ELEVATION |

DRAINAGE DATA

CONDITION	STORM RETURN PERIOD	TREATMENT TYPE	TREATMENT AREA	EXCESS PRECIPITATION	PEAK RUNOFF	RUNOFF VOLUME	RUNOFF RATE
	year	(table 4)	sq. ft.	(table 5)	(table 6)	cu. ft.	cfs
EXISTING	10	A	66844	0.08	0.24	446	0.37
		B	3810	0.22	0.76	70	0.07
		C	23070	0.44	1.49	846	0.79
		D	0	1.24	2.89	0	0.00
		TOTAL	93724			1361	1.22
DEVELOPED	100	A	66844	0.44	1.29	2451	1.98
		B	3810	0.67	2.03	213	0.18
		C	23070	0.99	2.87	1903	1.52
		D	0	1.97	4.37	0	0.00
		TOTAL	93724			4567	3.68
S	10	A	0	0.08	0.24	0	0.00
		B	2740	0.22	0.76	50	0.05
		C	0	0.44	1.49	0	0.00
		D	6350	1.24	2.89	656	0.42
		TOTAL	9090			706	0.47
S	100	A	0	0.44	1.29	0	0.00
		B	2740	0.67	2.03	153	0.13
		C	0	0.99	2.87	0	0.00
		D	6350	1.97	4.37	1042	0.84
		TOTAL	9090			1195	0.76
S	10	A	0	0.08	0.24	0	0.00
		B	20870	0.22	0.76	383	0.36
		C	0	0.44	1.49	0	0.00
		D	63764	1.24	2.89	6589	4.23
		TOTAL	84534			6972	4.59
H	100	A	0	0.44	1.29	0	0.00
		B	20870	0.67	2.03	1165	0.97
		C	0	0.99	2.87	0	0.00
		D	63764	1.97	4.37	10468	8.40
		TOTAL	84534			11633	7.37

NORTH DRIVE AISLE

VEE CHANNEL
 $Q = (1.489/n)AR^{6/5}S^{5/3}$, where $Q = 6.2$ cfs, $SS = 0.0001$
 $SS_2 = 33$, $S = 0.0342$ ft/ft, $n = 0.020$
therefore Depth = 0.39 ft, Velocity = 5.34 fps

CHANNEL FLOW

RECTANGULAR CHANNEL
 $Q = (1.489/n)AR^{6/5}S^{5/3}$, where $Q = 12.45$ cfs, Width = 3 ft
 $S = 0.0342$ ft/ft, $n = 0.013$
therefore Depth = 0.42 ft, Velocity = 10.00 fps

CATCH BASIN

BASIN IS IN SUMP. THEREFORE ASSUME IT TO BE 50% CLOGGED. SHARP CRESTED WEIR WHERE:
 $Q = CLH^{1.5}$ where $Q = 12.4$ cfs, $L = 12.15$ ft for $1/2$ of a Dbl D Basin, and $C = 3.2$
therefore $H = 0.47$ ft

NOTE: H WILL BE REDUCED BY ORIFICE FLOW IN GRATE.

CHANNEL INLET

BROAD CRESTED WEIR
 $Q = CLH^{1.5}$ where $Q = 12.45$ cfs, $L = 10.0$ ft, $C = 2.8$
therefore $H = 0.63$ ft

TAPER HEADER CURB FROM 6" HIGH AT 10' WEST TO 9" HIGH AT INLET TO 6" HIGH 20' EAST.


LEGAL DESCRIPTION

LOTS 1, CAS ADDITION


PERMANENT BENCHMARK

ACS NM446-N10 ELEVATION 5045.51 (NGVD 1929)

VICINITY MAP NO. B-13/14

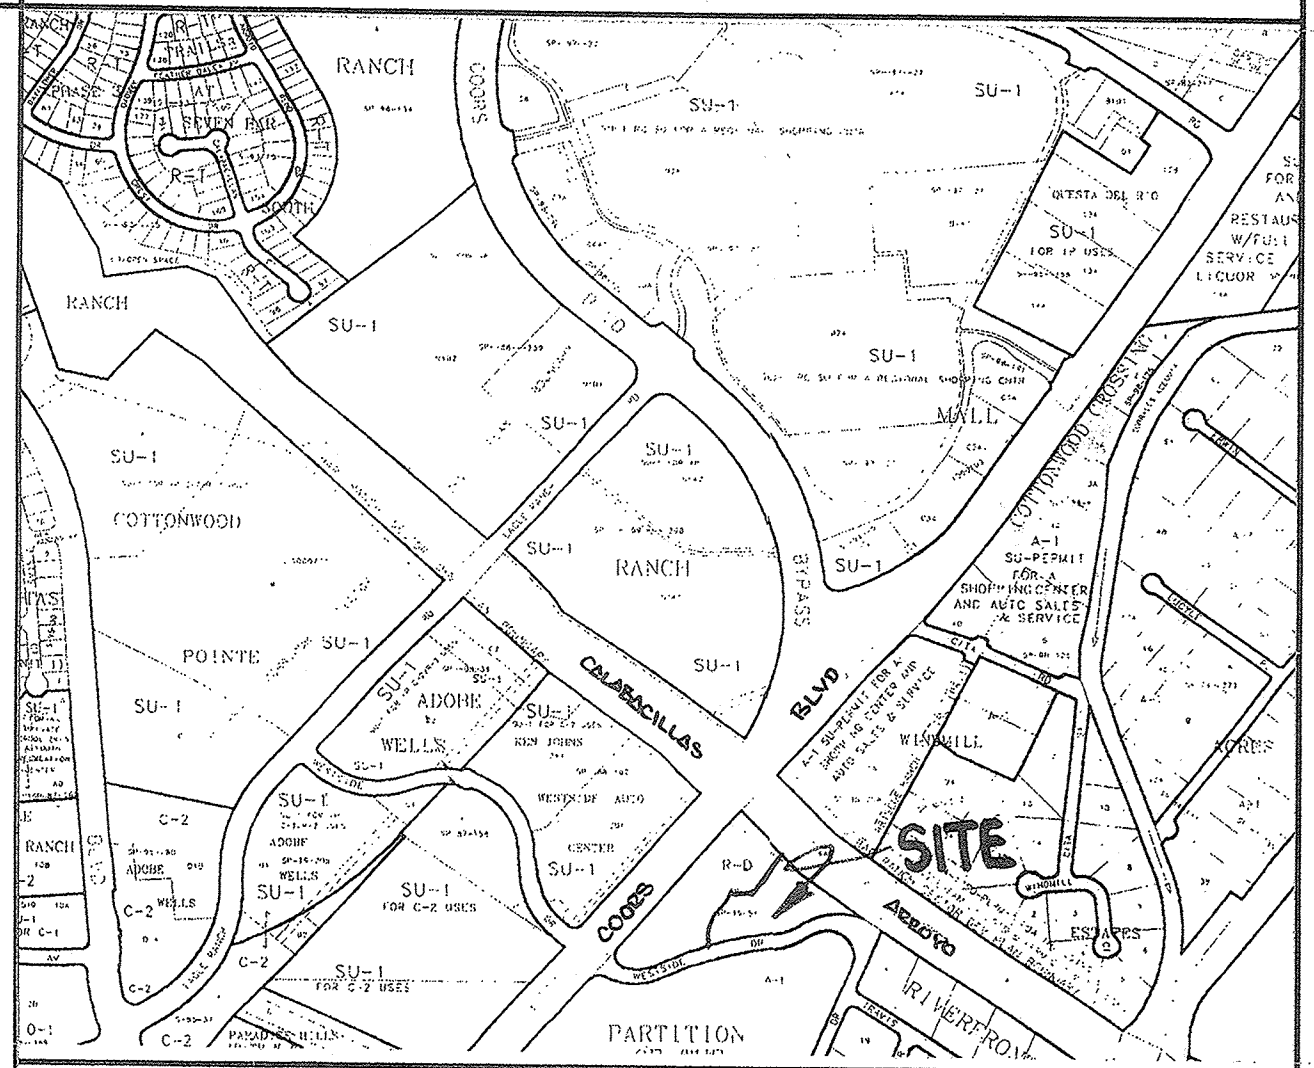

FEMA FIRM PANEL NO. 108

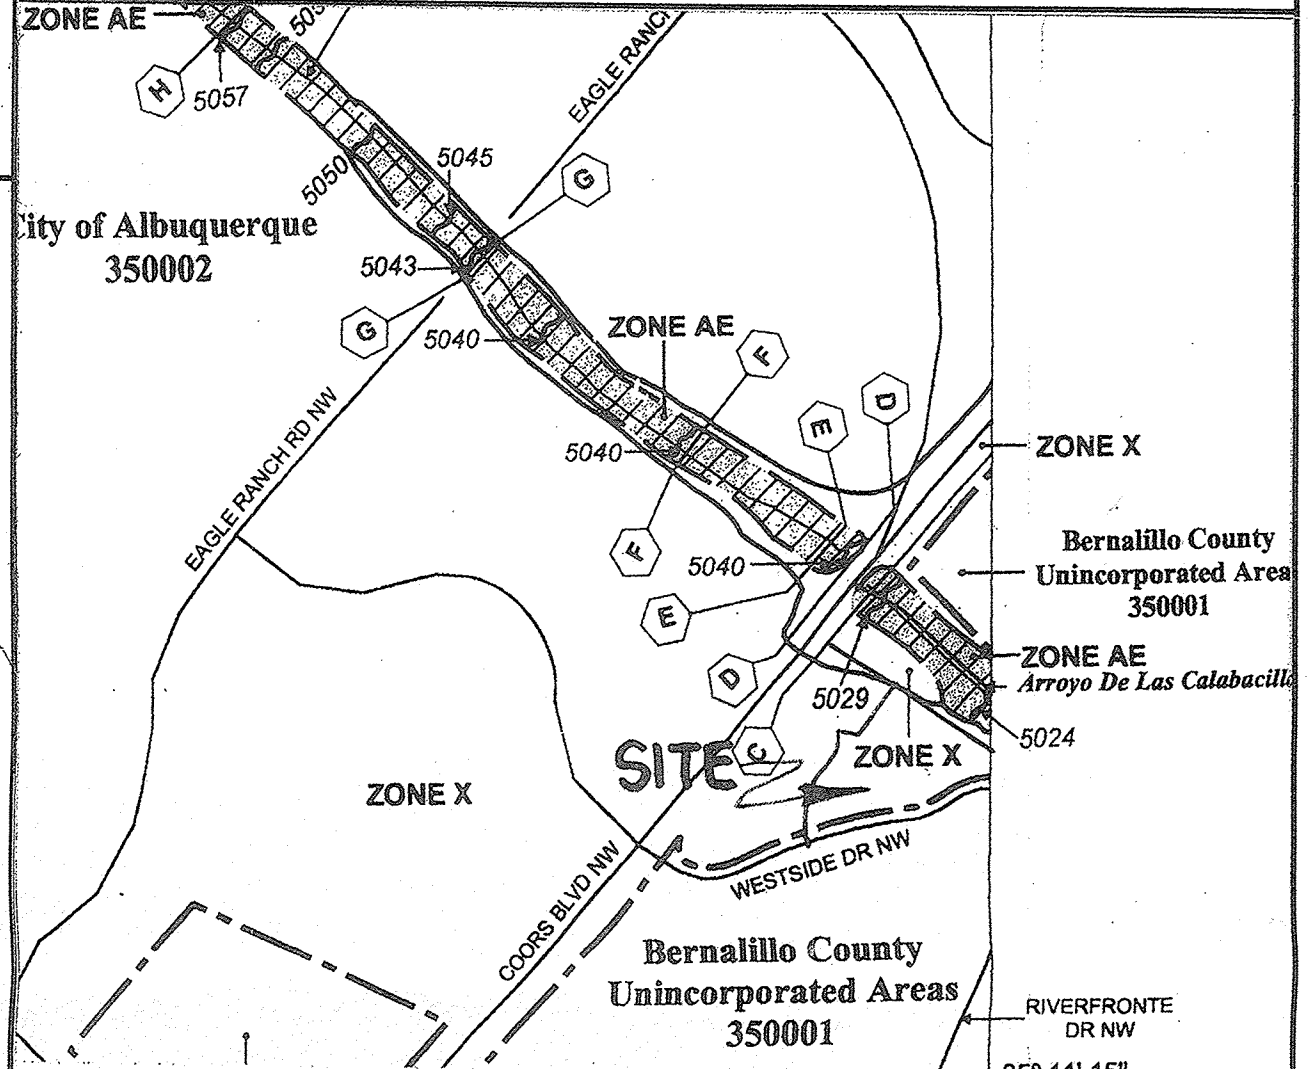

SITE CONDITIONS

- EXISTING CONDITIONS**
- THE EXISTING SITE IS QUITE STEEP (>10% SLOPE) SLOPING DOWNWARD FROM WEST TO EAST. VEGETATION IS COMPOSED OF SPARSE GRASSES AND SCATTERED WEEDS. SOILS ARE SANDY LOAMS.
 - THERE IS AN EXISTING CATCH BASIN AT THE EASTERLY END OF THE SITE (ON THE PROPERTY) THAT DRAINS INTO THE LAS CALABACILLAS ARROYO. THE LOT WEST OF THE SITE (LOT 2) DRAINS ACROSS THE SUBJECT SITE.
- PROPOSED CONDITIONS**
- THE PROPOSED OFFICE COMPLEX IS COMPOSED OF SEVERAL SMALLER BUILDINGS TO BETTER FIT THE EXISTING SLOPES. PARKING HAS BEEN PLACED UNDER THE EASTERLY PORTION OF TWO OF THE BUILDINGS TO FURTHER MATCH EXISTING SITE GRADES.
 - STORM WATER WILL CONTINUE TO BE ACCEPTED FROM LOT 2 TO THE WEST AND ROUTED ACROSS THE SUBJECT SITE TO A NEW ENLARGED CATCH BASIN TO REPLACE THE EXISTING OUTFALL. THE NEW OUTFALL FACILITY WILL HAVE A WATER QUALITY MANHOLE MEETING CITY AND AMFCA SPECIFICATIONS. ALL ONSITE STORM WATER AS WELL AS THAT FROM LOT 2 WILL BE ROUTED ACROSS THE SUBJECT SITE VIA ASPHALT DRIVES AND A CONCRETE CHANNEL.
 - A DRY STACK RETAINING WALL IS LOCATED ALONG THE SOUTHERLY LOT LINE OF THE SITE TO AID IN MEETING THE STEEP EXISTING GRADE. THE GRADE DIFFERENCE IS MADE UP WITH TWO PARALLEL WALLS 3 FEET APART. THE LOWER WALL IS LOCATED AT THE PROPERTY LINE AND IS FOUR FEET HIGH. THE UPPER WALL VARIES FROM ZERO TO FOUR FEET HIGH. THE WALLS ARE OFFSET TO ACCOMMODATE LANDSCAPING.

project title
**VISTA DEL BOSQUE
WESTSIDE DRIVE NW
ALBUQUERQUE, NM**

sheet title
GRADING & DRAINAGE

sheet date
04/26/05











design by
JJB

project no.
0408



sheet
1
of
2

RECEIVED
SEP 6 2005
HYDROLOGY
SECTION

BORDENAVE DESIGNS
P.O. BOX 91194, ALBUQUERQUE, NM 87199
(505)823-1344 FAX (505)821-9105

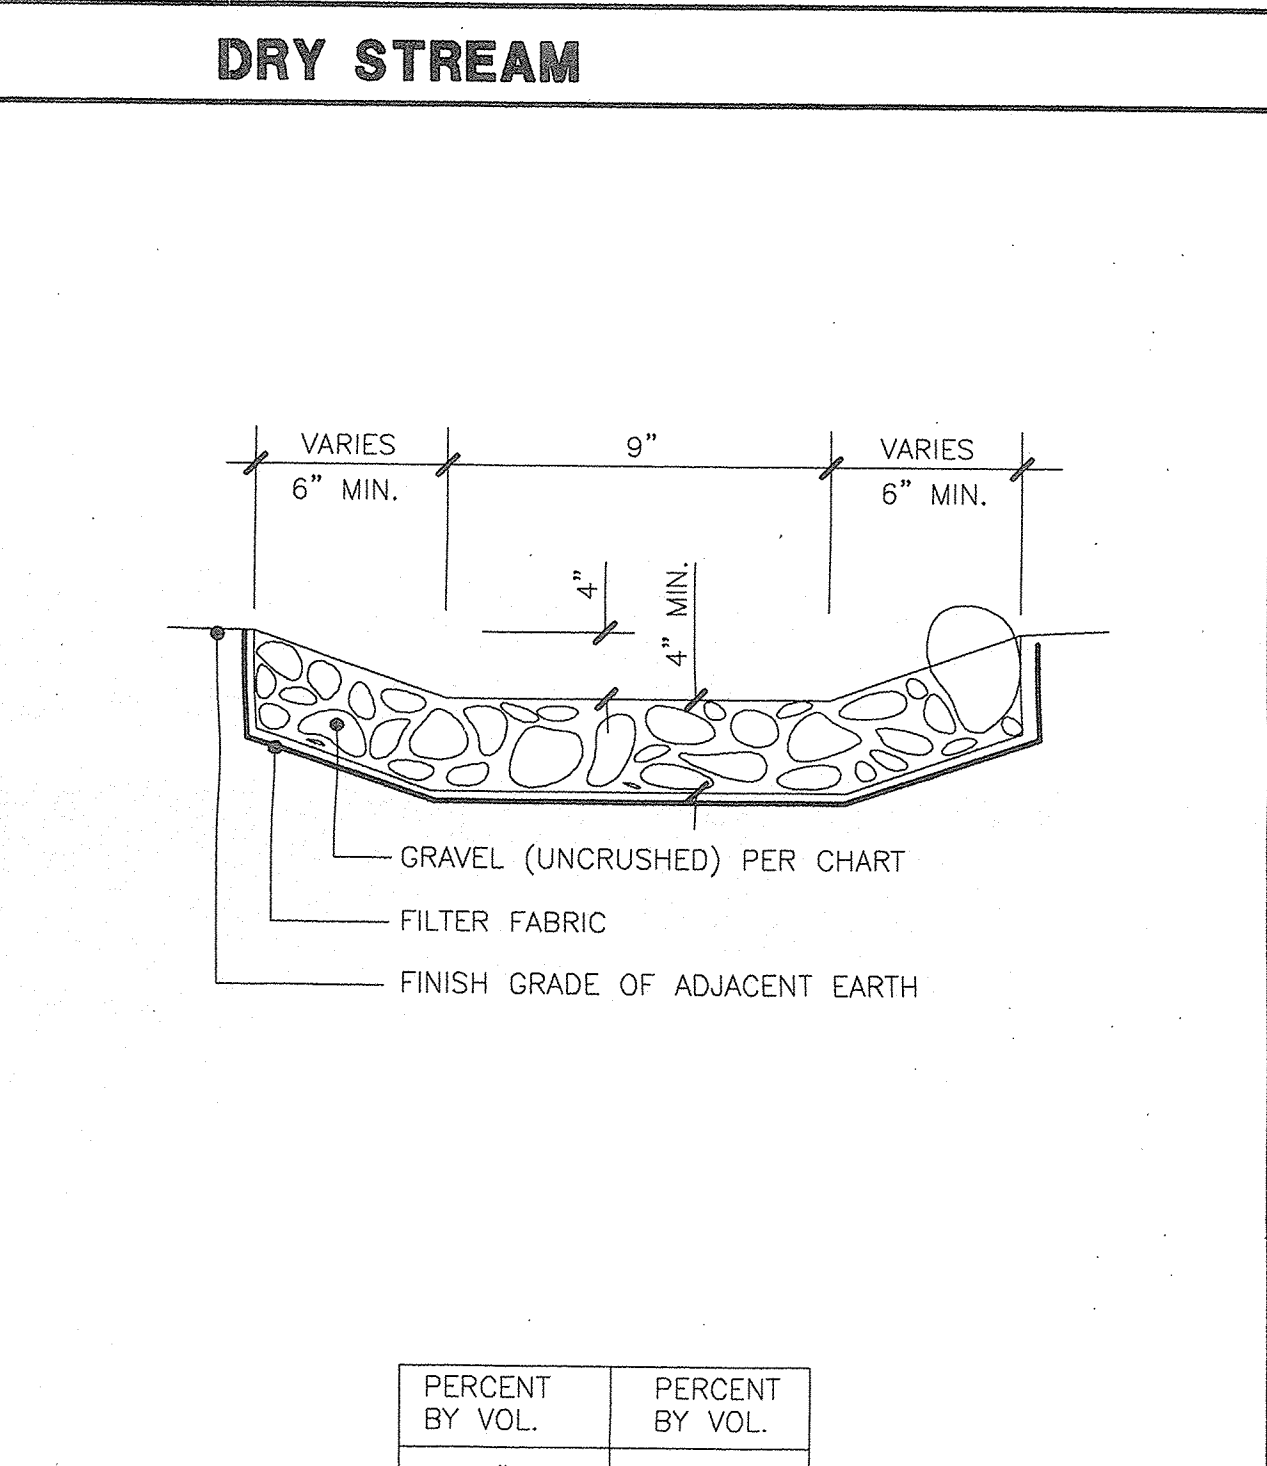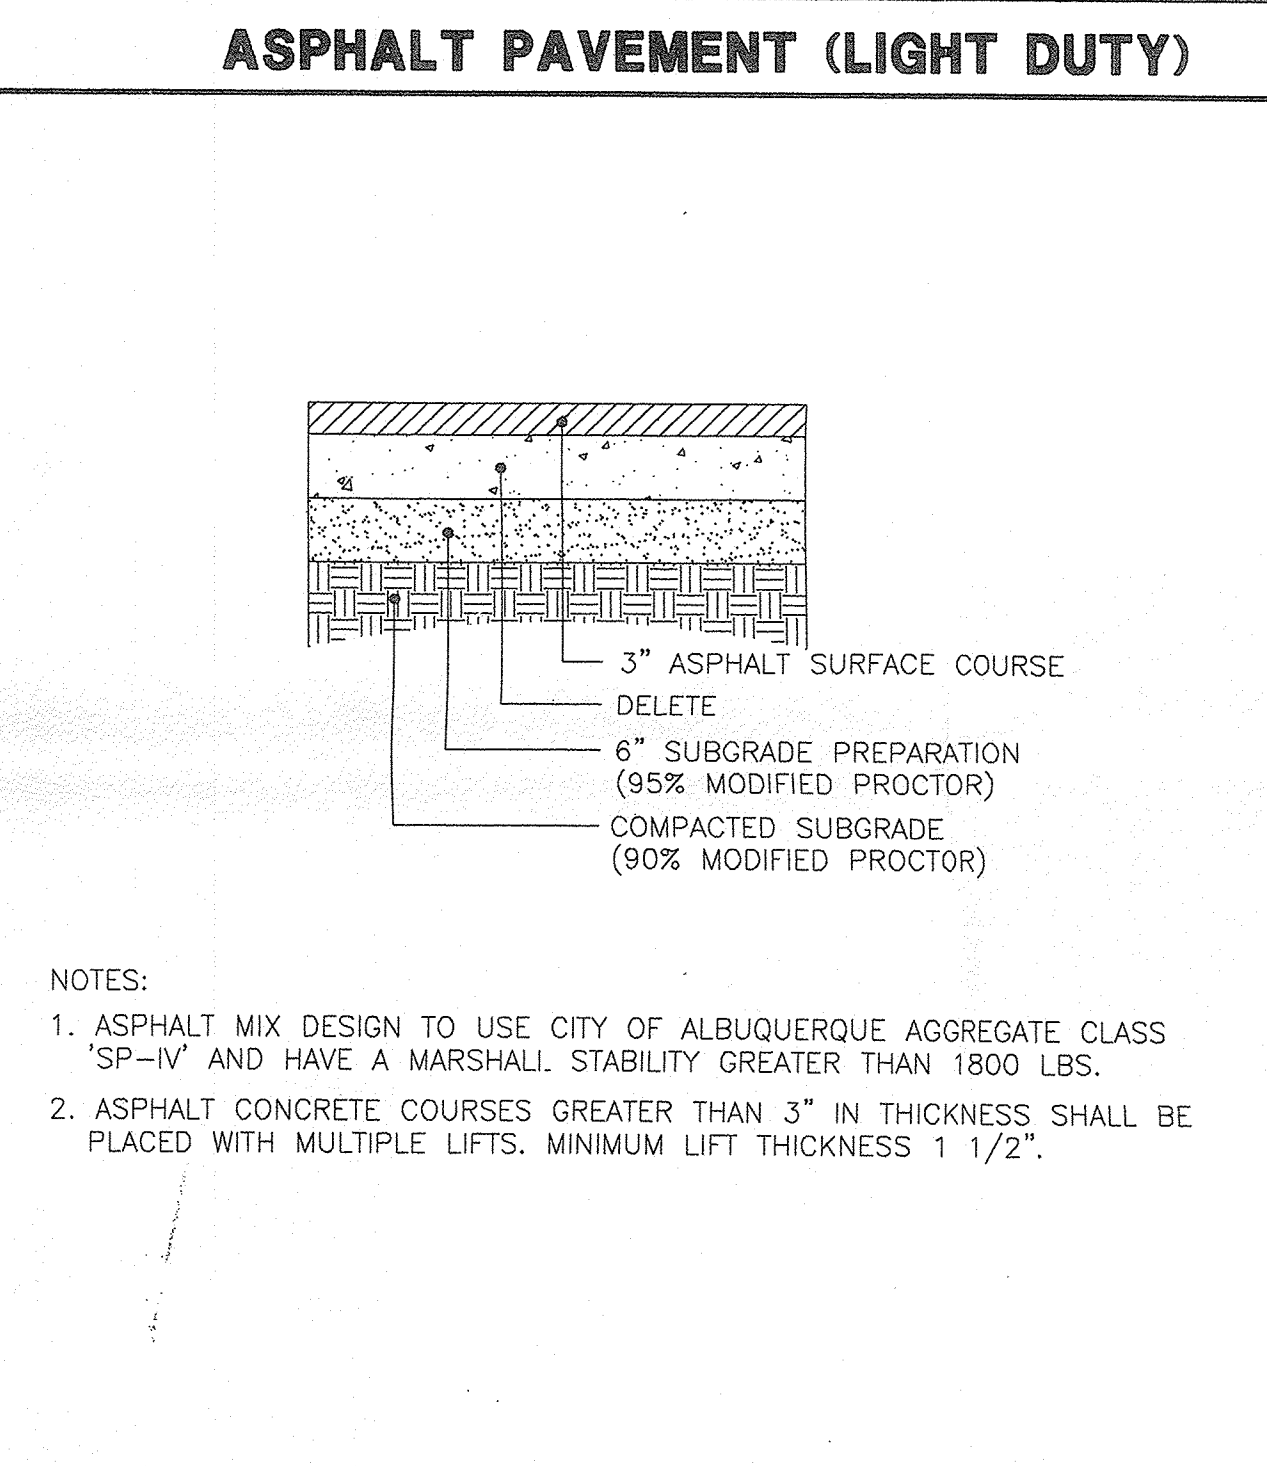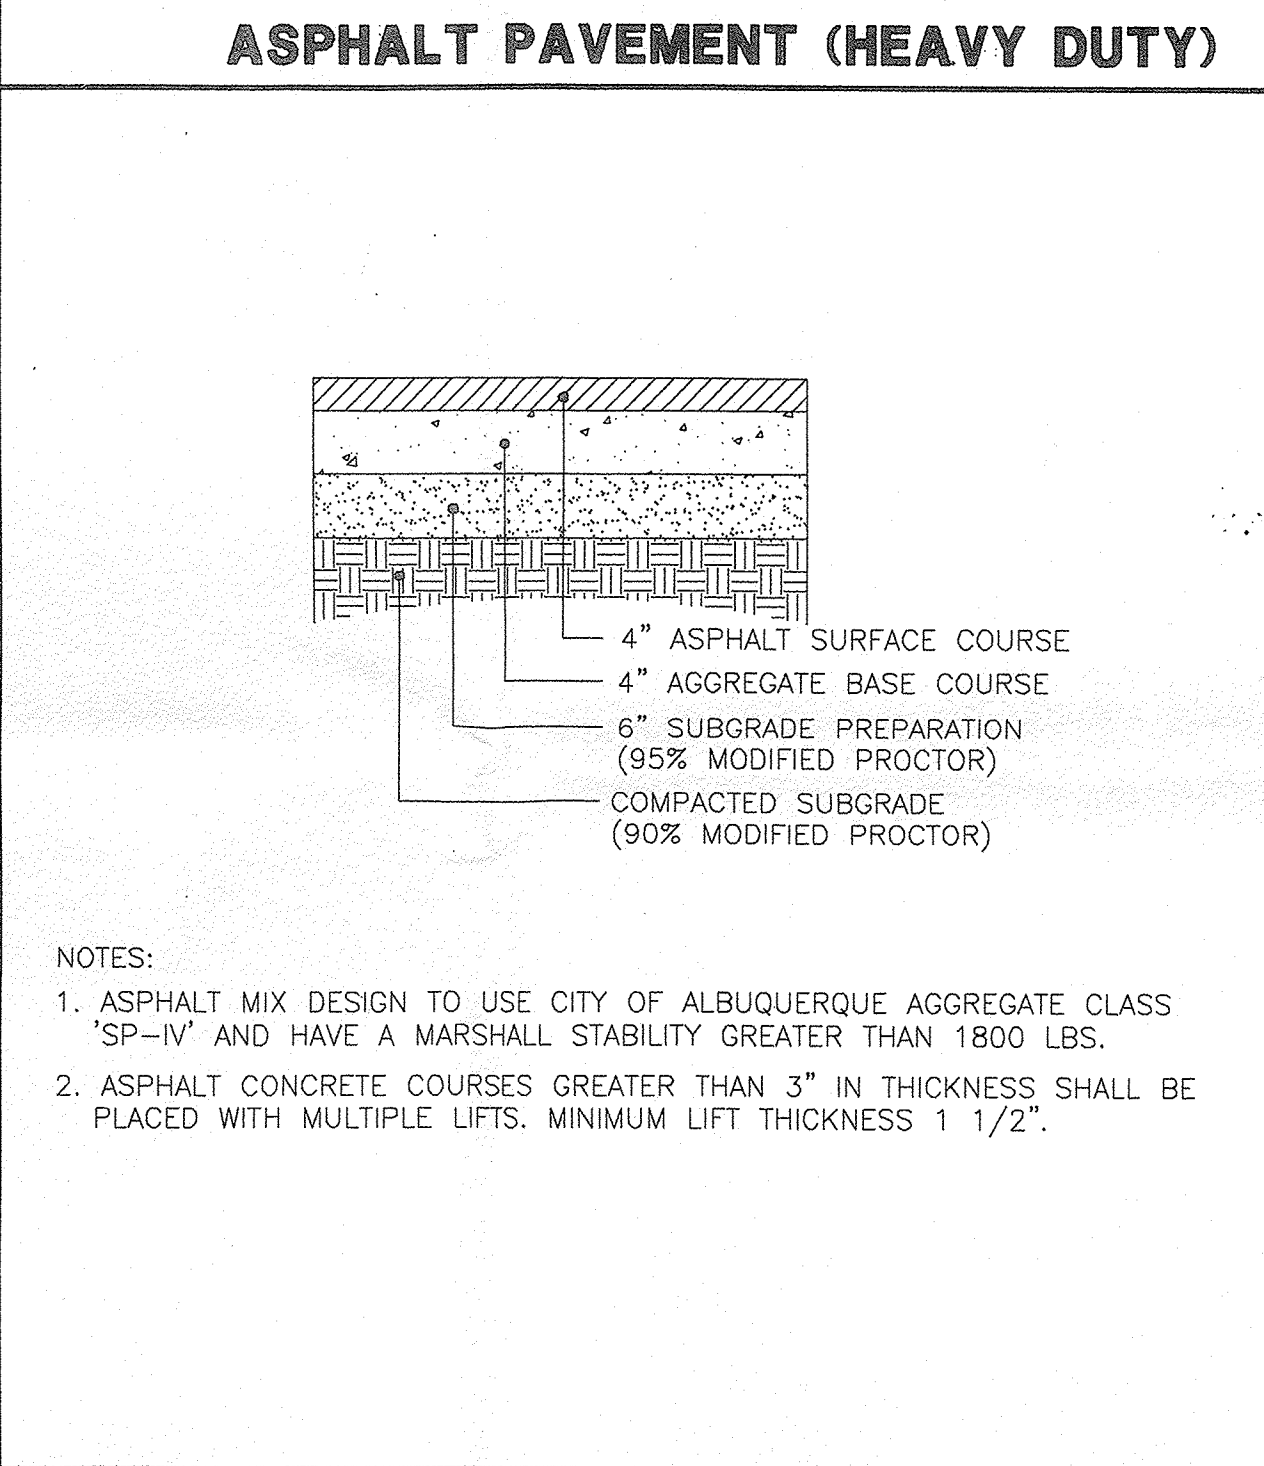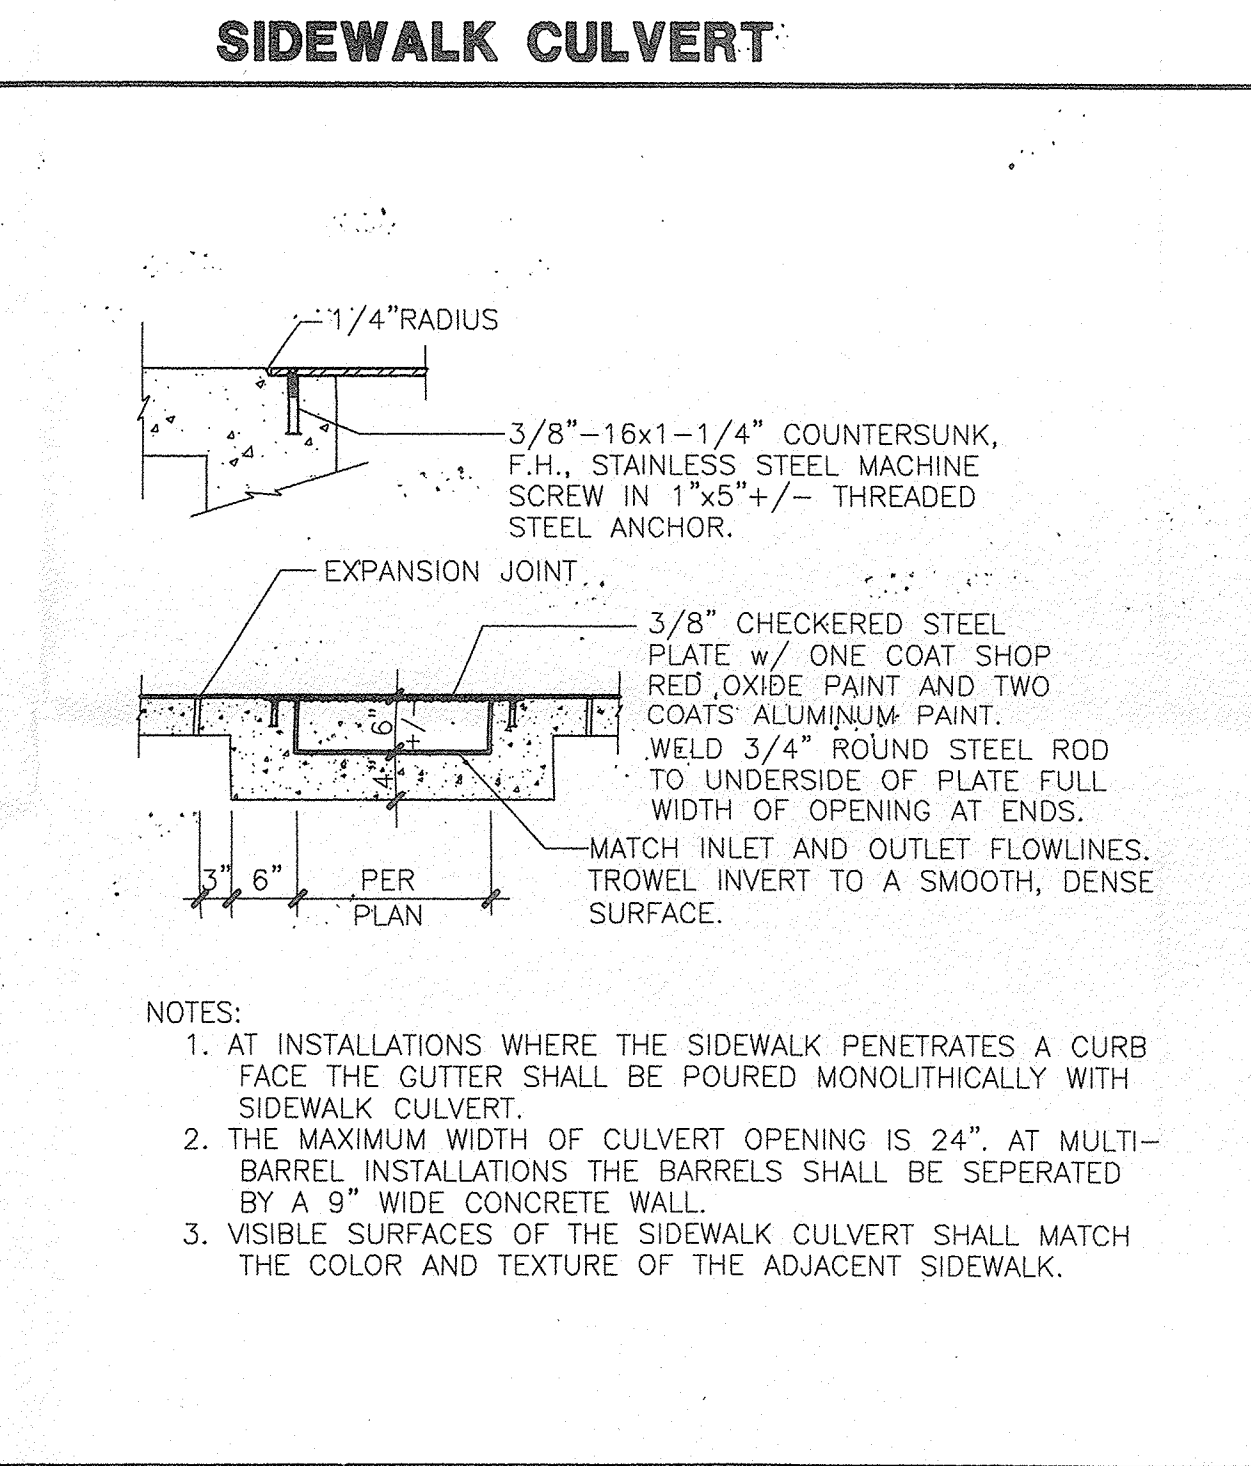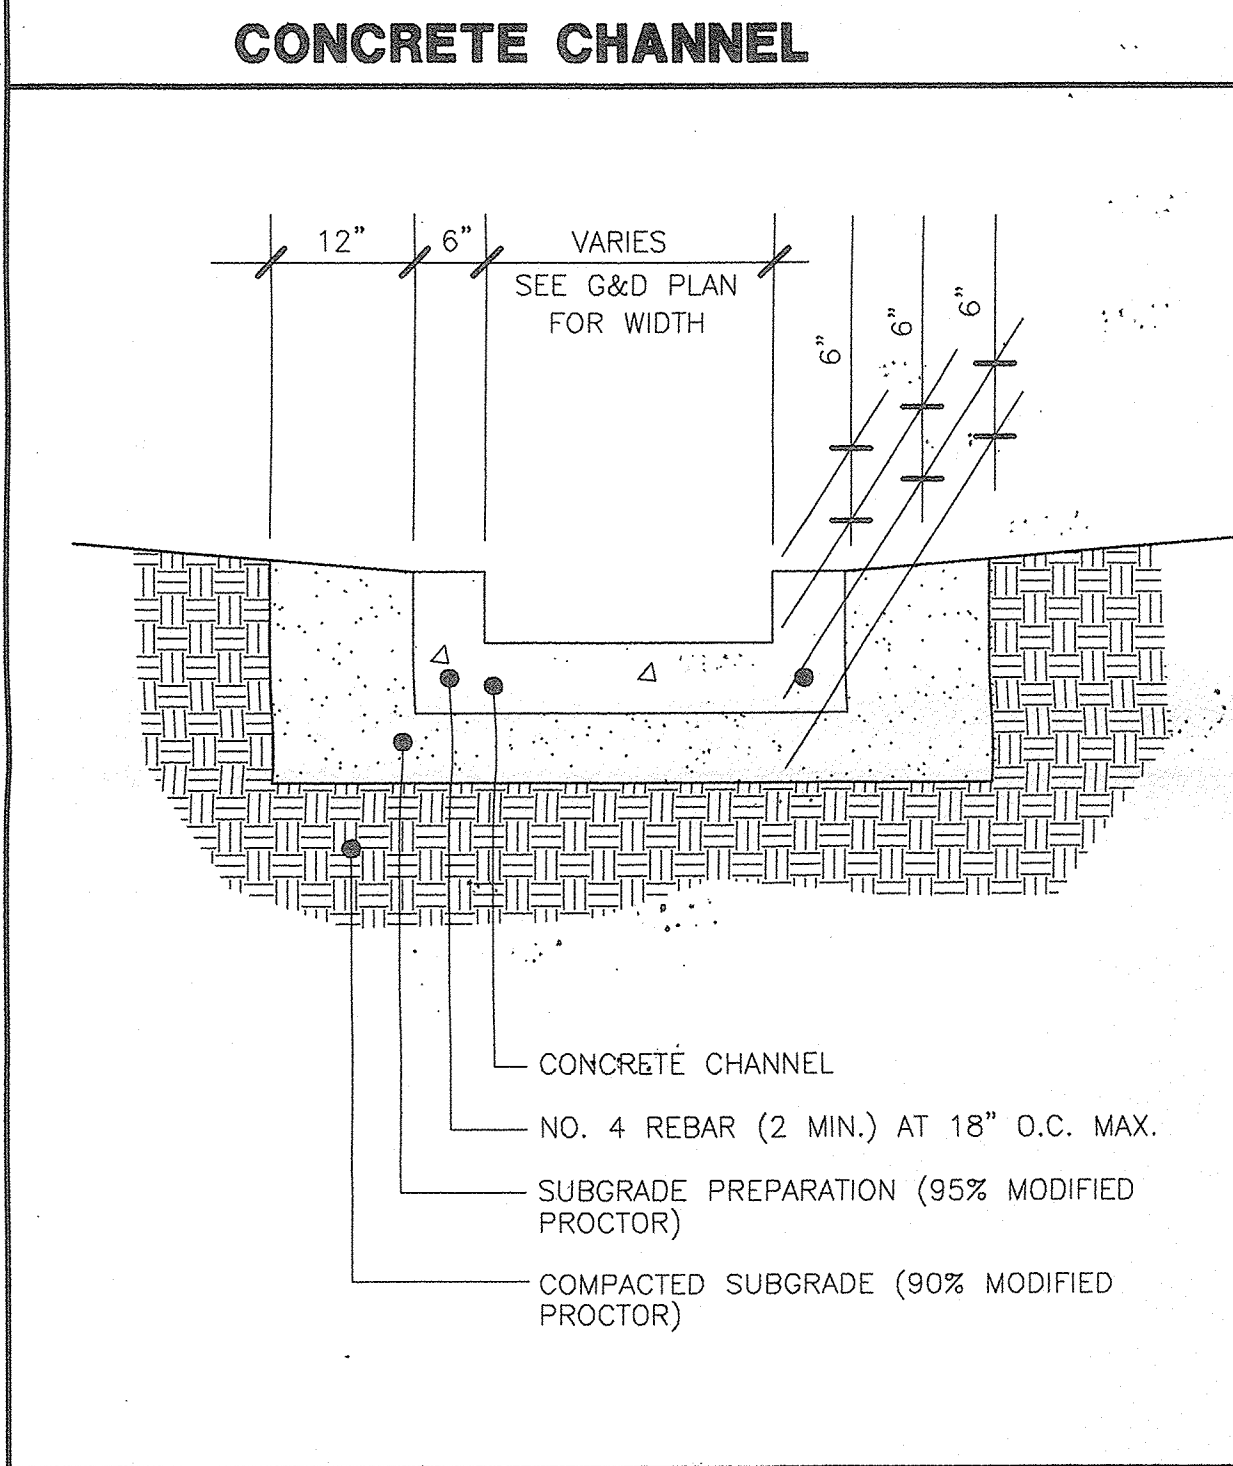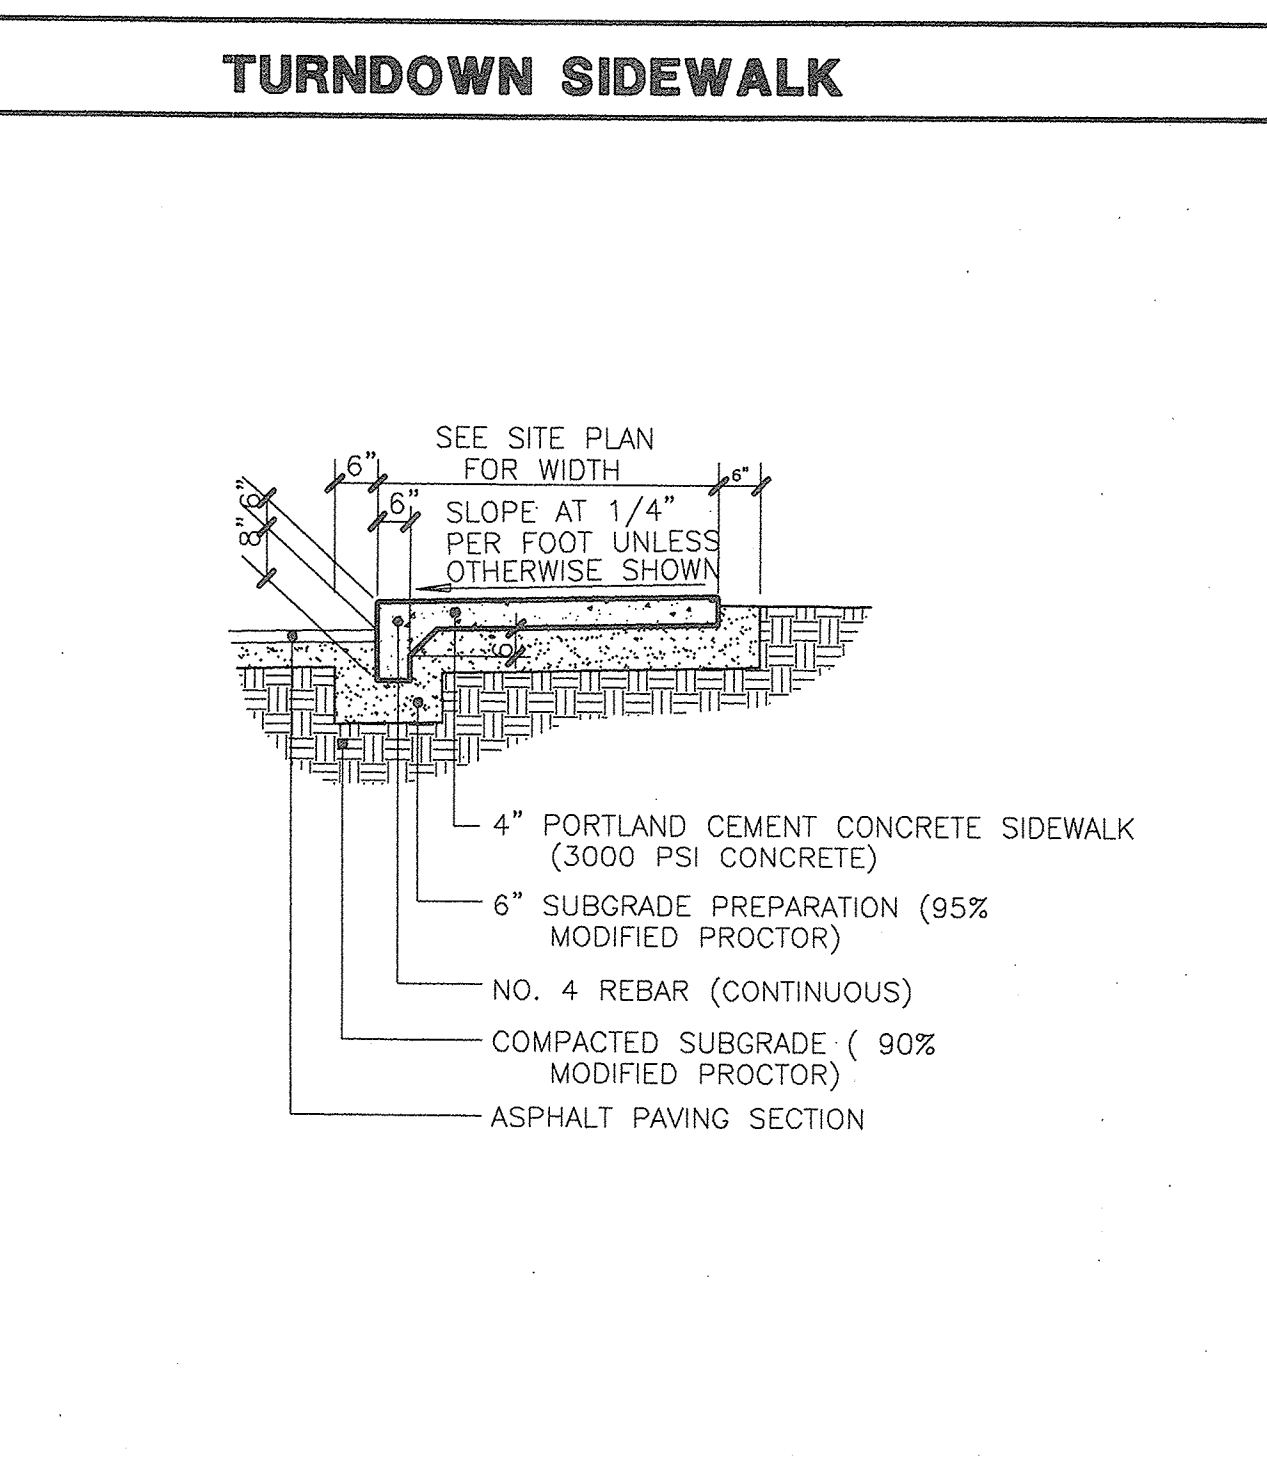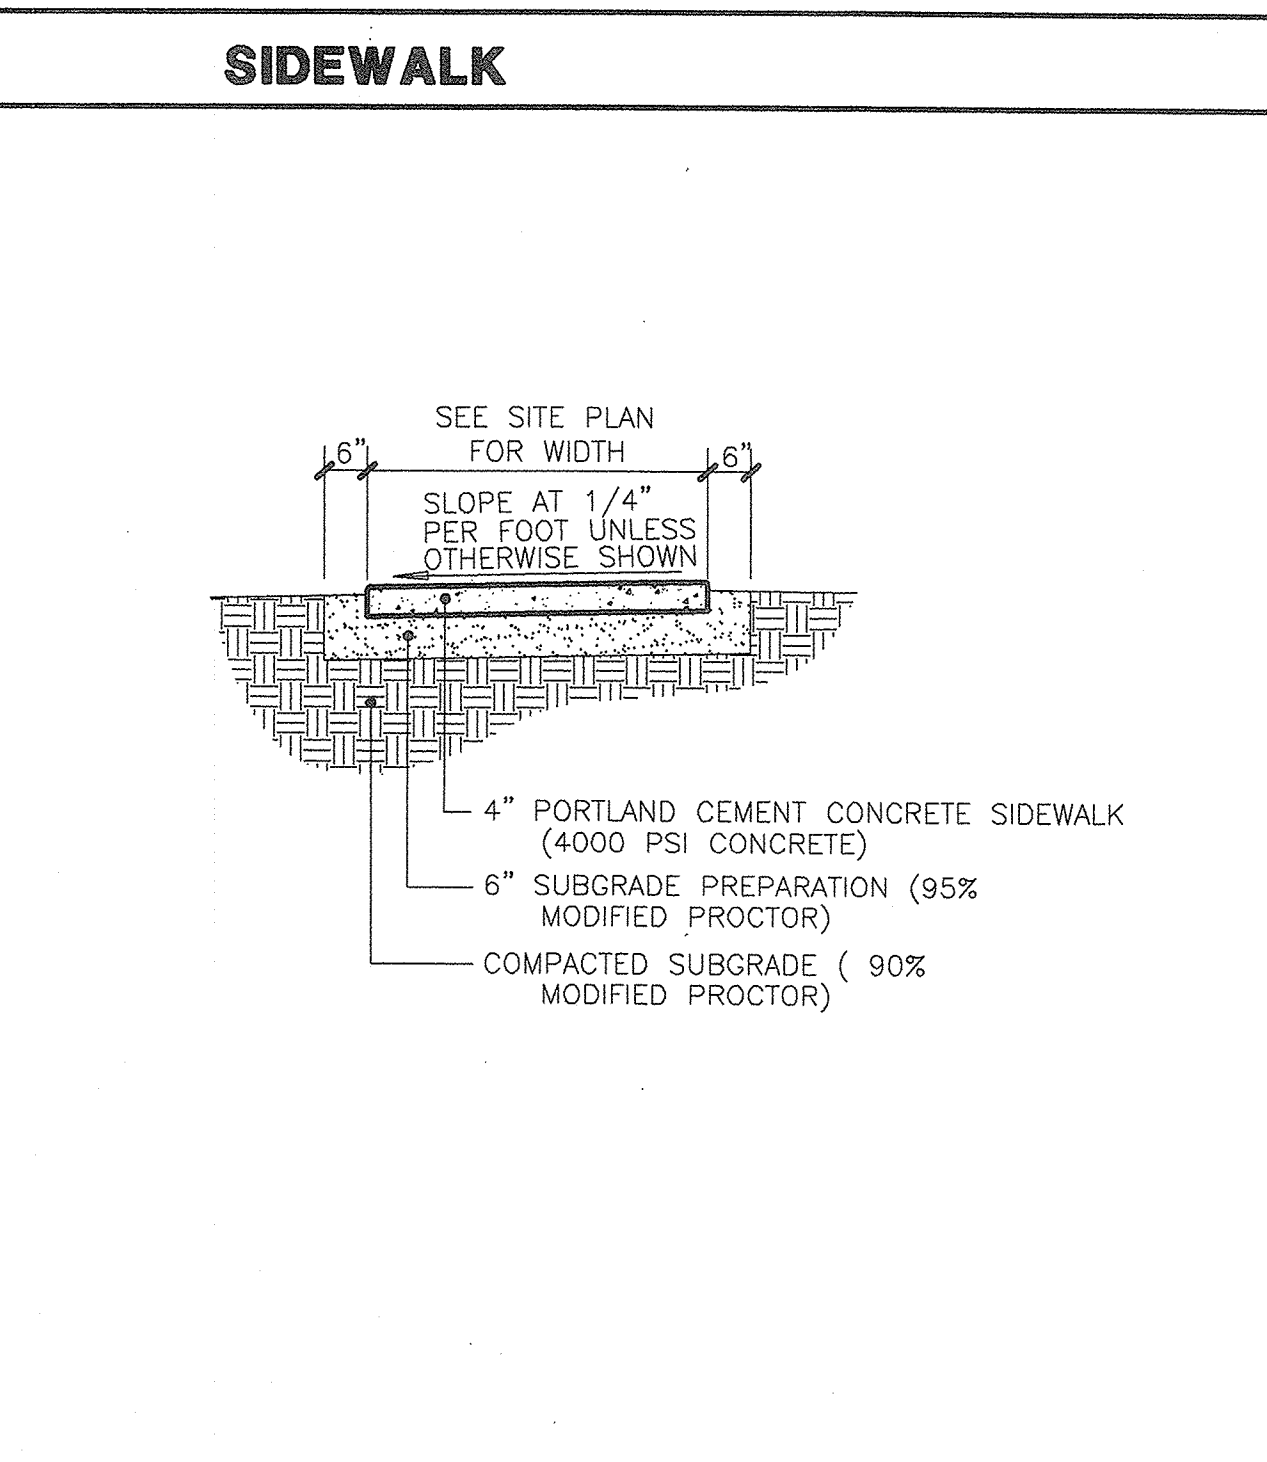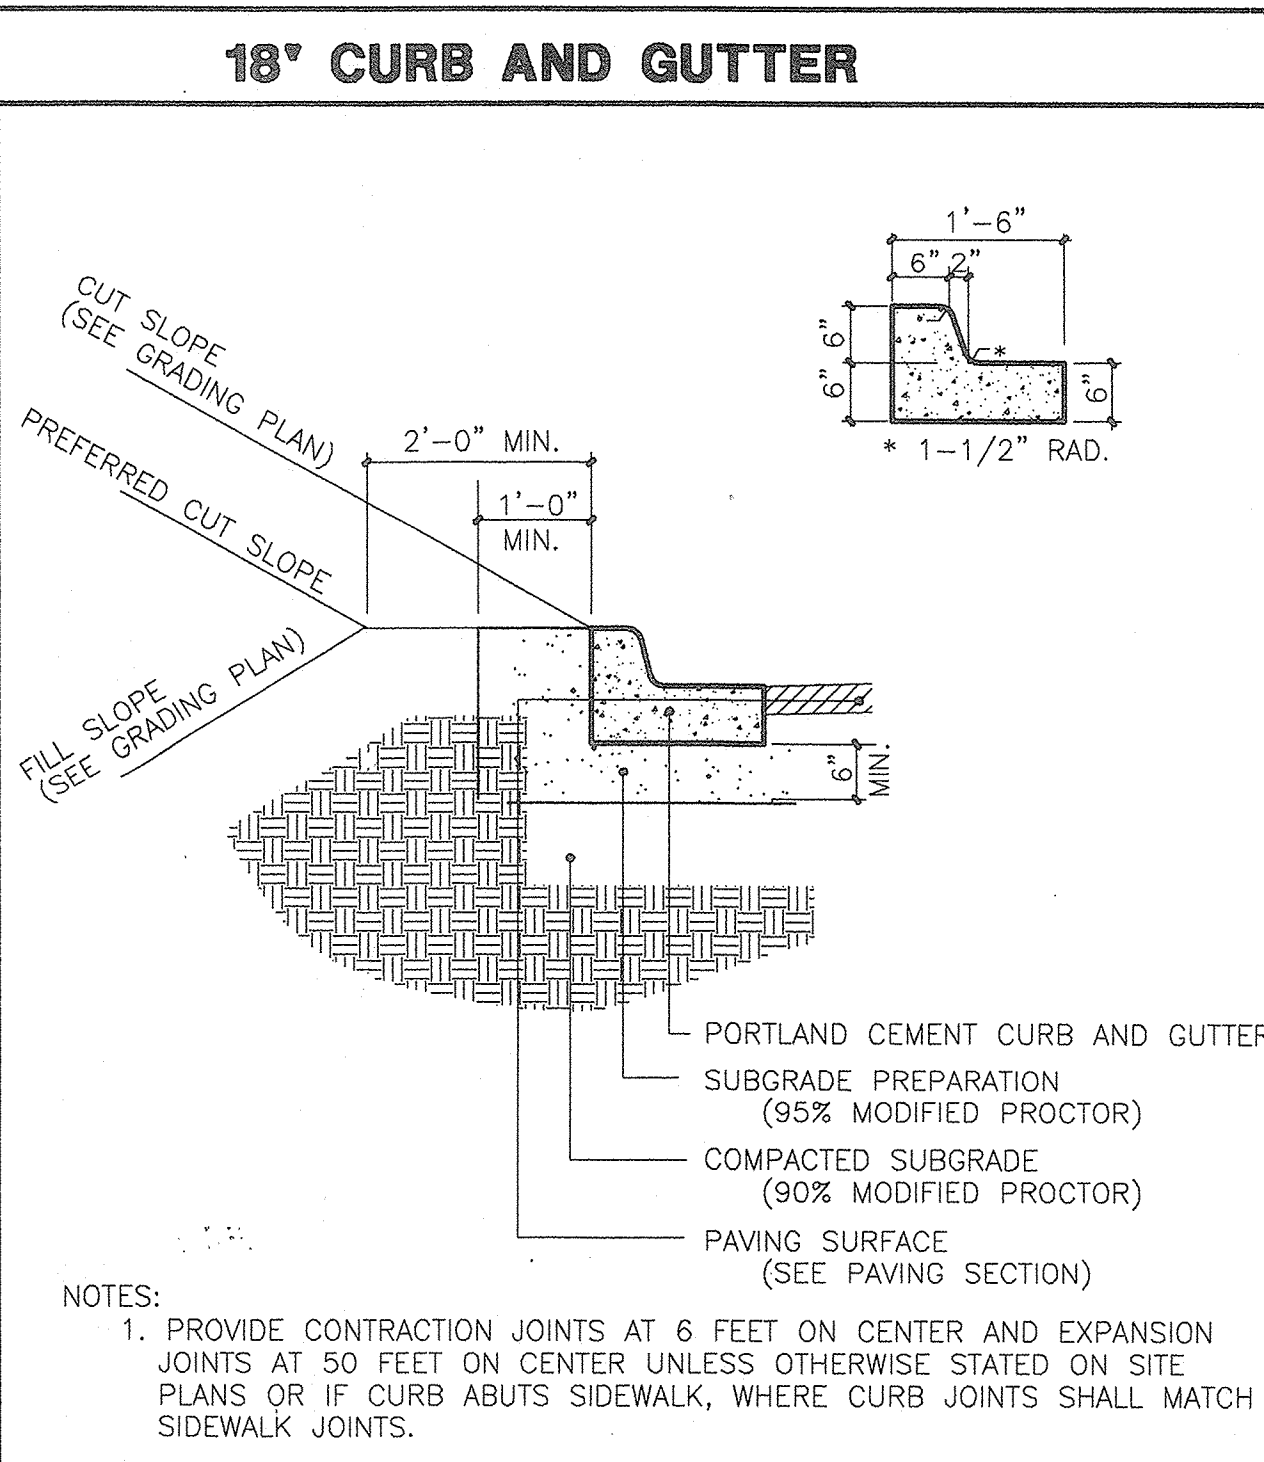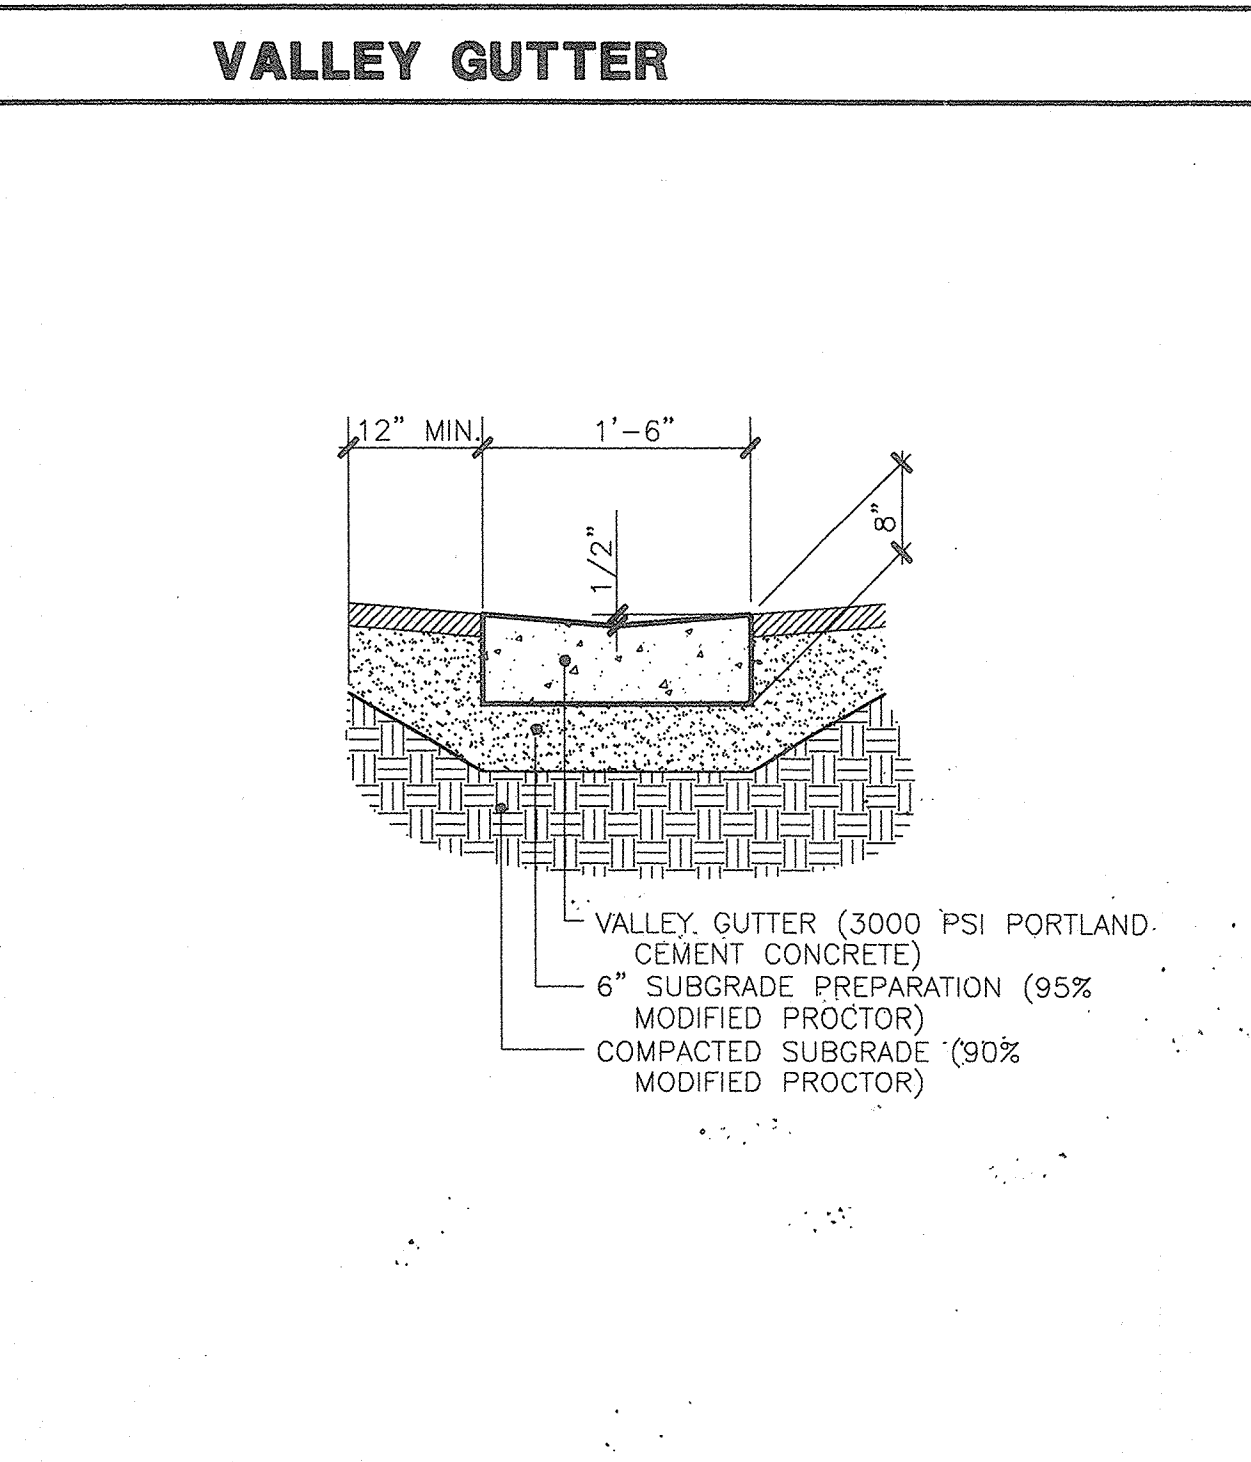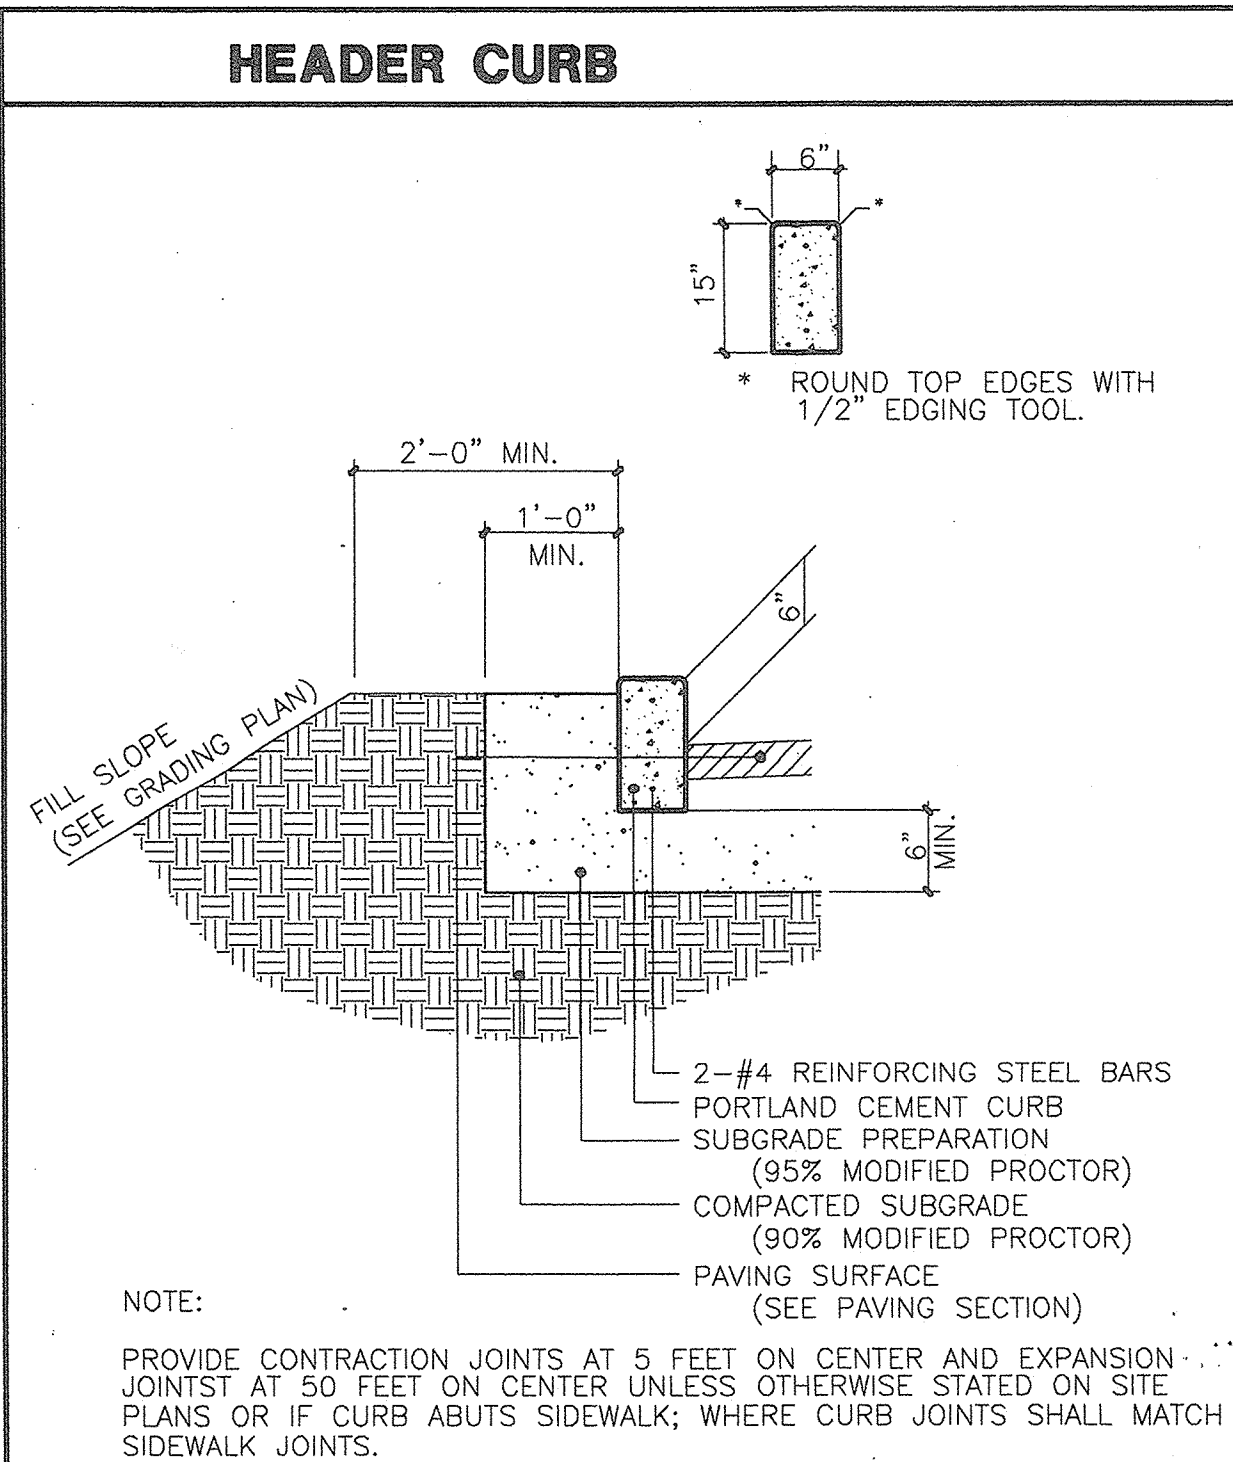

PERCENT BY VOL.	PERCENT BY VOL.
> 6"	0-5
3"-6"	40-60
1"-3"	10-30
3/8"-1"	10-15
< 3/8"	0-5

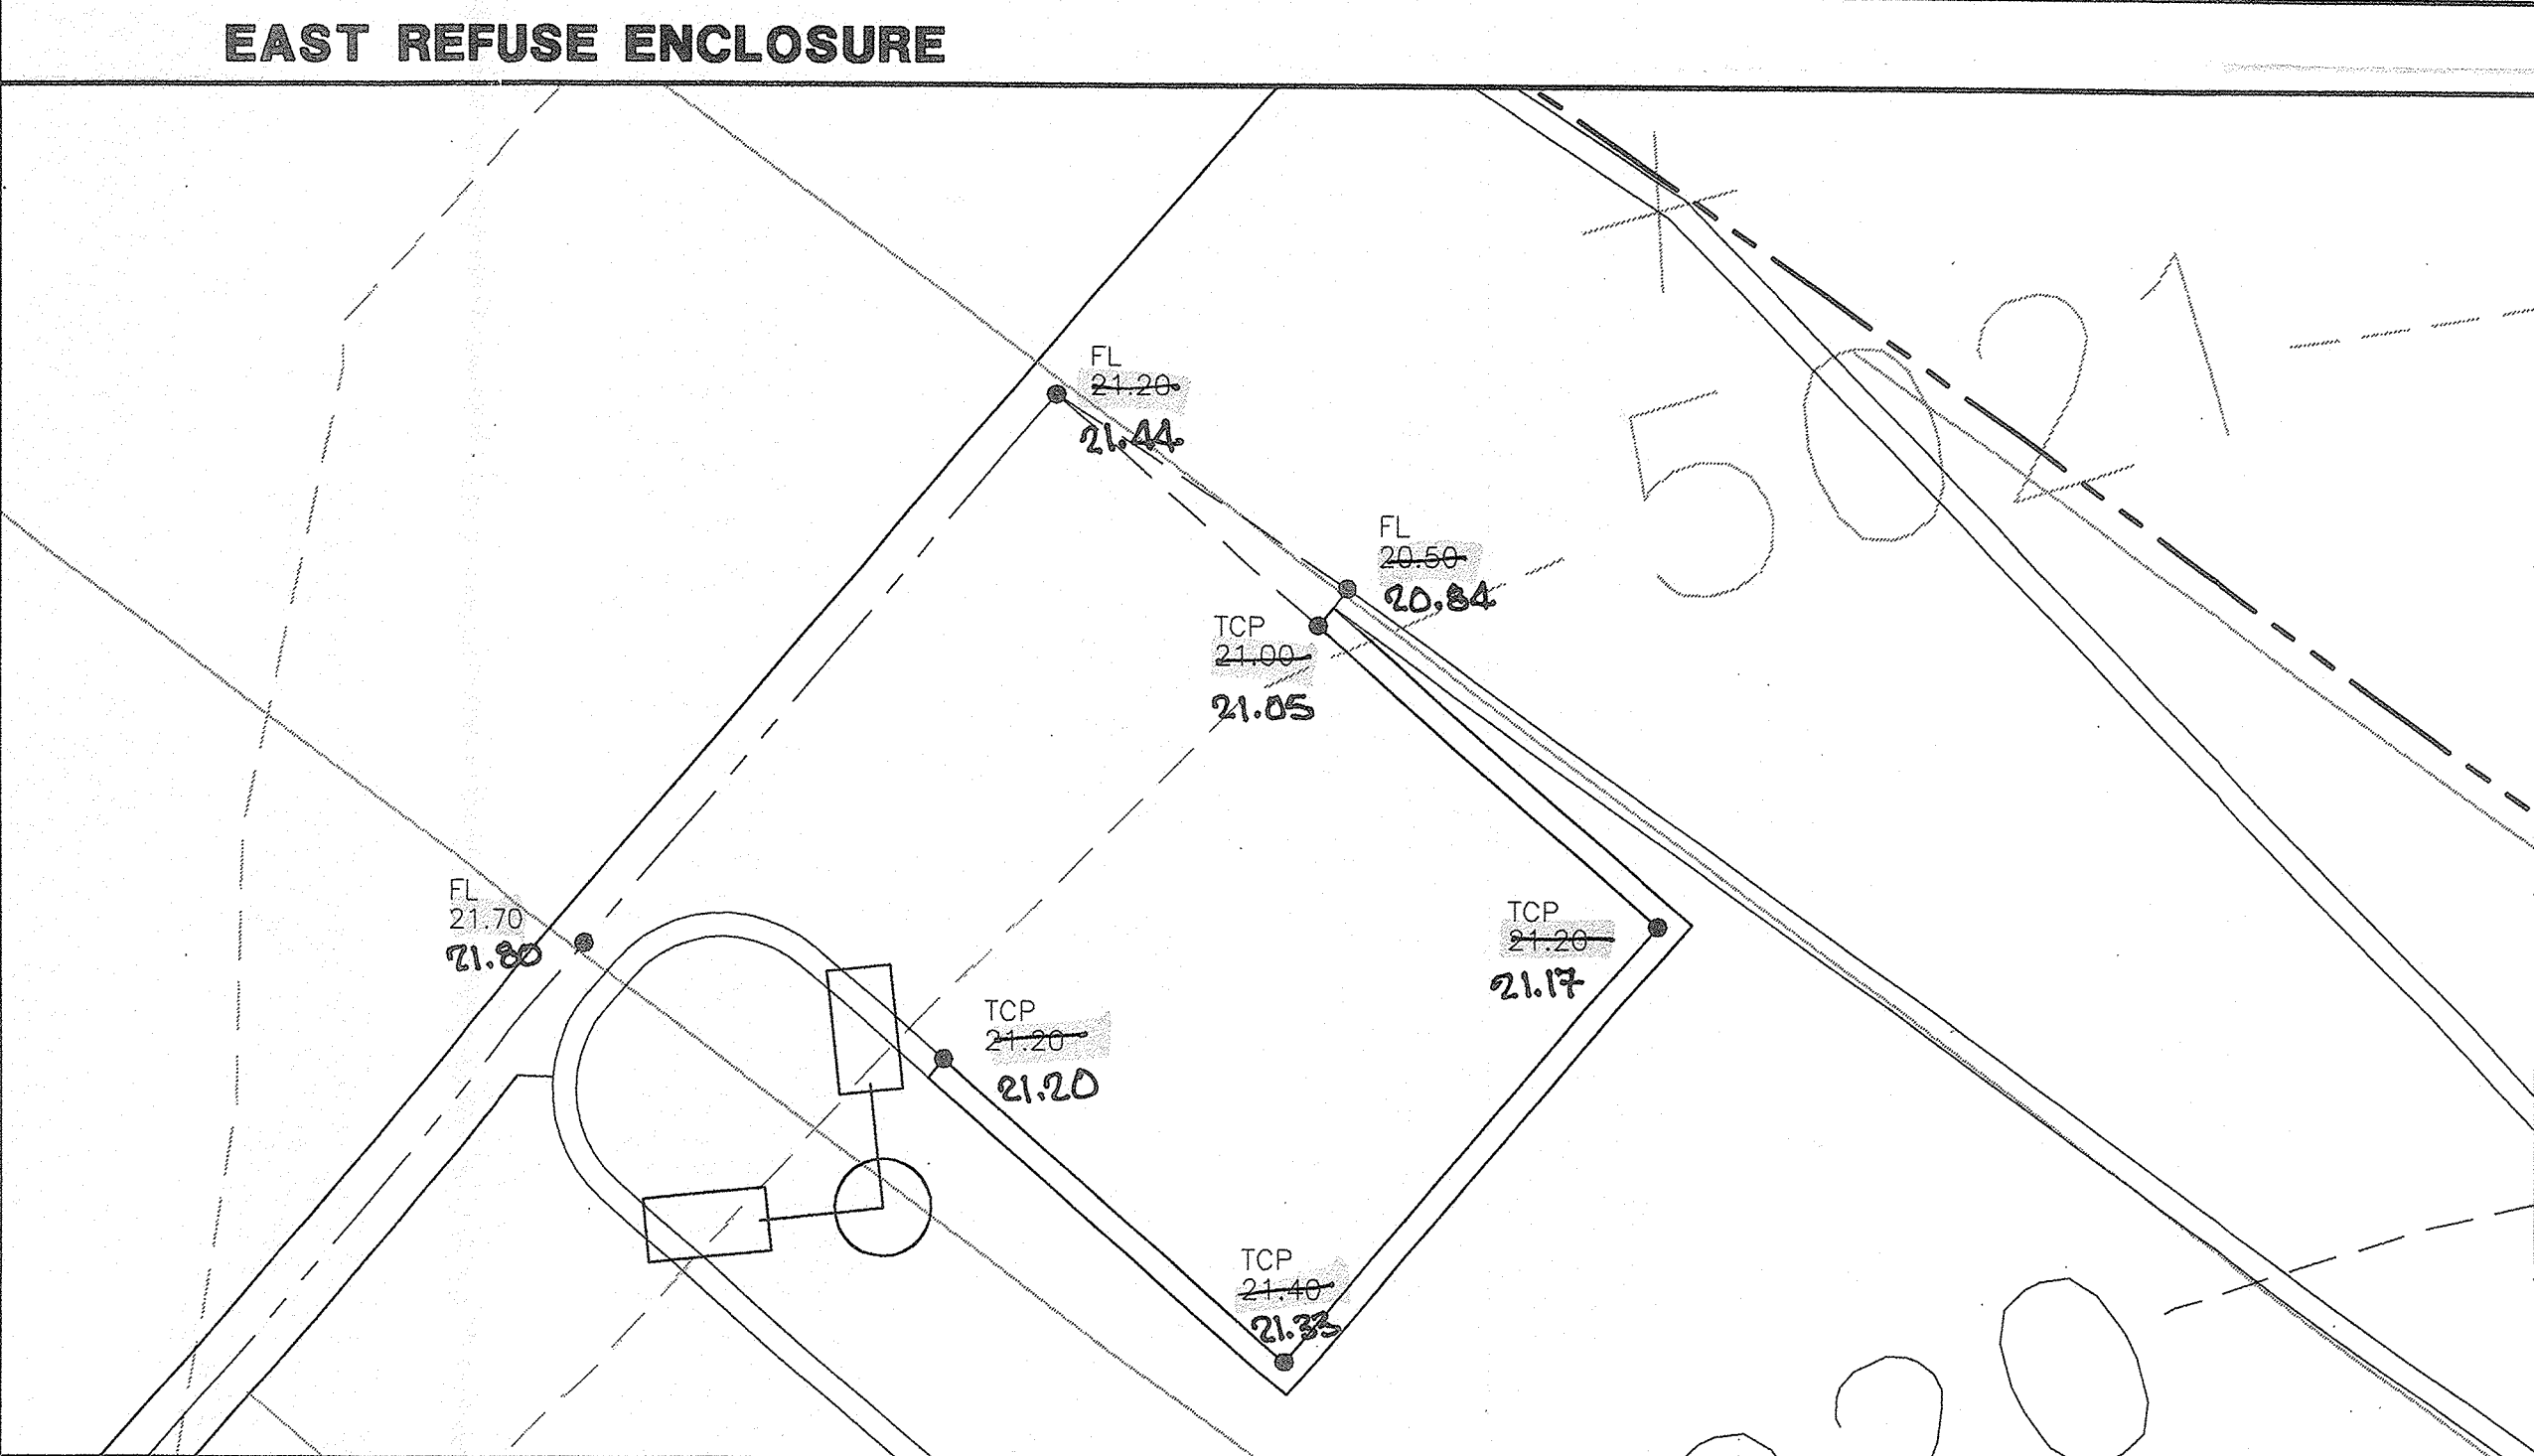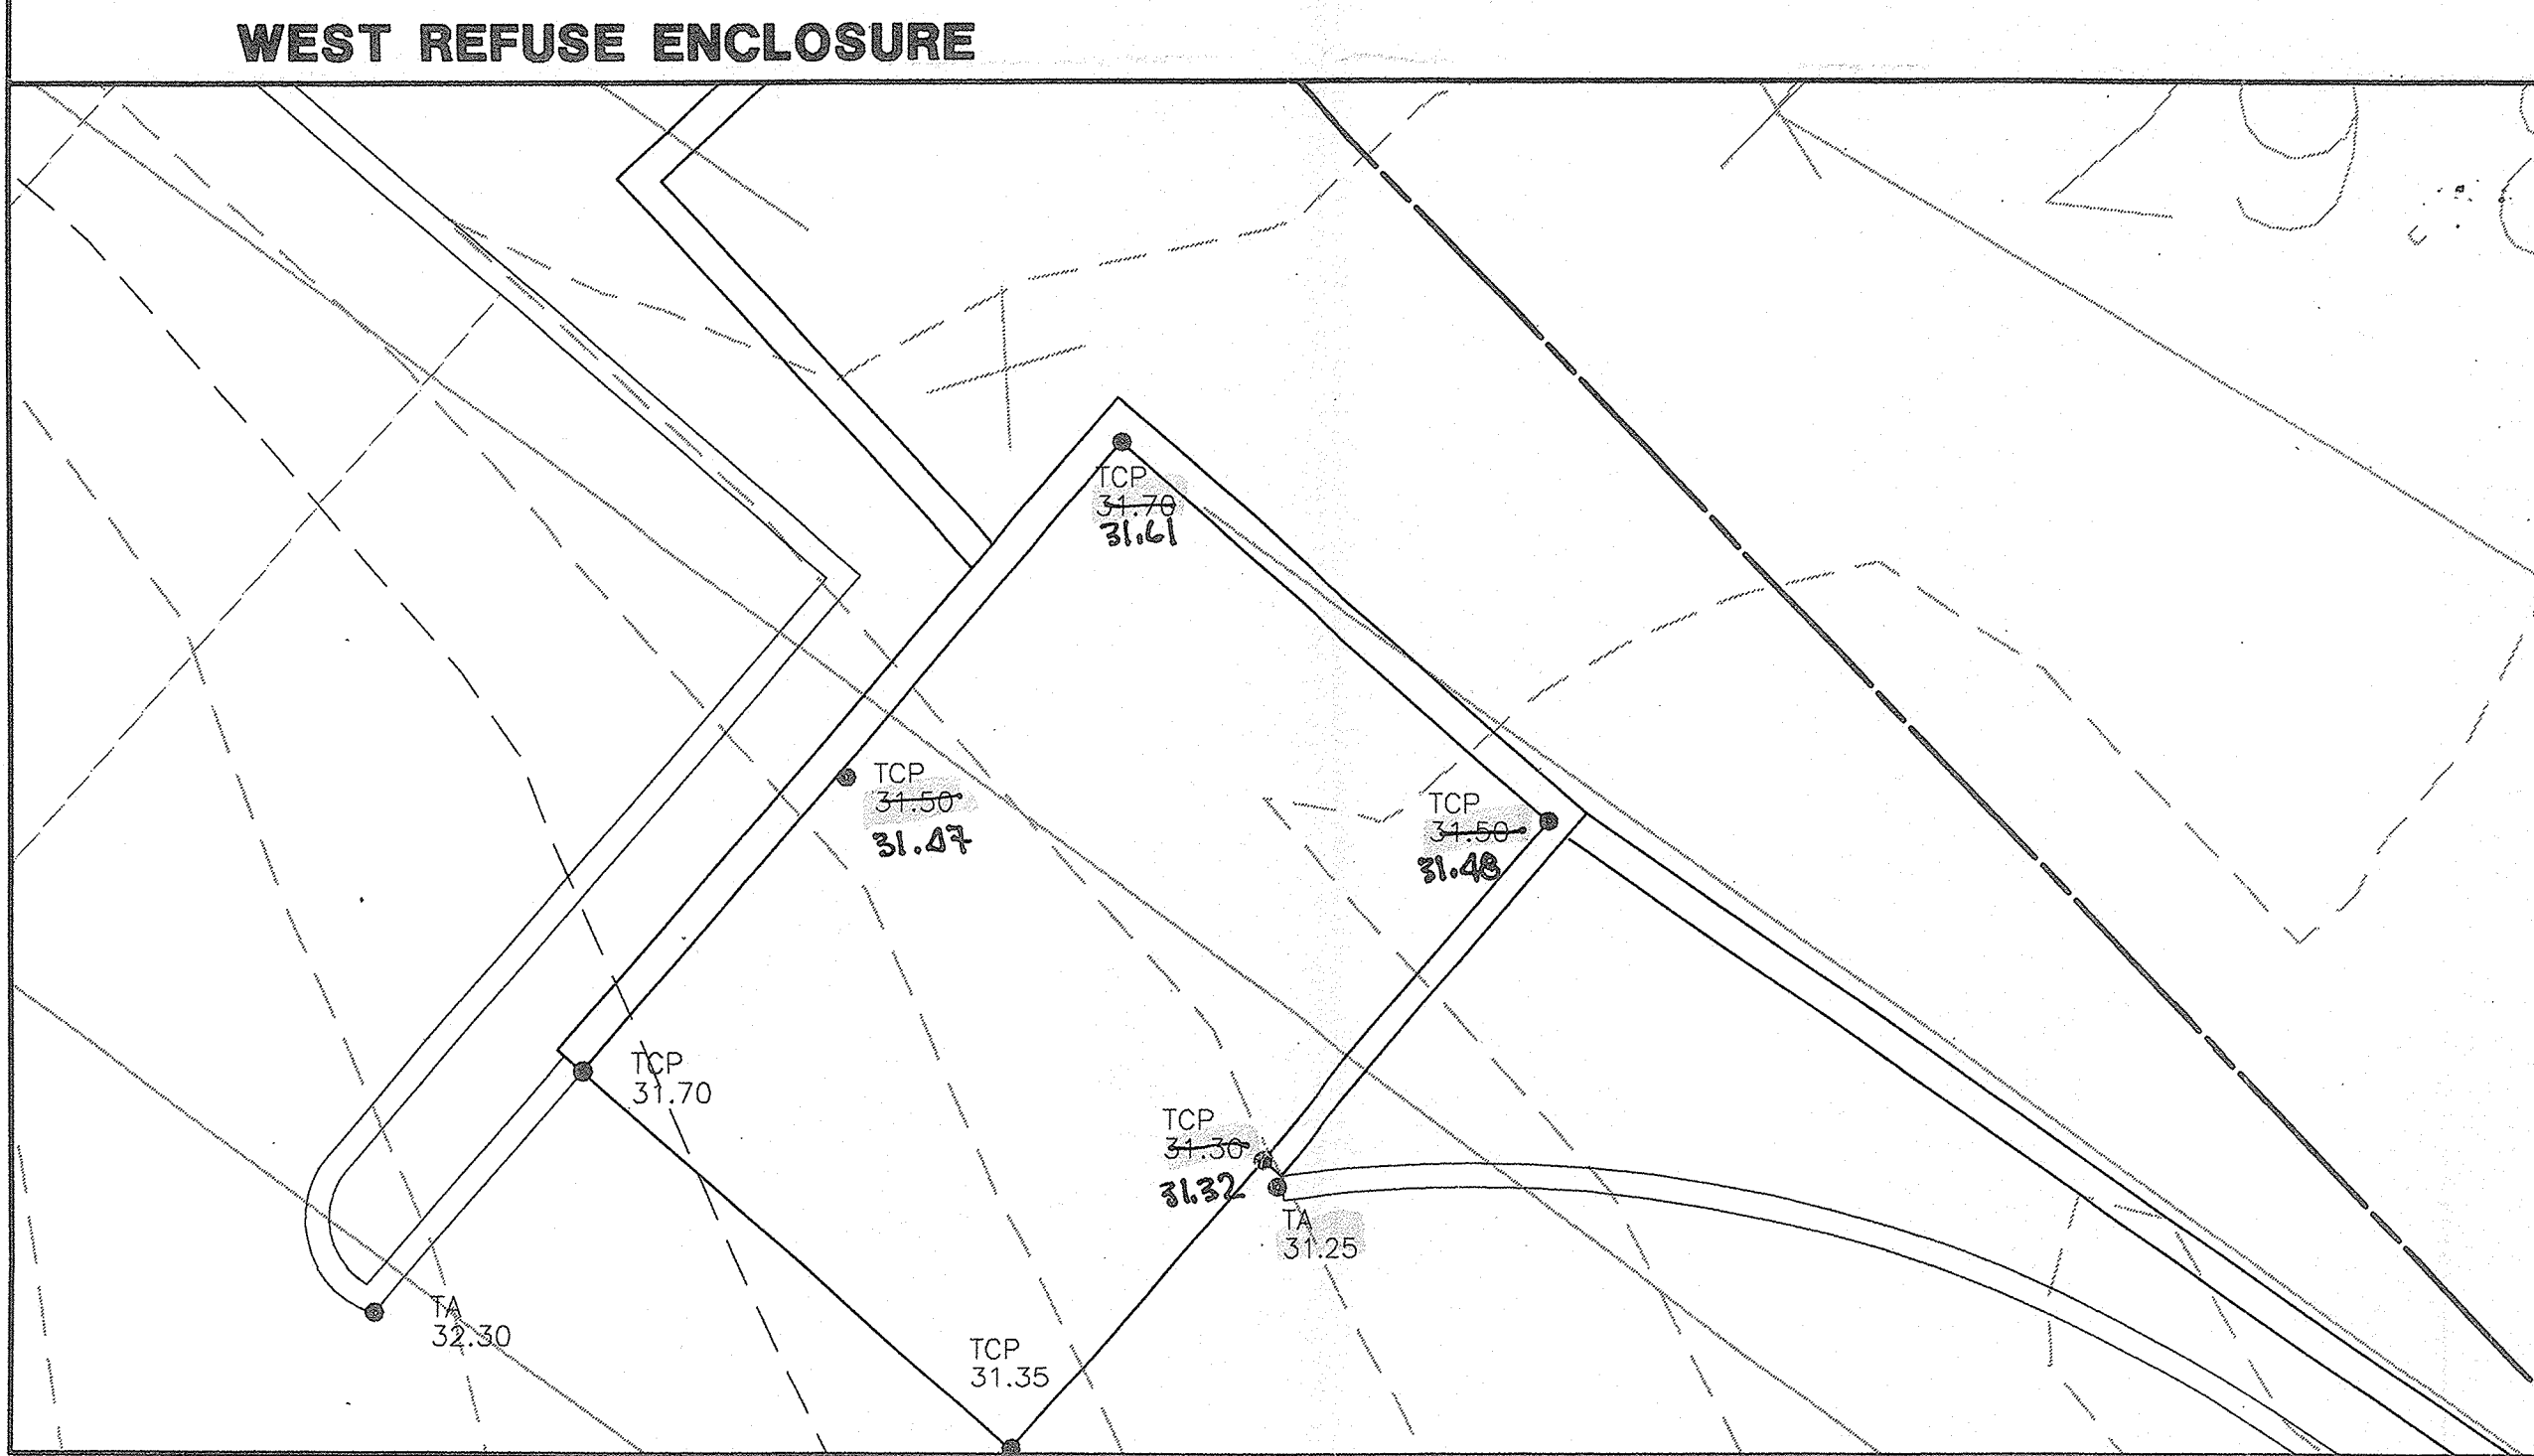[illegible]