

City of Albuquerque

P.O. BOX 1293 ALBUQUERQUE, NEW MEXICO 87103

November 13, 2001

Shahab Biazar, P.E.
Advanced Engineering & Consulting
10205 Snowflake Ct NW
Albuquerque, New Mexico 87114

RE: COPELANDS RESTAURANT PHASE 1 (B-14/D9)
(10051 Coors Blvd NW)
ENGINEERS CERTIFICATION FOR CERTIFICATE OF OCCUPANCY
ENGINEERS STAMP DATED 1/9/2001
ENGINEERS CERTIFICATION DATED 11/7/2001

Dear Mr. Biazar:


Based upon the information provided in your Engineers Certification submittal dated 11/9/2001, the above referenced site is approved for Permanent Certificate of Occupancy Phases 1 only. Engineers Certification is still required prior to issuance of Certificate of Occupancy for Phase 2 regarding this site.

If I can be of further assistance, please contact me at 924-3981.

Sincerely,

Teresa A. Martin
Hydrology Plan Checker
Public Works Department
BUB

C: Vickie Chavez, COA
approval file
✓ drainage file

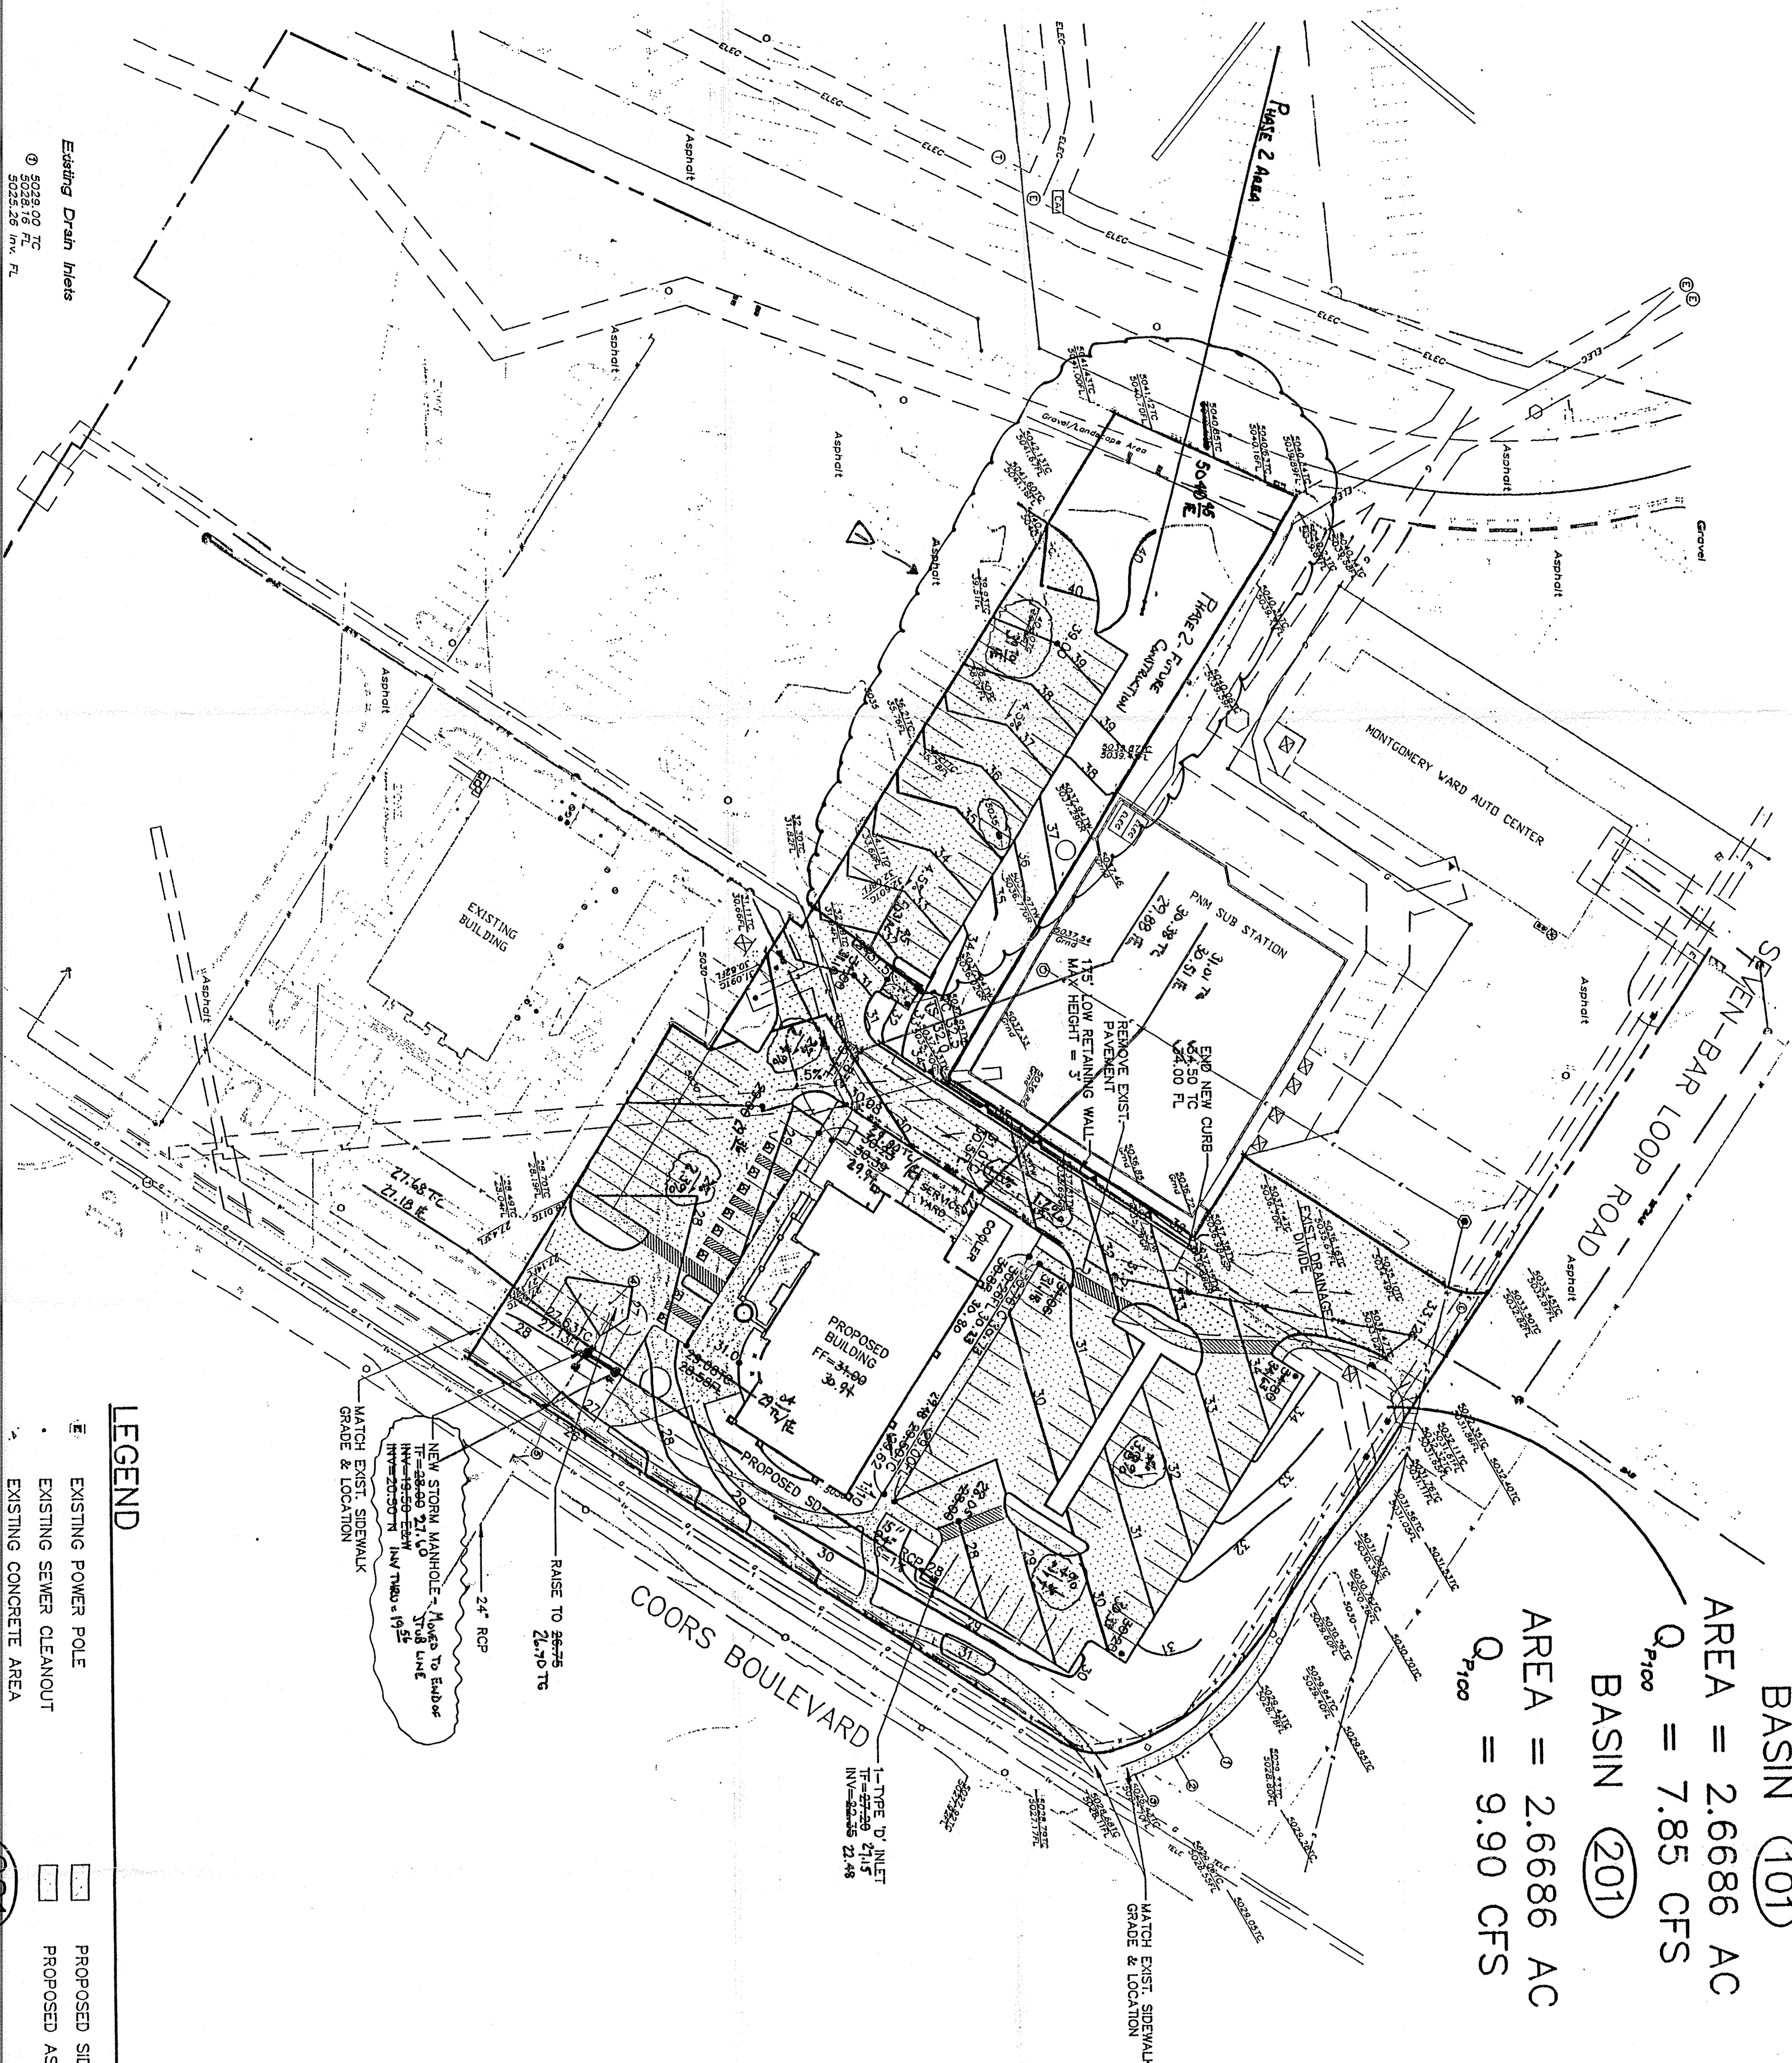

BASIN (101)
AREA = 2.6686 AC
 $Q_{700} = 7.85$ CFS
BASIN (201)
AREA = 2.6686 AC
 $Q_{700} = 9.90$ CFS

DRAINAGE REPORT

Site Location: The site is located on the northwest corner of Seven-Bar Loop Road and Coors Boulevard NW, more particularly described as Tract 12B, Questa Del Rio, Albuquerque, New Mexico.

Methodology: Section 22.2 Part A of the City of Albuquerque DPM was employed in the analysis for peak rate discharge and volumetric runoff. The 100-year frequency, 6-hour event design storm was applied. The site is located in Zone 1.




Existing Conditions. The total area of the property is 2,668 acres. The terrain is uncompacted soil with native vegetation. The site slopes from north to south with varying slopes ranging from 3% to 12% grades. Flows are conveyed via a catch basin located in the southern corner of lot 12B, this catch basin drains into a 24" catch basin that connects to a catch basin located on Coors Boulevard NW. This system connects a 60" RCP culvert that crosses under Coors Boulevard NW. Table 1 provides a breakdown of existing lot treatments, volumetric runoff, and peak discharge.

Basin	Treatment					V ₅₀₀ (ac-ft)	Q _p (cfs)
	Area (ac)	%A	%B	%C	%D		
101	2.6686	0	0	95.56	4.74	0.2304	7.85

Promoted Conditions: The site will be developed into a restaurant. The proposed site improvements will not alter the existing basin boundary, thereafter named Basin 210. The proposed restaurant will feature approximately 10,620 FT² of floor space, 72,263 FT² of paving, and the remaining area for landscaping and bare grading.

Basin	Treatment				V_{gas} (ac-ft)	Q_{p} (cfs)
	%A	%B	%C	%D		
201	2.6656	0	28.24	0	0.5365	9.90

Conclusions: Existing site conditions yield a peak volumetric runoff of 0.2504 acre-ft, which is discharged into an existing underground storm drain. Proposed improvements will increase total volumetric runoff to 0.3565 acre-ft. The existing 24" RCP Culvert it will more than adequate for the increased amount of flow that will be produced from developing this site.

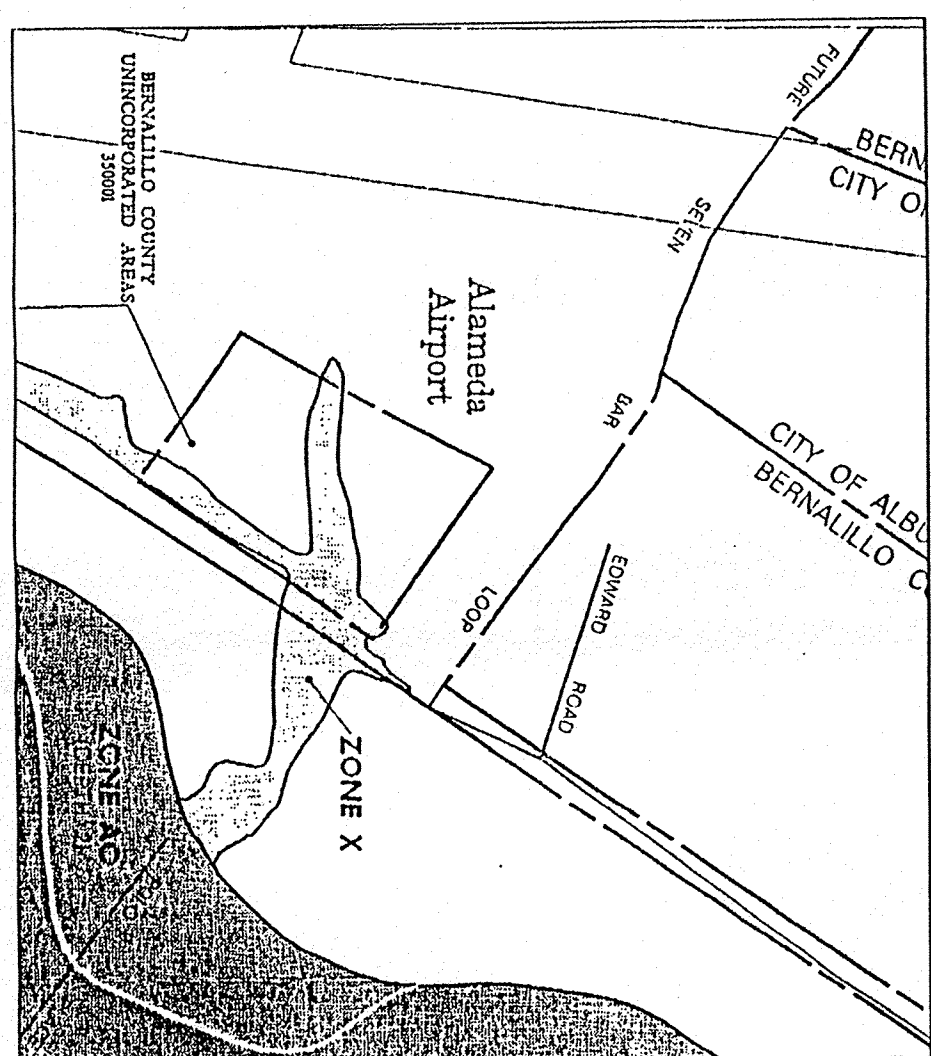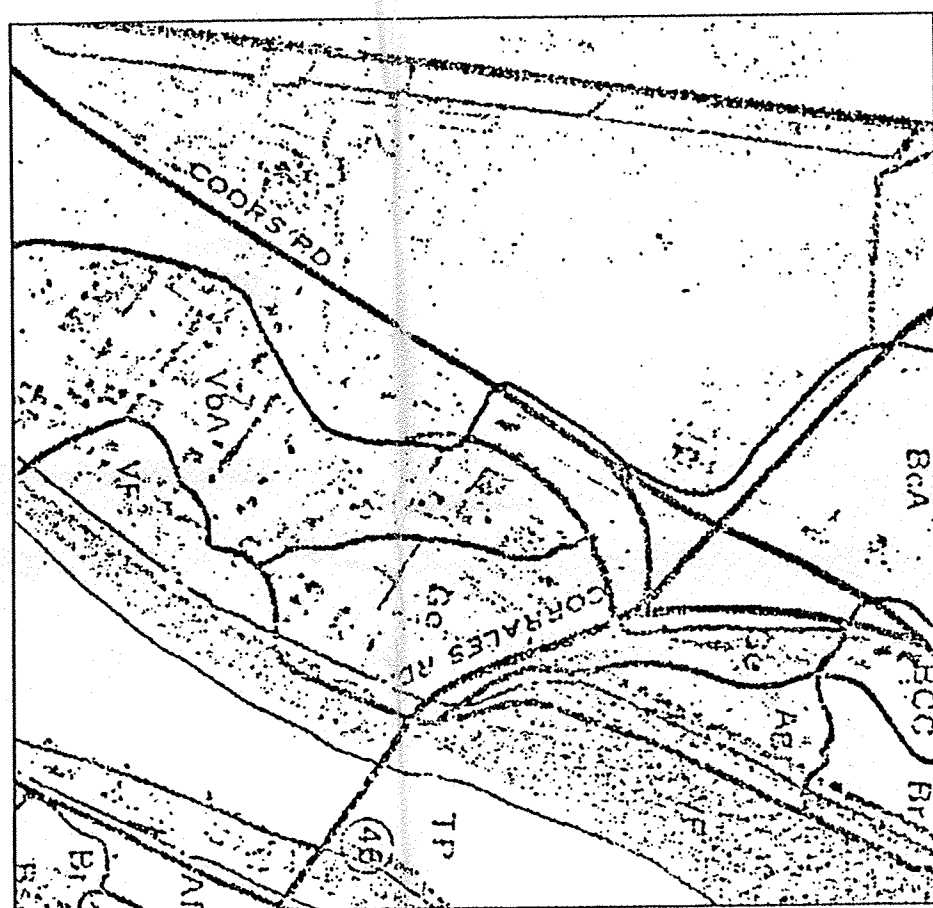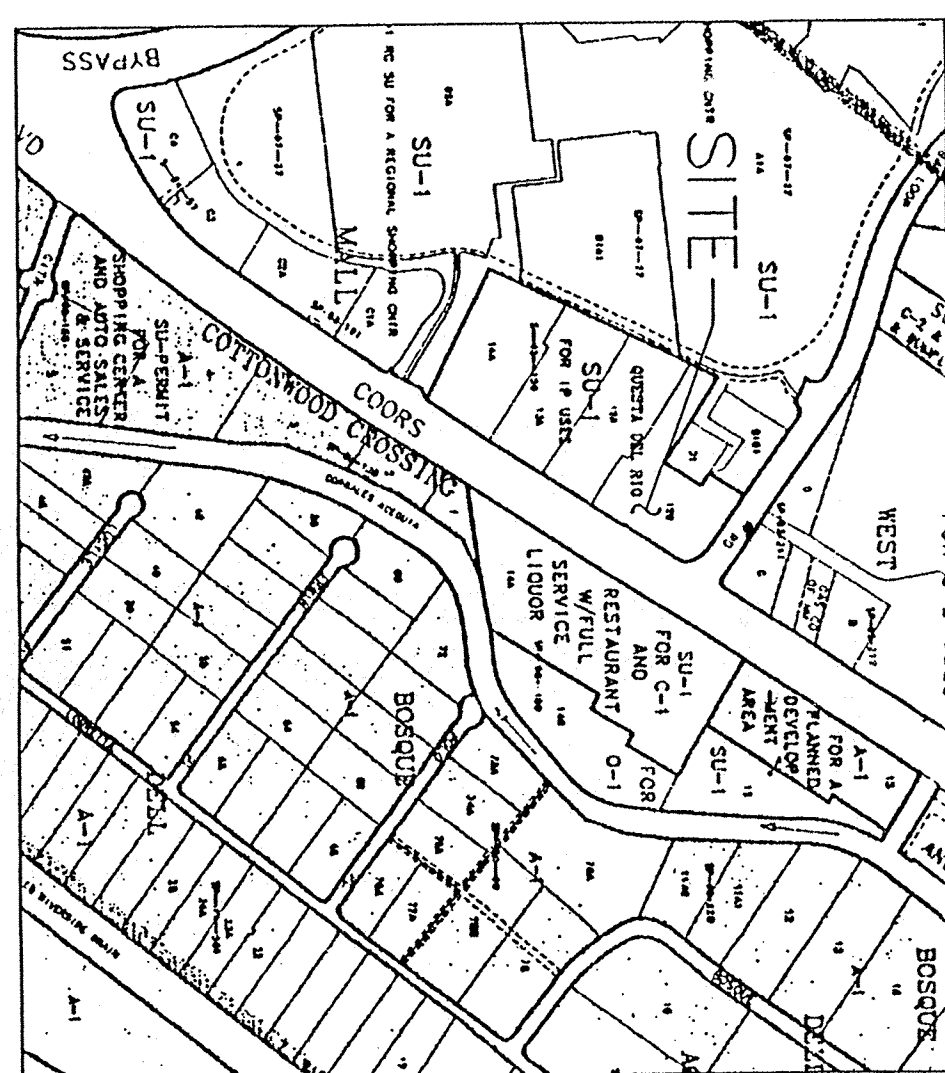

REFERENCE: FLOOD INSURANCE STUDY
PANEL 109

PANEL

RECEIVED
NOV 09 2001
HYDROLOGY SECTION

PROJECT: NEW COPELAND'S RESTAURANT
100051 COORS NORTH WEST
ALBUQUERQUE, NEW MEXICO

OWNER: CAJUN WEST INVESTMENTS
616 NORTH CAROLIN AVENUE
NEW ORLEANS, LOUISIANA 70119

APPROVED GRADING & DRAINAGE PLAN
THIS SHEET FOR INFORMATION ONLY – NOT FOR CONSTRUCTION

A P E C O T & C O M P A N Y
r c h i t e c t
300 RUE BEAUREGARD, BLDG. D, LAFAYETTE, LOUISIANA 70508
(337) 264-1874 *** FAX (337) 234-5000 *** E-MAIL pecot301@aol.com

THE PLANS AND DESIGNS
CONTAINED HEREIN ARE
SUBJECT TO PROTECTION
UNDER THE AIA GENERAL
CONDITIONS, AND CANNOT
BE USED, REPRODUCED, OR
CHANGED IN ANY WAY
WITHOUT THE EXPRESSED
WRITTEN PERMISSION OF
PECOT & COMPANY ARCHITECT.

REVISIONS:		
NO.	DATE:	DESCRIPTION

SHEET NUMBER

DATE: 1/10/01

**EASTERLING
& ASSOCIATES**
A DIVISION OF
**WILSON
JOHNSON**
2600 AMERICAN ROAD S.E. SUITE 1000
ALBUQUERQUE, NEW MEXICO
87124
(505) 898-8021

1555

NM-448-N12 CENTRAL ZONE (NAD 27
Y = 1528 910 94'

X = 381,108.54
ELEV = 5,023.41' (SLD 1929)

LEGAL

RANGE 3 EAST, NM PRINCIPAL MERIDIAN, CITY OF ALBUQUERQUE
BERNALILLO COUNTY, NM, LOTS 12-B, QUESTA DEL RIO.

ENGINEERS SEAL

T:\PROJECTS\Y0218054\M\ SHEETS\8054GD.DWG\01-02-01\CM

Swilling Drain Sheets

LEGEND	
①	EXISTING POWER POLE
②	EXISTING SEWER CLEANOUT
③	EXISTING CONCRETE AREA
④	EXISTING PLANTED AREA
⑤	EXISTING CONCRETE CURB & GUTTER
⑥	EXISTING HANDICAPPED PARKING
⑦	EXISTING UTILITY PEDESTAL
⑧	EXISTING TRAFFIC CONTROL BOX
⑨	EXISTING WATER METER
⑩	EXISTING DIRT AREA
⑪	EXISTING TRANSFORMER
⑫	EXISTING GAS METER/VALVE
⑬	EXISTING HYDRANT
⑭	EXISTING WHEELCHAIR RAMP
⑮	EXISTING WATER VALVE
⑯	EXISTING WATER MANHOLE
⑰	EXISTING TELEPHONE MANHOLE
⑱	EXISTING TELEPHONE PEDESTAL
⑲	EXISTING ROOF DRAIN
⑳	EXISTING ELECTRIC PANEL
㉑	EXISTING OVERHEAD ELECTRIC LINE
㉒	EXISTING 12" WATER LINE
㉓	EXISTING TELEPHONE LINE
㉔	EXISTING UNDERGROUND ELECTRIC LINE
㉕	EXISTING GAS LINE
㉖	EXISTING CABLE TELEVISION
㉗	EXISTING LIGHT
㉘	EXISTING FENCE
㉙	EXISTING UTILITY EXEMPT
㉚	EXISTING SPOT ELEVATION

BASIN	
PROPOSED BASIN DESIGNATION	PROPOSED SIDEWALK
	PROPOSED ASPHALT
25	PROPOSED FLOW ARROW
32.60	PROPOSED SPOT ELEVATION
32.60	DRAINAGE BASIN BOUNDARY
●	PROPOSED STORM MANHOLE
○	TOP OF CURB ELEVATION
FL	FLOWLINE ELEVATION
FF	FINISH FLOOR ELEVATION


Phase 2 - Future Construction	
①	EXISTING POWER POLE
②	EXISTING SEWER CLEANOUT
③	EXISTING CONCRETE AREA
④	EXISTING PLANTED AREA
⑤	EXISTING CONCRETE CURB & GUTTER
⑥	EXISTING HANDICAPPED PARKING
⑦	EXISTING UTILITY PEDESTAL
⑧	EXISTING TRAFFIC CONTROL BOX
⑨	EXISTING WATER METER
⑩	EXISTING DIRT AREA
⑪	EXISTING TRANSFORMER
⑫	EXISTING GAS METER/VALVE
⑬	EXISTING HYDRANT
⑭	EXISTING WHEELCHAIR RAMP
⑮	EXISTING WATER VALVE
⑯	EXISTING WATER MANHOLE
⑰	EXISTING TELEPHONE MANHOLE
⑱	EXISTING TELEPHONE PEDESTAL
⑲	EXISTING ROOF DRAIN
⑳	EXISTING ELECTRIC PANEL
㉑	EXISTING OVERHEAD ELECTRIC LINE
㉒	EXISTING 12" WATER LINE
㉓	EXISTING TELEPHONE LINE
㉔	EXISTING UNDERGROUND ELECTRIC LINE
㉕	EXISTING GAS LINE
㉖	EXISTING CABLE TELEVISION
㉗	EXISTING LIGHT
㉘	EXISTING FENCE
㉙	EXISTING UTILITY EXEMPT
㉚	EXISTING SPOT ELEVATION

201
PROPOSED BASIN DESIGNATION
BASIN

GRAPHIC SCALE


(IN FEET)

1 inch = 50 ft.



I certify that the grades shown on the plans have been built in substantial compliance with approved grading and drainage plan dated 12/1/2010. Survey information was supplied by Advanced Eng. & Consulting, LLC in accordance with normal surveying practices.

Shahab Buzari



REGISTERED PROFESSIONAL ENGINEER
NEW MEXICO
#3479