


SCANNED BY
MESA FFP-0

CITY OF ALBUQUERQUE
NEW MEXICO
MARCH 2004




1. TITLE SHEET
2. PLAT
3. PLAT
4. GRADING AND DRAINAGE PLAN
5. DETAIL SHEET
6. DETAIL SHEET
7. APPROVED MASTER UTILITY PLAN
8. PAVING, STRIPING, & SIGNAGE IMPROVEMENTS
COORS BLVD, NW STA: 11+30.40 TO STA: 20+03.31
9. STORM DRAIN IMPROVEMENTS
COORS BLVD, NW STA: 10+00 TO STA: 14+69.03

I, Ronald R. Bohanan, of the firm of Tierra West LLC, a Registered Professional Engineer in the State of New Mexico, do hereby certify, to the best of my knowledge and belief, that the infrastructure installed as part of this project has been inspected by me or by a qualified person under my direct supervision and has been constructed in accordance with the plans and specifications approved by the City Engineer and that the original design intent of the approved plans has been met, except as noted by me on the as-built construction drawings. This Certification is based on site inspections by me, or personnel under my direction with survey information provided by Russ Hugg, of Surv. Tek Inc., NMPS number 9750

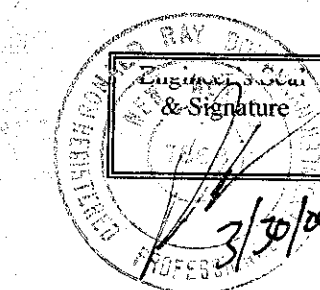

1	2	3	4	5	6	7	8	9	10	11	12	13	14	15
26		72	90	.	81								05	

DRB # 1002792

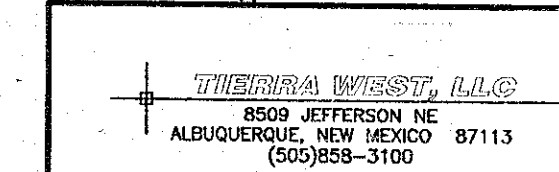

APPROVED AS RECORD DRAWING
DESIGN REVIEW SECTION
CITY CONSTRUCTION ENGINEER
DATE: 7/18/68

1/220097/2297DTITLE.DWG/MP/02-12-2004

Elevations are in NGVD 29.



VICINITY MAP ZONE ATLAS: B-14-Z

SCALE NONE

NOTICE TO CONTRACTORS

1. ALL WORK DURING THESE PLANS TO BE PERFORMED UNDER CONTRACT SHALL, EXCEPT AS OTHERWISE STATED OR PROVIDED FOR HEREON, BE CONSTRUCTED IN ACCORDANCE WITH THE CITY OF ALBUQUERQUE STANDARD SPECIFICATIONS FOR PUBLIC WORKS CONSTRUCTION, 1986 EDITION (UPDATE #7).
2. TWO WORKING DAYS PRIOR TO ANY EXCAVATION, THE CONTRACTOR MUST CONTACT NEW MEXICO ONE CALL SYSTEM (260-1990) FOR LOCATION OF EXISTING UTILITIES.
3. ANY WORK AFFECTING AN ARTERIAL ROADWAY REQUIRES 24-HOUR CONSTRUCTION.
4. PRIOR TO CONSTRUCTION, THE CONTRACTOR SHALL EXCAVATE AND VERIFY THE HORIZONTAL AND VERTICAL LOCATIONS OF ALL OBSTRUCTIONS. SHOULD A CONFLICT EXIST, THE CONTRACTOR SHALL NOTIFY THE ENGINEER OR SURVEYOR IMMEDIATELY SO THAT THE CONFLICT CAN BE RESOLVED WITH A MINIMUM AMOUNT OF DELAY.
5. SEVEN (7) WORKING DAYS PRIOR TO BEGINNING OF CONSTRUCTION, THE CONTRACTOR SHALL SUBMIT TO CONSTRUCTION COORDINATIONS DIVISION A DETAILED CONSTRUCTION SCHEDULE. TWO(2) WORKING DAYS PRIOR TO CONSTRUCTION, THE CONTRACTOR SHALL OBTAIN A BARRICADING PERMIT FROM THE CONST. COORDINATION DIVISION. CONTRACTOR SHALL NOTIFY BARRICADE ENGINEER (924-3400) PRIOR TO OCCUPANCY AN INTERSECTION. REFER TO STANDARD SPECIFICATIONS.
6. ALL STREET SIGNAGE ALTERED OR DESTROYED SHALL BE REPLACED WITH PLASTIC REFLECTORIZED PAVEMENT MARKINGS BY THE CONTRACTOR TO LOCATION AS EXISTING OR AS INDICATED BY THIS PLAN SET.
7. CONTRACTOR SHALL NOTIFY THE ENGINEER NOT LESS THAN SEVEN (7) DAYS PRIOR TO STARTING WORK IN ORDER THAT THE ENGINEER MAY TAKE NECESSARY MEASURES TO INSURE THE PRESERVATION OF SURVEY MONUMENTS. CONTRACTOR SHALL NOT DISTURB PERMANENT SURVEY MONUMENTS WITHOUT THE CONSENT OF THE ENGINEER AND SHALL NOTIFY THE ENGINEER AND BEAR THE EXPENSE OF REPLACING ANY THAT MAY BE DISTURBED WITHOUT PERMISSION. REPLACEMENT SHALL BE DONE ONLY BY THE CITY SURVEYOR. WHEN A CHANGE IS MADE IN THE FINISHED ELEVATIONS OF THE PAVEMENT OF ANY ROADWAY IN WHICH A PERMANENT SURVEY MONUMENT IS LOCATED, CONTRACTOR SHALL, AT HIS OWN EXPENSE, ADJUST THE MONUMENT TO THE NEW GRADE, UNLESS OTHERWISE SPECIFIED. REFER TO SECTION 4.4 OF THE GENERAL CONDITIONS OF THE STANDARD SPECIFICATIONS. ANY PERMANENT SURVEY MONUMENT LOCATED WITHIN 50' OF THIS PROJECT THAT IS NOT SHOWN ON THE PLAN AND IS DESTROYED DURING CONSTRUCTION WILL BE REPLACED AT THE DESIGNERS EXPENSE.
8. CONTRACTOR SHALL MAINTAIN A GRAFFITI-FREE WORK SITE. CONTRACTOR SHALL PROMPTLY REMOVE ANY AND ALL GRAFFITI FROM EQUIPMENT, WHETHER PERMANENT OR TEMPORARY.
9. ALL UTILITY WORK SHALL BE CONSTRUCTED IN ACCORDANCE WITH NEW MEXICO UTILITIES, INC. SPECIFICATIONS FOR WATER AND WASTEWATER FACILITIES (MOST RECENT REVISIONS).
10. THE CONTRACTOR SHALL NOTIFY NEW MEXICO UTILITIES (888-2661) FIVE(5) WORKING DAYS PRIOR TO BEGINNING OF THE CONSTRUCTION OF THE UTILITIES.
11. FOR STORM DRAIN CONSTRUCTION, RCP PIPE JOINTS SHALL NOT BE GROUTED PRIOR TO FINAL INSPECTION. FINAL INSPECTION WILL DETERMINE JOINTS TO BE GROUTED FOR FINAL ACCEPTANCE OF THE CONSTRUCTION.

THE FOLLOWING NOTES ALSO APPLY WHEN CHECKED

☒ ALL UTILITIES AND UTILITY SERVICE LINES SHALL BE INSTALLED PRIOR TO PAVING.

☒ BACKFILL COMPACTION SHALL BE ACCORDING TO SPECIFIED STREET USE.


☒ TACK COAT REQUIREMENTS SHALL BE DETERMINED BY THE PROJECT ENGINEER.

☒ SIDEWALKS AND WHEELCHAIR RAMPS WITHIN THE CURB RETURNS SHALL BE CONSTRUCTED WHEREVER A NEW CURB RETURN IS CONSTRUCTED.

☐ IF CURB IS DERESSED FOR A DRIVEPAV, THE DRIVEPAV SHALL BE CONSTRUCTED PRIOR TO ACCEPTANCE OF CURB AND GUTTER.

☒ ALL STORM DRAINAGE FACILITIES SHALL BE COMPLETED PRIOR TO FINAL ACCEPTANCE.

[illegible]

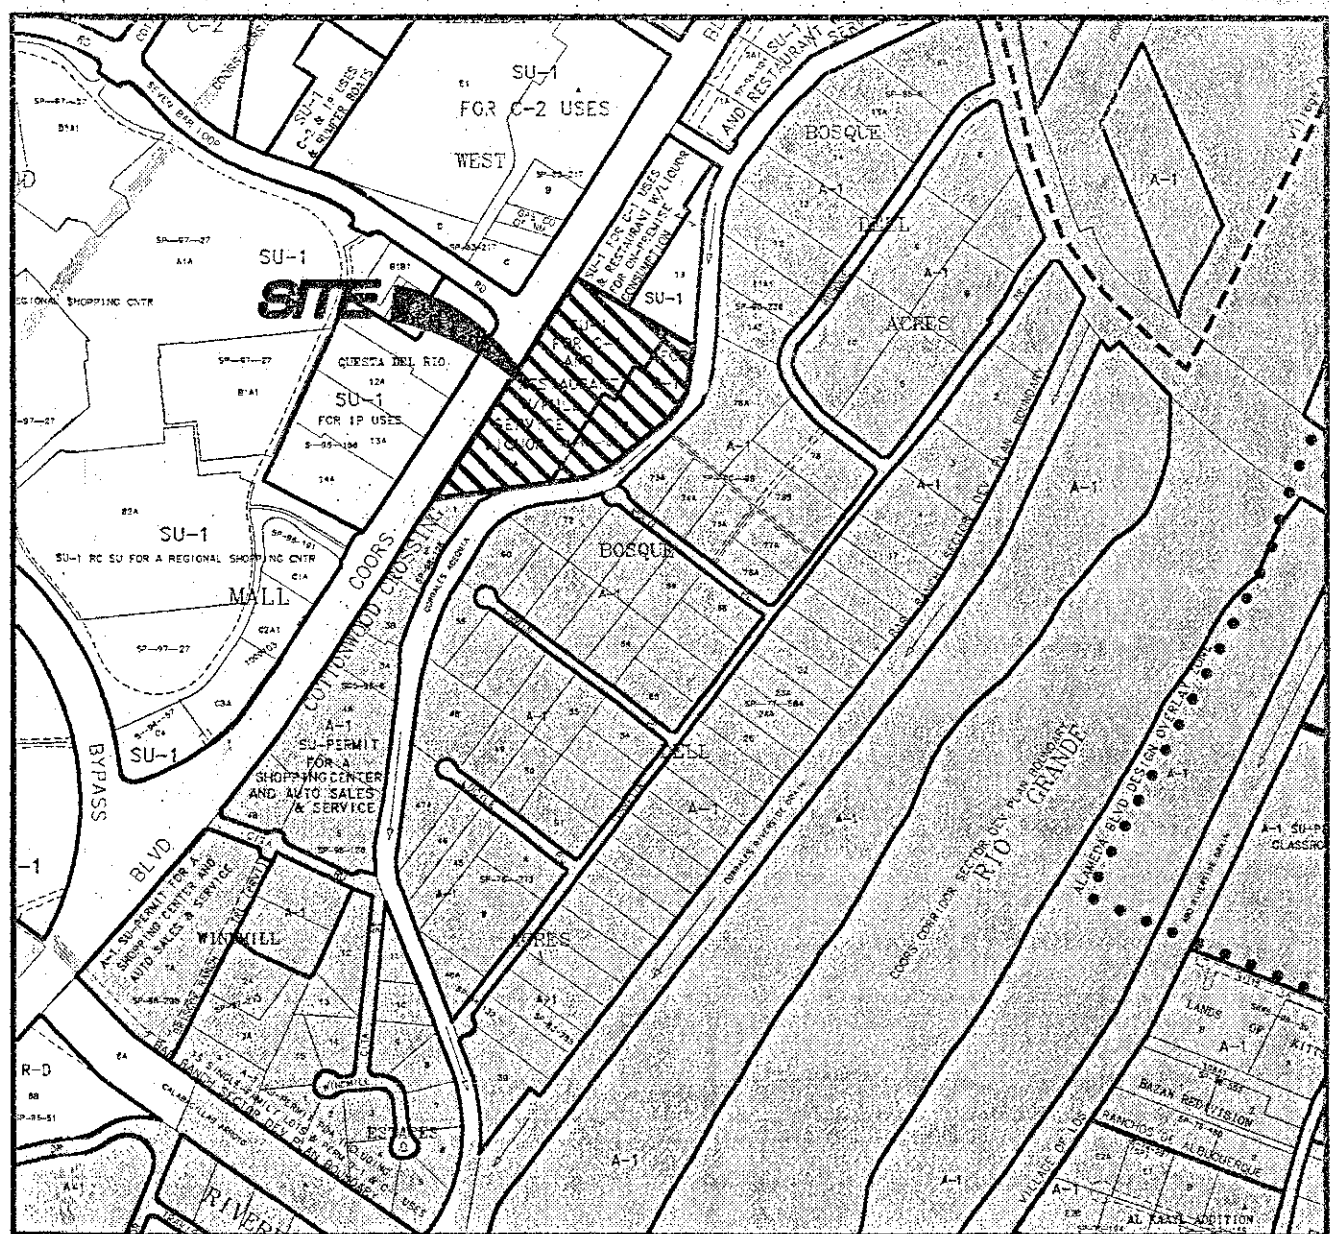

VICINITY MAP
N.T.S.

SUBDIVISION DATA

1. City of Albuquerque Zone Atlas Page: B-14-Z
2. U.C.L.S. Log Number 2003461539
3. Total number of existing tracts: 2
4. Total number of new lots created: 6
5. Gross subdivision acreage: 9.7690 acres
6. Total mileage of full width streets created: 0.00 miles

NOTE

Said Lots 1, 2, 3, 4, 5 and 6 are subject to that certain "Reciprocal Easement Agreement", filed in the office of the County Clerk of Bernalillo County, New Mexico on the 21st day of October, 1996, in Book BCR 96-26, Pages 2764-2777, as Document No. 96115257. See Sheet 4 of 4 for Additional Restrictions.

NOTE


These properties lie within the New Mexico Utilities, Inc. (NMU, Inc.) Franchise area. Water and Sanitary Sewer capabilities are based upon the NMU, Inc. facilities, not the City of Albuquerque.

DISCLOSURE STATEMENT

The purpose of this plat is to create 6 new lots. Grant City of Albuquerque sidewalk, public water line, public sanitary sewer line, public storm sewer, private cross access, public overhead and dry utility easements. Vacate existing easements as shown hereon.

SHEET INDEX

- SHEET 1 - Approvals
SHEET 2 - Legal Description, General Notes
SHEET 3 - New Lot Boundaries and Existing Easements
Vacated by O3DRB-01780VPE
SHEET 4 - New Easements Granted by this Plat

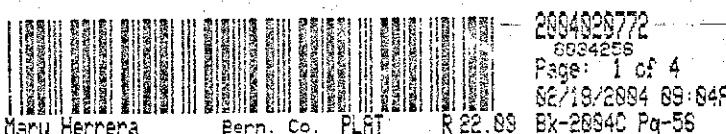

SCANNED BY
MESA REPRO

TREASURER'S CERTIFICATION

This is to certify that taxes are current and paid on the following property:

UPC# 101406519031820301 TRACT 14-A, BLACK RANCH
UPC# 101406522431320303 TRACT 14-B, BLACK RANCH

[Signature]
Bernalillo County Treasurer's Office Date 2/17/04

PUBLIC UTILITY EASEMENTS

PUBLIC UTILITY EASEMENTS shown on this plat are granted for the common and joint use of:

- A. PNM Electric Services for installation, maintenance and service of underground electrical lines, transformers and other equipment and related facilities reasonably necessary to provide electrical service.
- B. PNM Gas Services for installation, maintenance and service of, natural gas lines, valves and other equipment and facilities reasonably necessary to provide natural gas service.
- C. QWest Corporation for installation, maintenance and service of such lines, cable and other related equipment and facilities reasonably necessary to provide communication services, including but not limited to, ground pedestals and closures.
- D. Comcast Digital Cable for the installation, maintenance and service of such lines, cable and other related equipment and facilities reasonably necessary to provide Cable TV service.
- E. New Mexico Utilities, Inc. for the installation, maintenance, and service of such lines across the easement and related equipment and facilities reasonably necessary to provide Sanitary Sewer and Water Service.

Included, is the right to build, rebuild, construct, reconstruct, locate, relocate, change, remove, modify, renew, operate, and maintain facilities for the purposes described above, together with free access to, from, and over said easements, including sufficient working area space for electric transformers, with the right and privilege to trim and remove trees, shrubs or bushes which interfere with the purposes set forth herein. No building, sign, pool (aboveground or subsurface), hot tub, concrete or wood pool decking, or other structure shall be erected or constructed on said easements, nor shall any well be drilled or operated thereon. Property owners shall be solely responsible for correcting any violations of National Electrical Safety Code by construction of pools, decking, or any structures adjacent to or near easements shown on this plat.

Easements for electric transformers/switchgears, as installed, shall extend ten feet (10') in front of transformer/switchgear doors and five feet (5') on each side.

DISCLAIMER

In approving this plat, PNM Electric Services and PNM Gas Services did not conduct a Title Search of the properties shown hereon. Consequently, PNM does not waive nor release any easement or easement rights to which it may be entitled.

LOTS 1, 2, 3, 4, 5 AND 6 COTTONWOOD CROSSING, PHASE II

(BEING A REPLAT OF TRACTS 14-A AND 14-B, BLACK RANCH)

WITHIN
THE TOWN OF ALAMEDA GRANT
IN
PROJECTED SECTION 8, TOWNSHIP 11 NORTH, RANGE 3 EAST
NEW MEXICO PRINCIPAL MERIDIAN
CITY OF ALBUQUERQUE
BERNALILLO COUNTY, NEW MEXICO
NOVEMBER, 2003

PROJECT NUMBER 1002792

Application Number: 04-00184

PLAT APPROVAL

Utility Approvals:

[Signature] 12-22-03
PNM Electric Services Date
[Signature] 12-22-03
PNM Gas Services Date
[Signature] 12-19-03
QWest Corporation Date
[Signature] 2-10-04
Comcast Date
[Signature] 2-10-04
New Mexico Utilities Date


City Approvals:

[Signature] 12-8-03
City Surveyor Date
N/A
Real Property Division Date
N/A
Environmental Health Department Date
[Signature] 2-18-04
Traffic Engineering, Transportation Division Date
[Signature] 2-18-04
Utilities Department Date
[Signature] 2/18/04
Parks and Recreation Department Date
[Signature] 2-13-04
AMAFCA Date
[Signature] 2/18/04
City Engineer Date
[Signature] 2/13/04
DRB Chairperson, Planning Department Date

SURVEYOR'S CERTIFICATION

I, Russ P. Hugg, New Mexico Professional Surveyor Number 9750, hereby certify that this plat of survey was prepared from field notes of an actual ground survey performed by me or under my supervision; that it meets the Standards for Land Surveys in New Mexico as adopted by the New Mexico State Board of Registration for Professional Engineers and Professional Surveyors; that it meets the minimum requirements for surveys and monumentation of the Albuquerque Subdivision Ordinances; that it shows all easements of record; and that it is true and correct to the best of my knowledge and belief.

[Signature]
Russ P. Hugg
NMPS No. 9750
November 26, 2003

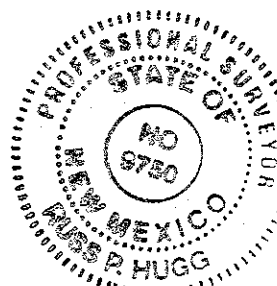

SURVOTEK, INC.

Consulting Surveyors
5645 Paradise Blvd. N.W. Albuquerque, New Mexico 87114 Phone: 505-897-5566
Fax: 505-897-3377

SHEET 1 OF 4



LOTS 1, 2, 3, 4, 5 AND 6 COTTONWOOD CROSSING, PHASE II

(BEING A REPLAT OF TRACTS 14-A AND 14-B, BLACK RANCH)

WITHIN
THE TOWN OF ALAMEDA GRANT
IN
PROJECTED SECTION 8, TOWNSHIP 11 NORTH, RANGE 3 EAST
NEW MEXICO PRINCIPAL MERIDIAN
CITY OF ALBUQUERQUE
BERNALILLO COUNTY, NEW MEXICO
NOVEMBER, 2003

GENERAL NOTES

1. Bearings are New Mexico State Plane Grid Bearings (Central Zone - NAD 1927) originated at the Albuquerque Control Survey Monument "NM448-N12".
2. Distances are ground.
3. Distances along curved lines are arc lengths.
4. Record Plat or Deed bearings and distances, where they differ from those established by this field survey, are shown in parenthesis ().
5. All corners found in place and held were tagged with a brass disk stamped "HUGG L.S. 9750" unless otherwise indicated hereon.
6. All corners that were set are either a 5/8" rebar with cap stamped "HUGG L.S. 9750" or a concrete nail with brass disk stamped "HUGG L.S. 9750" unless otherwise indicated hereon.
7. Field surveys were performed during the month of April, 2003.
8. Documents used in the preparation of this survey are as follows:
A. Plat entitled "TRACTS 14-A AND 14-B, BLACK RANCH, CITY OF ALBUQUERQUE, BERNALILLO COUNTY, NEW MEXICO, JANUARY 1998", filed June 3, 1998, in Volume 98C, Folio 157, records of Bernalillo County, New Mexico.
B. Survey entitled "BOUNDARY SURVEY PLAT, TRACTS 13 AND 14, BLACK RANCH, TOWN OF ALAMEDA GRANT, BERNALILLO COUNTY, NEW MEXICO, JUNE 1997", filed June 17, 1997, in Volume 97S, Folio 68, records of Bernalillo County, New Mexico.
C. Plat entitled "LOTS 1 THRU 5, COTTONWOOD CROSSING, TOWN OF ALAMEDA GRANT, BERNALILLO COUNTY, NEW MEXICO, FEBRUARY 1998", filed July 9, 1998, in Volume 98C, Folio 156, records of Bernalillo County, New Mexico.
D. Title Report prepared for this property by Lawyers Title Insurance Company, Commitment for Title Insurance No. 97209150, dated July 25, 1997.
9. All street centerline monumentation shall be installed at all centerline P.C.'s, P.T.'s, angle points and street intersections. All centerline monumentation will be set using the standard four (4") aluminum monument stamped "City of Albuquerque Centerline Monument - Do not disturb, PS Number 9750" and will be set flush with the final asphalt lift.
Manholes will be offset at all points of curvature, points of tangency, street intersections, and all other angle points to allow use of centerline monumentation.

AMAFCA EASEMENTS RELEASED BY SEPARATE DOCUMENT

The following easements were released by the document entitled "QUITCLAIM DEED / RELEASE OF EASEMENT" filed February 12, 2004, Book A72, Page 9151, records of Bernalillo County, New Mexico.

- A. 30' Easement for Floodway & Storm Drainage Works to A.M.A.F.C.A. filed Dec. 18, 1992, Book BCR 92-30, page 2668, vacated by O3DRB-01780VPE.
- B. Temporary Road Easement to A.M.A.F.C.A. filed May 12, 1994, Book BCR 94-15, page 4448, vacated by O3DRB-01780VPE.
- C. Albuquerque Metropolitan Arroyo Flood Control Authority Easement filed August 10, 1983, Misc. 38A, pages 64-67, vacated by O3DRB-01780VPE.

LEGAL DESCRIPTION

Tracts numbered Fourteen-A (14-A) and Fourteen-B (14-B), Black Ranch, within the Town of Alameda Grant, Projected Section 8, Township 11 North, Range 3 East, N.M.P.M., Bernalillo County, City of Albuquerque, New Mexico, the same is shown and designated on said plat, filed in the office of the County Clerk of Bernalillo County, New Mexico, on June 3, 1998, in Plat Book 98C, Folio 157.

Said parcel contains 9.7690 acres more or less.

DEDICATION

SURVEYED and REPLATTED and now comprising LOTS 1, 2, 3, 4, 5 AND 6, COTTONWOOD CROSSING, PHASE II, (BEING A REPLAT OF TRACTS 14-A AND 14-B, BLACK RANCH) WITHIN THE TOWN OF ALAMEDA GRANT, PROJECTED SECTION 8, TOWNSHIP 11 NORTH, RANGE 3 EAST, NEW MEXICO PRINCIPAL MERIDIAN, CITY OF ALBUQUERQUE, BERNALILLO COUNTY, NEW MEXICO, is with the free consent of and in accordance with the wishes and desires of the undersigned owner(s) and proprietor(s) thereof. Said owner(s) and proprietor(s) do hereby grant the easements as shown hereon and do hereby dedicate Lot 3 in fee simple with warranty covenants to the Albuquerque Metropolitan Arroyo Flood Control Authority. Said owner(s) and proprietor(s) do hereby grant the public utility easements to the use of the public forever, as shown hereon. Said owner(s) and proprietor(s) do hereby consent to all of the foregoing and do hereby certify that they are so authorized to act.

OWNER: TRACTS 14-A and 14-B, BLACK RANCH
The Albert J. Black and Mary Jane Black Revocable Trust



[Signature]
John F. Black, Trustee

ACKNOWLEDGEMENT

STATE OF NEW MEXICO
COUNTY OF BERNALILLO
This instrument was acknowledged before me on this 29th day of December, 2003, by John F. Black.

[Signature]
Notary Public

My Commission expires: Nov. 29, 2007

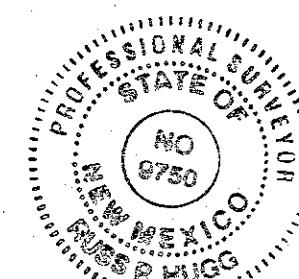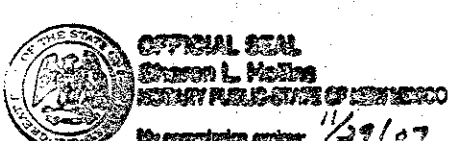

FOR REFERENCE ONLY

SURVOTEK, INC.

Consulting Surveyors
5645 Paradise Blvd. N.W. Albuquerque, New Mexico 87114 Phone: 505-897-5566
Fax: 505-897-3377

SHEET 2 OF 4

729081

2 OF 9

030329P

LOTS 1, 2, 3, 4, 5 AND 6 COTTONWOOD CROSSING, PHASE II (BEING A REPLAT OF TRACTS 14-A AND 14-B, BLACK RANCH)

WITHIN
THE TOWN OF ALAMEDA GRANT
IN
PROJECTED SECTION 8, TOWNSHIP 11 NORTH, RANGE 3 EAST
NEW MEXICO PRINCIPAL MERIDIAN
CITY OF ALBUQUERQUE
BERNALILLO COUNTY, NEW MEXICO
NOVEMBER, 2003

SEE SHEET 2 OF 4 FOR KEYED EASEMENT INFORMATION
SEE SHEET 2 OF 4 FOR ADDITIONAL A.M.A.F.C.A. EASEMENT INFORMATION

BOUNDARY INFORMATION AND EXISTING EASEMENTS

SEVEN BAR
LOOP ROAD

CORNER LEGEND
● SET 5/8" REBAR OR CONCRETE NAIL WITH
CAP OR BRASS DISK MARKED "HUGO LS
9750"
○ FOUND PROPERTY CORNER AS INDICATED
● SET 5/8" REBAR OR CONCRETE NAIL WITH
CAP OR BRASS DISK MARKED "HUGO LS
9750"

TRACT 14-A BLACK RANCH Filed 6-3-98, Vol. 98C, Folio 157

TRACT 14-B BLACK RANCH Filed 6-3-98, Vol. 98C, Folio 157

LINE TABLE

LINE	LENGTH	BEARING
L1	32.70'	N76°36'48"W
L2	28.72'	N27°52'55"W
L3	14.01'	N86°28'56"W
L4	55.93'	S28°23'32"W
L5	41.00'	N57°14'40"W
L6	37.00'	S32°55'48"W
L7	40.00'	S32°55'48"W
L8	48.64'	S15°11'06"W
L9	31.45'	S81°51'16"W
L10	49.25'	N61°36'28"W
L11	18.19'	N61°36'28"W
L12	37.36'	S32°55'48"W
L13	22.12'	S32°55'48"W
L22	12.16'	S69°20'21"E
L23	15.01'	S69°20'21"E
L24	161.06'	N32°38'46"E
L25	367.18'	S32°56'02"W
L26	35.99'	N12°21'14"W
L27	175.00'	S32°56'02"W
L28	175.00'	N32°50'11"E
L29	371.82'	S32°56'02"W
L30	370.88'	N32°50'11"E
L31	21.97'	S32°56'02"W
L32	28.82'	S32°50'11"E
L33	33.86'	S07°01'14"E
L34	21.10'	N08°09'48"W
L35	64.62'	S81°51'16"E
L36	6.49'	N80°10'42"E
L37	26.14'	N50°13'54"E
L38	138.63'	N46°31'30"E
L39	75.97'	N45°21'30"E
L40	102.38'	N45°21'30"E

CURVE TABLE

CURVE	LENGTH	RADIUS	TANGENT	CHORD	CHORD BEARING	DELTA
C1	184.88'	250.00'	96.89'	180.68'	S29°04'56"W (S29°05'55"W)	42°22'02" (42°22'02")
C2	186.31'	335.00'	95.64'	183.92'	S66°11'55"W (S66°11'55"W)	31°51'57" (31°51'57")
C3	122.62'	95.88'	71.30'	114.43'	S01°34'32"W (S01°34'32"W)	73°16'31" (73°16'31")

NOTE

Said Lots 1, 2, 3, 4, 5 and 6 are subject to that certain
"Reciprocal Easement Agreement", filed in the office of the County
Clerk of Bernalillo County, New Mexico on the 21st day of October,
1996, in Book BCR 96-28, Pages 2764-2777, as Document No.
206462-0-2771

SURVOTEK, INC.
Consulting Surveyors
6648 Paradise Blvd. N.W. Albuquerque, New Mexico 87114
Phone: 505-897-5298
Fax: 505-897-5577

SHEET 3 OF 4

NEW EASEMENTS GRANTED BY THIS PLAT

KEYED EASEMENTS

- A New Water Line Easement granted to New Mexico Utilities, Inc. by this plat. Easement to be 10' wide unless otherwise indicated.
- B New Private Access Easement granted to AMAFCA and MRGCD by this plat. Maintenance to be the responsibility of AMAFCA.

NOTE

Said Lots 1, 2, 3, 4, 5 and 6 are subject to that certain
"Reciprocal Easement Agreement", filed in the office of the County
Clerk of Bernalillo County, New Mexico on the 21st day of October,
1996, in Book BCR 96-28, Pages 2764-2777, as Document No.
206462-0-2771

Said Lots 1, 2, 3, 4, 5 and 6 are subject to that certain
"Declaration of Protective Covenants, Restrictions and Grant of
Easements", filed in the office of the County Clerk of Bernalillo
County, New Mexico on the 21st day of October, 2004, in Book
206462-0-2771 as Document No.

NOTE

All street centerline monumentation
shall be installed at all centerline
P.C.'s, P.T.'s, angle points and street
intersections. All centerline
monumentation will be set using the
standard four (4") aluminum
monument stamped "City of
Albuquerque Control Monument -
Do Not Disturb, PS Number 9750"
and will be set flush with the final
asphalt lift.

Manholes will be offset at all points
of curvature, points of tangency,
street intersections, and all other
angle points to allow use of
centerline monumentation.

LOTS 1, 2, 3, 4, 5 AND 6 COTTONWOOD CROSSING, PHASE II (BEING A REPLAT OF TRACTS 14-A AND 14-B, BLACK RANCH)

WITHIN
THE TOWN OF ALAMEDA GRANT
IN
PROJECTED SECTION 8, TOWNSHIP 11 NORTH, RANGE 3 EAST
NEW MEXICO PRINCIPAL MERIDIAN
CITY OF ALBUQUERQUE
BERNALILLO COUNTY, NEW MEXICO
NOVEMBER, 2003

SEE SHEET 2 OF 4 FOR ADDITIONAL A.M.A.F.C.A. EASEMENT INFORMATION

LINE TABLE

LINE	LENGTH	BEARING
L1	32.70'	N76°36'48"W
L2	28.72'	N27°52'55"W
L3	14.01'	N86°28'56"W
L4	55.93'	S28°23'32"W
L5	41.00'	N57°14'40"W
L6	37.00'	S32°55'48"W
L7	40.00'	S32°55'48"W
L8	48.64'	S15°11'06"W
L9	31.45'	S81°51'16"W
L10	49.25'	N61°36'28"W
L11	18.19'	N61°36'28"W
L12	37.36'	S32°55'48"W
L13	22.12'	S32°55'48"W
L14	19.89'	S88°44'18"E
L15	40.91'	N46°20'05"E
L16	33.06'	S60°38'23"E
L17	15.89'	N57°04'12"W
L18	43.68'	N57°17'22"W
L19	23.67'	N57°02'27"W
L20	40.11'	N57°02'27"W
L21	12.16'	S60°38'43"E
L22	29.39'	N85°55'21"W
L23	161.06'	N32°38'46"E
L24	367.18'	S32°56'02"W
L25	35.99'	N12°21'14"W
L26	175.00'	S32°56'02"W
L27	175.00'	N32°50'11"E
L28	371.82'	S32°56'02"W
L29	370.88'	N32°50'11"E
L30	21.97'	S32°56'02"W
L31	28.82'	S32°50'11"E
L32	33.86'	S07°01'14"E
L33	21.10'	N08°09'48"W
L34	64.62'	S81°51'16"E
L35	6.49'	N80°10'42"E
L36	26.14'	N50°13'54"E
L37	138.63'	N46°31'30"E
L38	75.97'	N45°21'30"E
L39	102.38'	N45°21'30"E
L40	19.62'	S32°55'48"W
L41	23.55'	S32°55'48"W
L42	15.87'	S32°55'48"W
L43	48.94'	N57°04'12"W
L44	23.88'	S57°04'12"E
L45	2.12'	S57°04'12"E
L46	181.30'	S57°04'12"E
L47	20.59'	S28°23'32"W
L48	24.25'	S61°36'28"E
L49	46.27'	S28°23'32"W
L50	82.43'	S62°07'06"W
L51	102.33'	S32°54'48"W
L52	17.00'	S07°01'12"E
L53	34.87'	N57°04'12"W
L54	34.87'	N57°04'12"W
L55	56.91'	N57°04'12"W
L56	20.80'	N06°04'27"W

CURVE TABLE

CURVE	LENGTH	RADIUS	TANGENT	CHORD	CHORD BEARING	DELTA
C1	184.88'	250.00'	96.89'	180.68'	S29°04'56"W (S29°05'55"W)	42°22'02" (42°22'02")
C2	186.31'	335.00'	95.64'	183.92'	S66°11'55"W (S66°11'55"W)	31°51'57" (31°51'57")
C3	122.62'	95.88'	71.30'	114.43'	S01°34'32"W (S01°34'32"W)	73°16'31" (73°16'31")
C4	71.71'	250.00'	36.10'	55.72'	N41°04'00"W (N41°04'00"W)	30°46'24" (30°46'24")
C5	55.66'	105.00'	28.50'	55.72'	N11°06'34"W (N11°06'34"W)	30°22'27" (30°22'27")
C6	92.87'	105.00'	27.01'	52.32'	N18°30'14"E (N18°30'14"E)	28°51'09" (28°51'09")
C7	72.95'	165.00'	37.09'	72.37'	N49°14'20"E (N49°14'20"E)	25°20'10" (25°20'10")
C8	59.04'	50.00'	14.94'	28.63'	N40°39'06"E (N40°39'06"E)	33°20'27" (33°20'27")
C9	58.19'	100.00'	26.95'	57.37'	S40°37'09"E (S40°37'09"E)	33°20'27" (33°20'27")
C10	10.16'	30.00'	5.13'	10.11'	N47°35'18"W (N47°35'18"W)	19°24'09" (19°24'09")
C11	26.67'	150.00'	13.37'	26.63'	N32°47'36"W (N32°47'36"W)	10°11'13" (10°11'13")
C12	22.20'	15.00'	13.69'	20.23'	S70°05'40"E (S70°05'40"E)	84°46'20" (84°46'20")
C13	19.41'	19.00'	11.33'	18.09'	S30°25'05"W (S30°25'05"W)	74°09'06" (74°09'06")

CORNER LEGEND

- SET 5/8" REBAR OR CONCRETE NAIL WITH
CAP OR BRASS DISK MARKED "HUGO LS
9750"
- FOUND PROPERTY CORNER AS INDICATED
- SET 5/8" REBAR OR CONCRETE NAIL WITH
CAP OR BRASS DISK MARKED "HUGO LS
9750"
- ▲ SET 4" ALUMINUM CENTERLINE MONUMENT

FOR REFERENCE ONLY

SURVOTEK, INC.
Consulting Surveyors
6648 Paradise Blvd. N.W. Albuquerque, New Mexico 87114
Phone: 505-897-5298
Fax: 505-897-5577

SHEET 4 OF 4

	EXISTING STORM SEWER INLET
	EXISTING STORM SEWER LINE
	PROPOSED STORM SEWER MANHOLE
	PROPOSED 12" LANDSCAPE DRAIN
	PROPOSED DOUBLE "C" WATER QUALITY INLET
	PROPOSED STORM SEWER LINE
	EXISTING CURB & GUTTER
	PROPOSED CURB & GUTTER
	BOUNDARY LINE
	EXISTING SIDEWALK
	PROPOSED RETAINING WALL
	EXISTING RETAINING WALL
	EXISTING CONTOUR
	EXISTING INDEX CONTOUR
	FLCW ARROW
	SLOPE TIE
	EXISTING SPOT ELEVATION
	PROPOSED SPOT ELEVATION

EXISTING UTILITIES ARE NOT SHOWN. IT SHALL BE THE SOLE RESPONSIBILITY OF THE CONTRACTOR TO CONDUCT ALL NECESSARY FIELD INVESTIGATIONS PRIOR TO ANY EXCAVATION TO DETERMINE THE ACTUAL LOCATION OF UTILITIES & OTHER IMPROVEMENTS.

1. CONTRACTOR IS RESPONSIBLE FOR OBTAINING A TOPSOIL DISTURBANCE PERMIT PRIOR TO BEGINNING WORK.
2. CONTRACTOR IS RESPONSIBLE FOR MAINTAINING RUN-OFF ON SITE DURING CONSTRUCTION.
3. CONTRACTOR IS RESPONSIBLE FOR CLEANING ALL SEDIMENT THAT GETS INTO EXISTING RIGHT-OF-WAY.
4. REPAIR OF DAMAGED FACILITIES AND CLEANUP OF SEDIMENT ACCUMULATIONS ON ADJACENT PROPERTIES AND IN PUBLIC FACILITIES IS THE RESPONSIBILITY OF THE CONTRACTOR.
5. ALL EXPOSED EARTH SURFACES MUST BE PROTECTED FROM WIND AND WATER EROSION PRIOR TO FINAL (CITY) ACCEPTANCE OF ANY PROJECT.

NTS

724

Topographic map showing contour lines and elevation markers. The map includes a scale bar indicating distances of 0, 50, and 100 feet. The contour lines represent elevations of 21.50 and 22.50 feet. A road or path is visible, and the map is oriented with North at the top.

11

© 2006 The Authors
Journal compilation © 2006 Blackwell Publishing Ltd

TABLE 1. *Summary of the 1997-1998 season*

NTS

40	20	0	20	40
----	----	---	----	----

Figure 1. The effect of the concentration of the *Agrobacterium* suspension on the transformation efficiency of *Agrobacterium* strains. The *Agrobacterium* strains were grown in the YEA medium for 24 h at 28 °C. The cell concentration of the *Agrobacterium* strains was adjusted to 10⁸ cells/ml. The cell suspension was mixed with the plant tissue and incubated for 24 h at 28 °C. The plant tissue was then cultured on the selective medium. The transformation efficiency was calculated as the number of transformants per 100 mg of plant tissue. The data were the mean of three independent experiments.

GRADING AND DRAINAGE PLAN

7299 81


BY JDN

10-20-03

229/GRB-8-6-03

220097

4 OF 9

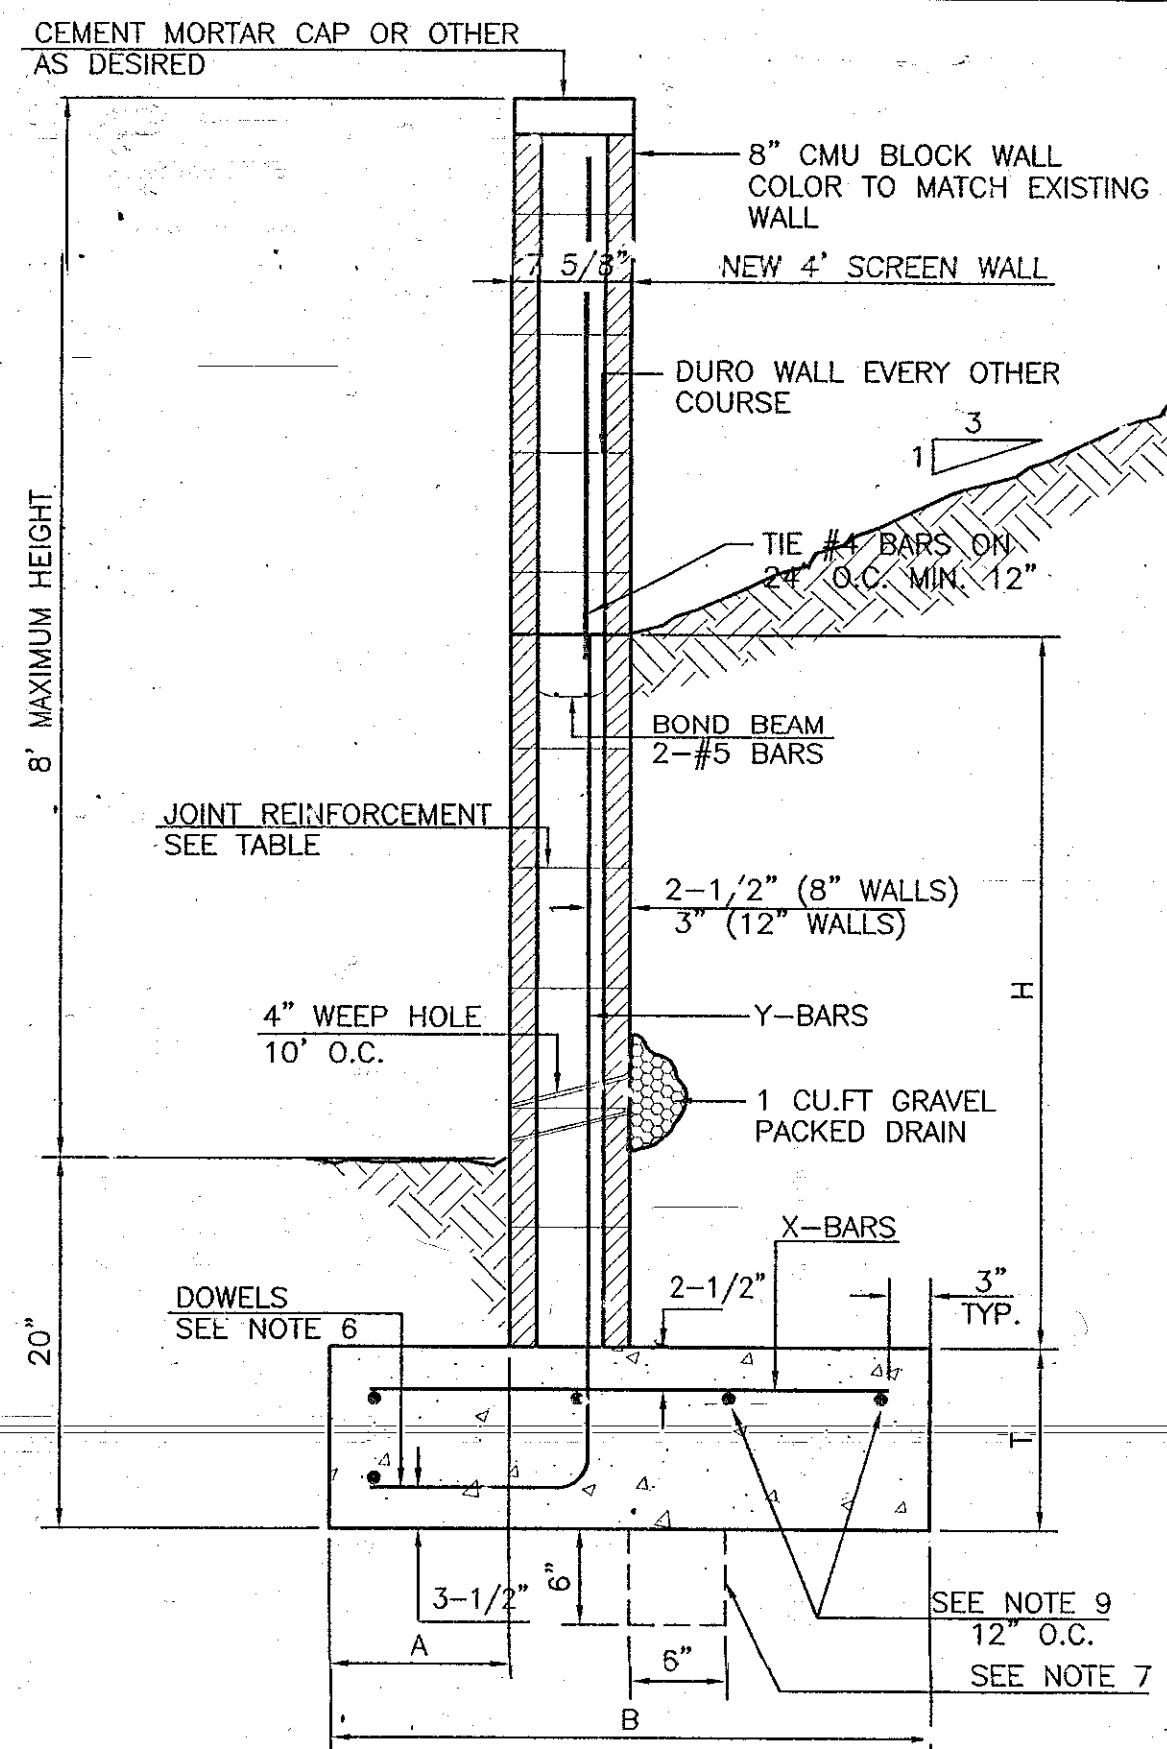

RETAINING WALL DETAIL
NTS

CERTIFICATE OF SUBSTANTIAL COMPLIANCE ON PLANS

I, Ronald R. Bohannan, of the firm of Tierra West LLC, a Registered Professional Engineer in the State of New Mexico, do hereby certify, to the best of my knowledge and belief, that the infrastructure installed as part of this project has been inspected by me or by a qualified person under my direct supervision and has been constructed in accordance with the plans and specifications approved by the City Engineer and that the original design intent of the approved plans has been met, except as noted by me on the as-built construction drawings. This Certification is based on site inspections by me, or personnel under my direction with survey information provided by:

Russ Huggs of Surv-Tek Inc. NMPS number 9750

8 INCH REINFORCED CONCRETE MASONRY WALL


H	X	A	B	T	Y-BARS	X-BARS
ft.-in.	ft.-in.	in.	ft.-in.	in.		
2'-0"	1'-1"	8"	2'-4"	9"	#3 @32" O.C.	#3 @27" O.C.
2'-8"	1'-9"	8"	2'-9"	9"	#4 @32" O.C.	#3 @27" O.C.
3'-4"	2'-5"	8"	2'-4"	9"	#3 @32" O.C.	#3 @27" O.C.
4'-0"	3'-1"	10"	2'-9"	9"	#4 @32" O.C.	#3 @27" O.C.
4'-8"	3'-10"	12"	3'-4"	10"	#4 @32" O.C.	#3 @27" O.C.
5'-4"	4'-6"	14"	3'-8"	10"	#4 @32" O.C.	#3 @27" O.C.
6'-0"	5'-3"	16"	4'-2"	12"	#6 @24" O.C.	#4 @25" O.C.

12 INCH REINFORCED CONCRETE MASONRY WALL


H	X	A	B	T	Y-BARS	X-BARS
ft.-in.	ft.-in.	in.	ft.-in.	in.		
5'-4"	4'-8"	14"	3'-8"	10"	#4 @24" O.C.	#3 @25" O.C.
6'-0"	5'-4"	15"	4'-2"	12"	#4 @16" O.C.	#4 @30" O.C.
6'-8"	6'-"	16"	4'-6"	12"	#6 @24" O.C.	#4 @22" O.C.
7'-4"	6'-8"	18"	4'-10"	12"	#6 @16" O.C.	#5 @26" O.C.
8'-0"	7'-4"	20"	5'-4"	12"	#7 @24" O.C.	#5 @21" O.C.
8'-8"	8'-0"	20"	5'-8"	12"	#7 @16" O.C.	#5 @21" O.C.

GENERAL NOTES:


- ALL CONCRETE IS TO BE 4000 PSI @ 28 DAYS.
- M-MUM COMPACTION UNDER FOOTINGS IS TO BE 95% PER ASTM D 1557 FOR A DEPTH OF 12" MOISTURE CONTENT IS TO BE $\pm 2.0\%$
- BACK FILL AGAINST WALLS IS TO BE HAND-PLACED AND COMPACTED.
- ALL BARS ARE TO BE GRADE 60, ASTM 615.
- TRUSS TYPE DUR-O-WALL EVERY OTHER COURSE.
- DOWELS SHALL BE AT LEAST EQUAL IN SIZE AND SPACING TO Y-BARS. SHALL PROJECT A MINIMUM OF 30 BAR DIA INTO THE FILLED BLOCK CORES, AND SHALL EXTEND TO THE TOE OF THE FOOTING.
- PROVIDE KEY FOR 8" AND 12" WALLS WHERE H EXCEEDS 6'-0"
- USE EITHER EXPANSION JOINTS ON 20' CENTERS OR PILASTERS EVERY 16'
- #3 BARS TO BE USED ON WALLS LESS THAN 2'-8" IN HEIGHT.
- #4 BARS TO BE USED ON WALLS GREATER THAN OR EQUAL TO 2'-8"
- X BARS TO BE USED ON WALLS EXCEEDING 2'-8"
- BOND BEAM, 1-#4 BARS FOR WALLS UNDER 3'-4", 2-#4 BARS FOR WALLS UNDER 5'-4", 2-#5 BARS FOR WALLS OVER 5'-4".

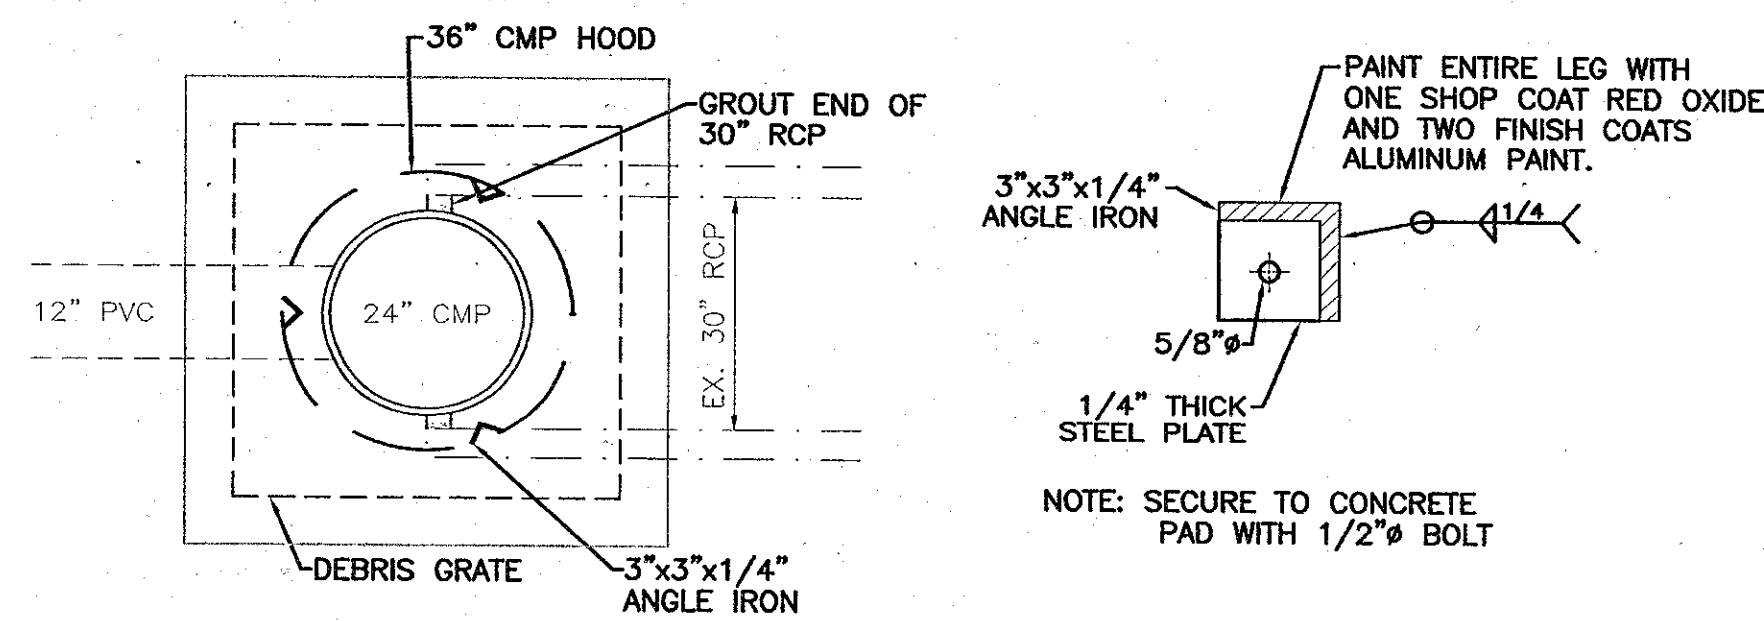


36" CMP HOOD DETAILS
NTS

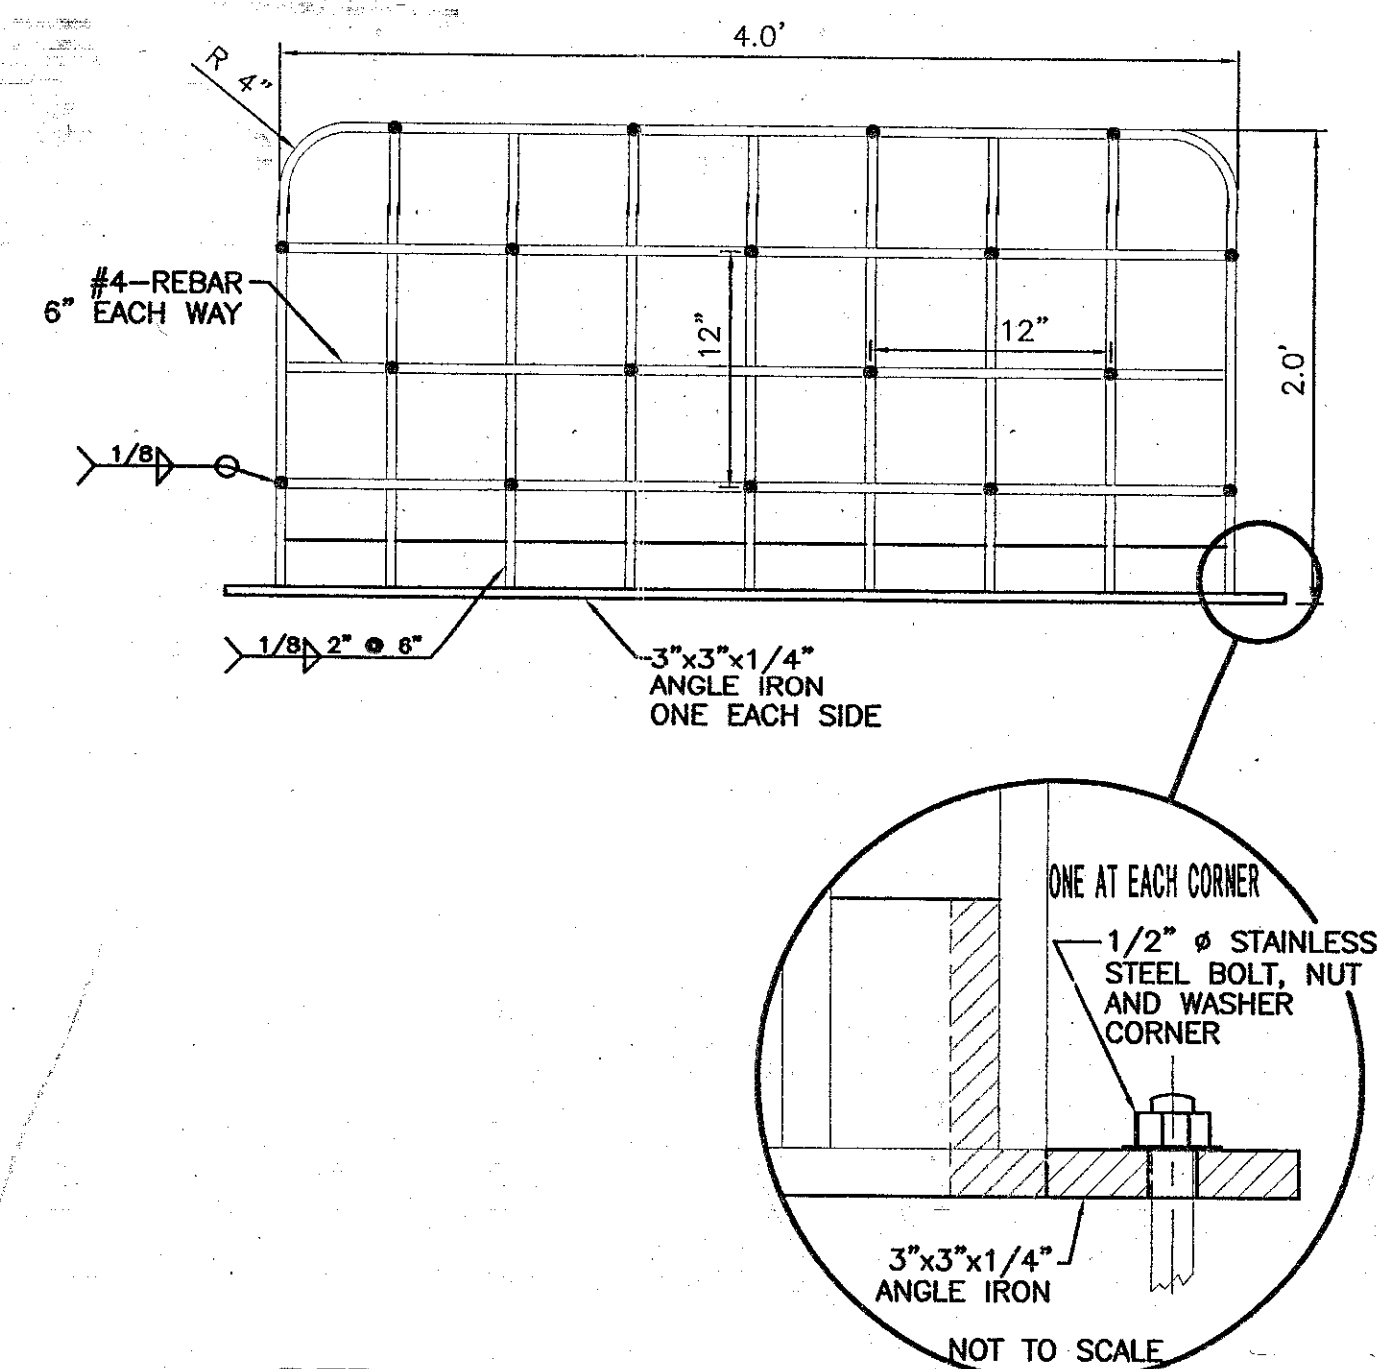


DEBRIS GRATE DETAIL
NTS

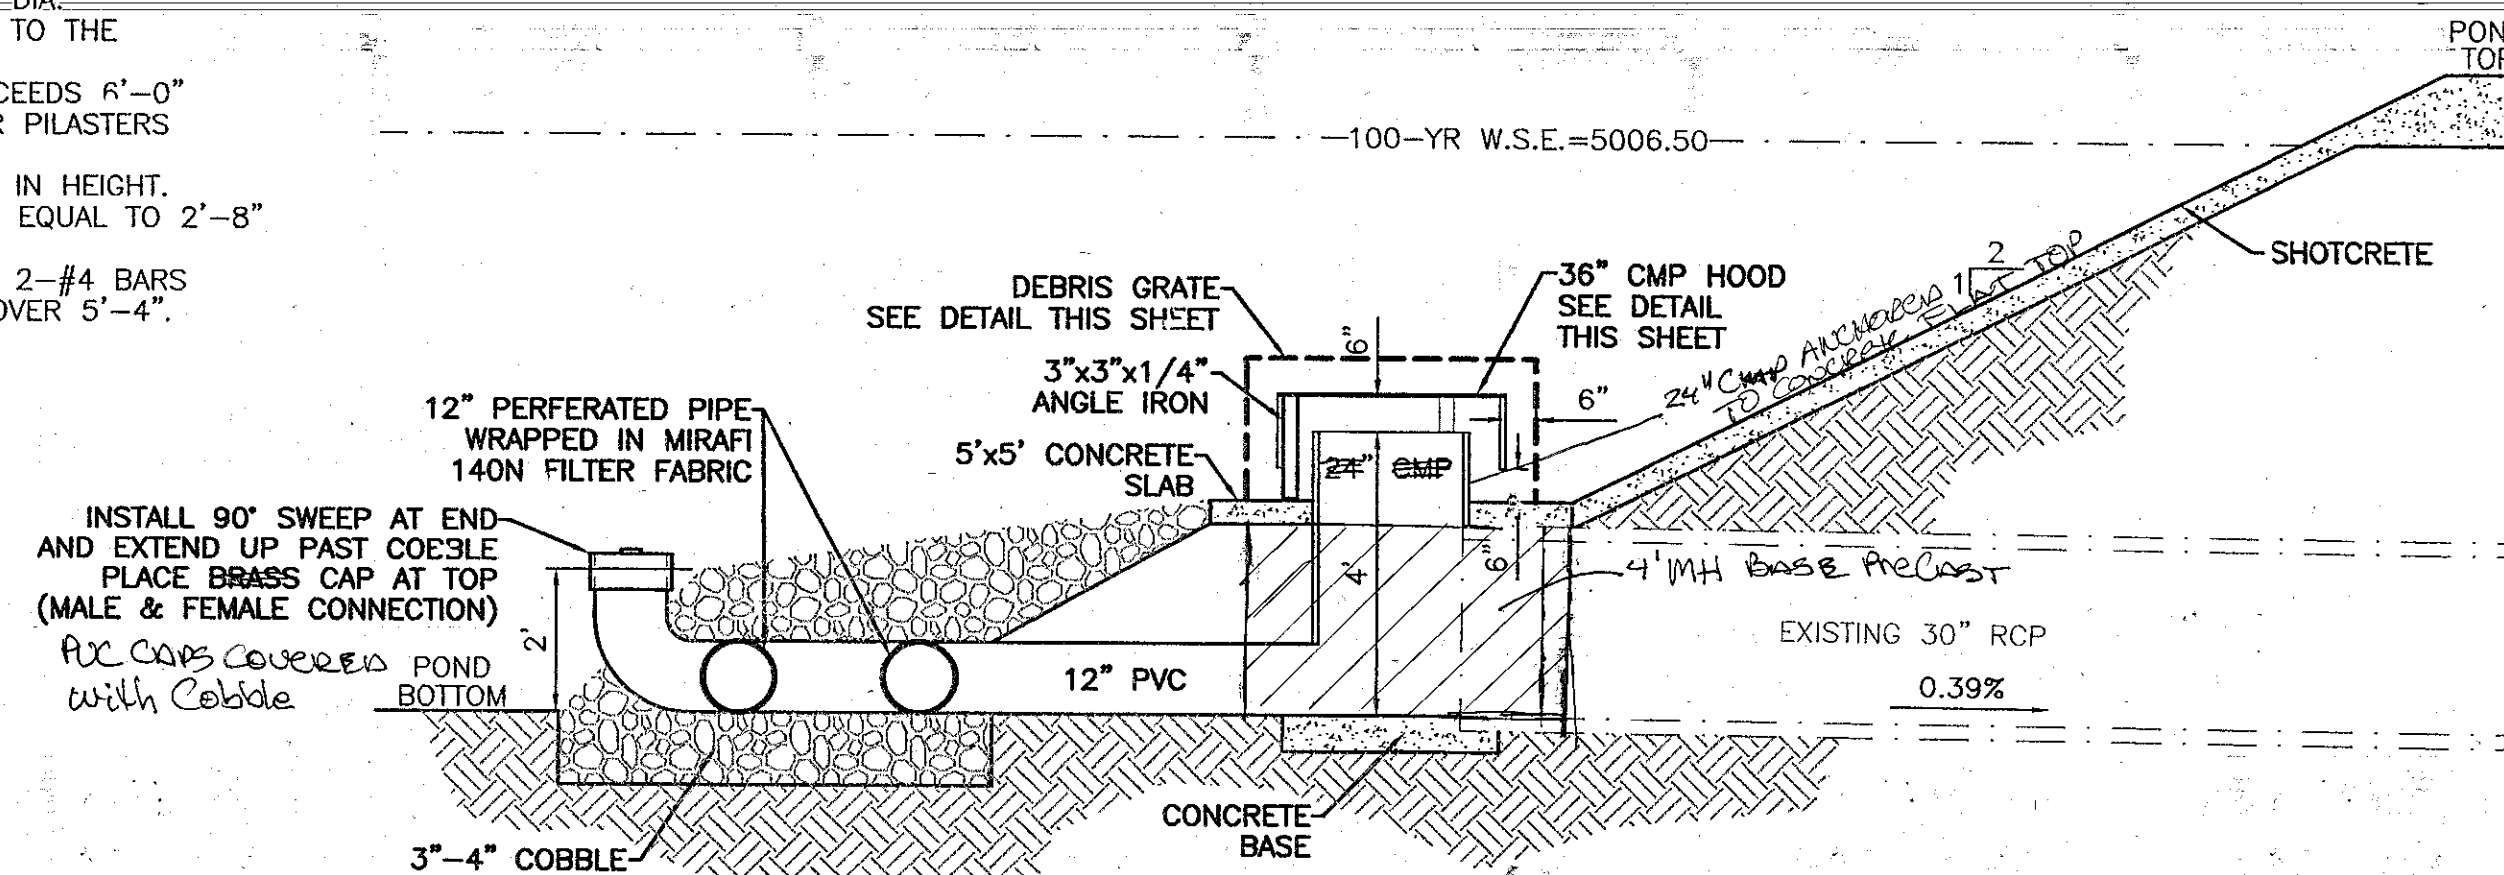


BAFFLE DETAIL
SCALE: NTS

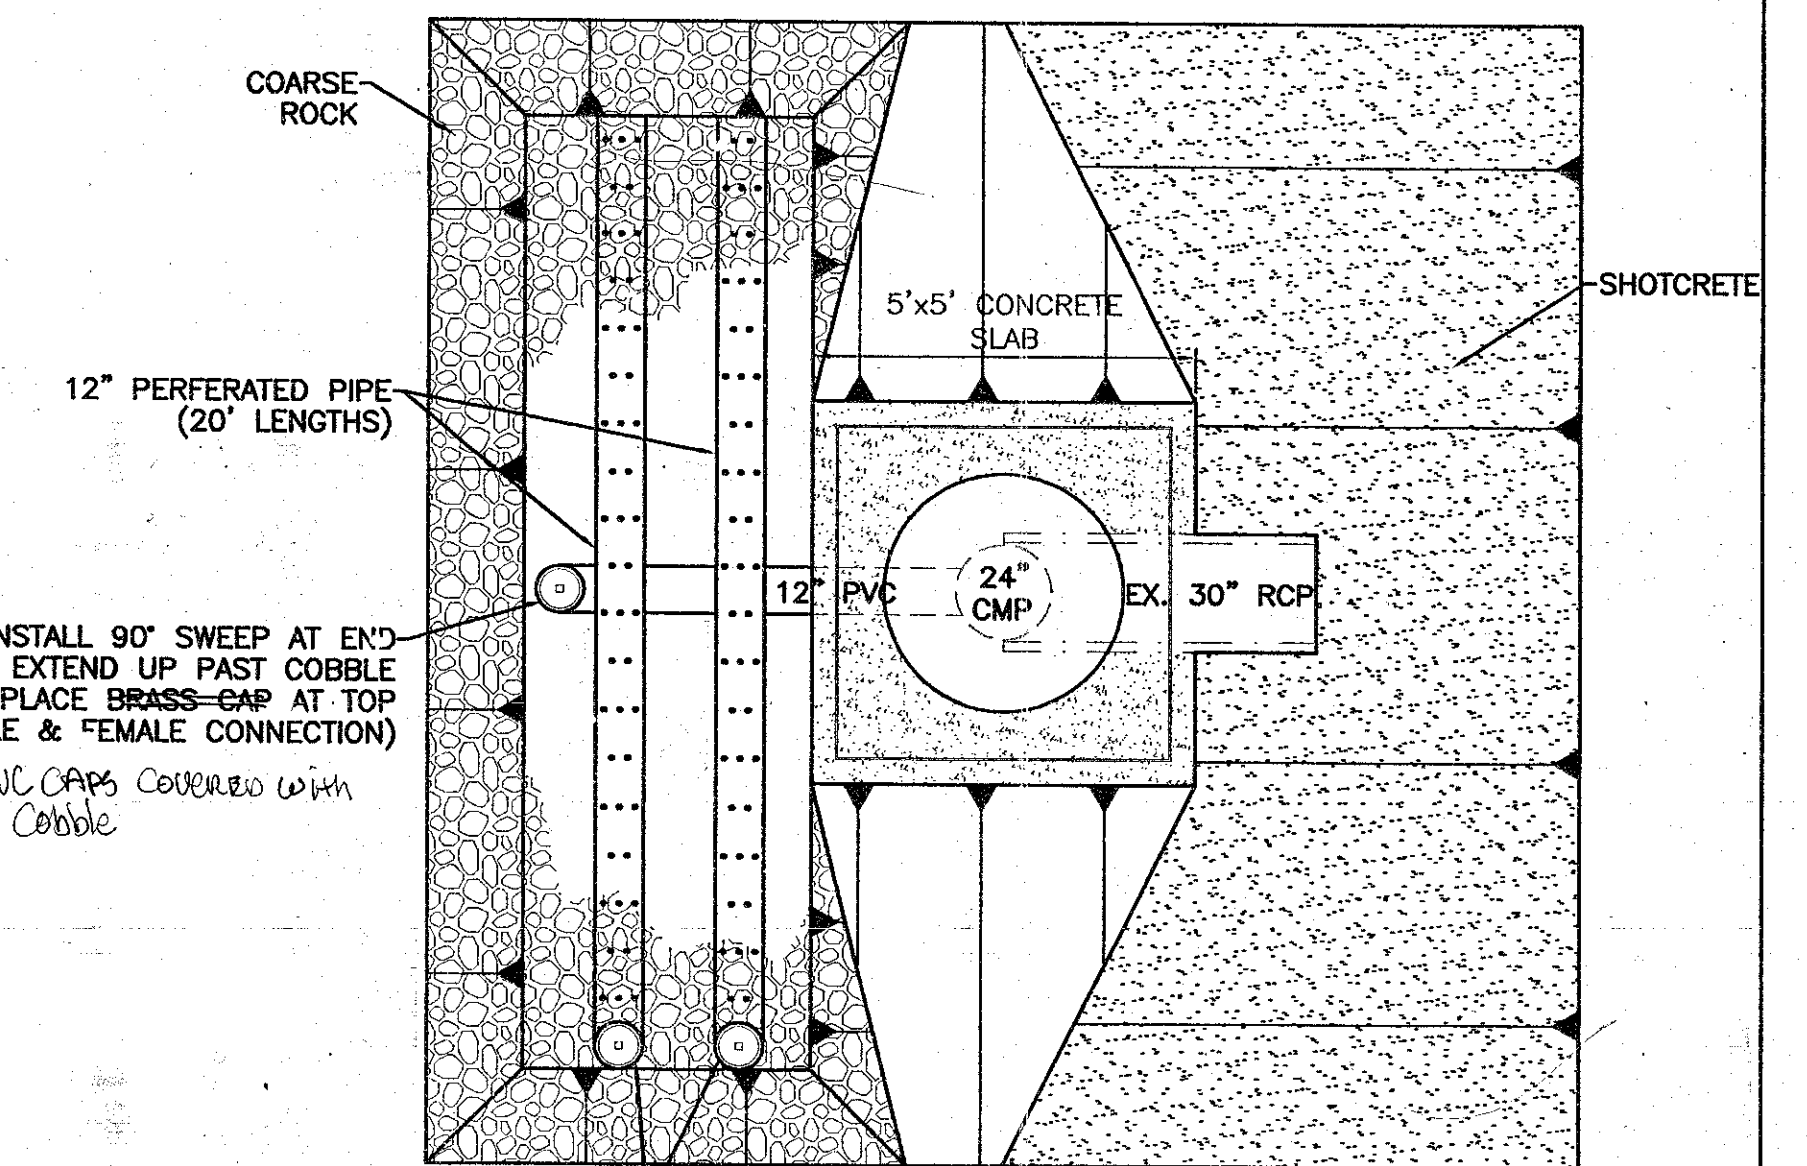


BAFFLE DETAIL PLAN VIEW
SCALE: NTS

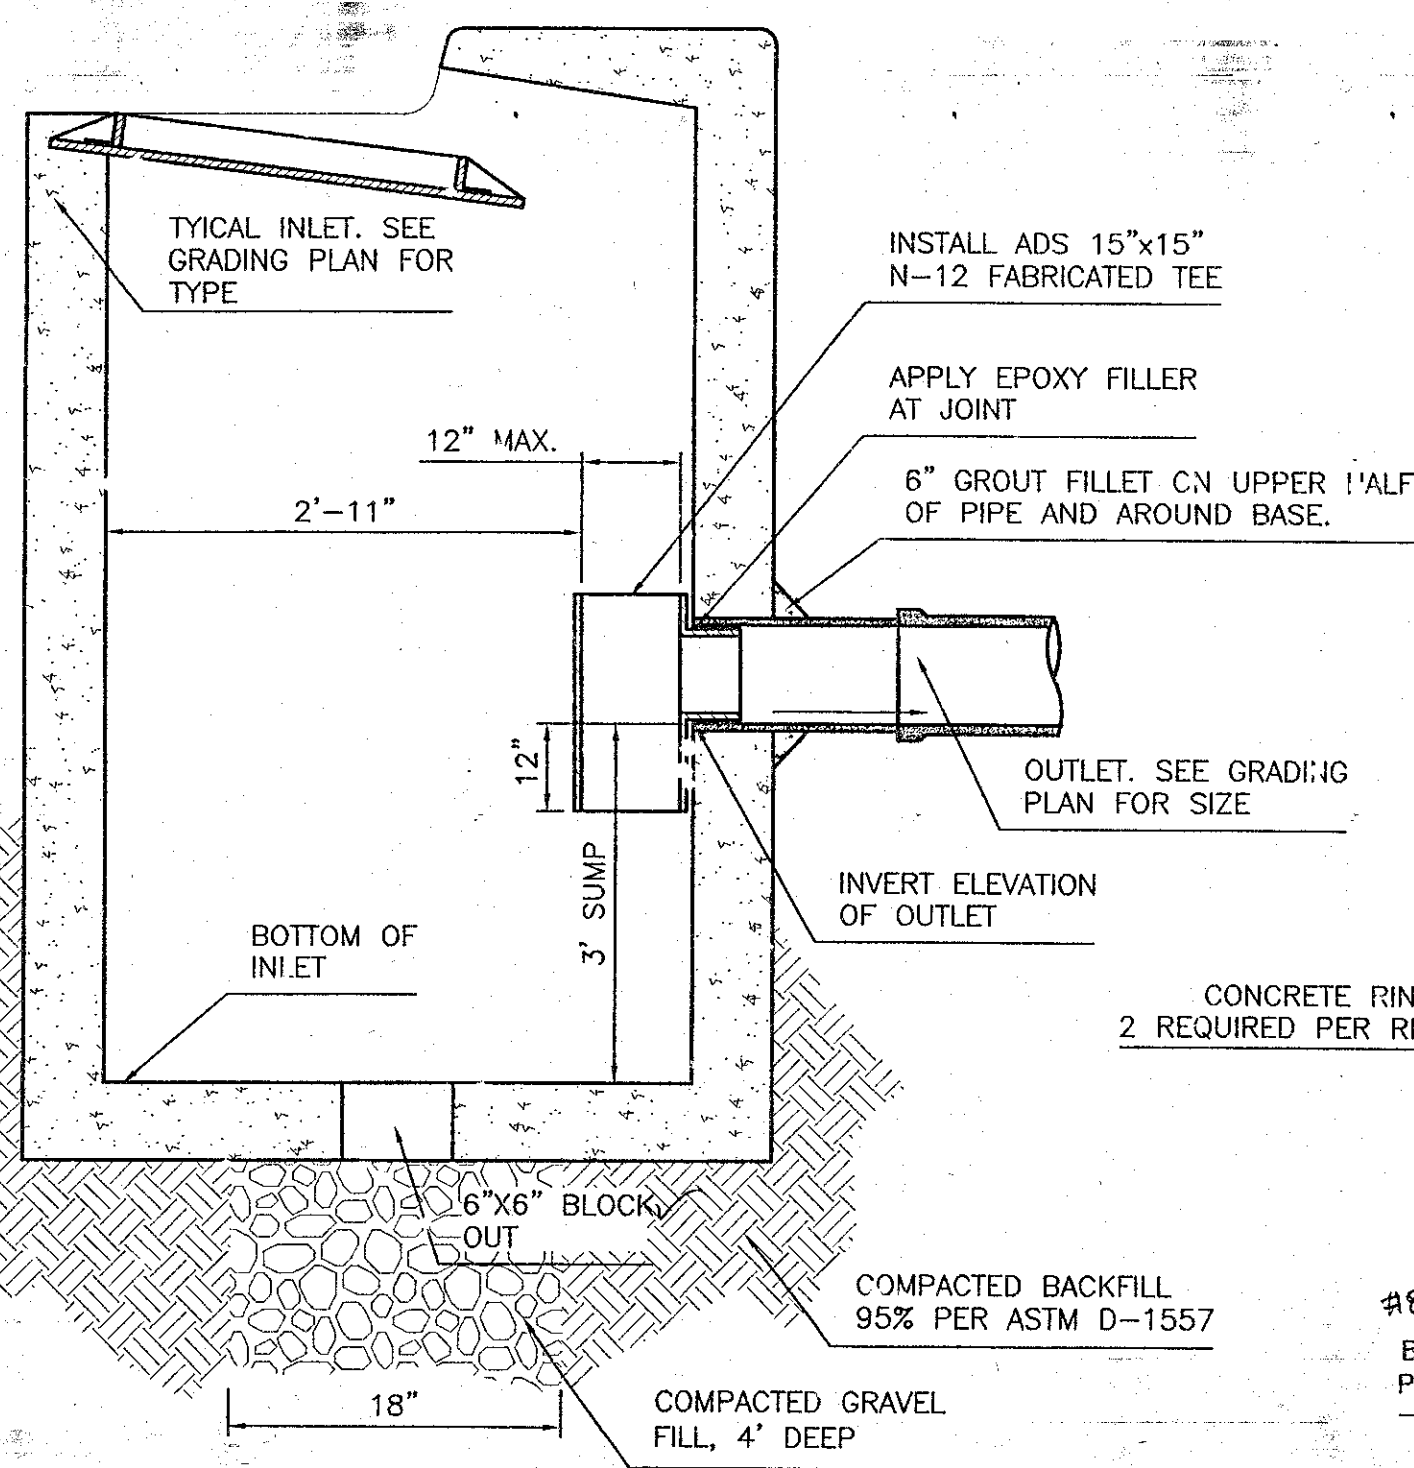






TYPICAL WATER QUALITY INLET DETAIL
NTS

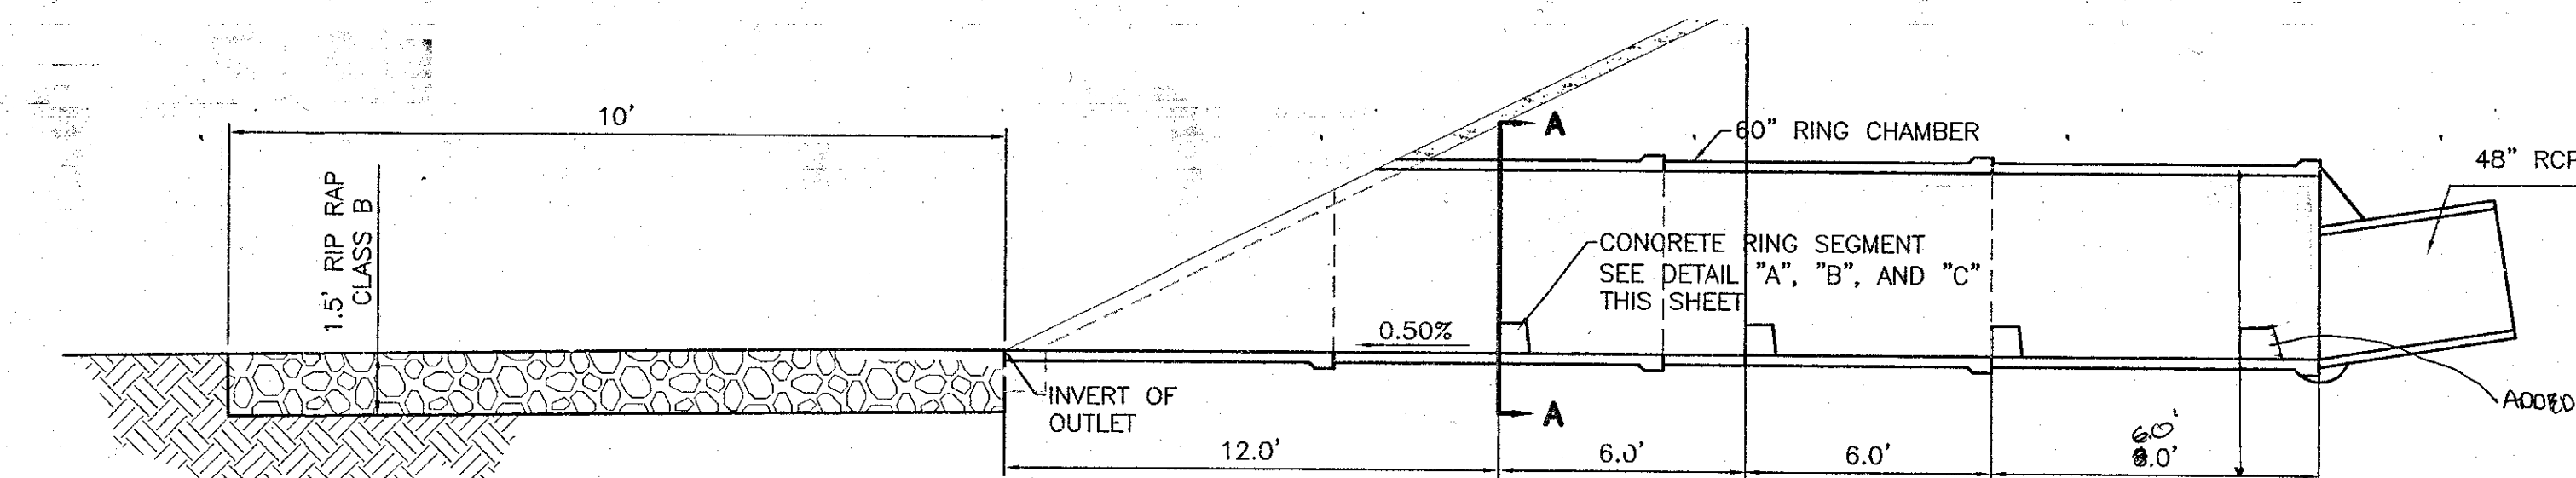





60" RING CHAMBER DETAIL
NTS

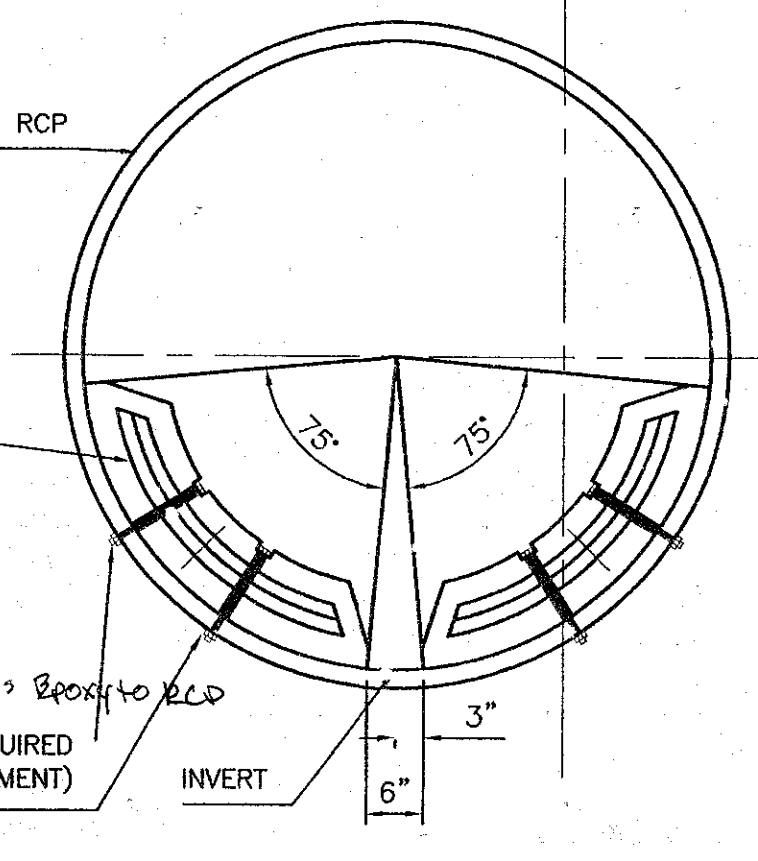







SECTION A-A RING SEGMENT
NTS

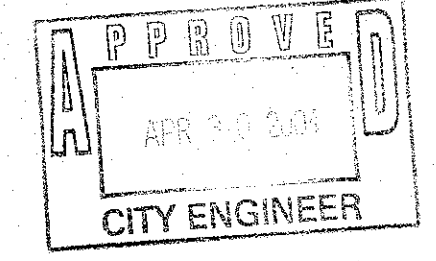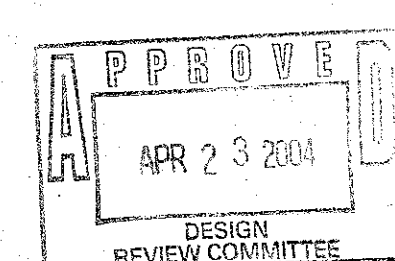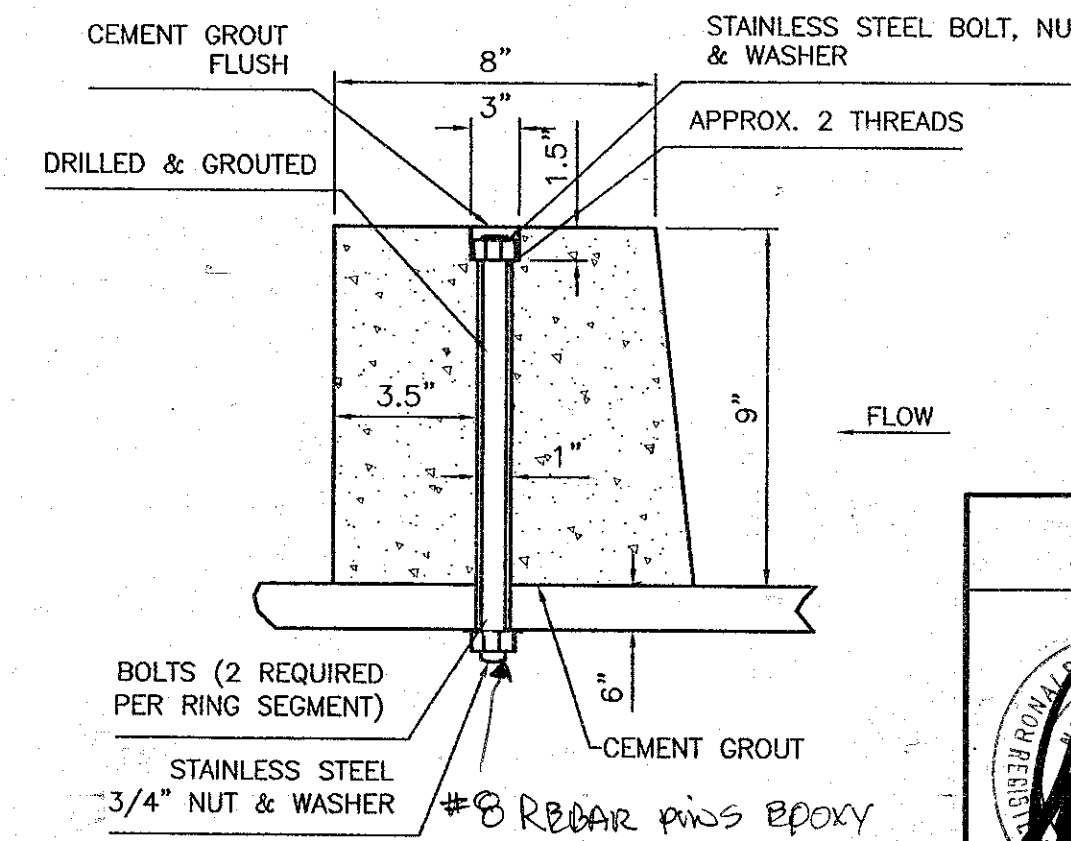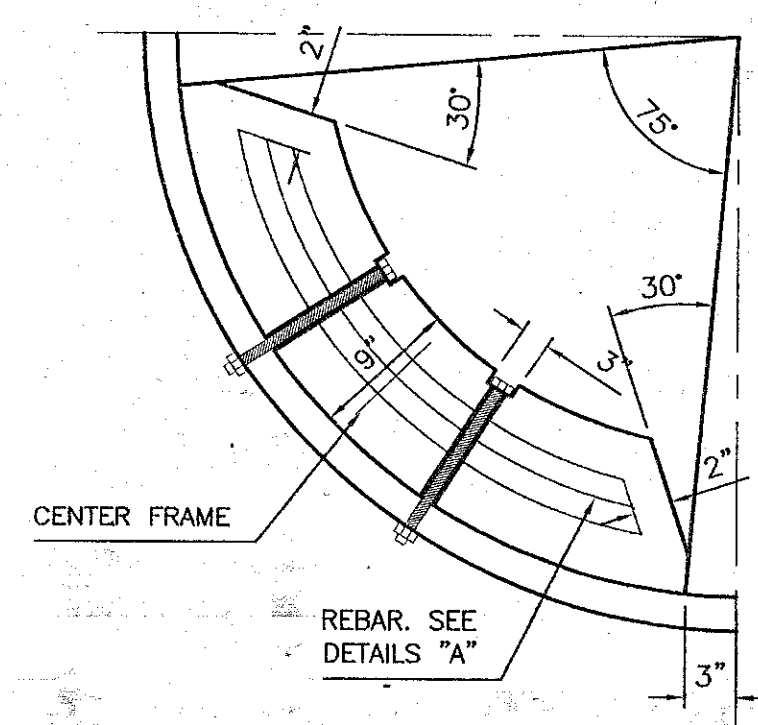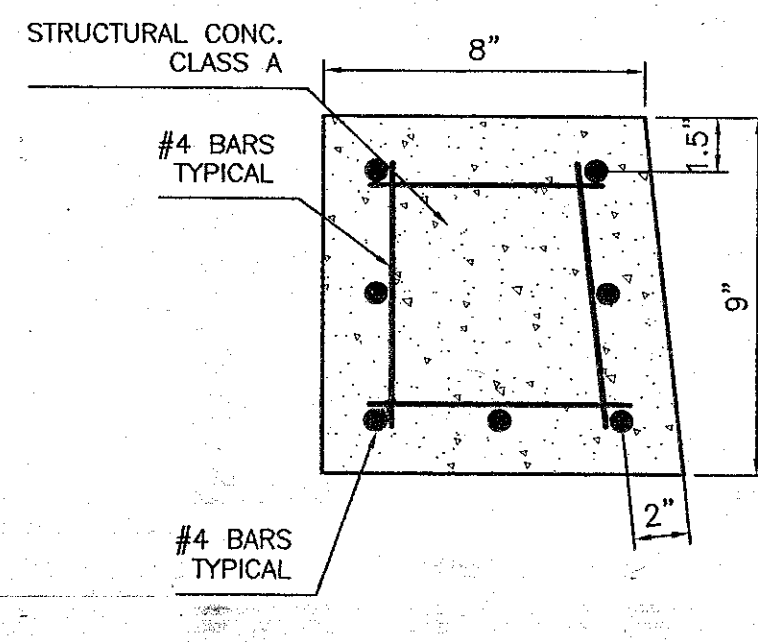

	COTTONWOOD CROSSING PHASE 2	DRAWN BY JDN
	DETAIL SHEET	DATE 02-26-04
		2297GRB-11-4-03
		SHEET # C-2
Tierra West, LLC 8509 JEFFERSON NE ALBUQUERQUE, NEW MEXICO 87113 (505) 858-3100		JOB # 220097

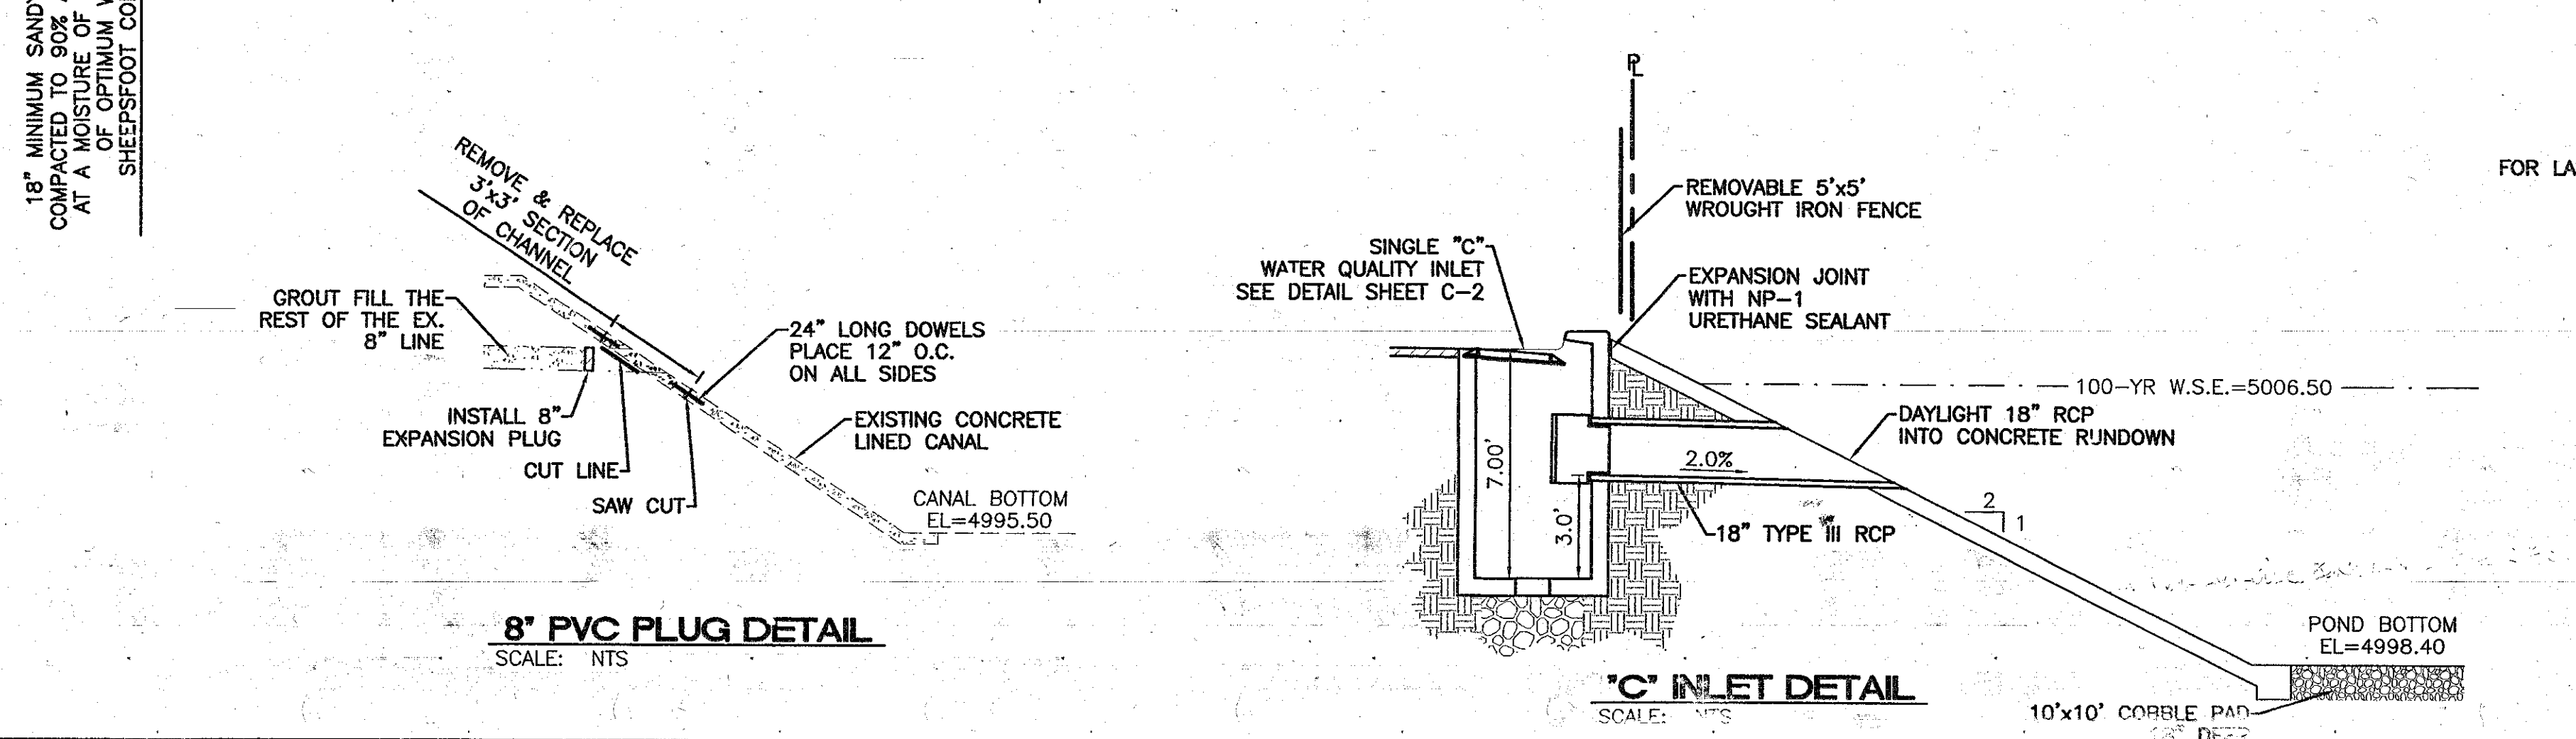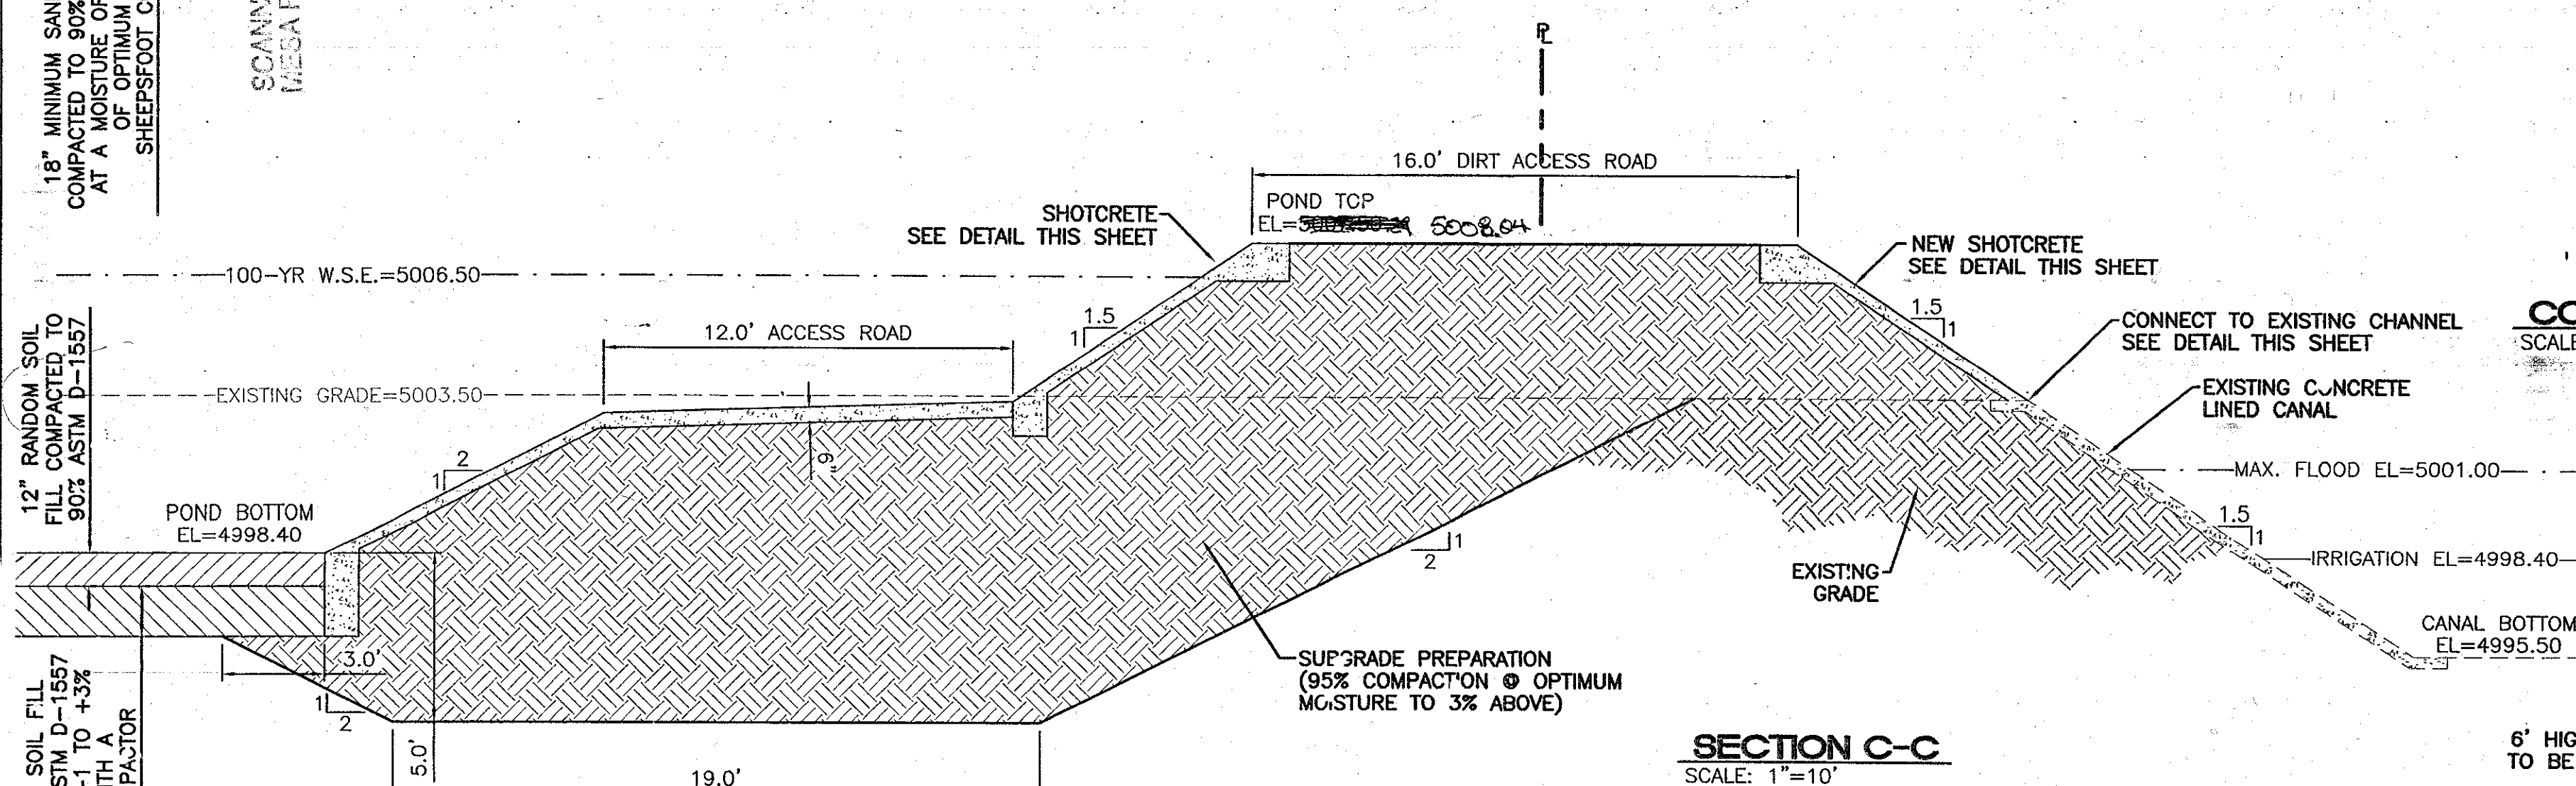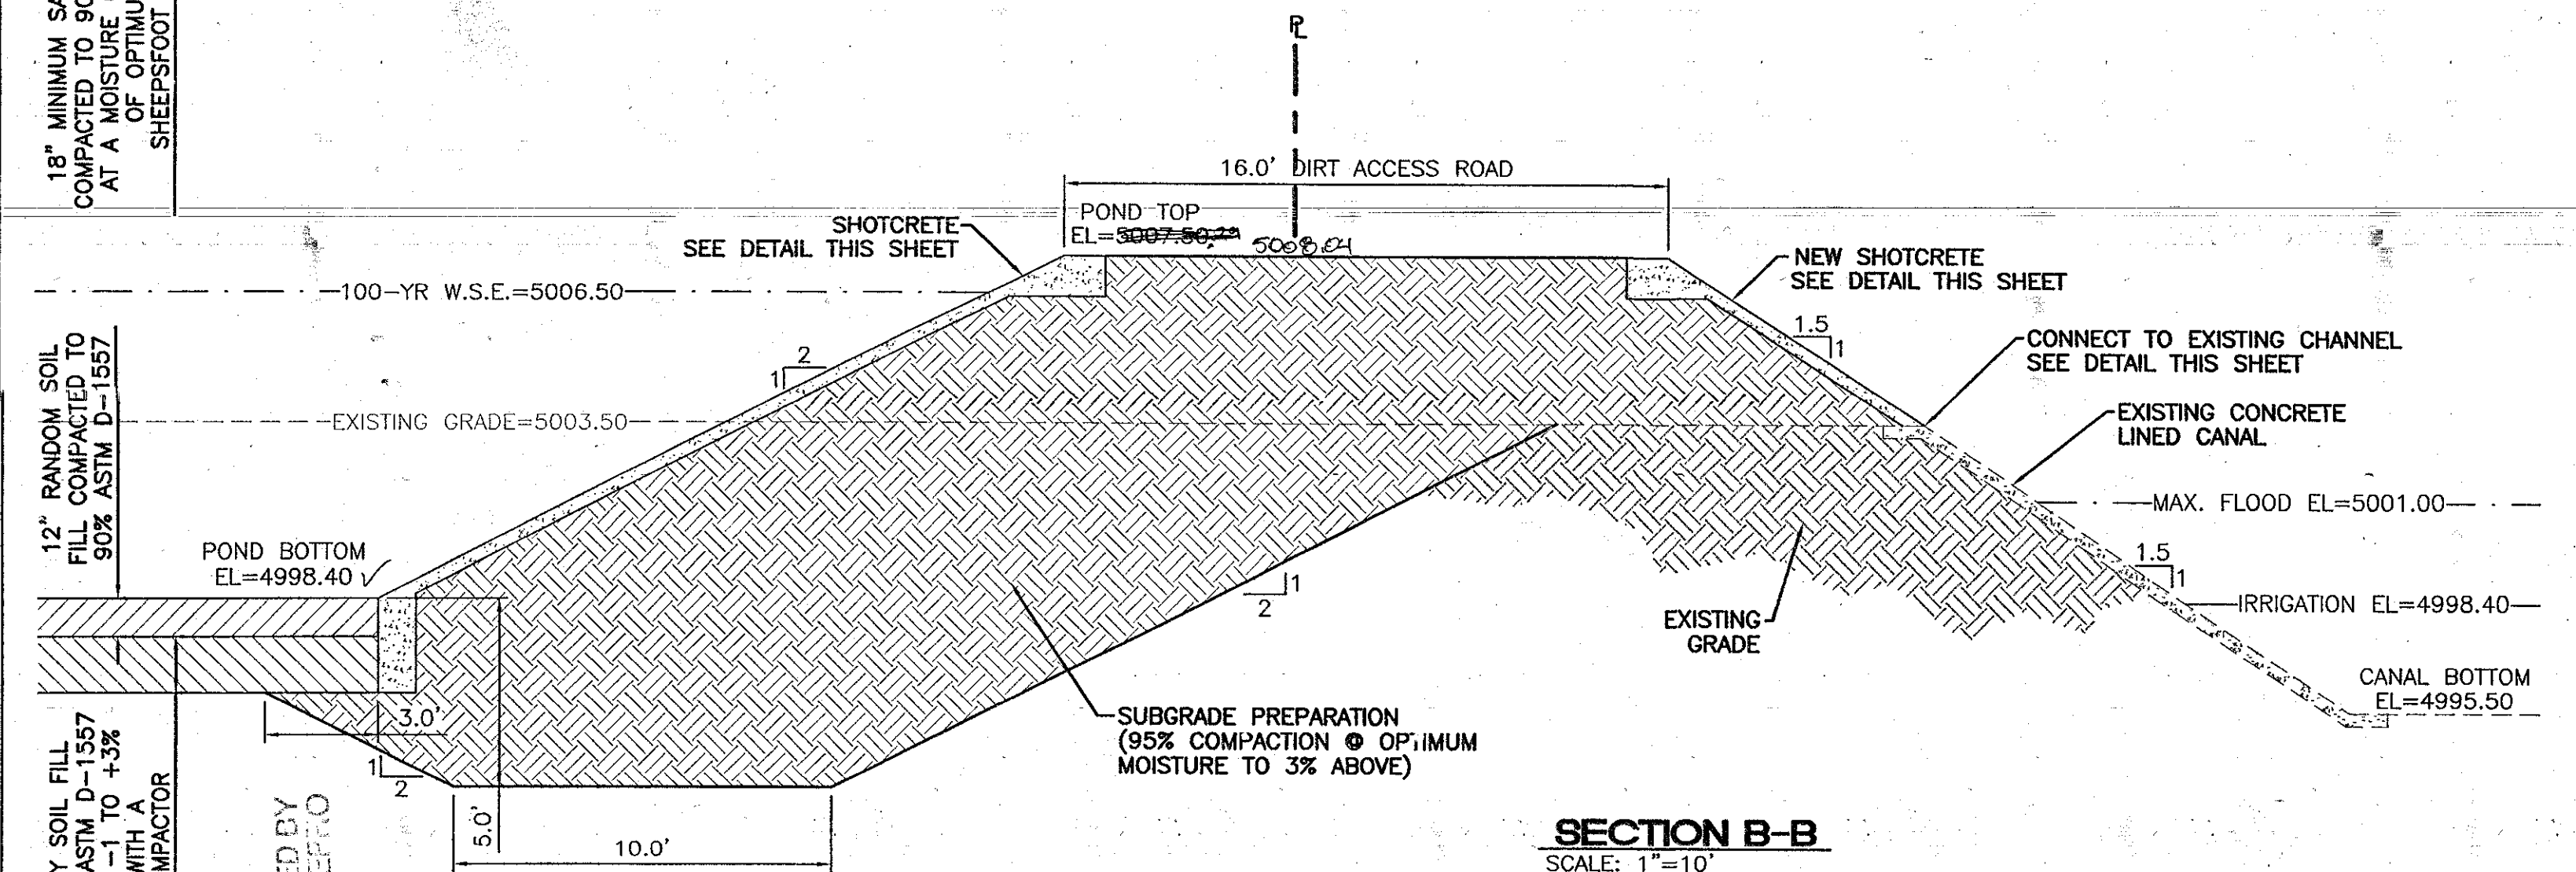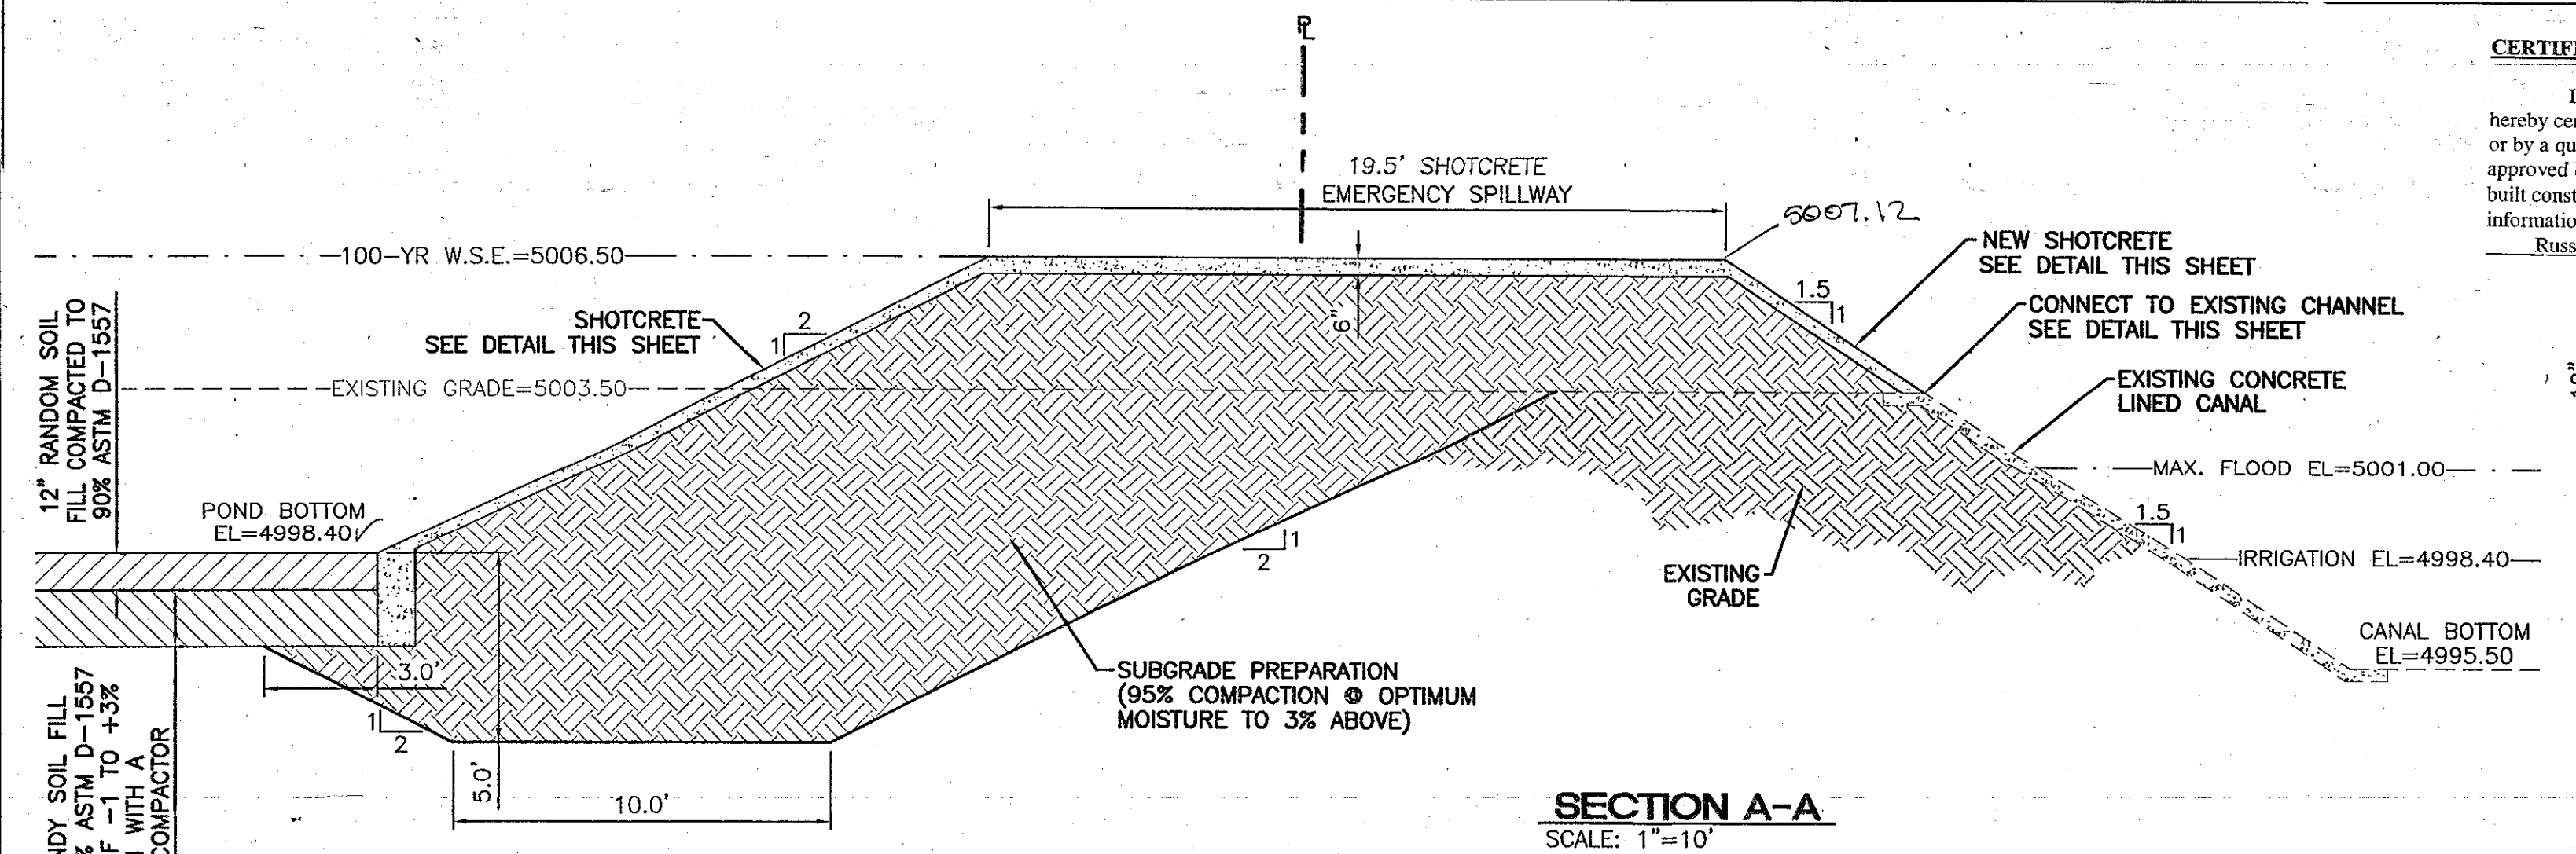

CERTIFICATE OF SUBSTANTIAL COMPLIANCE ON PLANS
I, Ronald R. Bohannon, of the firm of Tierra West LLC, a Registered Professional Engineer in the State of New Mexico, do hereby certify, to the best of my knowledge and belief, that the infrastructure installed as part of this project has been inspected by me or by a qualified person under my direct supervision and has been constructed in accordance with the plans and specifications approved by the City Engineer and that the original design intent of the approved plans has been met, except as noted by me on the as-information provided by the City Engineer. This Certification is based on site inspections by me, or personnel under my direction with survey information provided by the City Engineer.
Russ Hugg, of Survey-Tek Inc. NMPS number 9750

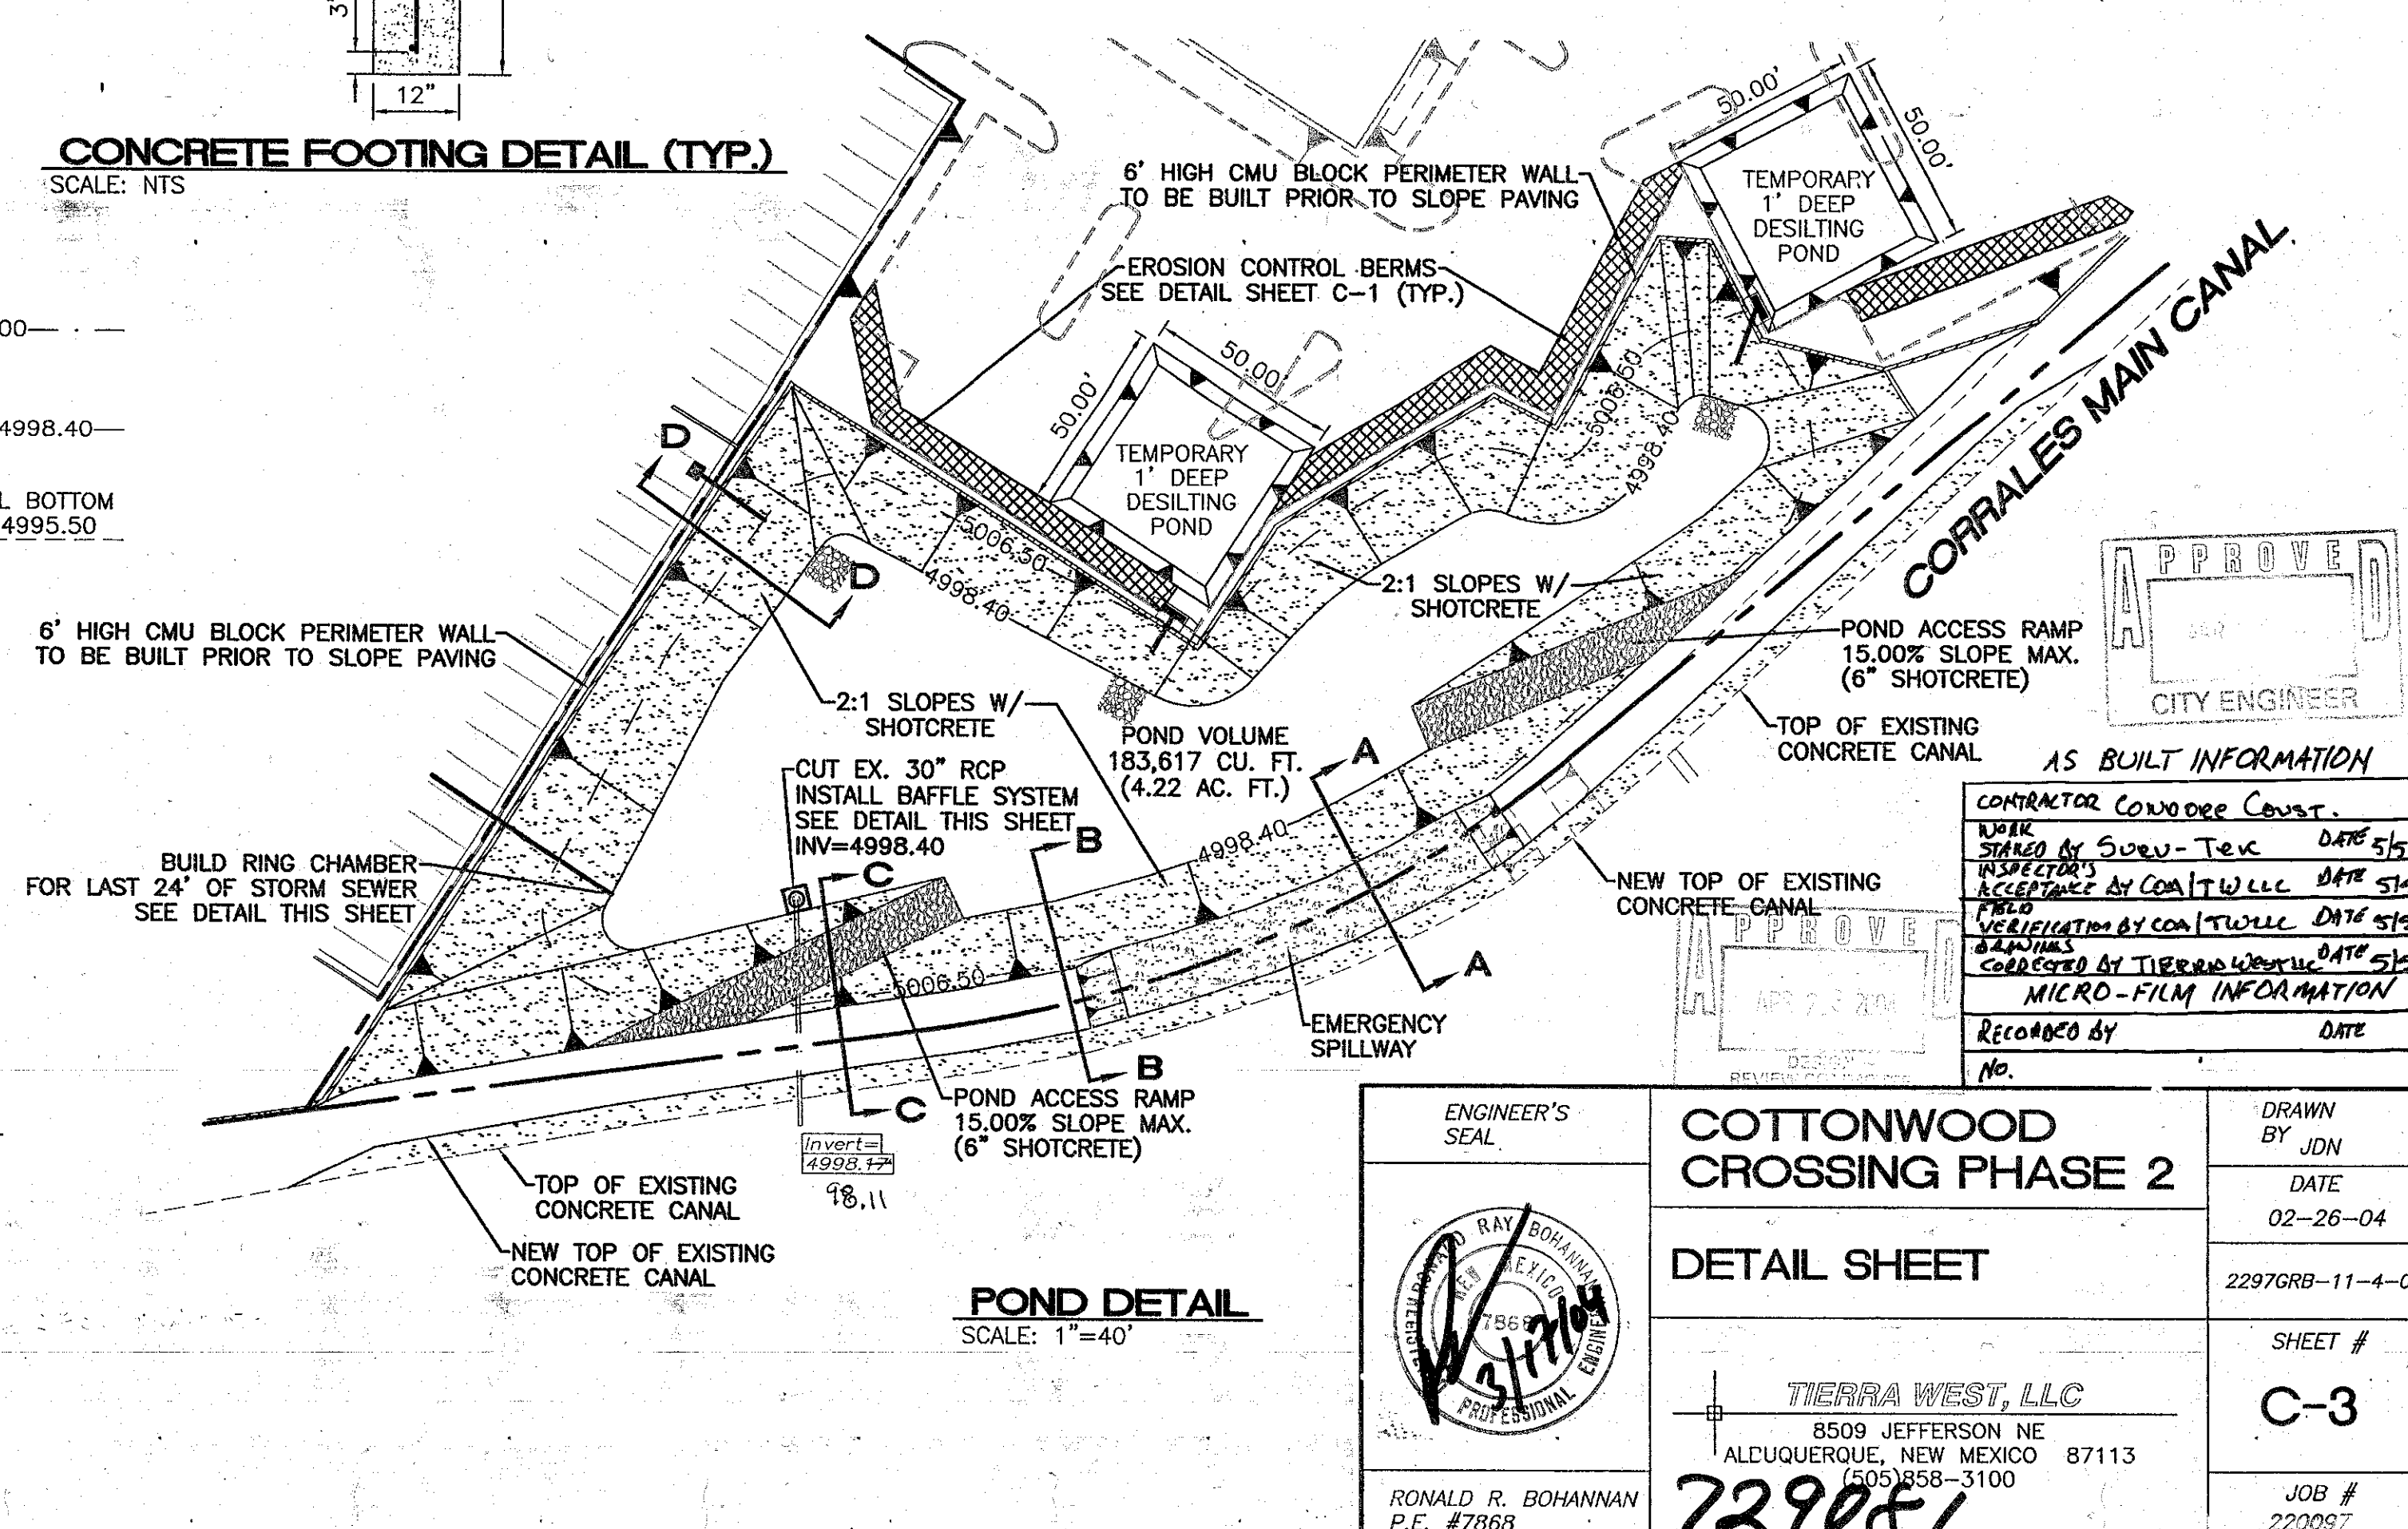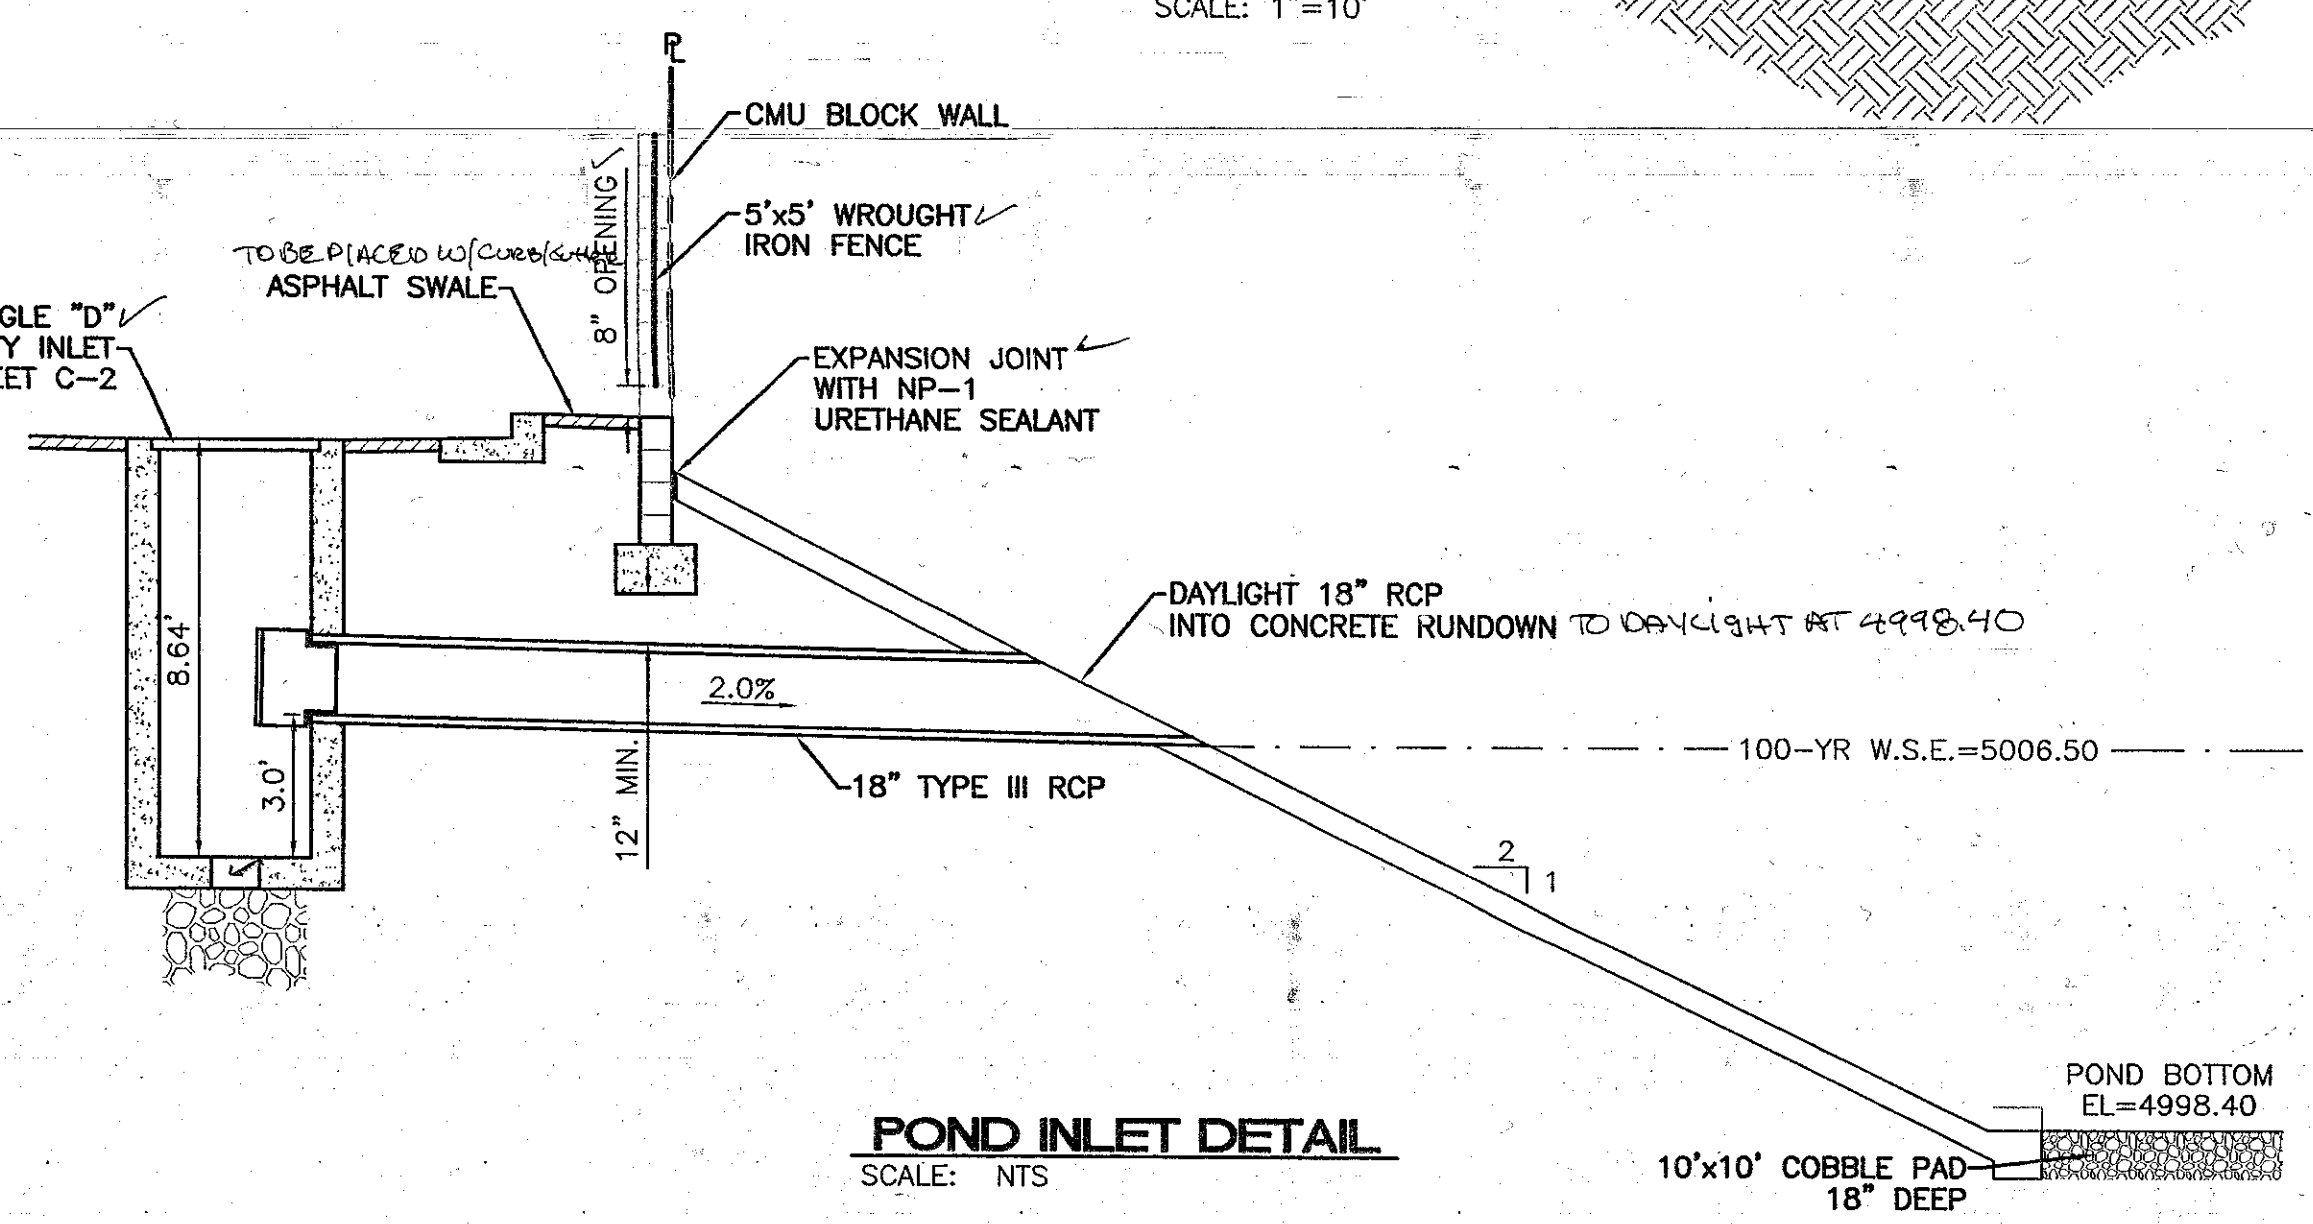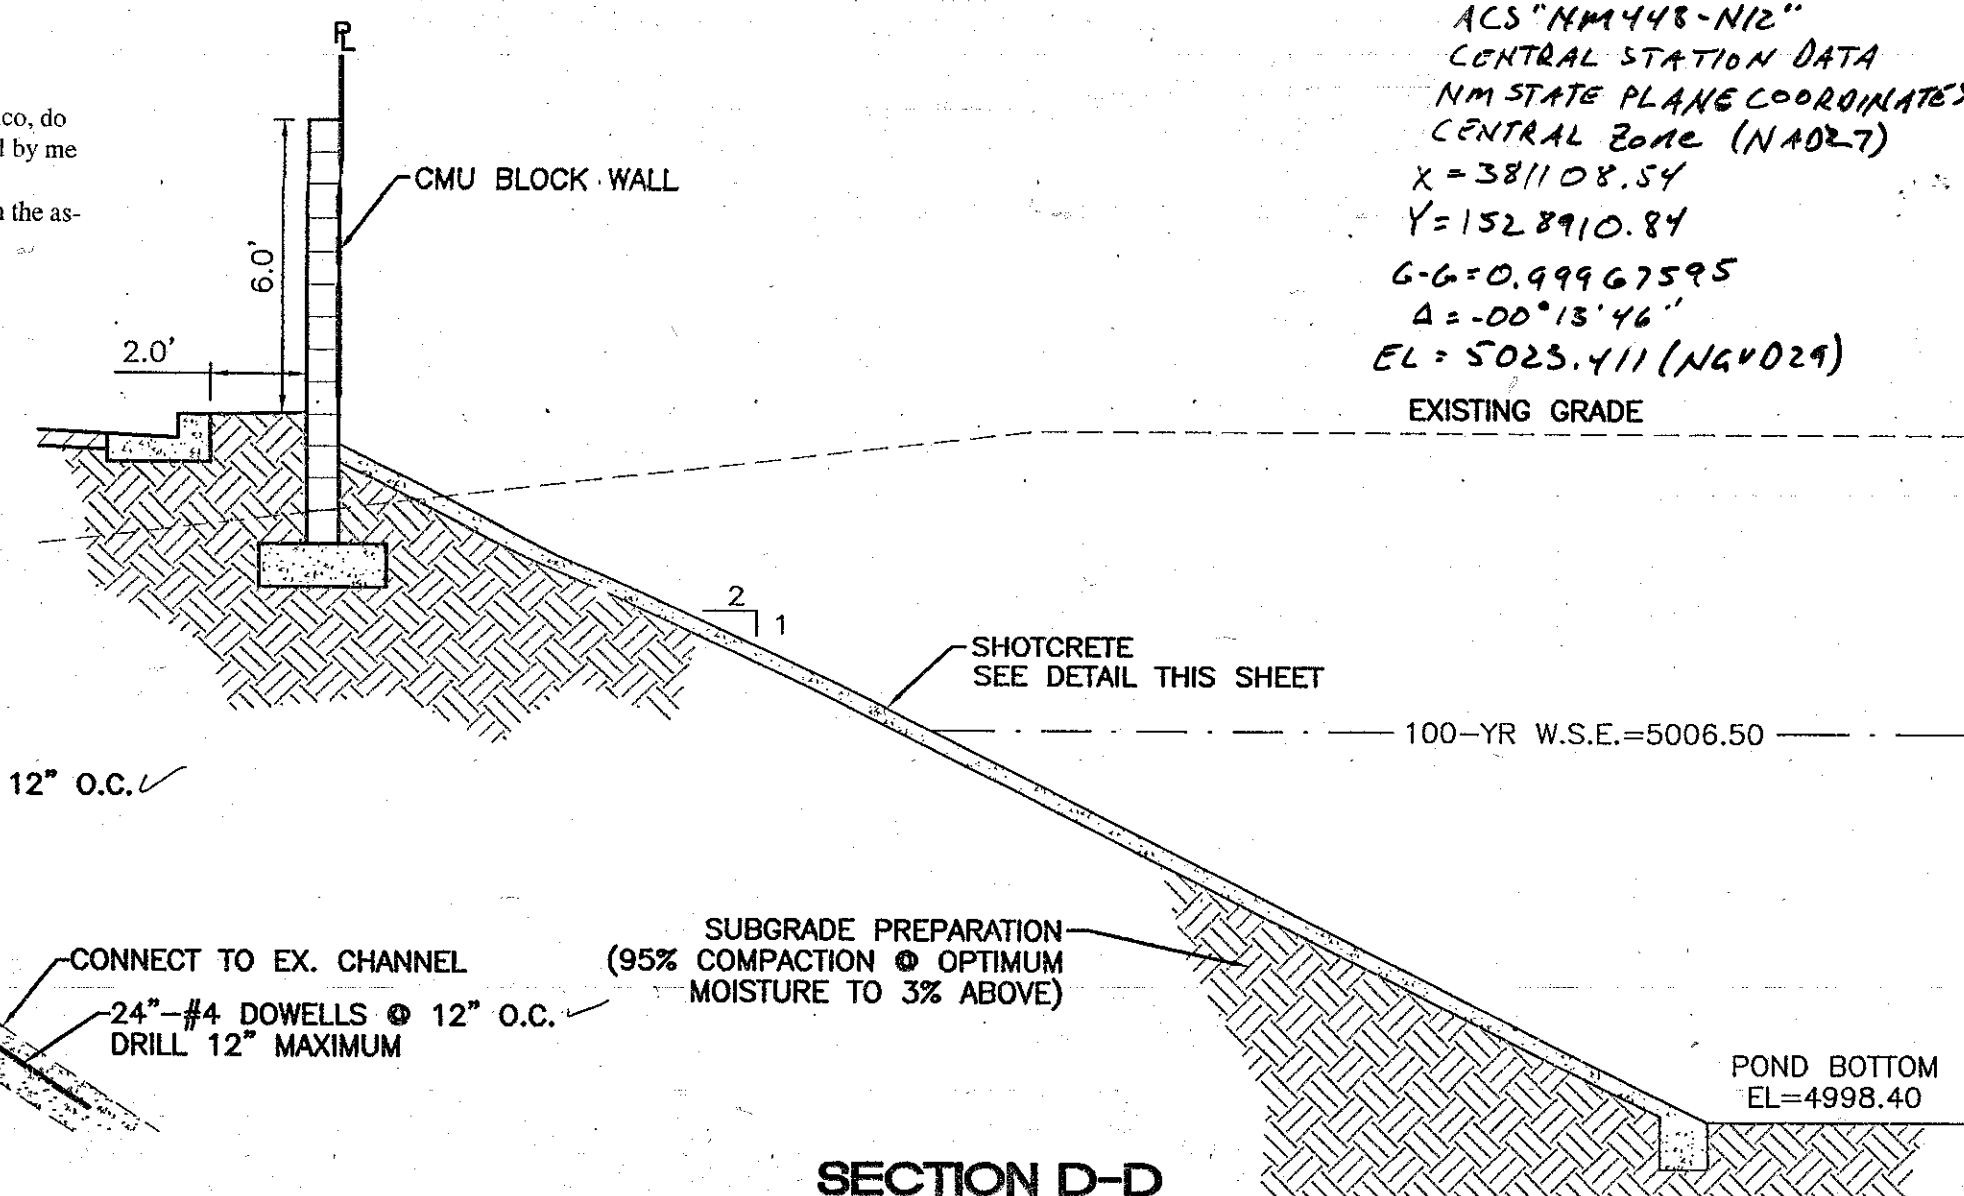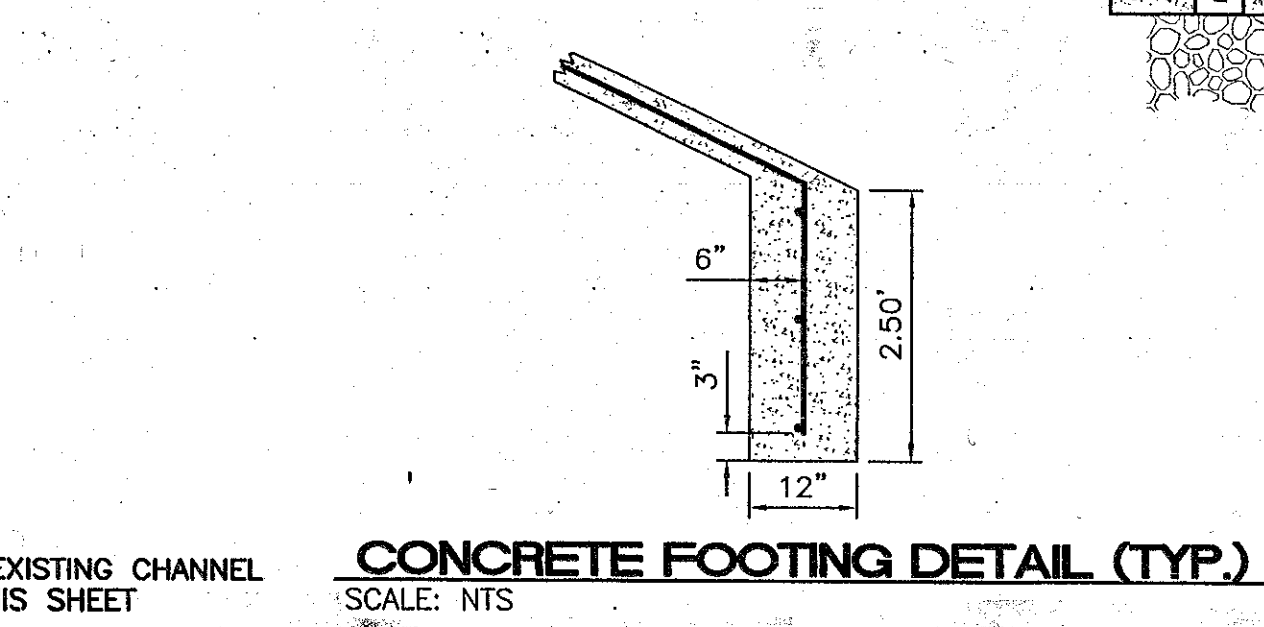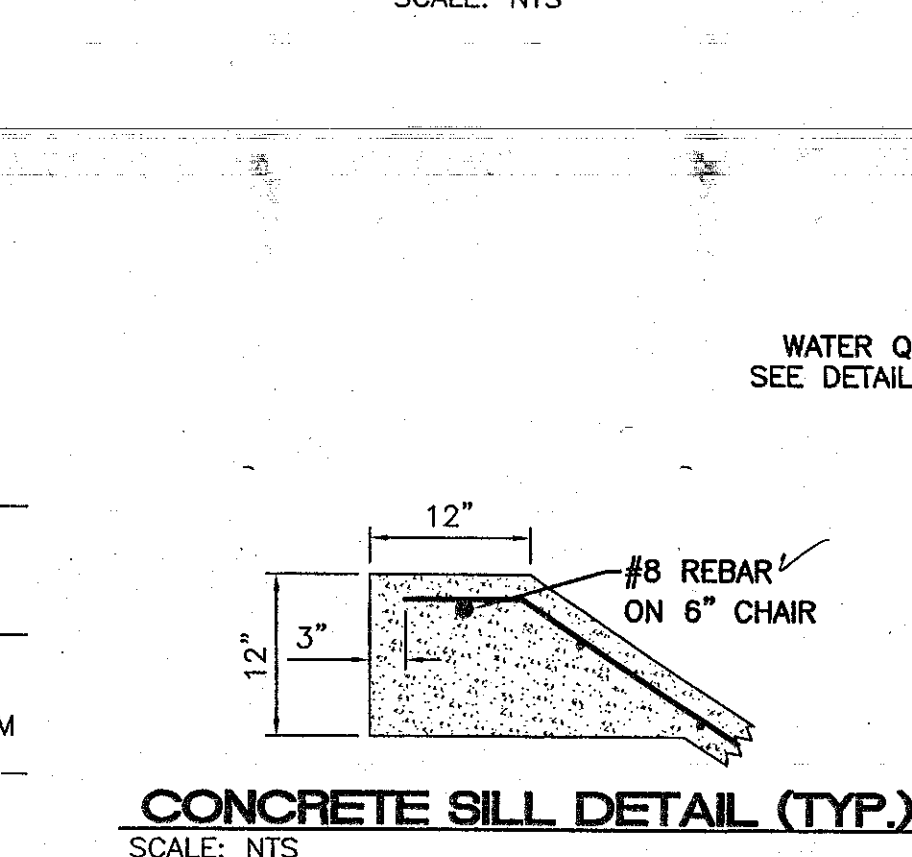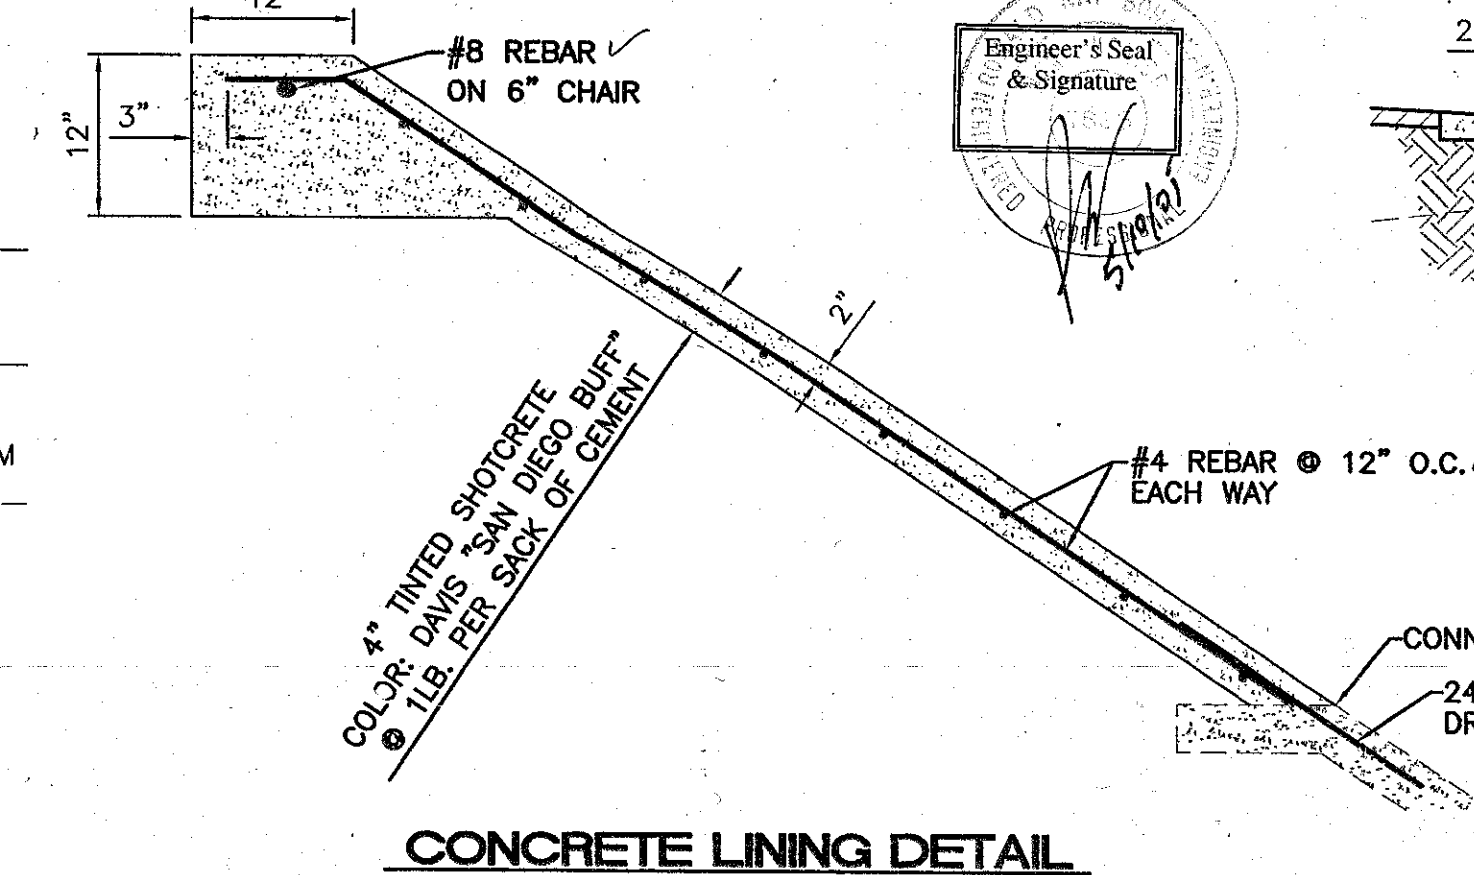

ACS'NM448-N12"
CENTRAL STATION DATA
NM STATE PLANE COORDINATES
CENTRAL ZONE (NAD83)
X=381108.54
Y=1528910.84
G-G=0.99967595
A=00°13'46"
EL=5025.111 (NGVD29)
EXISTING GRADE

APPROVED
CITY ENGINEER

AS BUILT INFORMATION
CONTRACTOR CONCORD CORP.
DATE SIGNED BY SURV-TEK DATE SIGNED BY CITY ENGINEER
INSPECTED BY CONTRACTOR DATE SIGNED BY CITY ENGINEER
FIELD VERIFICATION BY CONTRACTOR DATE SIGNED BY CITY ENGINEER
CONDUCTED BY TIERRA WEST DATE SIGNED BY CITY ENGINEER
MICRO-FILM INFORMATION
RECORDED BY
No.


ENGINEER'S SEAL RONALD R. BOHANNAN P.E. #7868	COTTONWOOD CROSSING PHASE 2	DRAWN BY JDN DATE 02-26-04 2297GRB-11-4-03
	DETAIL SHEET	SHEET # C-3 JOB # 220097

Tierra West, LLC
8509 JEFFERSON NE
ALBUQUERQUE, NEW MEXICO 87113
505-858-3100

729081

LEGEND

- EXISTING SAS MANHOLE
- EXISTING SANITARY SEWER LINE
- PROPOSED SAS MANHOLE
- PROPOSED SAS CLEANOUT
- DIRECTION OF FLOW
- 8" SAS
- PROPOSED SANITARY SEWER LINE
- SANITARY SEWER SERVICE LINE
- EXISTING METER
- EXISTING VALVE W/BOX
- EXISTING FIRE HYDRANT
- EXISTING WATER LINE
- PROPOSED METER
- PROPOSED VALVE W/BOX
- PROPOSED FIRE HYDRANT
- 8" WL
- PROPOSED WATER LINE
- EXISTING STORM SEWER MANHOLE
- EXISTING STORM SEWER LINE
- PROPOSED STORM SEWER MANHOLE
- PROPOSED STORM SEWER LINE
- EXISTING CURB & GUTTER
- PROPOSED CURB & GUTTER
- BOUNDARY LINE
- PROPOSED SIDEWALK
- PROPOSED RETAINING WALL

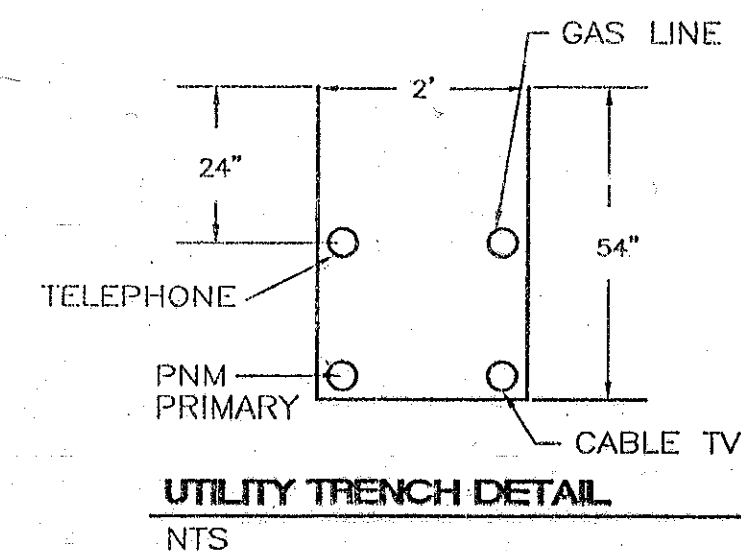

AS BUILT INFORMATION



CONTRACTOR	Cottonwood Crossing
DESIGNED BY	John T. Cox DATE 5-5-05
INVESTIGATED BY	DATE 5-5-05
FIELD VERIFICATION BY	Tierra West, LLC DATE 5-5-05
DATE	5-5-05
COLLECTED BY	Tierra West, LLC DATE 5-5-05
MICRO-FILM INFORMATION	
RECORDED BY	DATE
NO.	

GENERAL NOTES:

1. 4" MINIMUM BURY REQUIRED FOR ALL UTILITIES UNLESS OTHERWISE NOTED.
2. REFERENCE ARCHITECTURAL PLANS FOR WATER LINE RISER LOCATIONS.
3. CLEAN OUTS ARE TO BE BUILT PER UNIFORM PLUMBING CODE STANDARDS.
4. ALL BLOCKING IS PER CITY OF ALBUQUERQUE STANDARD DWG. 2320.
5. ALL PIPE MATERIAL TO BE USED PER UPC.

ACS "N4448-N12"
CENTRAL STATION DATA
NM STATE PLANE COORDINATES
Central Zone (NAD 83)
X=381108.54
Y=1528910.94
G=4=0.99967595
A=-00°13'46"
CL=5023.411 (NAD83)

COORS ROAD NW. (NEW MEXICO STATE HIGHWAY NO. 448)
15' Right of Way

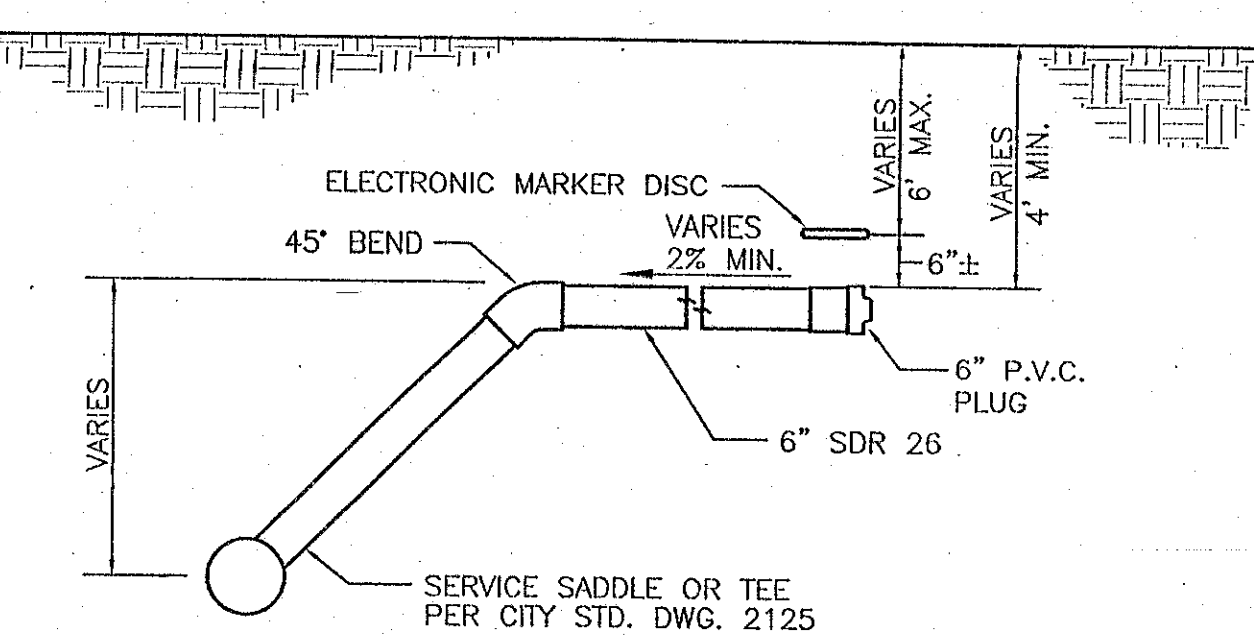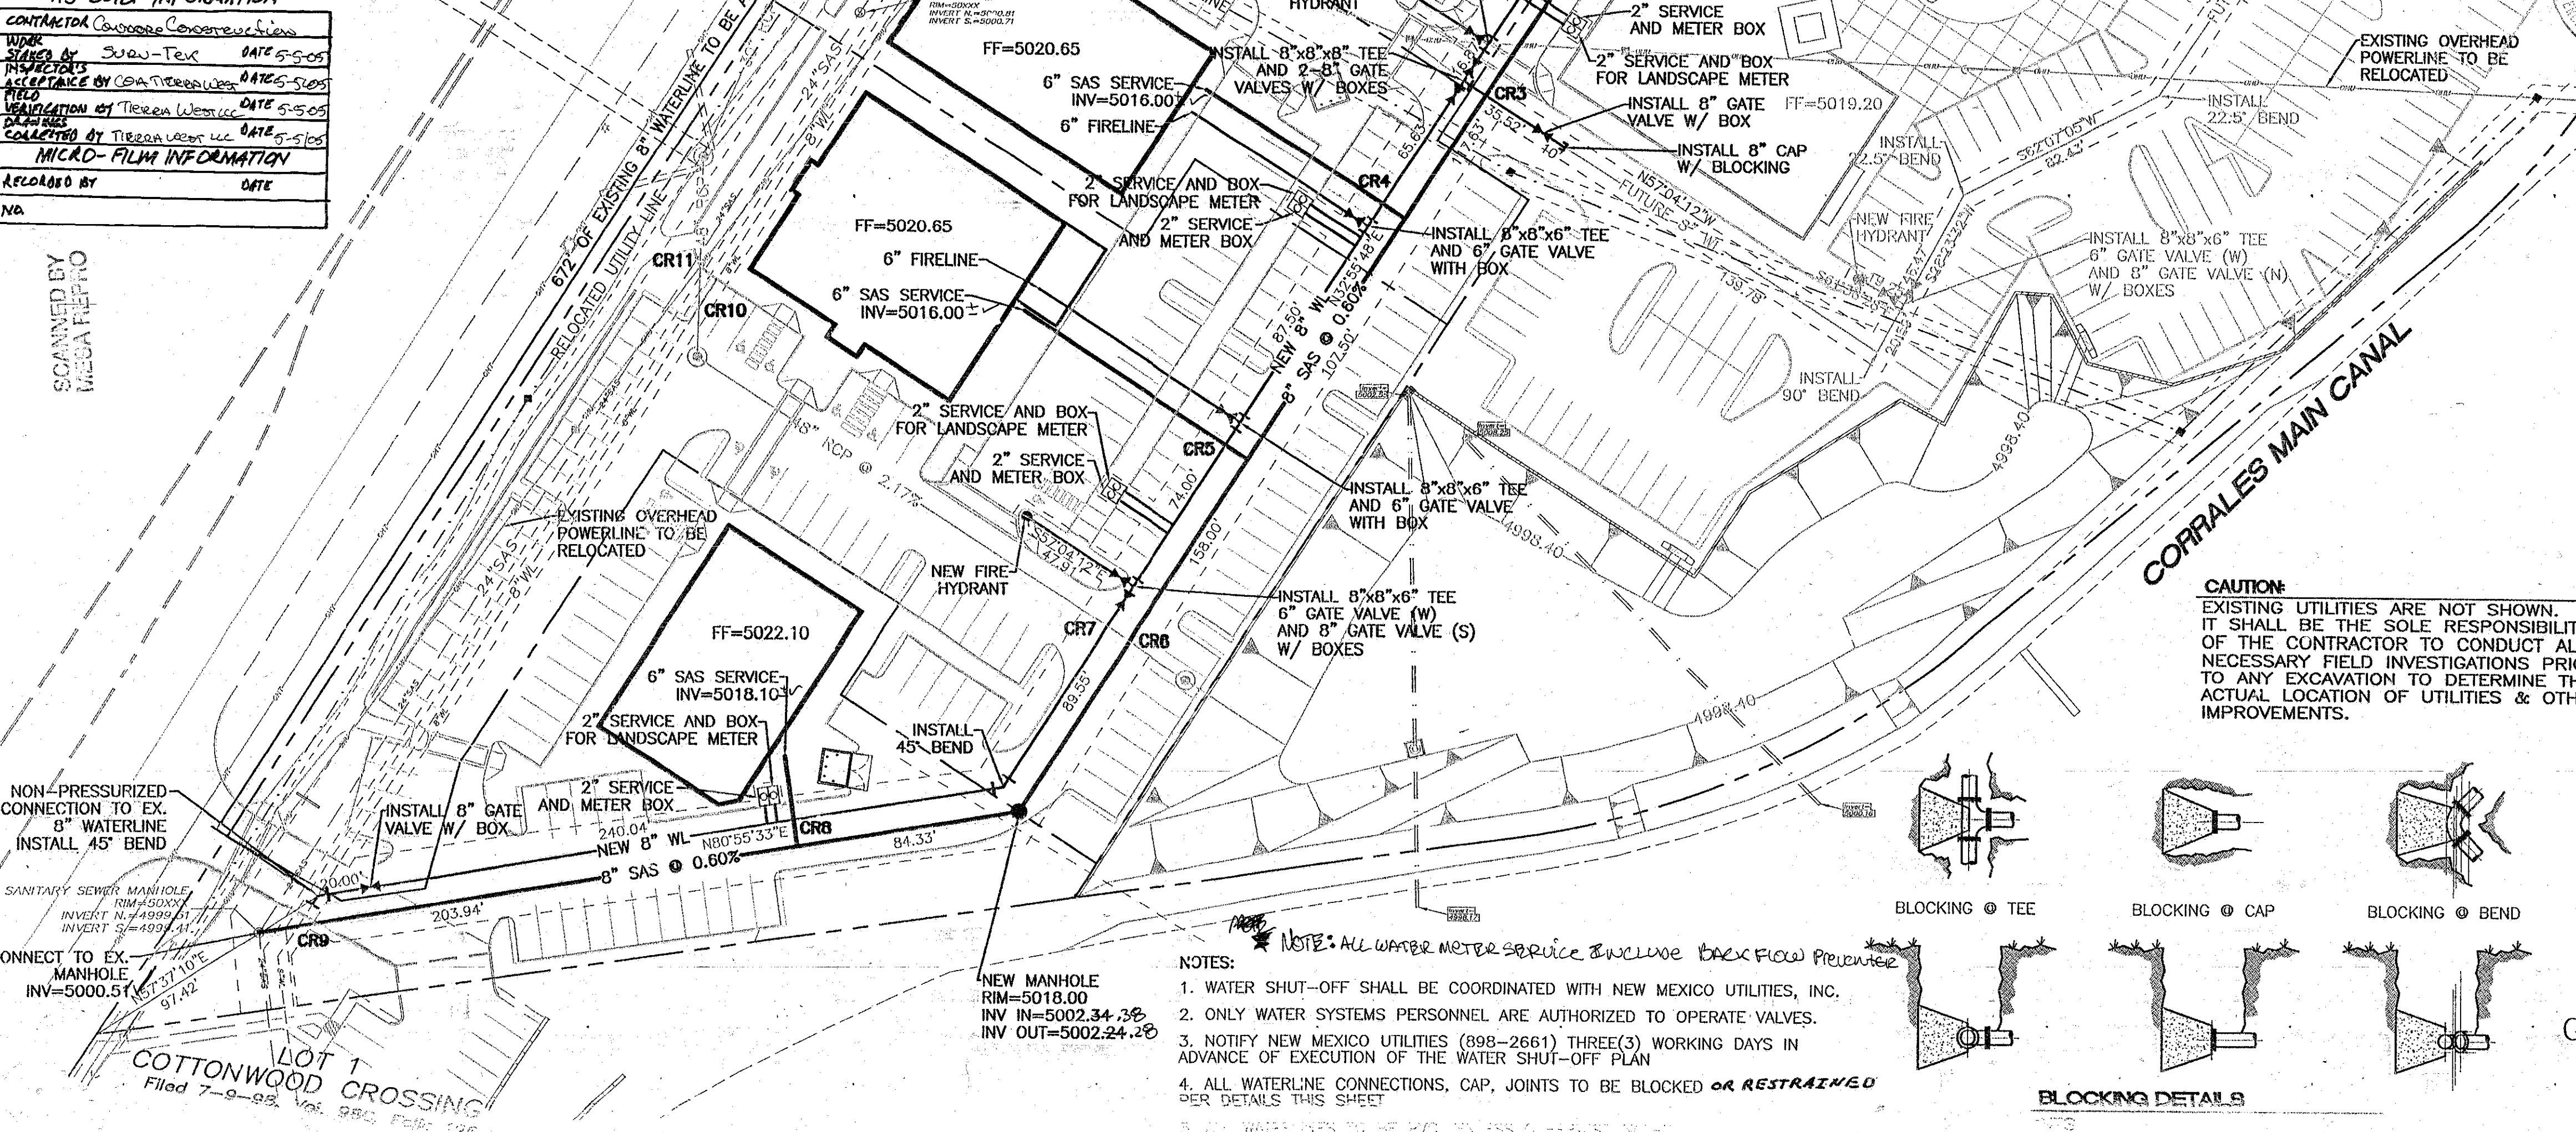

THE FOLLOWING TABLES WERE CREATED USING EBAA ION INC. SOFTWARE FOR RESTRAINING JOINTS WITH THESE CRITERIA:

DEPTH OF BURY: 3.0' MINIMUM
SAFETY FACTOR: 1.5 TO 1
PIPE MATERIAL: PVC
SOIL TYPE: CM/SM-SILTY GRAVEL/SILTY SAND, GRAVEL-SAND MIXTURES
TEST PRESSURE: 150 PSI
TRENCH TYPE 3: PIPE BEDDED IN 4" MINIMUM LOOSE SOIL BACKFILL LIGHTLY CONSOLIDATED TO TOP OF PIPE

THESE LENGTHS WILL BE AFFECTED IF THE TYPE OF MATERIAL, GREATER DEPTH OF BURY, ETC. CHANGES. THESE MUST BE RECALCULATED BY THE DESIGN ENGINEER PRIOR TO CONSTRUCTION.

RESTRAINING JOINT LENGTHS FOR TEES*

SIZE	5'	4'	3'	2'	1'	0'
12x12x12	14	18	22	25	29	33
12x12x10	6	10	14	19	23	28
12x12x8	1	1	7	12	18	23
12x12x6	1	1	1	3	10	18
12x12x4	1	1	1	1	2	12
10x10x10	9	13	17	20	24	28
10x10x8	1	5	10	14	19	23
10x10x6	1	1	1	6	12	18
10x10x4	1	1	1	1	4	12
8x8x8	5	9	13	16	20	23
8x8x6	1	1	3	8	13	18
8x8x4	1	1	1	1	6	12
6x6x6	1	3	7	10	14	18
6x6x4	1	1	1	1	6	12

RESTRAINING JOINT LENGTHS FOR HORIZONTAL BENDS, VALVES, AND DEAD ENDS (EACH SIDE)

SIZE	90°	45°	22-1/2°	11-1/4°	VALVES	DEAD END
12	15	6	3	1	34	
10	13	5	3	1	29	
8	11	4	2	1	24	
6	8	3	2	1	18	
4	6	2	1	N/A	13	

RESTRAINING JOINT LENGTHS FOR VERTICAL OFFSETS/BENDS (EACH SIDE)

SIZE	90°	45°	22-1/2°	11-1/4°
12 UPPER	DON'T USE	14	7	3
12 LOWER	DON'T USE	4	2	1
10 UPPER	DON'T USE	12	6	3
10 LOWER	DON'T USE	3	2	1
8 UPPER	DON'T USE	10	5	1
8 LOWER	DON'T USE	3	1	1
6 UPPER	DON'T USE	8	4	2
6 LOWER	DON'T USE	2	1	N/A
4 UPPER	DON'T USE	5	3	1
4 LOWER	DON'T USE	1	1	N/A



NOTICE TO CONTRACTORS

1. AN EXCAVATION/CONSTRUCTION PERMIT WILL BE REQUIRED BEFORE BEGINNING ANY WORK WITHIN CITY RIGHT-OF-WAY. AN APPROVED COPY OF THESE PLANS MUST BE SUBMITTED AT THE TIME OF APPLICATION FOR THIS PERMIT.
2. ALL WORK DETAILED ON THESE PLANS TO BE PERFORMED, EXCEPT AS OTHERWISE STATED OR PROVIDED HEREON, SHALL BE CONSTRUCTED IN ACCORDANCE WITH STANDARDS OF NEW MEXICO UTILITIES INCORPORATED AND WITH CITY OF ALBUQUERQUE INTERIM STANDARD SPECIFICATIONS FOR PUBLIC WORKS CONSTRUCTION, 1985.
3. TWO WORKING DAYS PRIOR TO ANY EXCAVATION, CONTRACTOR MUST CONTACT NEW MEXICO ONE CALL SYSTEM (260-1999), FOR LOCATION OF EXISTING UTILITIES.
4. PRIOR TO CONSTRUCTION, THE CONTRACTOR SHALL EXCAVATE AND VERIFY THE HORIZONTAL AND VERTICAL LOCATIONS OF ALL CONSTRUCTIONS. SHOULD A CONFLICT EXIST, THE CONTRACTOR SHALL NOTIFY THE ENGINEER SO THAT THE CONFLICT CAN BE RESOLVED WITH A MINIMUM AMOUNT OF DELAY.
5. BACKFILL COMPACTION SHALL BE ACCORDING TO RESIDENTIAL STREET USE.
6. MAINTENANCE OF THOSE FACILITIES NOT WITHIN DEDICATED EASEMENTS SHALL BE THE RESPONSIBILITY OF THE OWNER OF THE PROPERTY SERVED.
7. WORK ON ARTERIAL STREETS SHALL BE PERFORMED ON A 24-HOUR BASIS.
8. CONTRACTOR IS RESPONSIBLE TO PROVIDE UTILITY STUBS 5' FROM BUILDING

UTILITY CROSSING TABLE

LABEL	INV OF SAS PIPE	TOP OF SAS PIPE	BOTTOM OF WL	TOP OF WL	INV OF SD PIPE	TOP OF SD PIPE
CR1	5005.63	5006.30	5017.73	5018.40	-	-
CR2	5012.30	5012.97	5015.76	5016.43	-	-
CR3	5004.27	5004.94	5012.53	5013.20	-	-
CR4	5009.68	5010.18	5012.17	5012.84	-	-
CR5	5008.74	5009.24	5011.79	5012.46	-	-
CR6	5002.80	5003.47	-	-	5005.56	5009.81
CR7	-	-	5013.06	5013.73	5005.77	5010.02
CR8	5014.90	5015.40	5016.92	5017.59	-	-
CR9	5000.63	5001.30	5025.33	5026.00	-	-
CR10	-	-	5016.33	5017.00	5010.28	5014.53
CR11	5000.39	5002.64	-	-	5010.71	5014.96

CAUTION:
EXISTING UTILITIES ARE NOT SHOWN. IT SHALL BE THE SOLE RESPONSIBILITY OF THE CONTRACTOR TO CONDUCT ALL NECESSARY FIELD INVESTIGATIONS PRIOR TO ANY EXCAVATION TO DETERMINE THE ACTUAL LOCATION OF UTILITIES & OTHER IMPROVEMENTS.

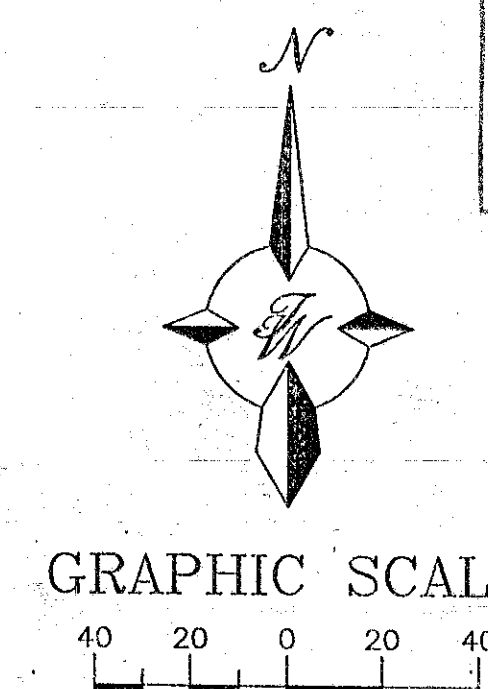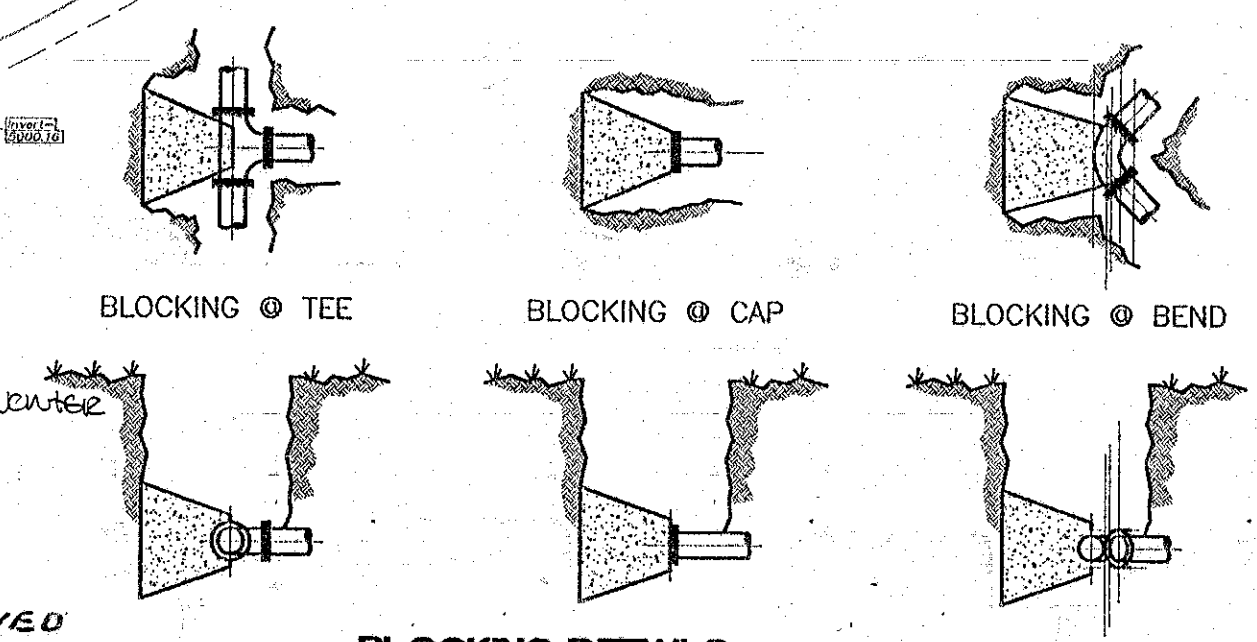

APPROVED

APR 23 2004

DESIGN REVIEW COMMITTEE

ENGINEER'S SEAL

RONALD R. BOHANNAN

APPROVED

APR 23 2004

CITY ENGINEER

COTTONWOOD CROSSING PHASE 2

MASTER UTILITY PLAN

TIERRA WEST, LLC

8509 JEFFERSON NE

ALBUQUERQUE, NEW MEXICO 87113

(505)858-3100

DATE

01-29-04


2297MUB-11-03-03

SHEET #

C-4

JOB #

- NOTE: ALL WATER METER SERVICE ENCLOSE BACK FLOW PREVENTER
- NOTES:
1. WATER SHUT-OFF SHALL BE COORDINATED WITH NEW MEXICO UTILITIES, INC.
 2. ONLY WATER SYSTEMS PERSONNEL ARE AUTHORIZED TO OPERATE VALVES.
 3. NOTIFY NEW MEXICO UTILITIES (898-2661) THREE(3) WORKING DAYS IN ADVANCE OF EXECUTION OF THE WATER SHUT-OFF PLAN
 4. ALL WATERLINE CONNECTIONS, CAP, JOINTS TO BE BLOCKED OR RESTRAINED PER DETAILS THIS SHEET
 5. ALL WATERLINES TO BE PROTECTED BY 18" MIN. COVER TO TOP OF PIPE

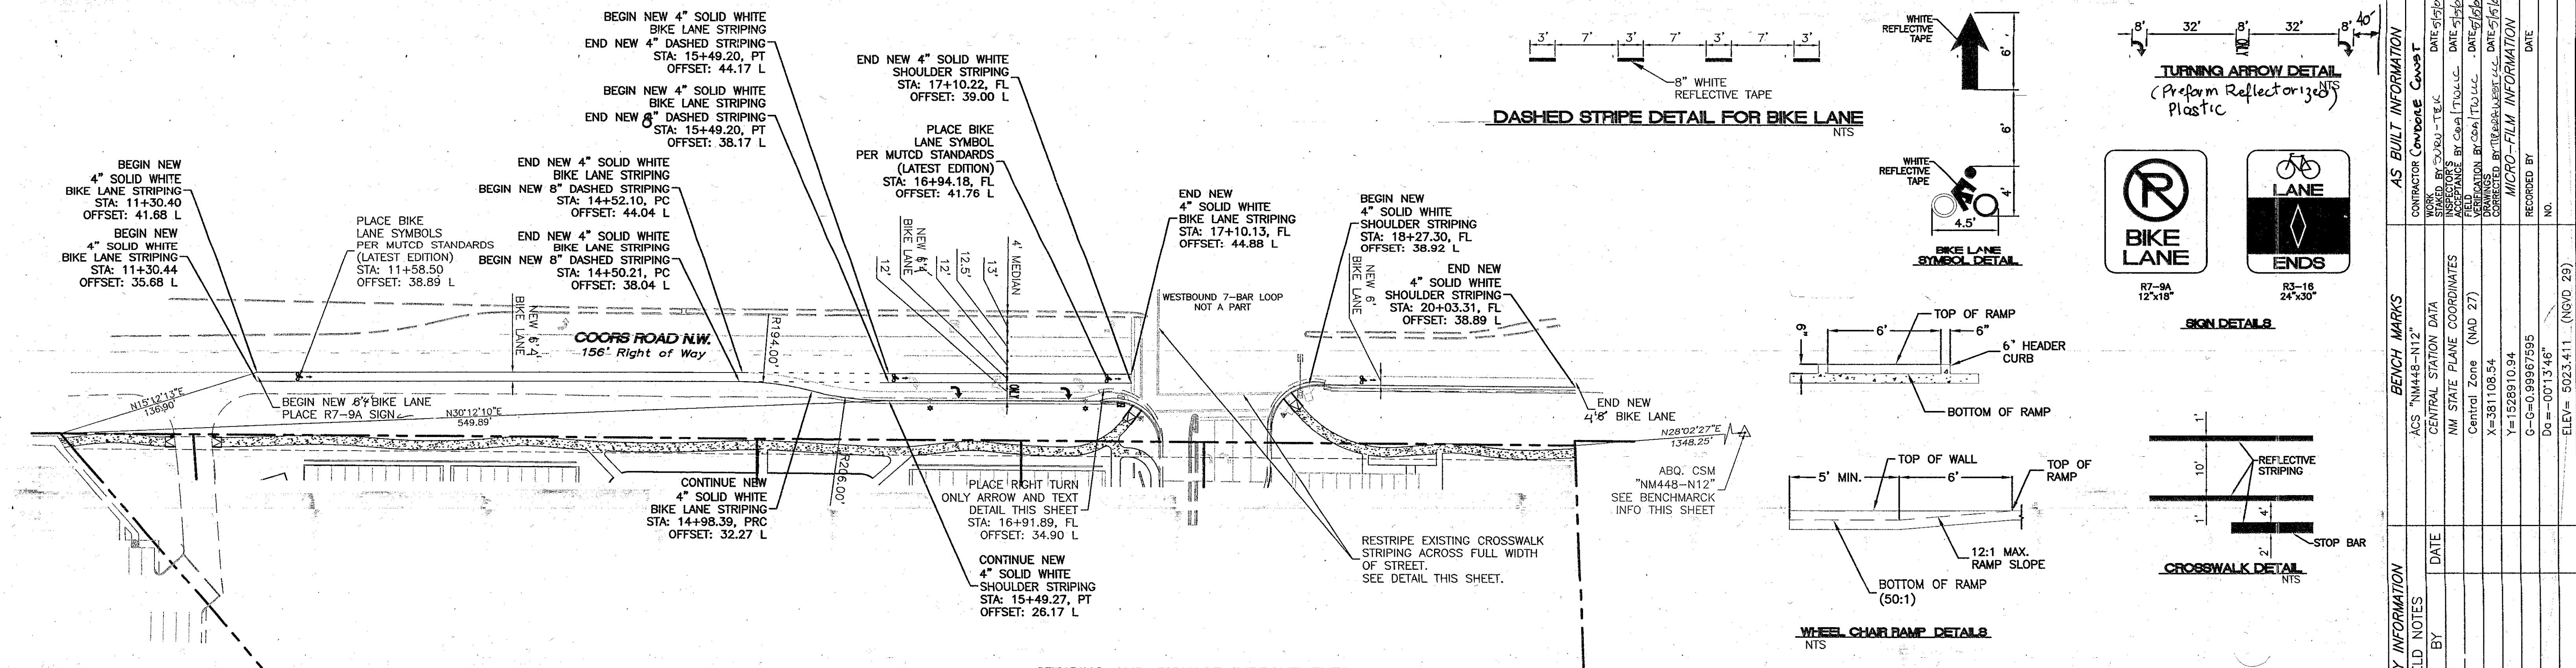

- SPECIAL PROJECT TRAFFIC CONTROL NOTES**
- ONLY SINGLE LANE CLOSURES ON COORS BLVD. WILL BE ALLOWED FOR CONSTRUCTION OF THIS PROJECT.
 - ARTERIAL/COLLECTOR ROAD USAGE FEES OF \$0.01 PER SQUARE FOOT OF BARRICADED AREA PER DAY WILL BE ASSESSED ON ALL LANE CLOSURES ON COORS BLVD.
 - CONTRACTOR MUST PERFORM AS MUCH WORK AS POSSIBLE BEHIND THE EXISTING CURB AND GUTTER PRIOR TO AFFECTING TRAFFIC ON COORS BLVD.
 - LANE CLOSURES ON COORS BLVD. WILL ONLY BE ALLOWED BETWEEN THE HOURS FROM 9:00 AM TO 3:00 PM DAILY, IF THE LANE CLOSURES MUST REMAIN IN PLACE DUE TO SAFETY CONCERNS (I.E. DROP OFFS), THEN THE CONTRACTOR MUST WORK CONTINUOUSLY, 24-HOURS PER DAY, UNTIL THE LANE IS RE-OPENED TO TRAFFIC.




- NOTES**
- BASIS FOR STATIONING IS PROP. LINE / R.O.W.
 - REMOVE EXISTING ROAD STRIPING AND REPLACE.
 - RELOCATION OF LIGHT POLES TO BE COORDINATED BY PNM.
 - BUILD CURB & GUTTER PER COA STD DWG #2415A.
 - STRIPING ERADICATION SHALL BE ACCOMPLISHED BY WATER BLASTING OR SURFACE PLANING OF THE ROADWAY TO A MAXIMUM DEPTH OF .25 INCHES AND FOR A WIDTH EQUAL TO TWO TIMES THE WIDTH OF THE STRIPE OR MARKING TO BE REMOVED.

CERTIFICATE OF SUBSTANTIAL COMPLIANCE ON PLANS


I, Ronald R. Bohannon, of the firm of Tierra West LLC, a Registered Professional Engineer in the State of New Mexico, do hereby certify, to the best of my knowledge and belief, that the infrastructure installed as part of this project has been inspected by me or by a qualified person under my direct supervision and has been constructed in accordance with the plans and specifications approved by the City Engineer and that the original design intent of the approved plans has been met, except as noted by me on the as-built construction drawings. This Certification is based on site inspections by me, or personnel under my direction with survey information provided by _____ of _____, Survey-Tek Inc., NMPS number 9750.

QUARTER POINTS

C1	FL	ELEV.	C2	FL	ELEV.
1	5027.89		4	5028.24	
2	5027.93		5	5028.47	
3	5027.96		6	5028.69	

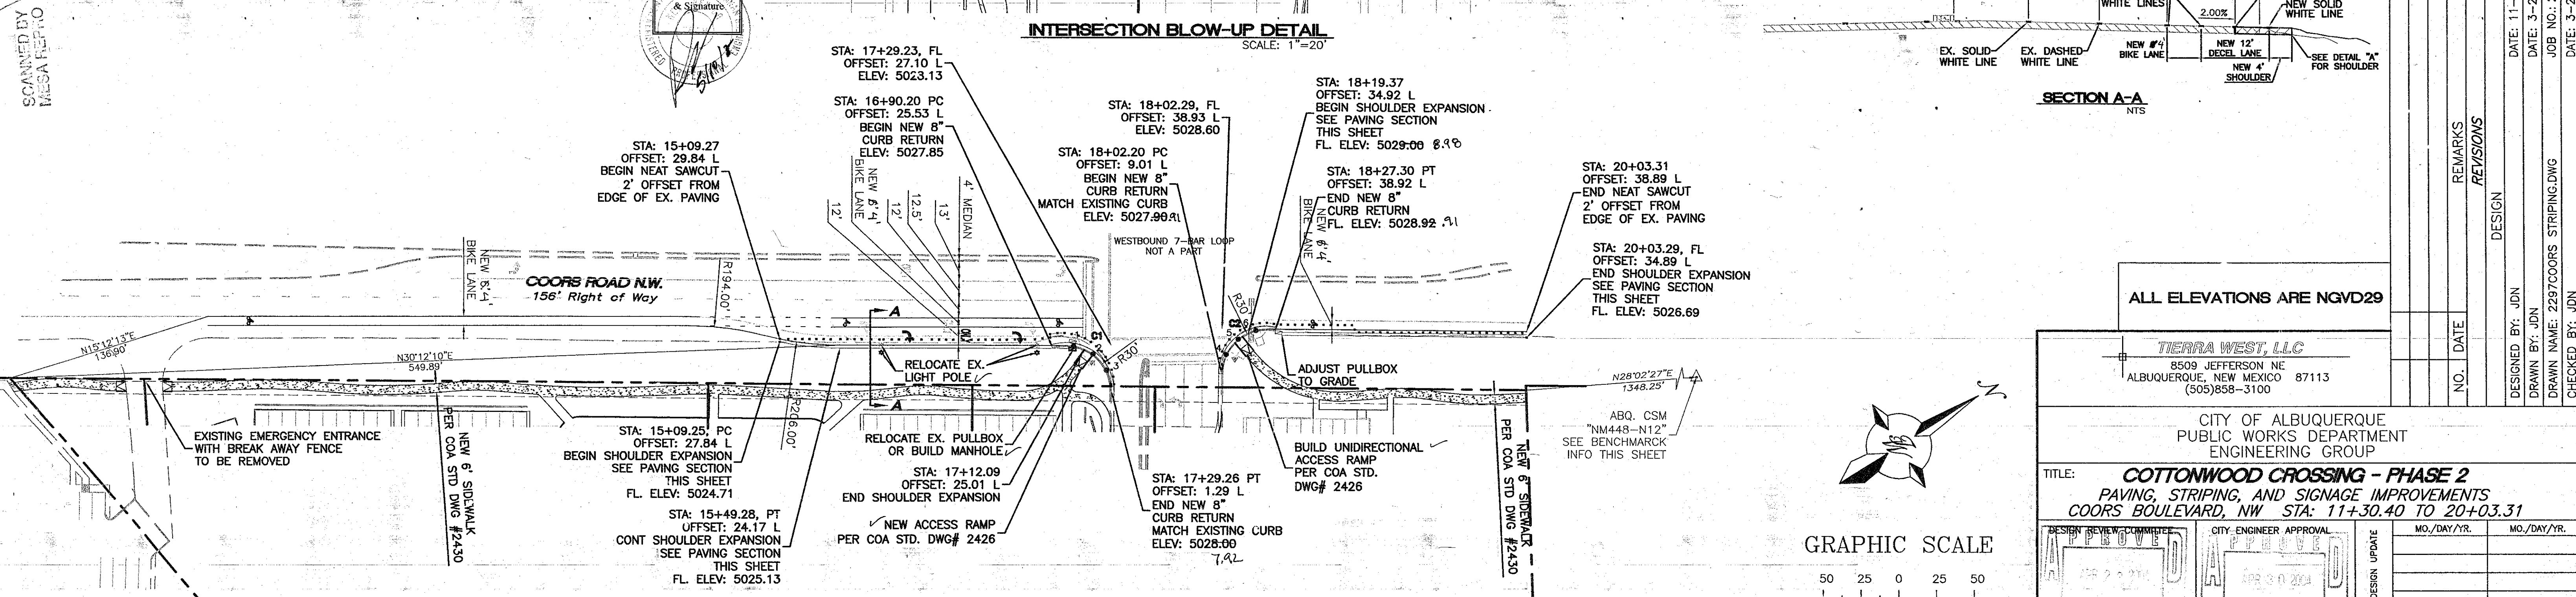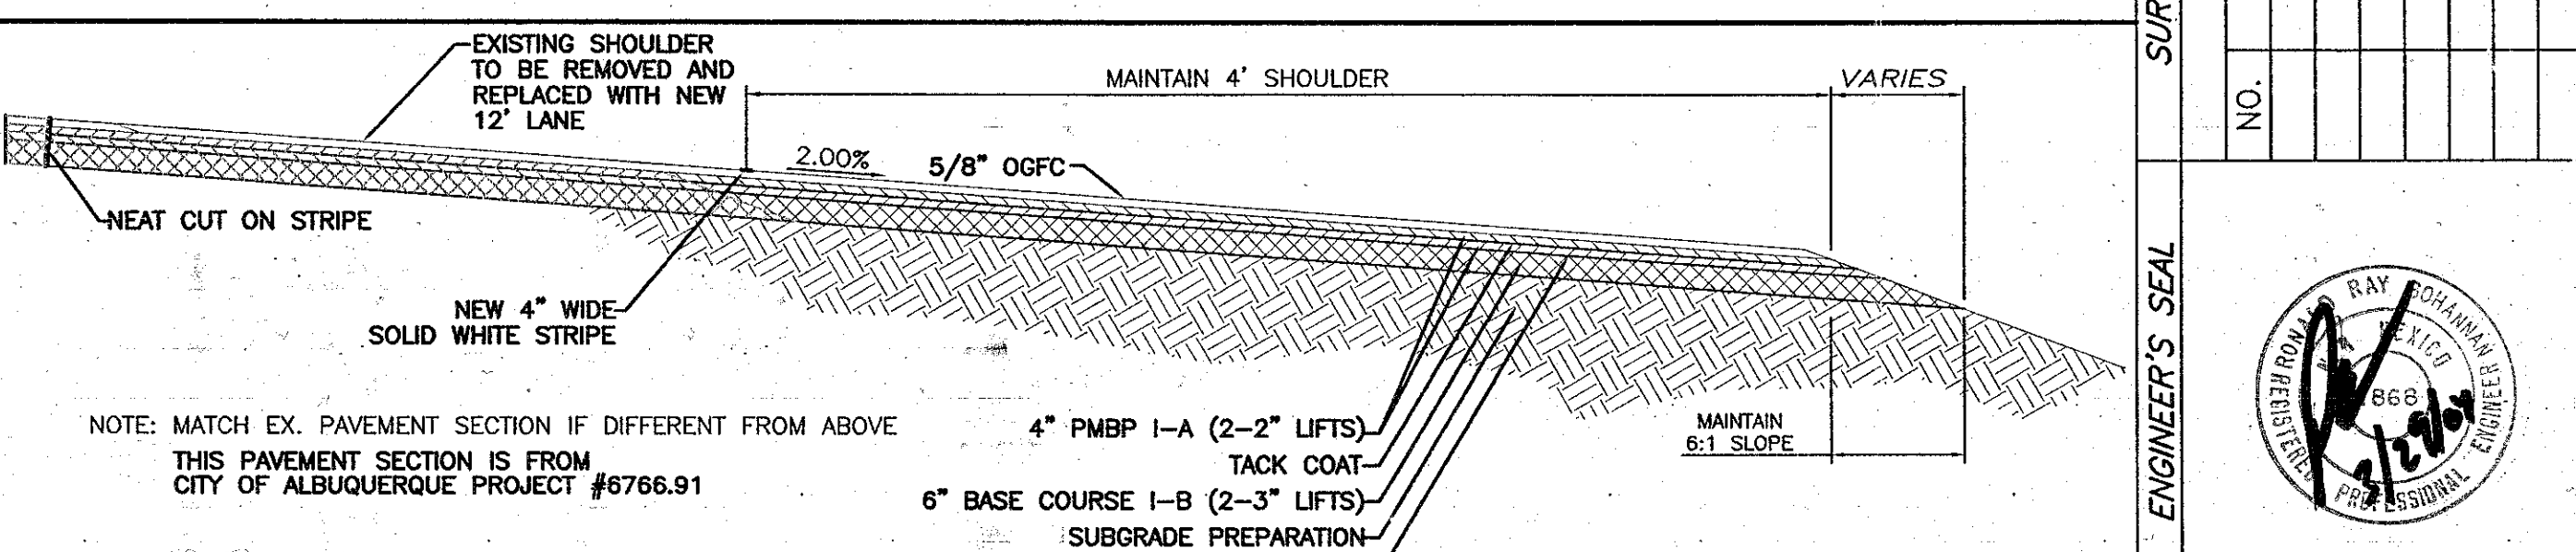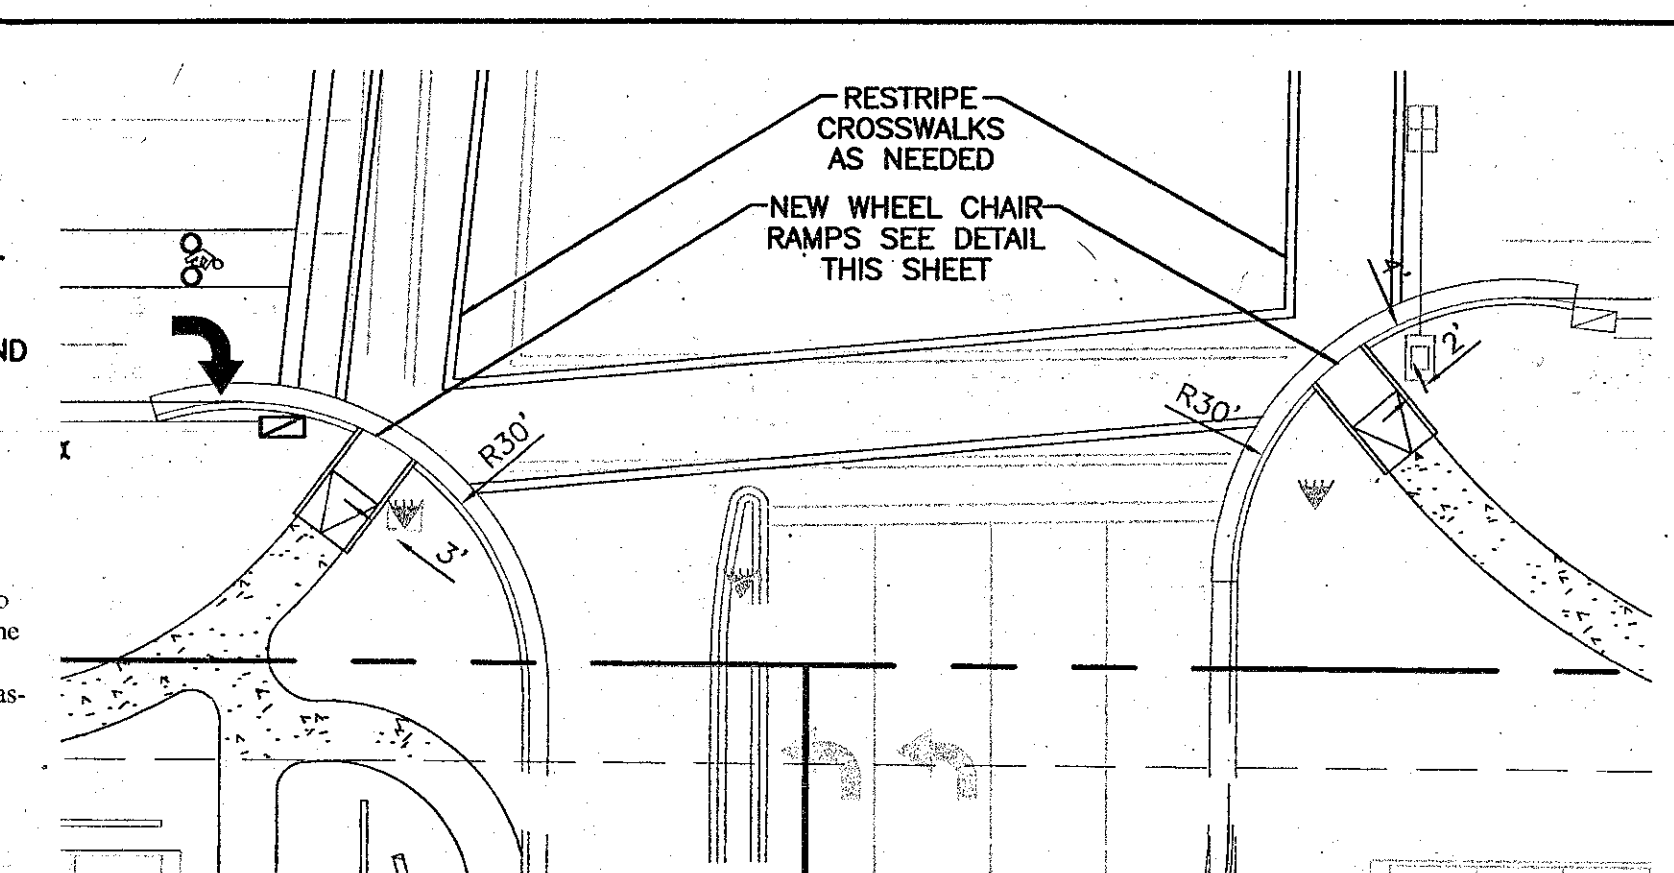

SCANNED BY
MESA REPRO

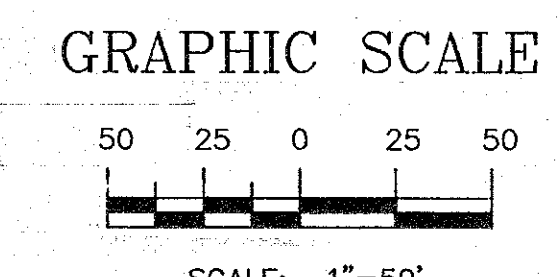

TIERRA WEST, LLC
8509 JEFFERSON NE
ALBUQUERQUE, NEW MEXICO 87113
(505)858-3100

CITY OF ALBUQUERQUE
PUBLIC WORKS DEPARTMENT
ENGINEERING GROUP

TITLE: COTTONWOOD CROSSING - PHASE 2
PAVING, STRIPING, AND SIGNAGE IMPROVEMENTS
COORS BOULEVARD, NW STA: 11+30.40 TO 20+03.31

DESIGN REVIEW COMMITTEE: [Signature]
CITY ENGINEER APPROVAL: [Signature]
CITY ENGINEER


DESIGNED BY: JDN
DRAWN BY: JDN
CHECKED BY: JDN

DATE: 11-5-03
DATE: 3-28-2004
JOB NO: 220097
DATE: 3-2004


CITY PROJECT NO. **729081** ZONE MAP NO. **B-14-Z** SHEET **8** OF **9**

10+00 11+00 12+00 13+00 14+00 15+00 16+00

SCANNED BY
MESA REPORT

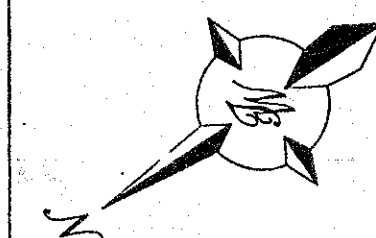


SCALE: HORIZ. 1"=50'
VERT. 1"= 5'

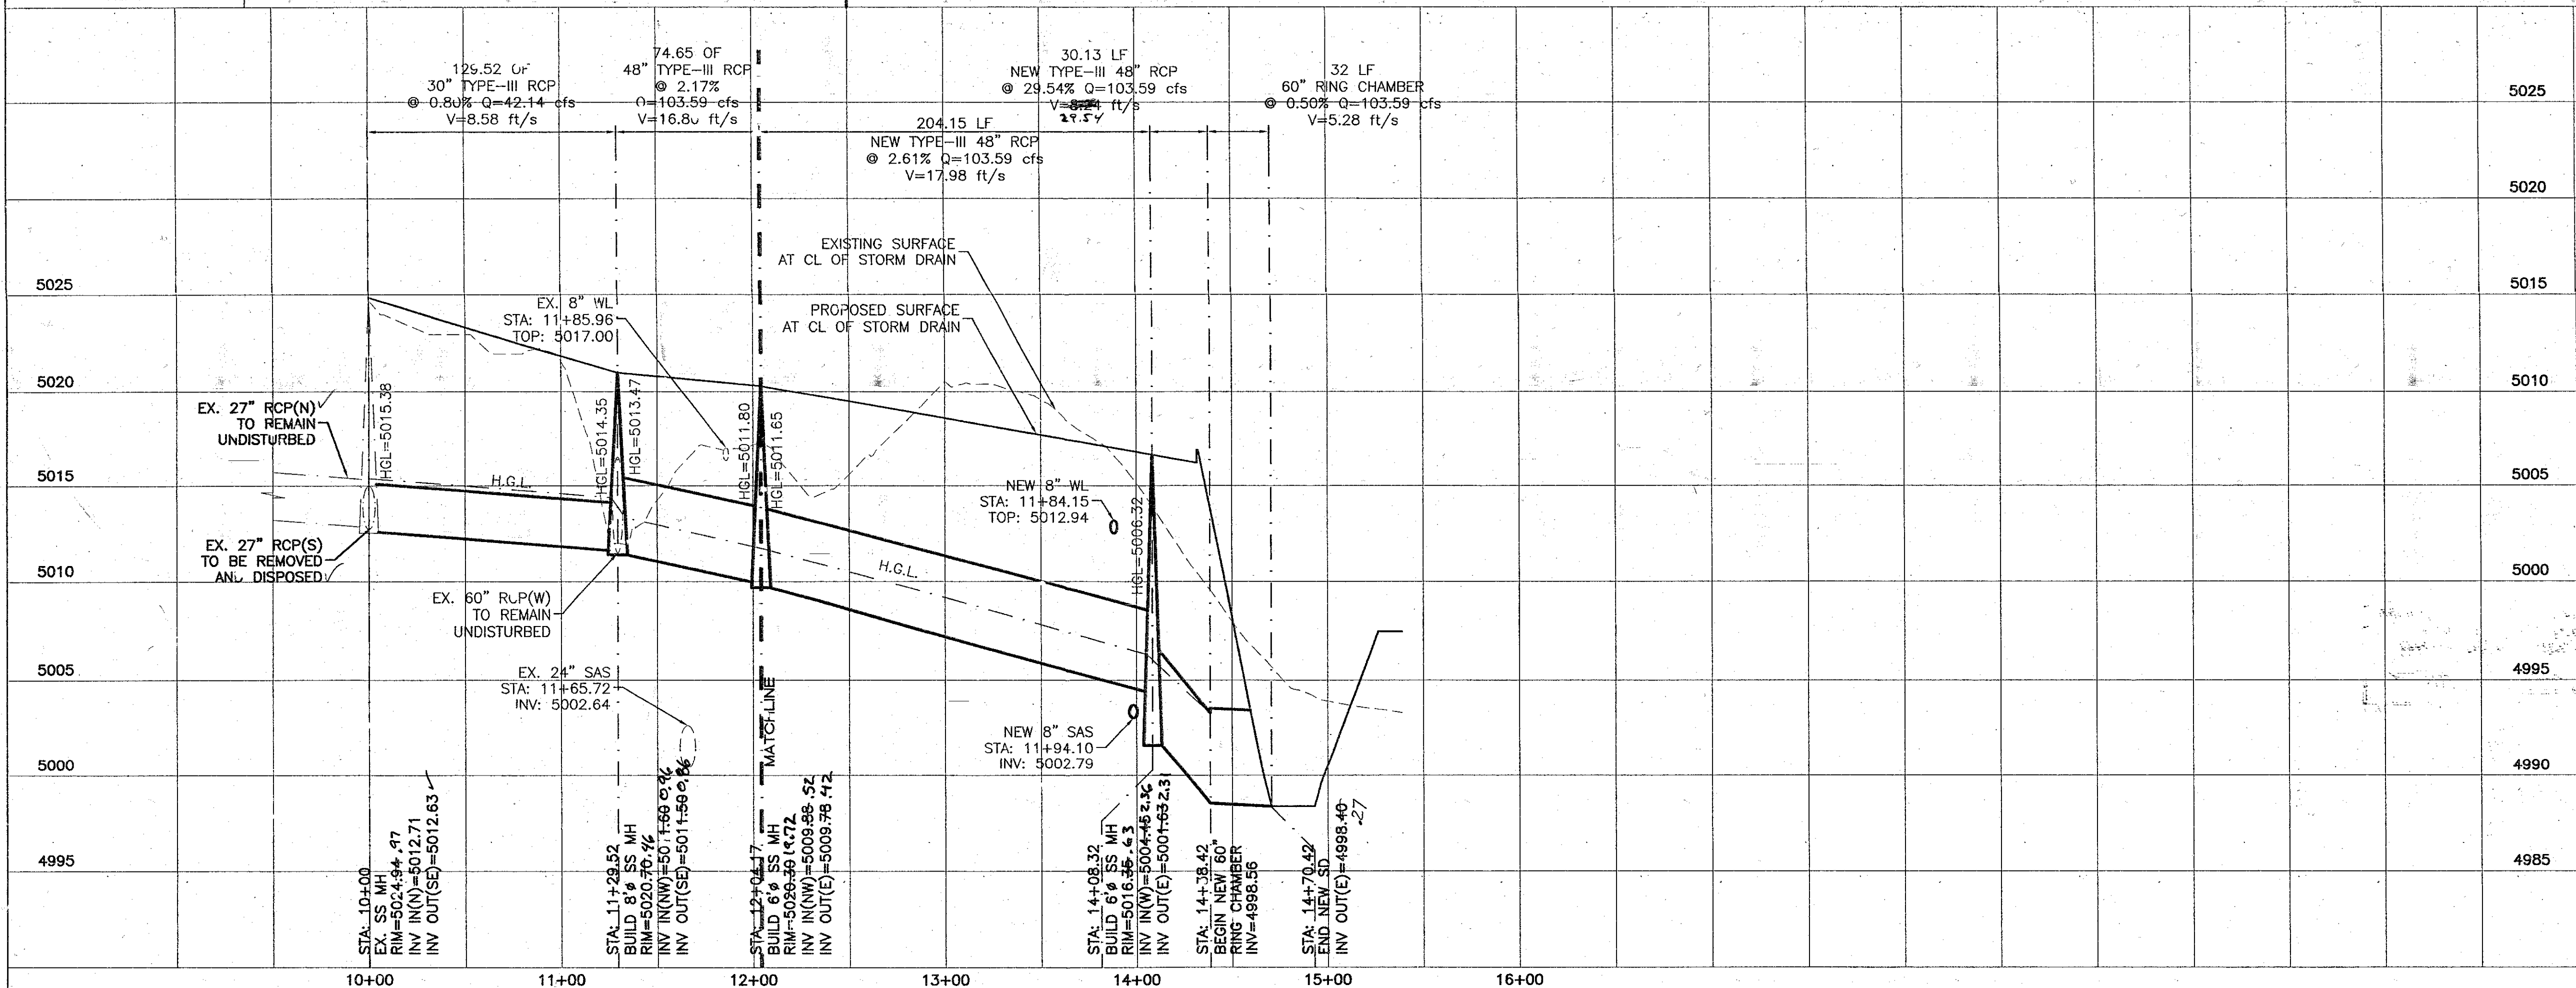

10+00 11+00 12+00 13+00 14+00 15+00 16+00

CERTIFICATE OF SUBSTANTIAL COMPLIANCE ON PLANS

I, Ronald R. Bohannon, of the firm of Tierra West LLC, a Registered Professional Engineer in the State of New Mexico, do hereby certify, to the best of my knowledge and belief, that the infrastructure installed as part of this project has been inspected by me or by a qualified person under my direct supervision and has been constructed in accordance with the plans and specifications approved by the City Engineer and that the original design intent of the approved plans has been met, except as noted by me on the as-built construction drawings. This Certification is based on site inspections by me, or personnel under my direction with survey information provided by
Russ Huggs, of Surv-Tek Inc., NMPS number 9750

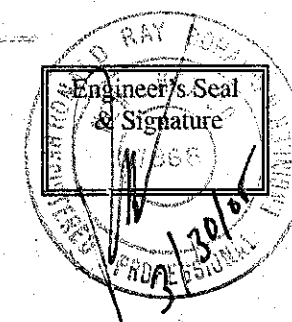

SCALE: HORIZ. 1"=50'
VERT. 1"= 5'

ALL ELEVATIONS ARE NGVD29

AS BUILT INFORMATION		BENCH MARKS		SURVEY INFORMATION		ENGINEER'S SEAL	
CONTRACTOR	DATE	NO.	BY	DATE	NO.	REMARKS	BY
CONTRACTOR: CONQUEST CONSULTING	DATE: 10/15/04						
WORK: STORM DRAIN	DATE: 10/15/04						
INSPECTOR'S NAME: BOHANNON	DATE: 10/15/04						
FIELD VERIFICATION BY: BOHANNON	DATE: 10/15/04						
CORRECTED BY: BOHANNON	DATE: 10/15/04						
MICRO-FILM INFORMATION		REVISIONS		DESIGN		DATE: 04-07-04	
RECORDED BY	DATE					DATE: 2-12-04	
NO.						JOB NO.: 220087	
						DATE: 2-2004	

TIERRA WEST, LLC	
8509 JEFFERSON NE	
ALBUQUERQUE, NEW MEXICO 87113	
(505)858-3100	
CITY OF ALBUQUERQUE	
PUBLIC WORKS DEPARTMENT	
ENGINEERING GROUP	
TITLE: COTTONWOOD CROSSING - PHASE 2	
STORM DRAIN IMPROVEMENTS	
COORS BOULEVARD, NW STA: 10+00 TO STA: 14+69.03	
DESIGN REVIEW COMMITTEE	CITY ENGINEER APPROVAL
APPROVED APR 23 2004	APPROVED APR 30 2004
DESIGN REVIEW COMMITTEE	CITY ENGINEER
CITY PROJECT NO. 729081	ZONE MAP NO. B-14-Z
SHEET 9 OF 9	