


CITY OF ALBUQUERQUE

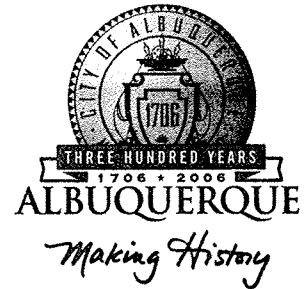

February 3, 2005

Mr. Bruce Stidworthy, P.E.
BOHANNAN-HUSTON, INC.
7500 Jefferson St. NE
Albuquerque, NM 87109

Re: MUSEUMS AT BALLOON FIESTA PARK
Balloon Museum Drive and North La Cueva Channel
Approval of Permanent Certificate of Occupancy (C.O.)
Engineer's Stamp dated 07/15/2002 (B-17/D1C)
Certification dated 02/02/2005

P.O. Box 1293

Dear Bruce,

Albuquerque

Based upon the information provided in your submittal received 02/02/2005, the above referenced certification is approved for release of Permanent Certificate of Occupancy by Hydrology.

New Mexico 87103

If you have any questions, you can contact me at 924-3982.

www.cabq.gov

Sincerely,

Arlene V. Portillo
Plan Checker, Planning Dept. - Hydrology
Development and Building Services


C: Phyllis Villanueva
File

I, BRUCE J. STIDWORTHY, NMPE 14523, OF THE FIRM BOHANNAN HUSTON INC., HEREBY CERTIFY THAT THIS PROJECT HAS BEEN GRADED AND WILL DRAIN IN SUBSTANTIAL COMPLIANCE WITH AND IN ACCORDANCE WITH THE DESIGN INTENT OF THE APPROVED PLAN DATED 7/15/02. THE RECORD DRAWING(S) FOR THIS PROJECT HAS/HAVE BEEN OBTAINED BY ALAN BENHAM, NMPS 15700, OF THE FIRM BOHANNAN HUSTON INC. I FURTHER CERTIFY THAT I HAVE PERSONALLY VISITED THE PROJECT SITE ON 12/8/05 AND HAVE DETERMINED BY VISUAL INSPECTION THAT THE SURVEY DATA PROVIDED IS REPRESENTATIVE OF ACTUAL SITE CONDITIONS AND THAT THE PROJECT IS THE BEST OF MY KNOWLEDGE AND BELIEF. THIS CERTIFICATION IS SUBMITTED IN SUPPORT OF A REQUEST FOR CERTIFICATE OF OCCUPANCY.

THE RECORD INFORMATION PRESENTED HEREON IS NOT NECESSARILY COMPLETE AND INTENDED ONLY TO VERIFY SUBSTANTIAL COMPLIANCE OF THE GRADING AND DRAINAGE ASPECTS OF THIS PROJECT. THOSE RELYING ON THIS RECORD DOCUMENT ARE ADVISED TO OBTAIN INDEPENDENT VERIFICATION OF ITS ACCURACY BEFORE USING IT FOR ANY OTHER PURPOSE.


Bruce J. Stidworthy 2/2/05
BRUCE J. STIDWORTHY, NMPE 14523

2/2/05

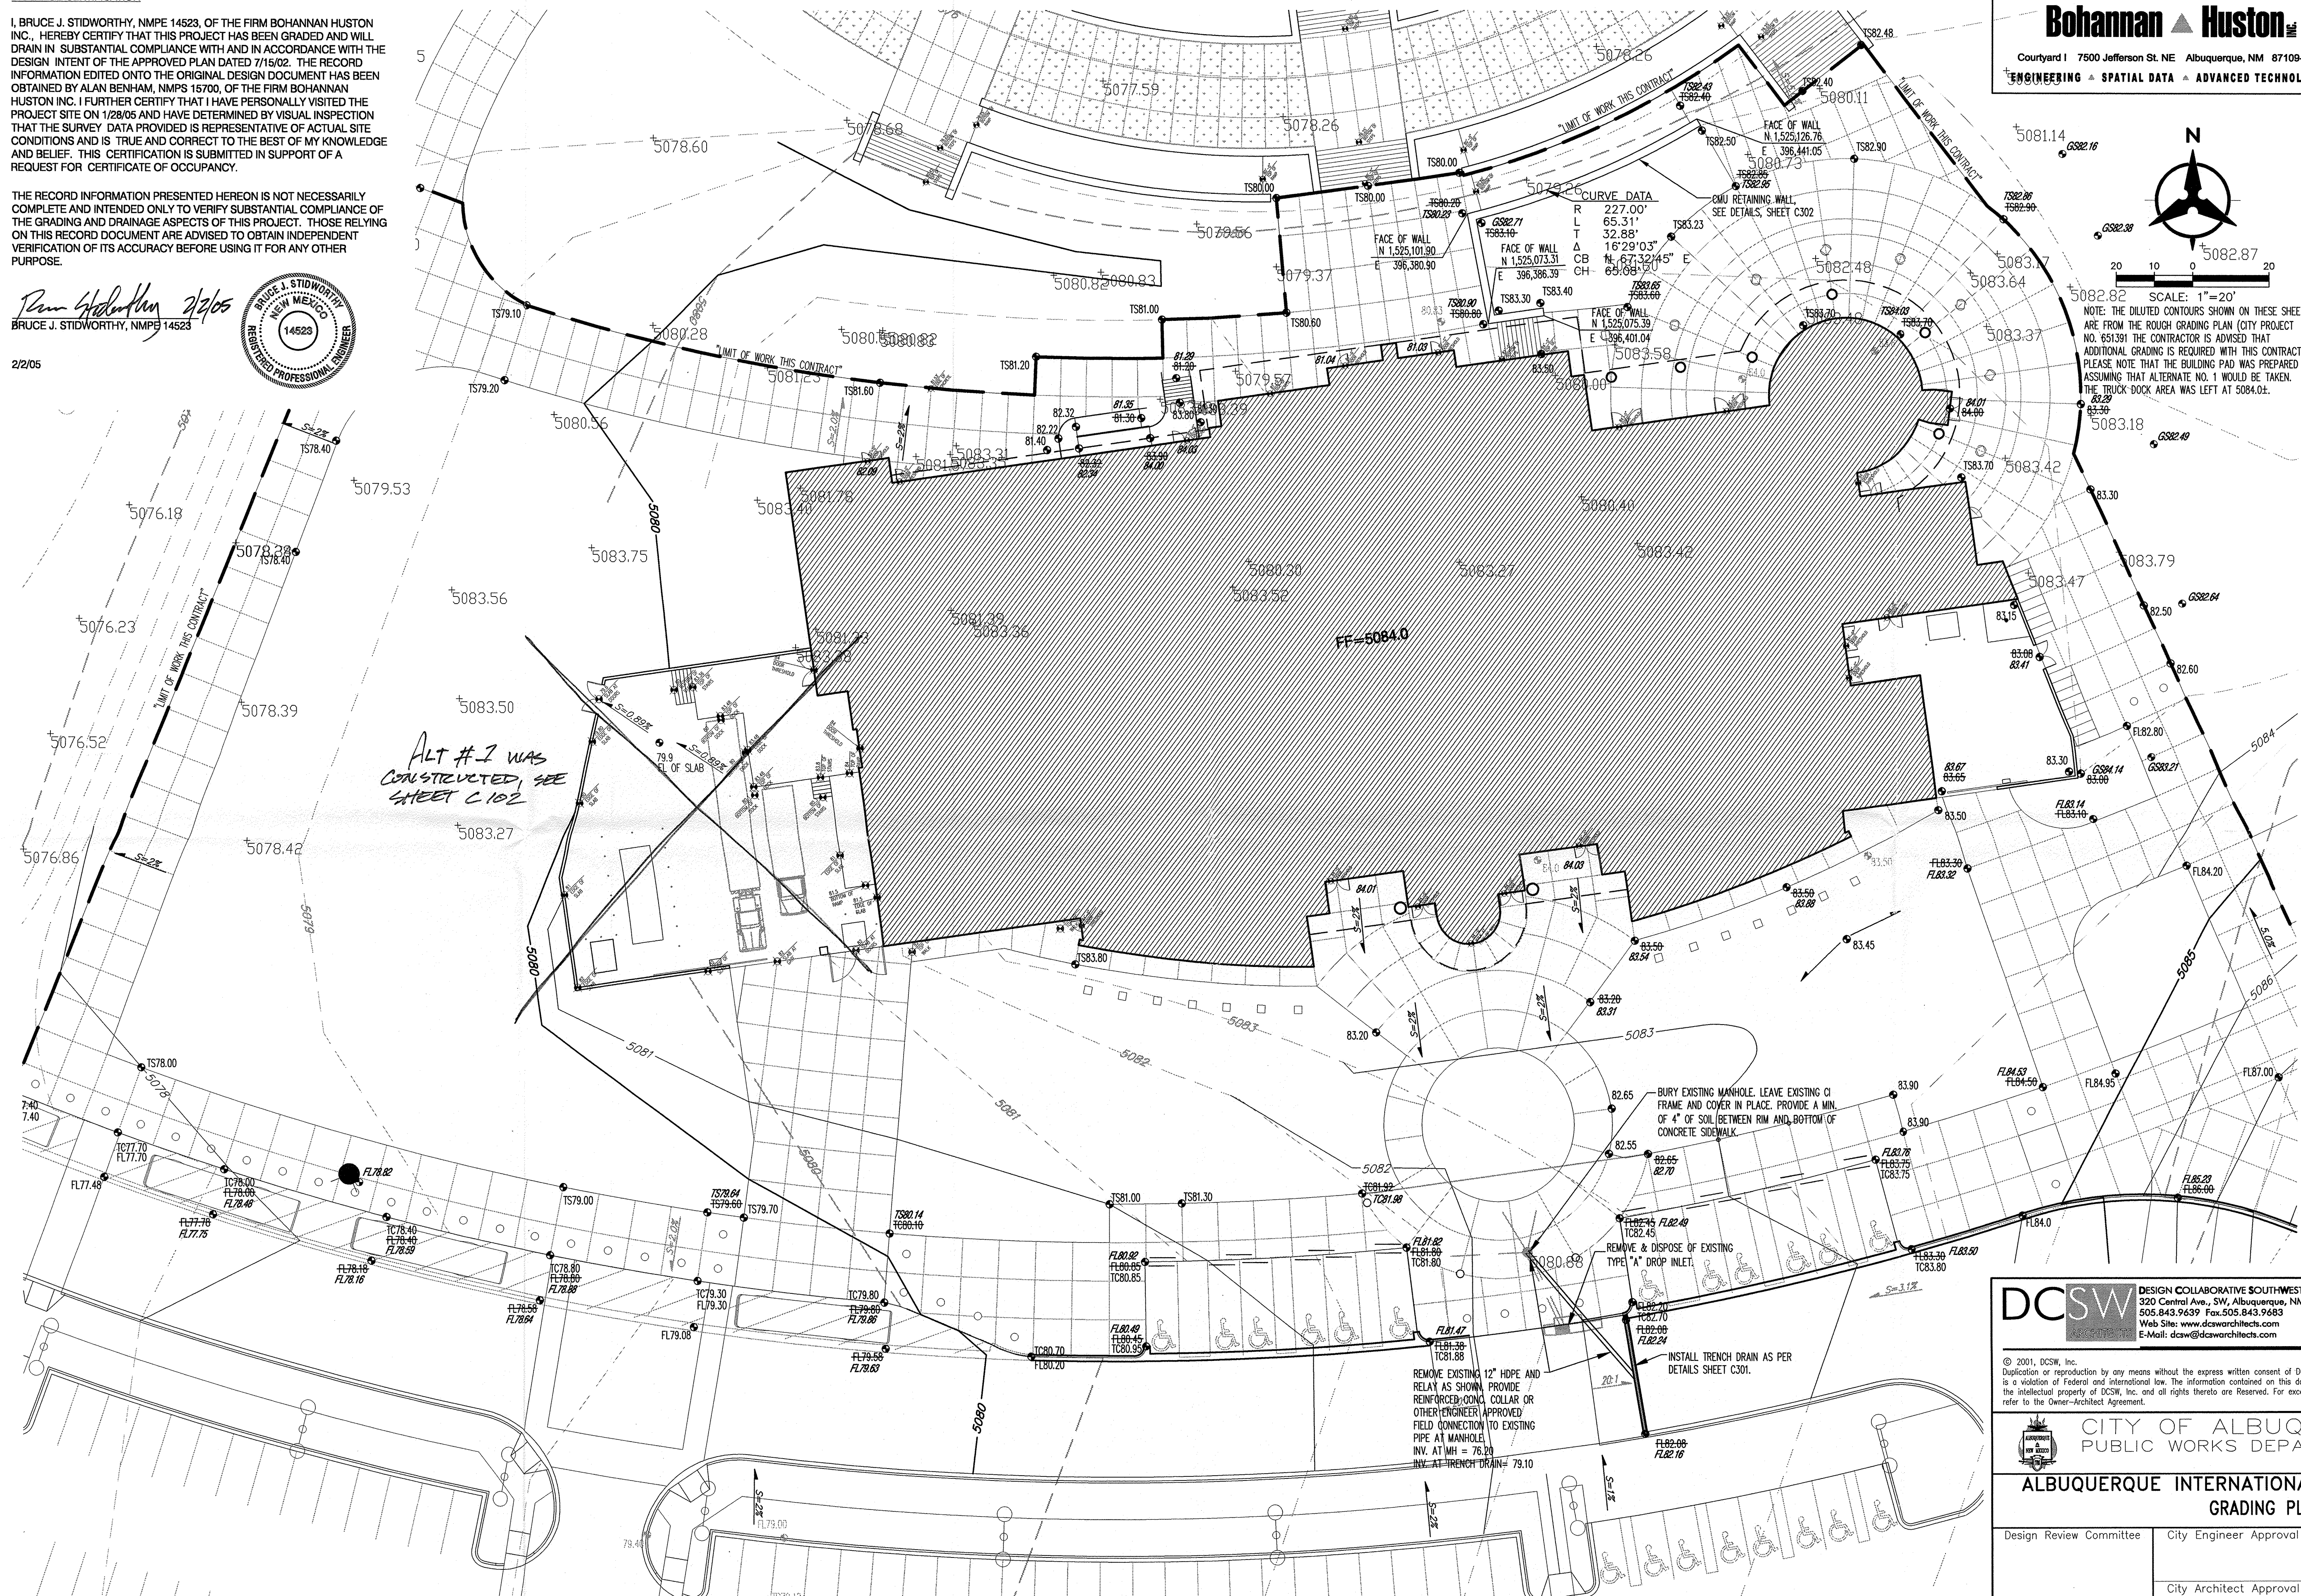

Bohannon Huston

Courtyard | 7500 Jefferson St. NE Albuquerque, NM 87109-4335
+ **ENGINEERING** & **SPATIAL DATA** & **ADVANCED TECHNOLOGIES**

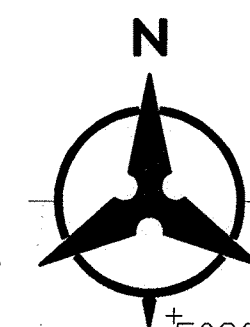

NOTE: THE DILUTED CONTOURS SHOWN ON THESE SHEETS ARE FROM THE ROUGH GRADING PLAN (CITY PROJECT NO. 651391). THE CONTRACTOR IS ADVISED THAT ADDITIONAL GRADING IS REQUIRED WITH THIS CONTRACT. PLEASE NOTE THAT THE BUILDING PAD WAS PREPARED ASSUMING THAT ALTERNATE NO. 1 WOULD BE TAKEN. THE TRUCK-DOCK AREA WAS LEFT AT 5084.0±.

ENGINEER'S SEAL		SURVEY INFORMATION		BENCH MARKS		AS-BUILT INFORMATION	
		FIELD NOTES		BM#1 APPROX. 72' NORTH AND EAST OF INTERSECTION OF SAN DIEGO AND JEFFERSON BETWEEN TWO TIMBER POWER POLES: 8" ALUMINUM CAP IN CONCRETE STAMPED "BH27, LS5544, 1984" X=397188.8841, Y=1525924.7813 ELEV. =5092.93. BM#2 APPROX. 117' NORTH OF NORTHERN MOST HORIZONTAL P.I. IN BOUNDARY FENCE AT MIDDLE N. DIVERSION CHANNEL RUNDOWN, APPROX. 3' EAST OF BOUNDARY FENCE: 2" UNMARKED ALUMINUM CAP X=395759.6322, Y=1527316.8546, ELEV =5044.15		CONTRACTOR	
		NO.	BY			DATE	STAMPED BY
No.	Date	REMARKS	By				
REVISIONS							
DESIGN							
Designed By:				MICRO-FILM INFORMATION			
DATE:				RECORDED BY			
Drawn By:				NO.			
DATE:							
Checked By:							
DATE:							

P:\01108\cdp\general\01108gp07.dwg
February 01, 2005 - 2:48pm
Layout1


DCSW JOB NO. 9736

12/21/01

FEB 02 2005

FEB 02 2005

HYDROLOGY SECTIC

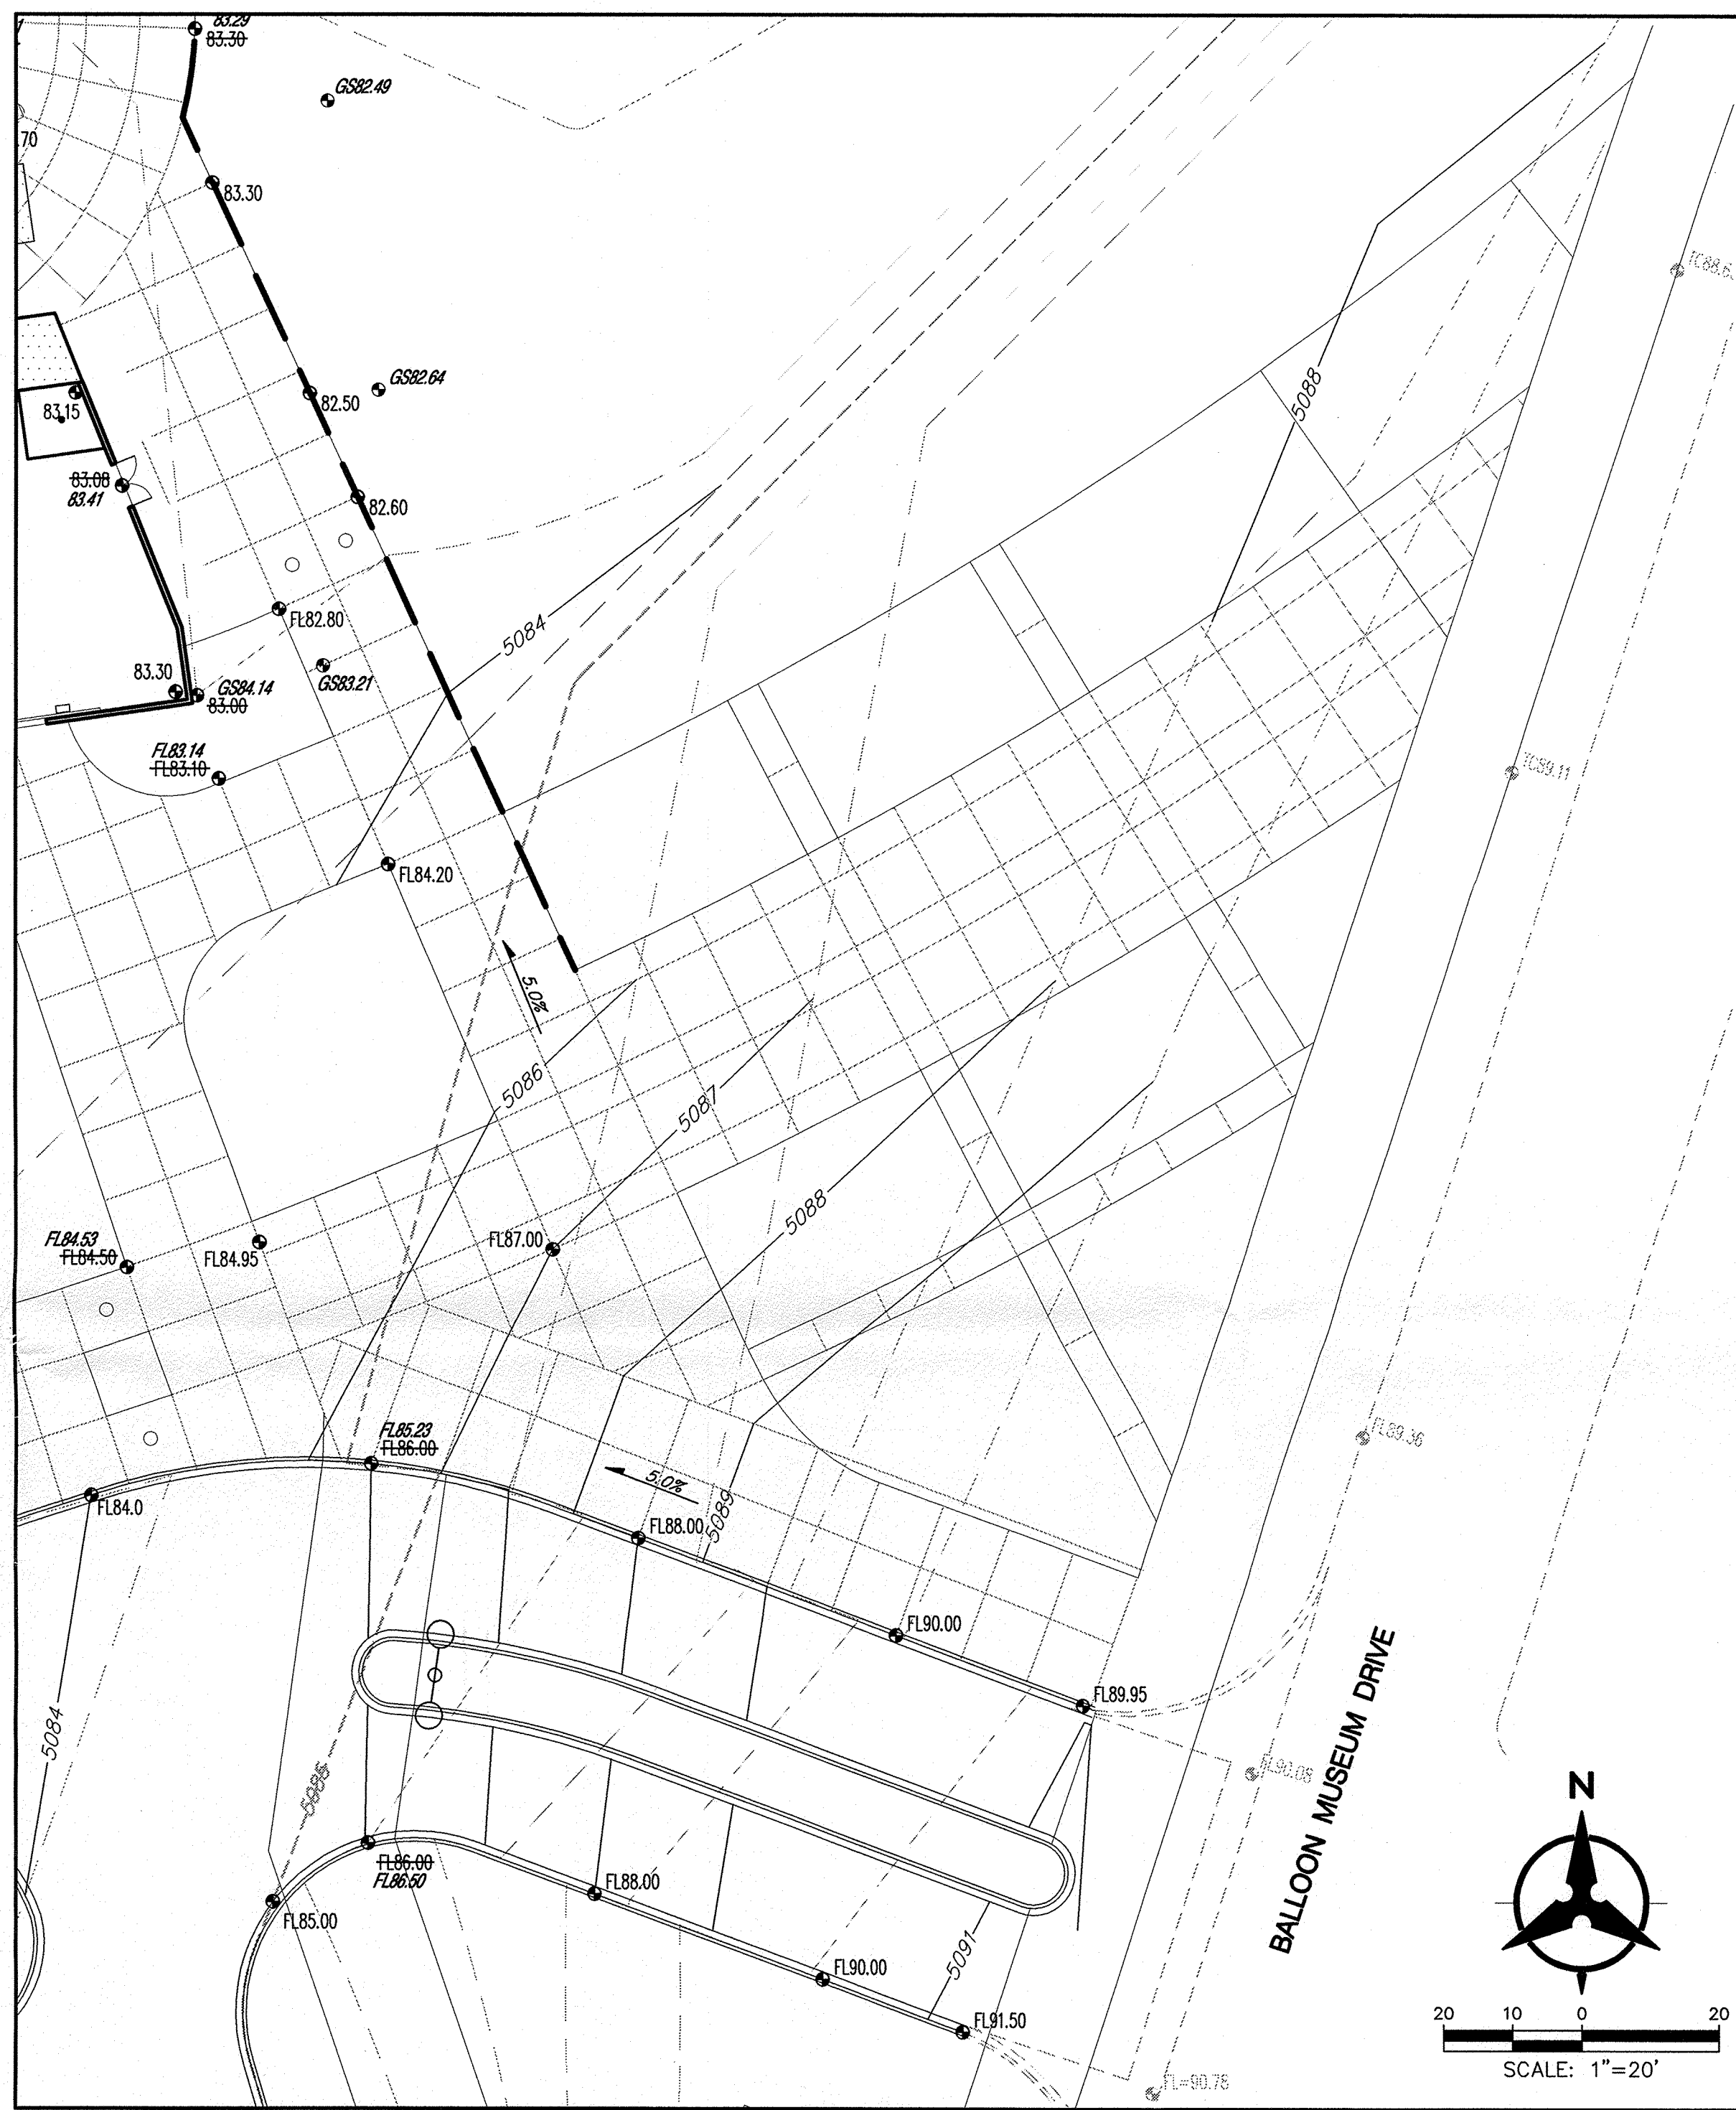

PEACE PARK GRADING PLAN


DRAINAGE CERTIFICATION

I, BRUCE J. STIDWORTHY, NMPE 14523, OF THE FIRM BOHANNAN HUSTON INC., HEREBY CERTIFY THAT THIS PROJECT HAS BEEN GRADED AND WILL DRAIN IN SUBSTANTIAL COMPLIANCE WITH AND IN ACCORDANCE WITH THE DESIGN INTENT OF THE IMPROVED PLAN DATED 7/16/02. THE RECORD INFORMATION EDITED INTO THIS PROJECT DESIGN DOCUMENT HAS BEEN OBTAINED BY ALAN BENHAM, NMPS 15700, OF THE FIRM BOHANNAN HUSTON INC. I FURTHER CERTIFY THAT I HAVE PERSONALLY VISITED THE PROJECT SITE ON 12/8/05 AND HAVE DETERMINED BY VISUAL INSPECTION THAT THE SURVEY DATA PROVIDED IS REPRESENTATIVE OF ACTUAL SITE CONDITIONS AND THAT THE DESIGN DOCUMENTS ACCURATELY REFLECT KNOWLEDGE AND BELIEF. THIS CERTIFICATION IS SUBMITTED IN SUPPORT OF A REQUEST FOR CERTIFICATE OF OCCUPANCY.

THE RECORD INFORMATION PRESENTED HEREON IS NOT NECESSARILY COMPLETE AND INTENDED ONLY TO VERIFY SUBSTANTIAL COMPLIANCE OF THE GRADING AND DRAINAGE ASPECTS OF THIS PROJECT. THOSE RELYING ON THIS RECORD DOCUMENT ARE ADVISED TO OBTAIN INDEPENDENT VERIFICATION OF ITS ACCURACY BEFORE USING IT FOR ANY OTHER PURPOSE.

Bruce Stidworthy 2/2/05
BRUCE J. STIDWORTHY, NMPE 14523

2/2/05

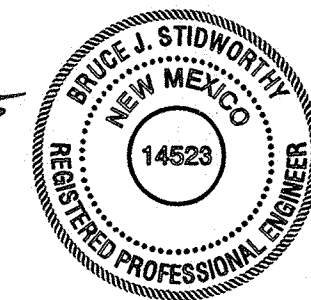

No.		Sheet		Of		170									
C-102		C102													
CARQUE MENT		BALLOON MUSEUM													
No.		Date		REMARKS		By									
				DESIGN REVISIONS											
				DESIGNED BY:		DATE:									
				DRAWN BY:		DATE:									
				CHECKED BY:		DATE:									
ENGINEER'S SEAL				SURVEY INFORMATION				BENCH MARKS				AS-BUILT INFORMATION			
				FIELD NOTES				DATE				BM#1 APPROX. 72' NORTH AND EAST OF INTERSECTION OF SAN DIEGO AND JEFFERSON BETWEEN TWO TIMBER POWER POLES: 8" ALUMINUM CAP IN CONCRETE STAMPED "BH27, LS6544, 1984." X=397188.8841, Y=1525924.7813 ELEV. =5092.93. BM#2 APPROX. 117' NORTH OF NORTHERN MOST HORIZONTAL P.I. IN BOUNDARY FENCE AT MIDDLE N. DIVERSION CHANNEL RUNDOWN, APPROX. 3' EAST OF BOUNDARY FENCE: 2" UNMARKED ALUMINUM CAP X=395759.6322, Y=1527318.8546, ELEV.=5044.55			
No.				Date				REMARKS				By			