



City of Albuquerque

Planning Department

Development & Building Services Division

DRAINAGE AND TRANSPORTATION INFORMATION SHEET

(REV 02/2013)

Project Title: _____ Building Permit #: _____ City Drainage #: _____

DRB#: _____ EPC#: _____ Work Order#: _____

Legal Description: _____

City Address: _____

Engineering Firm: _____ Contact: _____

Address: _____

Phone#: _____ Fax#: _____ E-mail: _____

Owner: _____ Contact: _____

Address: _____

Phone#: _____ Fax#: _____ E-mail: _____

Architect: _____ Contact: _____

Address: _____

Phone#: _____ Fax#: _____ E-mail: _____

Surveyor: _____ Contact: _____

Address: _____

Phone#: _____ Fax#: _____ E-mail: _____

Contractor: _____ Contact: _____

Address: _____

Phone#: _____ Fax#: _____ E-mail: _____

TYPE OF SUBMITTAL:

- _____ DRAINAGE REPORT
- _____ DRAINAGE PLAN 1st SUBMITTAL
- _____ DRAINAGE PLAN RESUBMITTAL
- _____ CONCEPTUAL G & D PLAN
- _____ GRADING PLAN
- _____ EROSION & SEDIMENT CONTROL PLAN (ESC)
- _____ ENGINEER'S CERT (HYDROLOGY)
- _____ CLOMR/LOMR
- _____ TRAFFIC CIRCULATION LAYOUT (TCL)
- _____ ENGINEER'S CERT (TCL)
- _____ ENGINEER'S CERT (DRB SITE PLAN)
- _____ ENGINEER'S CERT (ESC)
- _____ SO-19
- _____ OTHER (SPECIFY)

CHECK TYPE OF APPROVAL/ACCEPTANCE SOUGHT:

- _____ SIA/FINANCIAL GUARANTEE RELEASE
- _____ PRELIMINARY PLAT APPROVAL
- _____ S. DEV. PLAN FOR SUB'D APPROVAL
- _____ S. DEV. FOR BLDG. PERMIT APPROVAL
- _____ SECTOR PLAN APPROVAL
- _____ FINAL PLAT APPROVAL
- _____ CERTIFICATE OF OCCUPANCY (PERM)
- _____ CERTIFICATE OF OCCUPANCY (TCL TEMP)
- _____ FOUNDATION PERMIT APPROVAL
- _____ BUILDING PERMIT APPROVAL
- _____ GRADING PERMIT APPROVAL
- _____ PAVING PERMIT APPROVAL
- _____ WORK ORDER APPROVAL
- _____ GRADING CERTIFICATION
- _____ SO-19 APPROVAL
- _____ ESC PERMIT APPROVAL
- _____ ESC CERT. ACCEPTANCE
- _____ OTHER (SPECIFY)

WAS A PRE-DESIGN CONFERENCE ATTENDED: _____ Yes _____ No _____ Copy Provided

DATE SUBMITTED: _____ By: _____

Requests for approvals of Site Development Plans and/or Subdivision Plats shall be accompanied by a drainage submittal. The particular nature, location, and scope to the proposed development defines the degree of drainage detail. One or more of the following levels of submittal may be required based on the following:

1. **Conceptual Grading and Drainage Plan:** Required for approval of Site Development Plans greater than five (5) acres and Sector Plans
2. **Drainage Plans:** Required for building permits, grading permits, paving permits and site plans less than five (5) acres
3. **Drainage Report:** Required for subdivision containing more than ten (10) lots or constituting five (5) acres or more
4. **Erosion and Sediment Control Plan:** Required for any new development and redevelopment site with 1-acre or more of land disturbing area, including project less than 1-acre that are part of a larger common plan of development

June 10, 2014

voice: 505.823.1000
facsimile: 505.798.7988
toll free: 800.877.5332

Mr. Curtis Cherne, P.E.
Development and Building Services
City of Albuquerque
600 Second Street NW - 2st Floor
Albuquerque, NM 87102

Re: Presbyterian Systems Office Grading Certification
(B-17/D003)


Dear Mr. Cherne:

Based on the letter date January 22, 2014 we received Temporary Certificate of Occupancy for the referenced project. The letter stated that Permanent Certificate of Occupancy would not be granted until corrective action was taken to address the steep slope along the southern property line.

Since receipt of the letter, we have been working with the adjoining property owner to secure permission to grade the slope on their property. Attached is a copy of the letter granting permission. Once permission was obtained, the contractor was directed to place the fill necessary to flatten the slope to less than 1:1 (H:V). An as-built survey was performed to verify the slope met these criteria. The survey shows that the slope ranges between 1.2:1 to 1.6:1. A site visit was conducted to verify that the survey data is representative of actual conditions. Upon verification of the slope, EarthGuard Fiber Matrix was applied to stabilize the slope. The product literature states that this product stabilizes slopes up to 1:1.

With this certification we are requesting Permanent Certificate of Occupancy. Please contact me if you have any questions or need additional clarification.

Sincerely,



Glenn S. Broughton, P.E.
Senior Project Manager
Community Development & Planning

GSB/jcm
Enclosures



Presbyterian Healthcare Services
P.O. Box 26666
Albuquerque, NM 87125-6666
(505) 841-1234
www.phs.org

May 21, 2014

Sumco USA Corporation
9401 San Mateo Blvd., NE
Albuquerque, NM 87113

**Re: Presbyterian Cooper Center Administrative Center @ 9521 San Mateo Blvd, NE
Embankment between Presbyterian and Sumco properties**

Dear Sumco:

Please allow me to introduce myself as the representative of your new neighbor. My name is Jim Jeppson and I serve as the Administrative Director of Real Estate for Presbyterian Healthcare Services. Approximately two and a half years ago we purchased the property to the immediate north of your facility. Since then we have remodeled the building that formerly housed CitiCorp, planned and constructed a large addition, and are in the process of finalizing our occupancy of the property.

One thing we discovered during our activation of the property was the steep embankment that divides our property and yours. During construction we did not do much with it, but now as we near completion the City of Albuquerque has requested that we lessen the slope and add vegetation to the embankment. The City has a zoning standard that stipulate landscaping at all property lines. Apparently this was not something the City required when the previous owner constructed their building on the property.

We have looked into what will be required for us to satisfy the City's requirement. Doing so we discovered that the fence that separates our property is actually several feet into your property and does not sit on the property line, meaning the embankment is largely on your property. Since we have the view of the embankment, we are willing to incur the cost to make the improvements the City is requesting, but to do work on your property we need to obtain your written permission. This letter seeks that permission.

Attached please find four exhibits. The first one is a survey of the area in question and shows the property line, the contours illustrating the steep embankment, and the location of the existing chain link fence. The next two are photographs taken at the time we purchased the property.


We propose to have our contractor bring in some earthen fill to create a gentler slope, not as steep as seen in the photos. The contractor will next stabilize that fill material. After stabilization they will apply a sprayed-on hydro-mulch product that contains a soil stabilizing agent, grass seed, and fertilizer. This product will promote the growth of vegetation on the slope. All of this would occur on the side of the fence toward our property. It will not bother the fence, nor will it be visible to Sumco unless you walk right up the fence and look directly down the embankment. The final exhibit is a catalog sheet describing a product we propose to apply to the modified embankment.

We wish to proceed with this work immediately and expect it will be complete within 30 days from receipt of your written approval. Presbyterian will pay for this work in its entirety.

Thank you for your consideration of this request. If this proposal is acceptable, please sign below and return one original to us for our records. Of course as always if you have questions regarding anything contained herein, or require additional information please don't hesitate to contact us.

Sincerely,

Presbyterian Healthcare Services

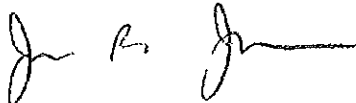

James R. Jeppson
Administrative Director of Real Estate

APPROVED FOR Sumco USA, Corporation


Signature

5/22/14
Date

Senior Manufacturing Officer / Vice President of Operations.
Printed Name & Title

REVISIONS	
11/20/2012	ADDENDUM 001
11/20/2012	REVISION PER COA PERMIT REVIEW AND INCLUDED IN ADDENDUM 002

DRAWN BY	BO
REVIEWED BY	GSB
DATE	November 6, 2012
PROJECT NO.	11-0100.003
DRAWING NAME	GRADING & DRAINAGE PLAN

KEYED NOTES

- CONSTRUCT TYPE 'D' DOUBLE GRATE STORM DRAIN INLET PER COA STD DWG 2206.
- CONSTRUCT TYPE 'D' SINGLE GRATE STORM DRAIN INLET PER COA STD DWG 2206.
- EXISTING TYPE 'C' SINGLE GRATE STORM DRAIN INLET TO REMAIN.
- EXISTING TYPE 'A' SINGLE GRATE STORM DRAIN INLET TO REMAIN.
- EXISTING TYPE 'A' DOUBLE GRATE STORM DRAIN INLET TO REMAIN.
- INSTALL STORM DRAIN PIPE. SEE PLAN FOR SIZE & SLOPE.
- CONSTRUCT RETAINING WALL, SEE ARCHITECTURAL PLANS FOR DETAILS.
- CONSTRUCT 3" WIDE CONCRETE RIBBON CHANNEL PER COA STD DWG 2236. OMIT CHECKERED STEEL PLATE.
- EXISTING TYPE 'D' SINGLE GRATE INLET TO REMAIN.
- CONSTRUCT 12" WIDE CURB OPENING FOR DRAINAGE/WATER HARVESTING. DEPRESS LANDSCAPE AREA PER DETAIL C3 ON SHEET L-105.
- CONSTRUCT 4" DIA STORM DRAIN MANHOLE TYPE "C" PER COA STD DWG 2101.
- INSTALL STORM DRAIN CLEANOUT PER DETAIL ON SHEET C-300.
- CONSTRUCT 4" DIA STORM DRAIN MANHOLE TYPE "E" PER COA STD DWG 2102.
- CONSTRUCT 12" WIDE SIDEWALK CULVERT PER COA STD DWG 2236.
- INSTALL STORM DRAIN TO WITHIN 5' OF BUILDING. SEE PLUMBING PLANS FOR CONTINUATION.
- INSTALL NYLOPLAST 12" DRAIN BASIN WITH 12" ROUND PEDESTRIAN GRATE.
- NOT USED.
- NOT USED.
- INSTALL LIGHT DUTY PAVEMENT SECTION PER DETAIL ON SHEET C-100.
- INSTALL 4" PVC PIPE SLEEVE THROUGH WALL FOR COURTYARD DRAINAGE. SEE PLAN FOR FINISHED GRADES & PIPE INVERT.
- CONSTRUCT 24" WIDE CONCRETE RIBBON CHANNEL PER COA STD DWG 2236. OMIT CHECKERED STEEL PLATE.
- CONNECT NEW STORM DRAIN TO EXISTING INLET/STORM DRAIN MANHOLE.
- 23.18"x18"x10" TEE, 18"x12" REDUCER & 12" CAP.
- INSTALL 2 - 24" WIDE SIDEWALK CULVERTS PER COA STD DWG 2236.
- INSTALL 12" DRAIN BASIN W/ 12" DOME GRATE.
- INSTALL HEAVY DUTY PAVEMENT SECTION PER DETAIL ON SHEET C-100.
- CONSTRUCT TYPE 'A' SINGLE GRATE STORM DRAIN INLET PER COA STD DWG 2201.
- INSTALL NYLOPLAST 12" DRAIN BASIN W/ 12" DOME GRATE.

NOTE: NOT ALL KEYED NOTES MAY APPLY TO THIS SHEET.

LEGEND

- PROPERTY LINE
- HEAVY DUTY ASPHALT PAVEMENT
SEE PAVEMENT SECTION ON SHEET C-100
- LIGHT DUTY ASPHALT PAVEMENT
SEE PAVEMENT SECTION ON SHEET C-100
- EXISTING CONTOURS
- PROPOSED SPOT ELEVATION
TC=TOP OF CURB, FL=FLOW LINE
TS=TOP OF SIDEWALK, TA=TOP OF ASPHALT
EW=EXISTING, FG=FINISHED GRADE
FGL=FINISHED GRADE LOW
- PROPOSED DIRECTION OF FLOW
- WATER BLOCK
- PROPOSED RETAINING WALL
- PROPOSED INDEX CONTOURS
- PROPOSED INTER CONTOURS
- PROPOSED WATER HARVESTING SWALE
SEE 1/C-101
- SEDIMENT CONTROL BERM

DRAINAGE CERTIFICATION

I, GLENN S. BROUGHTON, NMPE 14171, OF THE FIRM BOHANNAN HUSTON INC., HEREBY CERTIFY THAT THIS PROJECT HAS BEEN GRADED AND WILL DRAIN IN SUBSTANTIAL COMPLIANCE WITH AND IN ACCORDANCE WITH THE DESIGN INTENT OF THE APPROVED PLAN DATED 11/23/2012. THE RECORD INFORMATION EDITED ONTO THE ORIGINAL DESIGN DOCUMENT HAS BEEN OBTAINED BY BRIAN MARTINEZ, NMPS 18374, OF THE FIRM CARTESIAN SURVEYS INC. I FURTHER CERTIFY THAT I HAVE PERSONALLY VISITED THE PROJECT SITE ON 1/15/2014 AND HAVE DETERMINED BY VISUAL INSPECTION THAT THE SURVEY DATA PROVIDED IS REPRESENTATIVE OF ACTUAL SITE CONDITIONS AND IS TRUE AND CORRECT TO THE BEST OF MY KNOWLEDGE AND BELIEF. THIS CERTIFICATION IS SUBMITTED IN SUPPORT OF A REQUEST FOR PERMANENT CERTIFICATE OF OCCUPANCY.

THE RECORD INFORMATION PRESENTED HEREON IS NOT NECESSARILY COMPLETE AND INTENDED ONLY TO VERIFY SUBSTANTIAL COMPLIANCE OF THE GRADING AND DRAINAGE ASPECTS OF THIS PROJECT. THOSE RELYING ON THIS RECORD DOCUMENT ARE ADVISED TO OBTAIN INDEPENDENT VERIFICATION OF ITS ACCURACY BEFORE USING IT FOR ANY OTHER PURPOSE.

Glenn S. Broughton 1/21/14
GLENN S. BROUGHTON, NMPE 14171


1/20/2014


LEGEND

FL17.85 DESIGN GRADE
AS-BUILT GRADE

GLENN S. BROUGHTON
NEW MEXICO
14171
REGISTERED PROFESSIONAL ENGINEER

**BID ALTERNATE #1
GRADING DETAIL**
1"=30'-0"

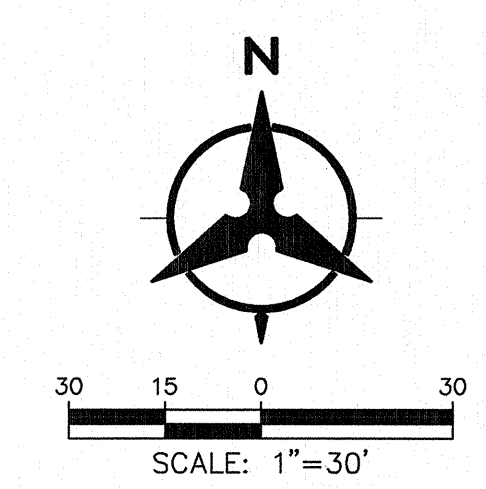

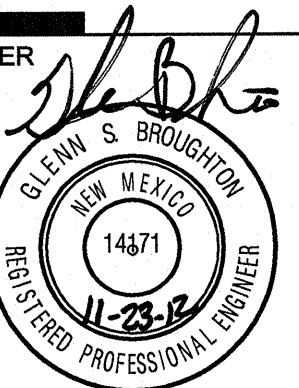

Presbyterian Rev. Hugh Cooper Administrative Center
PHASE TWO - BUILDING 2 NEW ADDITION
9521 San Mateo NE
Albuquerque, New Mexico


**ISSUED FOR
CONSTRUCTION**
1/7/2013

THE WORK REFLECTED HEREIN IS
NOT NECESSARILY ALL INCLUSIVE
OFFICIAL BID DOCUMENTS INCLUDING
ALL ADDENDA PREVAILS.




DRAWN BY BO
REVIEWED BY GSB
DATE November 6, 2012
PROJECT NO. 11-0100.003
DRAWING NAME


SECTIONS
AND DETAILS

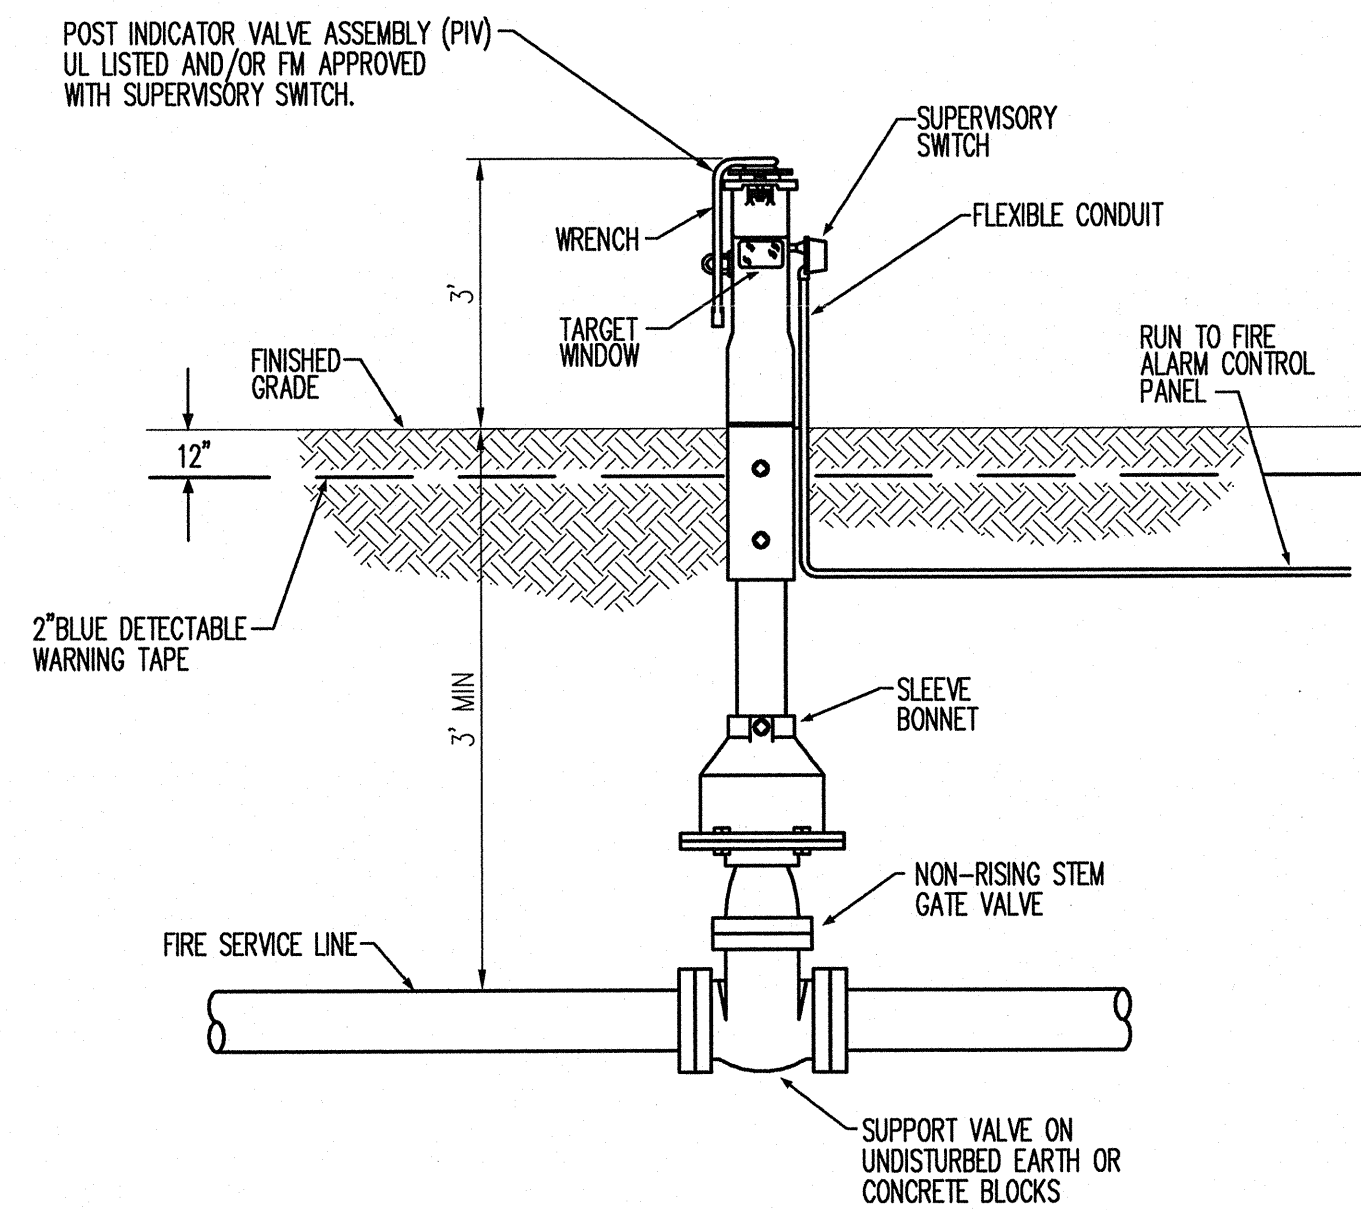


1 POST INDICATOR VALVE DETAIL
NOT TO SCALE

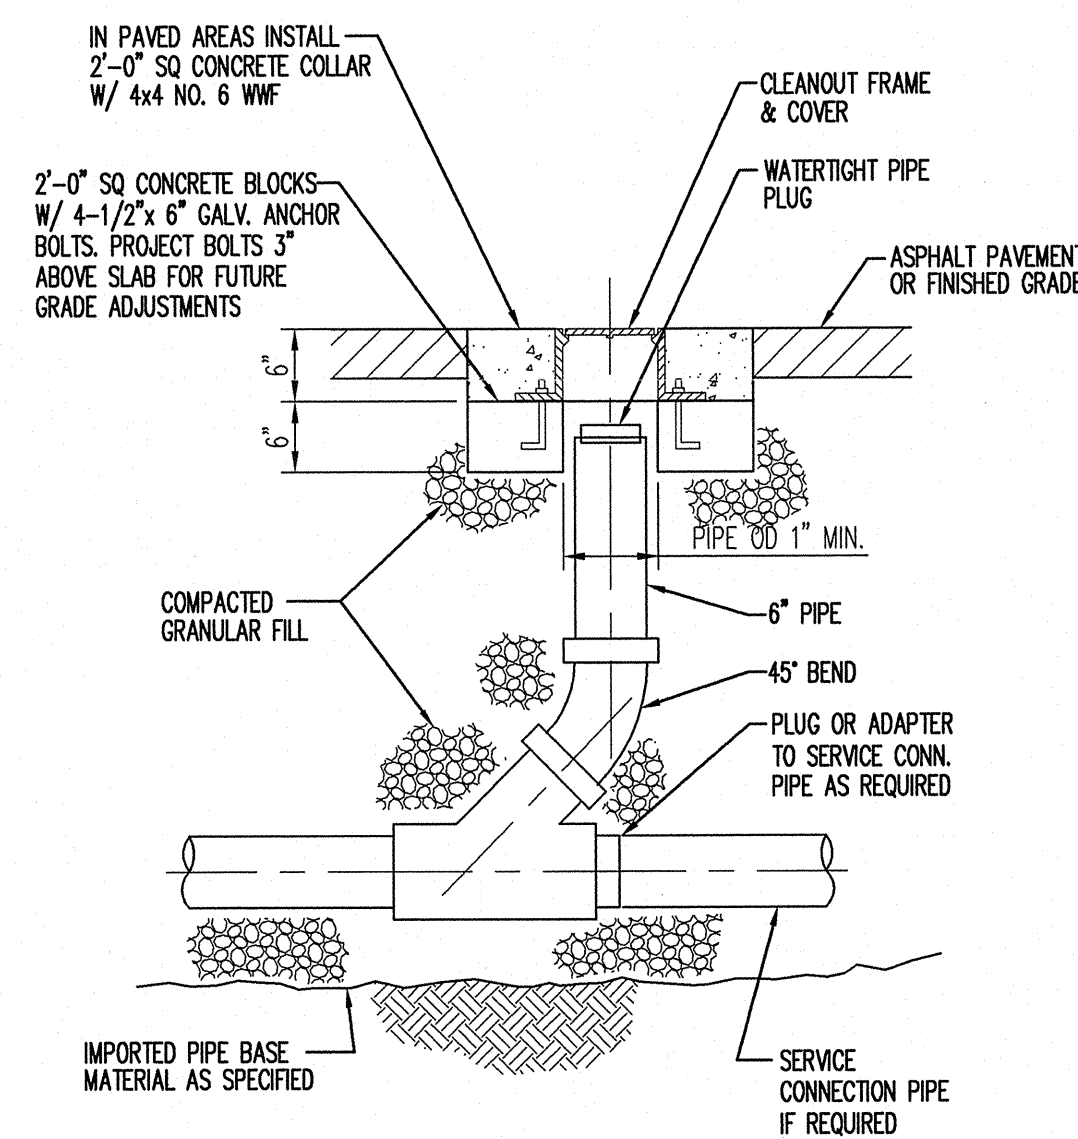

2 CLEANOUT DETAIL
NOT TO SCALE

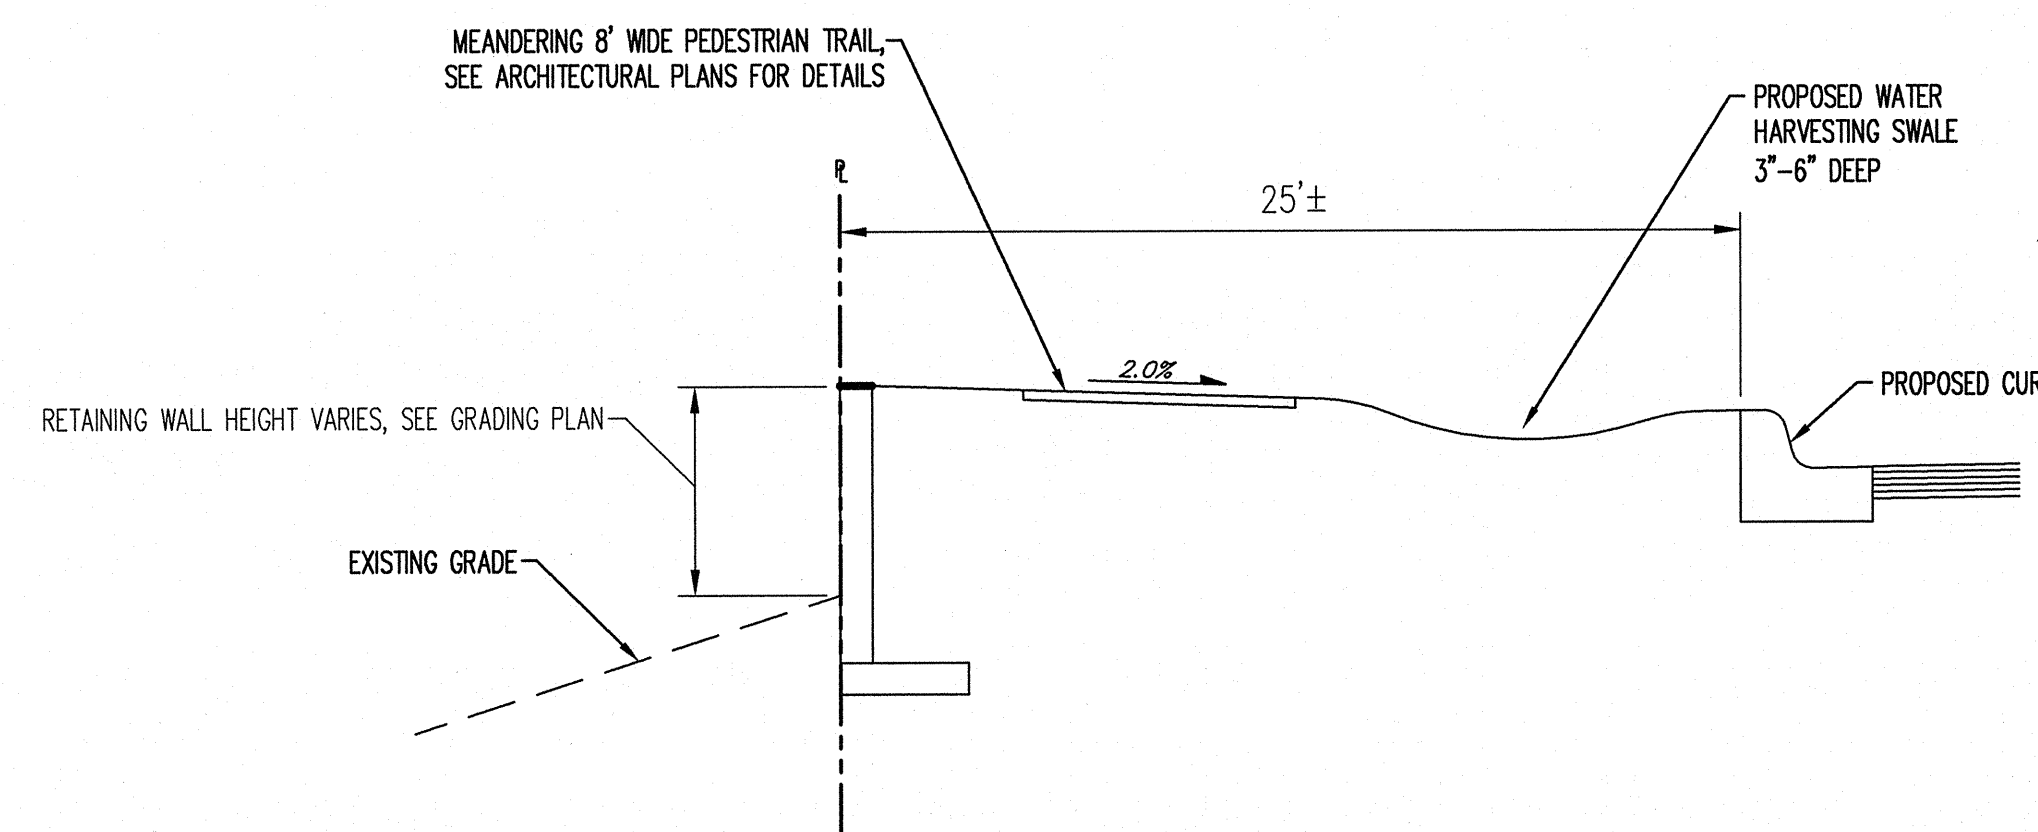

A TYPICAL SECTION AT PROPERTY LINE
N.T.S.

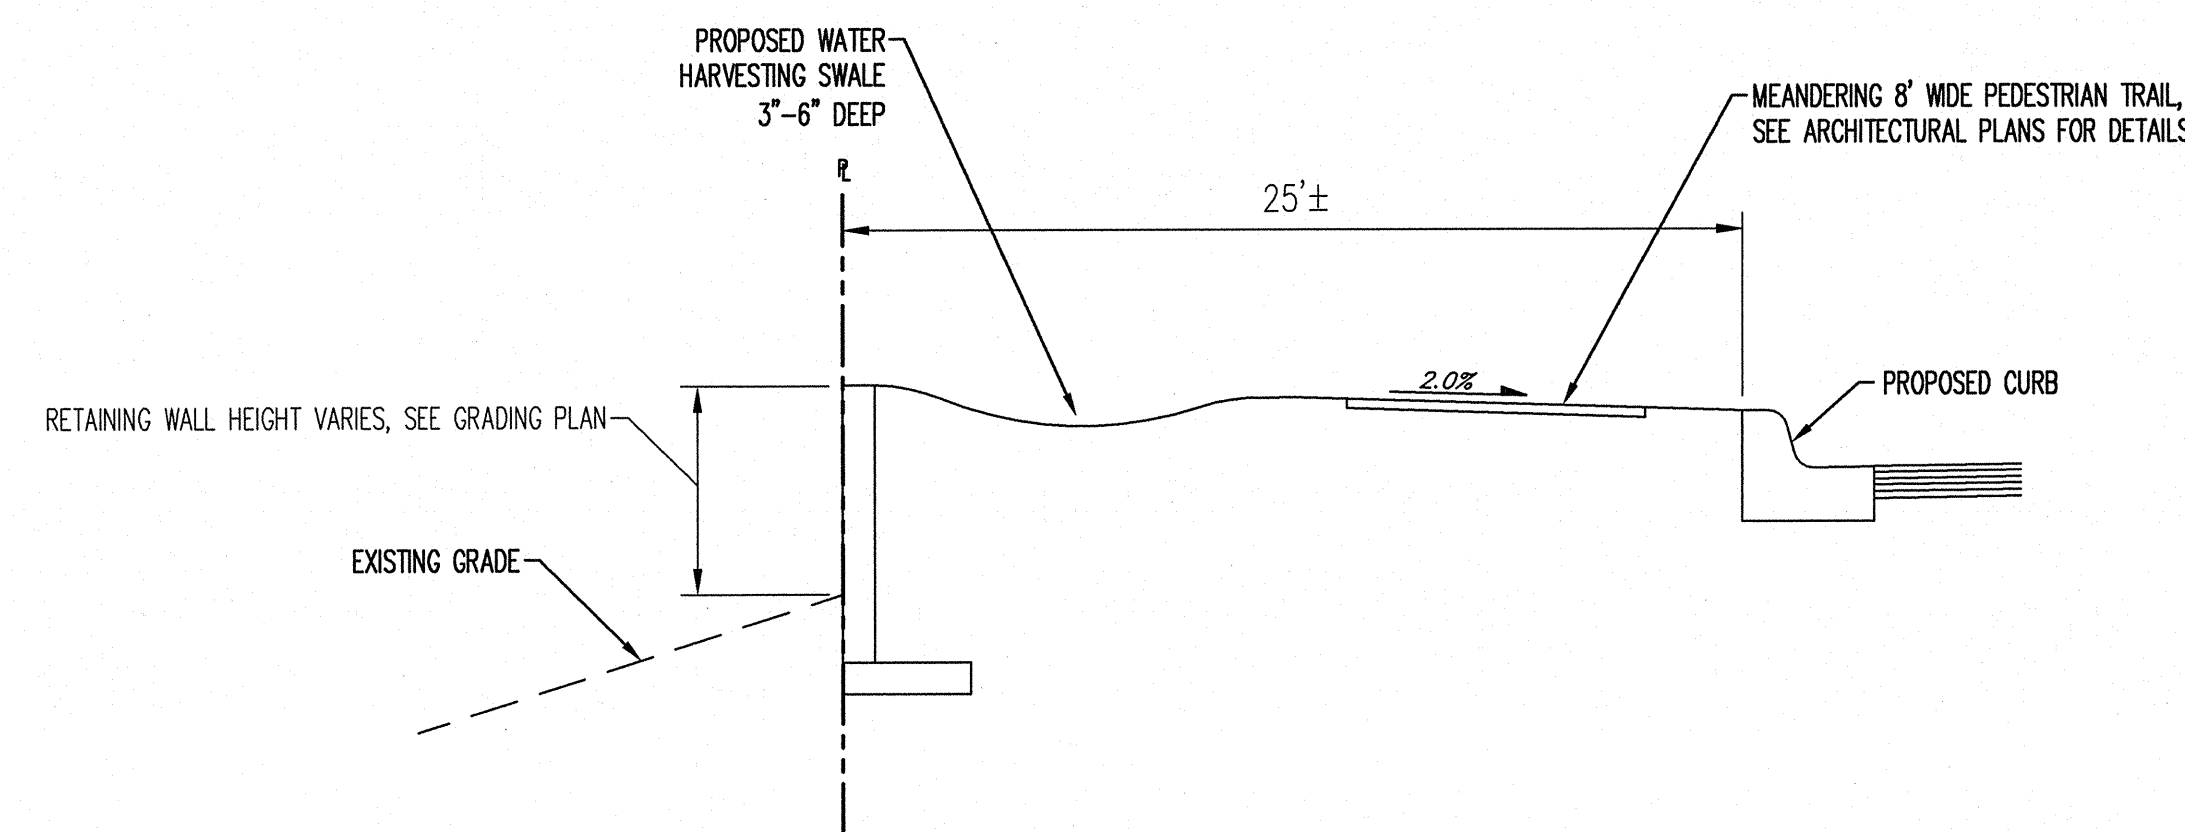

B TYPICAL SECTION AT PROPERTY LINE
N.T.S.

DRAINAGE CERTIFICATION

I, GLENN S. BROUGHTON, NMPE 14171, OF THE FIRM BOHANNAN HUSTON INC., HEREBY CERTIFY THAT THIS PROJECT HAS BEEN GRADED AND WILL DRAIN IN SUBSTANTIAL COMPLIANCE WITH AND IN ACCORDANCE WITH THE DESIGN INTENT OF THE APPROVED PLAN DATED 11/23/2012. THE RECORD INFORMATION EDITED ONTO THE ORIGINAL DESIGN DOCUMENT HAS BEEN OBTAINED BY BRIAN MARTINEZ, NMPS 18074, OF THE FIRM CARTESIAN SURVEYS INC. I FURTHER CERTIFY THAT I HAVE PERSONALLY VISITED THE PROJECT SITE ON 1/15/2014 AND HAVE DETERMINED BY VISUAL INSPECTION THAT THE SURVEY DATA PROVIDED IS REPRESENTATIVE OF ACTUAL SITE CONDITIONS AND IS TRUE AND CORRECT TO THE BEST OF MY KNOWLEDGE AND BELIEF. THIS CERTIFICATION IS SUBMITTED IN SUPPORT OF A REQUEST FOR PERMANENT CERTIFICATE OF OCCUPANCY.

THE RECORD INFORMATION PRESENTED HEREON IS NOT NECESSARILY COMPLETE AND INTENDED ONLY TO VERIFY SUBSTANTIAL COMPLIANCE OF THE GRADING AND DRAINAGE ASPECTS OF THIS PROJECT. THOSE RELYING ON THIS RECORD DOCUMENT ARE ADVISED TO OBTAIN INDEPENDENT VERIFICATION OF ITS ACCURACY BEFORE USING IT FOR ANY OTHER PURPOSE.

Glenn S. Broughton 1/21/14
GLENN S. BROUGHTON, NMPE 14171

1/20/2014

LEGEND

FL17.85 DESIGN GRADE
FL1417.80 AS-BUILT GRADE

GLENN S. BROUGHTON
NEW MEXICO
14171
REGISTERED PROFESSIONAL ENGINEER

KEYED NOTES

- CONSTRUCT TYPE 'D' DOUBLE GRATE STORM DRAIN INLET PER COA STD DWG 2206.
- CONSTRUCT TYPE 'D' SINGLE GRATE STORM DRAIN INLET PER COA STD DWG 2206.
- EXISTING TYPE 'C' SINGLE GRATE STORM DRAIN INLET TO REMAIN.
- EXISTING TYPE 'A' SINGLE GRATE STORM DRAIN INLET TO REMAIN.
- EXISTING TYPE 'A' DOUBLE GRATE STORM DRAIN INLET TO REMAIN.
- INSTALL STORM DRAIN PIPE. SEE PLAN FOR SIZE & SLOPE.
- CONSTRUCT RETAINING WALL, SEE ARCHITECTURAL PLANS FOR DETAILS.
- CONSTRUCT 3' WIDE CONCRETE RIBBON CHANNEL PER COA STD DWG 2236. OMIT CHECKERED STEEL PLATE.
- EXISTING TYPE 'D' SINGLE GRATE INLET TO REMAIN.
- CONSTRUCT 12" WIDE CURB OPENING FOR DRAINAGE/WATER HARVESTING. DEPRESS LANDSCAPE AREA PER DETAIL C3 ON SHEET L-105.
- CONSTRUCT 4' DIA STORM DRAIN MANHOLE TYPE 'C' PER COA STD DWG 2101.
- INSTALL STORM DRAIN CLEANOUT PER DETAIL ON SHEET C-300.
- CONSTRUCT 4' DIA STORM DRAIN MANHOLE TYPE 'C' PER COA STD DWG 2102.
- CONSTRUCT 12" WIDE SIDEWALK CULVERT PER COA STD DWG 2236.
- INSTALL STORM DRAIN TO WITHIN 5' OF BUILDING. SEE PLUMBING PLANS FOR CONTINUATION.
- INSTALL NYLOPLAST 12" DRAIN BASIN WITH 12" ROUND PEDESTRIAN GRATE.
- NOT USED.
- NOT USED.
- INSTALL LIGHT DUTY PAVEMENT SECTION PER DETAIL ON SHEET C-100.
- INSTALL 4" PVC PIPE SLEEVE THROUGH WALL FOR COURTYARD DRAINAGE. SEE PLAN FOR FINISHED GRADES & PIPE INVERT.
- CONSTRUCT 24" WIDE CONCRETE RIBBON CHANNEL PER COA STD DWG 2236. OMIT CHECKERED STEEL PLATE.
- CONNECT NEW STORM DRAIN TO EXISTING INLET/STORM DRAIN MANHOLE.
- 18"x18"x10" TEE, 18"x12" REDUCER & 12" CAP.
- INSTALL 2 - 24" WIDE SIDEWALK CULVERTS PER COA STD DWG 2236.
- INSTALL 12" DRAIN BASIN W/ 12" DOME GRATE.
- INSTALL HEAVY DUTY PAVEMENT SECTION PER DETAIL ON SHEET C-100.
- CONSTRUCT TYPE 'A' SINGLE GRATE STORM DRAIN INLET PER COA STD DWG 2201.
- INSTALL NYLOPLAST 12" DRAIN BASIN W/ 12" DOME GRATE.

NOTE: NOT ALL KEYED NOTES MAY APPLY TO THIS SHEET.

DRAINAGE CERTIFICATION

I, GLENN S. BROUGHTON, NMPE 14171, OF THE FIRM BOHANNAN HUSTON INC., HEREBY CERTIFY THAT THIS PROJECT HAS BEEN GRADED AND WILL DRAIN IN SUBSTANTIAL COMPLIANCE WITH AND IN ACCORDANCE WITH THE DESIGN INTENT OF THE APPROVED PLAN DATED 11/23/2012. THE RECORD INFORMATION EDITED ONTO THE ORIGINAL DESIGN DOCUMENT HAS BEEN OBTAINED BY BRIAN MARTINEZ, NMPS 18374, OF THE FIRM CARTESIAN SURVEYS INC. I FURTHER CERTIFY THAT I HAVE PERSONALLY VISITED THE PROJECT SITE ON 1/15/2014 AND HAVE DETERMINED BY VISUAL INSPECTION THAT THE SURVEY DATA PROVIDED IS REPRESENTATIVE OF ACTUAL SITE CONDITIONS AND IS TRUE AND CORRECT TO THE BEST OF MY KNOWLEDGE AND BELIEF. THIS CERTIFICATION IS SUBMITTED IN SUPPORT OF A REQUEST FOR PERMANENT CERTIFICATE OF OCCUPANCY.

THE RECORD INFORMATION PRESENTED HEREON IS NOT NECESSARILY COMPLETE AND INTENDED ONLY TO VERIFY SUBSTANTIAL COMPLIANCE OF THE GRADING AND DRAINAGE ASPECTS OF THIS PROJECT. THOSE RELYING ON THIS RECORD DOCUMENT ARE ADVISED TO OBTAIN INDEPENDENT VERIFICATION OF ITS ACCURACY BEFORE USING IT FOR ANY OTHER PURPOSE.


Glenn S. Broughton 1/21/14
GLENN S. BROUGHTON, NMPE 14171

1/20/2014


LEGEND

FL17.85 DESIGN GRADE
FL5417.30 AS-BUILT GRADE

GLENN S. BROUGHTON
NEW MEXICO
REGISTERED PROFESSIONAL ENGINEER
14171

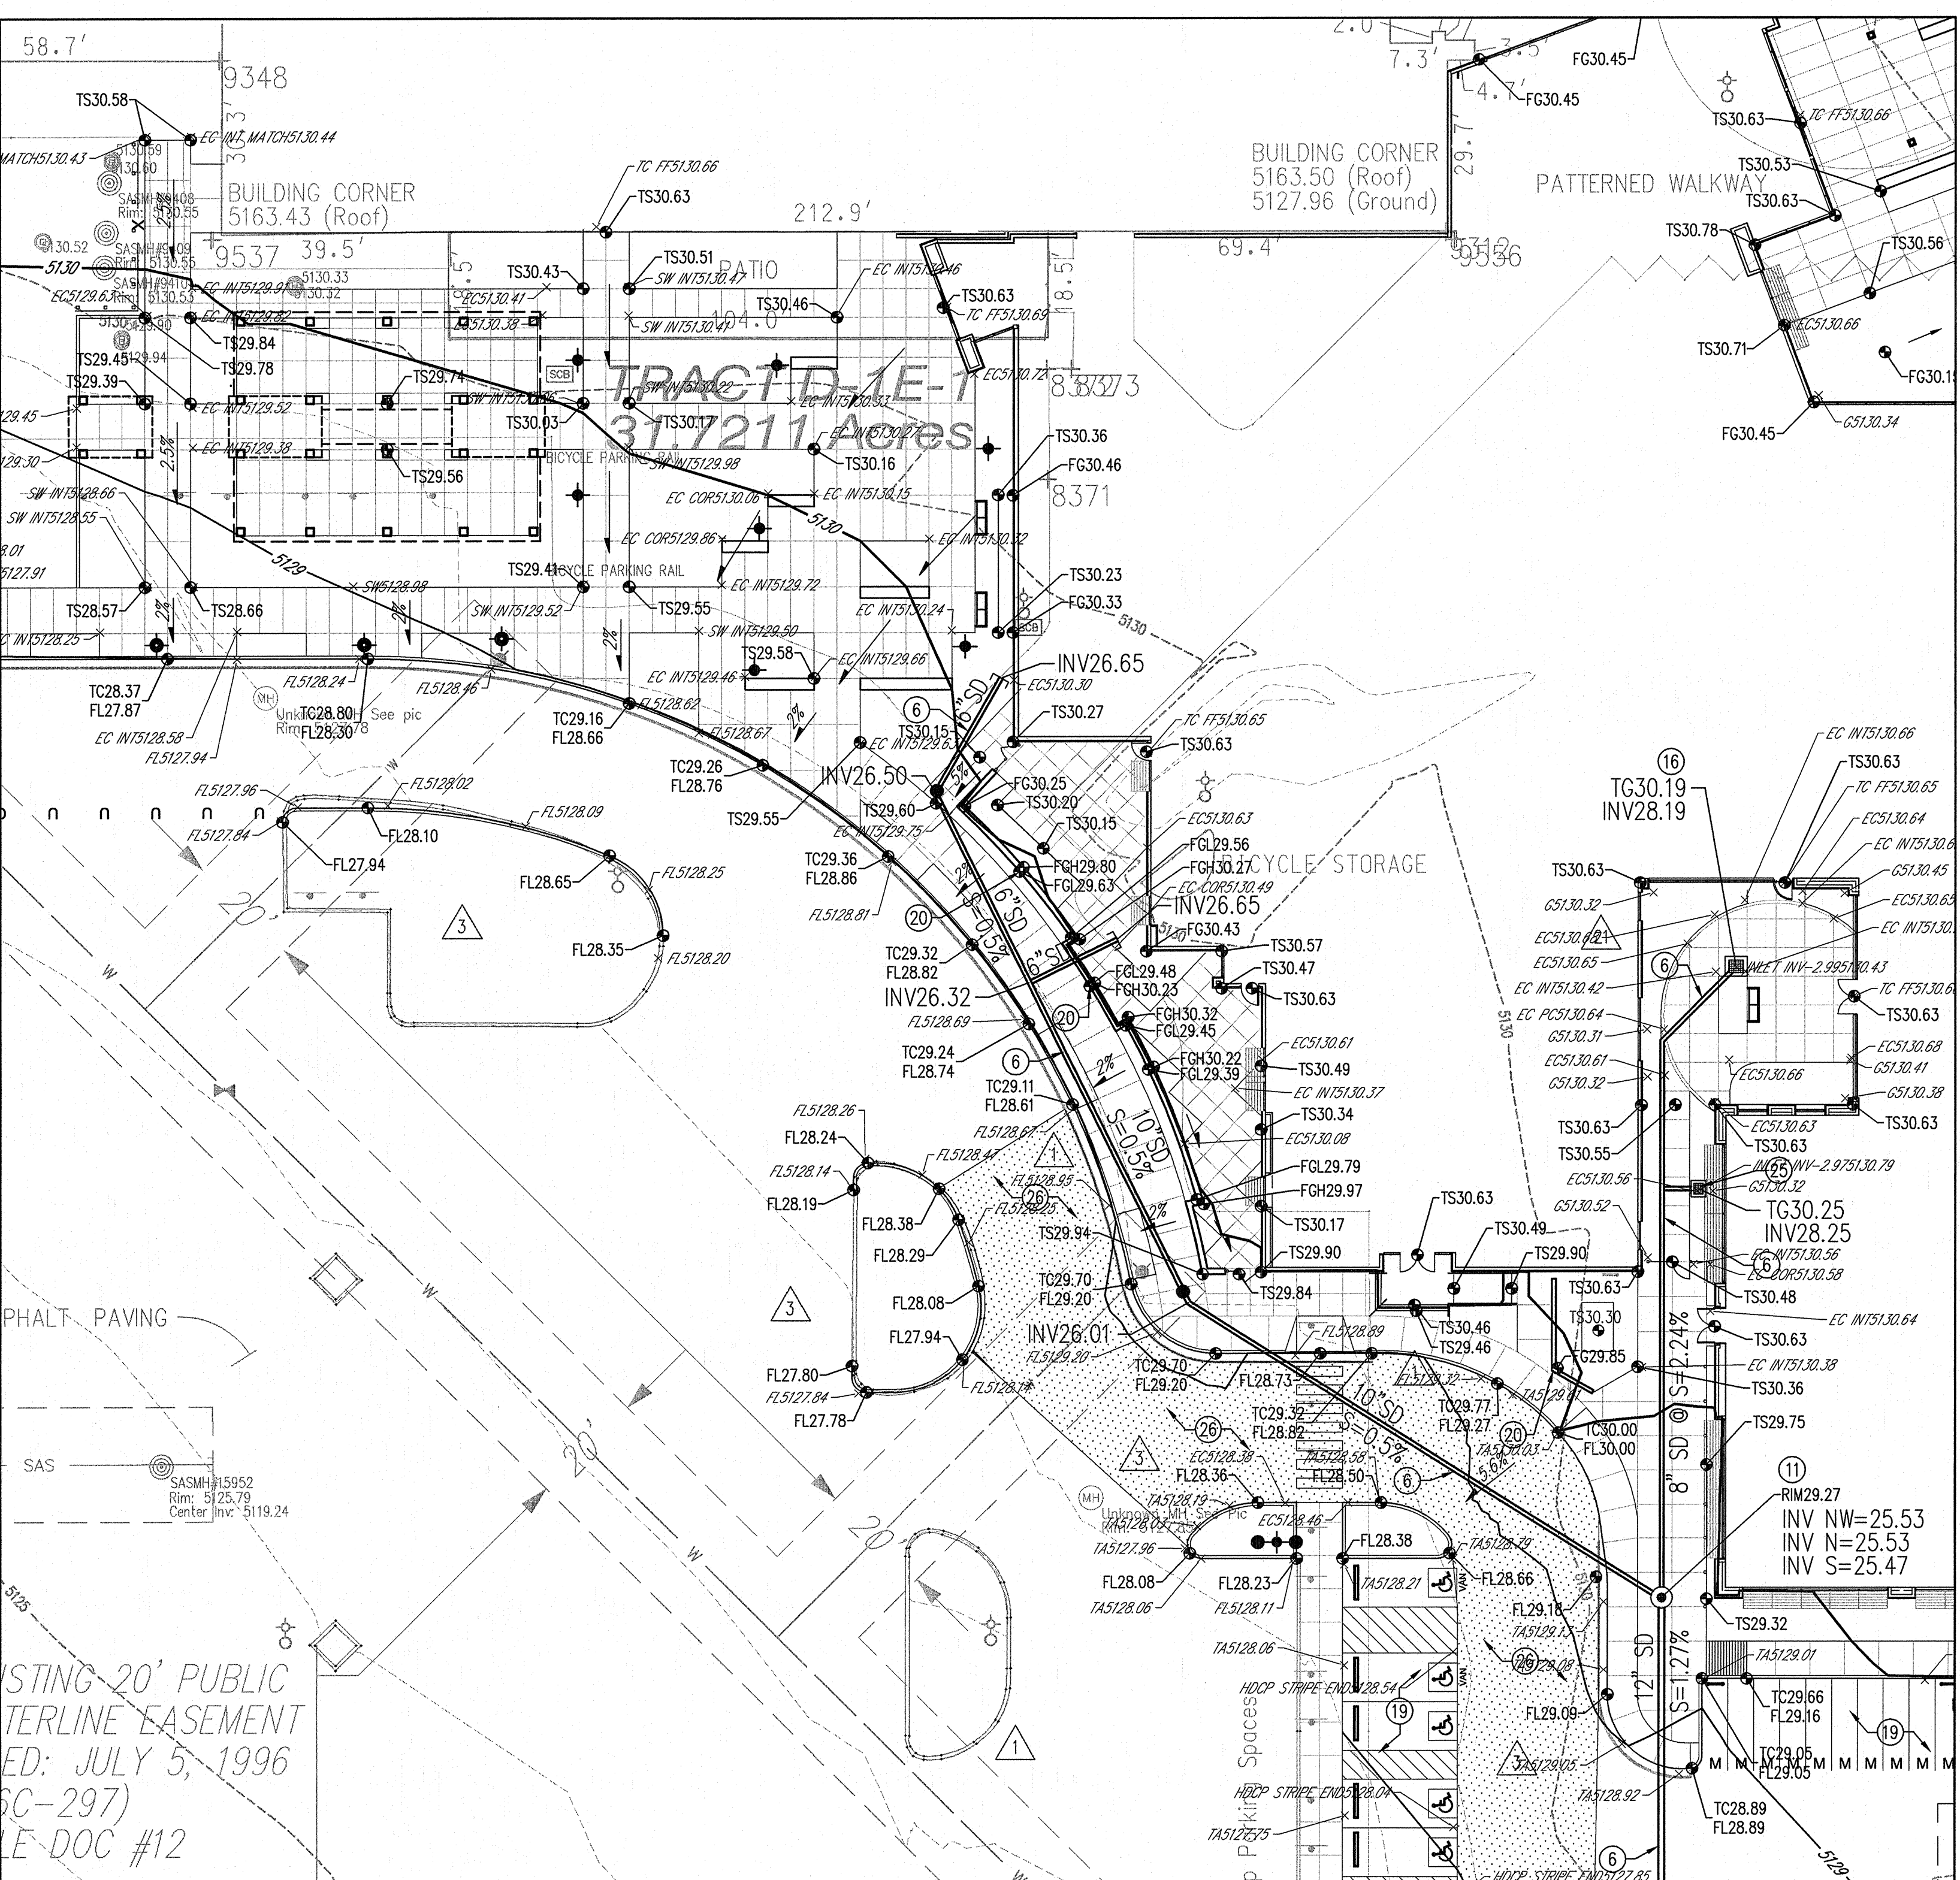

1 ENLARGED GRADING PLAN
1" = 20'-0"

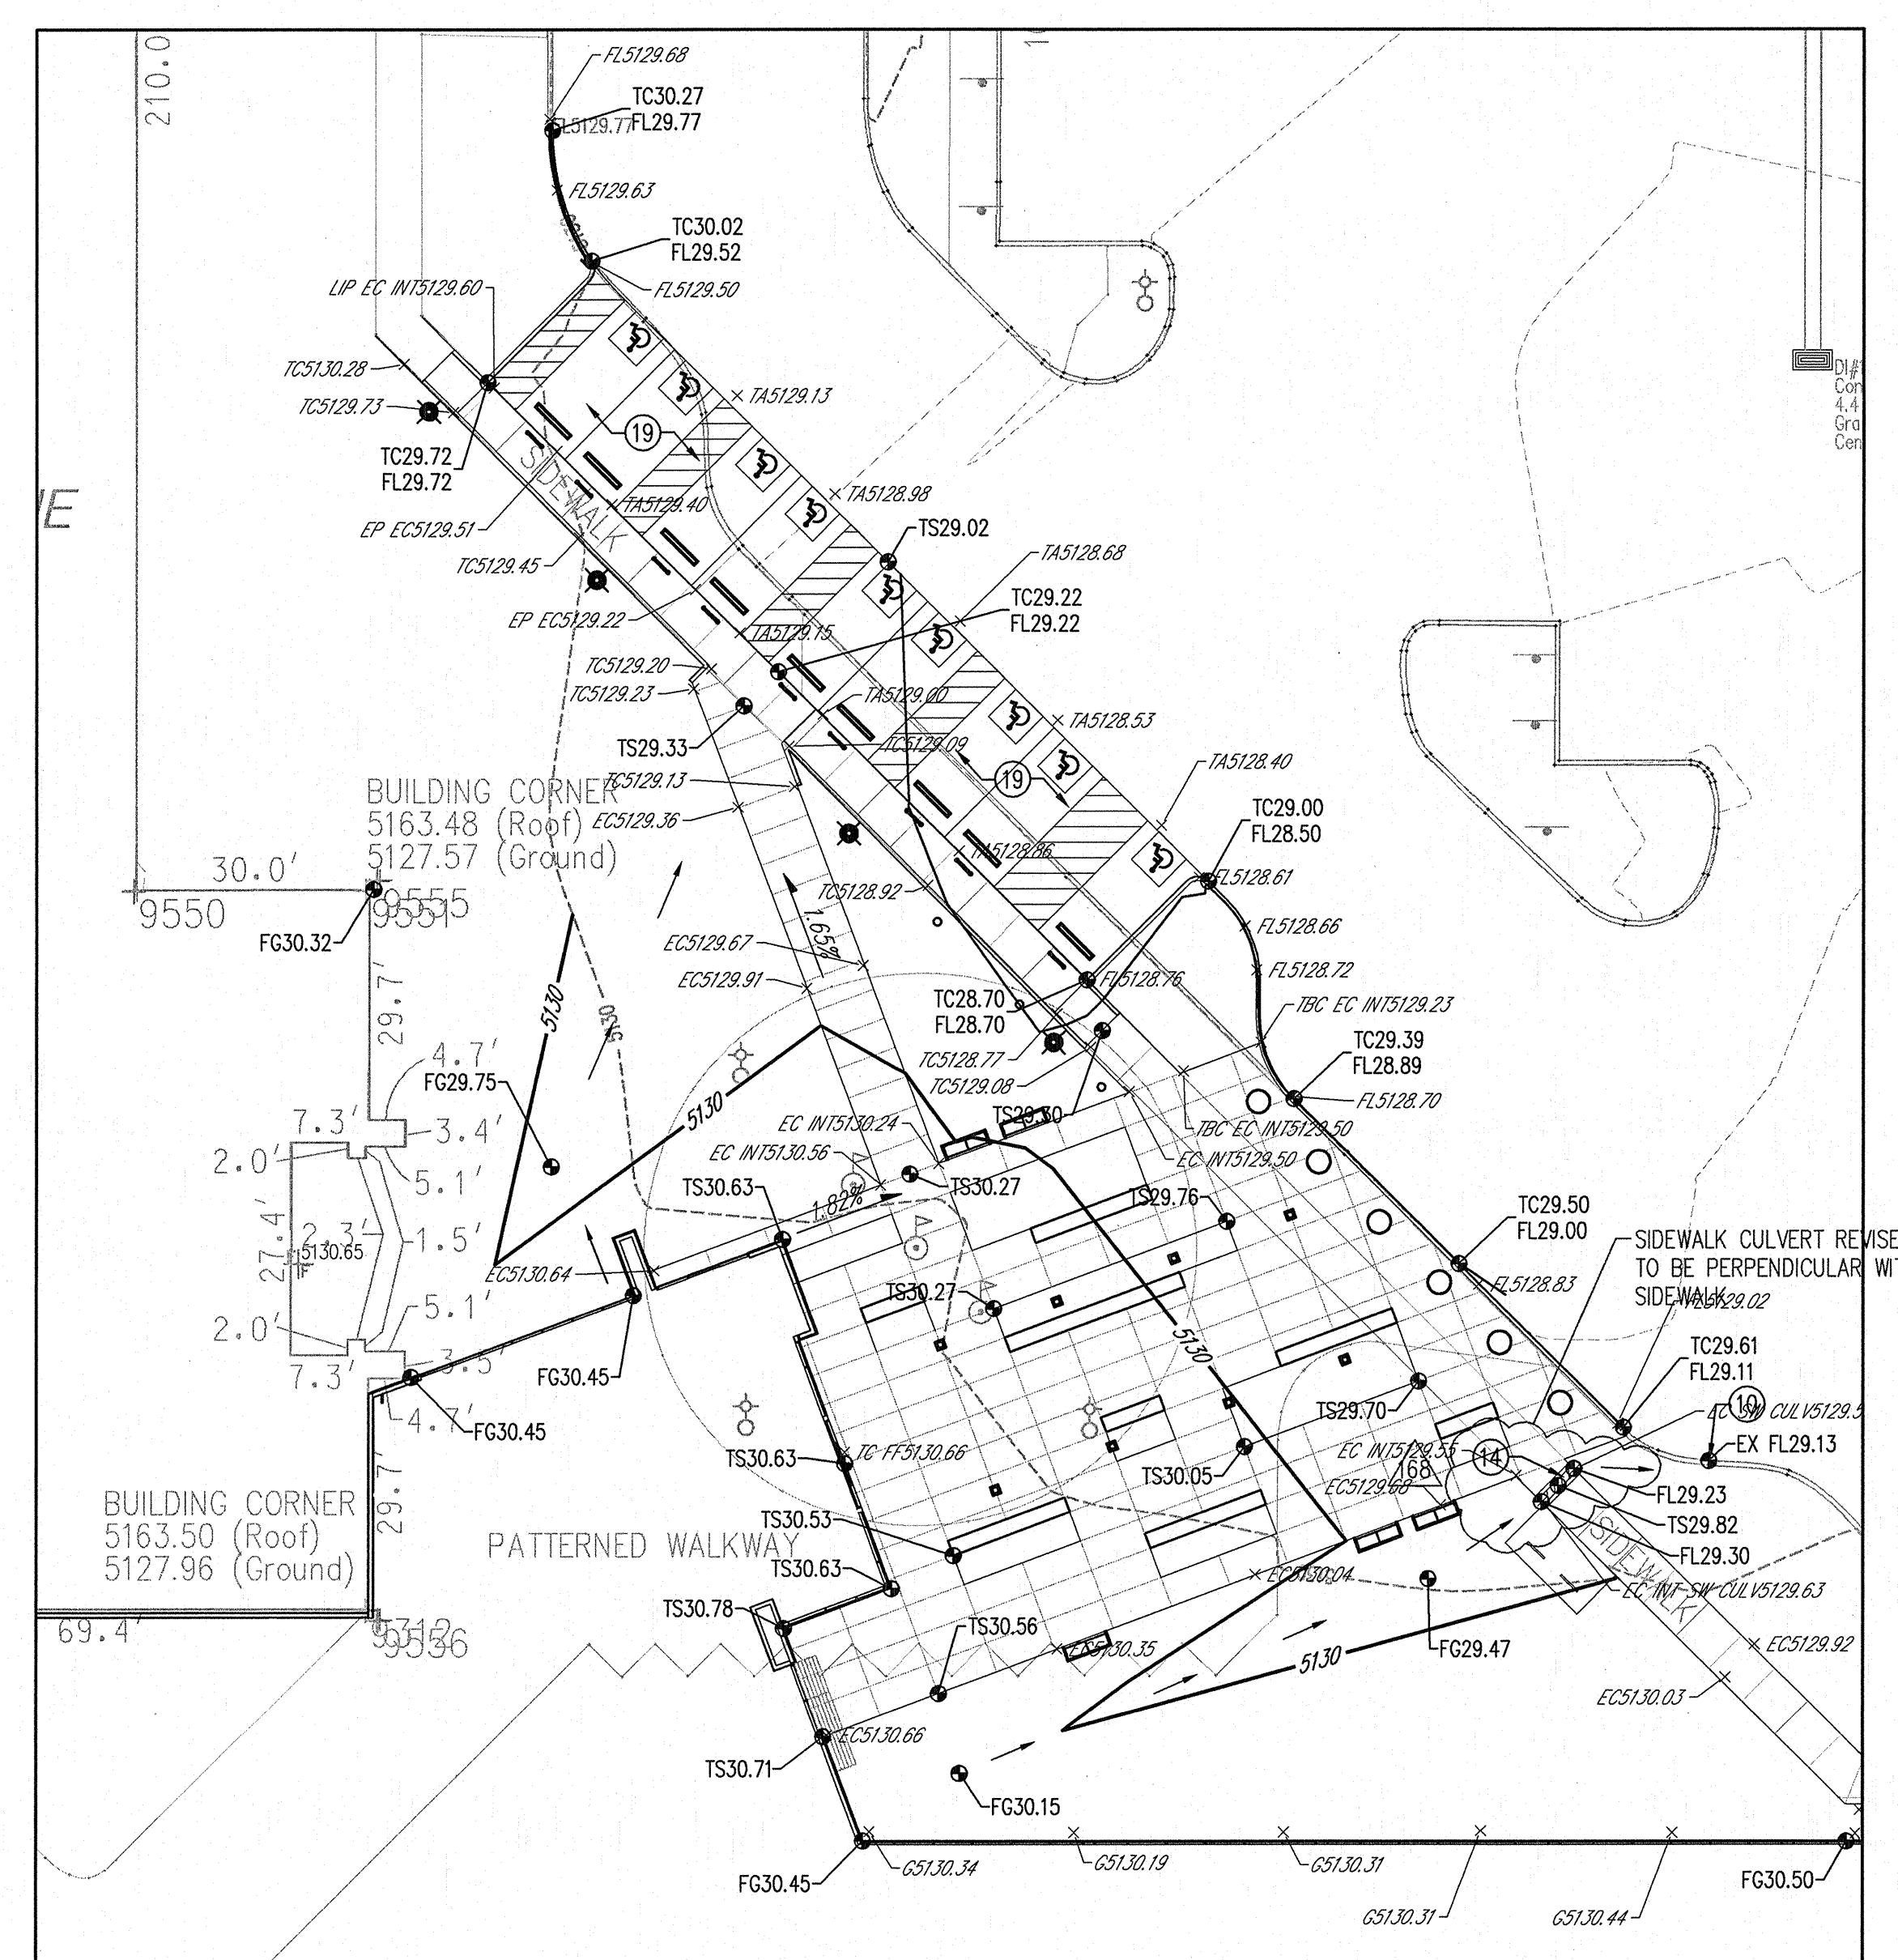

2 ENLARGED GRADING PLAN
1" = 20'-0"

KEYED NOTES

1. CONSTRUCT TYPE 'D' DOUBLE GRATE STORM DRAIN INLET PER COA STD DWG 2236.
2. CONSTRUCT TYPE 'D' SINGLE GRATE STORM DRAIN INLET PER COA STD DWG 2236.
3. EXISTING TYPE 'C' SINGLE GRATE STORM DRAIN INLET TO REMAIN.
4. EXISTING TYPE 'A' SINGLE GRATE STORM DRAIN INLET TO REMAIN.
5. EXISTING TYPE 'A' DOUBLE GRATE STORM DRAIN INLET TO REMAIN.
6. INSTALL STORM DRAIN PIPE. SEE PLAN FOR SIZE & SLOPE.
7. CONSTRUCT RETAINING WALL. SEE ARCHITECTURAL PLANS FOR DETAILS.
8. CONSTRUCT 3' WIDE CONCRETE RIBBON CHANNEL PER COA STD DWG 2236. OMIT CHECKERED STEEL PLATE.
9. EXISTING TYPE 'D' SINGLE GRATE INLET TO REMAIN.
10. CONSTRUCT 12" WIDE CURB OPENING FOR DRAINAGE/WATER HARVESTING. DEPRESS LANDSCAPE AREA PER DETAIL C3 ON SHEET L-105.
11. CONSTRUCT 4" DIA STORM DRAIN MANHOLE TYPE "C" PER COA STD DWG 2101.
12. INSTALL STORM DRAIN CLEANOUT PER DETAIL ON SHEET C-300.
13. CONSTRUCT 4" DIA STORM DRAIN MANHOLE TYPE "E" PER COA STD DWG 2102.
14. CONSTRUCT 12" WIDE SIDEWALK CULVERT PER COA STD DWG 2236.
15. INSTALL STORM DRAIN TO WITHIN 5' OF BUILDING. SEE PLUMBING PLANS FOR CONTINUATION.
16. INSTALL NYLOPLAST 12" DRAIN BASIN WITH 12" ROUND PEDESTRIAN GRATE.
17. NOT USED.
18. NOT USED.
19. INSTALL LIGHT DUTY PAVEMENT SECTION PER DETAIL ON SHEET C-100.
20. INSTALL 4" PVC PIPE SLEEVE THROUGH WALL FOR COURTYARD DRAINAGE. SEE PLAN FOR FINISHED GRADES & PIPE INVERT.
21. CONSTRUCT 24" WIDE CONCRETE RIBBON CHANNEL PER COA STD DWG 2236. OMIT CHECKERED STEEL PLATE.
22. CONNECT NEW STORM DRAIN TO EXISTING INLET/STORM DRAIN MANHOLE.
23. 18"x18"x10" TEE, 18"x12" REDUCER & 12" CAP.
24. INSTALL 2 - 24" WIDE SIDEWALK CULVERTS PER COA STD DWG 2236.
25. INSTALL 12" DRAIN BASIN W/ 12" DOME GRATE.
26. INSTALL HEAVY DUTY PAVEMENT SECTION PER DETAIL ON SHEET C-100.
27. CONSTRUCT TYPE 'A' SINGLE GRATE STORM DRAIN INLET PER COA STD DWG 2236.
28. INSTALL NYLOPLAST 12" DRAIN BASIN W/ 12" DOME GRATE.

NOTE: NOT ALL KEYED NOTES MAY APPLY TO THIS SHEET.

LEGEND

- PROPERTY LINE
- HEAVY DUTY ASPHALT PAVEMENT
SEE PAVEMENT SECTION ON SHEET C-100
- LIGHT DUTY ASPHALT PAVEMENT
SEE PAVEMENT SECTION ON SHEET C-100
- EXISTING CONTOURS
- PROPOSED SPOT ELEVATION
- TO-TOP OF CURB, FL=FLOW LINE
- TS=TOP OF SIDEWALK, TA=TOP OF ASPHALT
- EX=EXISTING, TO=FINISHED GRADE
- FB=FINISHED GRADE HIGH
- FL=FINISHED GRADE LOW
- PROPOSED DIRECTION OF FLOW
- WATER BLOCK
- PROPOSED RETAINING WALL
- PROPOSED INDEX CONTOURS
- PROPOSED INTER CONTOURS
- PROPOSED WATER HARVESTING SWALE
SEE 1/C-101
- SEDIMENT CONTROL BERM

DRAINAGE CERTIFICATION

I, GLENN S. BROUGHTON, NMPE 14171, OF THE FIRM BOHANNAN HUSTON INC., HEREBY CERTIFY THAT THIS PROJECT HAS BEEN GRADED AND WILL DRAIN IN SUBSTANTIAL COMPLIANCE WITH AND IN ACCORDANCE WITH THE DESIGN INTENT OF THE APPROVED PLAN DATED 11/23/2012. THE RECORD INFORMATION EDITED ONTO THE ORIGINAL DESIGN DOCUMENT HAS BEEN OBTAINED BY BRIAN MARTINEZ, NMPS 18374, OF THE FIRM CARTESIAN SURVEYS INC. I FURTHER CERTIFY THAT I HAVE PERSONALLY VISITED THE PROJECT SITE ON 1/15/2014 AND HAVE DETERMINED BY VISUAL INSPECTION THAT THE SURVEY DATA PROVIDED IS REPRESENTATIVE OF ACTUAL SITE CONDITIONS AND IS TRUE AND CORRECT TO THE BEST OF MY KNOWLEDGE AND BELIEF. THIS CERTIFICATION IS SUBMITTED IN SUPPORT OF A REQUEST FOR PERMANENT CERTIFICATE OF OCCUPANCY.


THE RECORD INFORMATION PRESENTED HEREON IS NOT NECESSARILY COMPLETE AND INTENDED ONLY TO VERIFY SUBSTANTIAL COMPLIANCE OF THE GRADING AND DRAINAGE ASPECTS OF THIS PROJECT. THOSE RELYING ON THIS RECORD DOCUMENT ARE ADVISED TO OBTAIN INDEPENDENT VERIFICATION OF ITS ACCURACY BEFORE USING IT FOR ANY OTHER PURPOSE.

Glenn S. Broughton
GLENN S. BROUGHTON, NMPE 14171


1/20/2014

LEGEND

- FL17.85 DESIGN GRADE
- FL1417.90 AS-BUILT GRADE

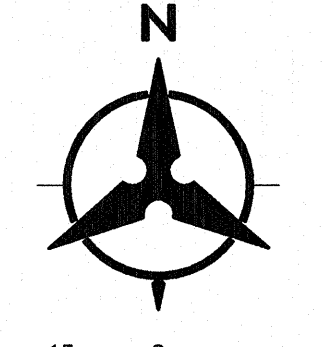

Bohannon & Huston

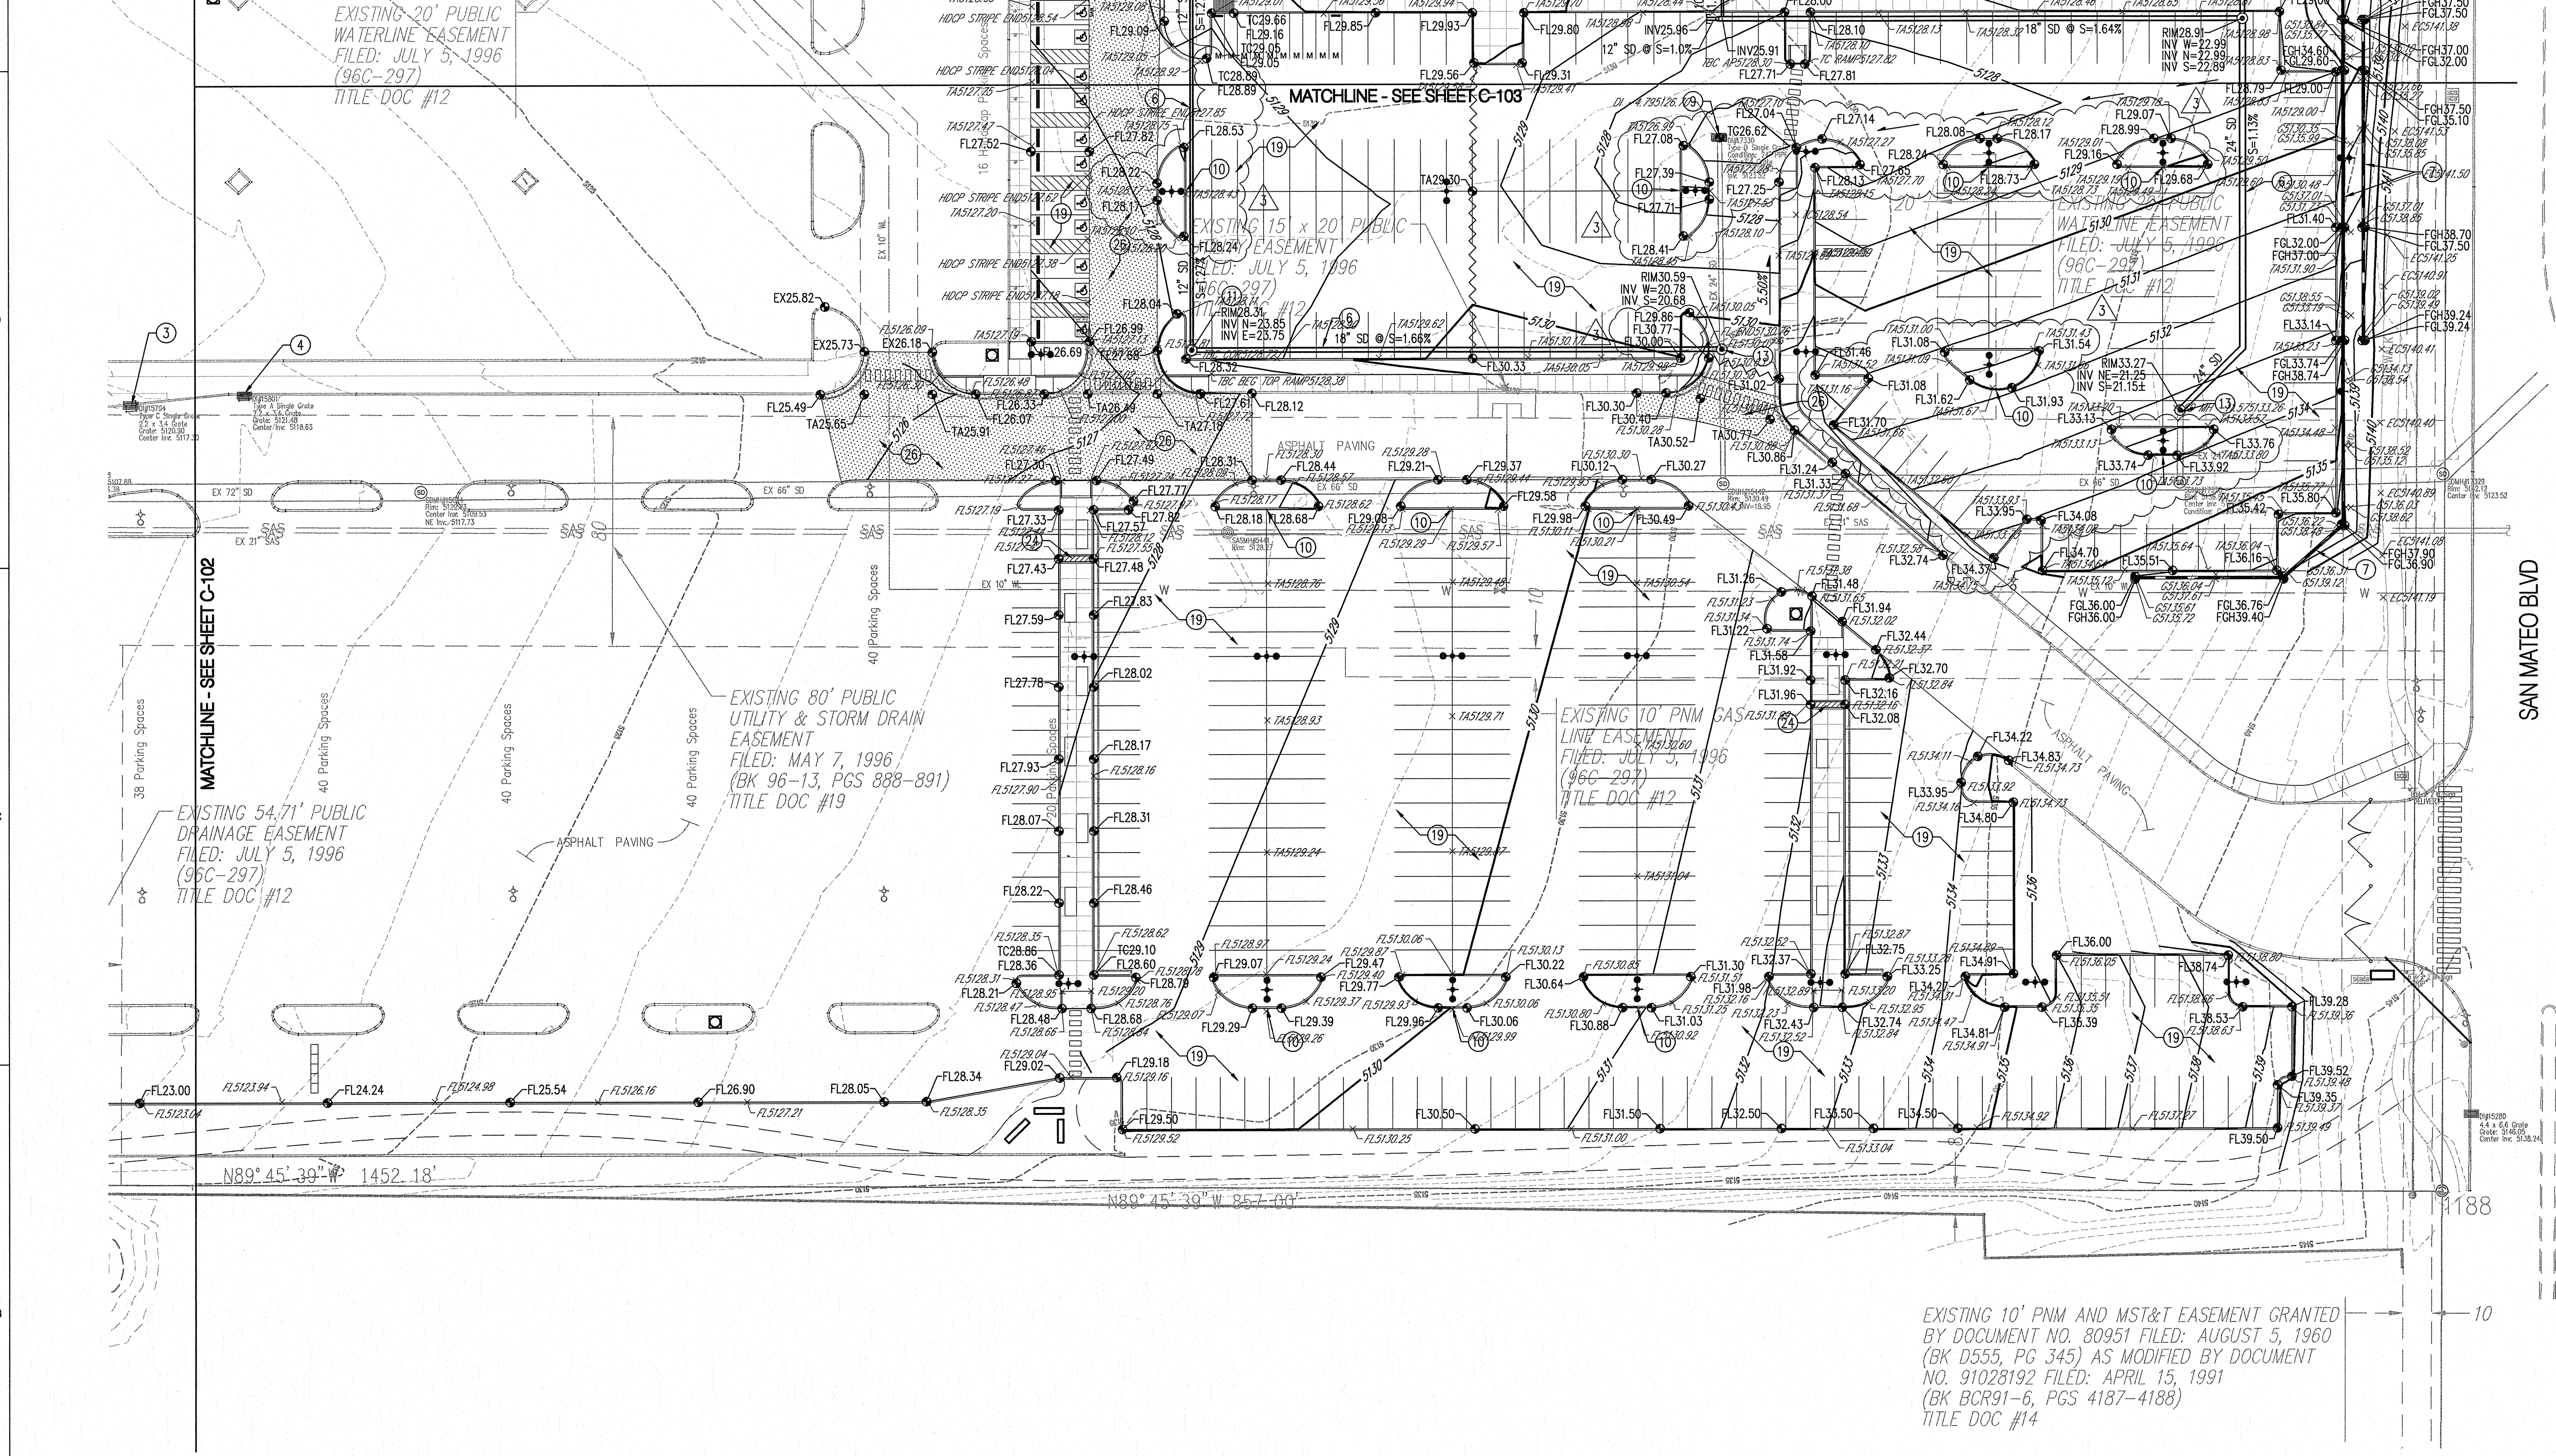

REVISIONS	
11/29/2012	ADDENDUM 001
11/29/2012	REVISION PER COA PERMIT REVIEW AND INCLUDED IN ADDENDUM 002
2/11/2013	RFW 012

DRAWN BY BO
REVIEWED BY GSB
DATE November 6, 2012
PROJECT NO. 11-0100.003
DRAWING NAME
GRADING &
DRAINAGE PLAN

SHEET NO.
C-103
OF

KEYED NOTES

- CONSTRUCT TYPE "D" DOUBLE GRATE STORM DRAIN INLET PER COA STD DWG 2206.
- CONSTRUCT TYPE "D" SINGLE GRATE STORM DRAIN INLET PER COA STD DWG 2206.
- EXISTING TYPE "C" SINGLE GRATE STORM DRAIN INLET TO REMAIN.
- EXISTING TYPE "A" SINGLE GRATE STORM DRAIN INLET TO REMAIN.
- EXISTING TYPE "A" DOUBLE GRATE STORM DRAIN INLET TO REMAIN.
- INSTALL STORM DRAIN PIPE. SEE PLAN FOR SIZE & SLOPE.
- CONSTRUCT RETAINING WALL, SEE ARCHITECTURAL PLANS FOR DETAILS.
- CONSTRUCT 3" WIDE CONCRETE RIBBON CHANNEL PER COA STD DWG 2236. OMIT CHECKERED STEEL PLATE.
- EXISTING TYPE "D" SINGLE GRATE INLET TO REMAIN.
- CONSTRUCT 12" WIDE CURB OPENING FOR DRAINAGE/WATER HARVESTING. DEPRESS LANDSCAPE AREA PER DETAIL C3 ON SHEET L-103.
- CONSTRUCT 4" DIA STORM DRAIN MANHOLE TYPE "C" PER COA STD DWG 2101.
- INSTALL STORM DRAIN CLEANOUT PER DETAIL ON SHEET C-300.
- CONSTRUCT 4" DIA STORM DRAIN MANHOLE TYPE "E" PER COA STD DWG 2102.
- CONSTRUCT 12" WIDE SIDEWALK CULVERT PER COA STD DWG 2236.
- INSTALL STORM DRAIN TO WITHIN 5' OF BUILDING. SEE PLUMBING PLANS FOR CONTINUATION.
- INSTALL NYLOPLAST 12" DRAIN BASIN WITH 12" ROUND PEDESTRIAN GRATE.
- NOT USED.
- NOT USED.
- INSTALL LIGHT DUTY PAVEMENT SECTION PER DETAIL ON SHEET C-100.
- INSTALL 4" PVC PIPE SLEEVE THROUGH WALL FOR COURTYARD DRAINAGE. SEE PLAN FOR FINISHED GRADES & PIPE INVERT.
- CONSTRUCT 3" WIDE CONCRETE RIBBON CHANNEL PER COA STD DWG 2236. OMIT CHECKERED STEEL PLATE.
- CONNECT NEW STORM DRAIN TO EXISTING INLET/STORM DRAIN MANHOLE.
- 23-18"x18"x10"-TEE, 18"x12"-REDUCER & 12"-CAP
- 24-INSTALL 2'-24" WIDE SIDEWALK CULVERTS PER COA STD DWG 2236.
- INSTALL 12" DRAIN BASIN W/ 12" DOME GRATE.
- INSTALL HEAVY DUTY PAVEMENT SECTION PER DETAIL ON SHEET C-100.
- CONSTRUCT TYPE "A" SINGLE GRATE STORM DRAIN INLET PER COA STD DWG 2201.
- 28-INSTALL NYLOPLAST 12" DRAIN BASIN W/ 12" DOME GRATE.

NOTE: NOT ALL KEYED NOTES MAY APPLY TO THIS SHEET.

LEGEND

- PROPERTY LINE
- HEAVY DUTY ASPHALT PAVEMENT
SEE PAVEMENT SECTION ON SHEET C-100
- LIGHT DUTY ASPHALT PAVEMENT
SEE PAVEMENT SECTION ON SHEET C-100
- EXISTING CONTOURS
- PROPOSED SPOT ELEVATION
TS=TOP OF CURB, FL=LOW LINE
TS=TOP OF SIDEWALK, TA=TOP OF ASPHALT
EX=EXISTING, FG=FINISHED GRADE
FGH=FINISHED GRADE HIGH
FGL=FINISHED GRADE LOW
- PROPOSED DIRECTION OF FLOW
- WATER BLOCK
- PROPOSED RETAINING WALL
- PROPOSED INDEX CONTOURS
- PROPOSED INTER CONTOURS
- PROPOSED WATER HARVESTING SWALE
SEE 1/C-101
- SEDIMENT CONTROL BERM

DRAINAGE CERTIFICATION


I, GLENN S. BROUGHTON, NMPE 14171, OF THE FIRM BOHANNAN HUSTON INC., HEREBY CERTIFY THAT THIS PROJECT HAS BEEN GRADED AND WILL DRAIN IN SUBSTANTIAL COMPLIANCE WITH AND IN ACCORDANCE WITH THE DESIGN INTENT OF THE APPROVED PLAN DATED 11/29/2012. THE RECORD INFORMATION EDITED ONTO THE ORIGINAL DESIGN DOCUMENT HAS BEEN OBTAINED BY BRIAN MARTINEZ, NMPS 18374, OF THE FIRM CARTESIAN SURVEYS INC. I FURTHER CERTIFY THAT I HAVE PERSONALLY VISITED THE PROJECT SITE ON 1/15/2014 AND HAVE DETERMINED BY VISUAL INSPECTION THAT THE SURVEY DATA PROVIDED IS REPRESENTATIVE OF ACTUAL SITE CONDITIONS AND IS TRUE AND CORRECT TO THE BEST OF MY KNOWLEDGE AND BELIEF. THIS CERTIFICATION IS SUBMITTED IN SUPPORT OF A REQUEST FOR PERMANENT CERTIFICATE OF OCCUPANCY.

THE RECORD INFORMATION PRESENTED HEREON IS NOT NECESSARILY COMPLETE AND INTENDED ONLY TO VERIFY SUBSTANTIAL COMPLIANCE OF THE GRADING AND DRAINAGE ASPECTS OF THIS PROJECT. THOSE RELYING ON THIS RECORD DOCUMENT ARE ADVISED TO OBTAIN INDEPENDENT VERIFICATION OF ITS ACCURACY BEFORE USING IT FOR ANY OTHER PURPOSE.

Glenn S. Broughton 1/21/14
GLENN S. BROUGHTON, NMPE 14171




- 1/20/2014
- LEGEND**
- FL17.65 DESIGN GRADE
 - FL1517.80 AS-BUILT GRADE

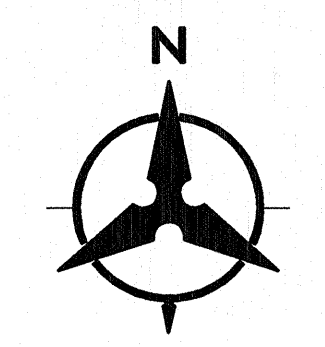

SCALE: 1"=30'

Bohannan & Huston

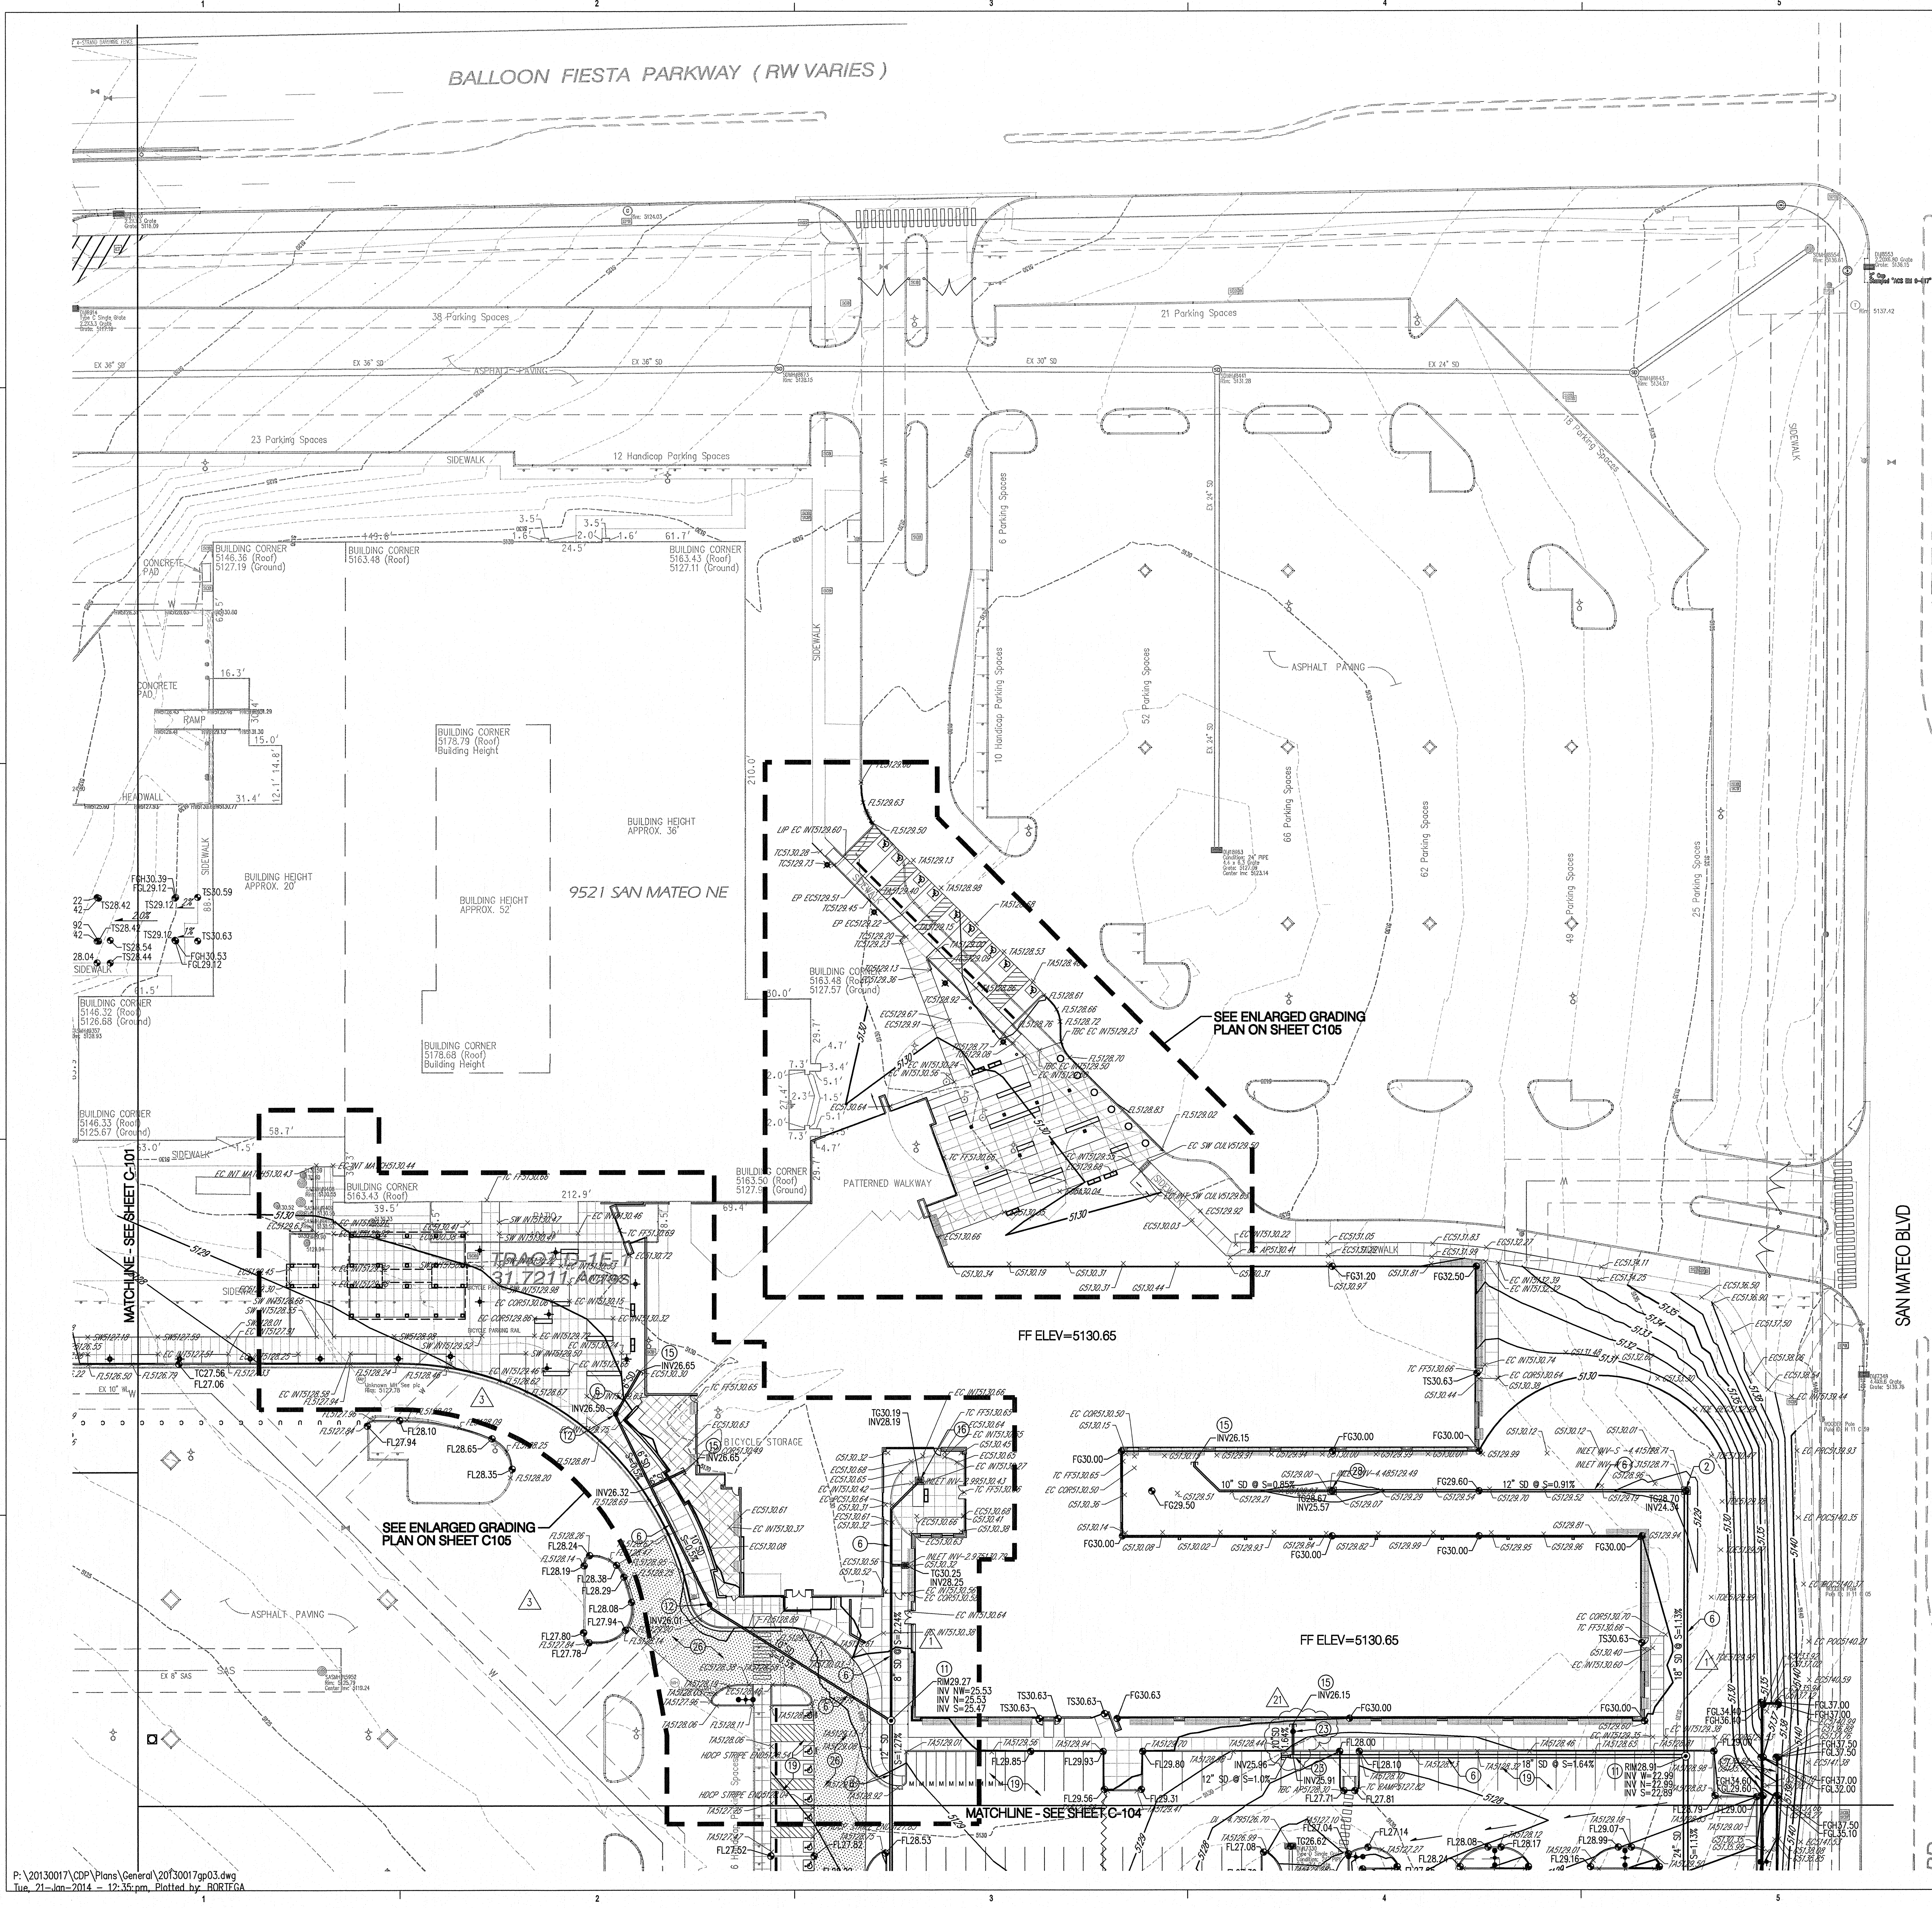

KEYED NOTES

1. CONSTRUCT TYPE "D" DOUBLE GRATE STORM DRAIN INLET PER COA STD DWG 2206.
2. CONSTRUCT TYPE "D" SINGLE GRATE STORM DRAIN INLET PER COA STD DWG 2206.
3. EXISTING TYPE "C" SINGLE GRATE STORM DRAIN INLET TO REMAIN.
4. EXISTING TYPE "A" SINGLE GRATE STORM DRAIN INLET TO REMAIN.
5. EXISTING TYPE "A" DOUBLE GRATE STORM DRAIN INLET TO REMAIN.
6. INSTALL STORM DRAIN PIPE. SEE PLAN FOR SIZE & SLOPE.
7. CONSTRUCT RETAINING WALL, SEE ARCHITECTURAL PLANS FOR DETAILS.
8. CONSTRUCT 3' WIDE CONCRETE RIBBON CHANNEL PER COA STD DWG 2236. OMIT CHECKERED STEEL PLATE.
9. EXISTING TYPE "D" SINGLE GRATE INLET TO REMAIN.
10. CONSTRUCT 12" WIDE CURB OPENING FOR DRAINAGE/WATER HARVESTING. DEPRESS LANDSCAPE AREA PER DETAIL C3 ON SHEET L-105.
11. CONSTRUCT 4' DIA STORM DRAIN MANHOLE TYPE "C" PER COA STD DWG 2101.
12. INSTALL STORM DRAIN CLEANOUT PER DETAIL ON SHEET C-300.
13. CONSTRUCT 4' DIA STORM DRAIN MANHOLE TYPE "E" PER COA STD DWG 2102.
14. CONSTRUCT 12" WIDE SIDEWALK CULVERT PER COA STD DWG 2236.
15. INSTALL STORM DRAIN TO WITHIN 5' OF BUILDING. SEE PLUMBING PLANS FOR CONTINUATION.
16. INSTALL NYLOPLAST 12" DRAIN BASIN WITH 12" ROUND PEDESTRIAN GRATE.
17. NOT USED.
18. NOT USED.
19. INSTALL LIGHT DUTY PAVEMENT SECTION PER DETAIL ON SHEET C-100.
20. INSTALL 4" PVC PIPE SLEEVE THROUGH WALL FOR COURTYARD DRAINAGE. SEE PLAN FOR FINISHED GRADES & PIPE INVERT.
21. CONSTRUCT 24" WIDE CONCRETE RIBBON CHANNEL PER COA STD DWG 2236. OMIT CHECKERED STEEL PLATE.
22. CONNECT NEW STORM DRAIN TO EXISTING INLET/STORM DRAIN MANHOLE.
23. 18"x18"x10" TEE, 18"x12" REDUCER & 12" CAP.
24. INSTALL 2 - 24" WIDE SIDEWALK CULVERTS PER COA STD DWG 2236.
25. INSTALL 12" DRAIN BASIN W/ 12" DOME GRATE.
26. INSTALL HEAVY DUTY PAVEMENT SECTION PER DETAIL ON SHEET C-100.
27. CONSTRUCT TYPE "A" SINGLE GRATE STORM DRAIN INLET PER COA STD DWG 2201.
28. INSTALL NYLOPLAST 12" DRAIN BASIN W/ 12" DOME GRATE.

NOTE: NOT ALL KEYED NOTES MAY APPLY TO THIS SHEET.

LEGEND

- PROPERTY LINE
- HEAVY DUTY ASPHALT PAVEMENT
SEE PAVEMENT SECTION ON SHEET C-100
- LIGHT DUTY ASPHALT PAVEMENT
SEE PAVEMENT SECTION ON SHEET C-100
- EXISTING CONTOURS
- PROPOSED SPOT ELEVATION
TC=TOP OF CURB, FL=FLOW LINE
TS=TOP OF SIDEWALK, TA=TOP OF ASPHALT
EX=EXISTING, FO=FINISHED GRADE
FGL=FINISHED GRADE HIGH
FGL=FINISHED GRADE LOW
- PROPOSED DIRECTION OF FLOW
- WATER BLOCK
- PROPOSED RETAINING WALL
- PROPOSED INDEX CONTOURS
- PROPOSED INTER CONTOURS
- PROPOSED WATER HARVESTING SWALE
SEE 1/C-101
- SEDIMENT CONTROL BERM

DRAINAGE CERTIFICATION

I, GLENN S. BROUGHTON, NMPE 14171, OF THE FIRM BOHANNAN HUSTON INC., HEREBY CERTIFY THAT THIS PROJECT HAS BEEN GRADED AND WILL DRAIN IN SUBSTANTIAL COMPLIANCE WITH AND IN ACCORDANCE WITH THE DESIGN INTENT OF THE APPROVED PLAN DATED 11/23/2012. THE RECORD INFORMATION EDITED ONTO THE ORIGINAL DESIGN DOCUMENT HAS BEEN OBTAINED BY BRIAN MARTINEZ, NMPS 18374, OF THE FIRM CARTESIAN SURVEYS INC. I FURTHER CERTIFY THAT I HAVE PERSONALLY VISITED THE PROJECT SITE ON 1/15/2014 AND HAVE DETERMINED BY VISUAL INSPECTION THAT THE SURVEY DATA PROVIDED IS REPRESENTATIVE OF ACTUAL SITE CONDITIONS AND IS TRUE AND CORRECT TO THE BEST OF MY KNOWLEDGE AND BELIEF. THIS CERTIFICATION IS SUBMITTED IN SUPPORT OF A REQUEST FOR PERMANENT CERTIFICATE OF OCCUPANCY.



THE RECORD INFORMATION PRESENTED HEREON IS NOT NECESSARILY COMPLETE AND INTENDED ONLY TO VERIFY SUBSTANTIAL COMPLIANCE OF THE GRADING AND DRAINAGE ASPECTS OF THIS PROJECT. THOSE RELYING ON THIS RECORD DOCUMENT ARE ADVISED TO OBTAIN INDEPENDENT VERIFICATION OF ITS ACCURACY BEFORE USING IT FOR ANY OTHER PURPOSE.

GLENN S. BROUGHTON 1/21/14
GLENN S. BROUGHTON, NMPE 14171

1/20/2014

LEGEND

- FL17.85 DESIGN GRADE
- FL147.80 AS-BUILT GRADE

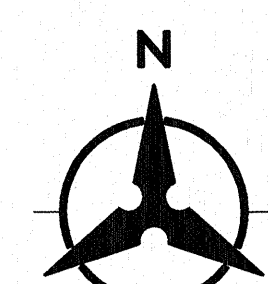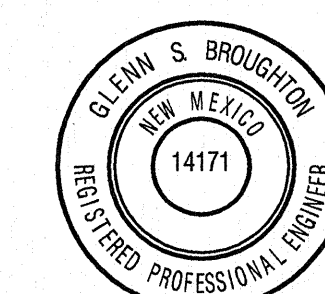

SCALE: 1"=30'