



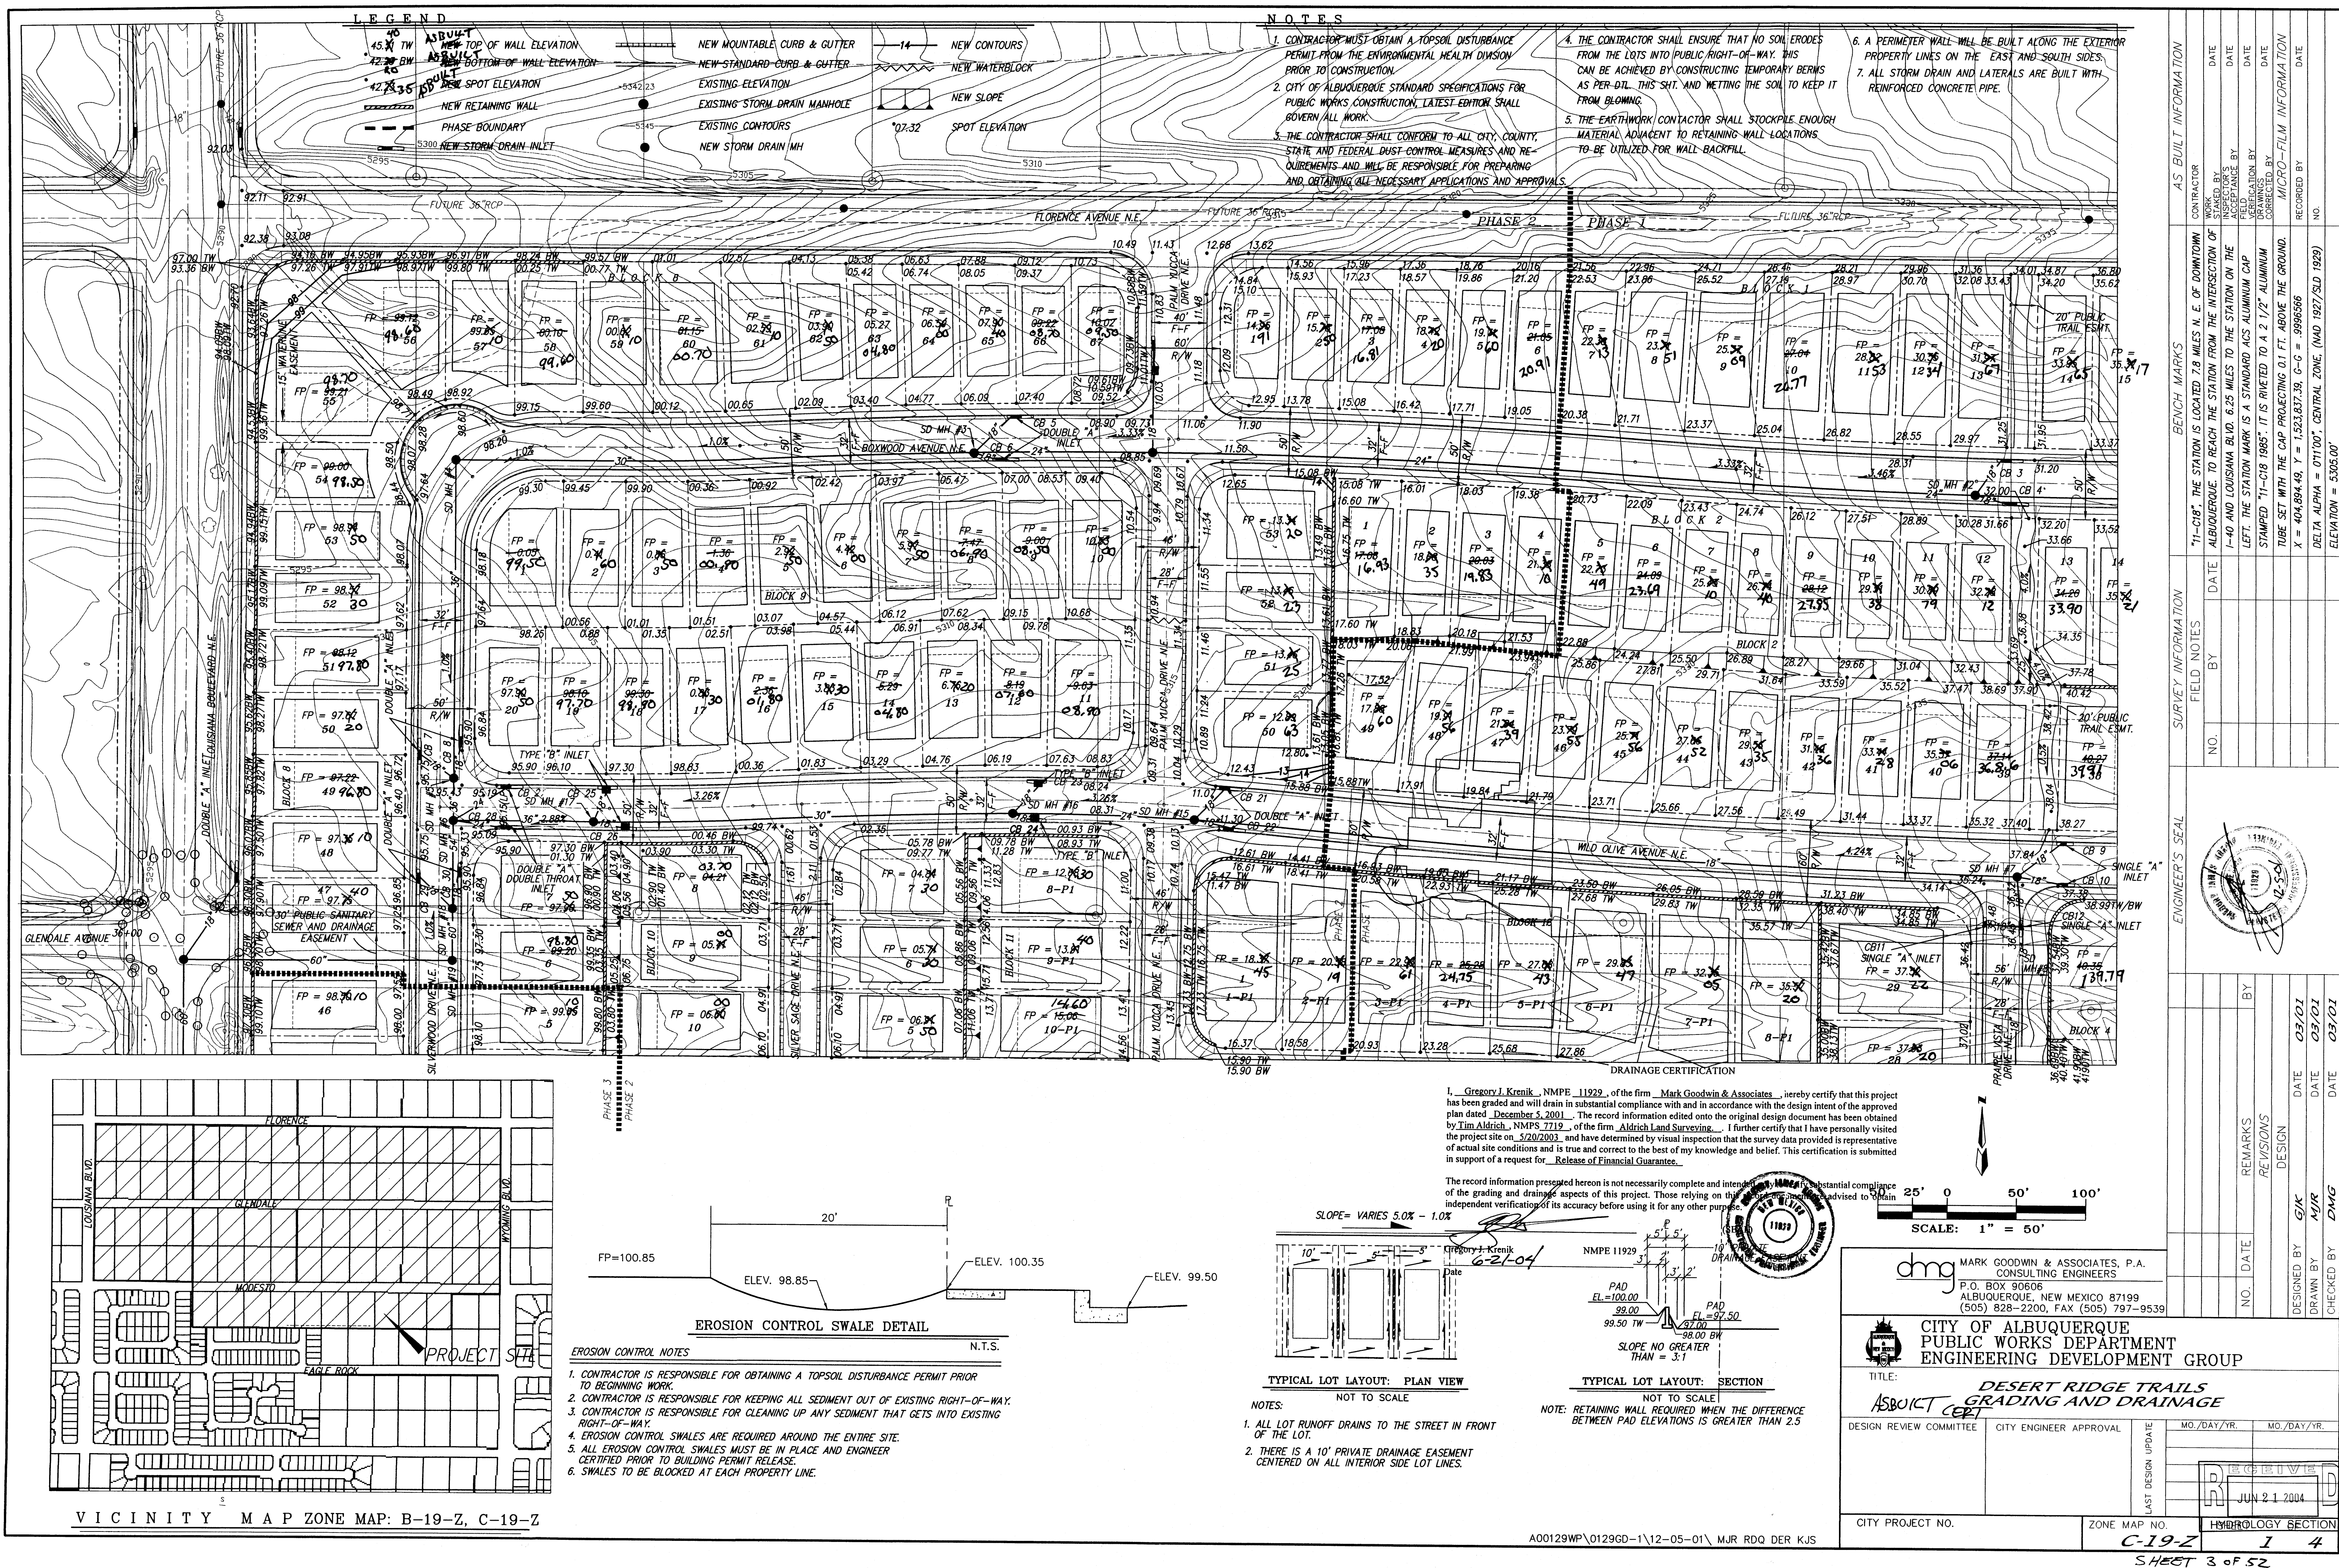

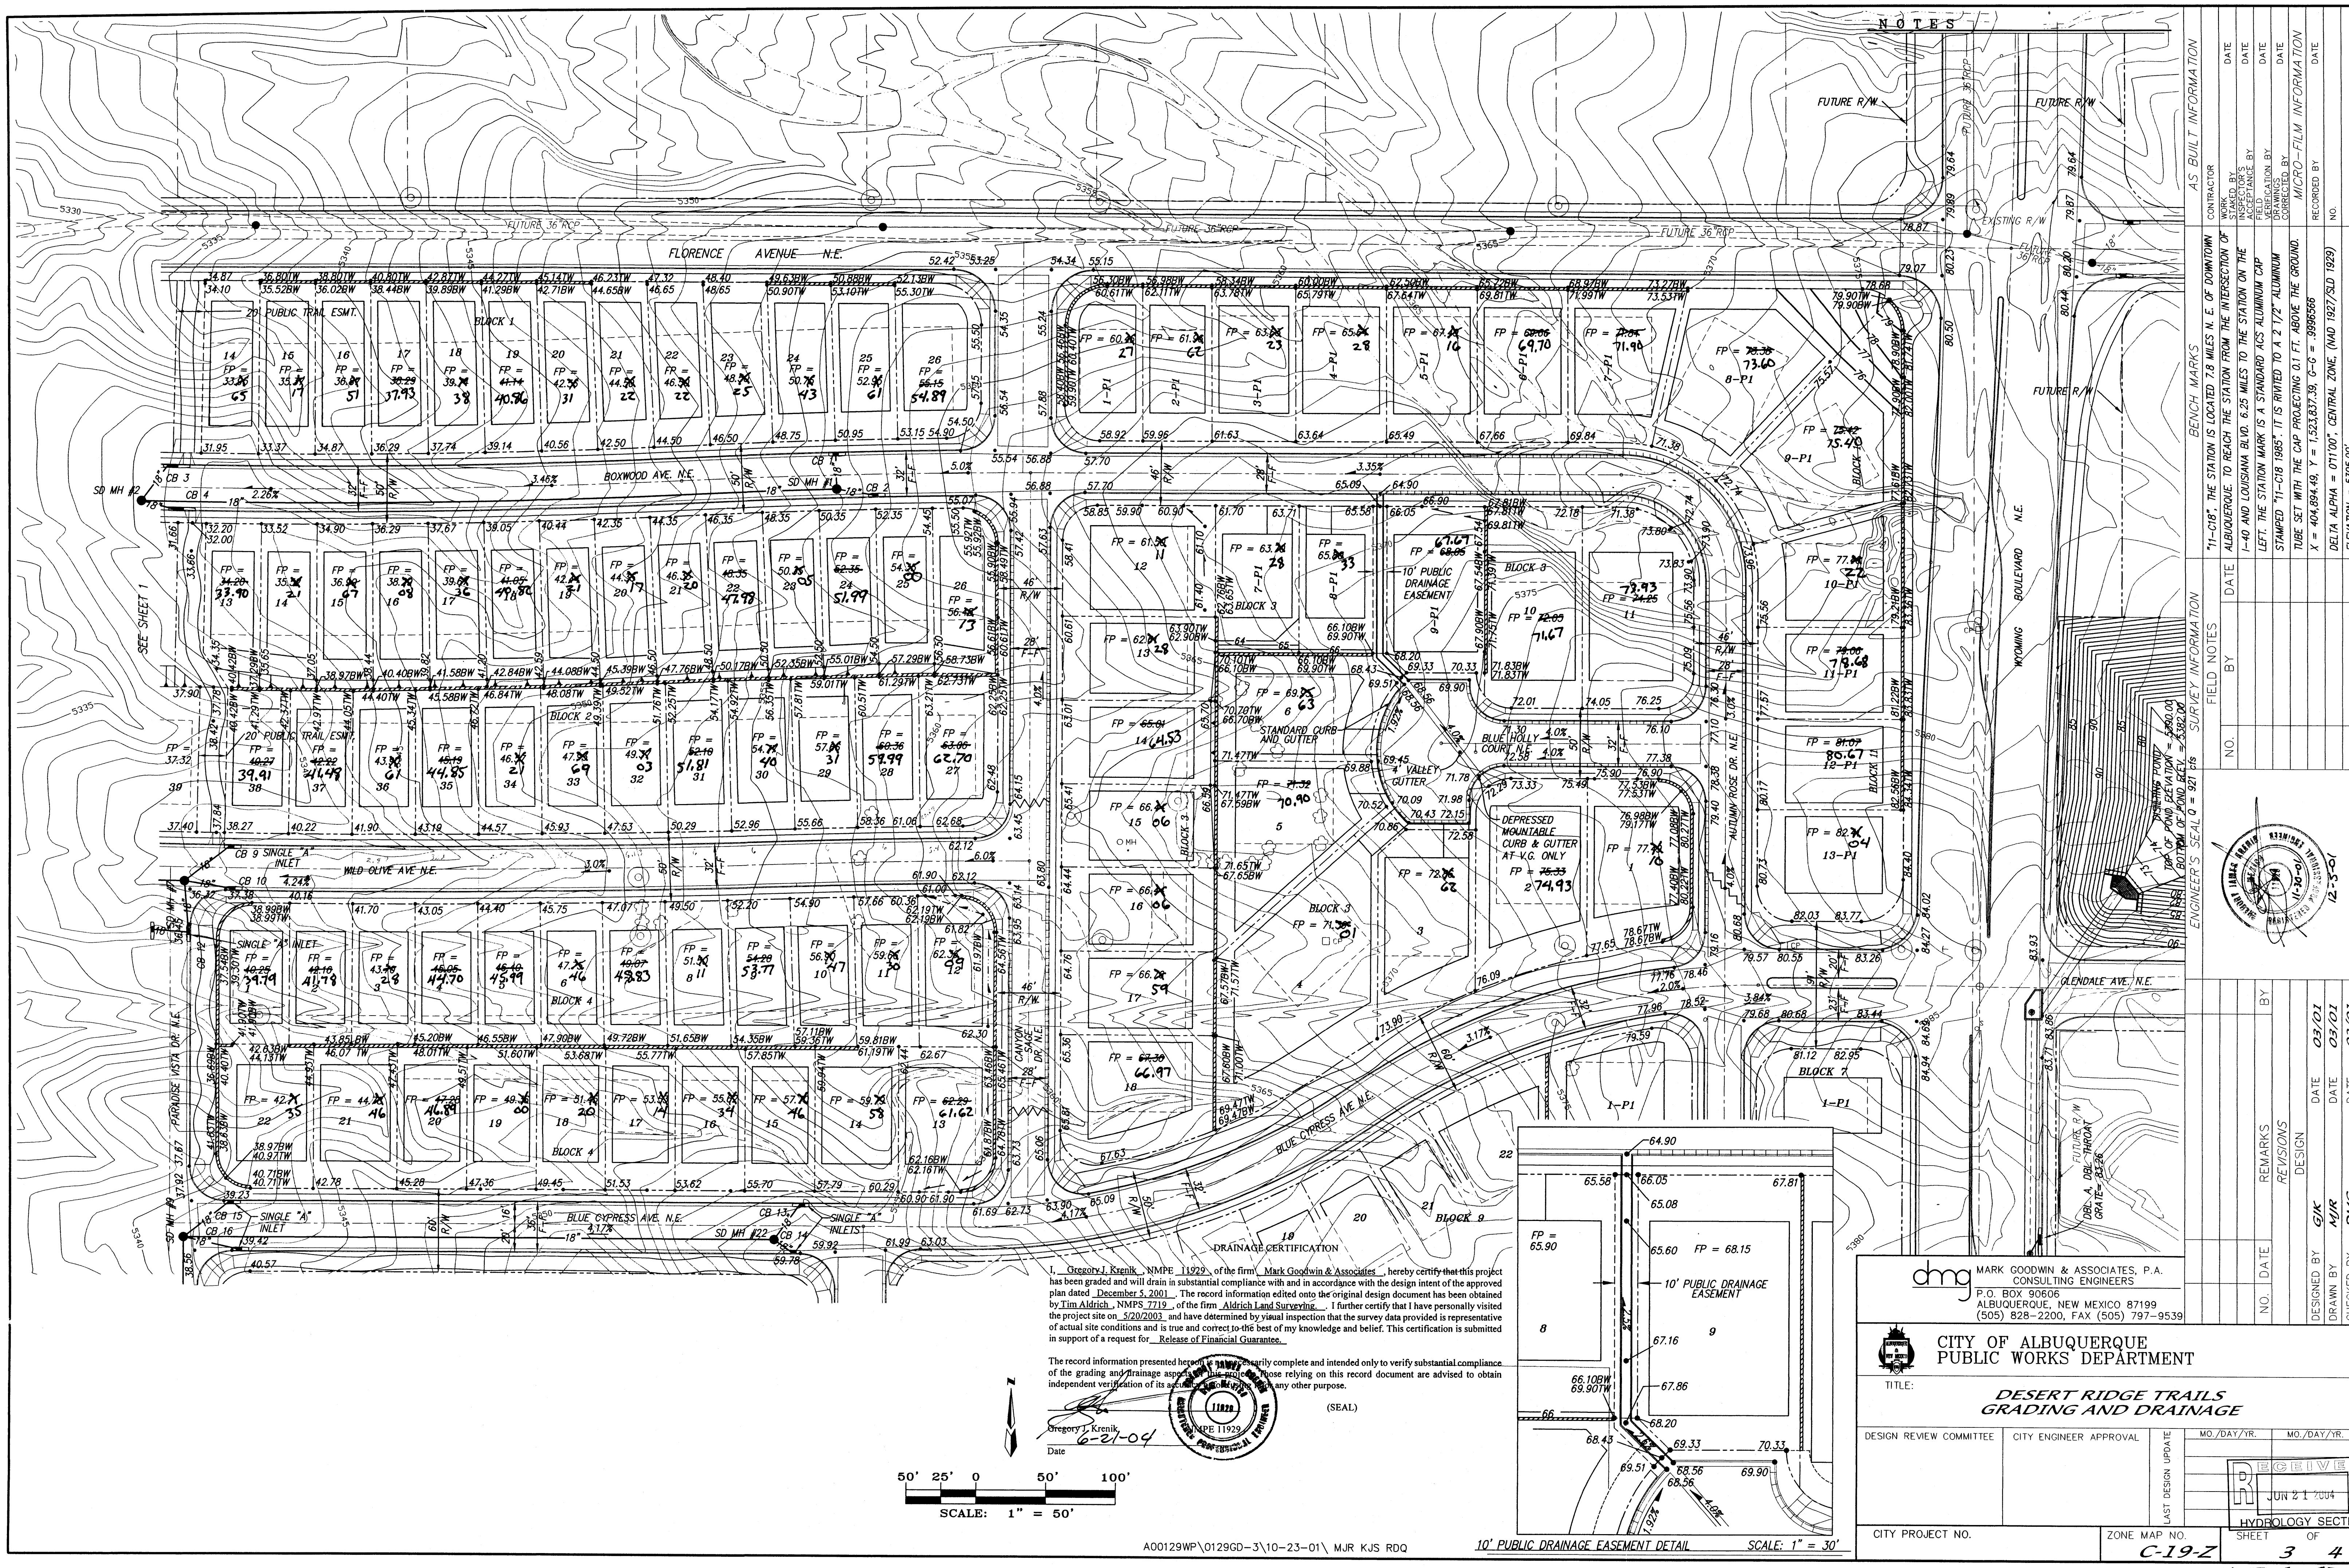

NOTES

11-CIB, THE STATION IS LOCATED 7.8 MILES N. E. OF DOWNTOWN ALBUQUERQUE, TO REACH THE STATION FROM THE INTERSECTION OF I-40 AND LOUISIANA BLVD. 6.25 MILES TO THE STATION ON THE LEFT. THE STATION MARK IS A STANDARD AGS ALUMINUM CAP STAMPED "11-CIB 1985". IT IS RITVED TO A 1/2" ALUMINUM TUBE SET WITH THE CAP PROTECTING 0.1 FT. ABOVE THE GROUND. X = 404,894.49, Y = 1,523,837.39, G-C = 999556 DELTA ALPHA = 011007, CENTRAL ZONE, (NAD 1927/SD 1929) ELEVATION = 5305.00'

DESIGN REVIEW COMMITTEE

CITY ENGINEER APPROVAL

CITY PROJECT NO.

ZONE MAP NO.

LAST DESIGN UPDATE

SHEET

OF

RECEIVED

HYDROLOGY SECTION

MARK GOODWIN & ASSOCIATES, P.A.
CONSULTING ENGINEERS
P.O. BOX 90606
ALBUQUERQUE, NEW MEXICO 87199
(505) 828-2200, FAX (505) 797-9539

CITY OF ALBUQUERQUE
PUBLIC WORKS DEPARTMENT

TITLE:
DESERT RIDGE TRAILS
GRADING AND DRAINAGE

DESIGNED BY: GJK
DRAWN BY: MJR
CHECKED BY: DMG

DATE: 03/01
DATE: 03/01
DATE: 03/01

AS BUILT INFORMATION

CONTRACTOR

WORK

DATE

STATIONED BY

DATE

ACCEPTANCE BY

DATE

FIELD

DATE

DRAWINGS

DATE

CORRECTED BY

DATE

MICRO-FILM INFORMATION

RECORDED BY

DATE

NO.

I, Gregory J. Krenik, NMPE 11929, of the firm Mark Goodwin & Associates, hereby certify that this project has been graded and will drain in substantial compliance with and in accordance with the design intent of the approved plan dated December 5, 2001. The record information edited onto the original design document has been obtained by Tim Aldrich, NMPS 2712, of the firm Aldrich Land Surveying. I further certify that I have personally visited the project site on 5/20/2003, and have determined by visual inspection that the survey data provided is representative of actual site conditions and is true and correct to the best of my knowledge and belief. This certification is submitted in support of a request for Release of Financial Guarantee.

The record information presented herein is for informational purposes only and is not intended to verify substantial compliance of the grading and drainage aspects of the project. Those relying on this record document are advised to obtain independent verification of its accuracy for any other purpose.

Gregory J. Krenik, NMPE 11929
6-21-04
Date

A00129WP\0129GD-3\10-23-01\ MJR KJS RDQ

10' PUBLIC DRAINAGE EASEMENT DETAIL SCALE: 1" = 30'

SHEET 5 OF 62

