

CITY OF ALBUQUERQUE

Planning Department
David Campbell, Director



Mayor Timothy M. Keller

July 1, 2019

Don Briggs, P.E.
Don Briggs Engineering, LLC
5324 Oakledge Ct. NW
Albuquerque, NM 87120

RE: 8500 Glendale Ave. NE
Grading and Drainage Plan
Engineer's Stamp Date: 05/28/19
Hydrology File: B20D067

Dear Mr. Briggs:

PO Box 1293

Based upon the information provided in your resubmittal received 06/25/2019, the Grading and Drainage Plan is approved for Building Permit, Grading Permit, and for action by the DRB on Site Plan for Building Permit.

Albuquerque

Please note that prior to Building Permit, an Engineer's Certification of the compacted pad and grading, per the DPM Chapter 22.7: Engineer's Certification Checklist For Non-Subdivision is required.

NM 87103

Please attach a copy of this approved plan in the construction sets for Building Permit processing along with a copy of this letter. Prior to approval in support of Permanent Release of Occupancy by Hydrology, Engineer Certification per the DPM checklist will be required.

www.cabq.gov

As a reminder, if the project total area of disturbance (including the staging area and any work within the adjacent Right-of-Way) is 1 acre or more, then an Erosion and Sediment Control (ESC) Plan and Owner's certified Notice of Intent (NOI) is required to be submitted to the Stormwater Quality Engineer (Curtis Cherne, PE, ccherne@cabq.gov, 924-3420) 14 days prior to any earth disturbance.

Also as a reminder, please provide the drainage easement along the 100 year floodplain line granted to the City prior to Permanent Release of Occupancy. Please submit this on the 4th floor of Plaza de Sol. A \$25 fee will be required. The Permanent Easement form can be obtained at the Hydrology Section's webpage. This must be recorded prior to submitting the Agreement and Covenant recording.

<https://www.cabq.gov/planning/development-review-services/hydrology-section>

CITY OF ALBUQUERQUE

Planning Department
David Campbell, Director



Mayor Timothy M. Keller

Please provide the Agreement and Covenant to the City prior to Permanent Release of Occupancy. Please submit this on the 4th floor of Plaza de Sol. A \$25 fee will be required.

If you have any questions, please contact me at 924-3995 or rbrissette@cabq.gov.

Sincerely,

A handwritten signature in purple ink that reads 'Renée C. Brissette'.

Renée C. Brissette, P.E. CFM
Senior Engineer, Hydrology
Planning Department

PO Box 1293

Albuquerque

NM 87103

www.cabq.gov



City of Albuquerque

Planning Department

Development & Building Services Division

DRAINAGE AND TRANSPORTATION INFORMATION SHEET (REV 11/2018)

Project Title: _____ **Building Permit #:** _____ **Hydrology File #:** _____

DRB#: _____ **EPC#:** _____ **Work Order#:** _____

Legal Description: _____

City Address: _____

Applicant: _____ **Contact:** _____

Address: _____

Phone#: _____ **Fax#:** _____ **E-mail:** _____

Owner: _____ **Contact:** _____

Address: _____

Phone#: _____ **Fax#:** _____ **E-mail:** _____

TYPE OF SUBMITTAL: _____ PLAT (___ # OF LOTS) _____ RESIDENCE _____ DRB SITE _____ ADMIN SITE

IS THIS A RESUBMITTAL?: _____ Yes _____ No

DEPARTMENT: _____ TRAFFIC/ TRANSPORTATION _____ HYDROLOGY/ DRAINAGE

Check all that Apply:

TYPE OF SUBMITTAL:

- _____ ENGINEER/ARCHITECT CERTIFICATION
- _____ PAD CERTIFICATION
- _____ CONCEPTUAL G & D PLAN
- _____ GRADING PLAN
- _____ DRAINAGE MASTER PLAN
- _____ DRAINAGE REPORT
- _____ FLOODPLAIN DEVELOPMENT PERMIT APPLIC
- _____ ELEVATION CERTIFICATE
- _____ CLOMR/LOMR
- _____ TRAFFIC CIRCULATION LAYOUT (TCL)
- _____ TRAFFIC IMPACT STUDY (TIS)
- _____ OTHER (SPECIFY) _____
- _____ PRE-DESIGN MEETING?

TYPE OF APPROVAL/ACCEPTANCE SOUGHT:

- _____ BUILDING PERMIT APPROVAL
- _____ CERTIFICATE OF OCCUPANCY
- _____ PRELIMINARY PLAT APPROVAL
- _____ SITE PLAN FOR SUB'D APPROVAL
- _____ SITE PLAN FOR BLDG. PERMIT APPROVAL
- _____ FINAL PLAT APPROVAL
- _____ SIA/ RELEASE OF FINANCIAL GUARANTEE
- _____ FOUNDATION PERMIT APPROVAL
- _____ GRADING PERMIT APPROVAL
- _____ SO-19 APPROVAL
- _____ PAVING PERMIT APPROVAL
- _____ GRADING/ PAD CERTIFICATION
- _____ WORK ORDER APPROVAL
- _____ CLOMR/LOMR
- _____ FLOODPLAIN DEVELOPMENT PERMIT
- _____ OTHER (SPECIFY) _____

DATE SUBMITTED: _____ **By:** _____

COA STAFF:

ELECTRONIC SUBMITTAL RECEIVED: _____

FEE PAID: _____




June 25, 2019
Renée C. Brissette, P.E. CFM
Senior Engineer, Hydrology
Planning Department

RE File: B20D067, 8500 Glendale Ave. NE

Dear Ms. Brissette,
Attached is a revised plan set based on your comments of June 10th, 2019. I have addressed the comments as follows:

1. It appears that your engineering stamp is too big. The NM Board of Licensure for Professional Engineers and Professional Surveyors Administrative Code 16.39.3.12.C states, "The design of the seal/stamp shall consist of three (3) concentric circles, the outermost circle being one (1) and one-half (1/2) inches in diameter...". Please reprint the three sheets with the proper stamp size. If you would like, you can keep the engineer's stamp date of 05/28/19. *This has been corrected.*
2. At the northwest and northeast corners of the property, there are proposed grading on the adjacent properties. Written approvals from both of the adjacent property owners are required prior to Building Permit approval. *Adjacent owners are being contacted.*
3. Please provide Floodplain Permit prior to Hydrology approval. This Permit can be obtained at the Hydrology Section's webpage. *The application has been submitted.*
4. Please provide a draft Elevation Certificate prior to Hydrology approval for Building Permit. The reason for this is because the floodplain is on the property. This will be need to get out from paying flood insurance. *The draft has been submitted.*
5. Please note a formal Elevation Certificate will need to be submitted to Hydrology prior to approval in support of Permanent Release of Occupancy. *Noted.*
6. As a reminder, if the project total area of disturbance (including the staging area and any work within the adjacent Right-of-Way) is 1 acre or more, then an Erosion and Sediment Control (ESC) Plan and Owner's certified Notice of Intent (NOI) is required to be submitted to the Stormwater Quality Engineer (Curtis Cherne, PE, ccherne@cabq.gov, 924-3420) 14 days prior to any earth disturbance. *Noted.*
7. Also as a reminder, please provide the drainage easement along the 100 year floodplain line granted to the City prior to Permanent Release of Occupancy. Please submit this on the 4th floor of Plaza de Sol. A \$25 fee will be required. The Permanent Easement form can be obtained at the Hydrology Section's webpage. This must be recorded prior to submitting the Agreement and Covenant recording. *Noted. Thank you for the reminder.* <https://www.cabq.gov/planning/development-review-services/hydrology-section>
8. Please provide the Agreement and Covenant to the City prior to Permanent Release of Occupancy. Please submit this on the 4th floor of Plaza de Sol. A \$25 fee will be required. *Noted*
9. Standard review fee of **\$300** for a DRB Site will be required at the time of resubmittal. *The fee has been paid.*

Sincerely


Don Briggs PE CFM
Don Briggs Engineering LLC

Floodplain Development Permit Application

Planning Dept., City of Albuquerque

Section 1: General Provisions (Applicant to read and sign)

1. No work of any kind may start in a Special Flood Hazard Area, SFHA, until a permit is issued.
2. Applicant is hereby informed that other permits may be required to fulfill local, state, and federal regulatory requirements.
3. Applicant hereby gives consent to the Floodplain Administrator and his/her representative to make reasonable inspections required to verify compliance.
4. Applicant must provide a Critical Habitat for Threatened & Endangered Species report prior to any work in a SFHA.
5. Applicant must provide the Base Flood Elevation, BFE, and must provide engineering calculations demonstrating that the development will not increase the BFE or result in increased flood risk on any neighboring property.
6. If this application is for a building the floodplain must be removed by first constructing any required storm drain and/or channel modifications and second acquiring a Letter of Map Revision, LOMR, from FEMA before a building permit will be issued. If storm drain and channel modifications are not involved then a draft Elevation Certificate must be submitted prior to Building Permit and a Final Elevation Certificate must be submitted prior to Certificate of Occupancy.
7. A Conditional Letter of Map Revision, CLOMR, is required prior to any work in the FLOODWAY, if applicable.
8. The applicant certifies that all statements herein and in attachments to this application are, to the best of my knowledge, true and accurate.

Applicant Signature Don Briggs Date _____

Applicant Printed Name Don Briggs Phone #: 249-4843

Owner Signature [Signature] Date 6/24/19

Owner Printed Name John Jones Phone #: 480-4537

Applicant is (check one): Owner _____ Builder _____ Engineer/Architect

Section 2: Proposed Development in Special Flood Hazard Area (to be completed by Applicant)

Project address/Legal Disc/Location: 8500 Glendale Ave NE
Lot 5, Blk 17, Tr 1, Unit 3, NAA

Section 2 (Cont.) - Description of Work in Special Flood Hazard Area (SFHA):

A. Building Development and Building Type

ACTIVITY

New Building

Addition

Alteration

Relocation

Demolition

Replacement

STRUCTURE TYPE

Residential (1-4 Family)

Residential (More than 4 Family)

Non Residential (Flood-proofing? Yes)

Combined Use (Residential & Commercial)

Manufactured Home (In Mobile Home Park? Yes)

If an addition or alteration:

Estimated Cost of Project \$ 900,000

Estimated Value of structure before addition/alteration. \$ _____

Percent of value (new construction /existing value) 100 %

B. Other Development Activities

Clearing Grading Utilities Paving

Watercourse Alteration (Bridge or Channel Modification)

Drainage Improvements (Storm drain or culverts)

Road, Street or Bridge Construction

Subdivision

Walls or Fences

Storage of Materials/Equipment for more than a year. (Materials Volume (cu. Ft.) _____)

Other (Please Specify) Construct RipRap scour wall

Is there a Grading & Drainage Plan associated with this work? Yes No

Drainage file Number: B20D067

Section 3: Floodplain Determination (Completed by the Floodplain Administrator)

___ The proposed development is located on FIRM Panel: _____

___ The proposed development is located in Zone X and NO FLOODPLAIN DEVELOPMENT PERMIT IS REQUIRED.

___ A portion of the proposed development is located in a SFHA but not any buildings so an approved G&D Plan is required (Engineer's Stamp Date _____) prior to issuance of a Floodplain Development Permit and no Building Permit will be issued for this construction.

___ A portion of the proposed Building is located in a SFHA but the project does not include any storm drain improvements and/or channel modifications so:

1. Approved G&D Plan is required (Engineer's Stamp Date _____) prior to issuance of a Floodplain Development Permit,
2. Draft Elevation Certificate (Date _____) is required prior to issuance of a Building Permit, and
3. Final Elevation Certificate and Engineer's Certification is required prior to Certificate of Occupancy.

___ A portion of the proposed Building is located in a SFHA and the project includes storm drain improvements and/or channel modifications that will change the floodplain location so

1. An Approved Grading and Drainage Plan is required (Engineer's Stamp Date _____) prior to issuing a Flood Plain Development Permit and a Grading Permit and/or a Work Order.
2. The improvements must be constructed and an Approved Engineer's Certification (Engineer's Stamp Date _____) and an Approved LOMR Request (Engineer's Stamp Date _____) must be approved by Hydrology prior to approval of the LOMR application to FEMA.
3. The Floodplain must be removed by a LOMR from FEMA (Date _____) prior to issuance of a Building Permit.

___ A portion of the proposed development is located in a FLOODWAY so:

1. Approved G&D Plan (Engineer's Stamp Date _____) and an Approved CLOMR Request (Date _____) is required prior to approval of the application to FEMA, and
2. CLOMR from FEMA (Date _____) is required prior to issuance of a Floodplain Development Permit, a Grading Permit, and/or a Work Order.
3. The improvements must be constructed and an Approved Engineer's Certification (Engineer's Stamp Date _____) and an Approved LOMR Request (Engineer's Stamp Date _____) must be approved by Hydrology prior to approval of the LOMR application to FEMA (Date _____).
4. The Floodplain must be removed by a LOMR from FEMA (Date _____) prior to issuance of a Building Permit.

Drainage File Number: _____

Floodplain Permit Number: _____

Signed: _____

Date: 6/24/18

Printed Name: John Jones



City of Albuquerque

Planning Department

Floodplain Development Permit

Project Title 8500 Glendale

Project Location (Major Cross Streets/Arroyo or address)
8500 Glendale Ave NE

Property Owner: (Note: If applying for a Building Permit, the "Company" or "Owner" name on this form must match the "Owner" name on the Building Permit.)

Company Name or Owner Name: John Jones

Responsible Person: (Note: Name below may be the same as Owner Name above if there is no Company Name)

Name: John Jones

Phone Number: 480-4537

E-mail: rtmf91@gmail.com

Site Contact: (if different than Property Owner info above.)

Name: _____

Phone: _____

e-mail: _____

For City personnel use only:

City Personnel Signature: _____ Date _____





Description of Work _____

Check all that apply:

Final Elevation Certificate required prior to Certificate of Occupancy

No Building Permits will be allowed until FEMA issues a LOMR removing the SFHA.

A LOMR must be obtained from FEMA prior to release of Financial Guarantees.

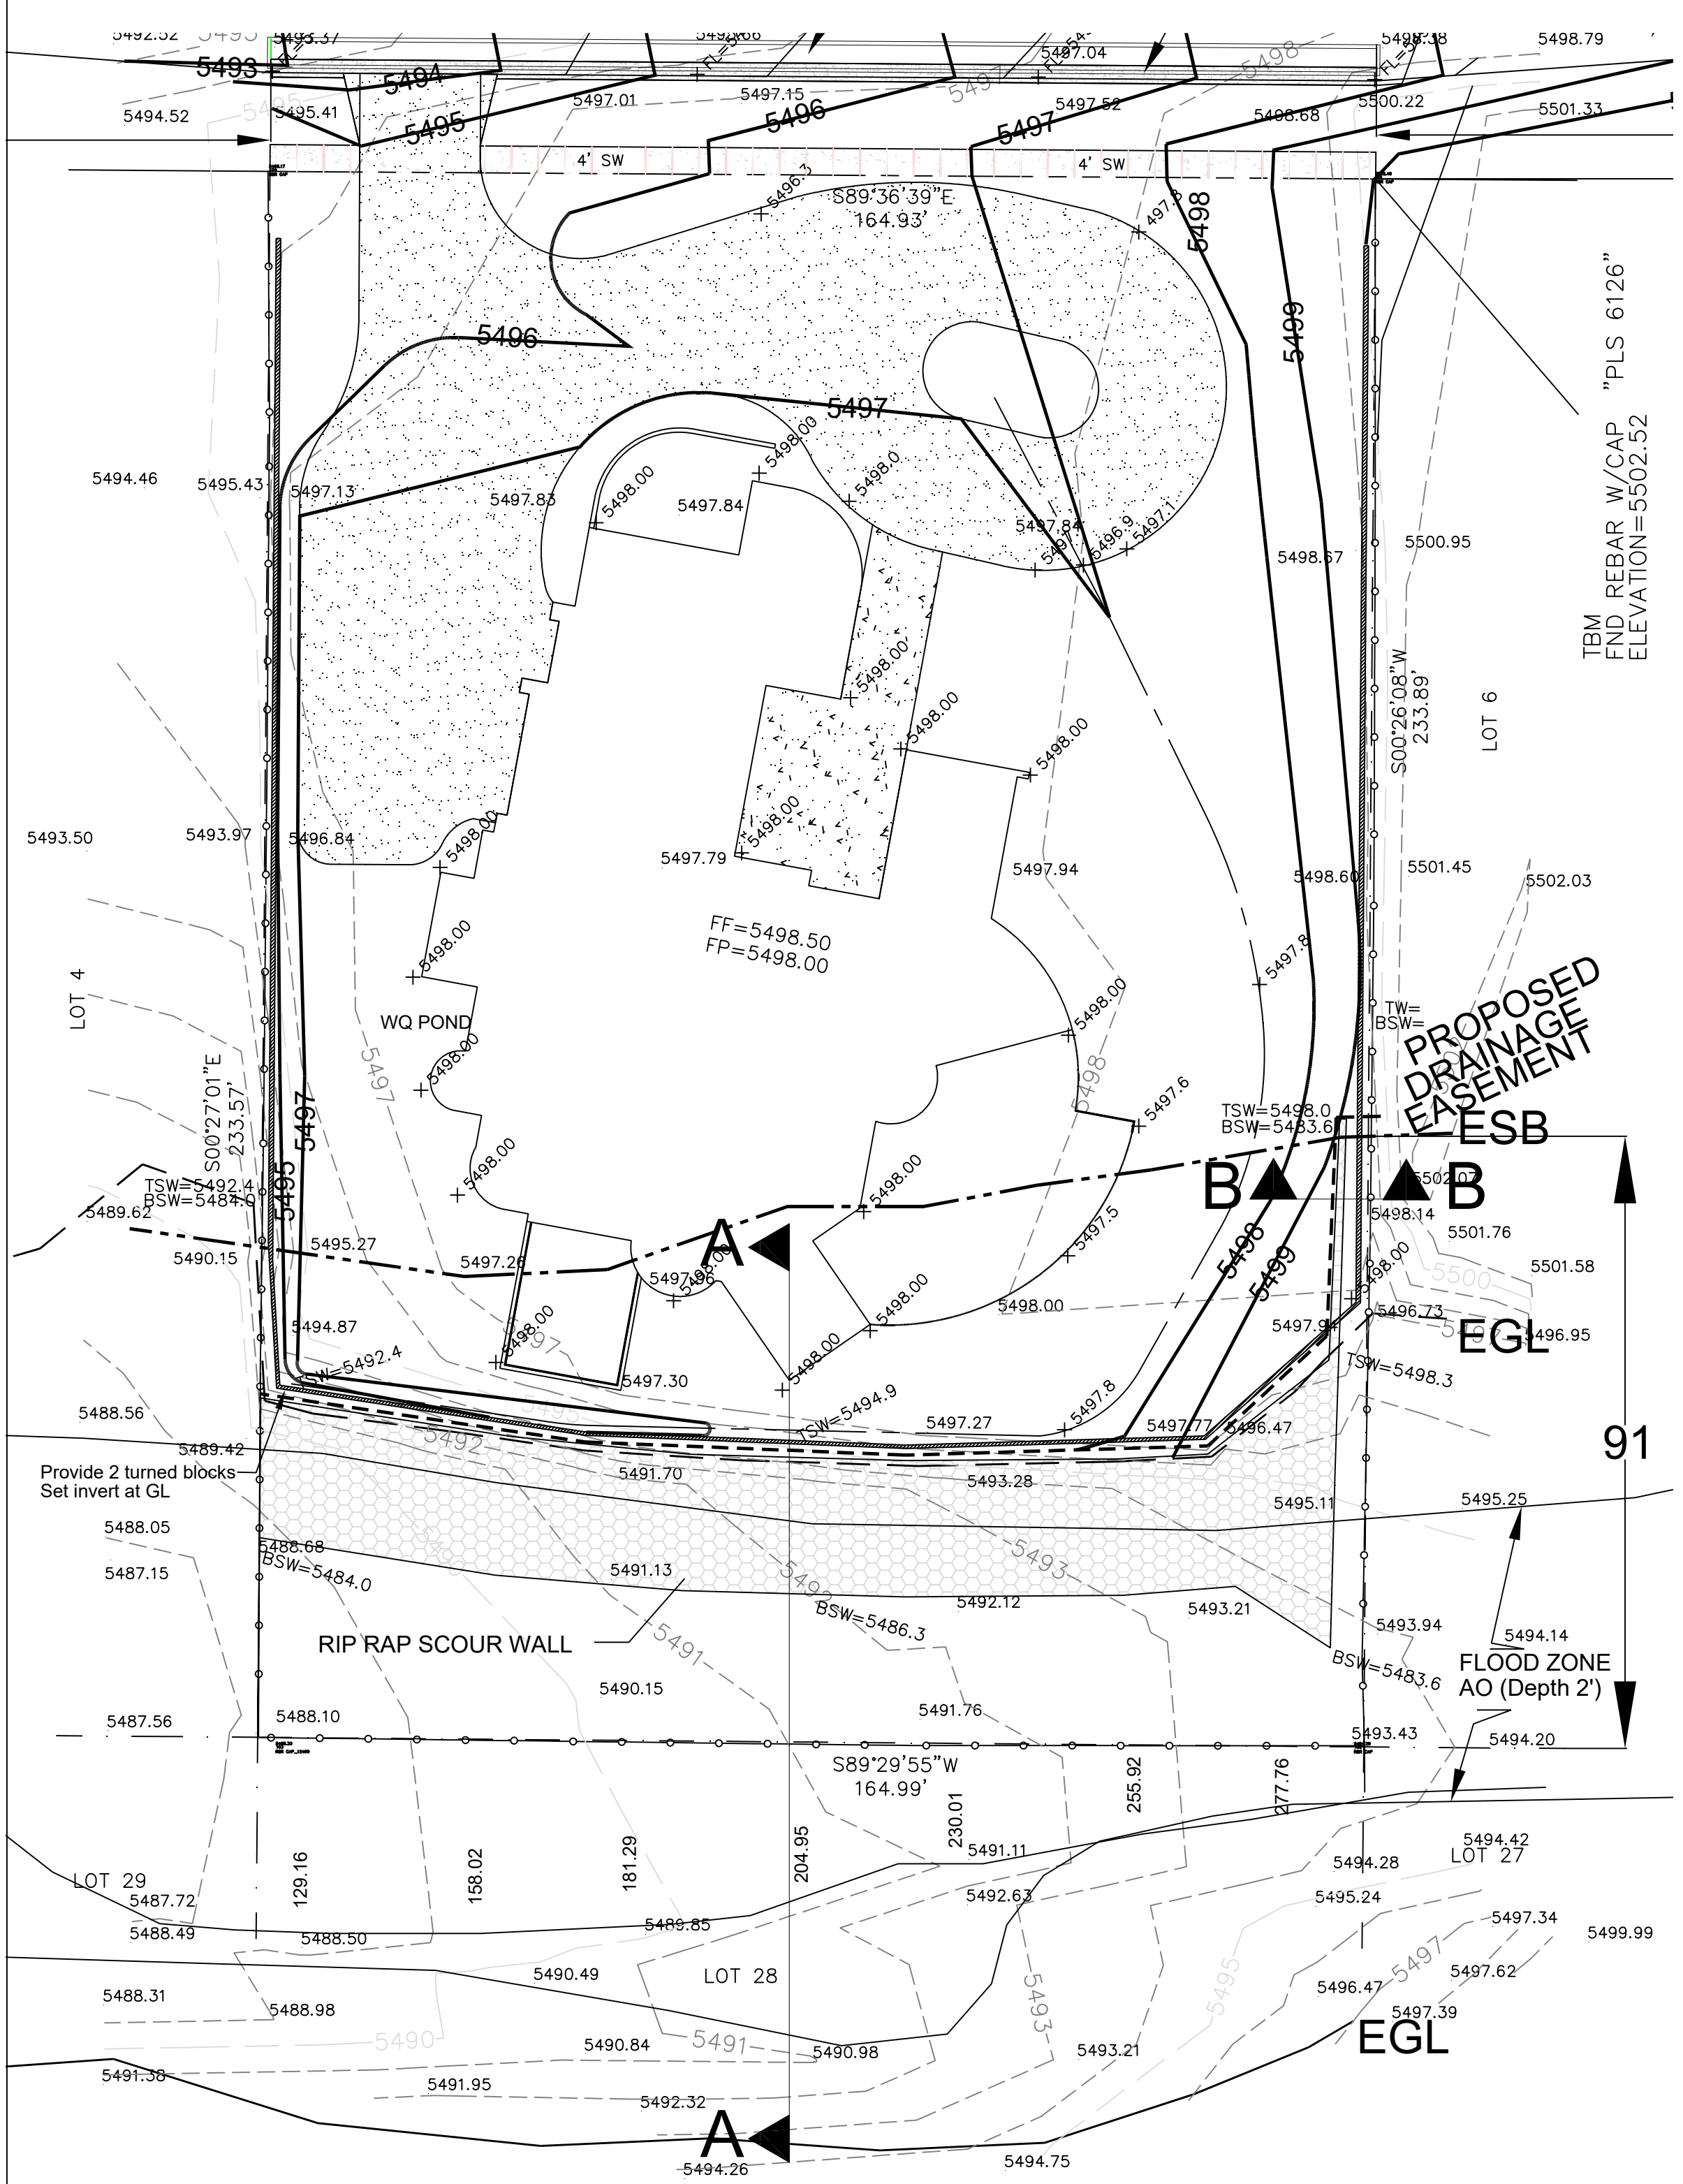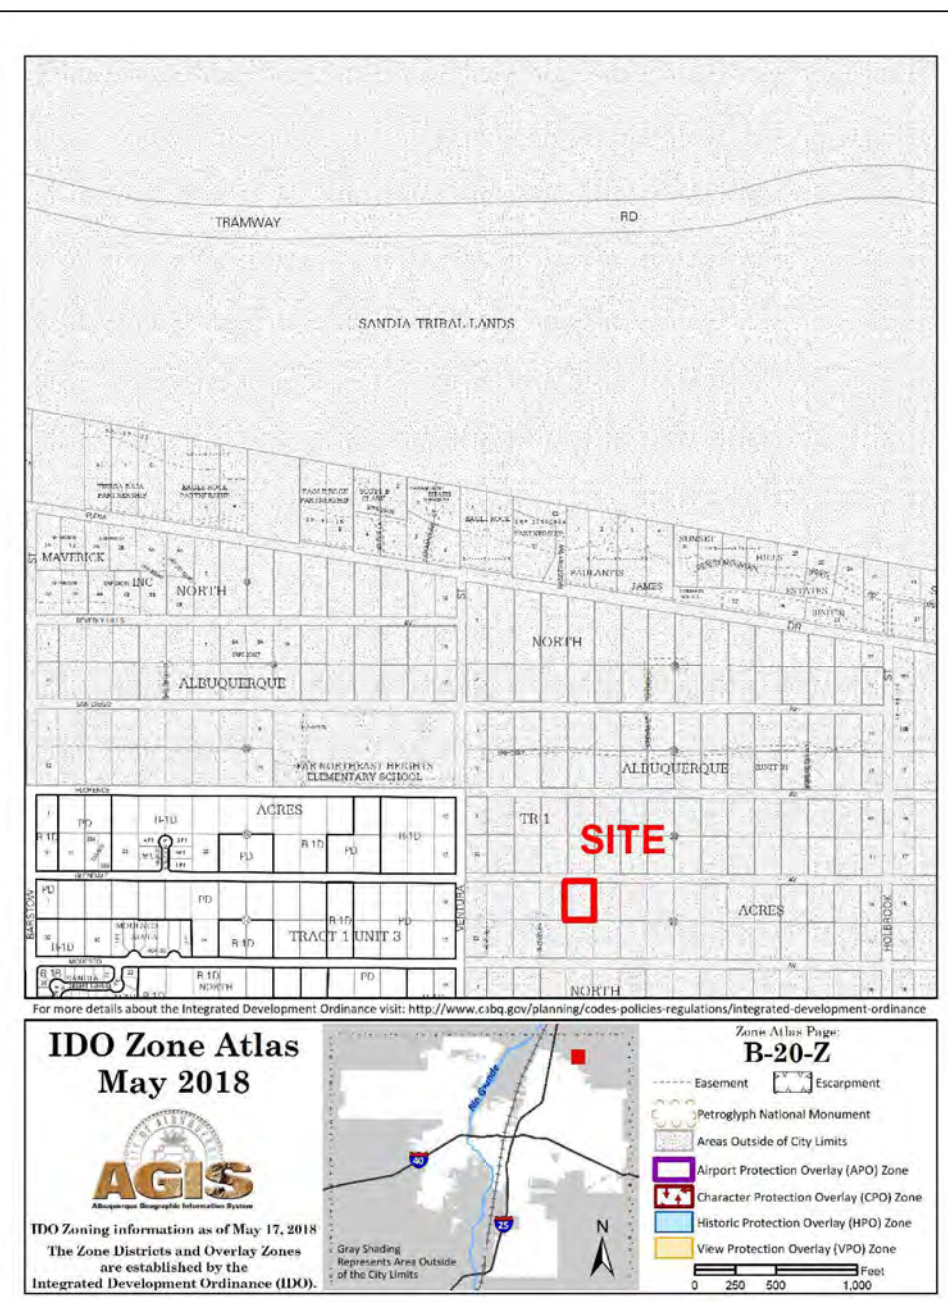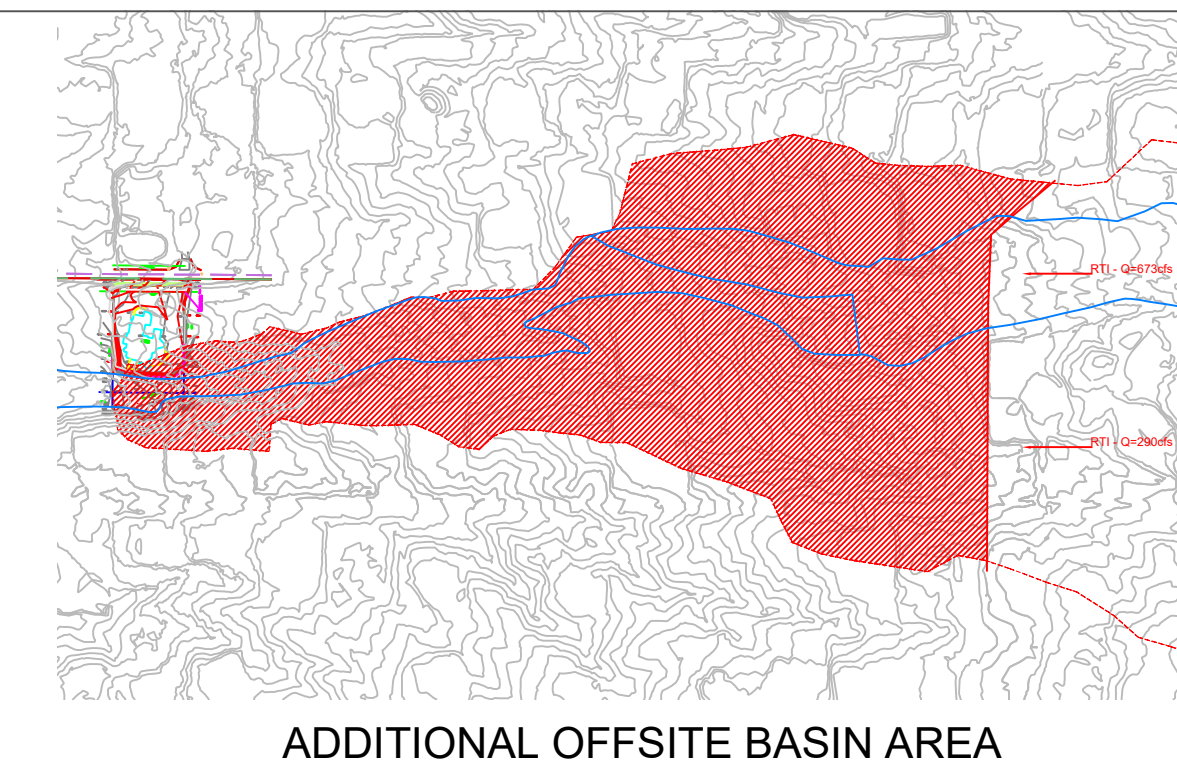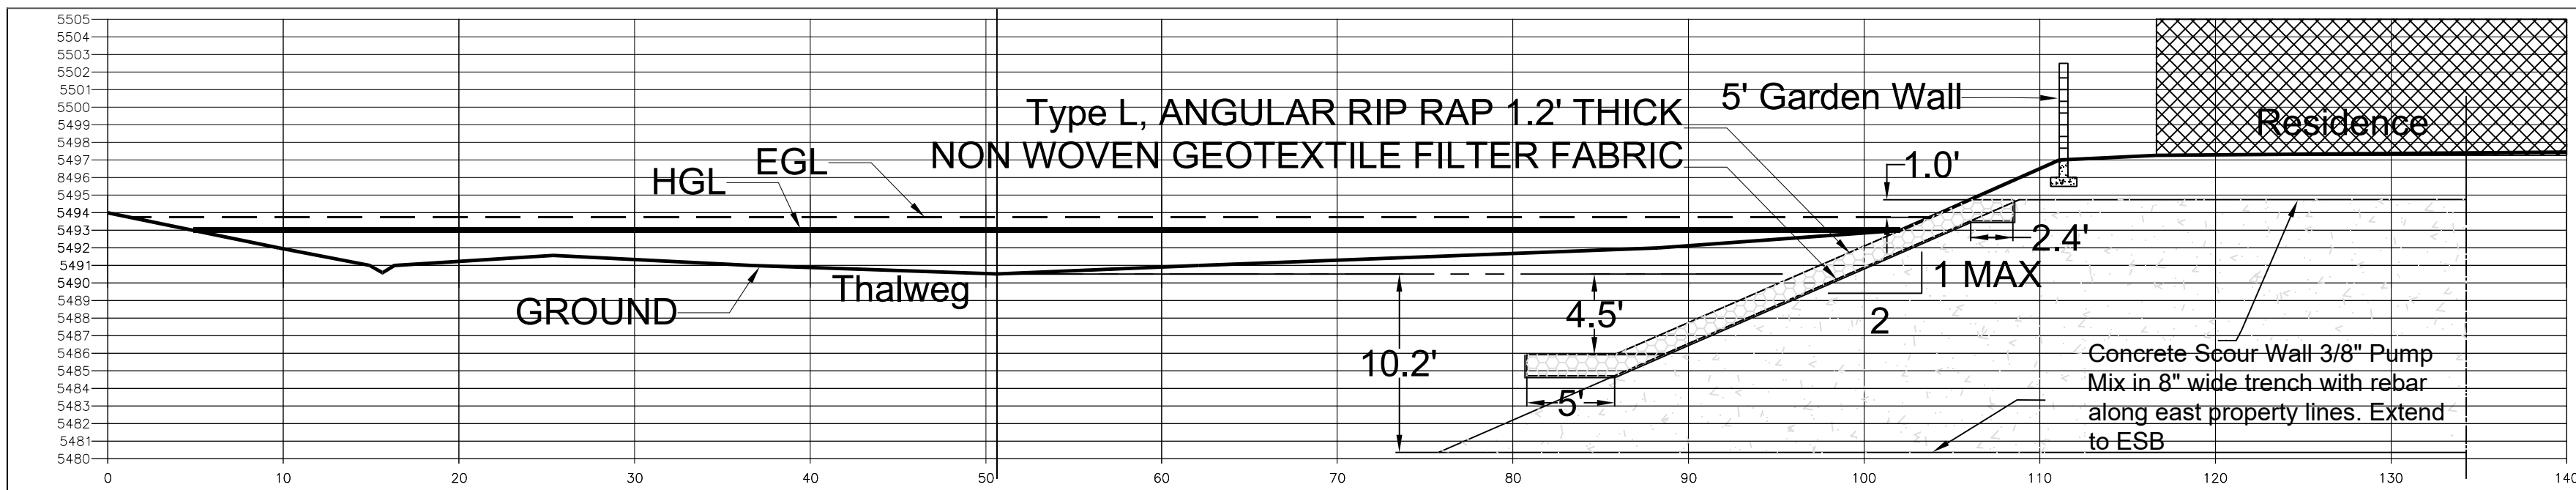

Hydrology Calculations
8500 Glendale NE

Land Treatment	Percent	Area (ac)	Excess Precipitation (in)	Unit Peak Discharge (cfs/ac)	Runoff Volume (ac-ft)	Peak Discharge (cfs)	Comments
A	20.00%	0.18	0.66	1.87	0.01	0.33	Natural Ground
B	20.00%	0.18	0.92	2.60	0.01	0.46	Landscaped Areas
C	34.00%	0.30	1.29	3.45	0.03	1.04	Compacted earth
D	26.00%	0.23	2.36	5.02	0.05	1.16	Impervious Areas
TOTAL	100.00%	0.89	1.37	3.00	0.10	3.00	

4420.24 cu ft

Hydrology Calculations
Additional Offsite Watershed Assuming Full Development

Land Treatment	Percent	Area (ac)	Excess Precipitation (in)	Unit Peak Discharge (cfs/ac)	Runoff Volume (ac-ft)	Peak Discharge (cfs)	Comments
A	20.00%	4.92	0.66	1.87	0.27	9.21	Natural Ground
B	20.00%	4.92	0.92	2.60	0.38	12.80	Landscaped Areas
C	34.00%	8.37	1.29	3.45	0.90	28.87	Compacted earth
D	26.00%	6.40	2.36	5.02	1.26	32.12	Impervious Areas
TOTAL	100.00%	24.61	1.37	3.00	2.81	83.00	

1072117.1 sq ft

Proposed

Land Treatment	Percent	Area (ac)	Excess Precipitation (in)	Unit Peak Discharge (cfs/ac)	Runoff Volume (ac-ft)	Peak Discharge (cfs)	Comments
A	18.00%	0.09	0.66	1.87	0.00	0.17	Natural Ground
B	36.00%	0.32	0.92	2.60	0.02	0.83	Landscaped Areas
C	30.00%	0.27	1.29	3.45	0.03	0.92	Compacted earth
D	24.00%	0.21	2.36	5.02	0.04	1.07	Impervious Areas
TOTAL	100.00%	0.89	1.35	3.00	0.10	2.99	

4363.38 cu ft



Water Quality Retention Volume = 0.42' x 9304.416 sq ft = 325.65 cu ft.

DIFFERENCE

% Change	Runoff Volume (ac-ft)	Peak Discharge (cfs)
-1%	0.00	-0.04
0%	0.00	0.00
1%	0.00	0.04

Pond only Water Quality Volume

- LEGEND
- Existing Contour
 - Basin Boundary
 - New Channel Centerline
 - Ponding Areas
 - Design Contour
 - New 5' CMU Garden Wall no more than 24" retainage
 - Existing Ground Spot Elevation
 - Design Spot Elevation

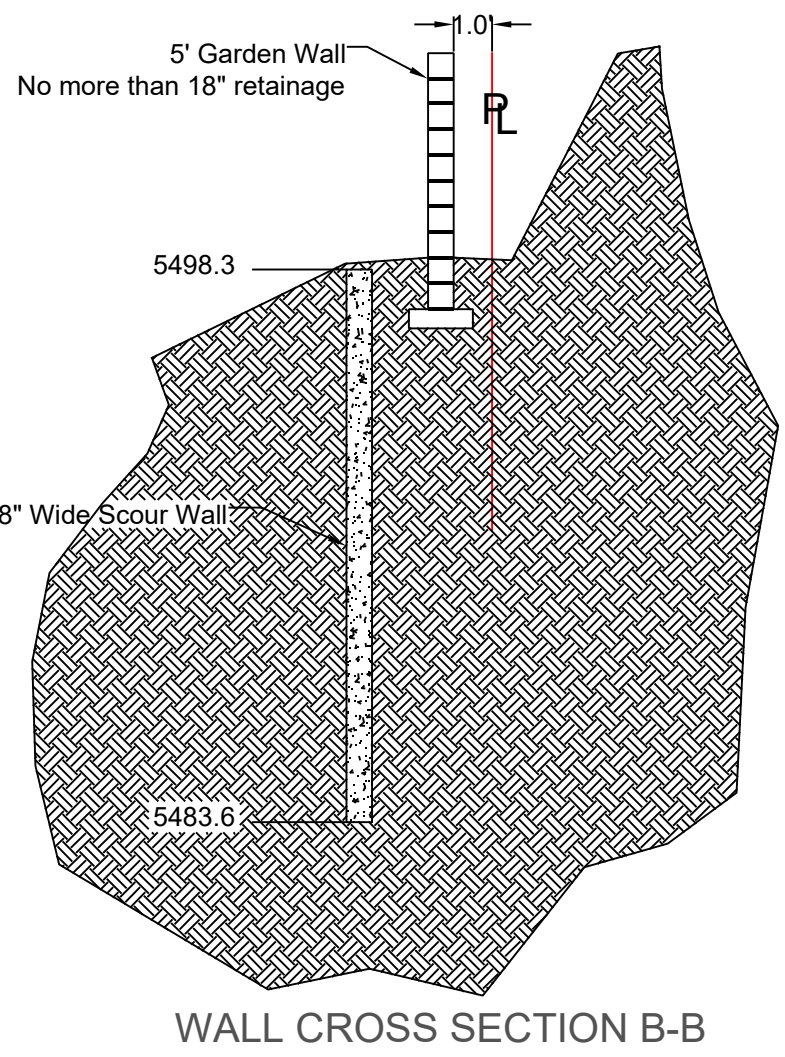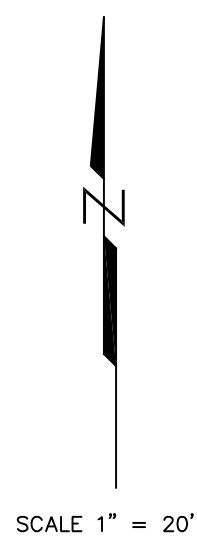

DRAINAGE NARRATIVE

This grading & drainage plan was prepared to support a building permit application for a new residence located at 8500 Glendale NE (Lot 5, Block 17, Tract 1, Unit 3, NAA) in North Albuquerque Acres. The plan was prepared using allowable discharge rates based on land treatment percentages of A=20%, B=20%, C=34%, and D=26% and the hydrology methodology presented in Chapter 22.2 of the City of Albuquerque's Development Process Manual (abbreviated method).

The site is a 0.89 acre parcel located in Precipitation Zone 3. The site is impacted by the Camino Arroyo with an estimated flow rate of 1046cfs (RTI Flows @ Ventura + additional developed basin flow) at the property. The property is partially located in FEMA Flood Zone AO (Depth 2') as shown on panel 35001C0133H. Sewer and water service is available from ABCWUA.

Stormwater impacts and mitigation requirements are determined by comparing runoff from the proposed developed conditions to the NAA allowable conditions (see Site Hydrology on this plan). Mitigation measures are designed to reduce developed runoff to at or below the NAA allowable.

This analysis indicates that the site developed runoff will not exceed the allowable runoff in a 100yr, 6hr. rainfall event so ponding is not required.

The offsite Camino Arroyo flow is passed through the property in its natural channel location. A hydraulic analysis of the Camino Arroyo was performed using the US Army's HEC RAS software to determine the Hydraulic Grade Line, Energy Grade Line and flow velocity. The results of the analysis indicated the developed lot will have a minimum 2' freeboard above the water surface and a 1' freeboard above the Energy Grade Line at the South East corner. A Drainage Easement that encompasses the Energy Grade Line is proposed. The HEC RAS analysis is presented on Sheet 2 of 2.

GENERAL NOTES

Due to the proximity of the home to the Camino Arroyo a scour analysis is required. Scour calculations were performed using the equations presented in AMAFCA's Sediment and Erosion Design Guide. The Erosion Setback is calculated at 98' and the parallel scour depth at 4.5' (3.5' + 1' Safety Factor) and 10.2' (9.2' + 1') for the perpendicular scour depth. As the home will be located within the Erosion Setback a scour wall is required for this development. The scour wall design is presented on this plan.

Construction of public infrastructure is required with this development. This infrastructure is shown on Sheet 3 of 3 and will be completed through the Development Review Board process.

Contractor is responsible for utility spots and controlling sediment deposition and erosion during construction.

A concrete washout bin must be provided as per Bernalillo County MS4 Permit requirements.

All disturbed area due to construction must be reseeded or landscaped following construction.

SCOUR CALCULATIONS (SEDS)
CROSS SECTION 204.95

Q100 =	1033 cfs
SLOPE	0.01587 ft/ft
THALWEG ELEVATION	5490.8 ft
HGL DEPTH = D100	2.28 ft
HGL ELEVATION	5493.08 ft
EGL ELEVATION	5493.84 ft
AREA	147.73 sq ft
VELOCITY =	6.99 fps
VELOCITY HEAD =	0.76 ft
FRICTION	1.01

LATERAL EROSION (Erosion Setback)
Qd = 0.21(Q100) = 206.6 cfs (Dominant Discharge)
ESB = (0.92 + 4.6' log(Qd/Qd*))^0.4 = 98 ft (EQ 3.816)

VERTICAL EROSION (Scour Depth)
PARALLEL
Vs = 114(73 + (14' * 3.14159 * Fr^2) / D100) = 3.45 ft (EQ 3.89)
SAFETY FACTOR = 1.00 ft
REQUIRED SCOUR DEPTH = 4.45 ft

PERPENDICULAR
Vs = ((73 + (14' * 3.14159 * Fr^2) / COS(θ)) + (4' * Fr^0.33) / SIN(θ)) / D100 = 9.15 ft (EQ 3.90)

REQUIRED SCOUR DEPTH ELEVATION = 5496.35
TOP OF SCOUR WALL = EGL + 1' = 5494.84

SCOUR WALL ROCK SIZING (Denver Urban Drainage Design Manual)
MINIMUM d50 = 1.59 ft (V50 = 1776.88 > 1.55 Max.)
N for Riprap = 0.036
Riprap Layer Thickness = 1.2 ft (2(d50))

SCOUR WALL CALCULATIONS

X Section	Thalweg	Bot SW	EGL	Top SW
129.16	5488.5	5484.0	5491.42	5492.42
158.02	5489.3	5484.8	5492.29	5493.29
181.29	5489.9	5485.4	5493.15	5494.15
204.95	5490.8	5486.3	5493.86	5494.86
230.01	5491.4	5486.9	5494.76	5495.76
255.92	5492.8	5488.3	5495.01	5497.01
277.76	5493.5	5489.0	5495.97	5497.97

AS-BUILT INFORMATION		BENCHMARKS		SURVEY INFORMATION		ENGINEER'S SEAL	
CONTRACTOR	DATE	NO.	BY	NO.	BY	NO.	BY
WORK STAKED BY	DATE	NO.	BY	NO.	BY	NO.	BY
ACCEPTANCE BY	DATE	NO.	BY	NO.	BY	NO.	BY
FIELD VERIFICATION BY	DATE	NO.	BY	NO.	BY	NO.	BY
REVISION BY	DATE	NO.	BY	NO.	BY	NO.	BY
CORRECTED BY	DATE	NO.	BY	NO.	BY	NO.	BY
RECORDED BY	DATE	NO.	BY	NO.	BY	NO.	BY
NO.	DATE	NO.	DATE	NO.	DATE	NO.	DATE

REVISIONS DESIGN

DESIGNED BY DB DATE 4/25/2019
DRAWN BY DB DATE 4/25/2019
CHECKED BY DATE

REVISIONS DESIGN




DESIGNED BY DB DATE 4/25/2019
DRAWN BY DB DATE 4/25/2019
CHECKED BY DATE

DON BRIGGS Engineering LLC
505-249-4843
donbriggsengineering@gmail.com
5324 Oakledge Ct. NW, Albuquerque, NM 87120

TITLE: **8500 Glendale Grading & Drainage Plan**

Design Review Committee	City Engineer Approval	Mo. / Day / Yr.	Mo. / Day / Yr.

City Project No. **B20D067** Zone Map No. Sheet **1** Of **3**

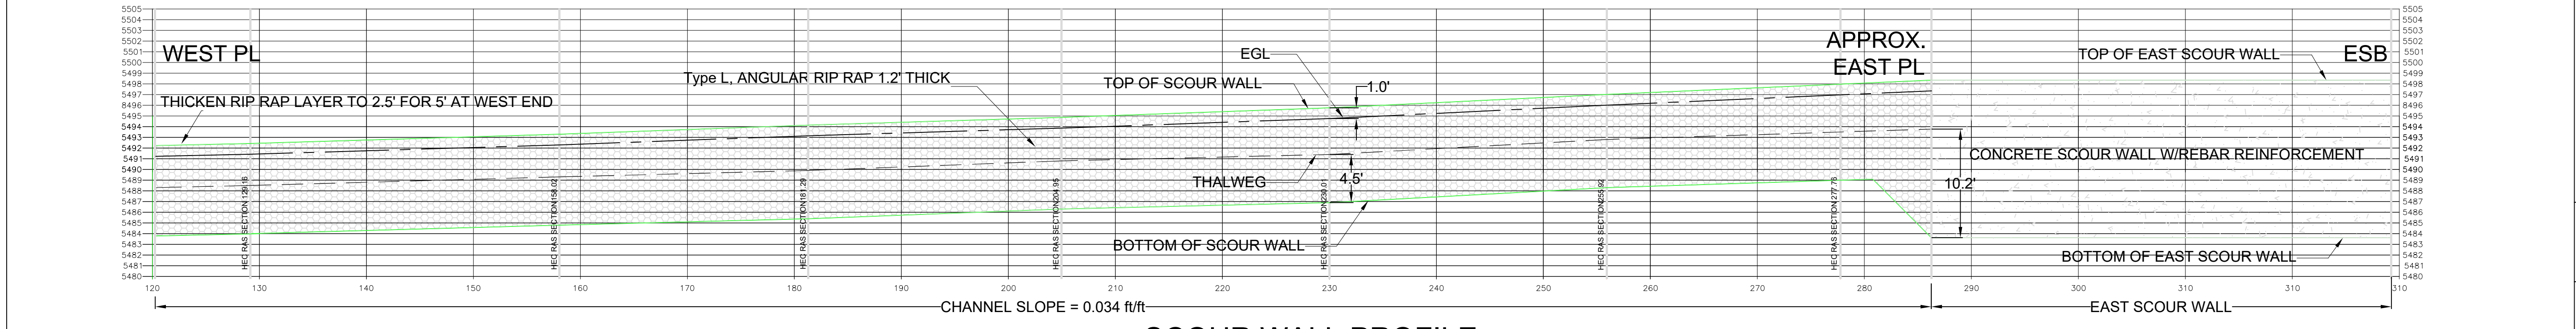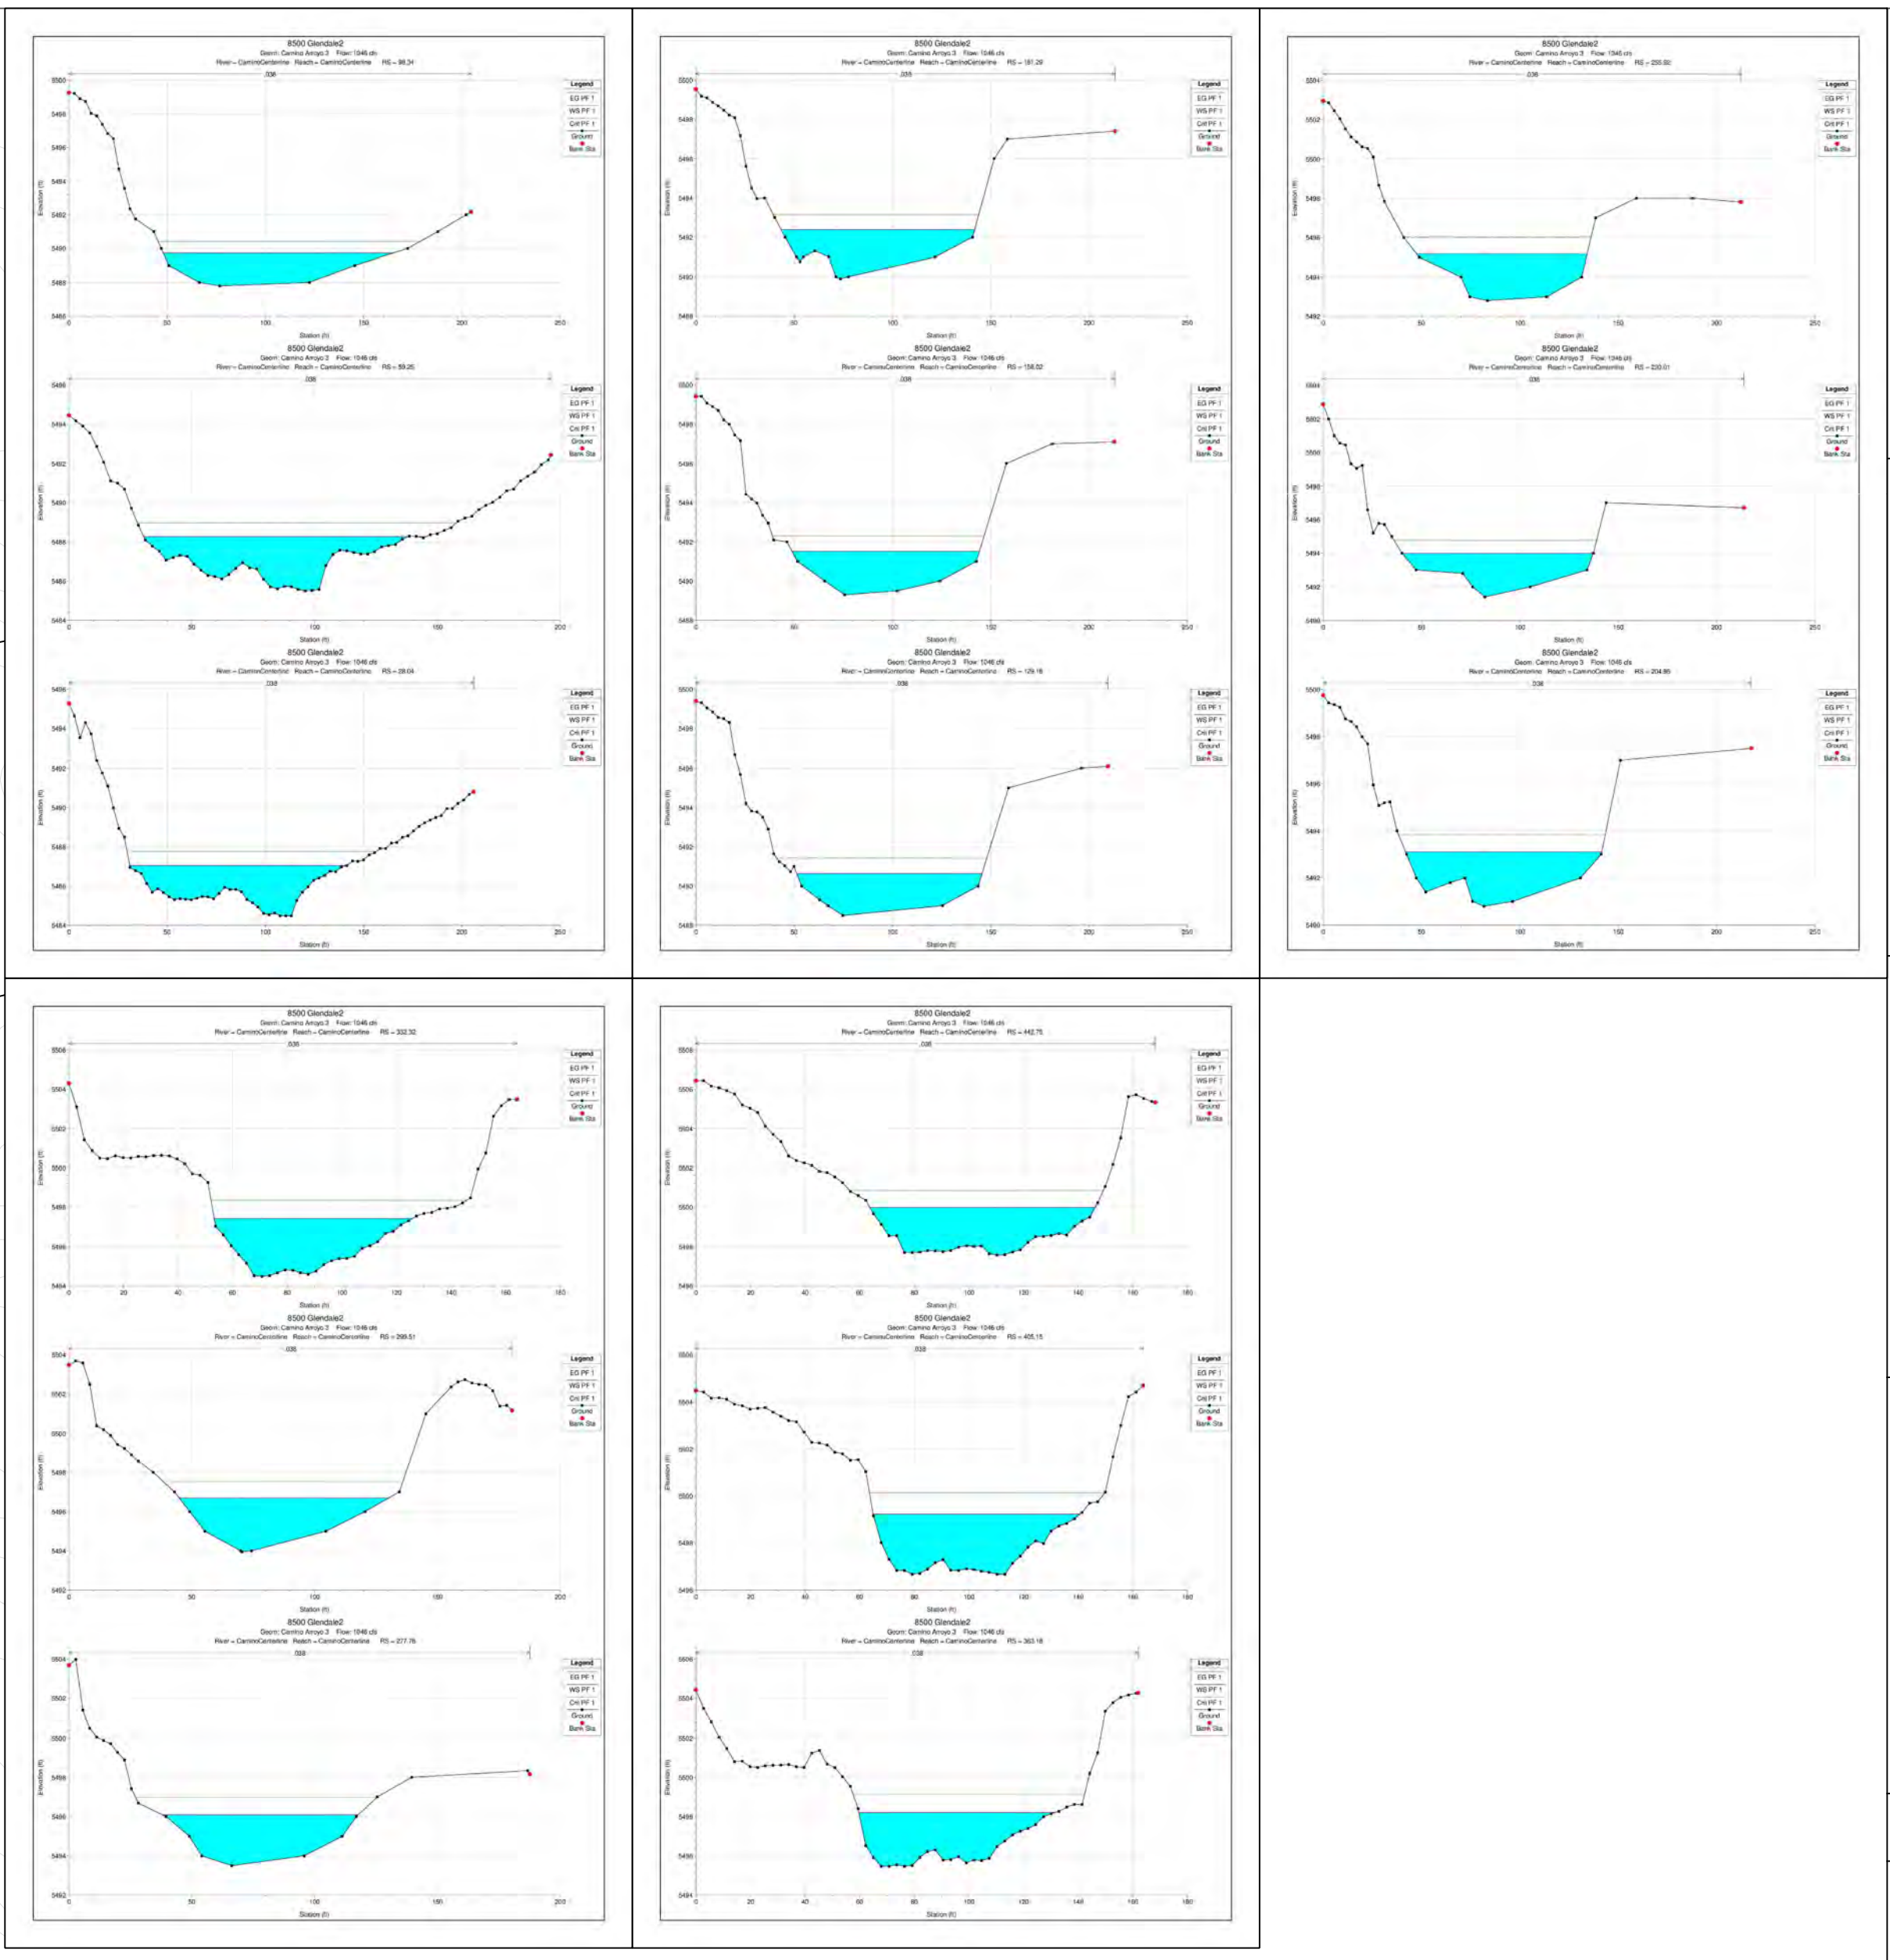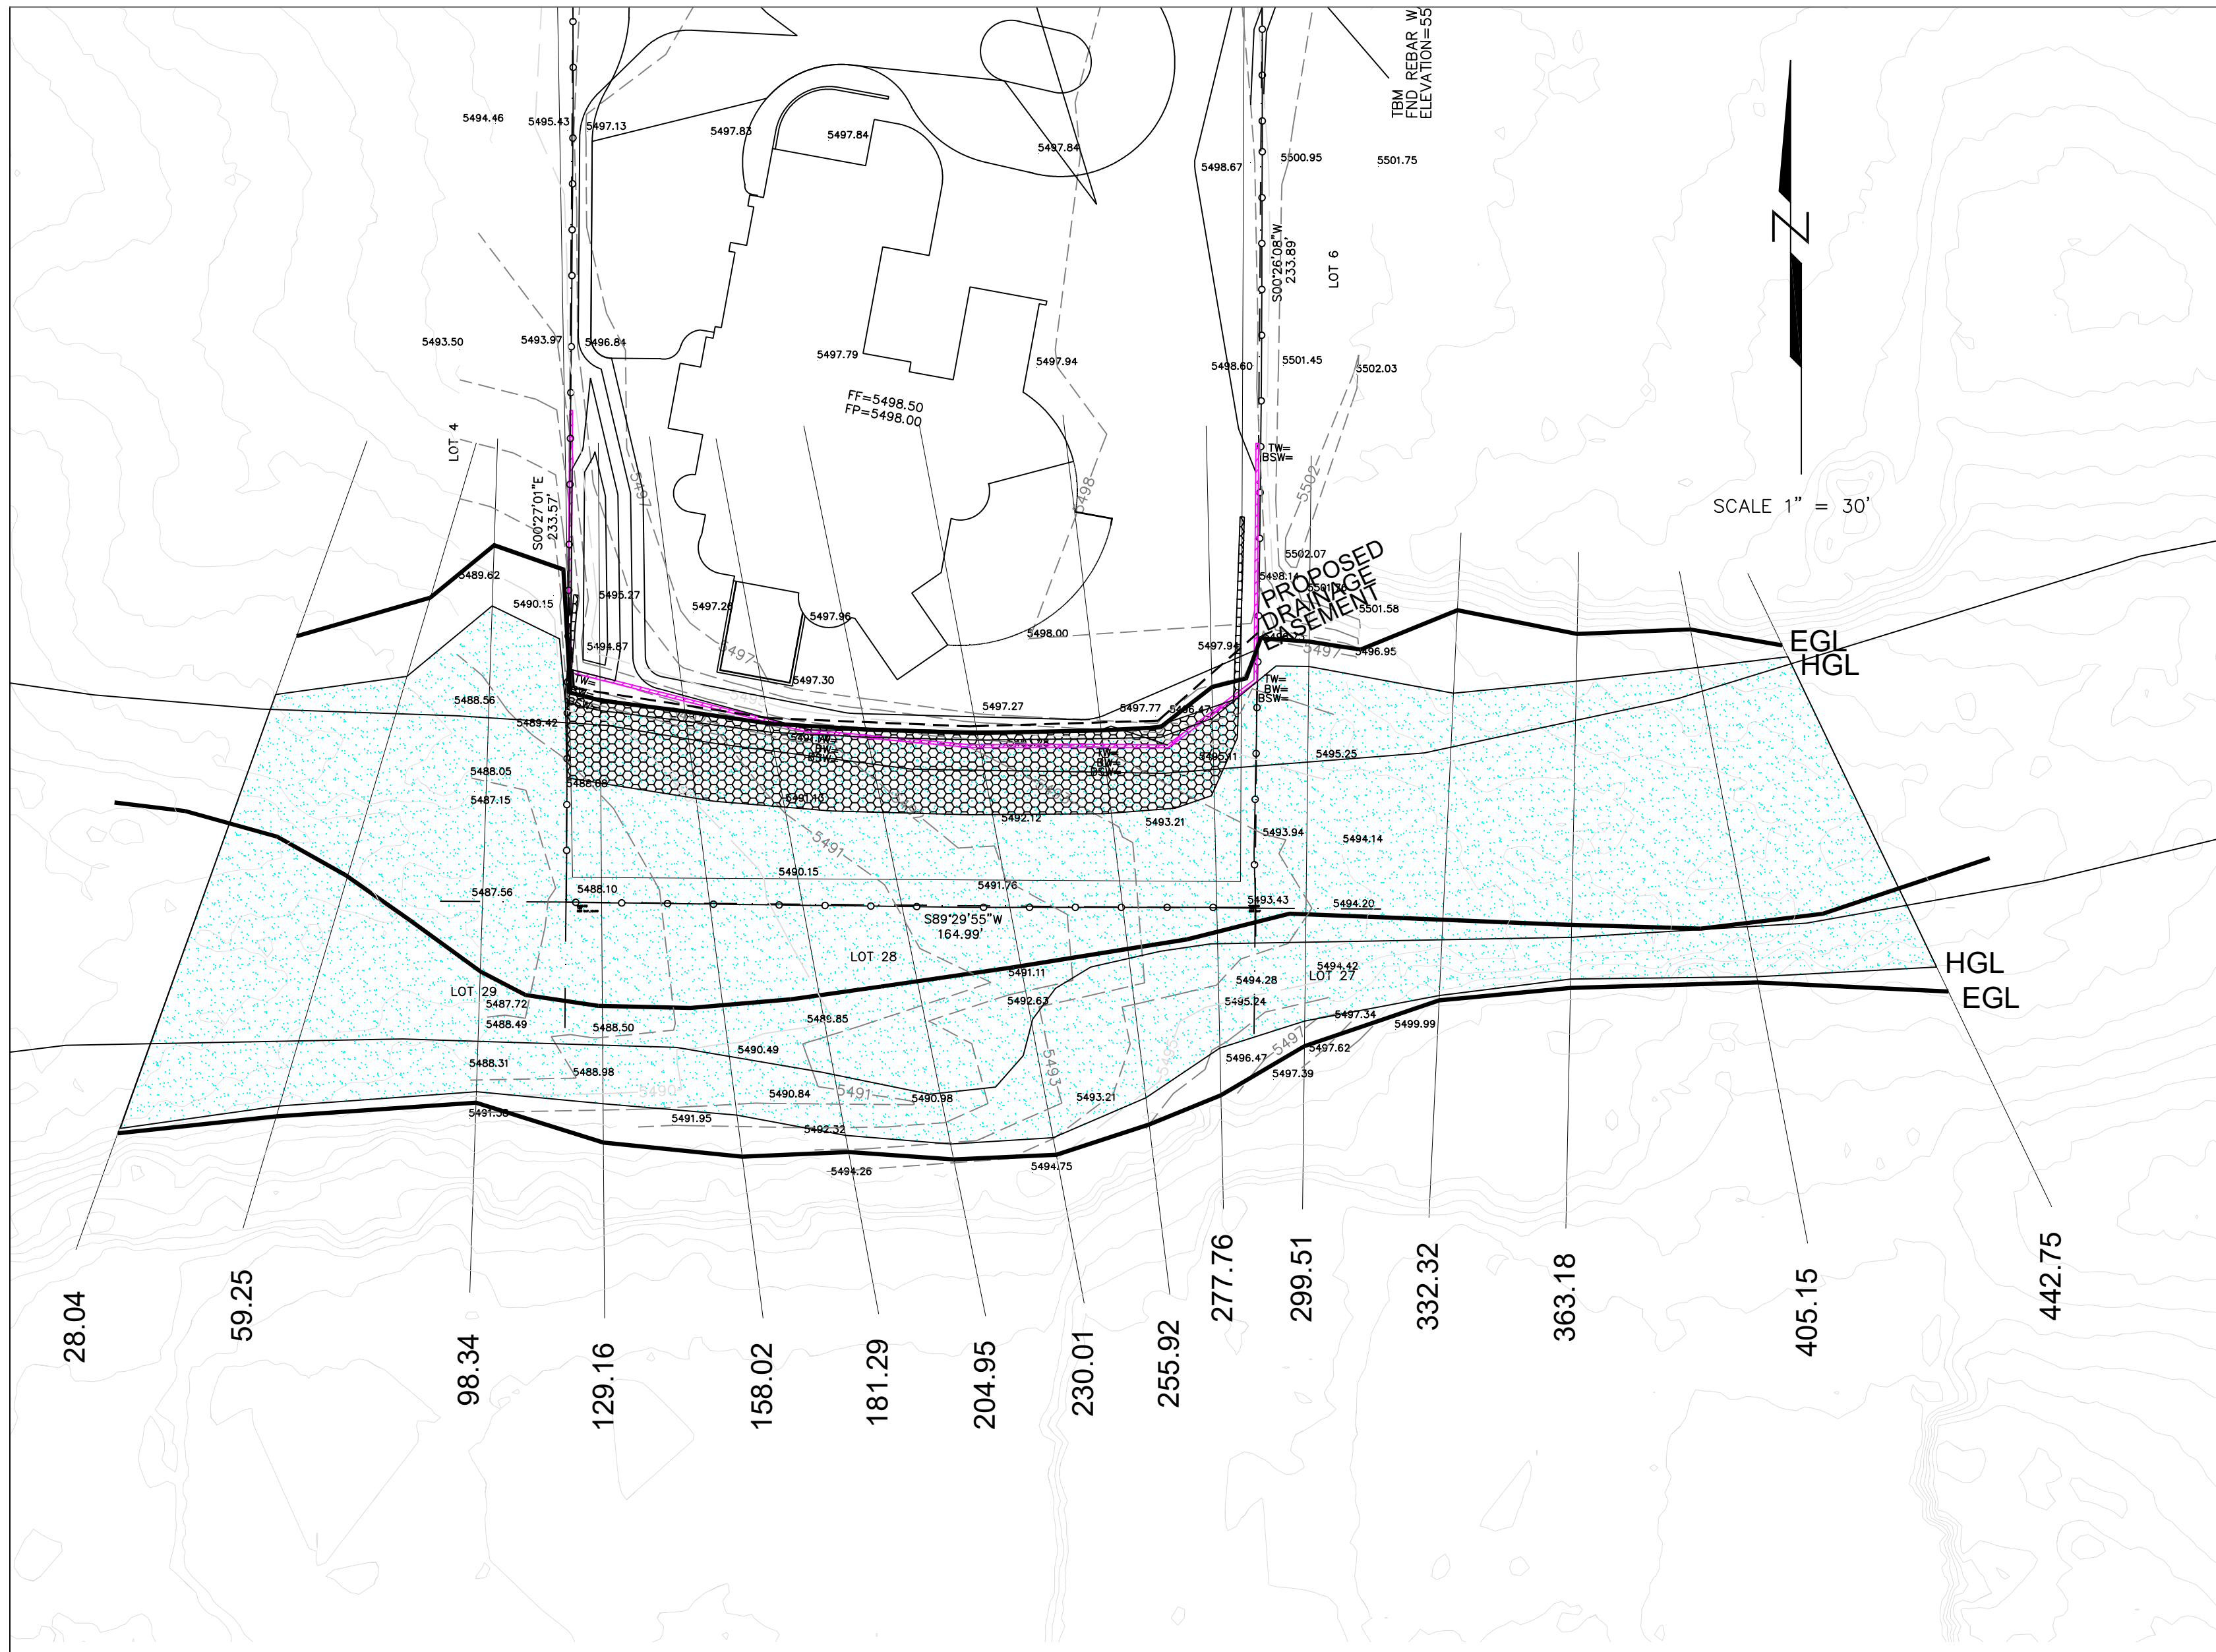

SCOUR WALL PROFILE

SCOUR WALL CALCULATIONS

Scour Depth 4.5

X Section	Thalweg	Btm SW	EGL	Top SW
129.16	5489.5	5494.0	5491.42	5492.42
158.02	5489.3	5484.8	5492.29	5493.29
181.29	5489.9	5485.4	5493.15	5494.15
204.95	5490.8	5486.3	5493.86	5494.86
230.01	5491.4	5486.9	5494.76	5495.76
255.92	5492.8	5488.3	5496.01	5497.01
277.76	5493.5	5489.0	5496.97	5497.97

Reach	River Sta	Profile	Q Total (cfs)	Mn Ch El (ft)	W.S. Elev (ft)	Crit W.S. (ft)	E.G. Elev (ft)	E.G. Slope	Vel Chnl (ft/s)	Flow Area (sq ft)	Top Width (ft)	Froude # Cnl
CaminoCenterline	28.04	PF 1	1046.00	5484.48	5487.05	5487.05	5487.76	0.019325	6.77	154.45	110.63	1.01
CaminoCenterline	59.25	PF 1	1046.00	5485.50	5488.26	5488.26	5488.97	0.019015	6.73	155.51	110.97	1.00
CaminoCenterline	98.34	PF 1	1046.00	5487.80	5489.73	5489.73	5490.41	0.019307	6.63	157.77	116.88	1.01
CaminoCenterline	129.16	PF 1	1046.00	5488.50	5490.63	5490.63	5491.42	0.018475	7.13	146.75	94.23	1.01
CaminoCenterline	158.02	PF 1	1046.00	5489.30	5491.51	5491.51	5492.29	0.018540	7.11	147.17	95.20	1.01
CaminoCenterline	181.29	PF 1	1046.00	5489.90	5492.38	5492.38	5493.15	0.018666	7.02	148.92	98.37	1.01
CaminoCenterline	204.95	PF 1	1046.00	5490.80	5493.10	5493.10	5493.86	0.018494	6.97	150.07	99.63	1.00
CaminoCenterline	230.01	PF 1	1046.00	5491.40	5493.99	5493.99	5494.76	0.018542	7.05	148.36	97.04	1.01
CaminoCenterline	255.92	PF 1	1046.00	5492.80	5495.18	5495.18	5496.01	0.018241	7.33	142.05	88.78	1.01
CaminoCenterline	277.76	PF 1	1046.00	5493.50	5496.08	5496.08	5496.97	0.017846	7.55	138.51	79.40	1.01
CaminoCenterline	299.51	PF 1	1046.00	5493.95	5496.70	5496.70	5497.54	0.018171	7.38	141.75	85.34	1.01
CaminoCenterline	332.32	PF 1	1046.00	5494.49	5497.41	5497.41	5498.35	0.017646	7.79	134.25	72.56	1.01
CaminoCenterline	363.18	PF 1	1046.00	5495.47	5498.21	5498.21	5499.15	0.017522	7.79	134.23	71.79	1.00
CaminoCenterline	405.15	PF 1	1046.00	5496.67	5499.22	5499.22	5500.14	0.017780	7.68	136.24	75.64	1.01
CaminoCenterline	442.75	PF 1	1046.00	5497.57	5499.97	5499.97	5500.84	0.018055	7.46	140.25	82.47	1.01

AS BUILT INFORMATION

CONTRACTOR: _____

WORK STARTED BY: _____ DATE: _____

ACCEPTANCE BY: _____ DATE: _____

FIELD VERIFICATION BY: _____ DATE: _____

CORRECTED BY: _____ DATE: _____

RECORDING INFORMATION

RECORDED BY: _____ DATE: _____

NO.:

BY:

DATE:

REVISIONS

DESIGNED BY: DB DATE 4/25/2019

DRAWN BY: DB DATE 4/25/2019

CHECKED BY: _____ DATE: _____

ENGINEER'S SEAL

14912

5/28/19

PROFESSIONAL ENGINEER

REMARKS

1 5/28/2019 Address Comments



DON BRIGGS Engineering LLC

505-249-4843
donbriggseengineering@gmail.com
5324 Oakledge Ct. NW, Albuquerque, NM 87120

TITLE: **8500 Glendale HEC RAS Analysis**

Design Review Committee City Engineer Approval


City Project No. **B20D067** Zone Map No. _____ Sheet **2** Of **3**

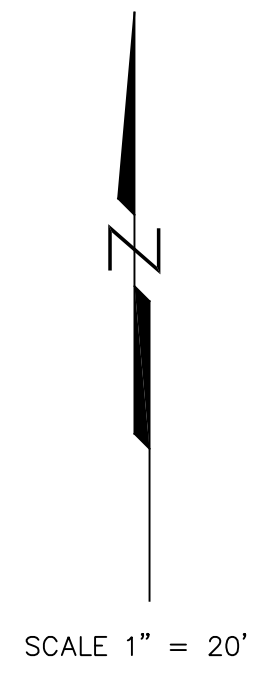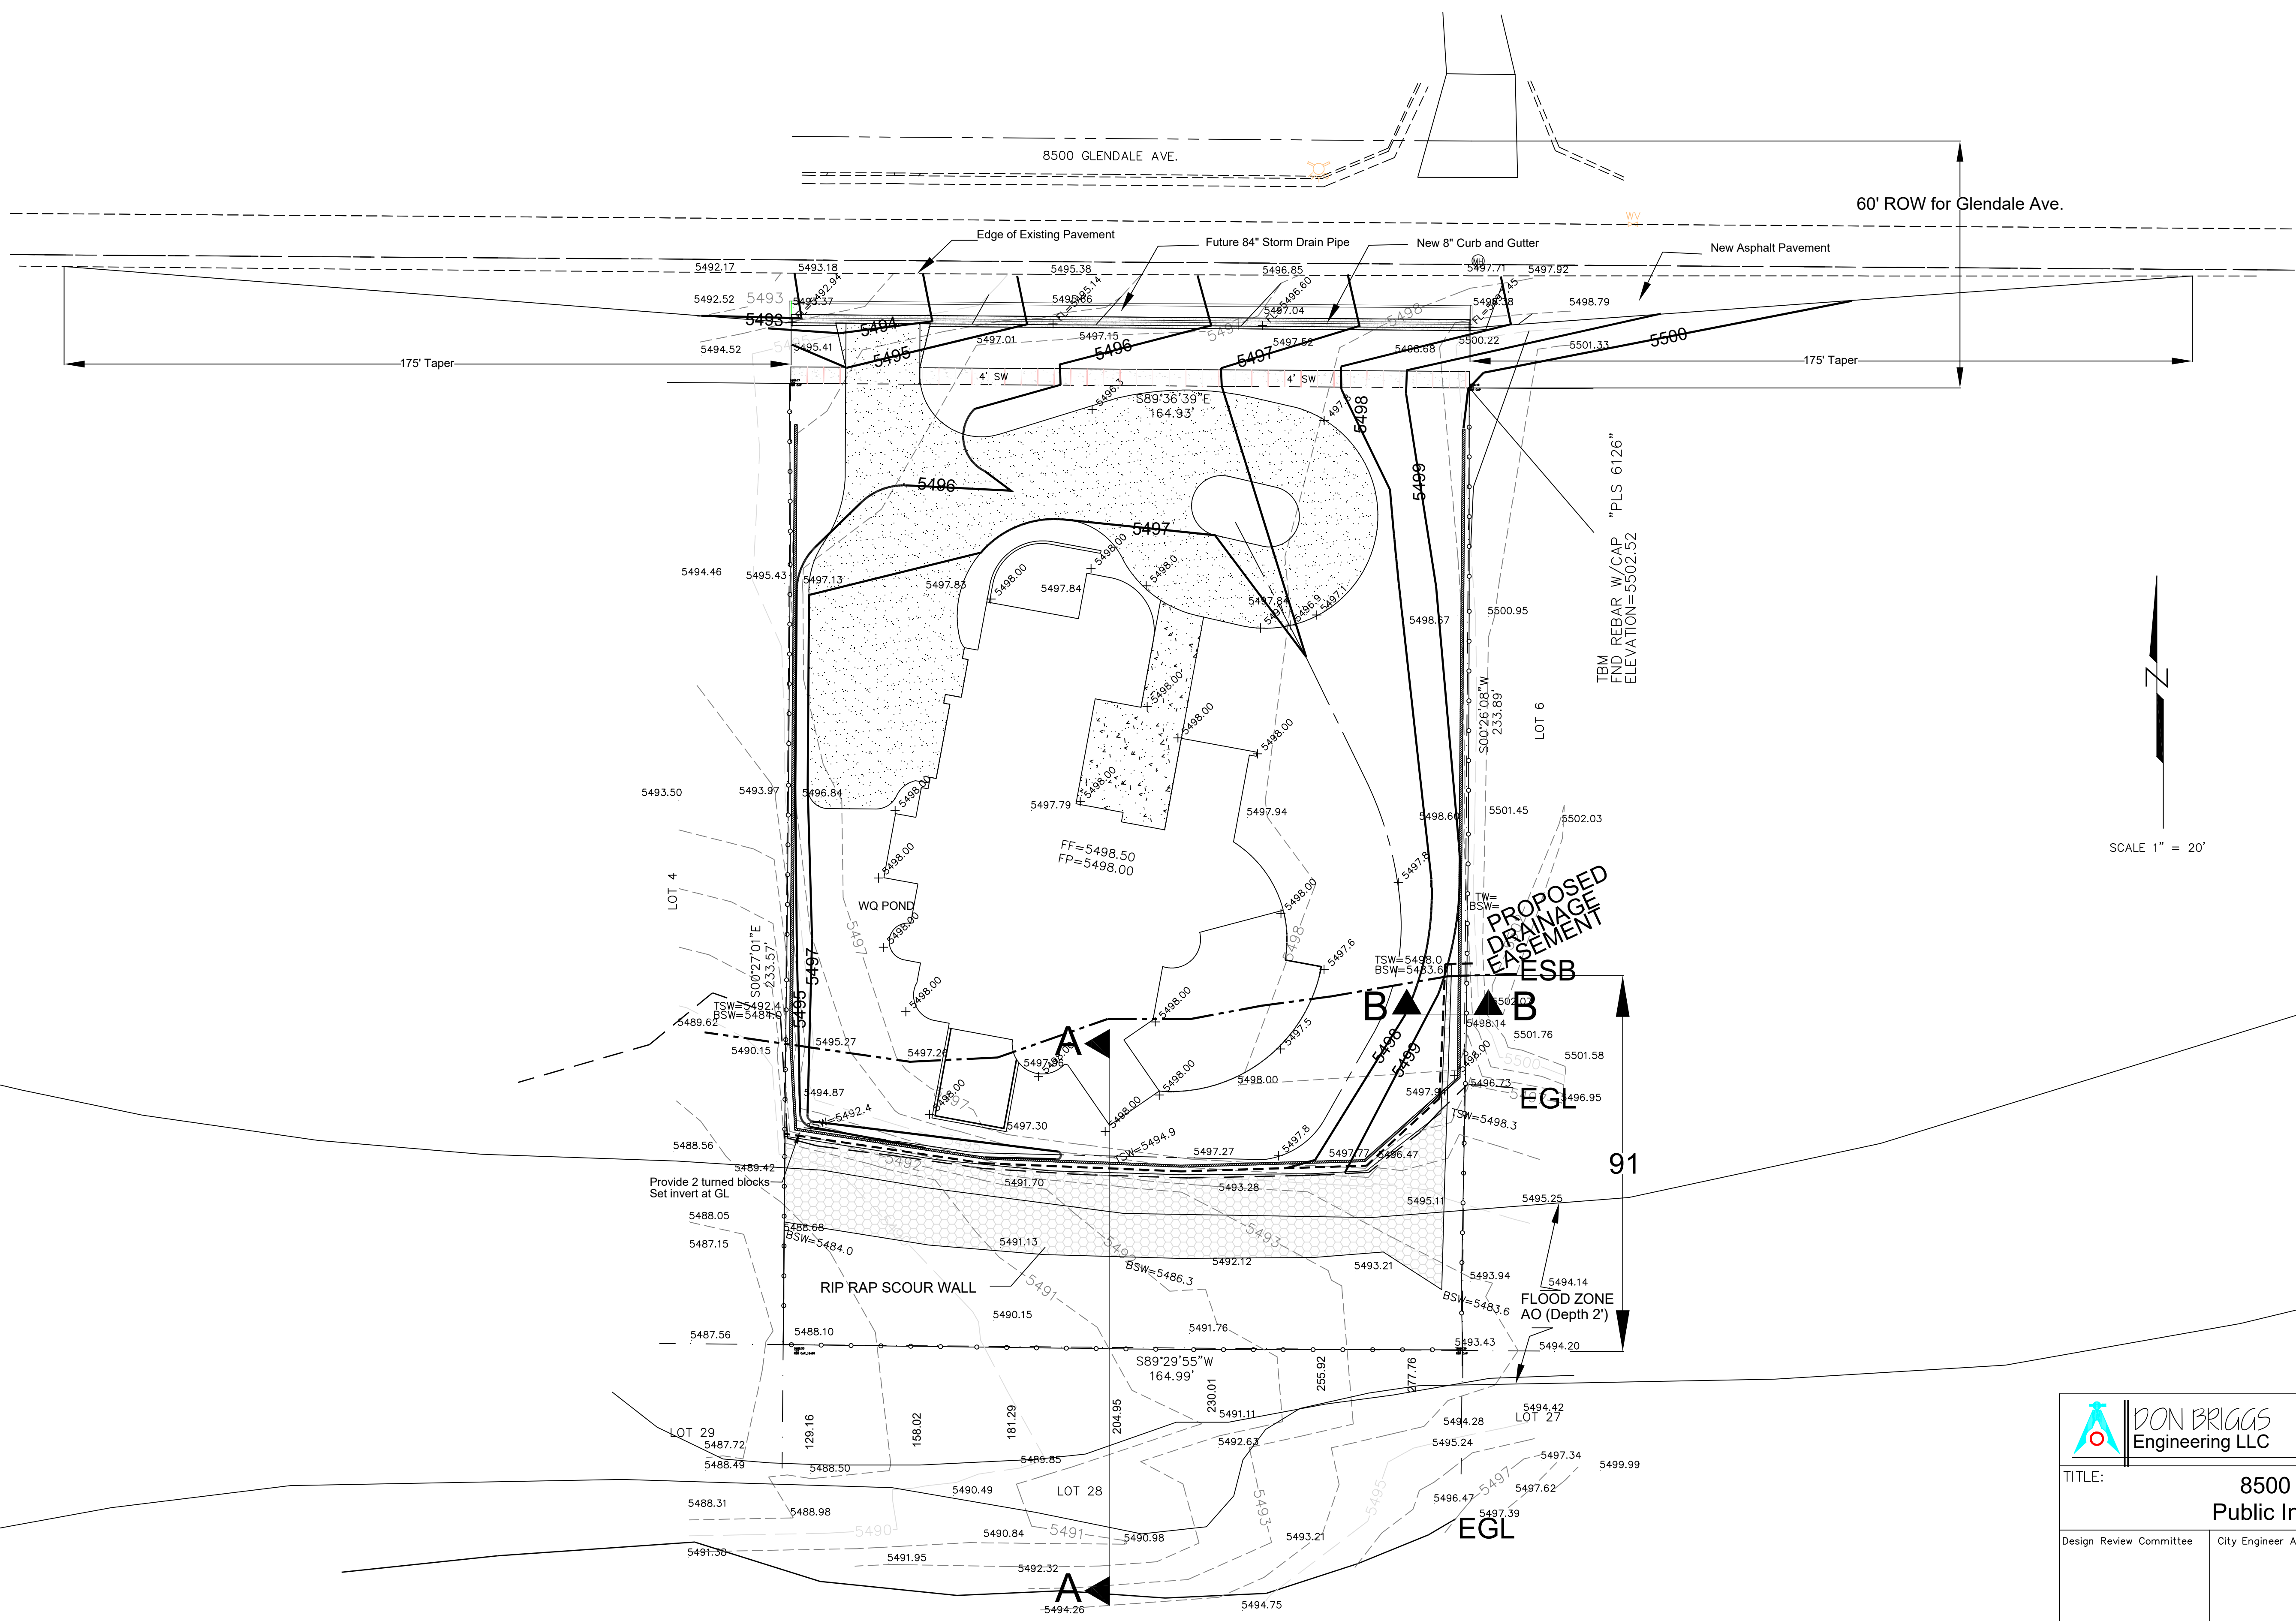

AS-BUILT INFORMATION	
CONTRACTOR	
WORK STAKED BY	DATE
ACCEPTANCE BY	DATE
FIELD VERIFICATION BY	DATE
CORRECTED BY	DATE
RECORDING INFORMATION	
RECORDED BY	DATE
NO.	


BENCHMARKS	
NO.	DATE

SURVEY INFORMATION	
FIELD NOTES	
NO.	BY

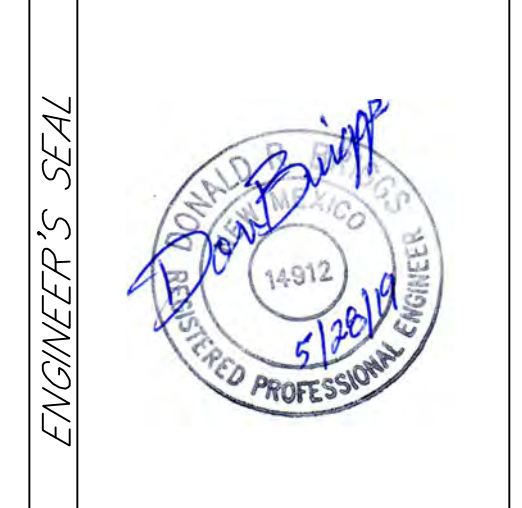

REVISIONS	
DESIGNED BY	DB
DATE	5/28/2019
DRAWN BY	DB
DATE	5/28/2019
CHECKED BY	
DATE	

NO.	DATE	REMARKS

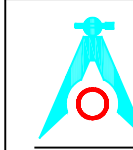

DON BRIGGS
Engineering LLC

505-249-4843
donbriggseengineering@gmail.com
5324 Oakledge Ct. NW, Albuquerque, NM 87120

TITLE: **8500 Glendale Public Infrastructure**

Design Review Committee	City Engineer Approval	Mo. / Day / Yr.	Mo. / Day / Yr.

City Project No. **B20D067** Zone Map No. Sheet **3** Of **3**