


THIS IS NOT A BOUNDARY SURVEY; DATA IS SHOWN FOR ORIENTATION ONLY.
THE BOUNDARY INFORMATION DEPICTED BY THIS PLAN IS BASED UPON THE
BOUNDARY SURVEY PREPARED BY HIGH MESA CONSULTING GROUP (FORMERLY
JEFF WORTENSEN AND ASSOC., INC.), NMPS NO. 11184, DATED JANUARY, 2007.
TOPOGRAPHIC INFORMATION IS BASED UPON A TOPOGRAPHIC SURVEY
PREPARED BY HIGH MESA CONSULTING GROUP (FORMERLY JEFF WORTENSEN
AND ASSOC., INC.) DATED SEPTEMBER, 2007. NMPS NO. 11184.

9 2

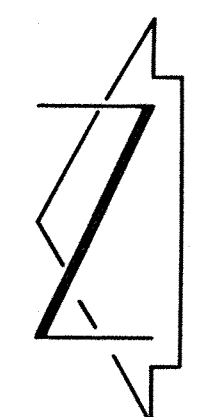

11-28-2007
6-12-2007.18

11-28-2007
10-12-2007 2007.184.3

SHEET 2 OF 5

6010-B MIDWAY PARK BLVD. NE • ALBUQUERQUE, NEW MEXICO 87109
PHONE: 505.345.4250 • FAX: 505.345.4254 • www.highmesacg.com

CITY HYDROLOGY


APPROVED BY _____

NEL	DATE	BY	REVISIONS
1	11/07	GRB	LABEL ARCHEOLOGICAL SITE
2	2/09	JSM	RECORD DRAWING AND CERTIFICATION FOR TEMP. C.O.
3	11-09	JSM	RECORD DRAWING AND DRAINAGE CERTIFICATION FOR PERM. C.O.


SHEET 2 OF 5

MATCH LINE; FOR CONTINUATION SEE SHEET 2

RECORD DRAWING **FOR CERTIFICATION, SEE SHEET 1** **FOR RECORD DRAWING LEGEND, SEE SHEET 4**

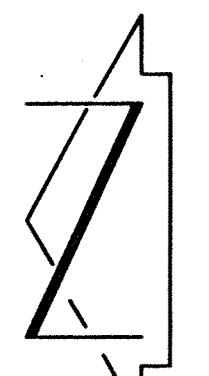

SCALE: 1" = 50'

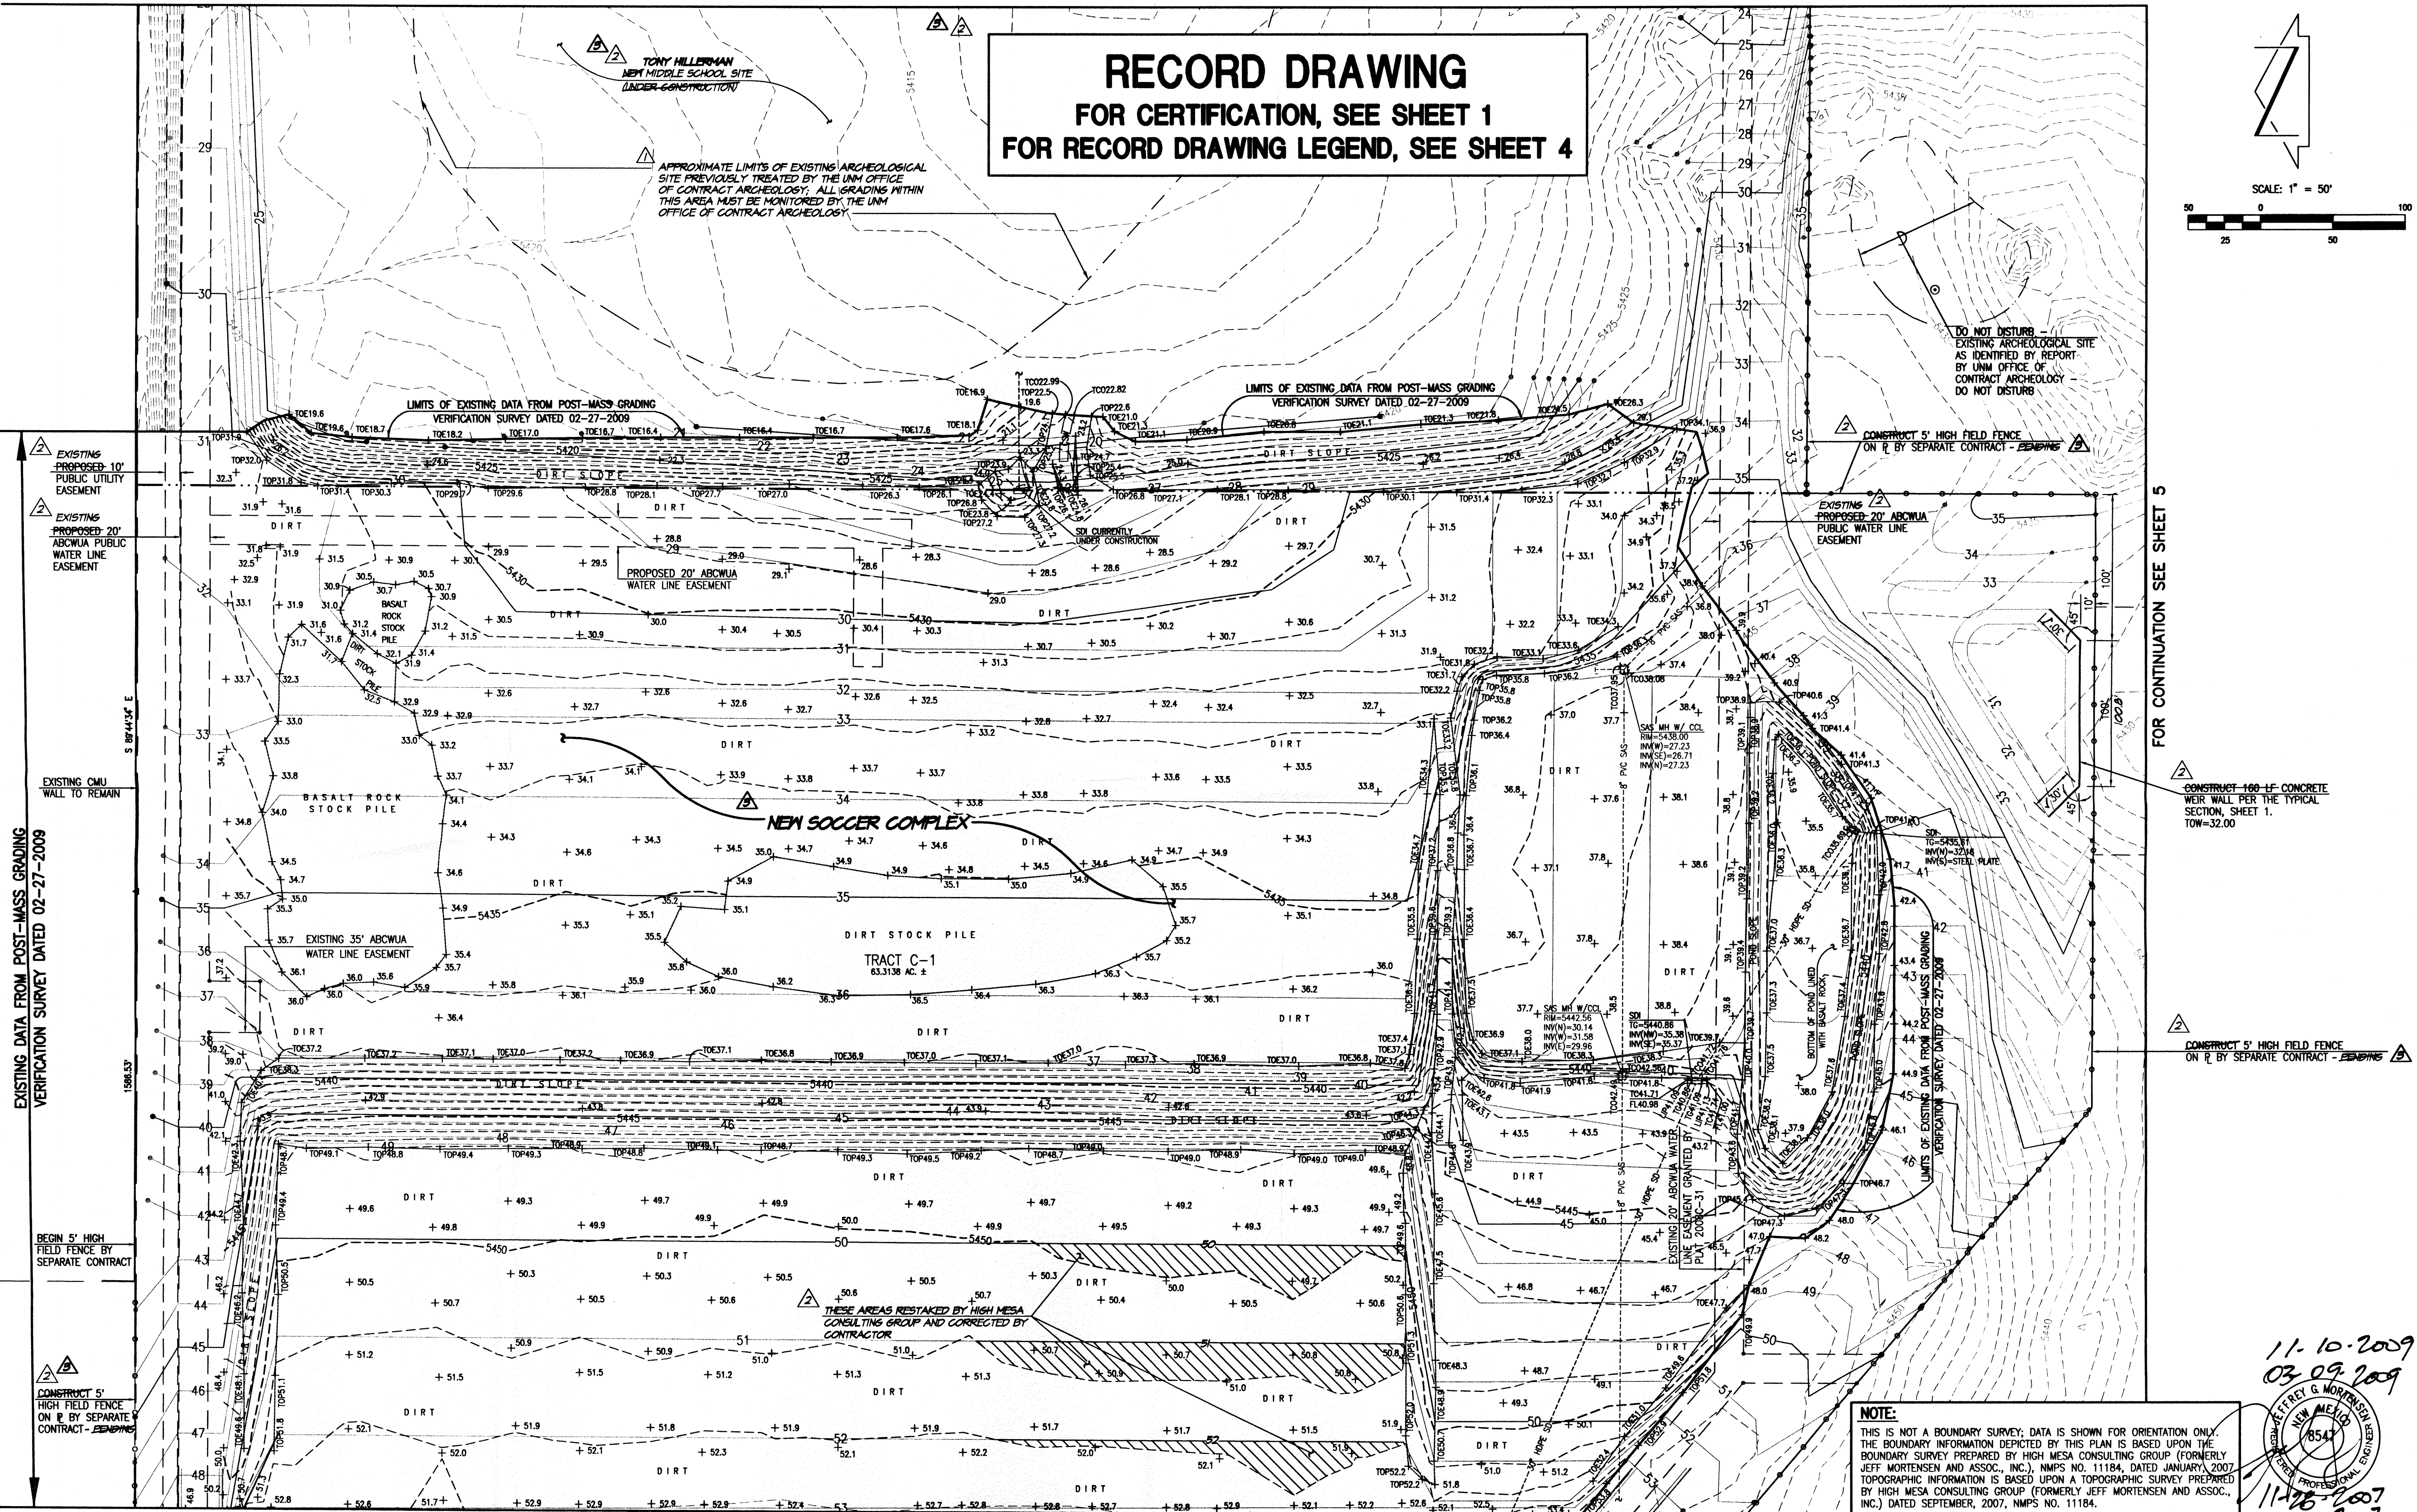

FOR CONTINUATION SEE SHEET 5

MATCH LINE; FOR CONTINUATION SEE SHEET 4

NOTE:

THIS IS NOT A BOUNDARY SURVEY; DATA IS SHOWN FOR ORIENTATION ONLY. THE BOUNDARY INFORMATION DEPICTED BY THIS PLAN IS BASED UPON THE BOUNDARY SURVEY PREPARED BY HIGH MESA CONSULTING GROUP (FORMERLY JEFF MORTENSEN AND ASSOC., INC.), NMPS NO. 11184, DATED JANUARY, 2007. TOPOGRAPHIC INFORMATION IS BASED UPON A TOPOGRAPHIC SURVEY PREPARED BY HIGH MESA CONSULTING GROUP (FORMERLY JEFF MORTENSEN AND ASSOC., INC.), DATED SEPTEMBER, 2007, NMPS NO. 11184.

11-10-2009
 03-09-2009
 JEFF MORTENSEN & ASSOCIATES
 11-26-2007
 10-12-2009/1043

HIGH MESA Consulting Group

6010-B MIDWAY PARK BLVD. NE • ALBUQUERQUE, NEW MEXICO 87109
 PHONE: 505.345.4250 • FAX: 505.345.4254 • www.highmesacg.com

MASS GRADING PLAN - CENTER **TRACT C-1, ANCIENT MESA** **NORTHWEST EDUCATION CORRIDOR**

APPROVED FOR ROUGH GRADING:

ORIGINAL SIGNED BY JEREMY HOOVER DATED
 10/18/07

CITY HYDROLOGY

DATE

DESIGNED BY

G.R.B.

DRAWN BY

H.M.C.

APPROVED BY

J.G.M.

NO.	DATE	BY	REVISIONS	JOB NO.
1	11/07	GRB	LABEL ARCHEOLOGICAL SITE	2006.187.6
2	2/09	JSM	RECORD DRAWING AND CERTIFICATION FOR TEMP. C.O.	DATE 10-2007
3	11-09	JSM	RECORD DRAWING AND DRAINAGE CERTIFICATION FOR PERM. C.O.	SHEET 3 OF 5

MATCH LINE; FOR CONTINUATION SEE SHEET 3

RECORD DRAWING FOR CERTIFICATION, SEE SHEET 1

RECORD DRAWING LEGEND	
CONSTRUCT	RECORD INFORMATION (VERIFIED BY ENGINEER)
✓	AS-CONSTRUCTED = AS-DESIGNED (VERIFIED BY ENGINEER)
38' 42"	RECORD INFORMATION (VERIFIED BY ENGINEER)
+25.2	RECORD INFORMATION (VERIFIED BY ENGINEER)
28.95.92	RECORD INFORMATION (VERIFIED BY ENGINEER)
✓	AS-CONSTRUCTED = AS-DESIGNED (VERIFIED BY AS-BUILT SURVEY)
31.31.8	RECORD INFORMATION FROM AS-BUILT SURVEY
+26.9	RECORD INFORMATION FROM AS-BUILT SURVEY
31.25.22	RECORD INFORMATION FROM AS-BUILT SURVEY
+26.9	RECORD INFORMATION FROM POST-MASS GRADING VERIFICATION SURVEY
-5455-	CONTOUR FROM POST-MASS GRADING VERIFICATION SURVEY
-60-	AS-APPROVED DESIGN CONTOUR FROM APPROVED PLAN

NOTE:
THIS IS NOT A BOUNDARY SURVEY; DATA IS SHOWN FOR ORIENTATION ONLY. THE BOUNDARY INFORMATION DEPICTED BY THIS PLAN IS BASED UPON THE BOUNDARY SURVEY PREPARED BY HIGH MESA CONSULTING GROUP (FORMERLY JEFF MORTENSEN AND ASSOC., INC.), NMPS NO. 11184, DATED JANUARY, 2007. TOPOGRAPHIC INFORMATION IS BASED UPON A TOPOGRAPHIC SURVEY PREPARED BY HIGH MESA CONSULTING GROUP (FORMERLY JEFF MORTENSEN AND ASSOC., INC.) DATED SEPTEMBER, 2007, NMPS NO. 11184.

OVER-EXCAVATION NOTE:
THE ROUGH GRADING CONTRACTOR SHALL OVER-EXCAVATE THE BUILDING PADS TO THE ELEVATIONS SHOWN AND BACKFILL TO THE FINISH PAD ELEVATIONS. ALL BACKFILL SHALL BE COMPACTED TO 95% ASTM D-1557 AND IN ACCORDANCE WITH THE GEO-TECHNICAL INVESTIGATION REPORT NO. 07-1-187 DATED JUNE 6, 2007 BY VINYARD & ASSOCIATES, INC.

File Path: \\C:\Users\jmoore\Documents\2007\184\184.dwg Plot Date: 11-09-2009
File Name: 618764GPA_R3.DWG Plot Time: 2:38 pm

HIGH MESA Consulting Group

6010-B MIDWAY PARK BLVD. NE • ALBUQUERQUE, NEW MEXICO 87109
PHONE: 505.345.4250 • FAX: 505.345.4254 • www.highmesacg.com

MASS GRADING PLAN - WEST **TRACT C-1, ANCIENT MESA** **NORTHWEST EDUCATION CORRIDOR**

APPROVED FOR ROUGH GRADING:

ORIGINAL SIGNED BY JEREMY HOOVER DATED
10/18/07
CITY HYDROLOGY DATE

DESIGNED BY: G.R.B.
DRAWN BY: CFA/BLE/DMH
APPROVED BY: J.G.M.

NO.	DATE	BY	REVISIONS	JOB NO.
1	11/07	GRB	REVISE FOR OVER-EXCAVATION REQUIREMENTS	2006.187.6
2	2/09	JGM	RECORD DRAWING AND CERTIFICATION	DATE 10-2007
3	11-01	JGM	RECORD DRAWING AND DRAINAGE CERTIFICATION FOR PERM. G.O.	SHEET 4 OF 5

11-10-2009
03-09-2009
JEFFREY G. MORTENSEN
NEW MEXICO
8547
11-28-2007
10-12-2007.184.3

